


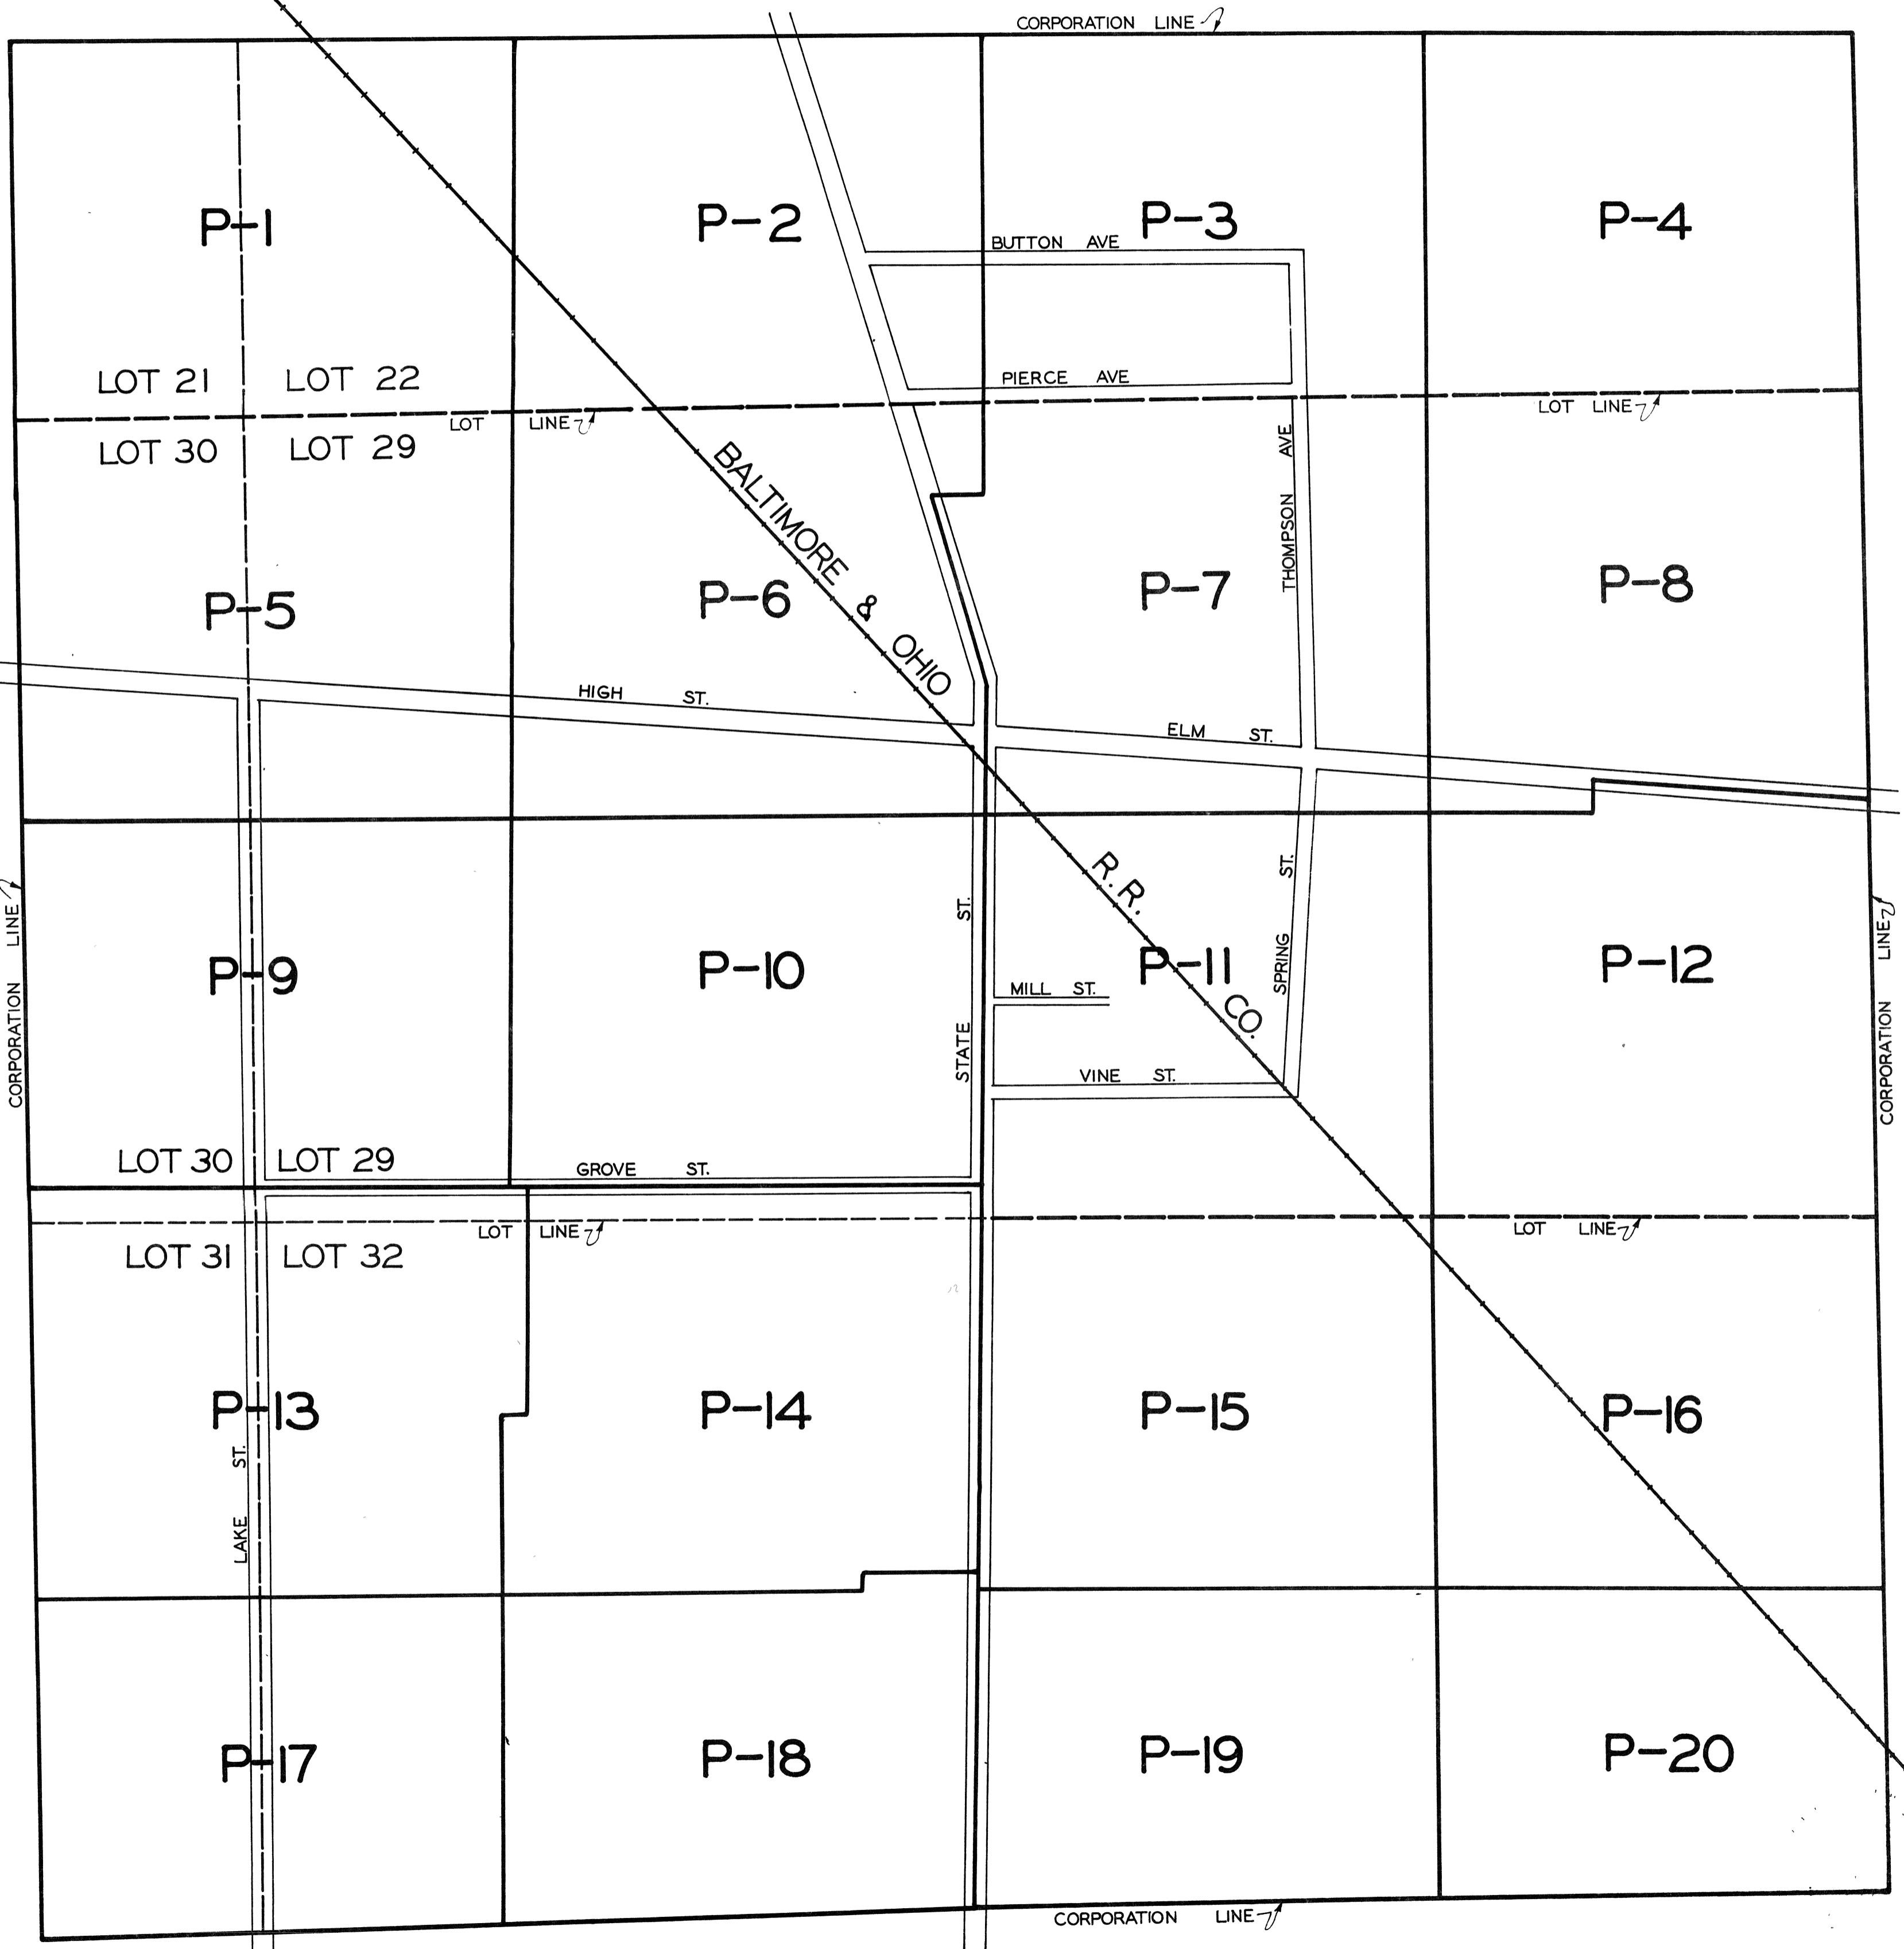


INDEX MAP OF MIDDLEFIELD VILL.

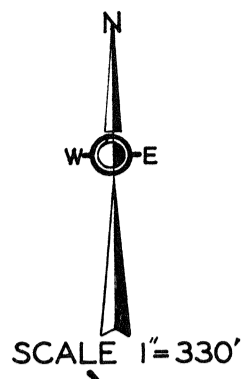

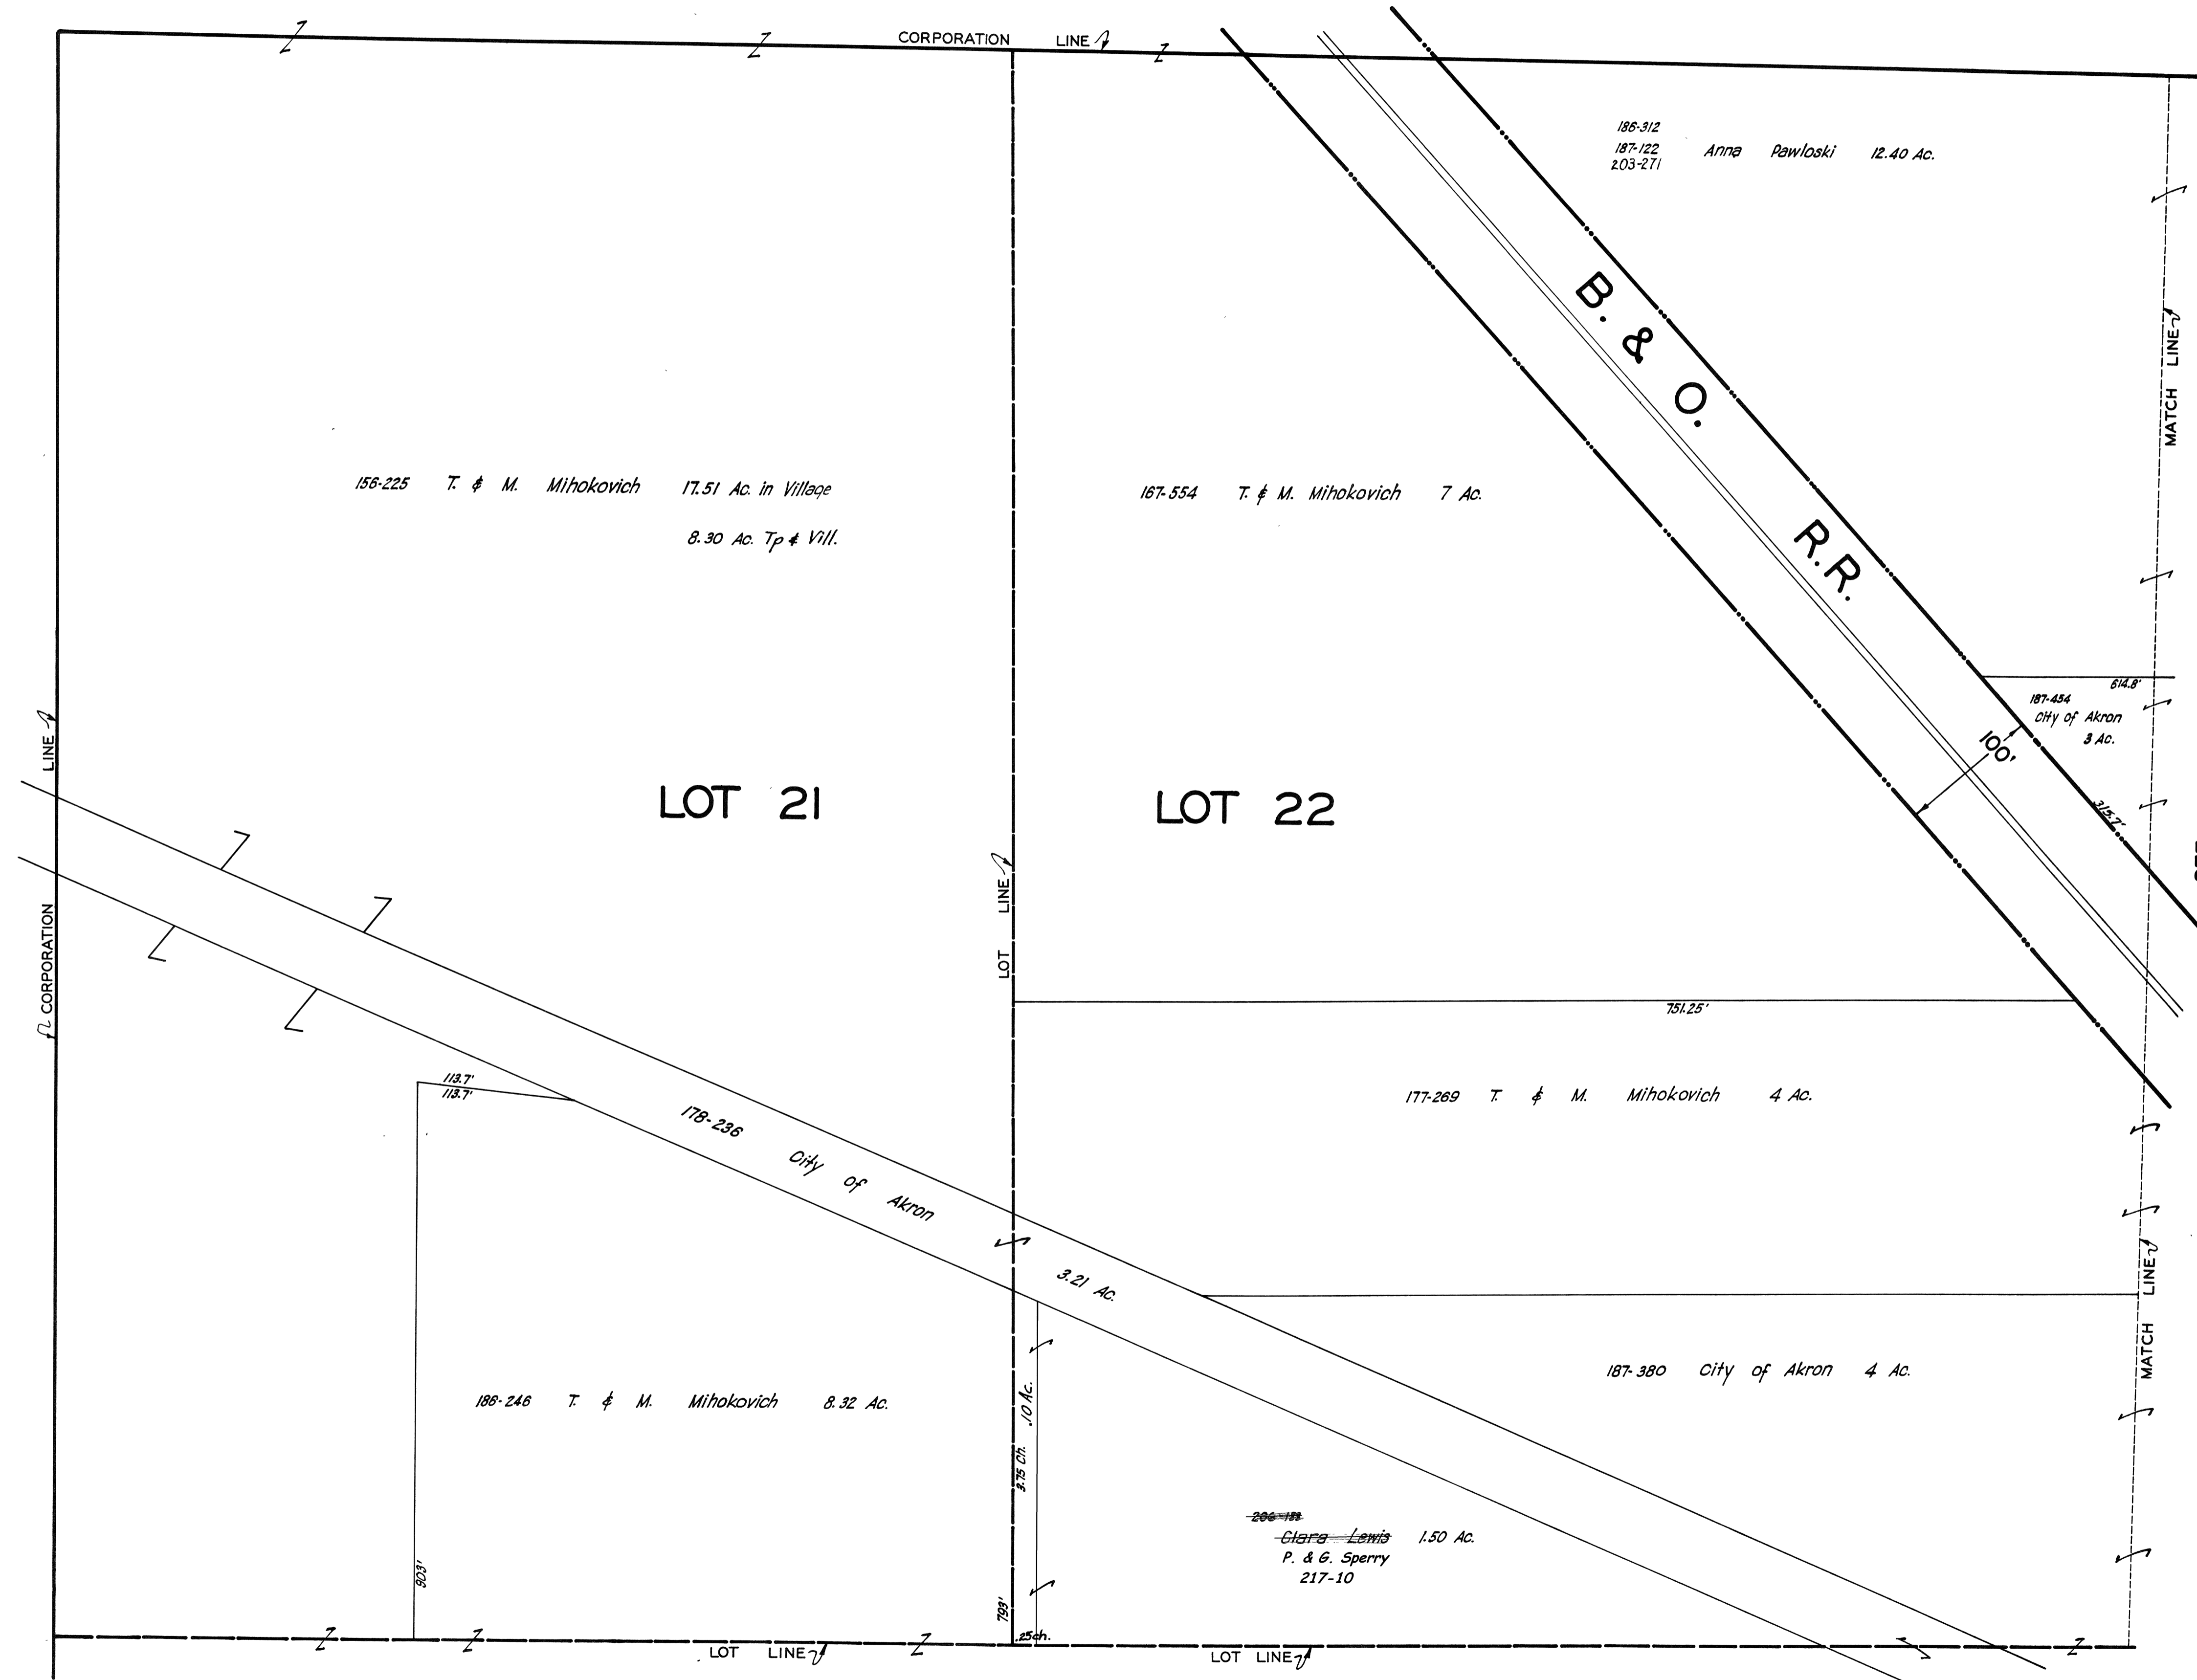


SEE PAGE TWO

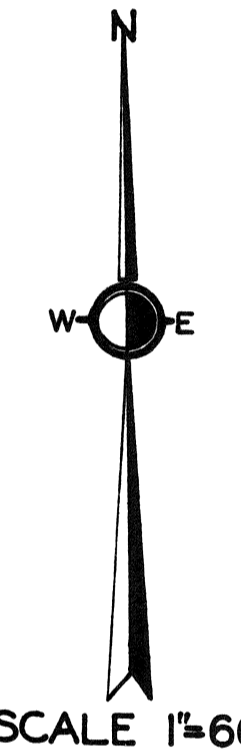

8-21-42
 JAN. 1, 1941
 3-1-43
 2-15-44


**MIDDLEFIELD
 VIL-1
 NOT TO SCALE
 1944**

SEE PAGE FIVE

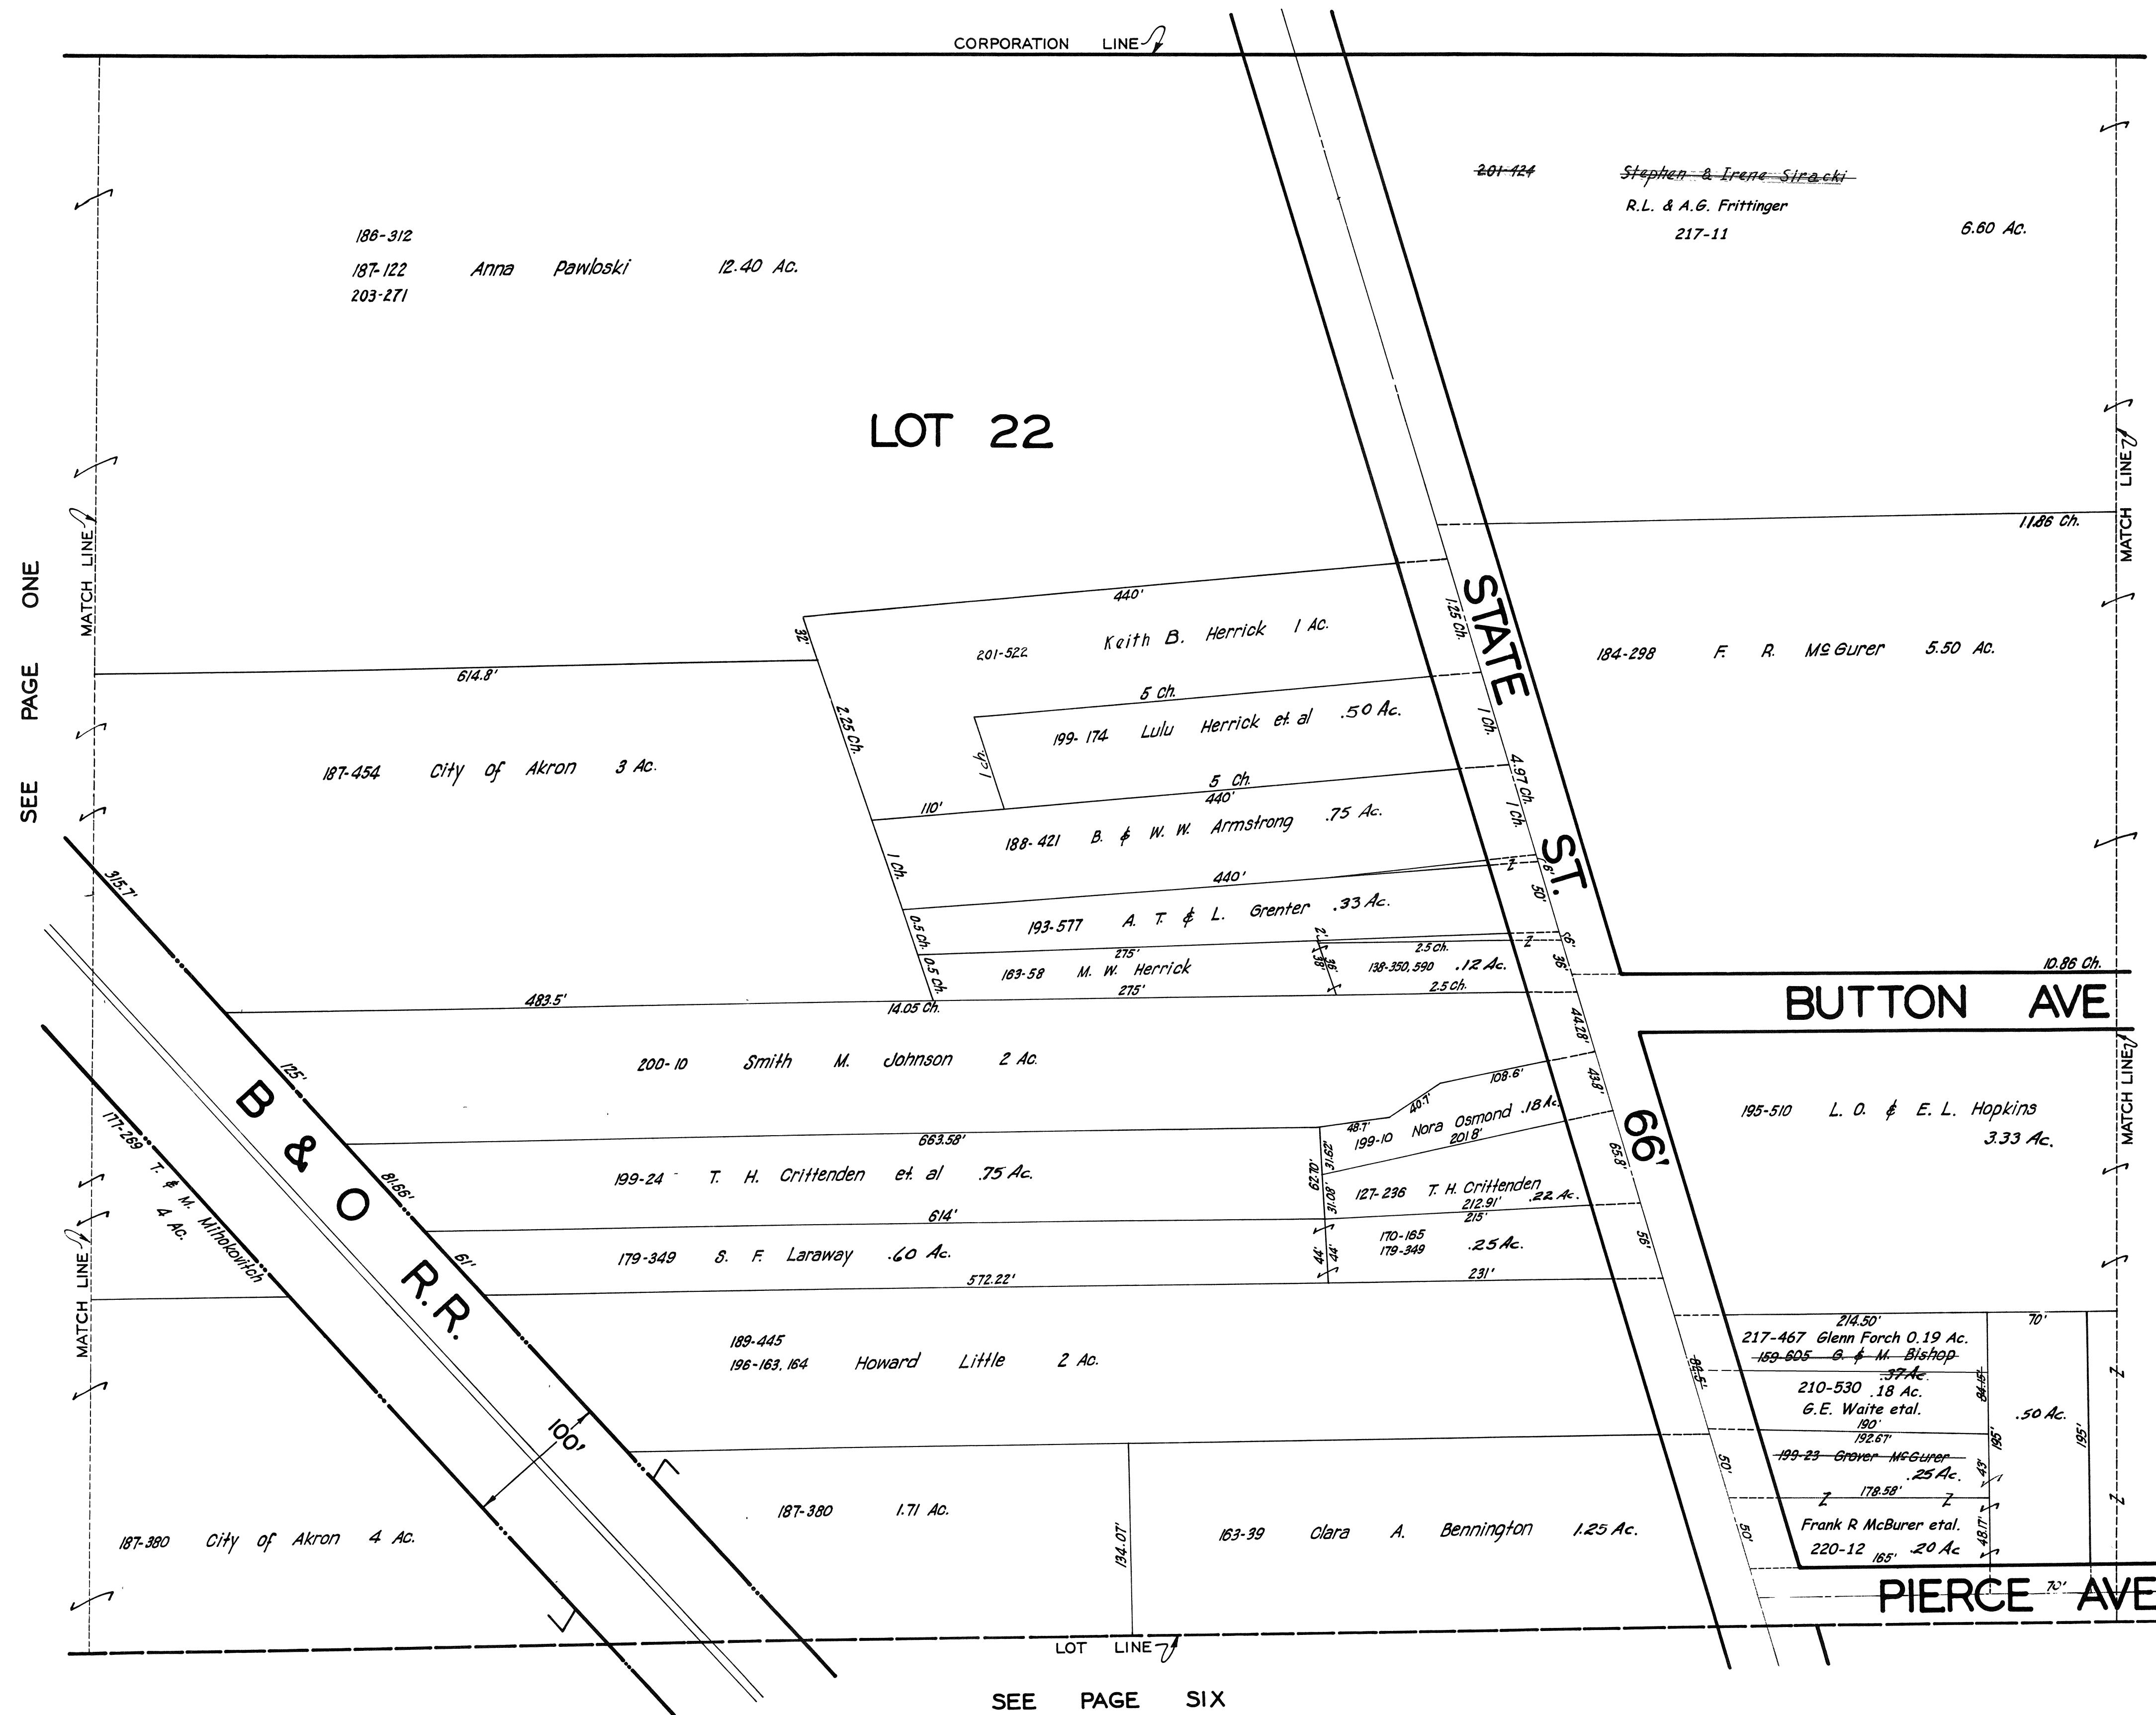

SEE PAGE ONE


SEE PAGE THREE

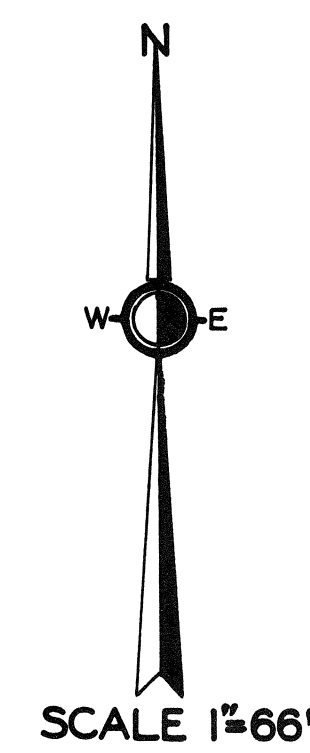

8-21-42
 JAN. 1, 1941
 3-1-43
 2-15-44

**MIDDLEFIELD
 VIL - 2
 NOT TO SCALE
 1944**


SEE PAGE SIX

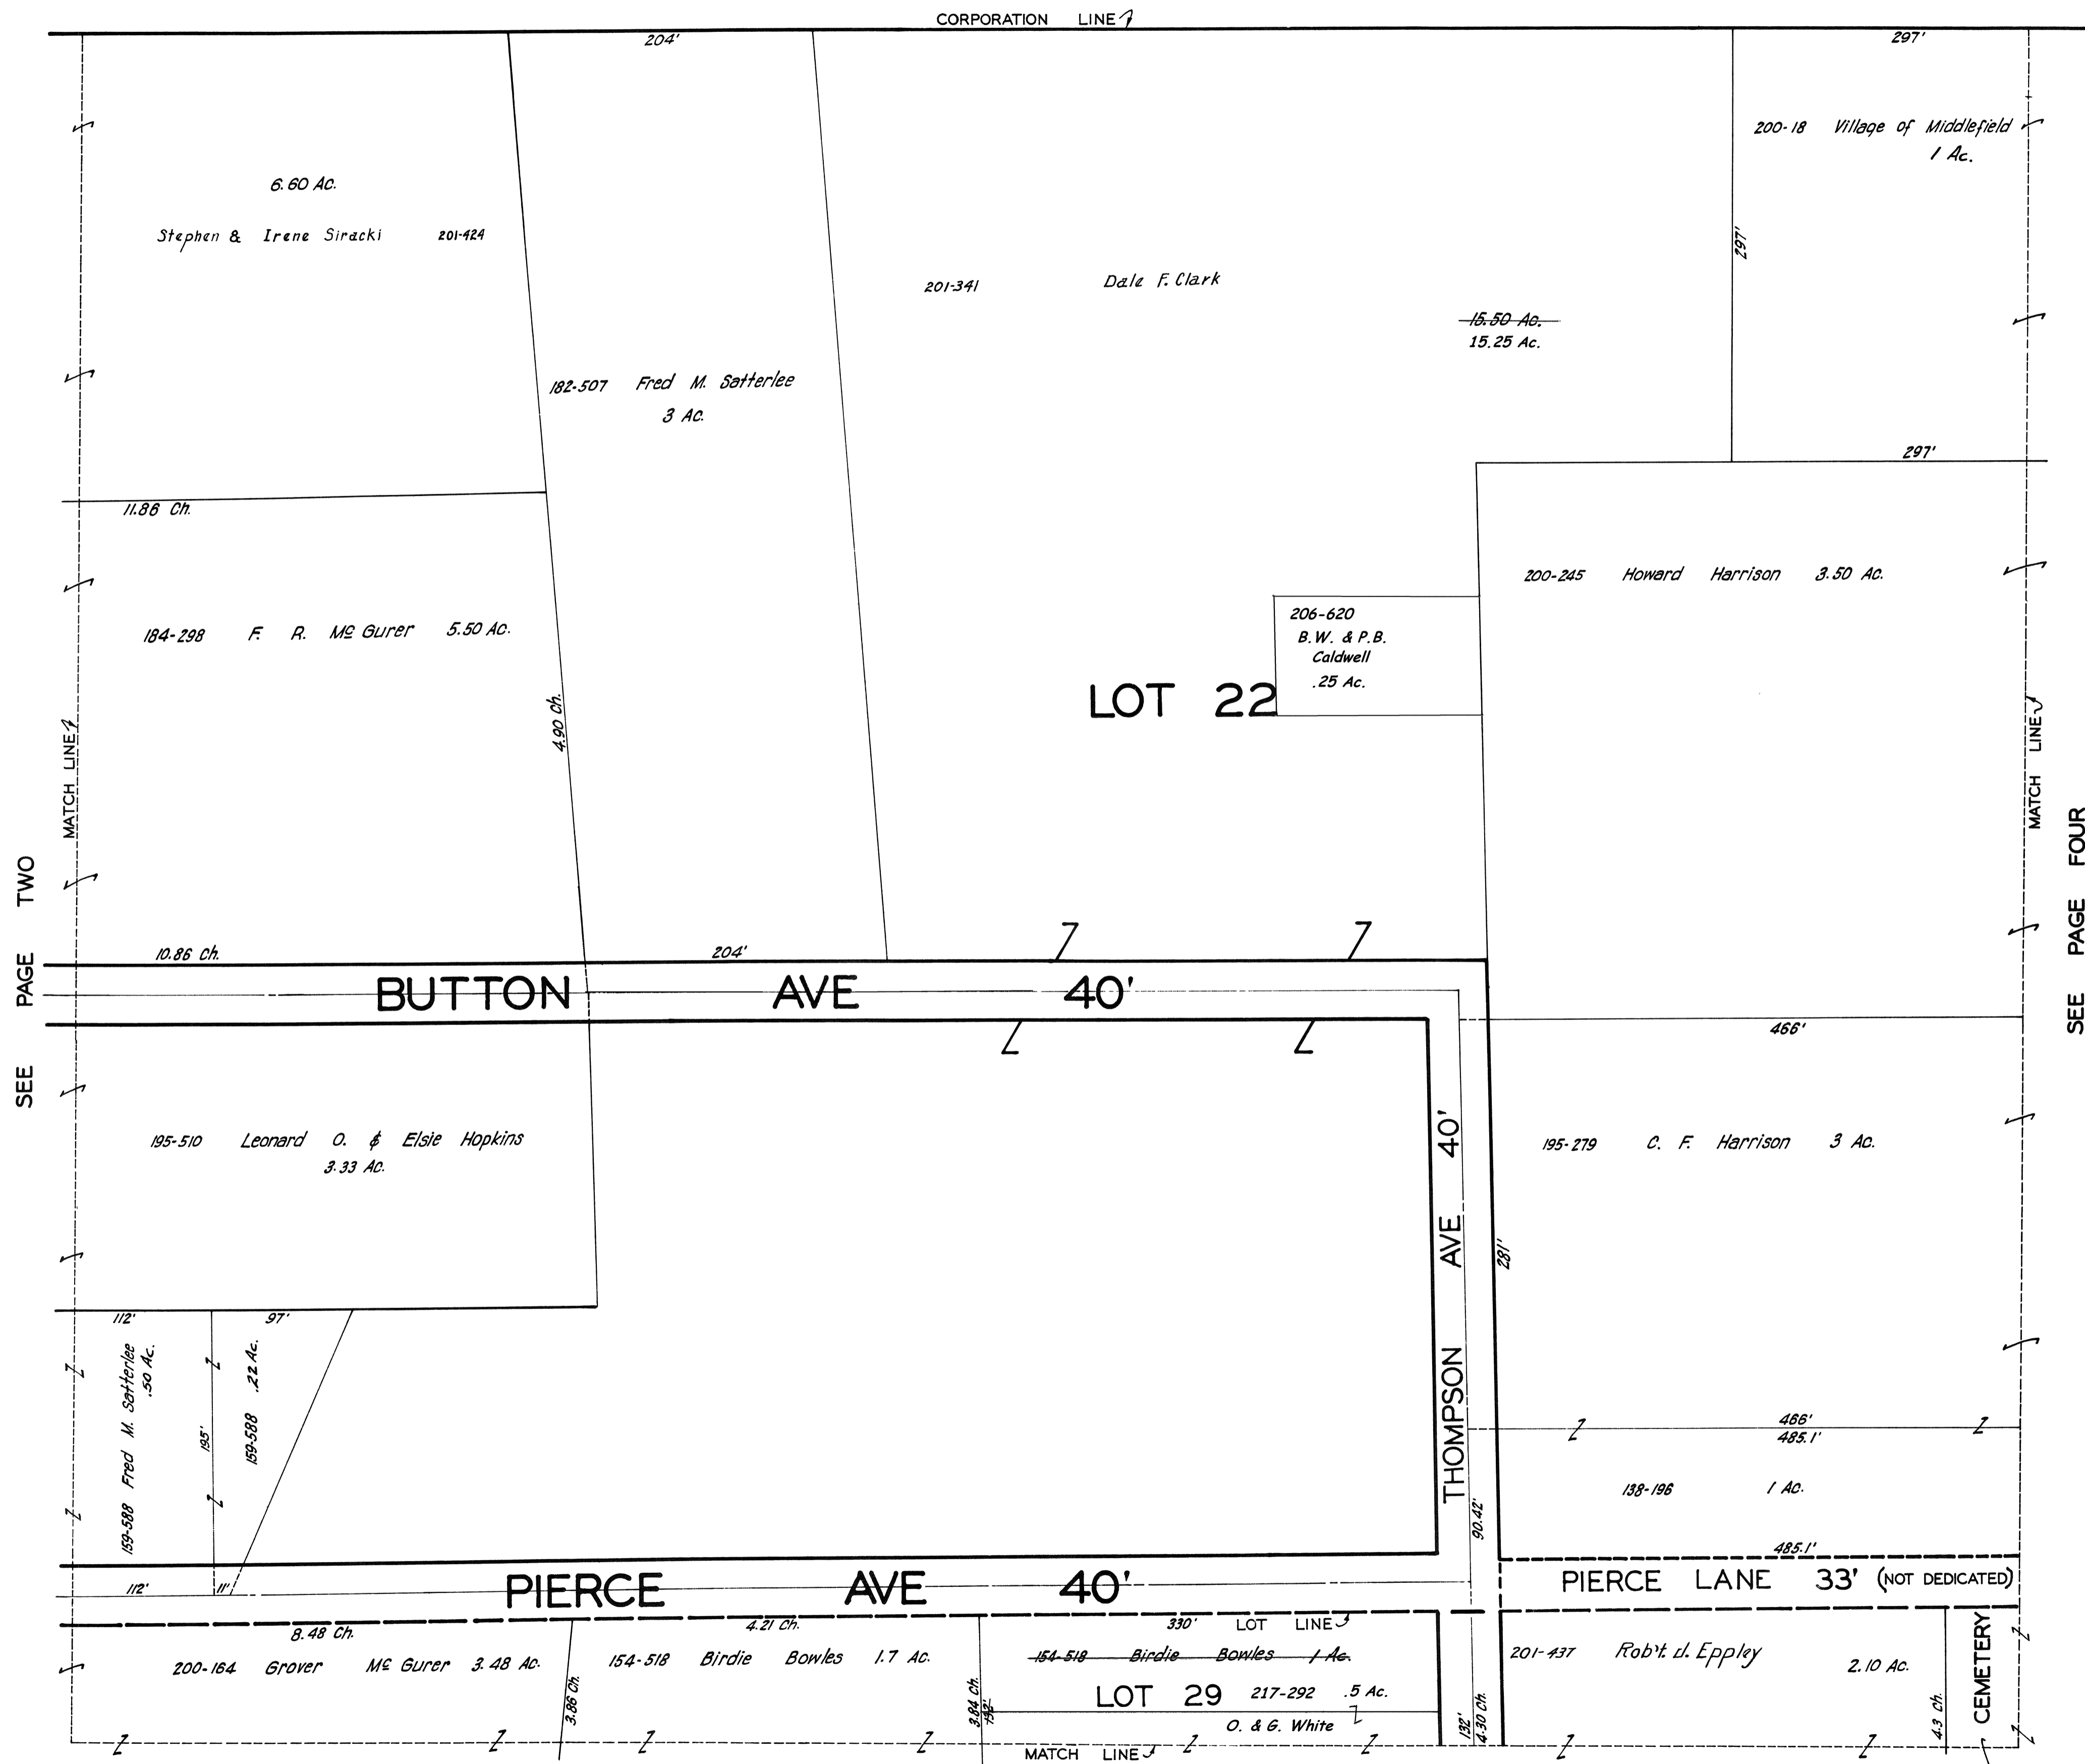

SEE PAGE TWO



SEE PAGE FOUR

SEE PAGE SEVEN

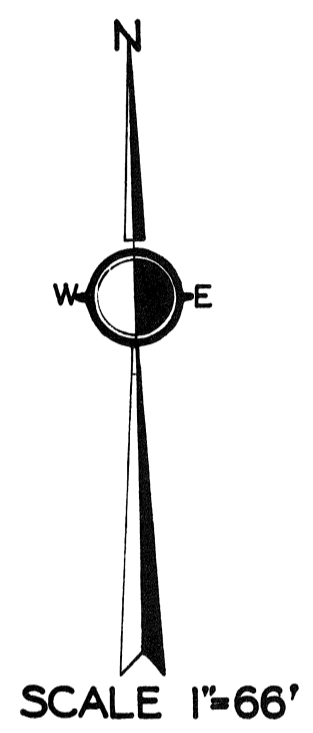


8-21-42
 JAN. 1, 1941
 3-1-43
 2-15-44

**MIDDLEFIELD
 VIL - 3
 NOT TO SCALE
 1944**

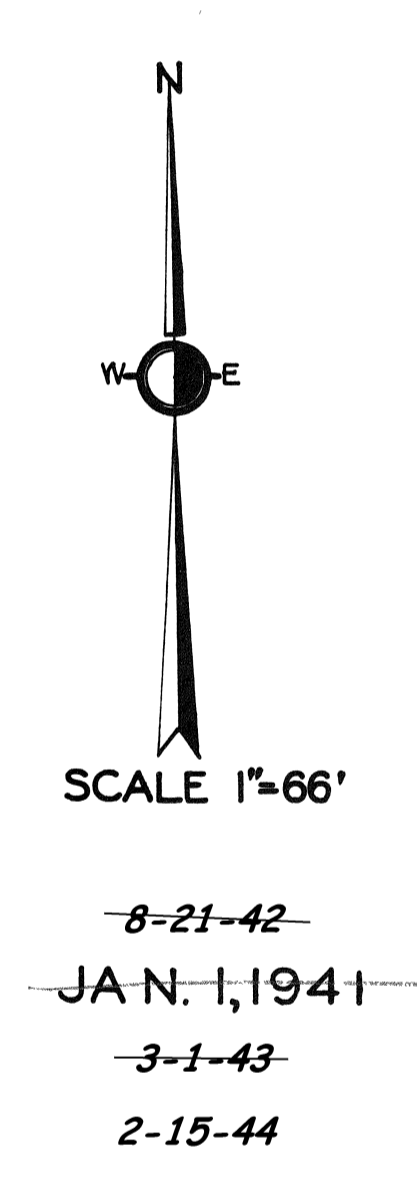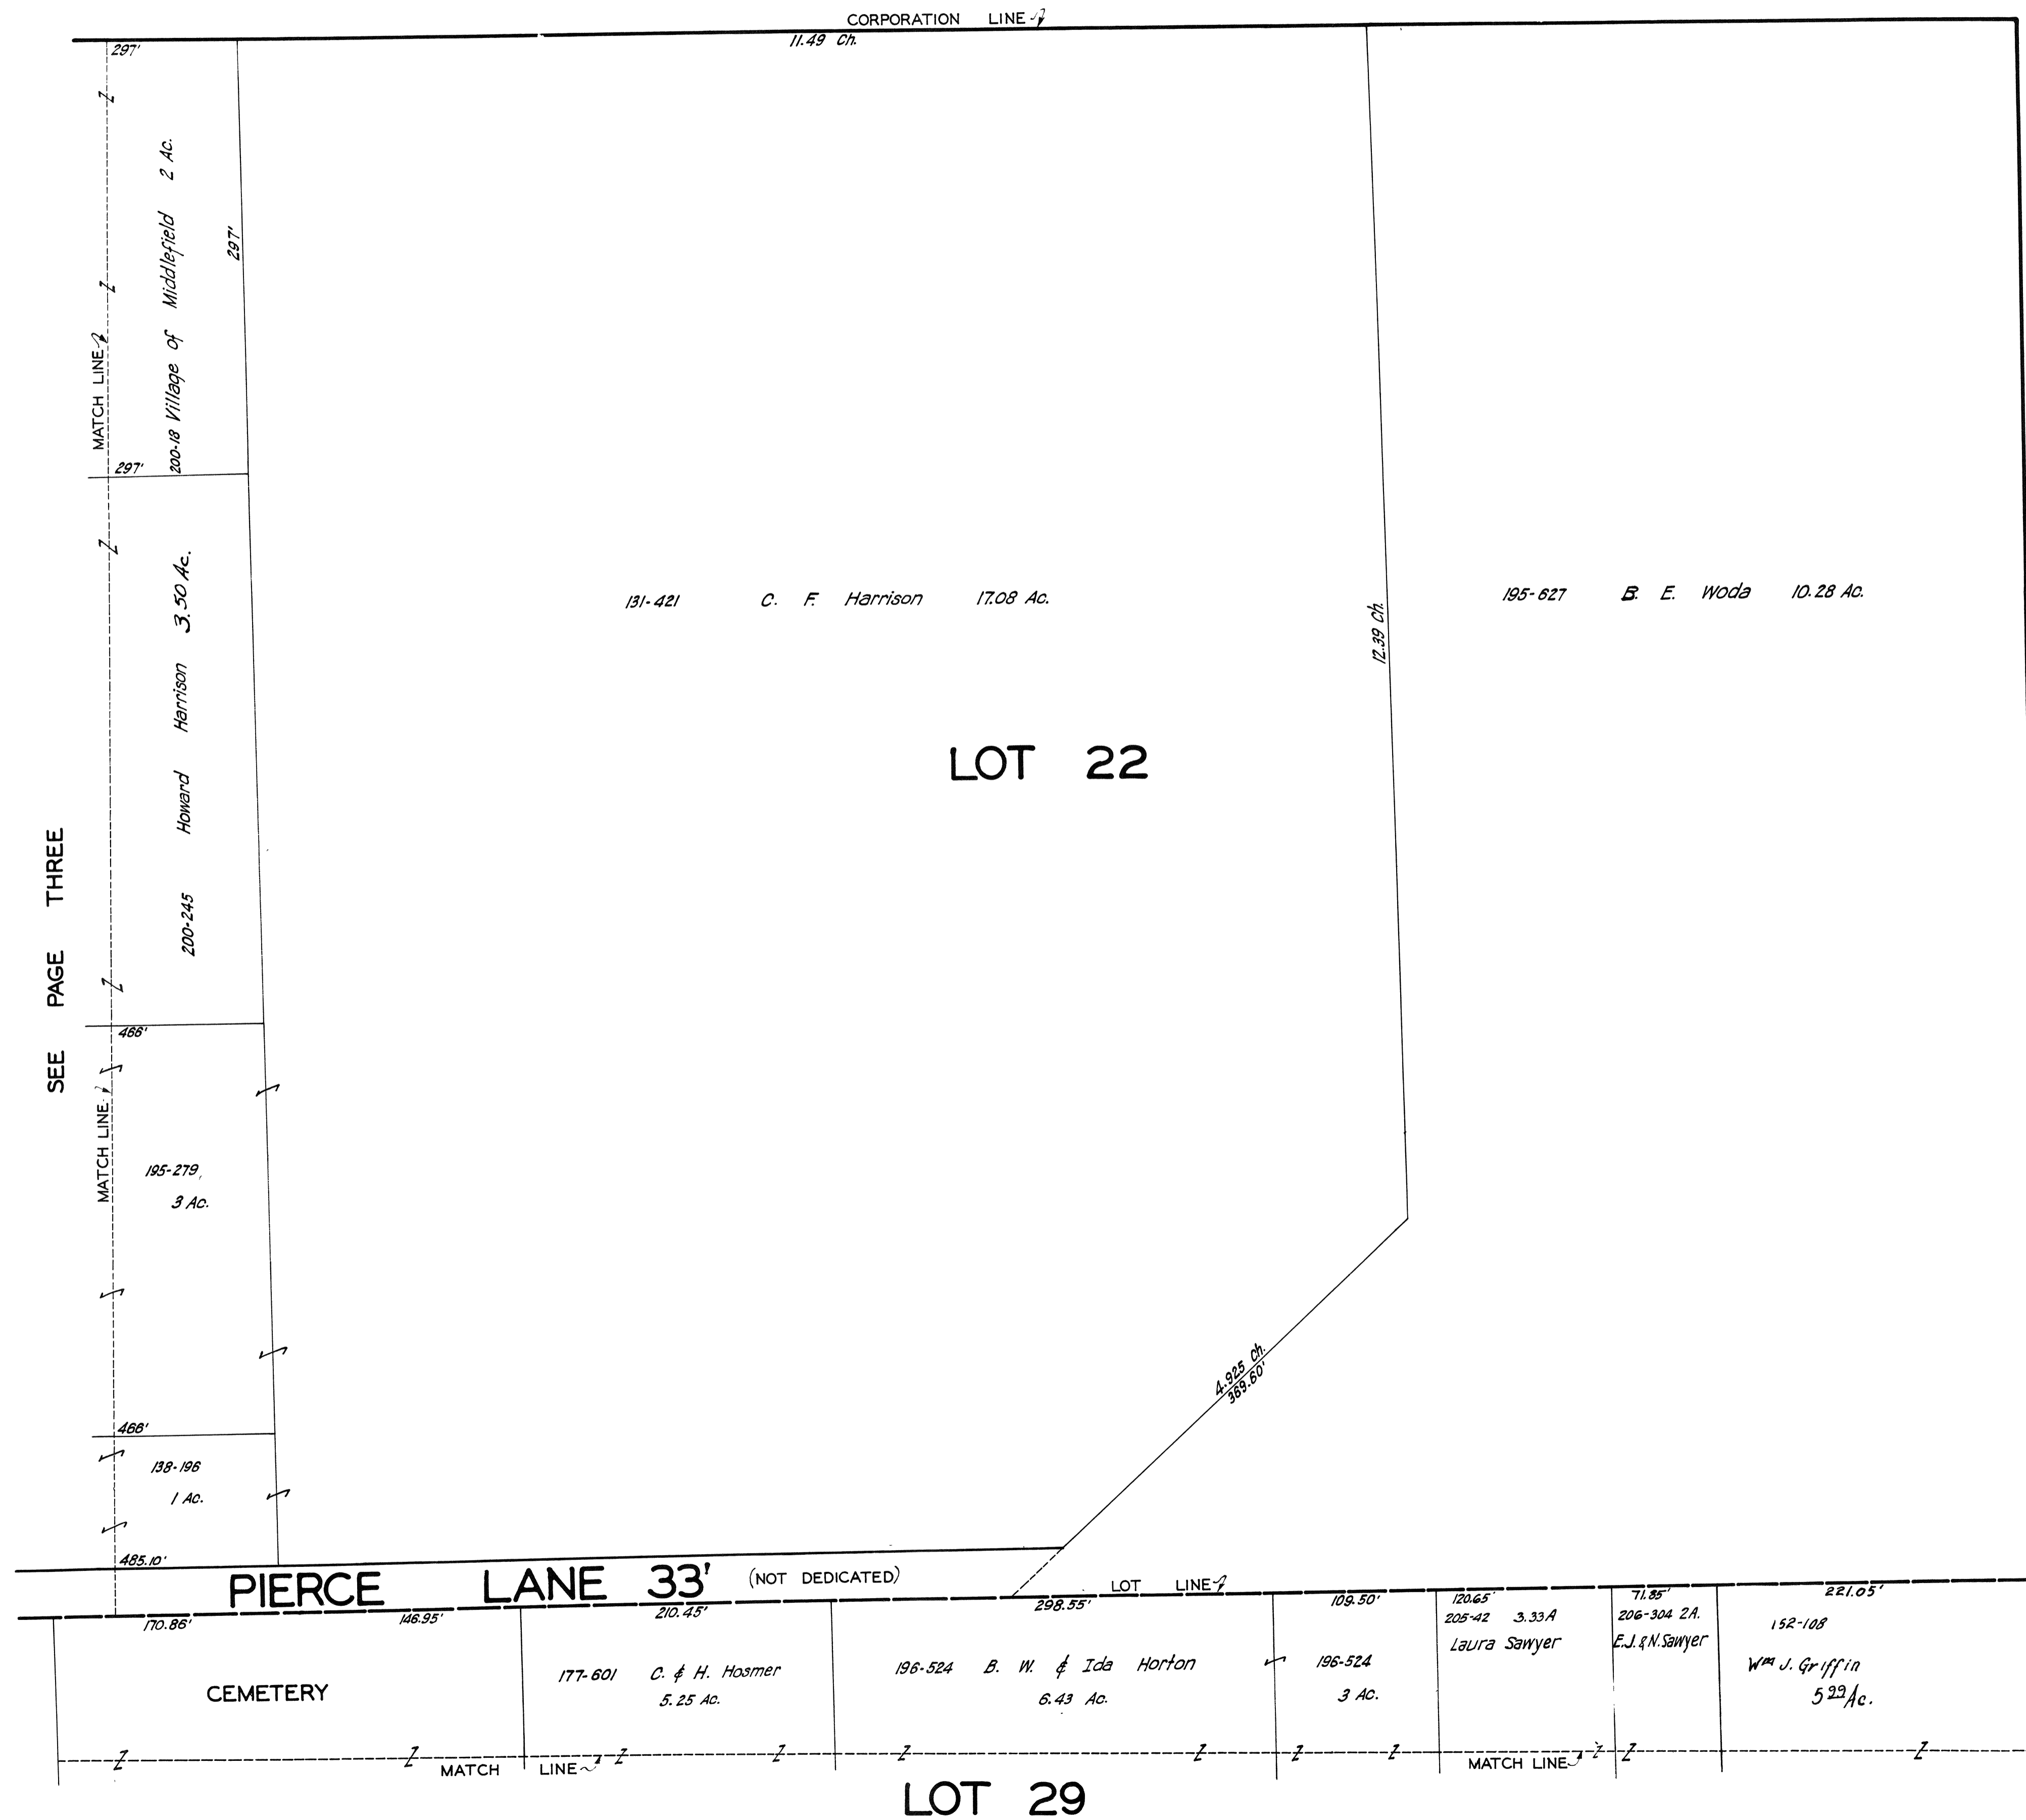


**MIDDLEFIELD
VIL-4
NOT TO SCALE
1944**

SEE PAGE ONE

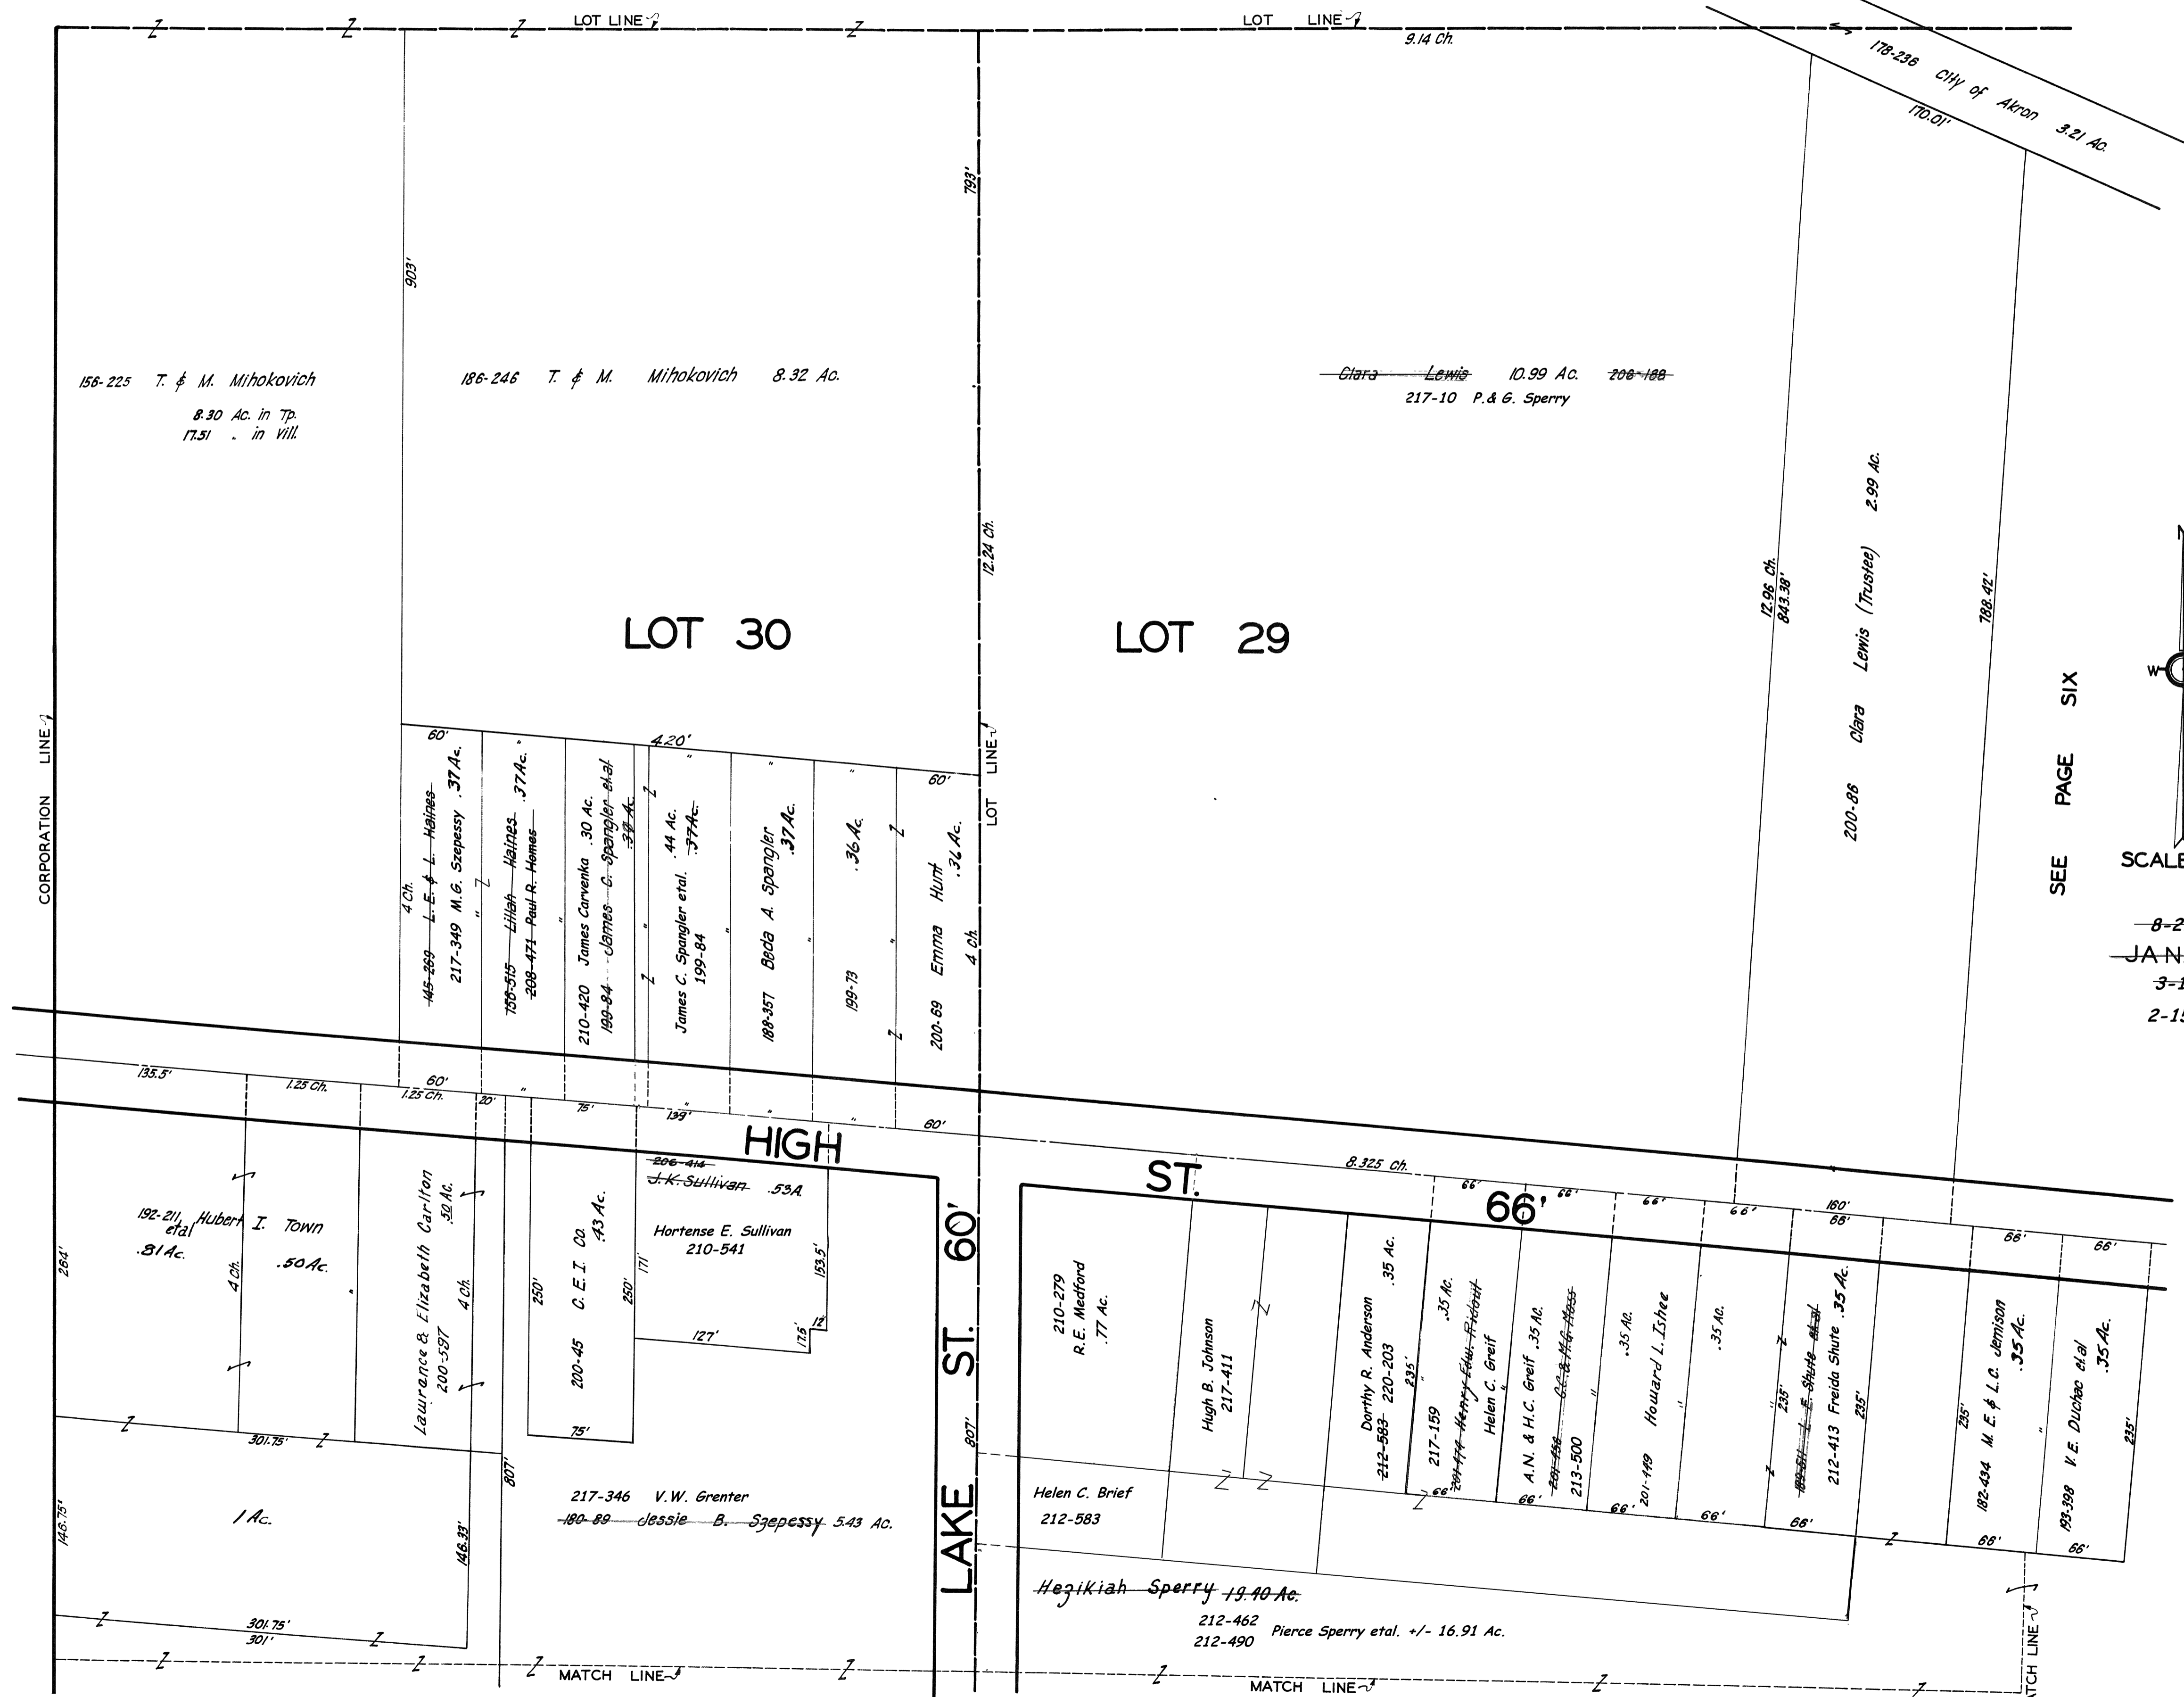

MIDDLEFIELD VIL - 5 NOT TO SCALE 1944

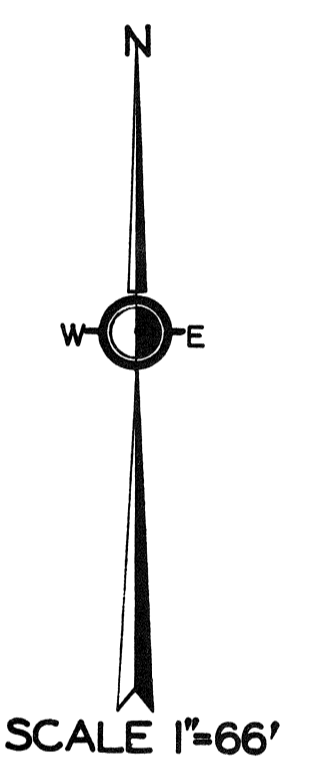


SEE PAGE SIX


8-21-42
JAN. 1, 1941
3-1-43
2-15-44

SEE PAGE NINE

MIDDLEFIELD VIL-7 NOT TO SCALE 1944

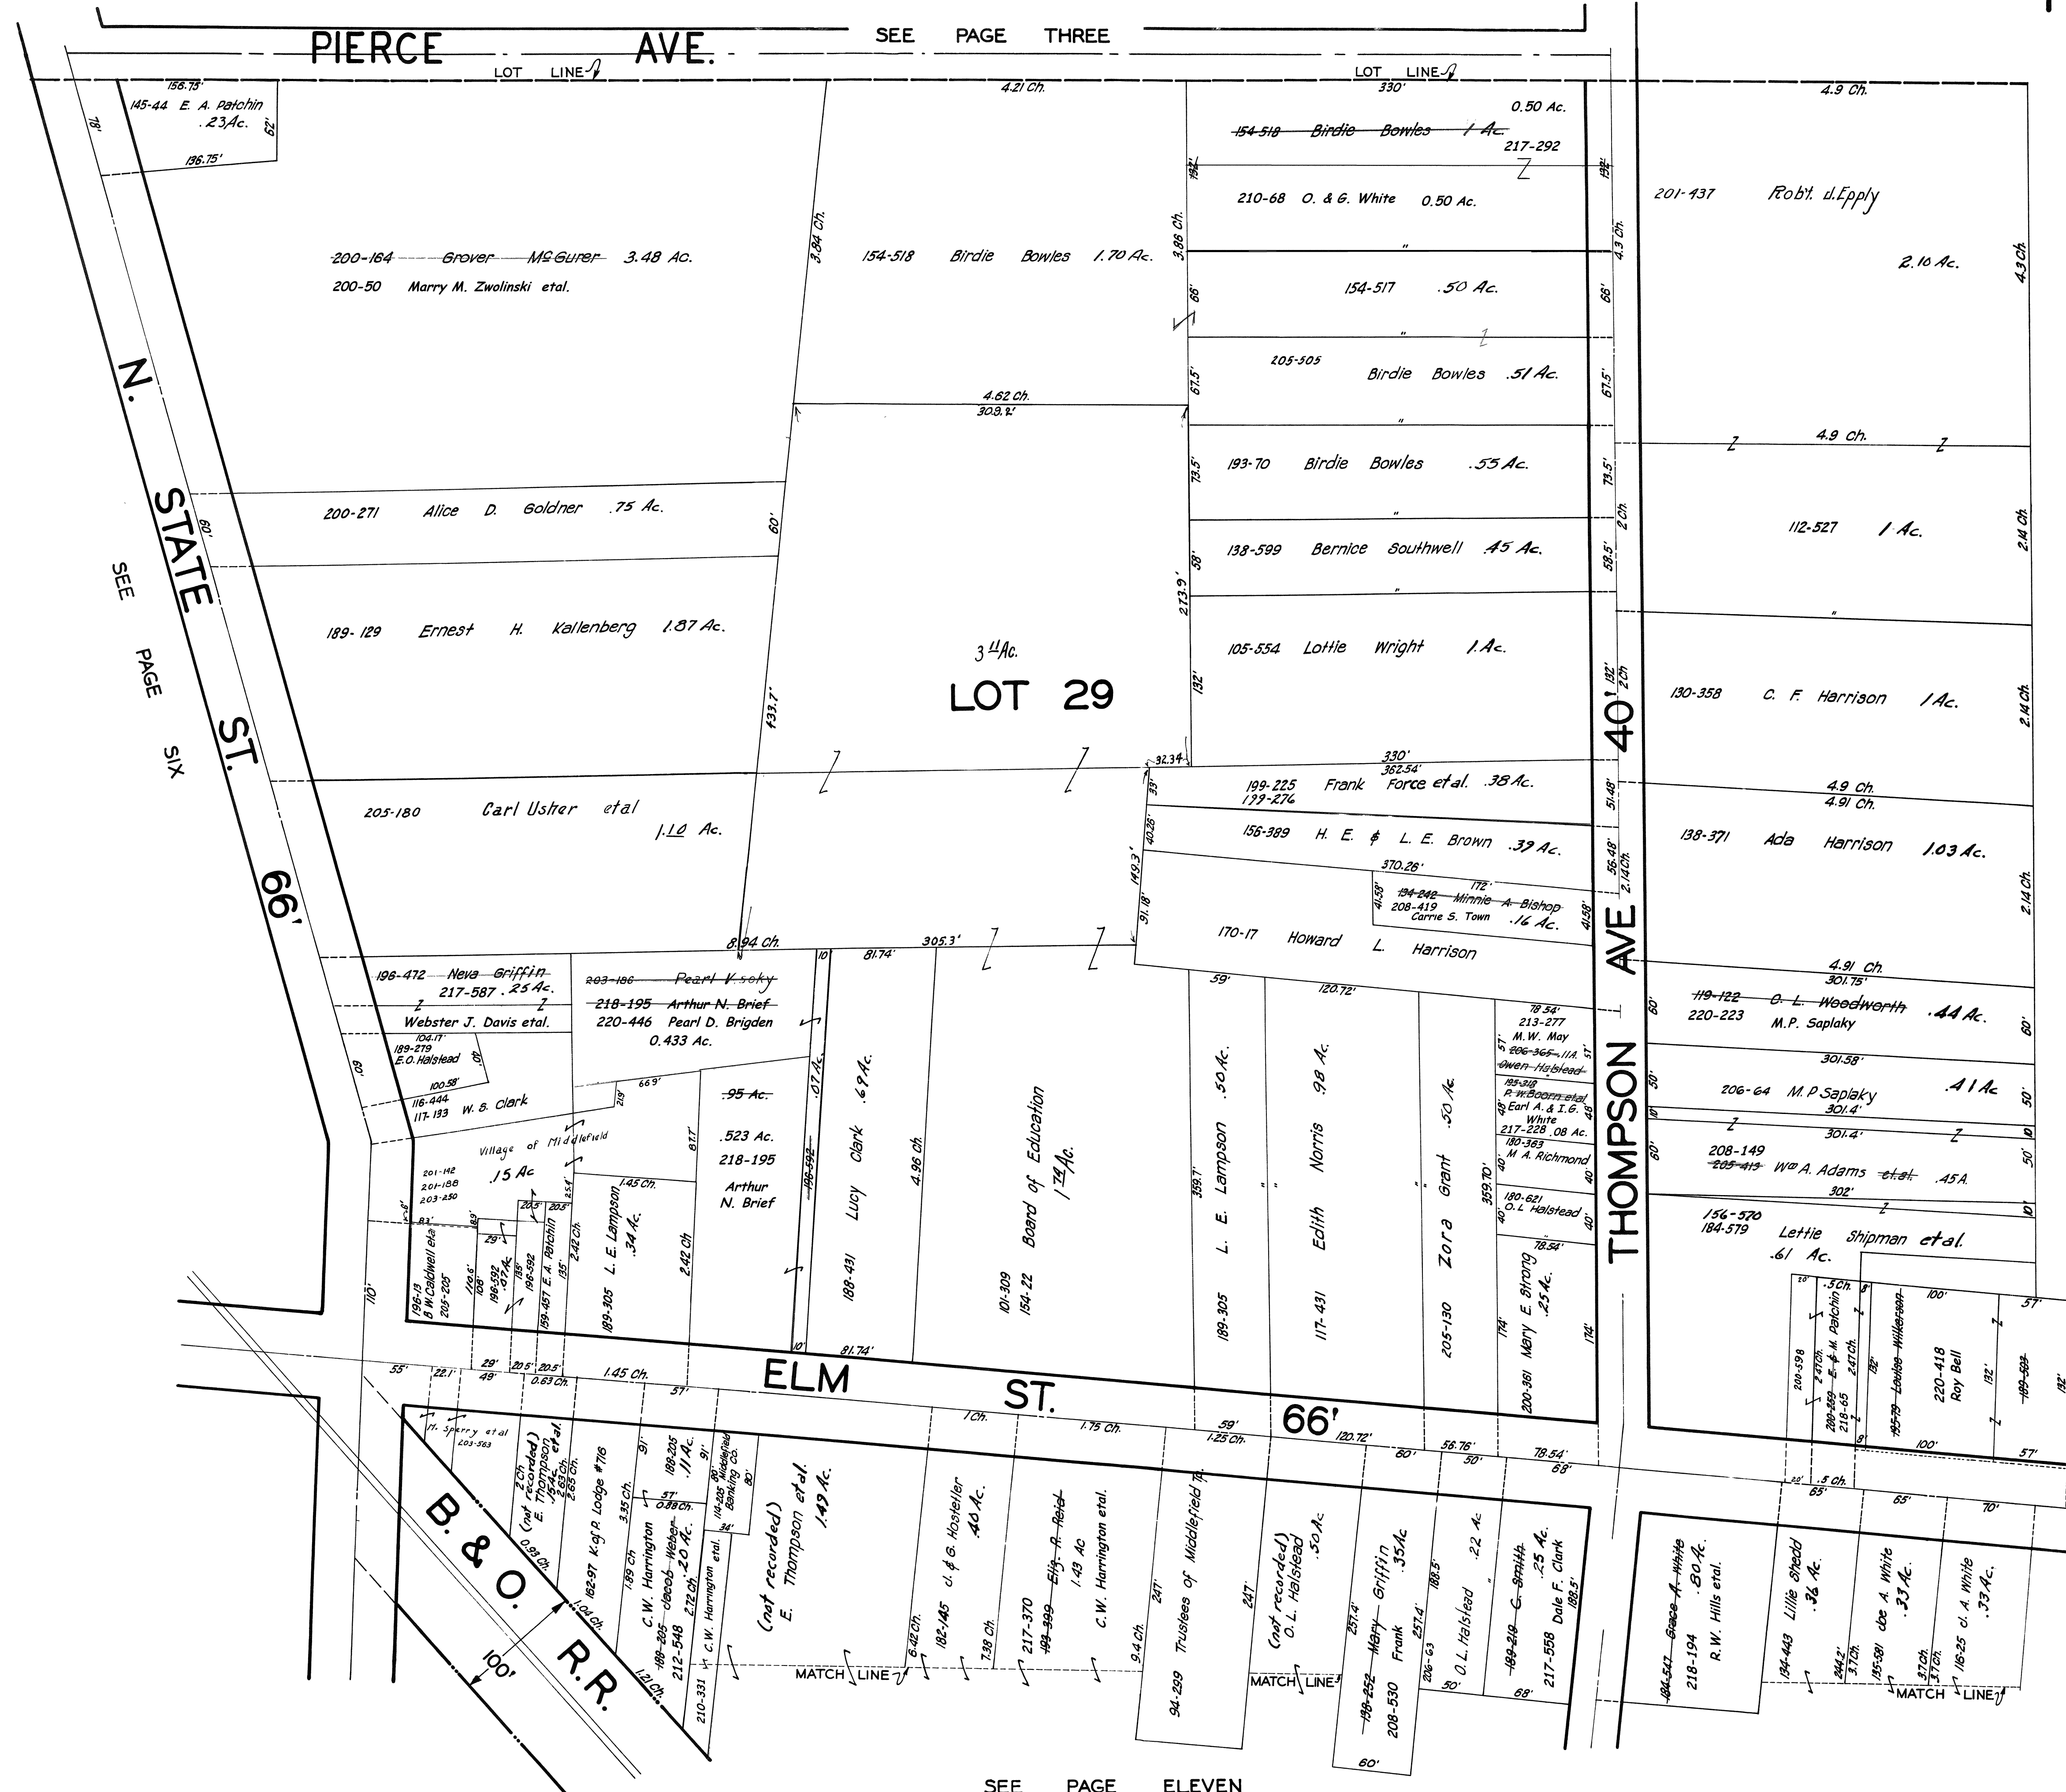

SEE PAGE EIGHT

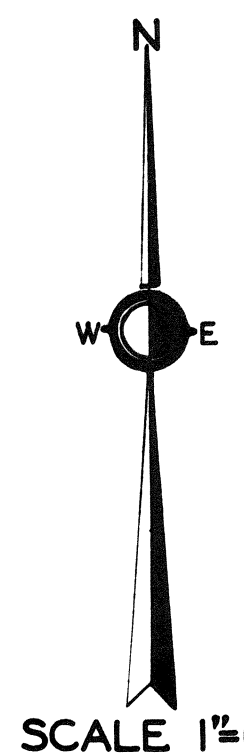


8-21-42
 JAN. 1, 1944
 3-1-43
 2-15-44

SEE PAGE FIVE

MIDDLEFIELD
VIL -9
NOT TO SCALE
1944




SEE PAGE TEN

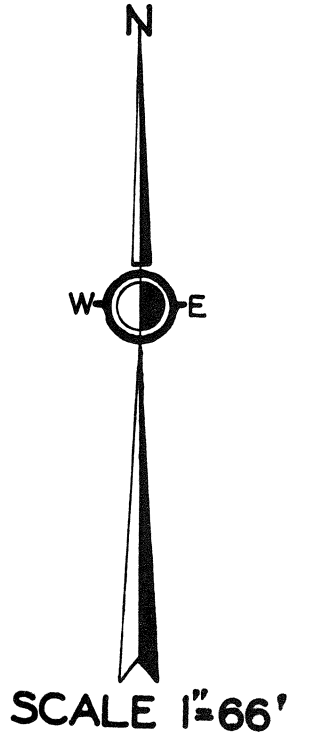

8-21-42
JAN. 1, 1941
3-1-43
2-15-44


SEE PAGE THIRTEEN

SEE PAGE SIX

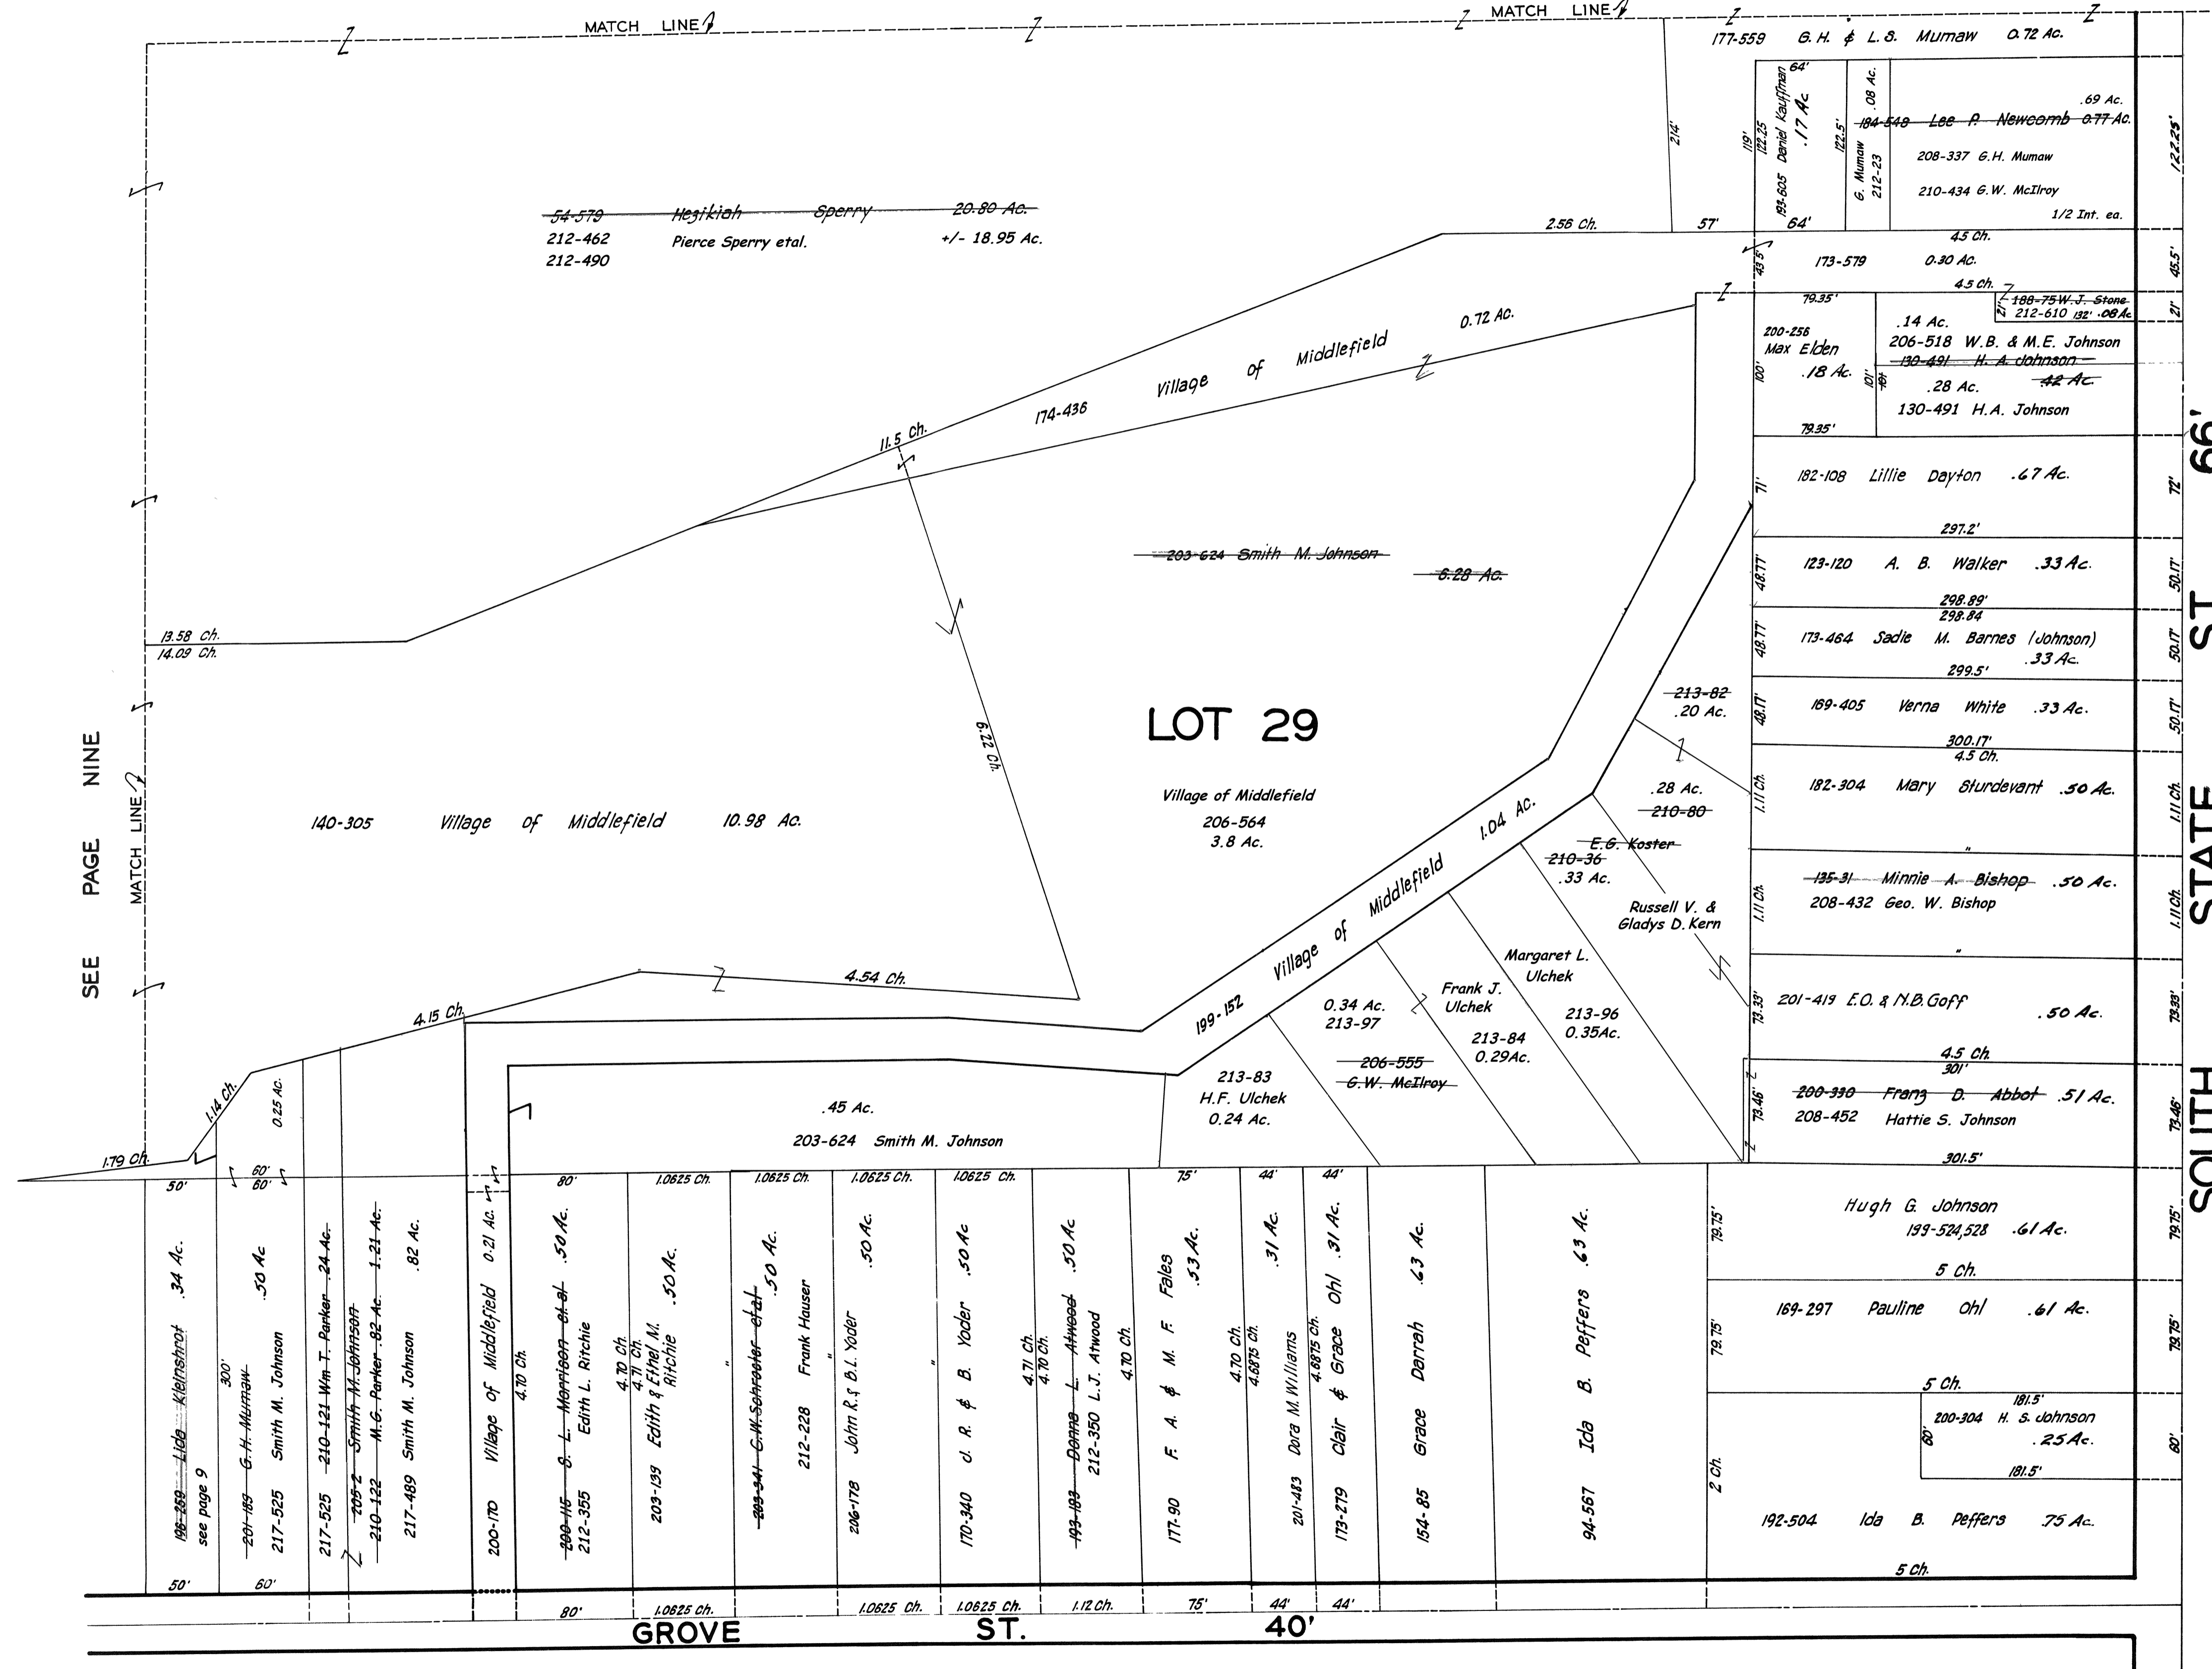

SEE PAGE NINE


SEE PAGE ELEVEN

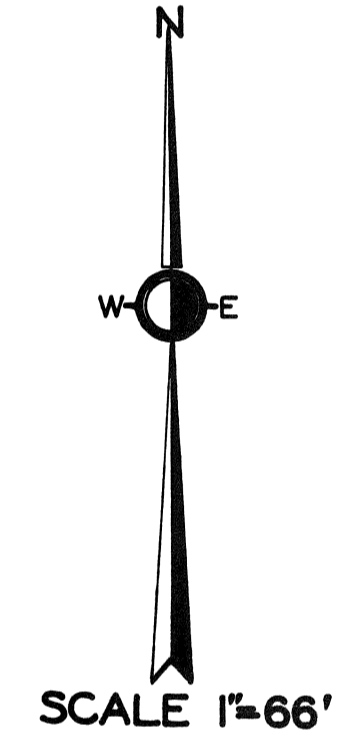

JAN 1, 1941
2-15-41

**MIDDLEFIELD
VIL - 10
NOT TO SCALE
1944**

SEE PAGE FOURTEEN

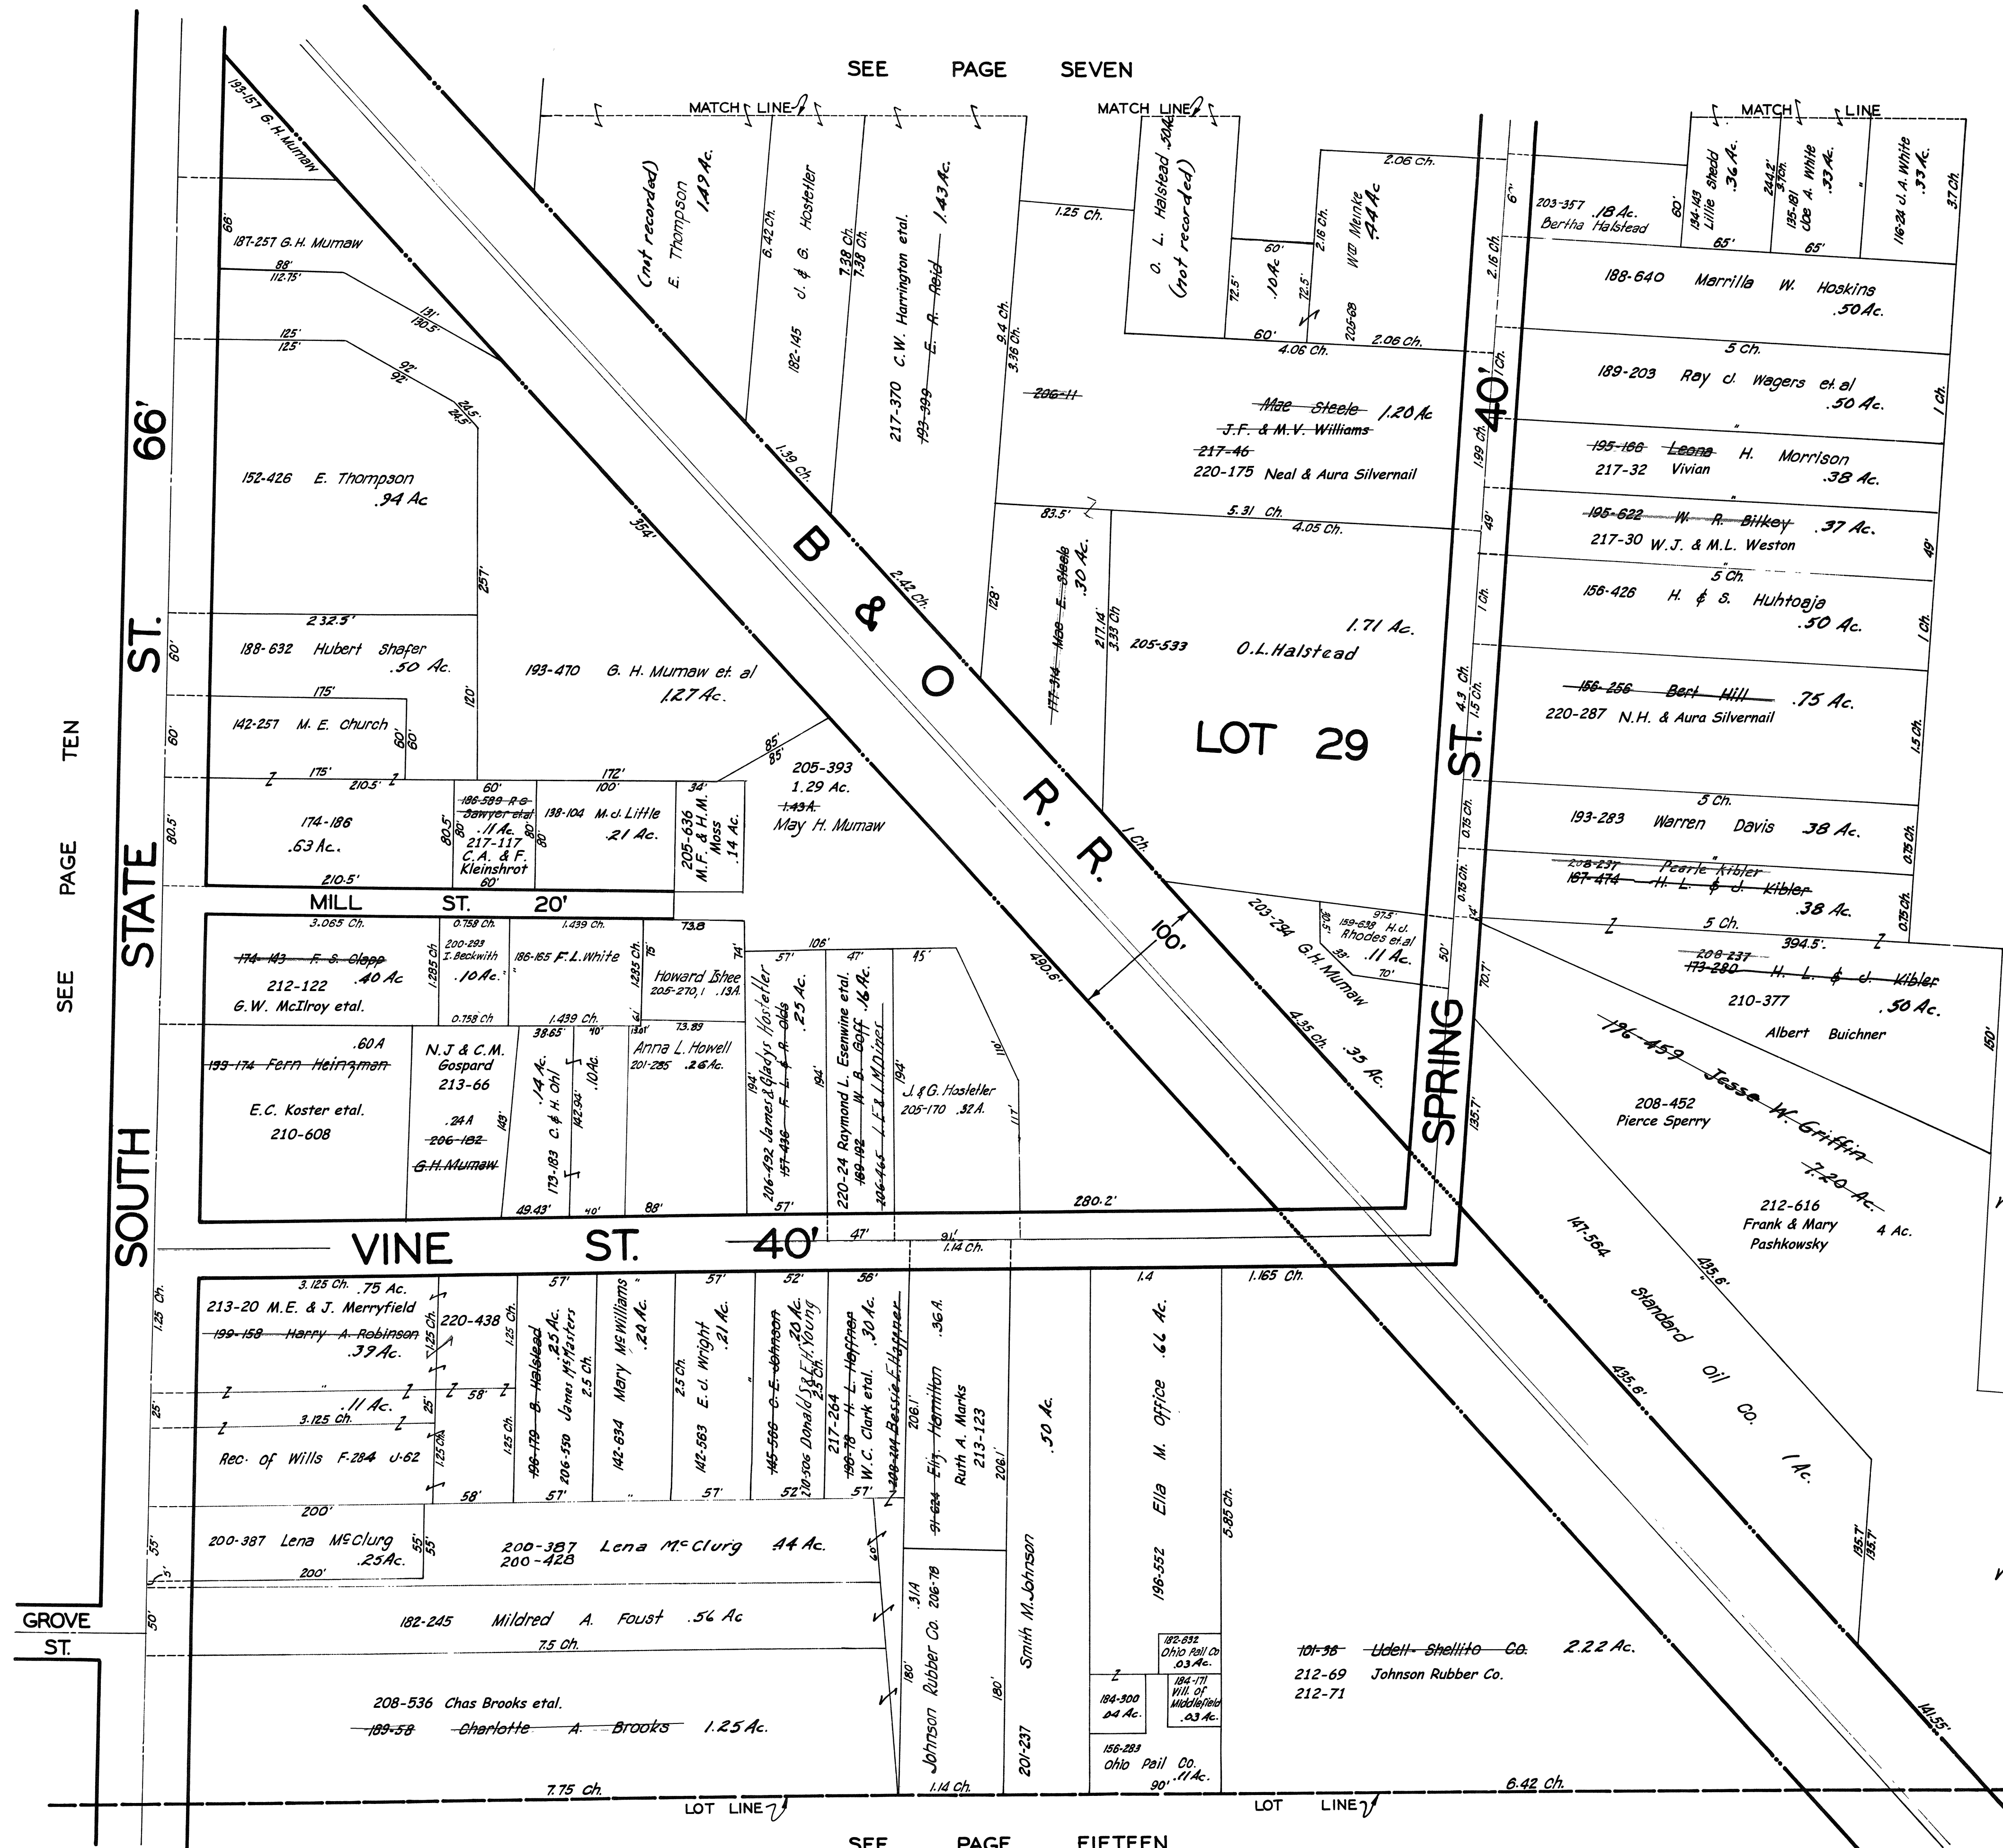


SEE PAGE TEN
 SOUTH STATE ST. 66'
 SEE PAGE TEN
 SOUTH STATE ST. 66'
 SEE PAGE TEN
 SOUTH STATE ST. 66'

SEE PAGE SEVEN

SEE PAGE FIFTEEN



SEE PAGE TWELVE

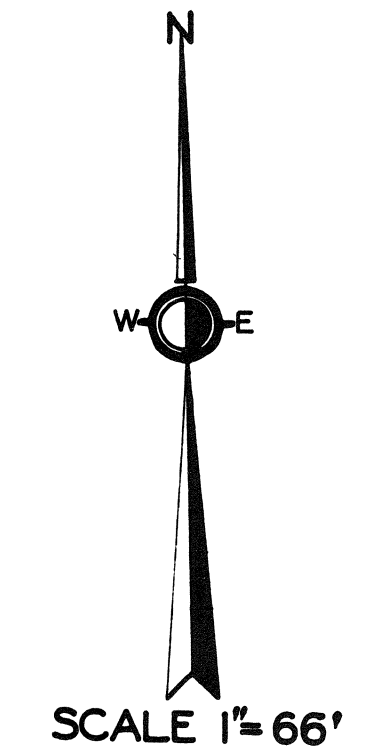

JAN. 1, 1941

**MIDDLEFIELD
 VIL - 11
 NOT TO SCALE
 1944**

SEE PAGE EIGHT

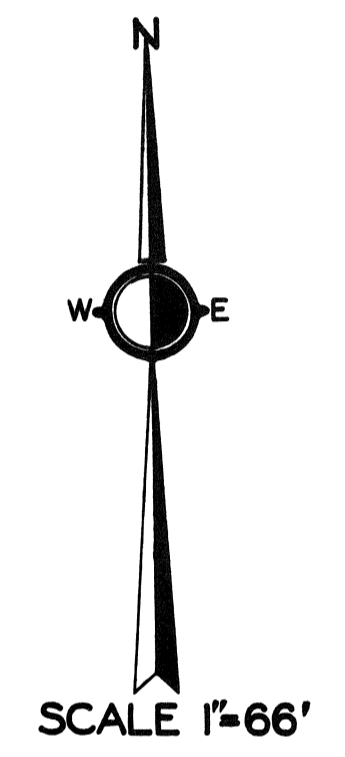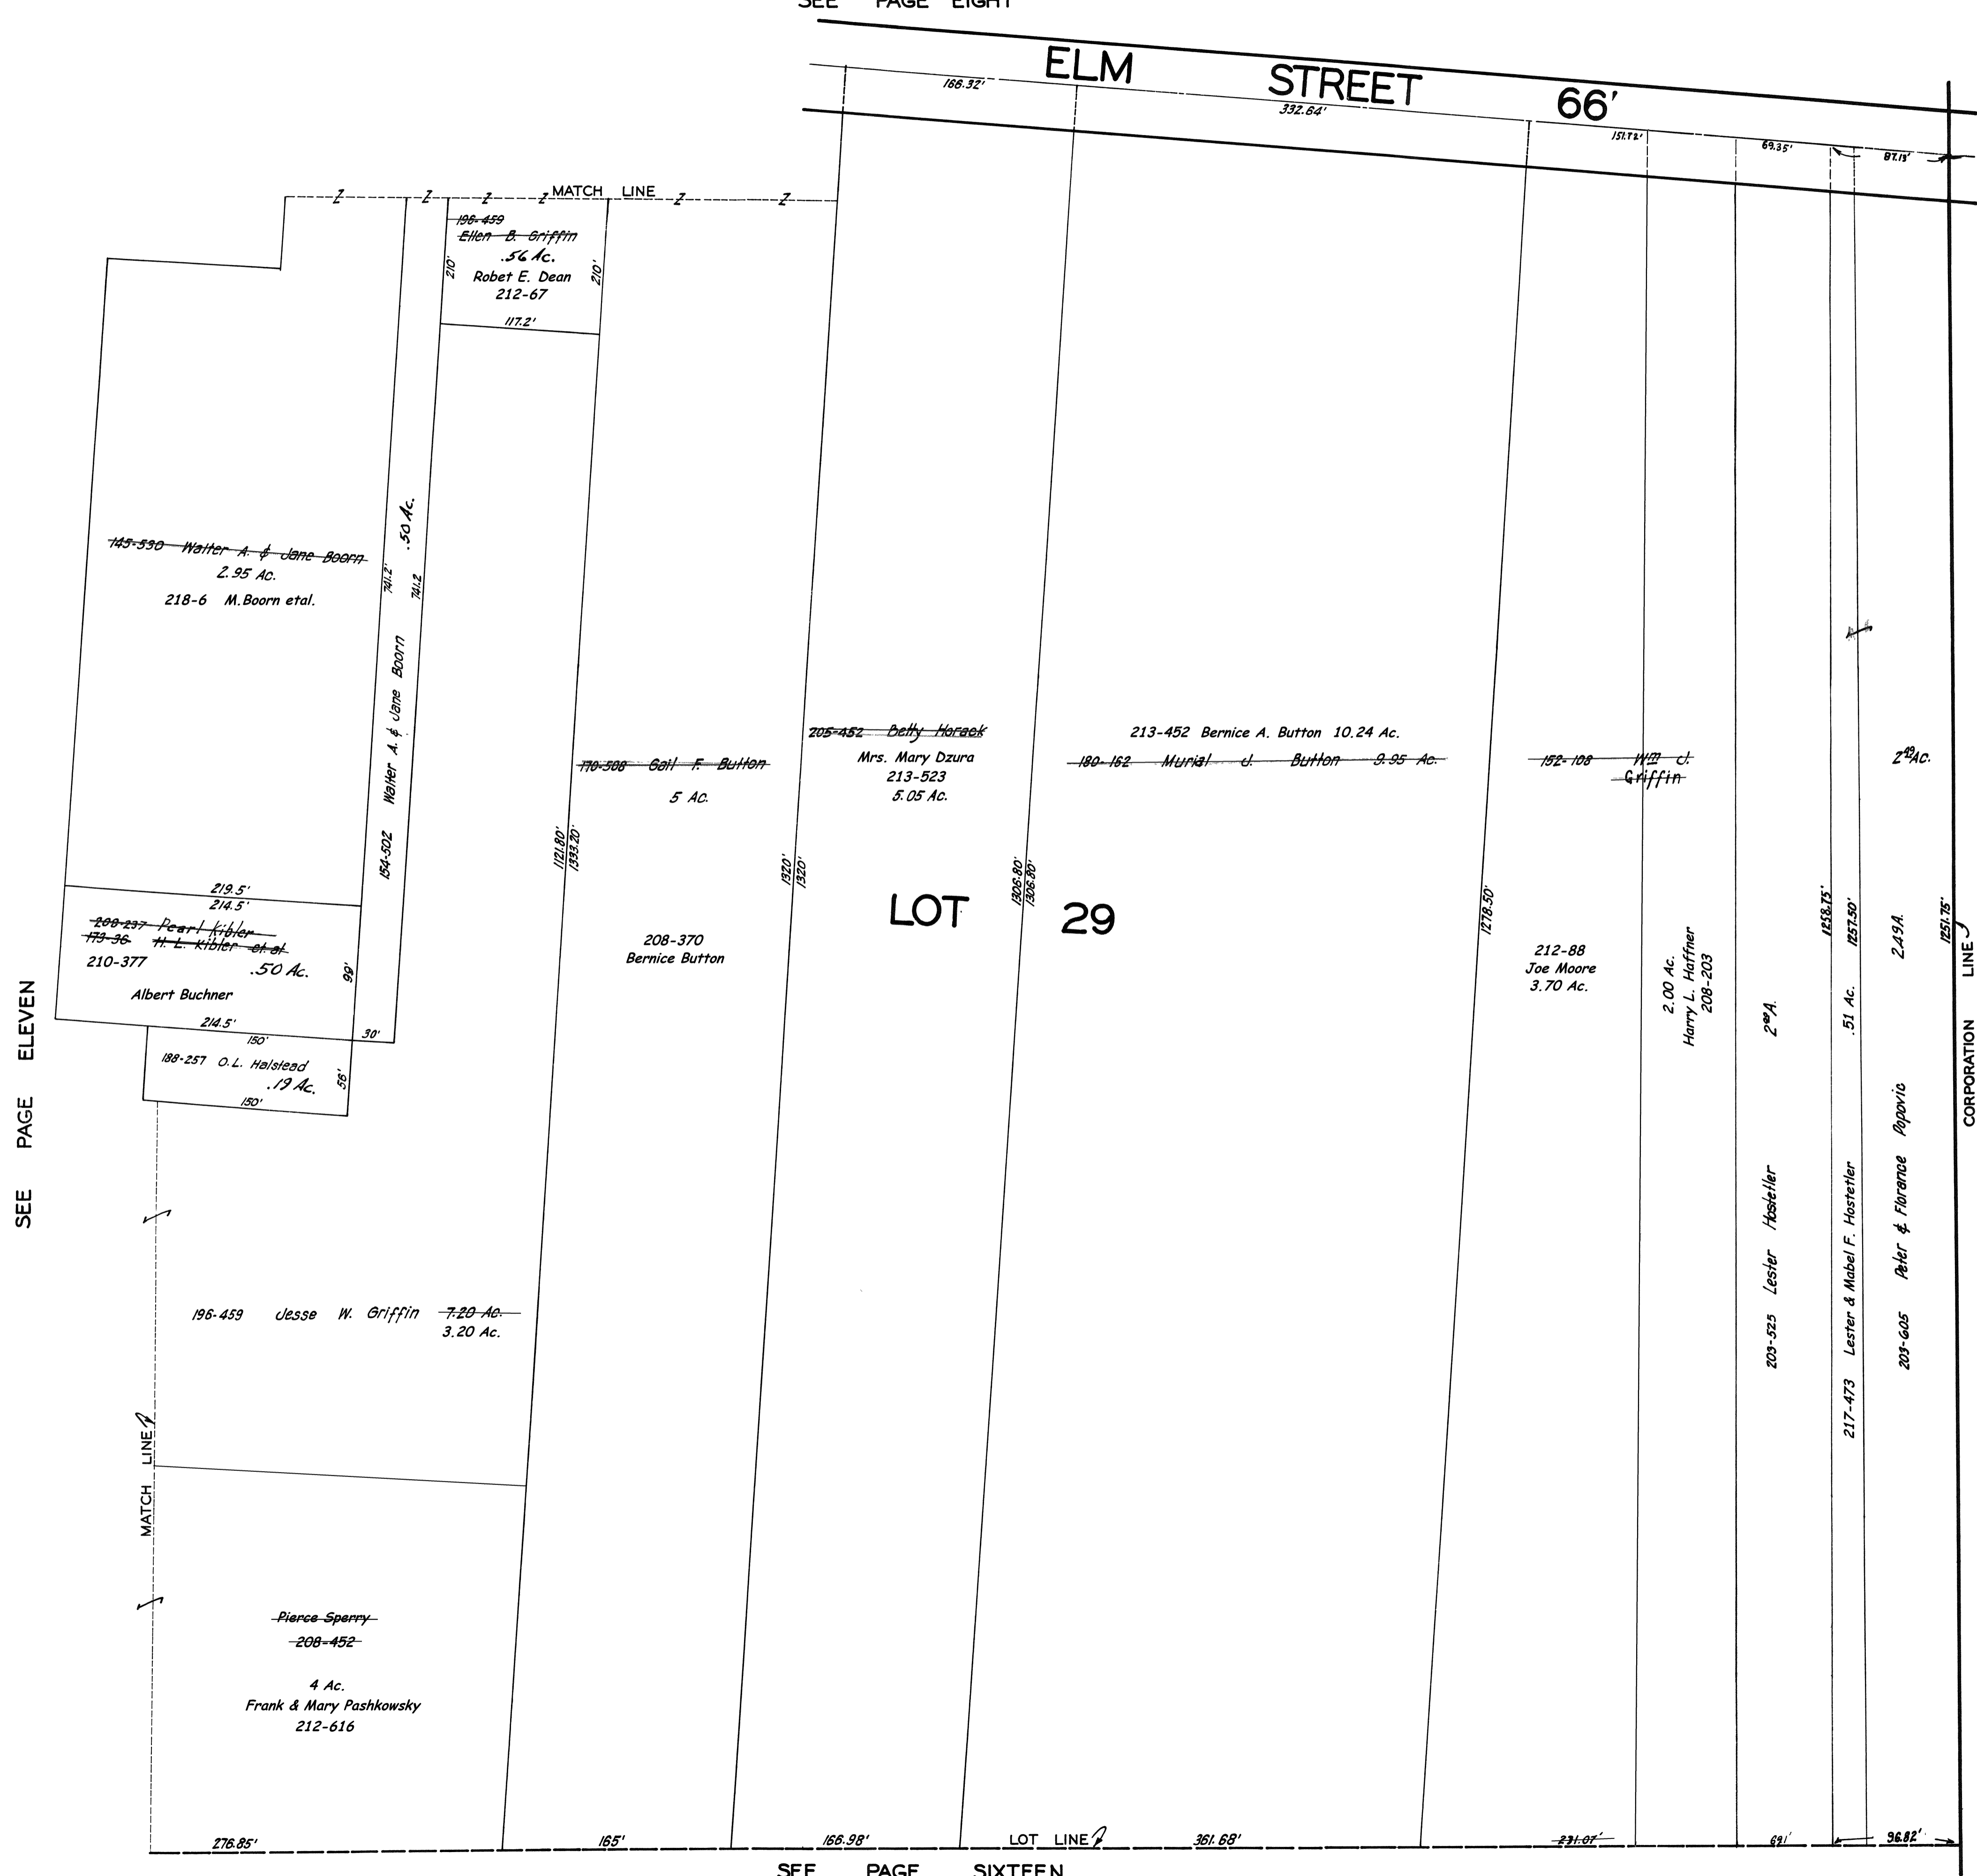


JAN. 1, 1941
2 15 44

**MIDDLEFIELD
VIL - 12
NOT TO SCALE
1944**

SEE PAGE ELEVEN


SEE PAGE SIXTEEN

SEE PAGE TEN

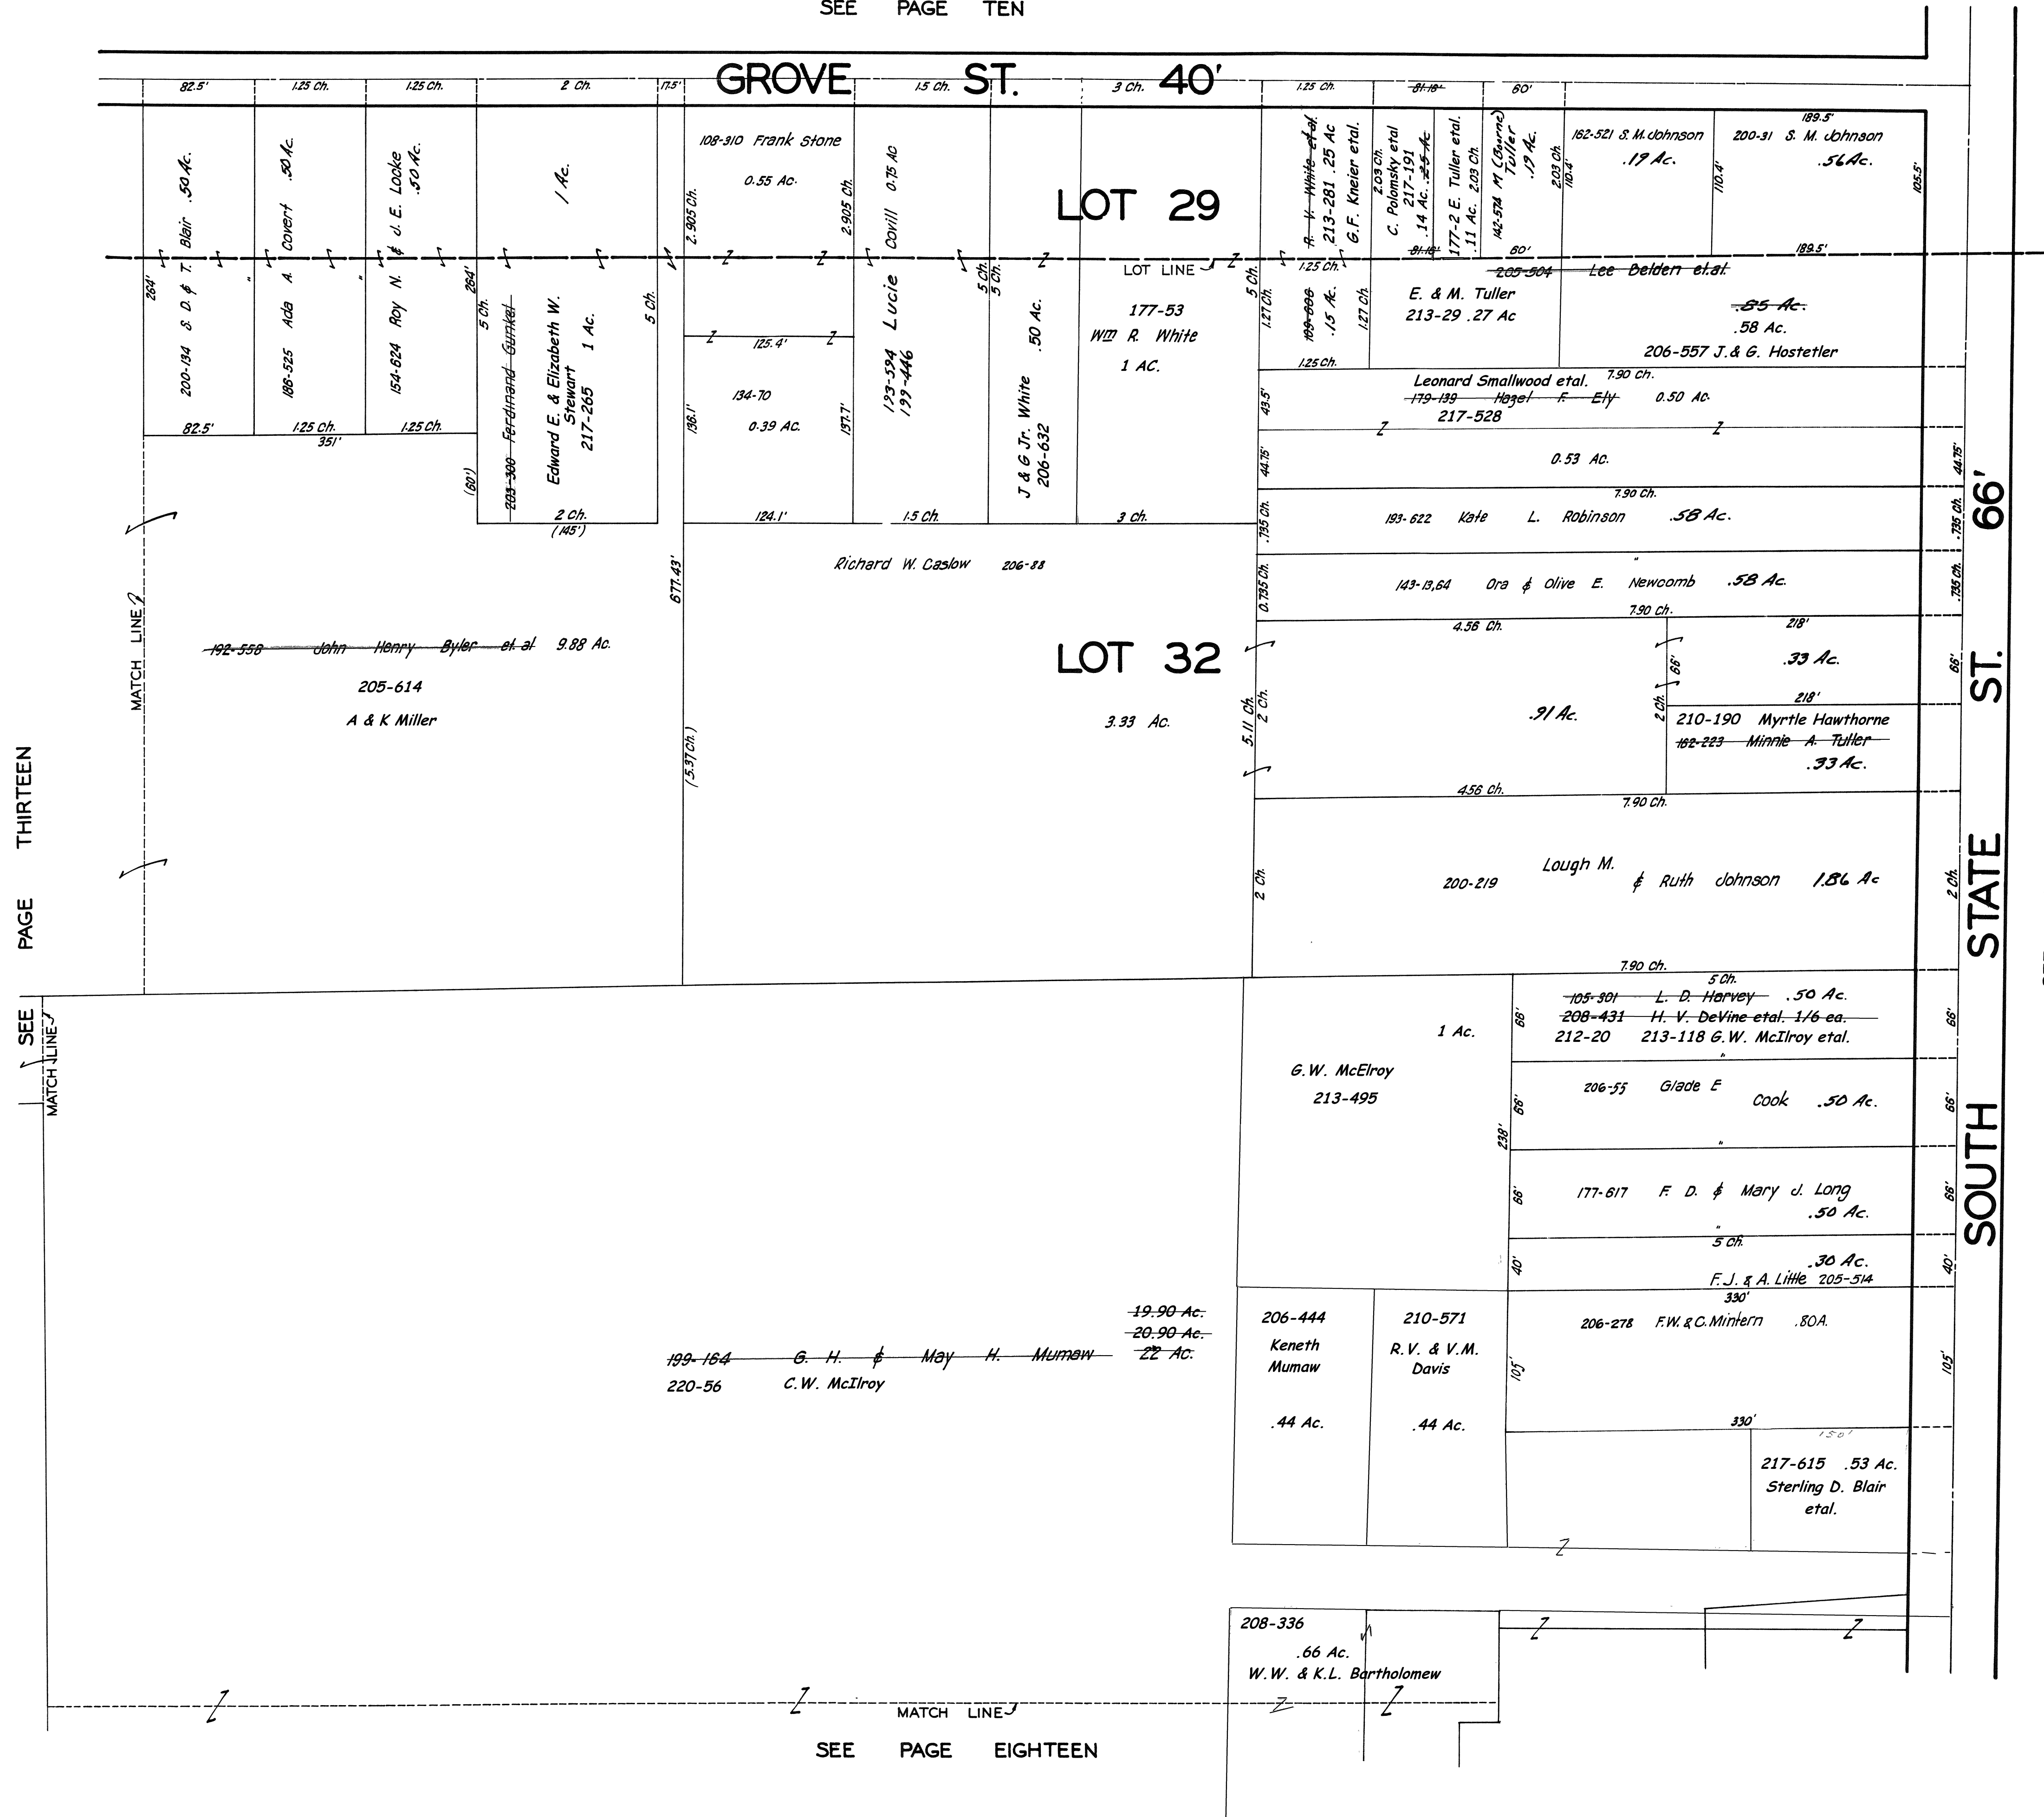

PAGE THIRTEEN



SEE PAGE EIGHTEEN

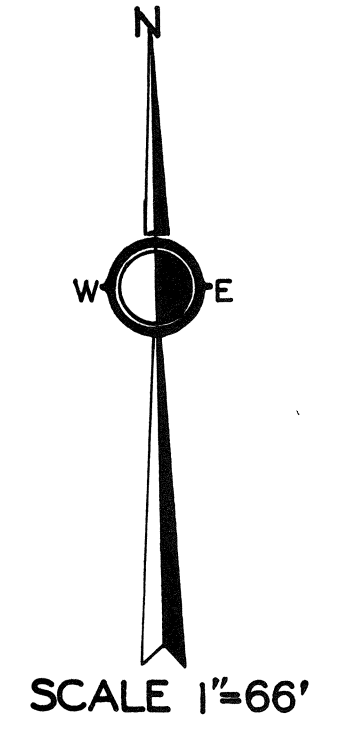

JAN 11 1941
 2-15-14

SEE PAGE FIFTEEN

**MIDDLEFIELD
 VIL - 14
 NOT TO SCALE
 1944**

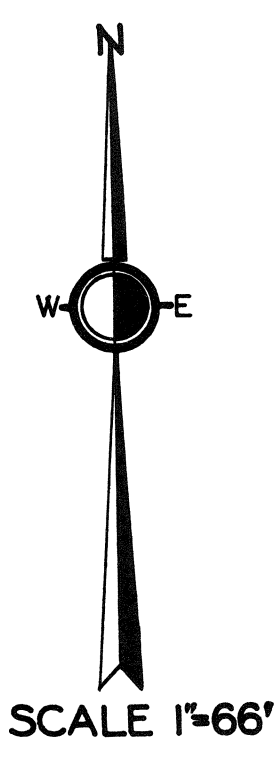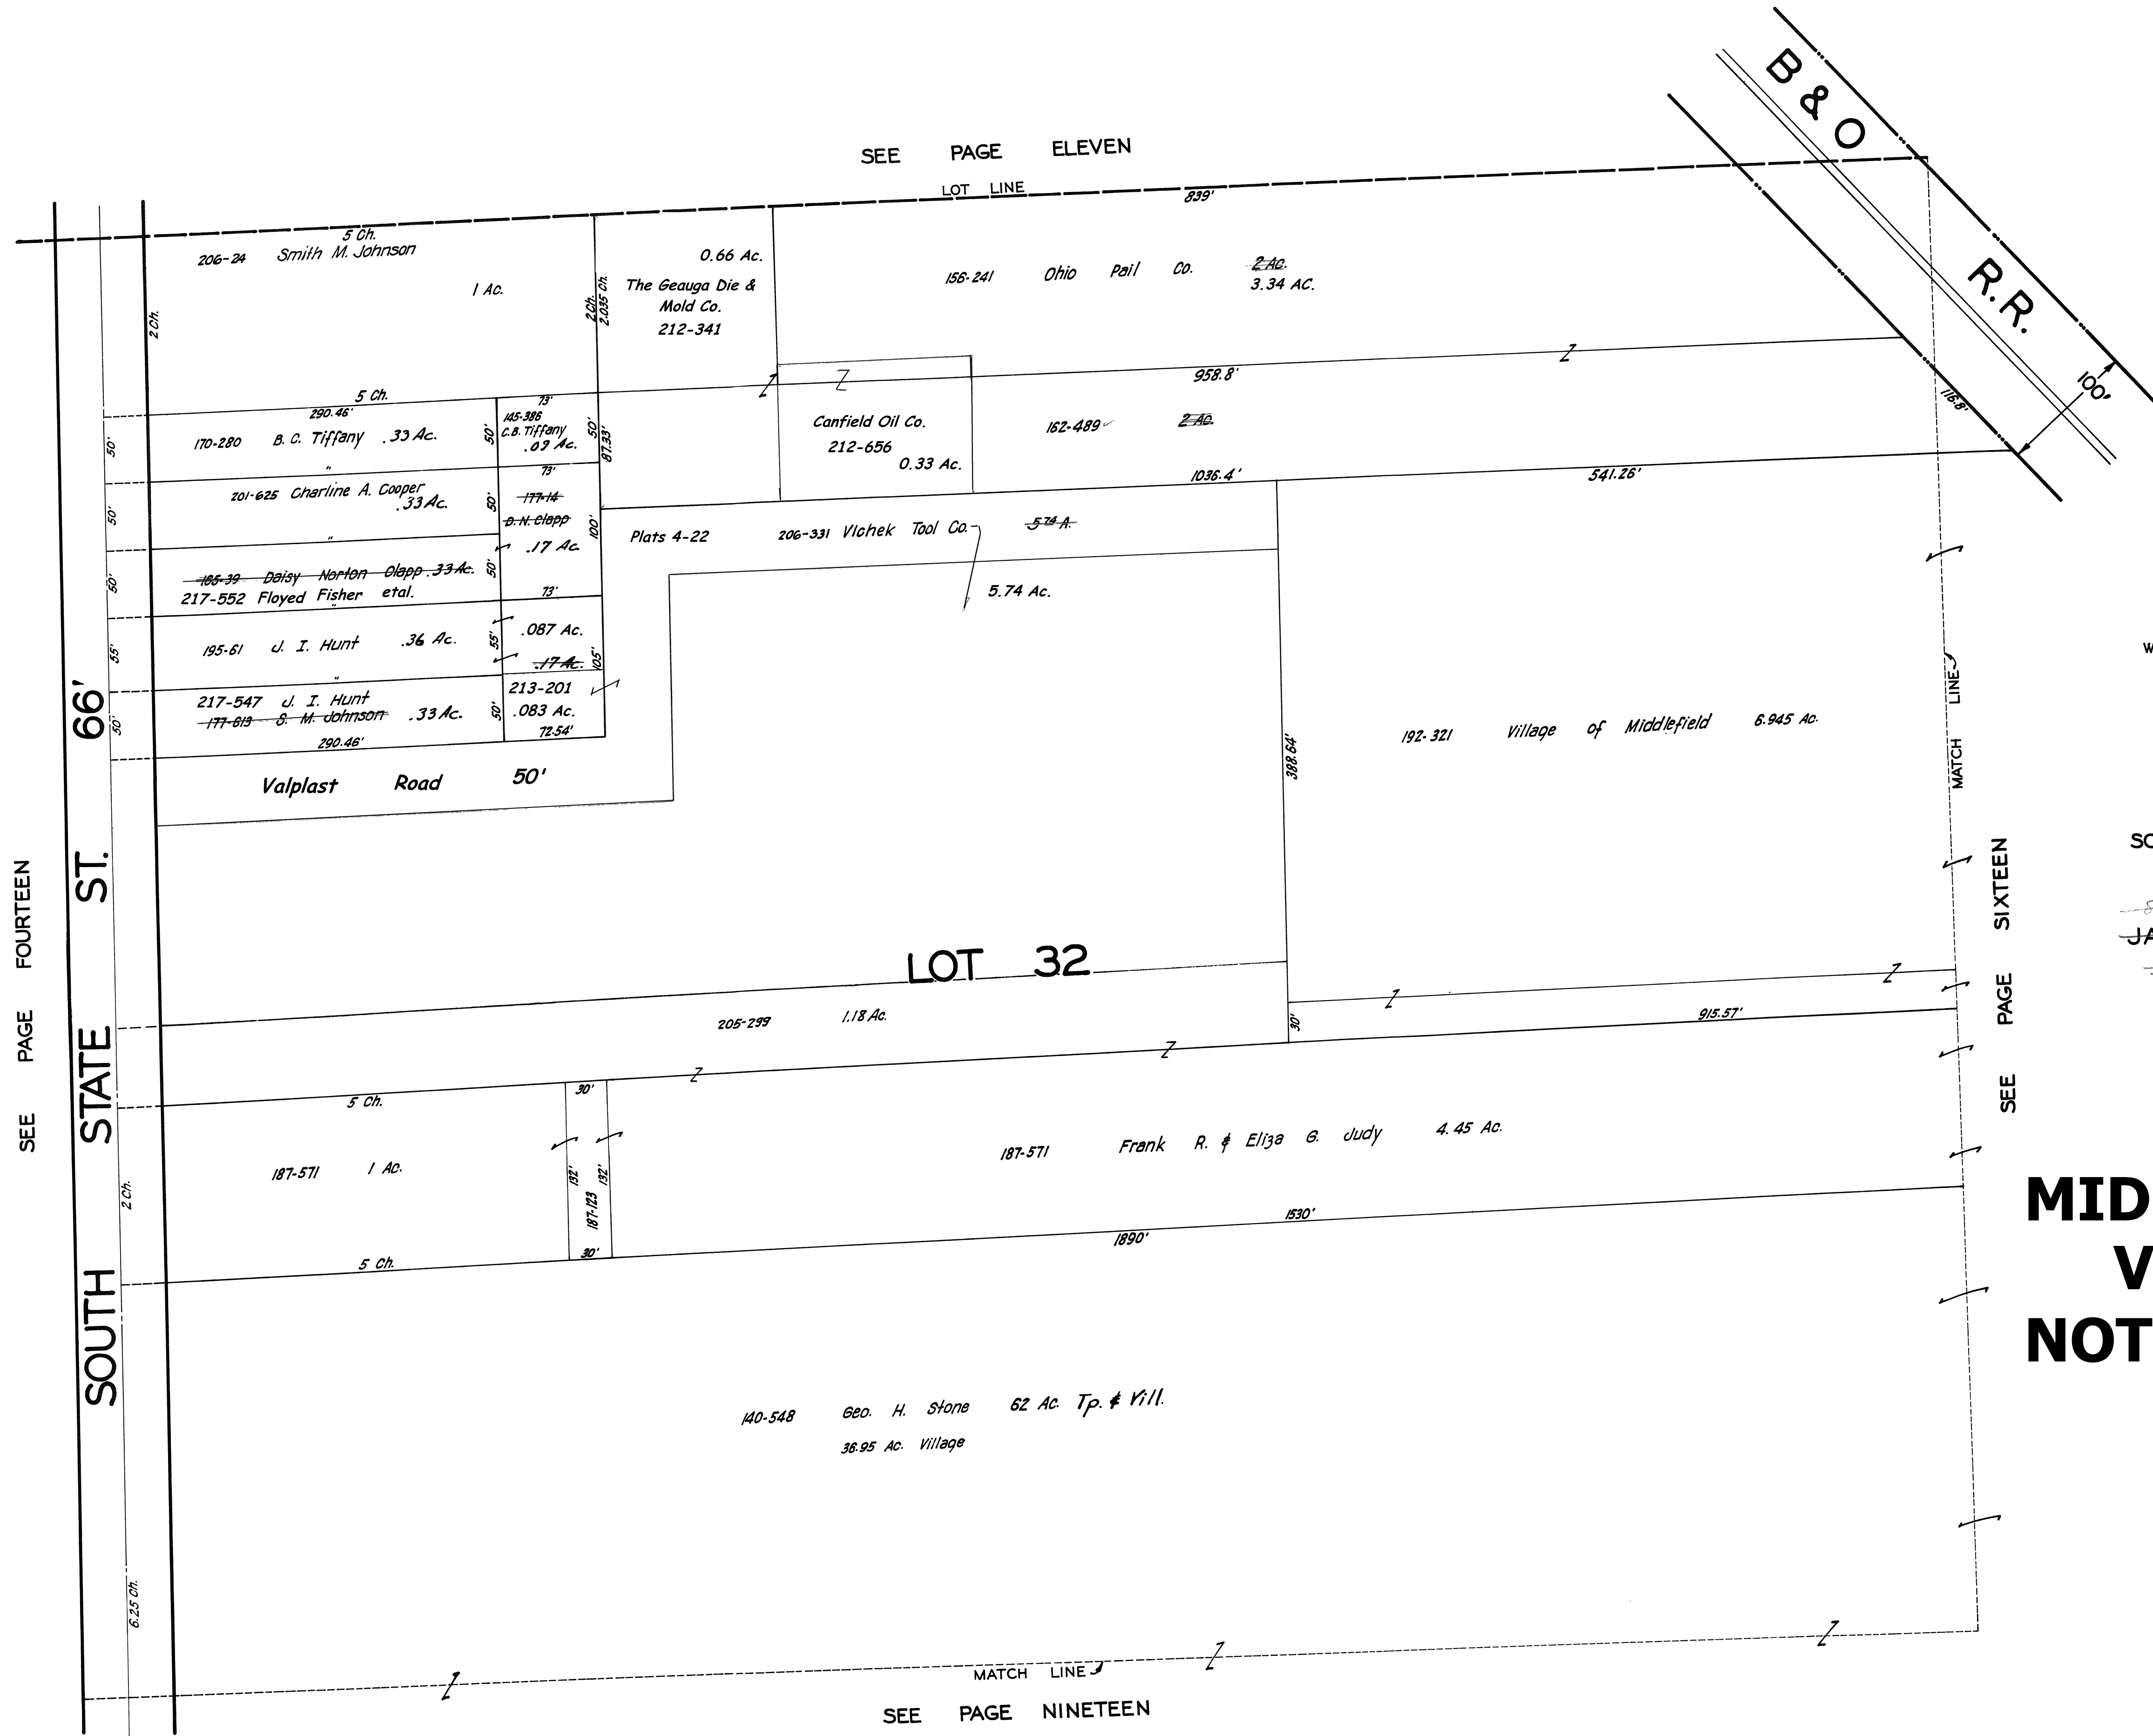


SCALE 1"=66'

JAN. 1, 1941

2 15 47


**MIDDLEFIELD
VIL - 15
NOT TO SCALE
1944**

SEE PAGE TWELVE

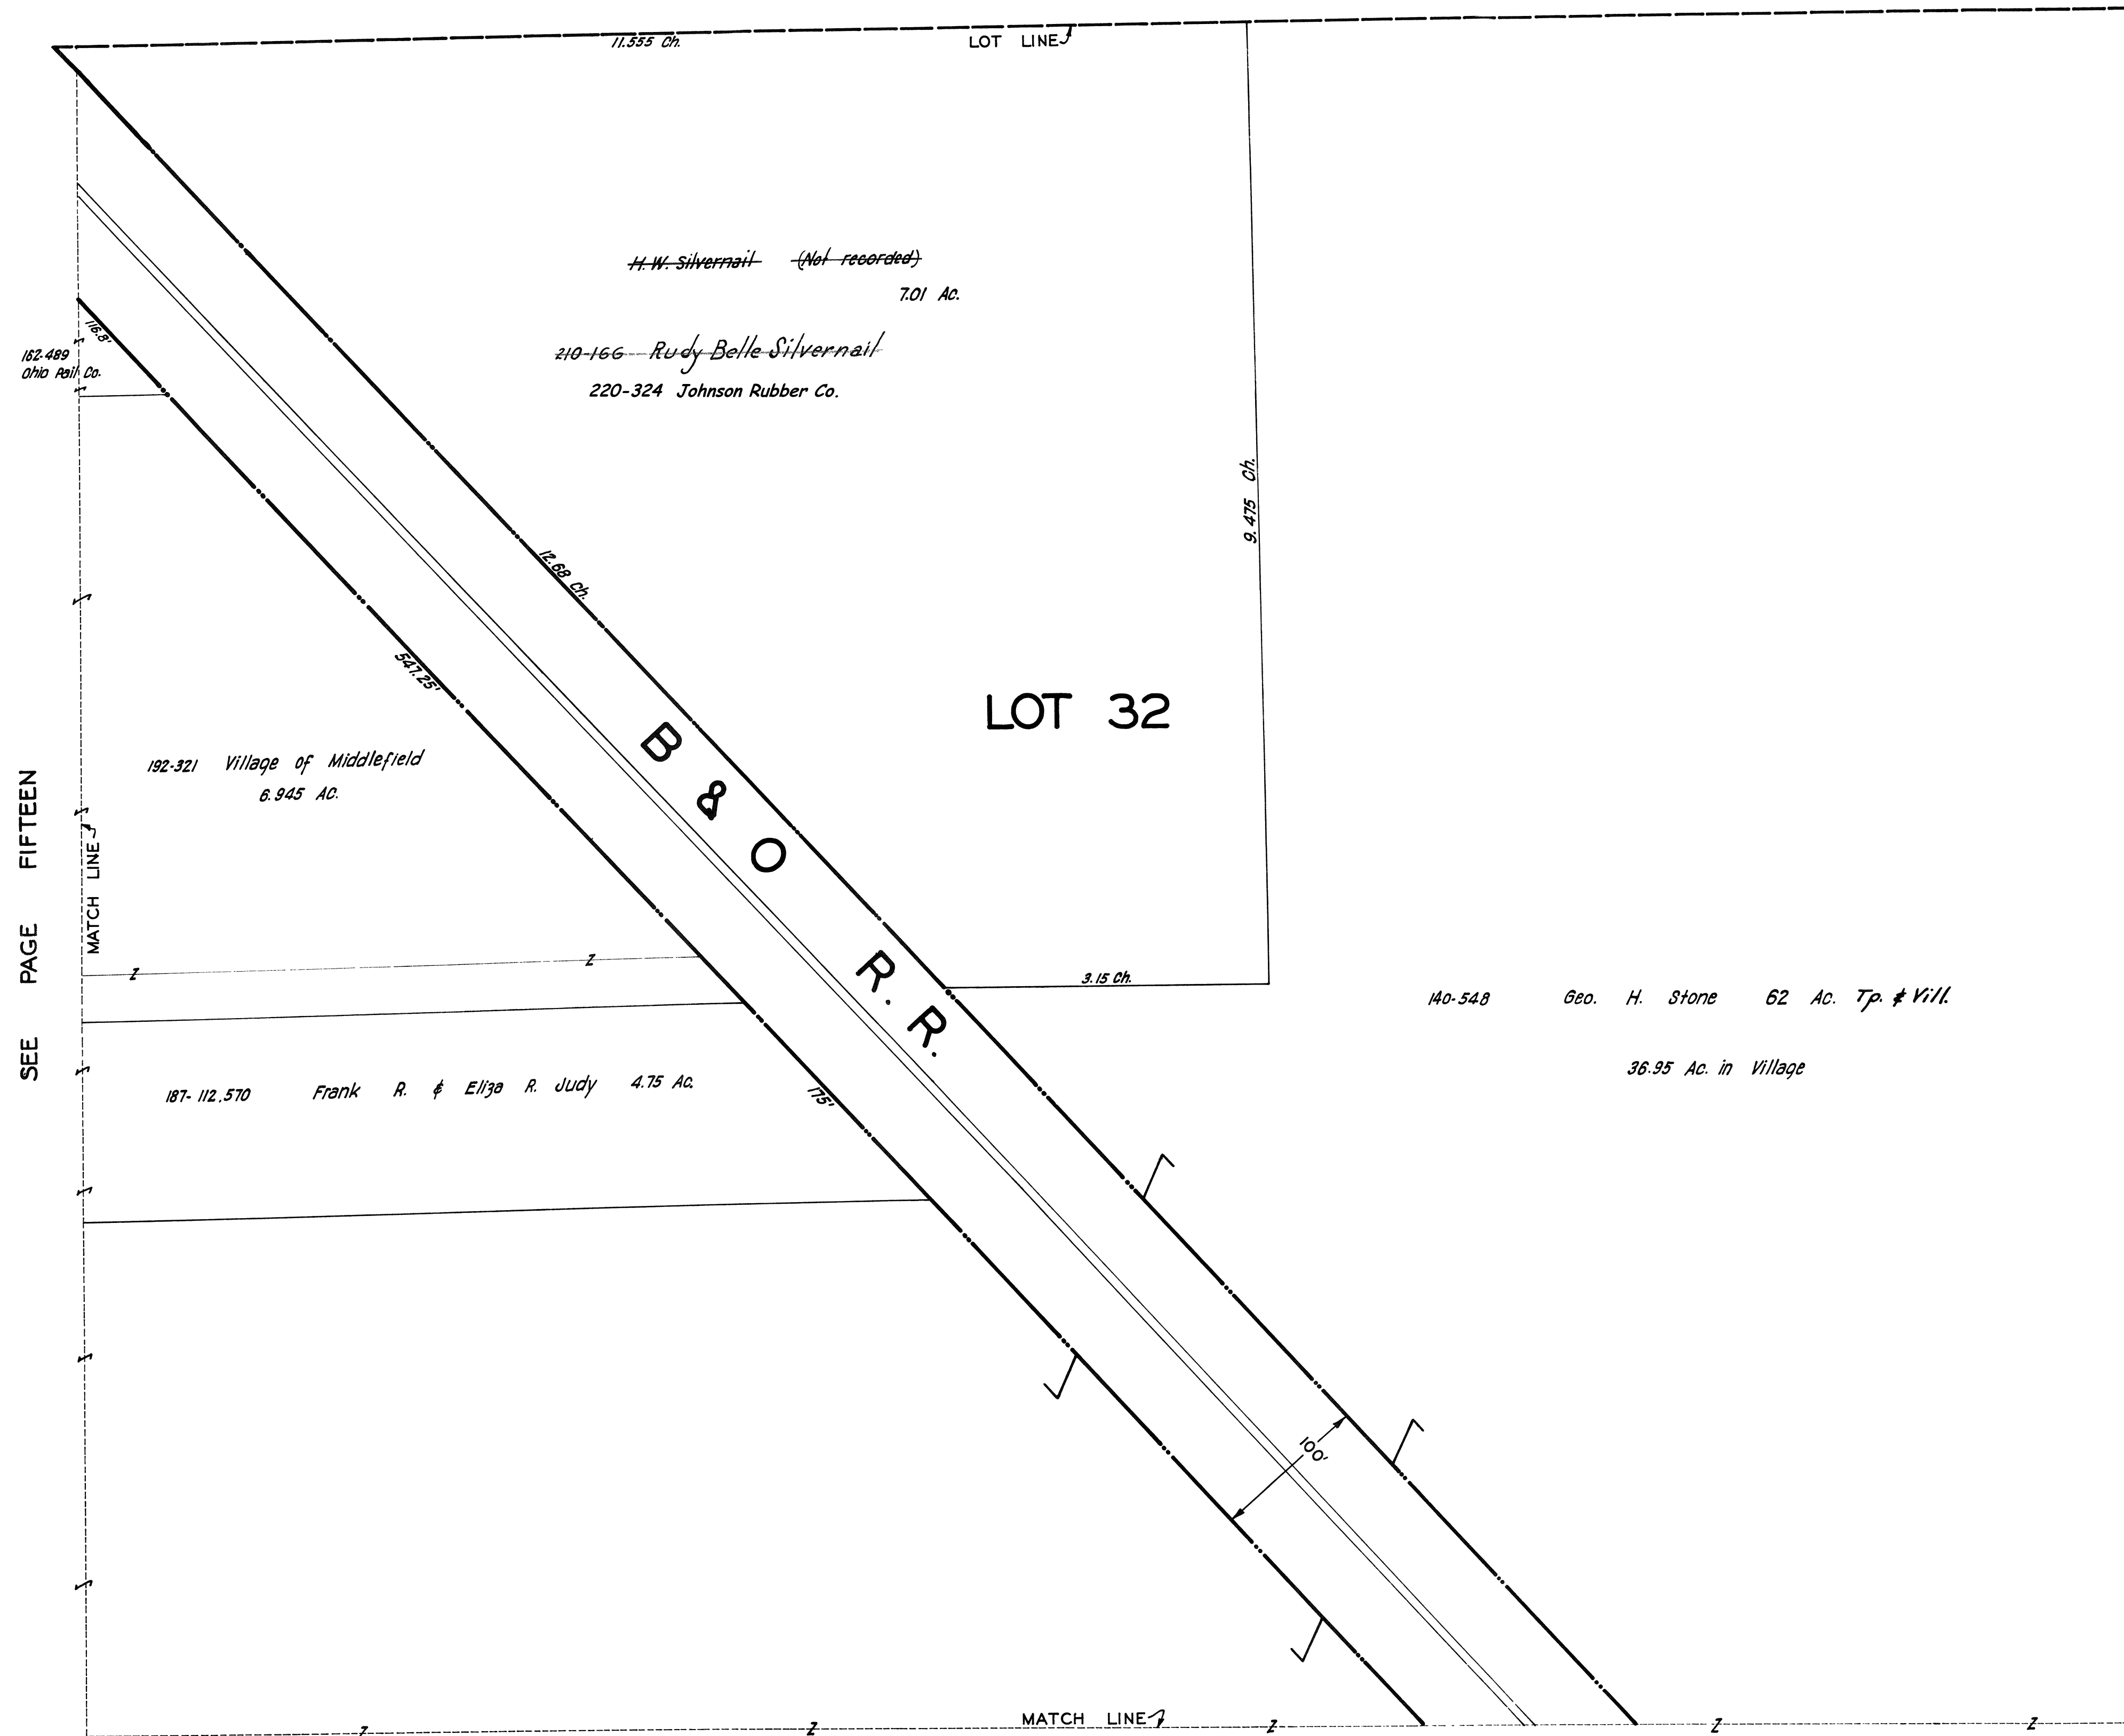

SEE PAGE FIFTEEN

SEE PAGE TWENTY

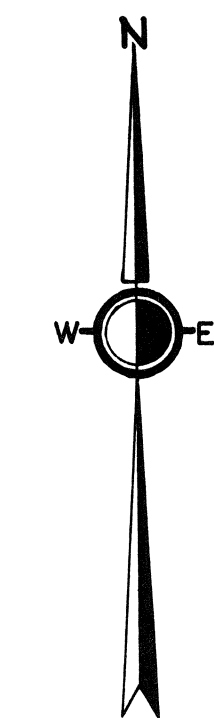



SCALE 1"=66'

JAN. 1, 1941

2 15 '14

**MIDDLEFIELD
VIL - 16
NOT TO SCALE
1944**

SEE PAGE THIRTEEN

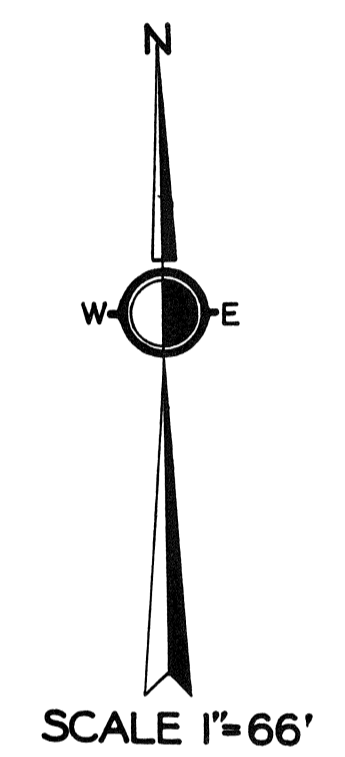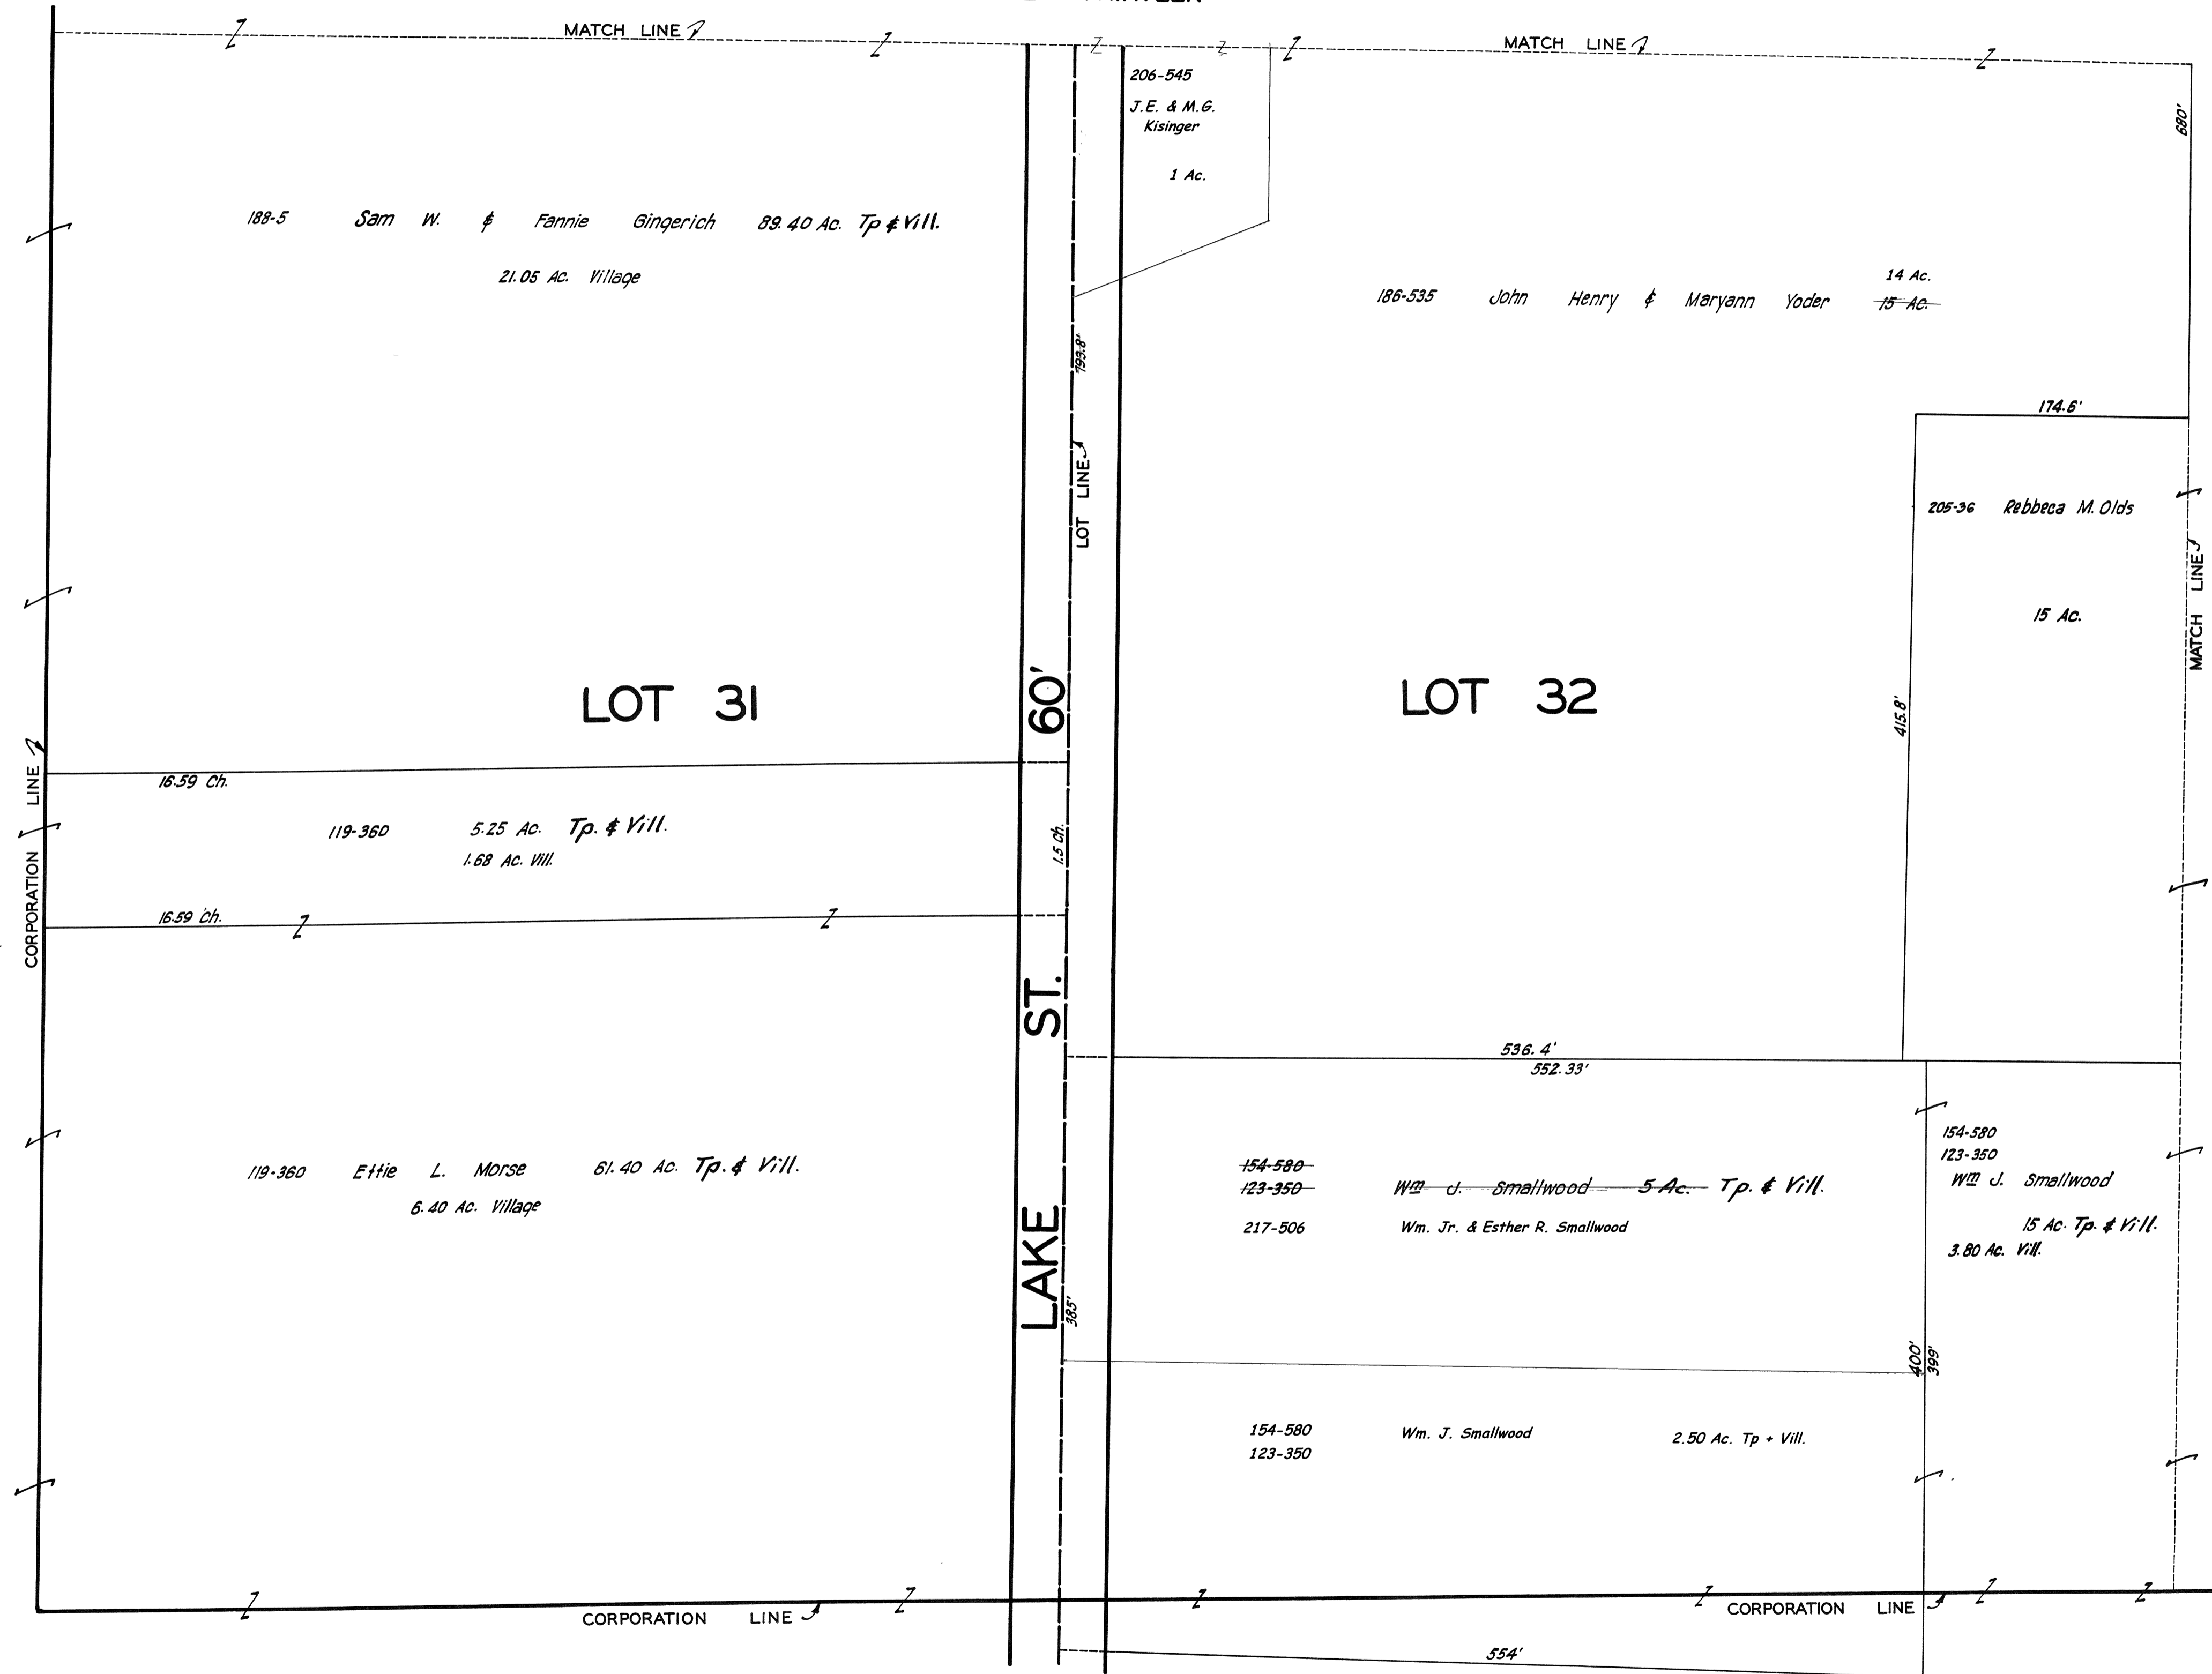



SCALE 1"=66'

JAN. 1, 1941

2-15-44

SEE PAGE EIGHTEEN

**MIDDLEFIELD
VIL - 17
NOT TO SCALE
1944**

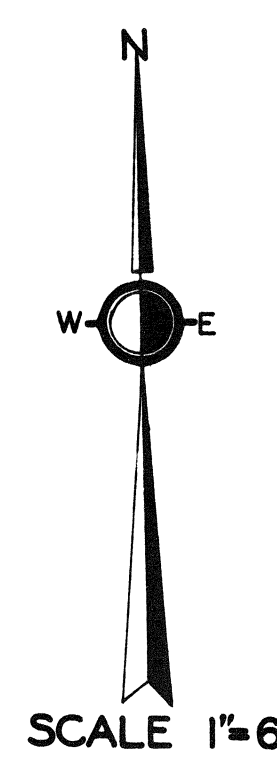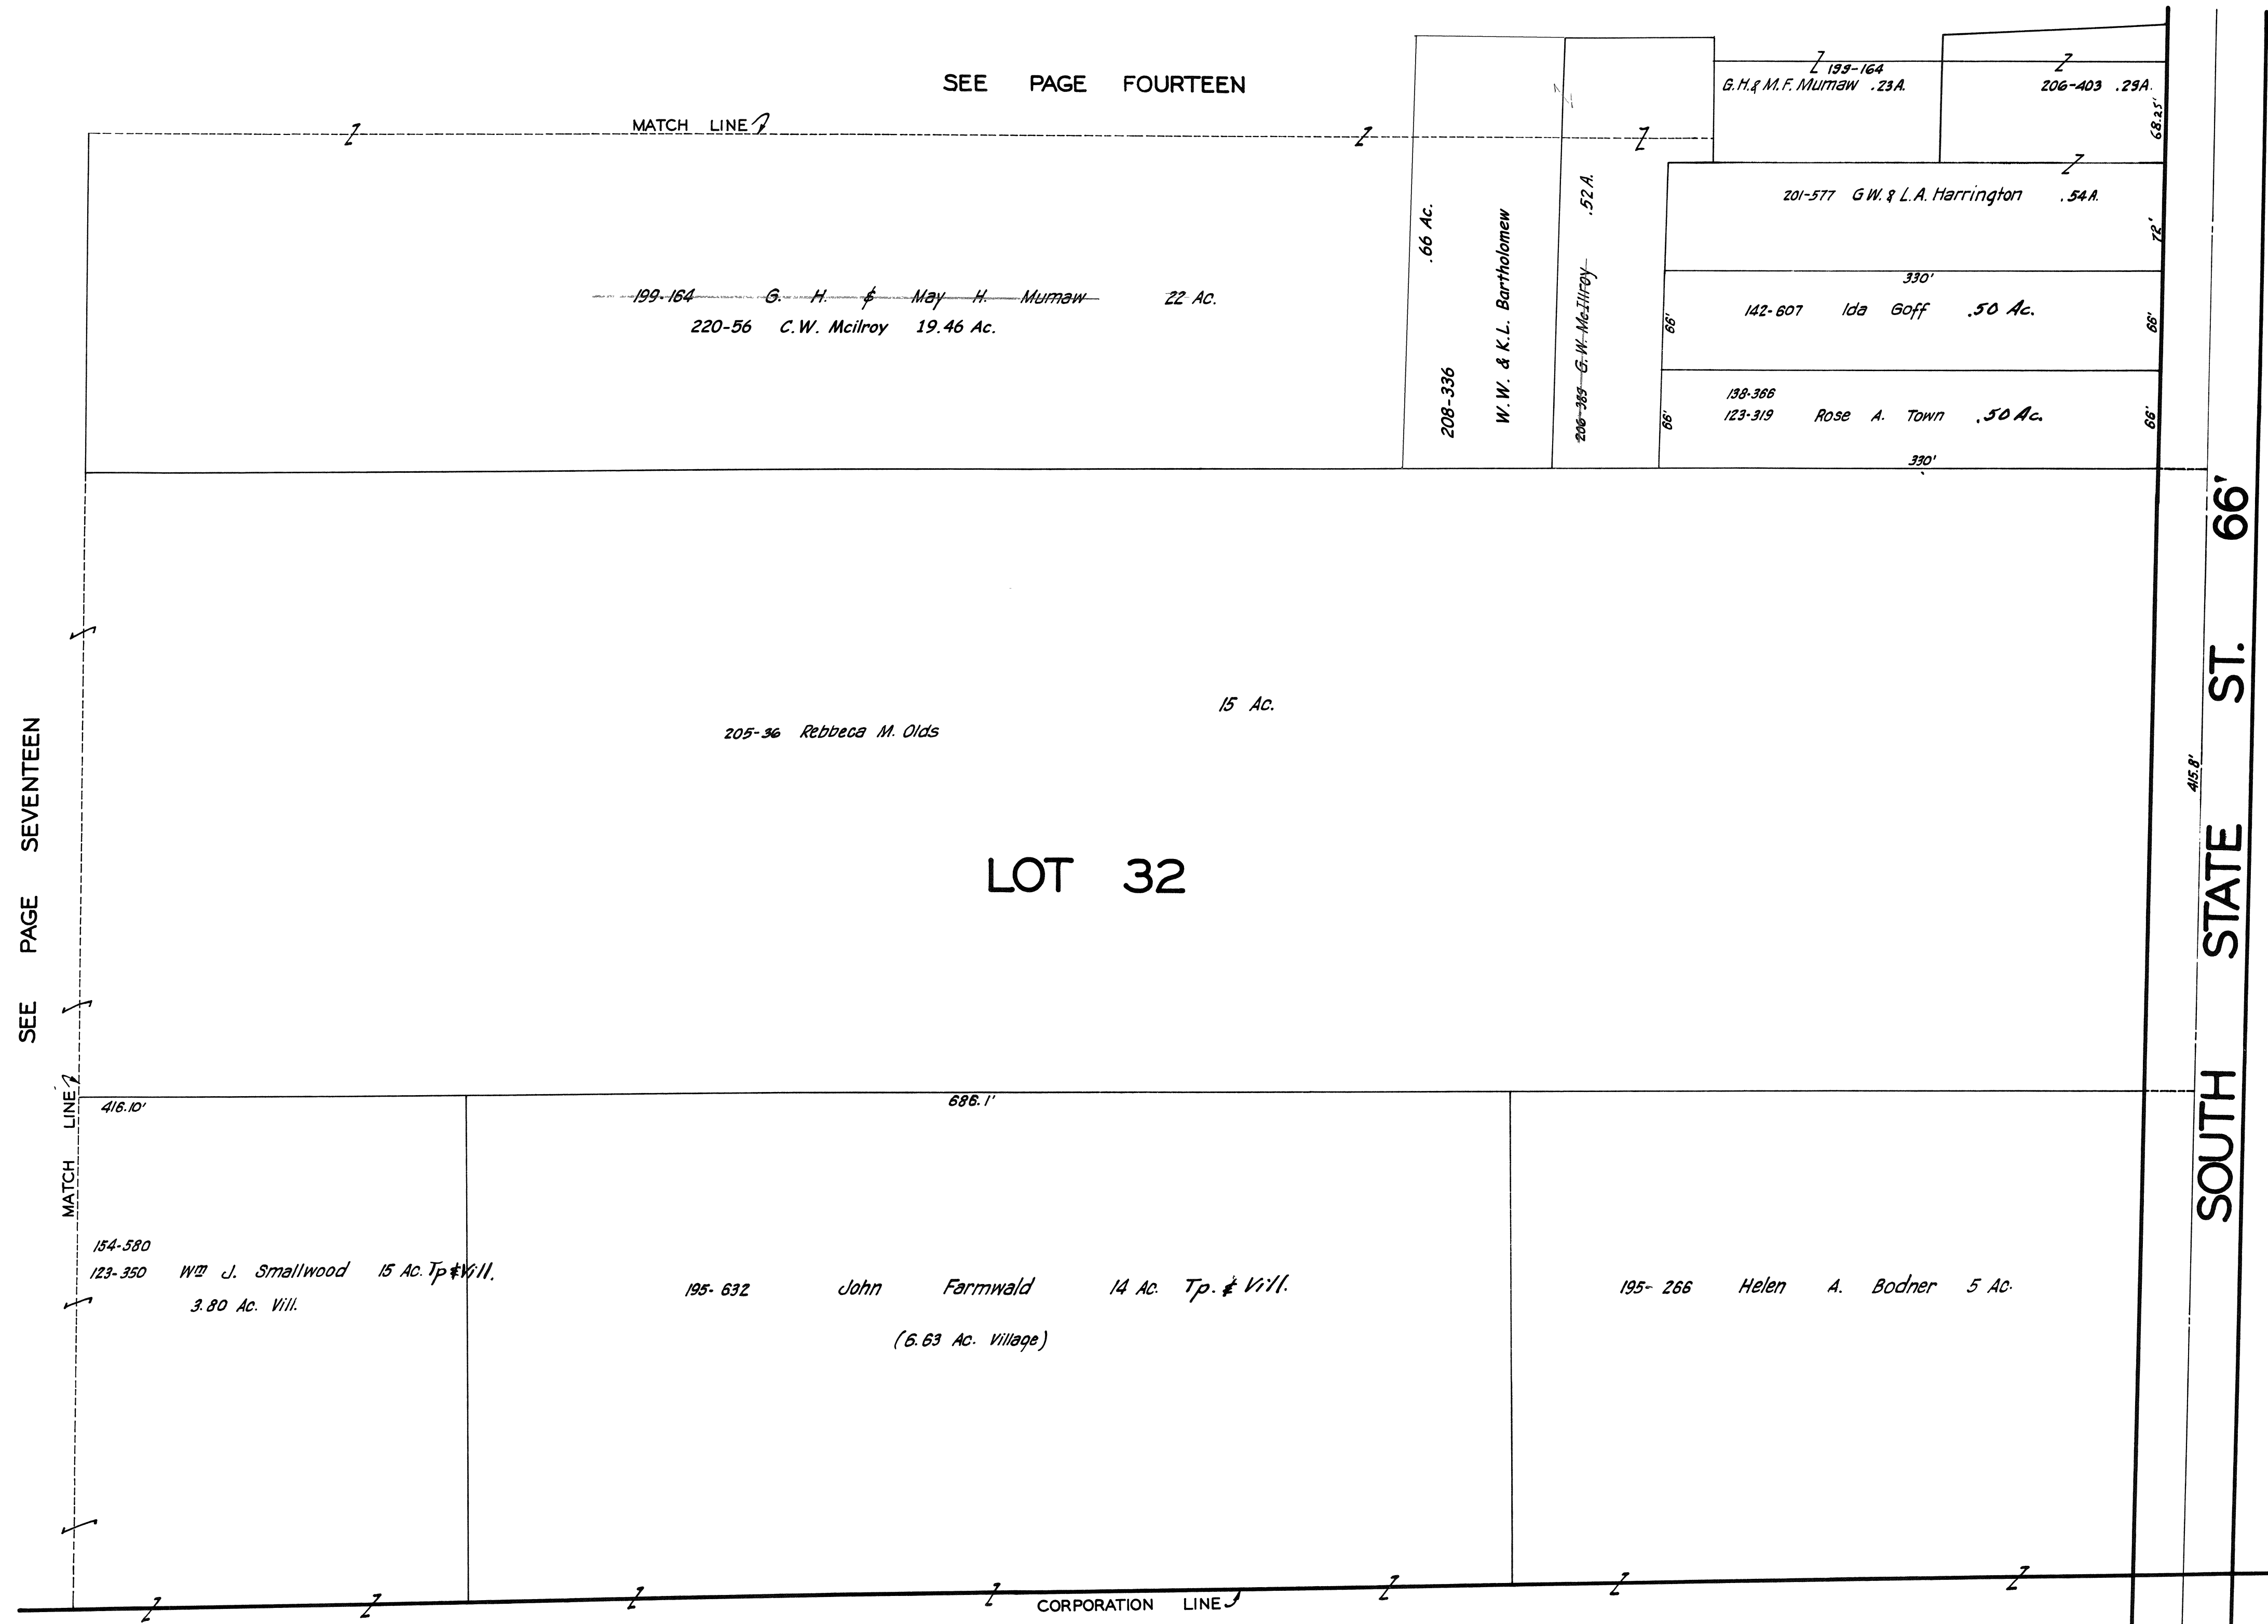

SCALE 1"=66'


JAN 1, 1941
2-15-44

**MIDDLEFIELD
VIL - 18
NOT TO SCALE
1944**

SEE PAGE NINETEEN

MIDDLEFIELD
VIL - 19
NOT TO SCALE
1944


SEE PAGE FIFTEEN

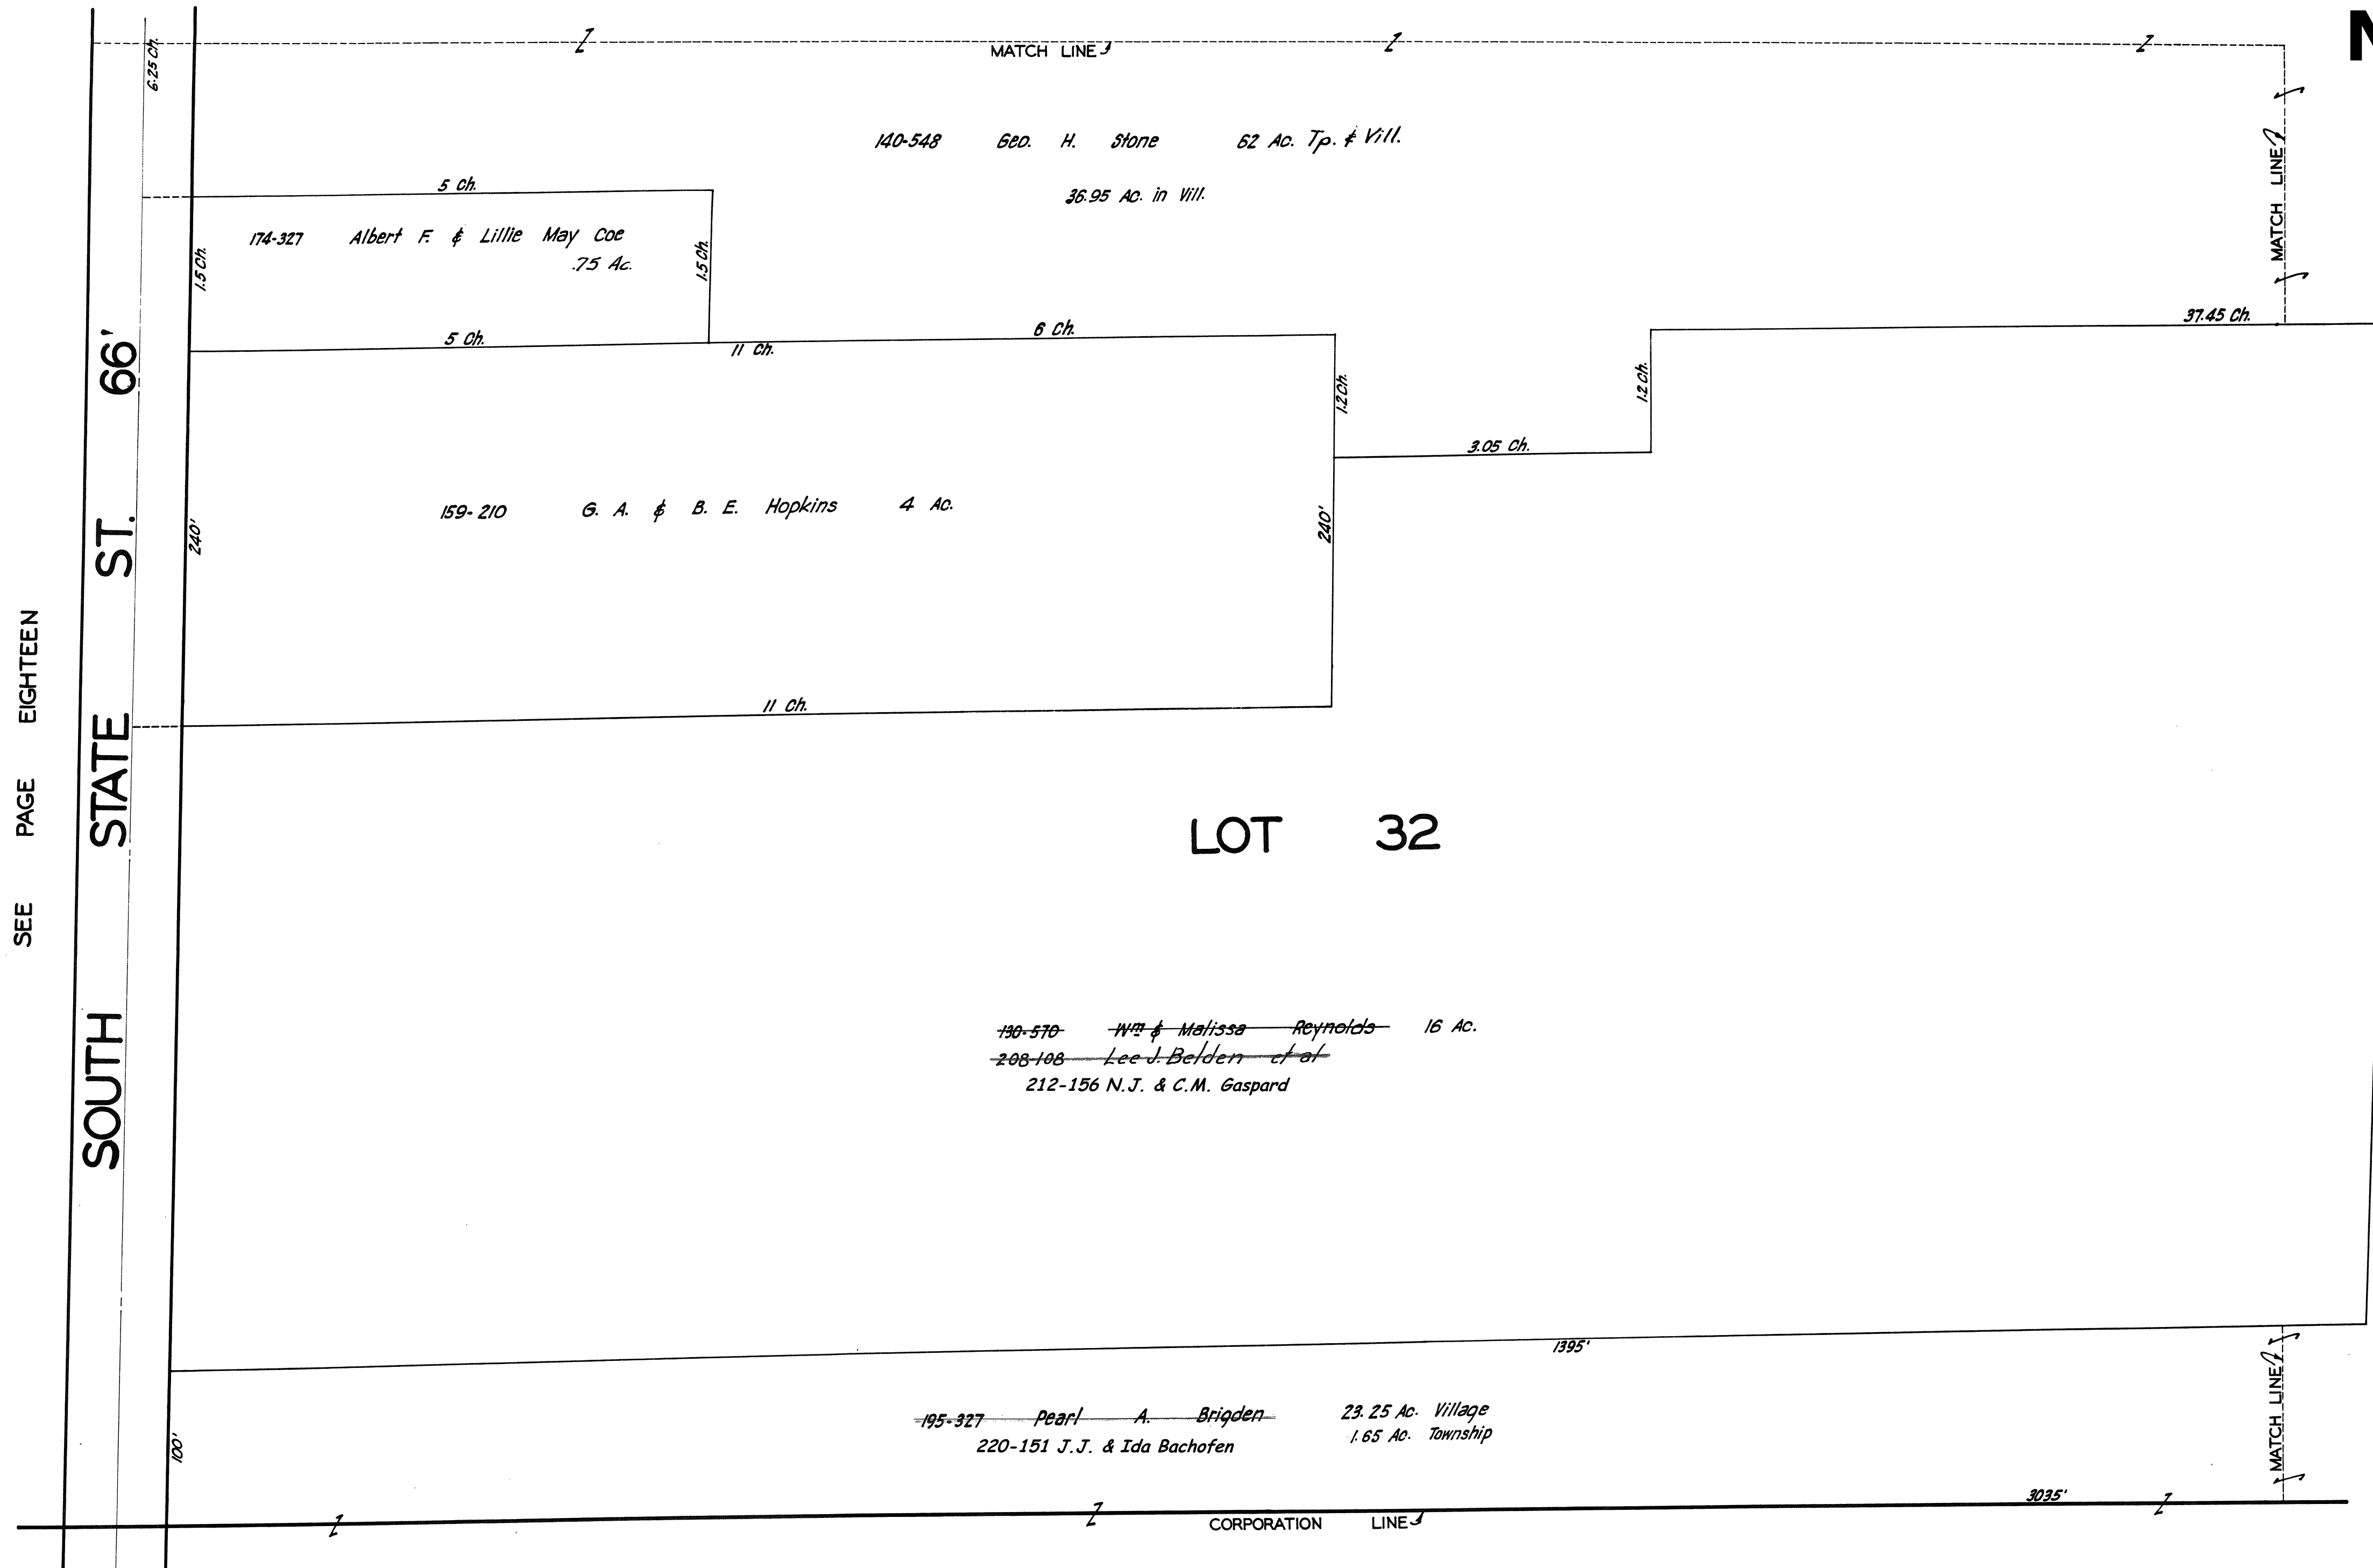

SEE PAGE EIGHTEEN

SOUTH STATE ST. 66'

LOT 32

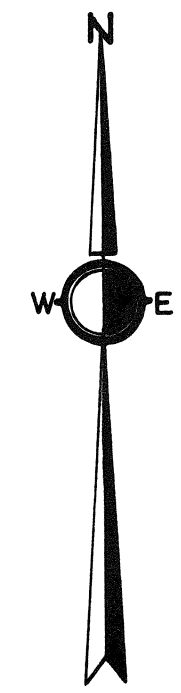


SCALE 1"=66'


~~8-21-43~~
 JAN. 1, 1941
~~8-1-43~~
 2-15-44

SEE PAGE TWENTY

SEE PAGE SIXTEEN

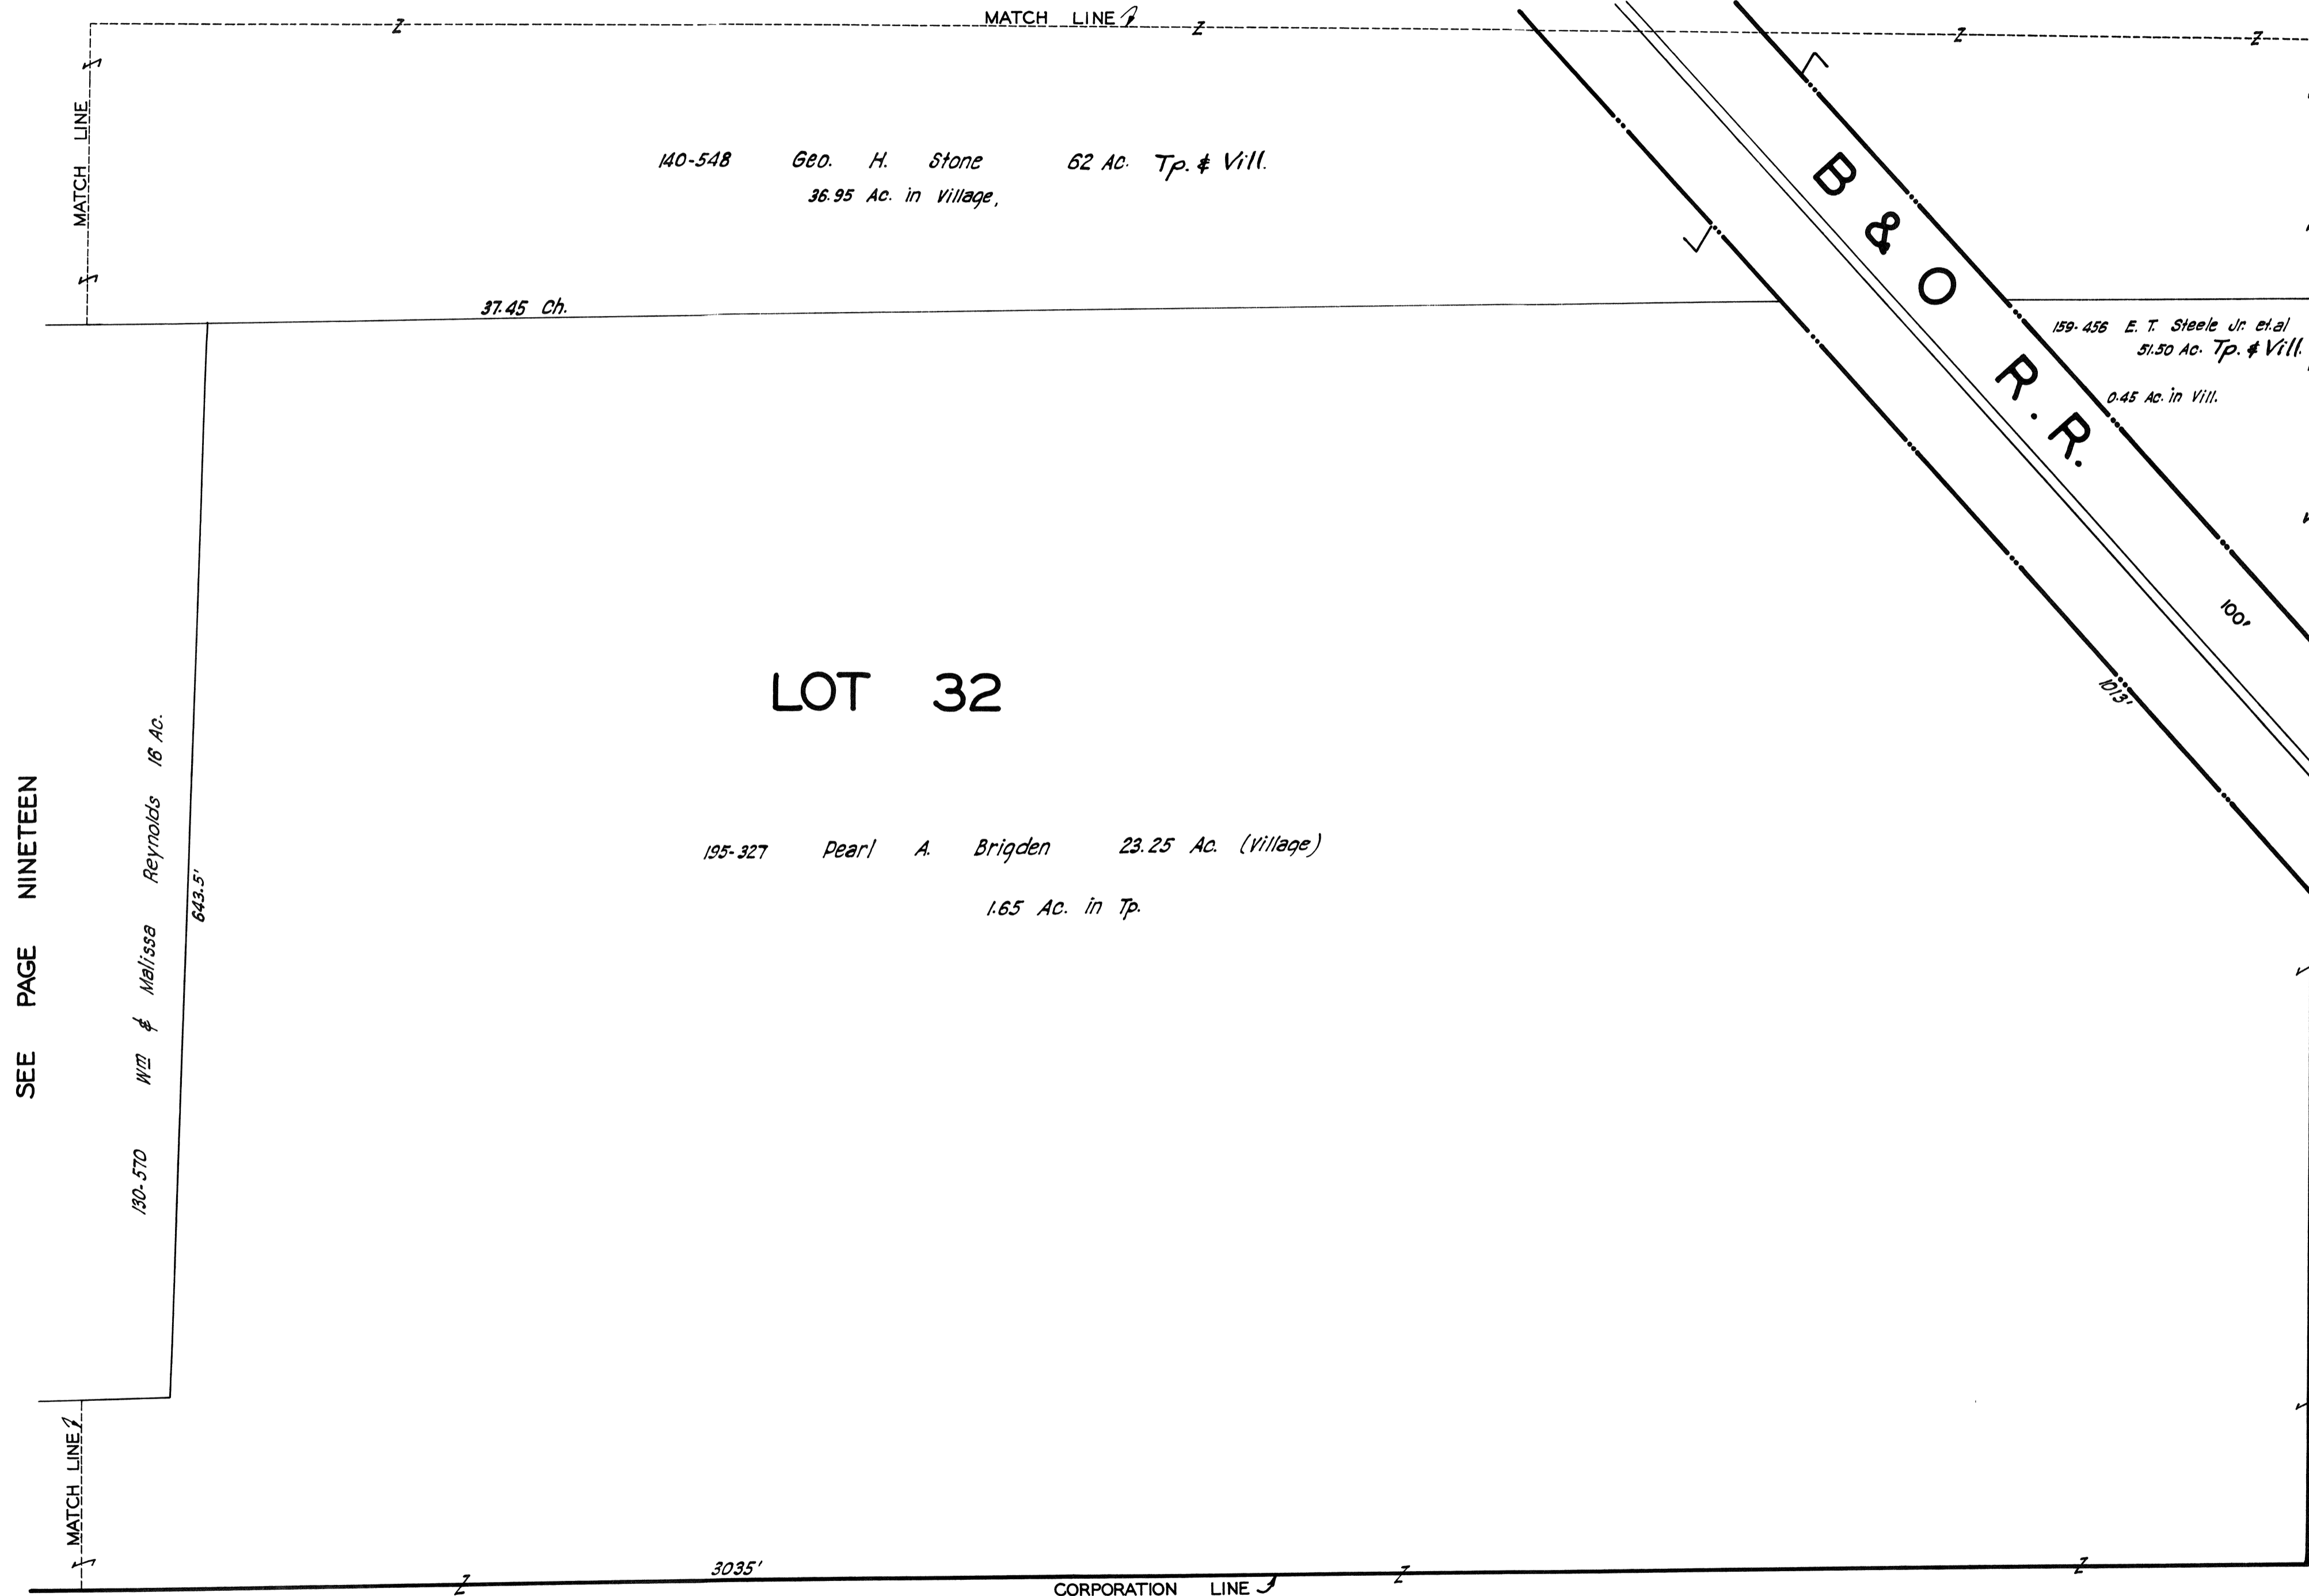

SEE PAGE NINETEEN

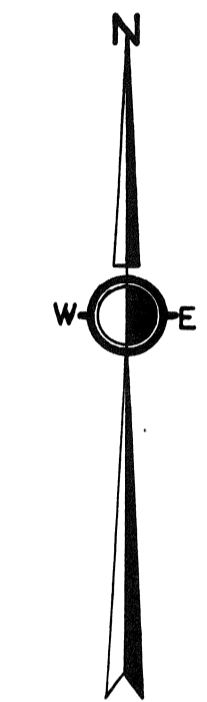

SCALE 1"=66'

JAN. 1, 1941

2-12-77

**MIDDLEFIELD
VIL - 20
NOT TO SCALE
1944**