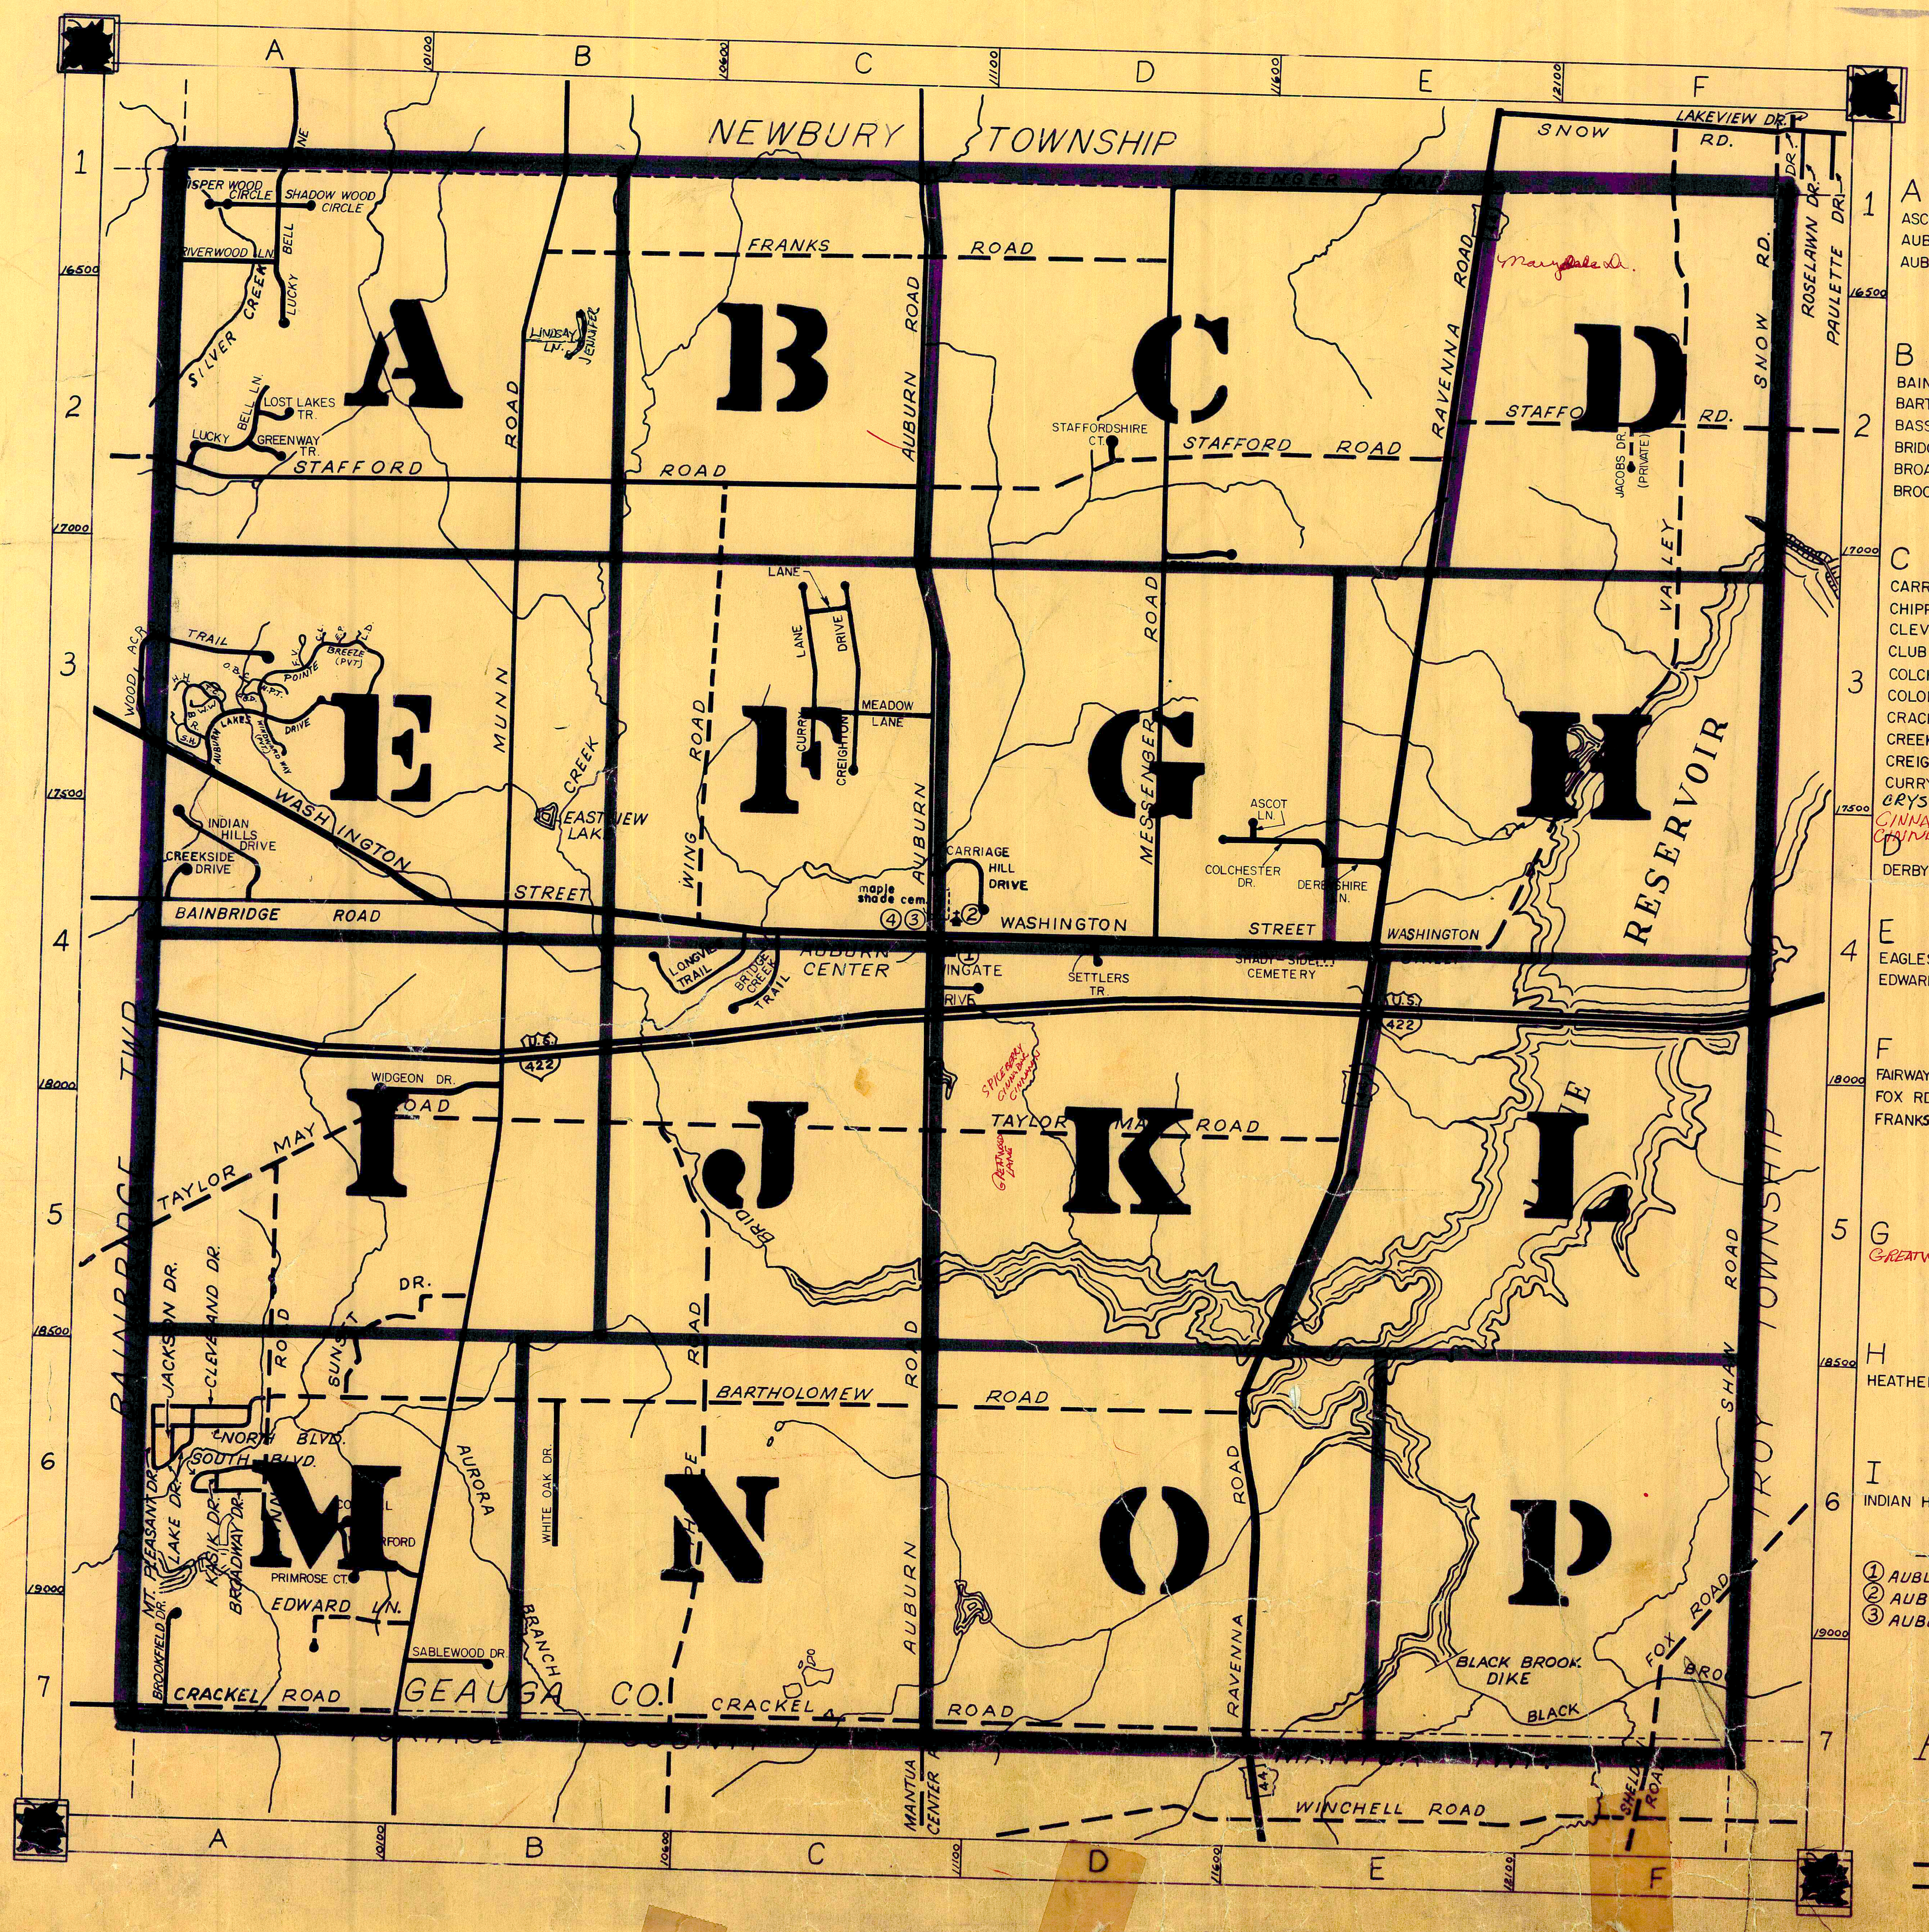
NEWBURY TOWNSHIP
A
B
C
D
E
F
G
H
I
J
K
L
M
N
O
P
1
2
3
4
5
6
7
16500
17000
17500
18000
18500
19000
SNOW RD.
LAKEVIEW DR.
ROSELAWN DR.
PAULETTE DR.
MESSENGER ROAD
FRANKS ROAD
STAFFORD ROAD
STAFFORD RD.
STAFFORDSHIRE CT.
AUBURN ROAD
RAVENNA ROAD
MUNN ROAD
WING ROAD
Marydale Dr.
JACOBS DR. (PRIVATE)
VALLEY
RESERVOIR
WASHINGTON STREET
BAINBRIDGE ROAD
AUBURN CENTER
WINGATE DRIVE
SETTLERS TR.
SHADY SIDE CEMETERY
CARRIAGE HILL DRIVE
maple shade cem.
EASTVIEW LAKE
INDIAN HILLS DRIVE
CREEKSIDE DRIVE
WOOD ACRE TRAIL
LANE
DRIVE
MEADOW LANE
CREIGHTON
ASCOT LN.
COLCHESTER DR.
DERBYSHIRE LN.
422
WIDGEON DR.
TAYLOR MAY ROAD
BAINBRIDGE TWP.
BARTHOLOMEW ROAD
JACKSON DR.
CLEVELAND DR.
NORTH BLVD.
SOUTH BLVD.
MT. PLEASANT DR.
LAKE DR.
BROOKFIELD DR.
KASIK DR.
BROADWAY DR.
PRIMROSE CT.
EDWARD LN.
SUNSET DR.
AURORA BRANCH
WHITE OAK DR.
SABLEWOOD DR.
CRACKEL ROAD
GEAUGA CO.
PORTAGE COUNTY
MANTUA CENTER
WINCHELL ROAD
BLACK BROOK DIKE
BLACK
FOX ROAD
SHAW ROAD
TROY TOWNSHIP
SILVER CREEK
LUCKY BELL LN.
LOST LAKES TR.
GREENWAY TR.
WHISPER WOOD CIRCLE
SHADOW WOOD CIRCLE
RIVERWOOD LN.
LONGVIEW TRAIL
SPICEBERRY CIRCLE
GREATWOOD LANE

ROAD INDEX

A

ASCOT LN.	D4
AUBURN RD.	C1-C7
AUBURN LAKES DR.	A3

B

BAINBRIDGE RD.	A4
BARTHOLOMEW RD.	A6-D6
BASS RUN (PVT.)	A3
BRIDGE CREEK TR.	C4
BROADWAY DR. (PVT.)	A6
BROOKFIELD DR.	A7

C

CARRIAGE HILL	D3
CHIPPING LANE (PVT.)	A3
CLEVELAND DR. (PVT.)	A6
CLUB LN (PVT.)	A3
COLCHESTER DR.	D4-E4
COLONIAL COURT	A6
CRACKEL RD.	A7-E7
CREEKSIDE DR.	A4
CREIGHTON DR.	C3
CURRY LN.	C3
CRYSTAL TRAIL	M
CINNAMON TR.	map K
CINNABAR TR.	map K

D

DERBYSHIRE LN.	E4

E

EAGLES POINTE (PVT.)	A3
EDWARD LN.	A7

F

FAIRWAY VIEW (PVT.)	A3
FOX RD.	F6-F7
FRANKS RD.	B1-D1

G

GREATWOOD LANE	K

H

HEATHER HILL (PVT.)	A3

I

INDIAN HILLS DR.	A4

J

JACKSON DR. (PVT.)	A6
JACOBS DR. (PVT.)	F2
JENNIFER LN	map A

K

KASIK DR. (PVT.)	A6

L

Lindsay Ln	map A
LAKE DR. (PVT.)	A6
LONG DR. (PVT.)	A3
LONGVIEW TR.	C4
LOST LAKES TR.	A2
LUCKY BELL LN.	A1-A2

M

MARYDALE DR.	map D
MEADOW LN.	C3
MESSENGER RD.	E1-D4
MT. PLEASANT DR.	A6
MUNN RD.	B1-B7

N

NORTH BLVD. (PVT.)	A6
NORTH PIN TAIL (PVT.)	A3

O

OVERLOOK BROOK CT. (PVT.)	A3
OVERLOOK BROOK DR. (PVT.)	A3

P

POINTE BREEZE (PVT.)	A3
PRIMROSE COURT	A6

Q

QUINN RD.	A5-A6

R

RAVENNA RD.	E1-E7
RIVERWOOD LN.	A1
ROBIN WOOD LN.	D3

S

SABLEWOOD DR.	B7
SETTLERS TR.	D4
SHADOW WOOD CIRCLE	A1
SHAW RD.	F4-F6
SIGNAL HILL (PVT.)	A3
SNOW RD.	F1-F2
SOUTH BLVD. (PVT.)	A6
SOUTH PIN TAIL (PVT.)	A3
STAFFORD RD.	A2-E2
STAFFORDSHIRE COURT	D2
SUNSET DR.	B5-A6
SPICEBERRY CIR	map K

T

TAYLOR MAY RD.	A5-E5
THORPE RD.	B5-B7
TIMBER LN.	C3
TWIN CREEKS (PVT.)	A3

U

U.S. 422	A4-F4

V

VALLEY RD.	F1-E4

W

WASHINGTON ST.	A3-E4
WATERFORD TR.	A6
WHISPER WOOD CIRCLE	A1
WHITE OAK DR.	B6
WIDGEON DR.	A5-B5
WINDWARD WAY (PVT.)	A3
WING RD.	C3-C4
WINGATE DR.	C4
WOOD ACRE TR.	A3
WOODSONG WAY (PVT.)	A3

Y

Z

① AUBURN ELEM. SCHOOL
② AUBURN COMMUNITY CHURCH
③ AUBURN TOWN HALL
④ AUBURN VOL. FIRE DEPT.

AUBURN TOWNSHIP

0 5 10 15 20

SCALE : 1" = 2,000'

ROBERT L. PHILLIPS,
GEAUGA COUNTY ENGINEER

UNPAVED ROAD
PAVED ROAD
TOWNSHIP LINE
COUNTY LINE

N

NEWBURY TOWNSHIP
BAINBRIDGE TOWNSHIP
TRACT ONE
SEC. 1
SEC. 2
SEC. 3
6
1
6
2
5
2
5
3
4
3
4
WHISPER WOOD
SHADOW WOOD CIRCLE
LUCKY BELL LANE
RIVERWOOD LANE
FRANKS ROAD
STAFFORD ROAD
LINDSAY LANE
JENNIFER LANE
WEATHERTOP LANE
LOST LAKES TRAIL
GREENWAY TRAIL
LUCKY BELL LANE
MUNN ROAD
Auburn Lands Inc.
495-59
661-519
58.50 Ac.
TIMMONS FARMS
930-1290
23.32 Ac.
20.12 Ac.
Auburn Lands Inc.
C.V. WEST, INC. & B.B. BEARD, TRUSTEE
911-794
51.52 Ac.
75.22 Ac
51.5 Ac
LORIEN WOODS INC.
836-863
18.4Ac
16.4Ac
REMAINDER 53.476Ac IN PARCEL #1 PER VOL 21-110
LORIEN DEV. CORP
443-949
101.73 Ac
578-101
661-518
71.25Ac
Auburn Lands Inc.
254-21
Metro-Mach. & Tool Co Inc.
AUBURN SPRINGS COUNTRY CLUB EST VOL 12 P 90-91
M.E. TIMMONS
2.755Ac
795-27
34.935 Ac.
R. & G. TIMMONS
345-449
44.42 Ac.
SCALE 1" = 300'
ALL LOTS IN BURLINGTON GROUP 972-1037
J. Zucker
J.M. & C.S. BRENNER
986-821
B. Swank
E. & D. KENYO
542-1287
J.L. & M.C. PETRONELLI
810-518
M. Munn
BLOCK "A" 10.225 Ac. COMMON AREA
MEIKO MACH. & Tool Co Inc
117 Ac.
509-661
23.5 Ac
I. BALOGH
710-37
10 Ac.
JOHNSON PLASTIC CO.
546-1327
821-423
12.013 Ac.
IMS Company
637-591
21.099 Ac.
A.R. & E. MORSE
9.00 Ac
S.J. & E.J. MRAZ
837-224
29.0 Ac
C.F. SCHANEY
751-862
Match Line
Match line
JAN. 1, 1994
Auburn
"A"
RELATIVE REPRESENTATION
* INADEQUATE DESCRIPTION

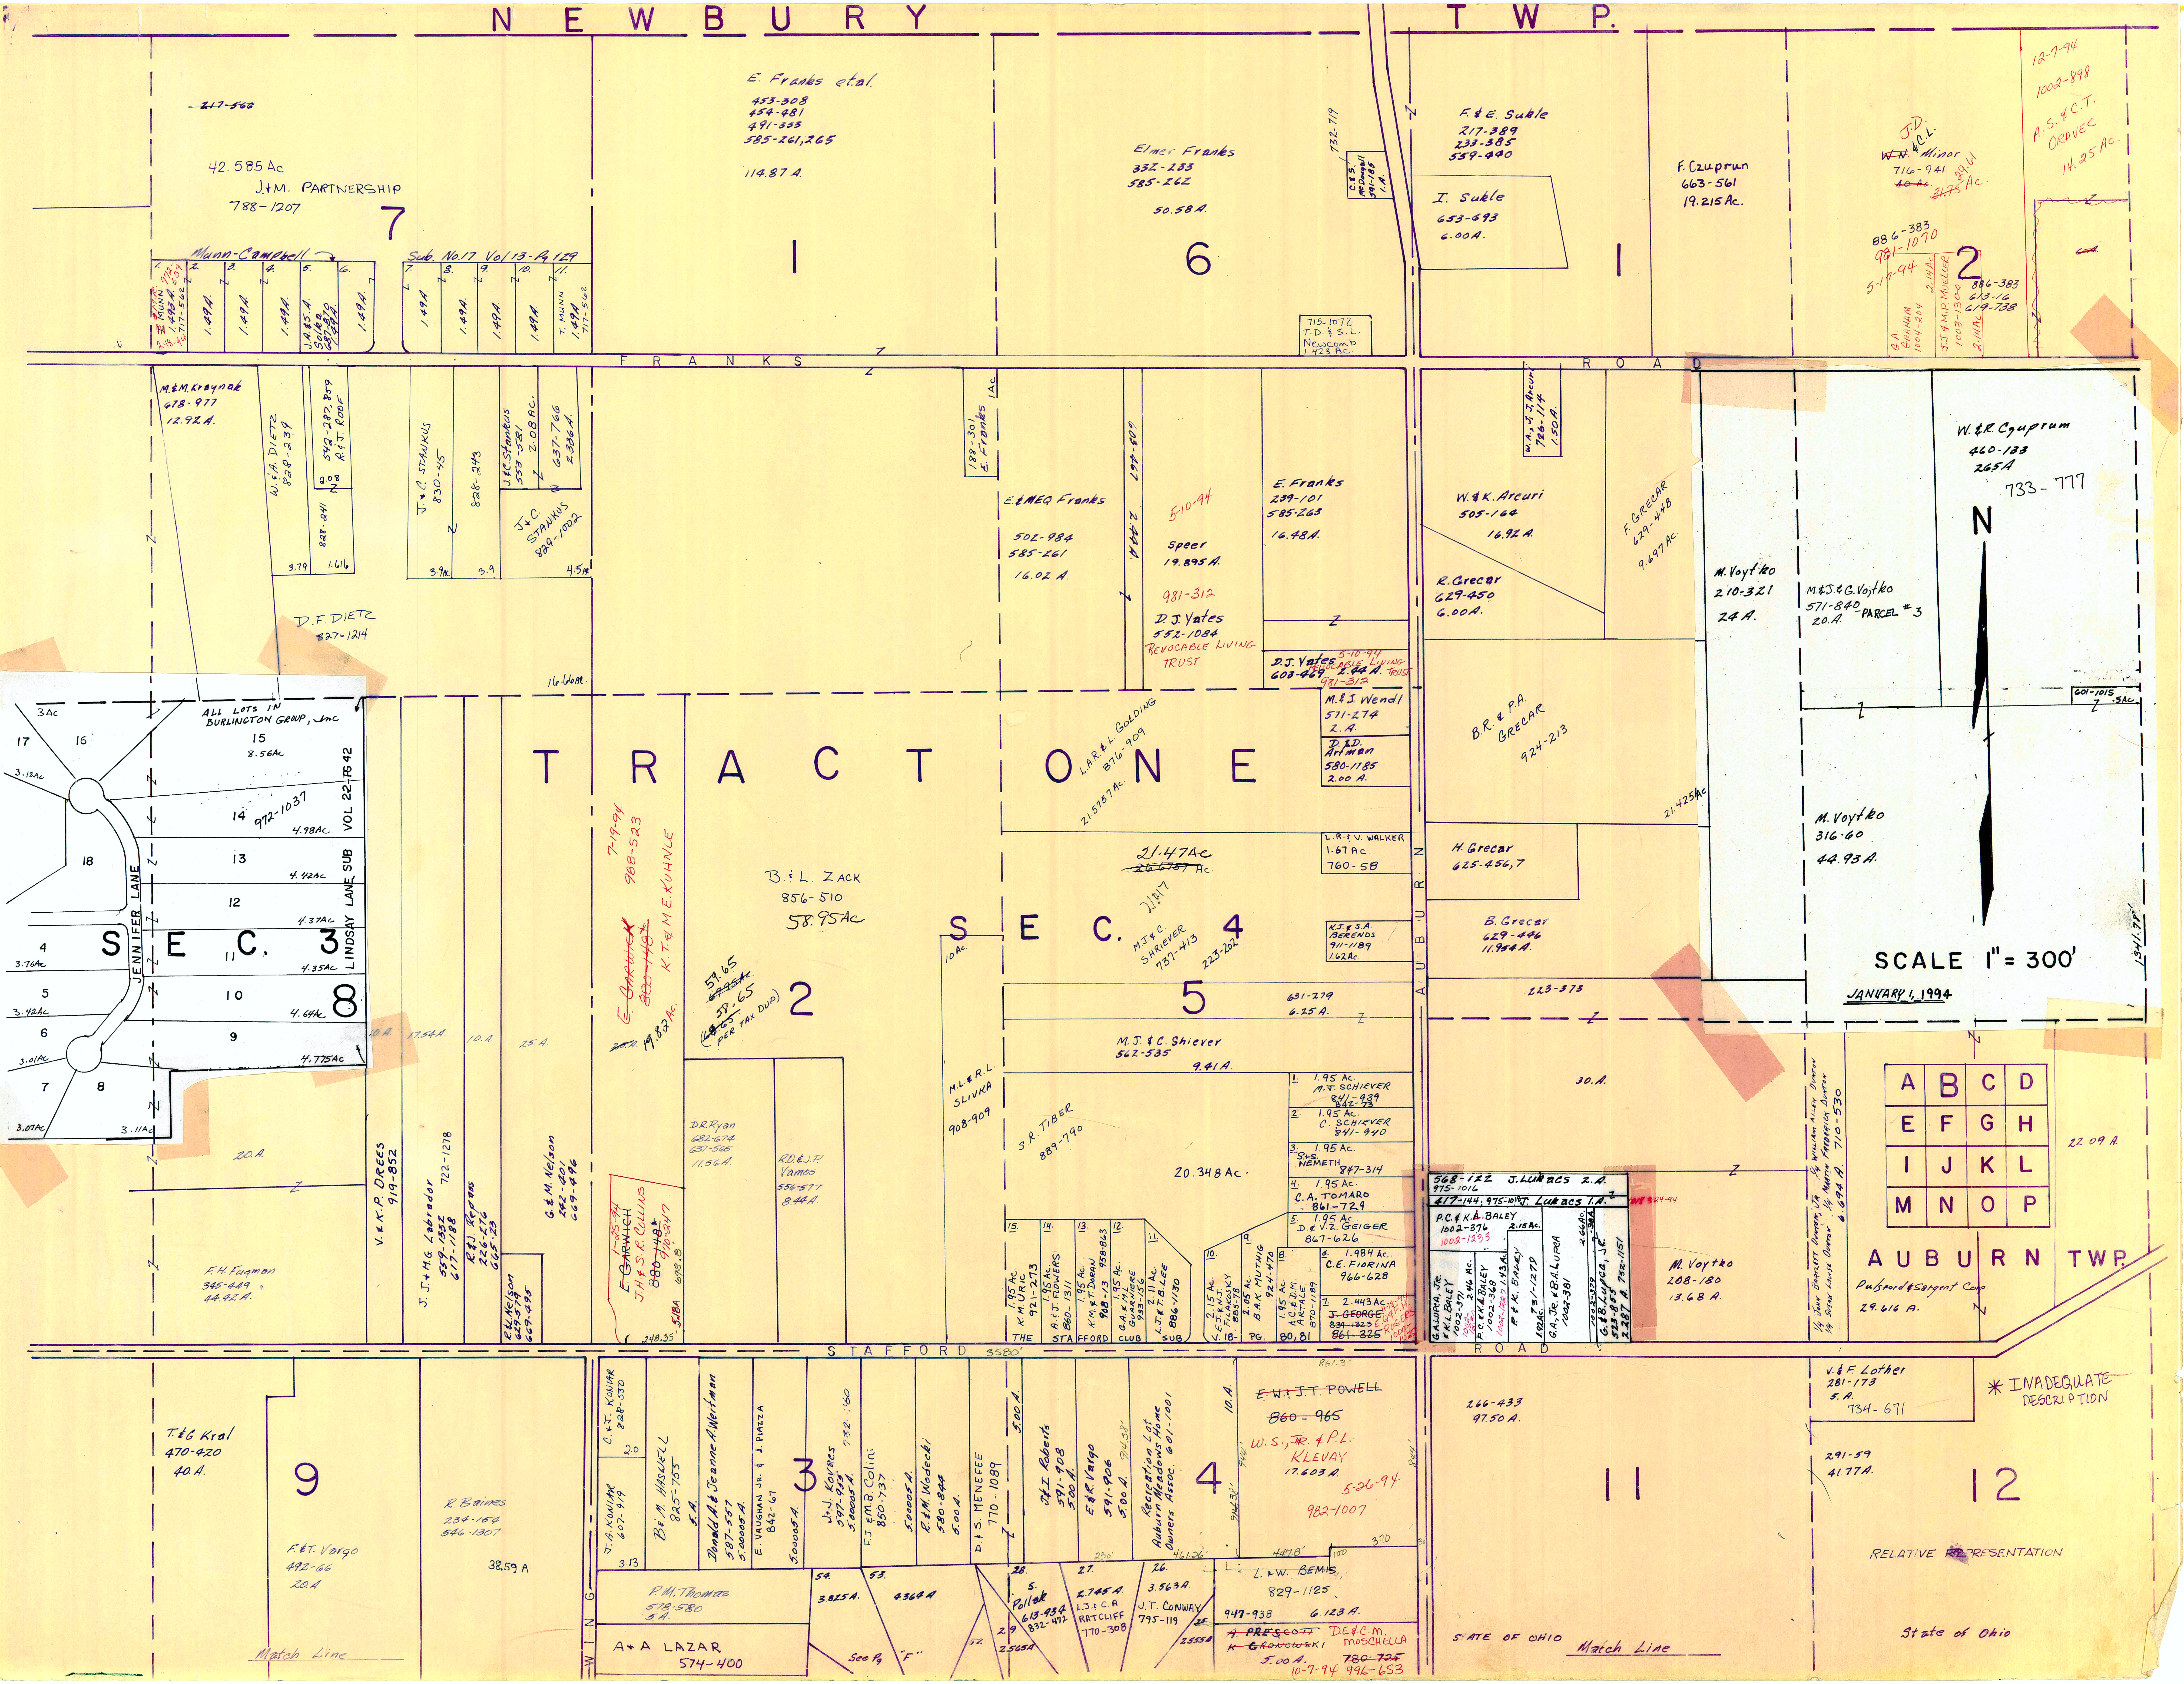
NEWBURY TWP.
J&M. PARTNERSHIP
788-1207
42.585 Ac
7
Munn-Campbell
Sub. No17 Vol 13-Pg 129
E. Franks etal.
453-308
454-481
491-333
585-261,265
114.87 A.
1
Elmer Franks
332-233
585-262
50.58 A.
6
F.&E. Suhle
217-389
233-385
559-440
I. Suhle
653-693
6.00 A.
1
F. Czuprun
663-561
19.215 Ac.
J.D. C.L. Minor
716-741
2
12-7-94
1002-898
A.S.&C.T. GRAVEC
14.25 Ac.
5-17-94
715-1072
T.D.&S.L. Newcomb
FRANKS ROAD
M.&M. Kraynak
678-977
12.92 A.
W.&A. DIETZ
828-239
J.&C. STANKUS
830-45
J.&C. STANKUS
889-1002
D.F. DIETZ
827-1214
E.&MEQ Franks
502-984
585-261
16.02 A.
E. Franks
239-101
585-263
16.48 A.
5-10-94
Speer
19.895 A.
981-312
D.J. Yates
552-1084
REVOCABLE LIVING TRUST
D.J. Yates
W.&K. Arcuri
505-164
16.92 A.
R. Grecar
629-450
6.00 A.
F. GRECAR
629-448
9.697 Ac.
W.&R. Czuprum
460-133
265A
733-777
N
M. Voytko
210-321
24 A.
M.&J.&G. Vojtko
571-840
20 A.
PARCEL # 3
M. Voytko
316-60
44.93 A.
SCALE 1" = 300'
JANUARY 1, 1994
ALL LOTS IN BURLINGTON GROUP, Inc.
JENNIFER LANE
LINDSAY LANE SUB VOL 22-PG 42
972-1037
SEC. 3
8
TRACT ONE
L.A.R.&L. GOLDING
876-909
21.5757 Ac.
M.&J. Wendl
571-274
D.&D. Artman
580-1185
2.00 A.
B.R.&P.A. GRECAR
924-213
L.R.&V. WALKER
1.67 Ac.
760-58
H. Grecar
625-456,7
B. Grecar
629-446
11.984 A.
21.47 Ac
M.J.&C. SHRIEVER
737-413
223-262
SEC. 4
5
631-279
6.25 A.
M.J.&C. Shiever
562-535
9.41 A.
B.&L. ZACK
856-510
58.95 Ac
2
7-19-94
988-523
K.T.&M.E. KUHNLE
M.L.&R.L. SLIVKA
908-909
S.R. TIBER
889-790
20.348 Ac.
D.R. Ryan
11.56 A.
R.D.&J.P. Vamos
8.44 A.
F.H. Fugman
345-449
44.42 A.
V.&K.P. DREES
919-852
J.J.&M.G. Labrador
G.&M. Nelson
E. GARWICH
J.H.&S.R. COLLINS
AUBURN ROAD
223-373
30 A.
J. LUKACS
P.C.&K.A. BALEY
1002-376
M. Voytko
208-180
13.68 A.
AUBURN TWP.
Pulsford & Sargent Corp.
29.616 A.
22.09 A.
A B C D
E F G H
I J K L
M N O P
STAFFORD ROAD
THE STAFFORD CLUB SUB
C.E. FIORINA
966-628
J. GEORGE
861-325
T.&G. Kral
470-420
40 A.
9
F.&T. Vargo
492-66
20 A.
R. Baines
38.59 A
P.M. Thomas
518-580
5 A.
A+A LAZAR
574-400
Bi M. HASWELL
825-755
Donald A.& Jeanne A. Wertman
J.J. Korres
F.J.&M.B. Colini
850-737
R.&M. Wodecki
D.&S. MENEFEE
770-1089
3
4
E.&J. Vargo
591-906
Recreation Lot Auburn Meadows Home Owners Assoc.
W.S., Jr.&P.L. KLEVAY
17.603 A.
5-26-94
982-1007
L.&W. BEMIS
829-1125
6.123 A.
J.T. CONWAY
795-119
DE.&C.M. MOSCHELLA
10-7-94
996-653
266-433
97.50 A.
11
V.&F. Lother
281-173
5 A.
734-671
291-59
41.77 A.
12
* INADEQUATE DESCRIPTION
RELATIVE REPRESENTATION
STATE OF OHIO
State of Ohio
Match Line
Match Line
See Pg "F"

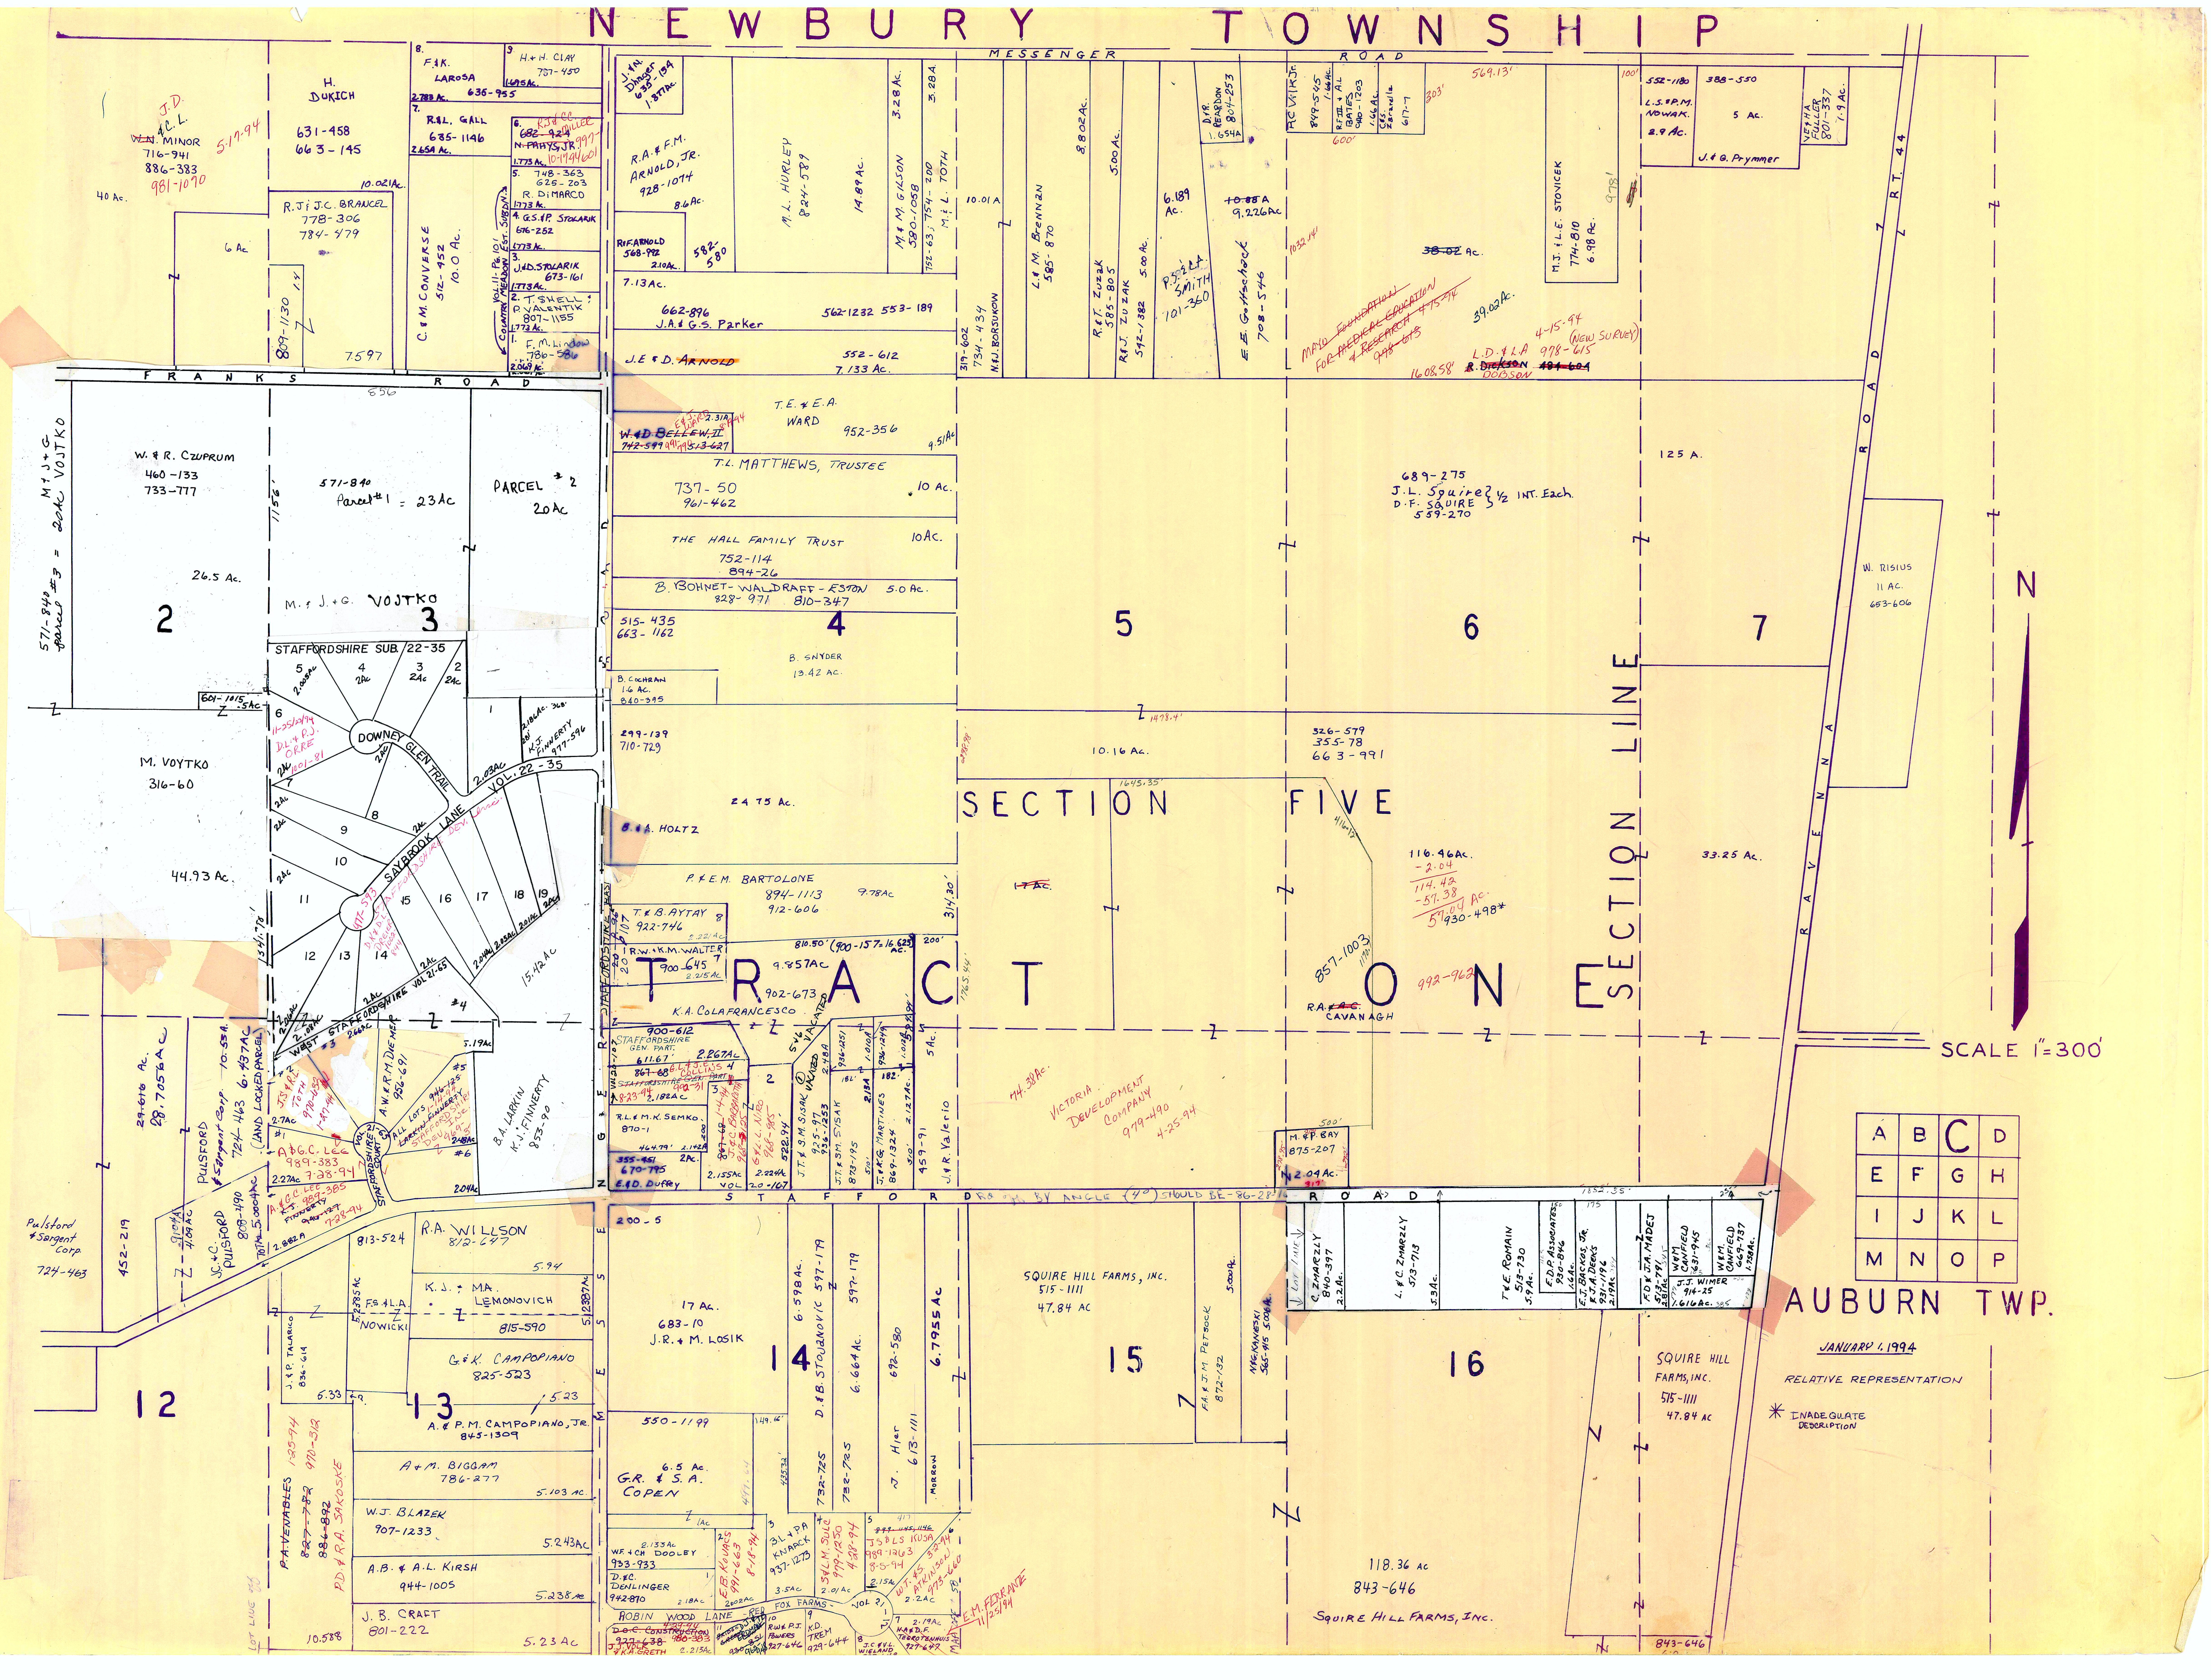
NEWBURY TOWNSHIP
MESSENGER ROAD
FRANKS ROAD
STAFFORD ROAD
RAVENNA ROAD
RT. 44
TRACT ONE
SECTION FIVE
SECTION LINE
SECTION LINE
2
3
4
5
6
7
12
13
14
15
16
N
SCALE 1"=300'
AUBURN TWP.
JANUARY 1, 1994
RELATIVE REPRESENTATION
* INADEQUATE DESCRIPTION
A B C D
E F G H
I J K L
M N O P
J.D. & C.L. ~~W.N.~~ MINOR 716-941 886-383 981-1090 5-17-94
40 Ac.
H. DUKICH 631-458 663-145
10.021Ac.
R.J. & J.C. BRANCEL 778-306 784-479
6 Ac.
809-1130
7.597
8. F. & K. LAROSA 635-955 2.783 Ac.
9. H. & H. CLAY 737-450 1.695 Ac.
7. R. & L. GALL 635-1146 2.654 Ac.
6. ~~682-924~~ ~~N. FAHYS, JR.~~ R.J. & C.C. MILLER 997-601 10-17-94 1.773 Ac.
5. 748-363 625-203 R. DiMARCO 1.773 Ac.
4. G.S. & P. STOLARIK 676-252 1.773 Ac.
3. J. & D. STOLARIK 673-161 1.773 Ac.
2. T. SHELL & P. VALENTIK 807-1155 1.773 Ac.
1. F.M. Lindow 786-586 2.069 Ac.
VOL. 11 PG. 101 COUNTRY MEADOW EST. SUBDN.
C. & M. CONVERSE 512-452 10.0 Ac.
J. & N. Dhager 635-154 1.877Ac.
R.A. & F.M. ARNOLD, JR. 928-1074 8.6Ac.
R. & F. ARNOLD 568-992 2.10Ac.
582-580
M.L. HURLEY 824-589
14.89 Ac.
M. & M. GILSON 580-1058
3.28 Ac.
752-63; 754-200 M. & L. TOTH
3.28 A
7.13 Ac.
662-896 J.A. & G.S. Parker 562-1232 553-189
J.E. & D. ~~ARNOLD~~ 552-612 7.133 Ac.
10.01 A
319-602 734-434 N. & J. BORSUKOW
L. & M. Brennan 585-870
8.802 Ac.
R. & T. Zuzak 585-805
5.00 Ac.
R. & J. ZUZAK 542-1382
5.00 Ac.
6.189 Ac.
P.J. & L.A. SMITH 101-360
D. & R. REARDON 804-253 1.654A
~~10.88~~ A 9.226Ac
E.E. Gottschalk 708-546
R.C. Vilk Jr. 849-545 1.66Ac.
R.F. III & A.L. BATES 940-1203 1.66Ac.
C. & S. Zbaraella 617-7
303'
600'
569.13'
1032.14'
~~MAYO FOUNDATION FOR MEDICAL EDUCATION & RESEARCH~~ 4-15-94 ~~998-615~~
~~38.02~~ Ac.
39.02Ac.
L.D. & L.A. 978-615 4-15-94 (NEW SURVEY)
R. ~~DICKSON~~ DOBSON ~~484-604~~
1608.58'
M.J. & L.E. STOVICEK 774-810 6.98 Ac.
978'
100'
552-1180 L.S. & P.M. NOWAK. 2.9 Ac.
388-550 5 Ac. J. & G. Prymmer
V.E. & H.A. FULLER 801-337 1.9 Ac.
856
M. & J. & G. VOJTKO 571-840 Parcel #3 = 20Ac
W. & R. CZUPRUM 460-133 733-777
26.5 Ac.
571-840 Parcel #1 = 23Ac
PARCEL #2 20Ac
1156'
M. & J. & G. VOJTKO
601-1015 .5Ac
M. VOYTKO 316-60
44.93 Ac.
341.78'
STAFFORDSHIRE SUB. 22-35
DOWNEY GLEN TRAIL
SAYBROOK LANE VOL. 22-35
2.00Ac 2Ac 2Ac 2Ac
11-25/22/94 D.L. & P.J. ORRE 1001-81
2.18Ac. K.J. FINNERTY 977-596
2.03AC
977-593
D.K. & D.L. DREIER 1002-844
STAFFORDSHIRE DEV. INC.
2.04Ac 2.05Ac 2.01Ac 2Ac
15.42Ac
WEST STAFFORDSHIRE VOL 21-65
#3 2.66Ac
#4
2.06Ac 2.08Ac
5.19Ac
T.E. & E.A. WARD 952-356
~~W. & D. BELLEW, II~~ ~~742-599~~ 991-798 ~~513-627~~ E. & J. WARD 8-19-94 2.31A
9.51Ac
T.L. MATTHEWS, TRUSTEE 737-50 961-462 10 Ac.
THE HALL FAMILY TRUST 752-114 894-26 10Ac.
B. BOHNET-WALDRAFF-ESTON 828-971 810-347 5.0 Ac.
515-435 663-1162
B. SNYDER 13.42 Ac.
B. COCHRAN 1.6 Ac. 840-395
299-139 710-729
298.98'
24.75 Ac.
B. & A. HOLTZ
P. & E.M. BARTOLONE 894-1113 912-606 9.78Ac
314.30'
T. & B. AYTAY 922-746 8 2.221Ac
R.W. & K.M. WALTER 900-645 7 2.215Ac
810.50' (900-157 = 16.625 Ac.)
200'
9.857Ac
902-673
K.A. COLAFRANCESCO
1765.44'
STAFFORDSHIRE EAST VOL 20-107
900-612 STAFFORDSHIRE GEN. PART. 611.67'
2.267Ac
~~867-68~~ G.L. & J.E. COLLINS 992-31 8-23-94 ~~STAFFORDSHIRE GEN. PART.~~ 2.182Ac
R.L. & M.K. SEMKO 870-1
464.79' 2.142A
355-451 670-795 E. & D. Duffey
2Ac.
2.155Ac VOL 20-107
3 ~~867-68~~ 1-4-94 J. & C. BARBARITA 968-125
G. & L. NIRO 968-985
2.224Ac
522.94'
5 & 6 VACATED
① VACATED
J.T. & S.M. SISAK 925-97 936-1253
2.48A
936-1251 1.010A
J.T. & S.M. SISAK 873-195
2.13A
936-1249 1.012A
J. & K.G. MARTINES 869-1324
2.127Ac.
459-91 J. & R. Valerio
5 Ac.
29.616 Ac. 28.7056AC
PULSFORD & Sargent Corp. 724-463 10.53A. 6.437AC (LAND LOCKED PARCEL)
Pulsford & Sargent Corp. 724-463
452-219
#2 J.S. & R.L. TOTH 970-183 1-27-94
2.7Ac
#1 A. & G.C. LEE 989-383 7-28-94
2.27Ac
A. & G.C. LEE ~~K.J. FINNERTY~~ 989-385 ~~946-127~~ 7-28-94
STAFFORDSHIRE COURT VOL. 21-65
A.W. & R.M. DIEMER 956-691
#5 ALL LOTS ~~946-125~~ ~~LARKIN FINNERTY~~ STAFFORDSHIRE DEV. INC. 969-31 1-14-94
2.48Ac #6
2.04Ac
B.A. LARKIN K.J. FINNERTY 853-90
9.104A 4.09AC
J.C. & C. PULSFORD 808-490 TOTAL 5.000AC
2.882A
R.A. WILLSON 812-647
813-524
5.94
K.J. & M.A. LEMONOVICH 815-590
5.2385Ac F.S. & L.A. NOWICKI
5.2387Ac
J. & P. TALARICO 836-614
G. & K. CAMPOPIANO 825-523
5.33
5.23
A. & P.M. CAMPOPIANO, JR. 845-1309
A. & M. BIGGAM 786-277
5.103 Ac.
W.J. BLAZEK 907-1233
5.243Ac
A.B. & A.L. KIRSH 944-1005
5.238 Ac
J.B. CRAFT 801-222
5.23 Ac
10.588
~~P.A. VENABLES~~ ~~827-782~~ ~~886-892~~ P.D. & R.A. SAKOSKE 970-312 1-25-94
LOT LINE
200-5
17 Ac. 683-10 J.R. & M. LOSIK
6.598 Ac.
D. & B. STOJANOVIC 597-179
597-179
6.664 Ac.
692-580
6.7955 Ac
550-1199
149.66'
6.5 Ac. G.R. & S.A. COPEN
491.64
435.32'
732-725
732-725
J. Hier 613-1111
MORROW
1 Ac
W.F. & C.H. DOOLEY 933-933 2.133Ac
D. & C. DENLINGER 942-870 2.18Ac
2 E.B. KOVACS 991-663 8-18-94 2.002Ac
3 J.L. & P.A. KNAACK 937-1273 3.5Ac
4 S. & L.M. SULC 979-1250 4-28-94 2.01Ac
5 ~~899-1145, 1146~~ J.S. & L.S. KUSA 989-1263 8-5-94 2.15Ac
6 W.T. & S. ATKINSON 973-660 3-2-94 2.2Ac
7 N.A. & D.F. TEGROTENHUIS 927-647 2.19Ac
E.M. FERRANTE 11/25/94
ROBIN WOOD LANE
RED FOX FARMS VOL 21-1
~~D. & C. CONSTRUCTION~~ ~~927-638~~ J.J. VOLK & K.A. GRETH 4-29-94 980-383 2.213Ac
11 J. & L. ERDMAN
10 R.W. & P.J. POWERS 927-646
9 K.D. TREM 929-644
8 J.C. & V.L. WIELAND
689-275 J.L. Squire } 1/2 INT. Each D.F. SQUIRE } 559-270
125 A.
W. RISIUS 11 Ac. 653-606
1478.4'
10.16 Ac.
326-579 355-78 663-991
1645.35'
416.12'
~~17~~ Ac.
116.46Ac. -2.04 114.42 -57.38 57.04 Ac.
930-498*
857-1003
1170'
992-962
R.A. & ~~A.C.~~ CAVANAGH
33.25 Ac.
114.38Ac. VICTORIA DEVELOPMENT COMPANY 979-490 4-25-94
500'
M. & P. BAY 875-207 2.04 Ac.
ROAD BY ANGLE (4°) SHOULD BE -86-28-16
1852.35'
SQUIRE HILL FARMS, INC. 515-1111 47.84 AC
F.A. & J.M. PETSOCK 872-132
5.00Ac.
N. & G. KANIESKI 565-415 5.006A.
LOT LINE
C. ZMARZLY 840-397 2.2Ac.
L. & C. ZMARZLY 513-713 5.3Ac.
T. & E. ROMAIN 513-730 5.9Ac.
E.D.P. ASSOCIATES 930-846 1.6Ac.
E.J. BACKOS, JR. & J.A. DEEKS 931-1196 2.19Ac
F.D. & J.A. MADEJ 513-791 2.81Ac
W. & M. CANFIELD 631-945
W. & M. CANFIELD 669-737 1.758Ac.
J.J. WIMER 914-25 1.616Ac.
SQUIRE HILL FARMS, INC. 515-1111 47.84 AC
118.36 AC 843-646 SQUIRE HILL FARMS, INC.
843-646

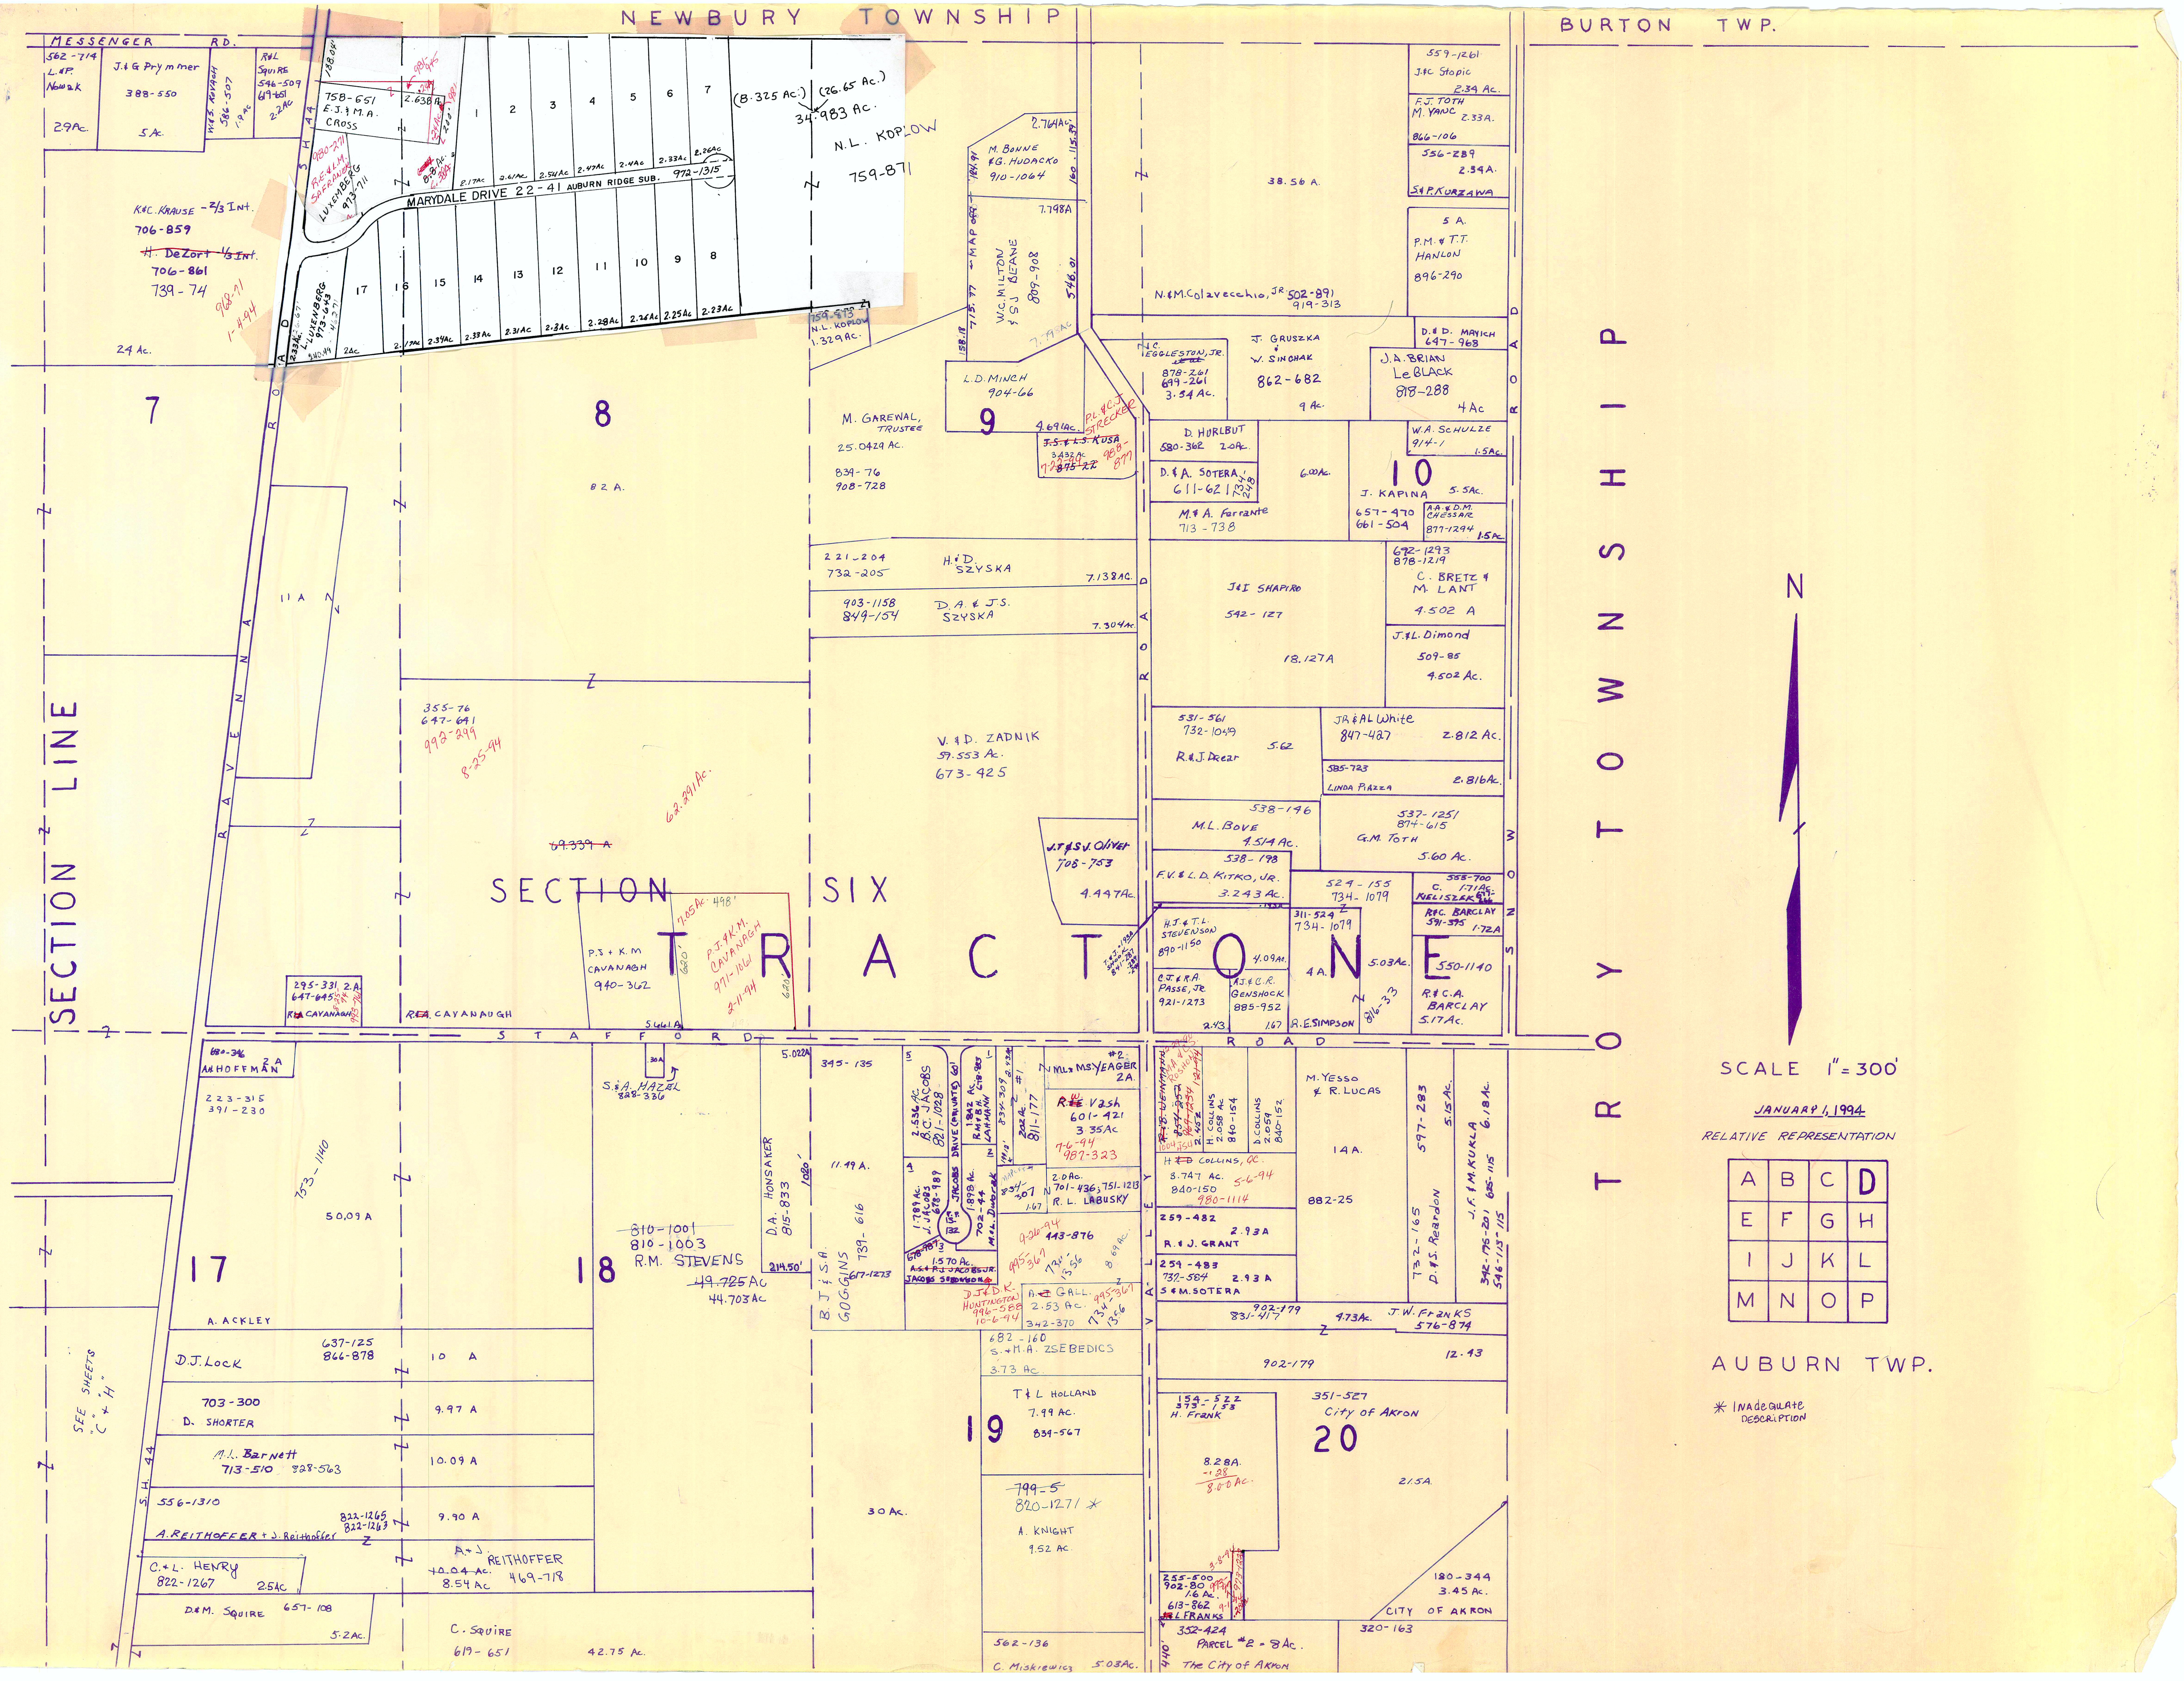
NEWBURY TOWNSHIP
BURTON TWP.
TROY TOWNSHIP
SECTION LINE
SECTION SIX
TRACTONE
MESSENGER RD.
MARYDALE DRIVE 22-41 AUBURN RIDGE SUB. 972-1315
RAVENNA ROAD
STAFFORD ROAD
SHOW ROAD
VALLEY ROAD
SH 44
7
8
9
10
17
18
19
20
N.L. KOPLOW 759-871
34.983 Ac.
K&C. KRAUSE 2/3 Int. 706-859
~~H. DeZort 1/3 Int.~~ 706-861 739-74
M. GAREWAL, TRUSTEE 25.0429 Ac. 839-76 908-728
V. & D. ZADNIK 59.553 Ac. 673-425
H.&D. SZYSKA
D.A. & J.S. SZYSKA
J&I SHAPIRO 542-127 18.127 A
N.&M. Colavecchio, Jr. 502-891 919-313
P.J. & K.M. CAVANAGH 940-362
R.M. STEVENS 810-1003 44.703 Ac
D.J. Lock
A. ACKLEY
D. SHORTER
M.L. Barnett 713-510
A. REITHOFFER + J. Reithoffer
A+J. REITHOFFER 469-718
C.&L. HENRY 822-1267
D&M. SQUIRE 657-108
C. SQUIRE 619-651
T&L HOLLAND 7.99 Ac. 834-567
A. KNIGHT 9.52 Ac
City of Akron 351-527
M. YESSO & R. LUCAS 14 A. 882-25
J.W. Franks 576-874
SEE SHEETS "C" + "H"
N
SCALE 1" = 300'
JANUARY 1, 1994
RELATIVE REPRESENTATION
A B C D
E F G H
I J K L
M N O P
AUBURN TWP.
* Inadequate Description

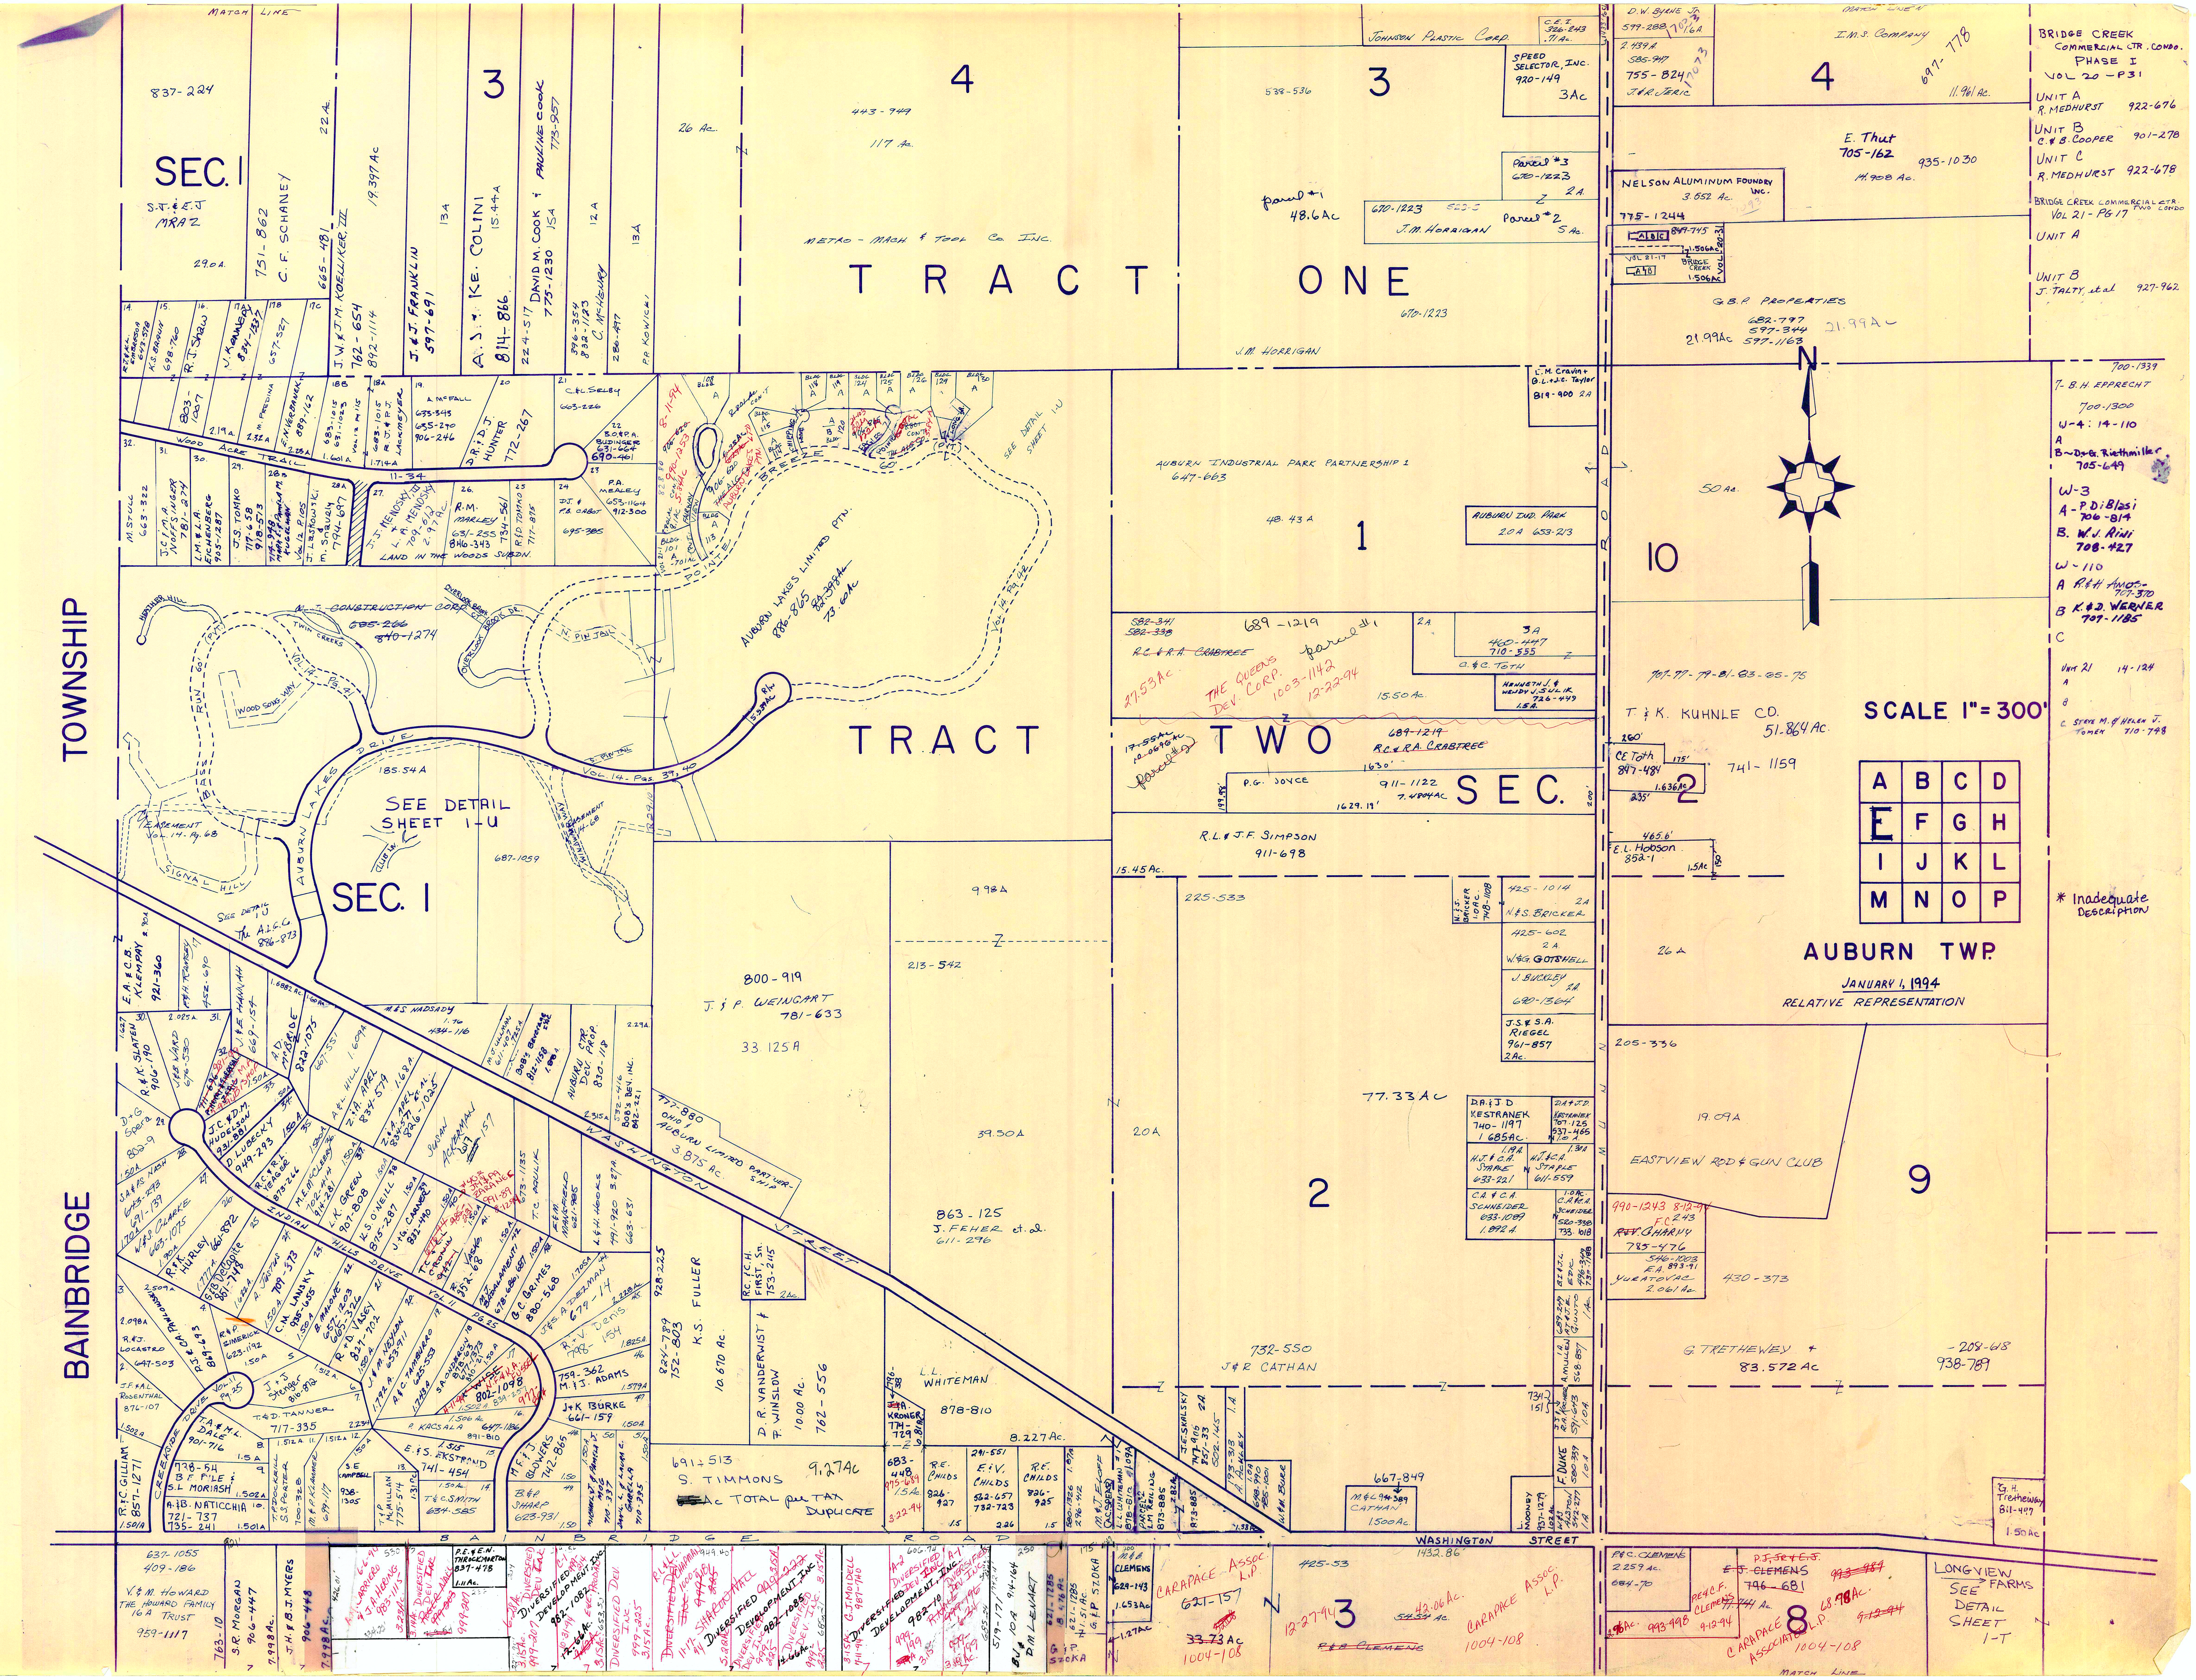
MATCH LINE
SEC. I
TRACT ONE
TRACT TWO
SEC. 2
SEC. I
TOWNSHIP
BAINBRIDGE
BAINBRIDGE ROAD
WASHINGTON STREET
MUNN ROAD
AUBURN LAKES DRIVE
INDIAN HILLS DRIVE
WOOD ACRE TRAIL
SIGNAL HILL
LAND IN THE WOODS SUBDN.
SEE DETAIL SHEET I-U
SEE DETAIL SHEET I-T
LONGVIEW FARMS
AUBURN LAKES LIMITED PTN. 882-865
AUBURN INDUSTRIAL PARK PARTNERSHIP 1 647-663
METRO-MACH & TOOL Co. INC.
J.M. HORRIGAN
JOHNSON PLASTIC CORP.
SPEED SELECTOR, INC. 920-149
I.M.S. COMPANY
E. Thut 705-162
NELSON ALUMINUM FOUNDRY INC. 3.652 Ac. 775-1244
G.B.P. PROPERTIES 682-797 597-344 597-1163 21.99Ac
BRIDGE CREEK COMMERCIAL CTR. CONDO. PHASE I VOL 20-P31
UNIT A R. MEDHURST 922-676
UNIT B C.&B. COOPER 901-278
UNIT C R. MEDHURST 922-678
BRIDGE CREEK COMMERCIAL CTR. TWO CONDO VOL 21-PG 17
UNIT A
UNIT B J. TALTY, et al 927-962
700-1339
7- B.H. EPPRECHT 700-1300
W-4: 14-110
A
B~D&G. Riethmiller 705-649
W-3
A - P. DiBlasi 706-814
B. W.J. Rini 708-427
W-110
A R.&H. Amos 707-370
B K.&D. WERNER 707-1185
C
Unit 21 14-124
A
B
C Steve M. & Helen J. Tomen 710-748
T. & K. KUHNLE CO. 51.864 Ac. 741-1159
EASTVIEW ROD & GUN CLUB
G. TREHEWEY + 83.572 Ac
J.&P. WEINGART 781-633 33.125A
R.L. & J.F. SIMPSON 911-698
P.G. JOYCE 911-1122
R.C. & R.A. CRABTREE 689-1219
THE QUEENS DEV. CORP. 1003-1142 12-22-94
J. FEHER et al. 611-296
J&R CATHAN 732-550
L.L. WHITEMAN 878-810
K.S. FULLER
S. TIMMONS 691-513 9.27Ac
CARAPACE ASSOC. L.P. 1004-108
DIVERSIFIED DEVELOPMENT INC.
1
2
3
4
8
9
10
SCALE 1" = 300'
A B C D
E F G H
I J K L
M N O P
* Inadequate Description
AUBURN TWP.
JANUARY 1, 1994
RELATIVE REPRESENTATION
N

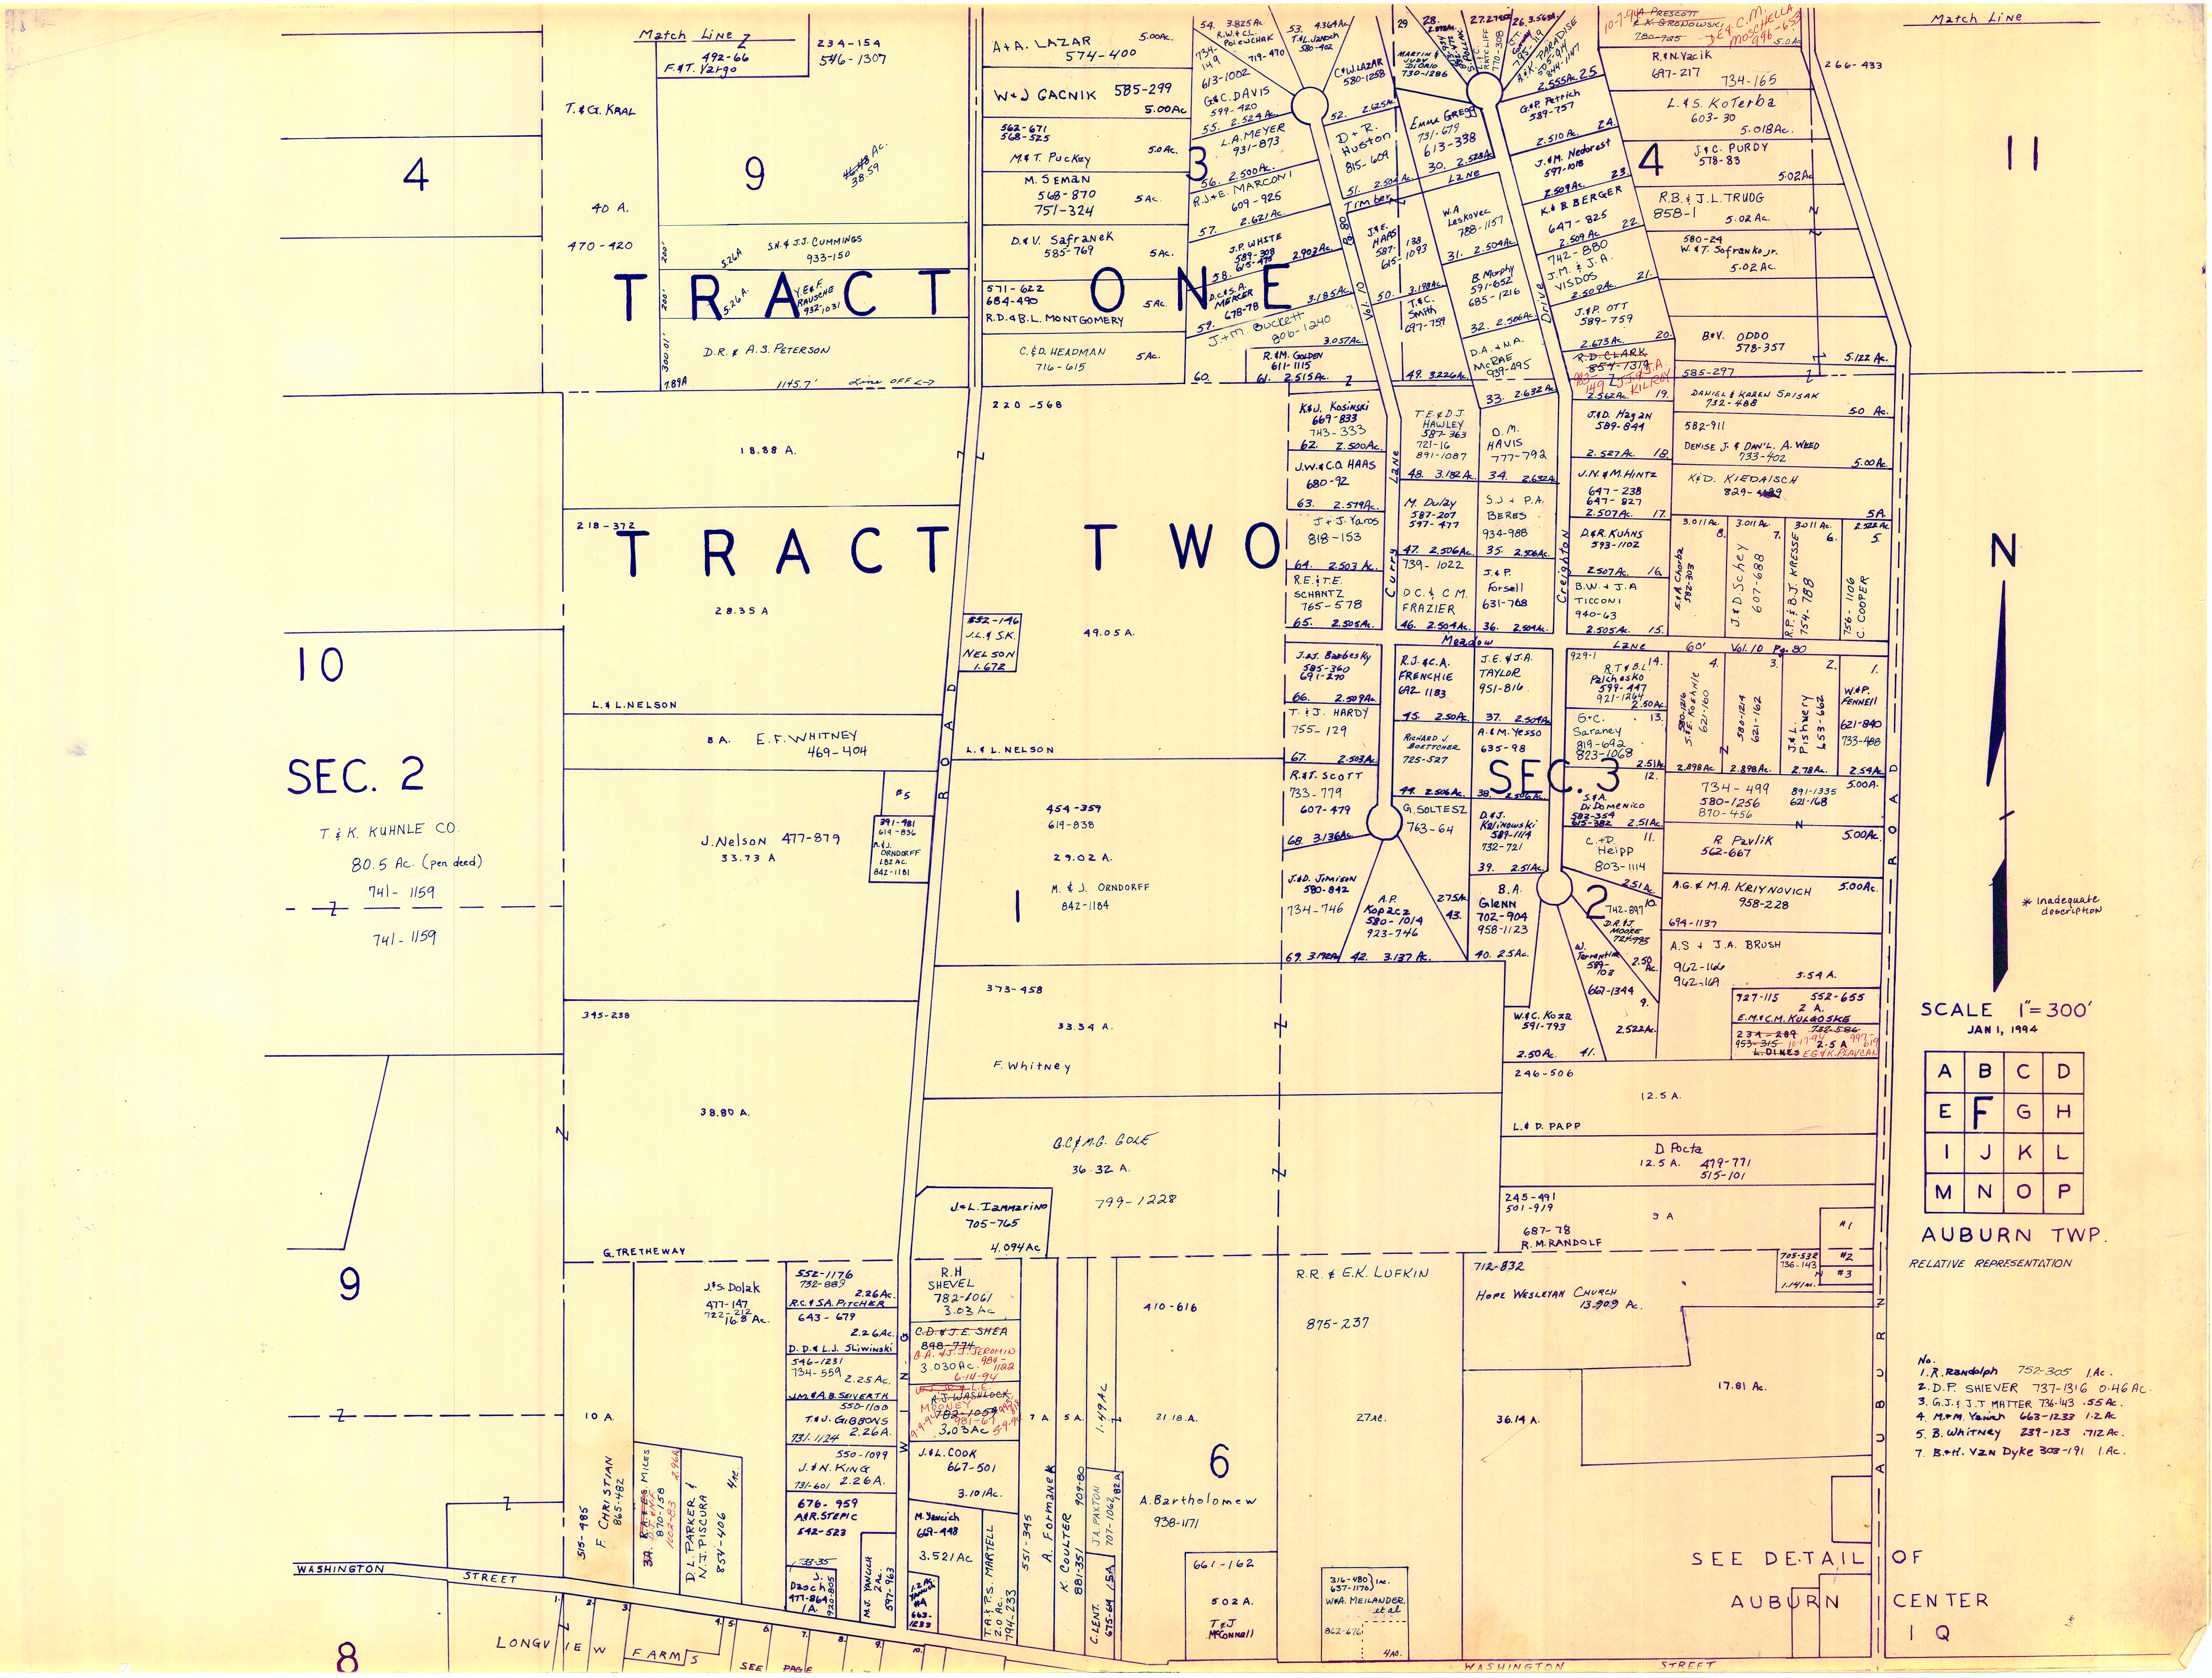
Match Line
Match Line
TRACT ONE
TRACT TWO
SEC. 2
SEC. 3
4
9
3
4
11
10
9
1
2
6
8
T. & G. KRAAL
40 A.
470-420
492-66
F. & T. Vargo
234-154
546-1307
S.H. & J.J. CUMMINGS
933-150
Y. & F. RAUSCHE
932-1031
D.R. & A.S. PETERSON
1145.7'
A. & A. LAZAR
574-400
W. & J. GACNIK
585-299
M. & T. Puckey
M. Seman
568-870
751-324
D. & V. Safranek
585-769
571-622
684-490
R.D. & B.L. MONTGOMERY
C. & D. HEADMAN
716-615
220-568
18.88 A.
218-372
28.35 A
L. & L. NELSON
8 A.
E.F. WHITNEY
469-404
J. Nelson 477-879
33.73 A
L. & L. NELSON
49.05 A.
J.L. & S.K. NELSON
454-359
619-838
29.02 A.
M. & J. ORNDORFF
842-1184
A. & J. ORNDORFF
842-1181
395-238
373-458
33.34 A.
F. Whitney
38.80 A.
G.C. & M.G. GOLE
36.32 A.
799-1228
J. & L. Iammarino
705-765
4.094 Ac.
T. & K. KUHNLE CO.
80.5 Ac. (per deed)
741-1159
741-1159
G. TRETHEWAY
J. & S. Dolak
477-147
16.8 Ac.
R.C. & S.A. PITCHER
643-679
D.D. & L.J. Sliwinski
546-1231
734-559
J.M. & A.B. SEYFERTH
550-1100
T. & J. GIBBONS
J. & N. KING
676-959
A. & R. STEPIC
642-523
R.H. SHEVEL
782-1061
3.03 Ac.
C.D. & J.E. SHEA
3.030 Ac.
R.J. WASHLOCK
3.03 Ac.
J. & L. COOK
667-501
3.10 Ac.
M. Yancich
649-448
3.52 Ac.
10 A.
F. CHRISTIAN
865-482
D.L. PARKER
N.J. PISCURA
854-406
R.R. & E.K. LUFKIN
875-237
410-616
21.18 A.
27 Ac.
A. Bartholomew
938-1171
661-162
5.02 A.
T. & J. McConnell
WM. MEILANDER et al
A. Formanek
K. COULTER
J.A. PAXTON
C. LENT
T. & P.S. MARTELL
HOPE WESLEYAN CHURCH
13.909 Ac.
712-832
36.14 A.
17.81 Ac.
R.M. RANDOLF
687-78
245-491
501-919
9 A
D. Pocta
12.5 A.
479-771
515-101
L. & D. PAPP
246-506
12.5 A.
WASHINGTON STREET
LONGVIEW FARMS SEE PAGE
WASHINGTON STREET
SEE DETAIL OF AUBURN CENTER 1Q
AUBURN ROAD
WANG ROAD
Curry Lane
Creighton Drive
Meadow Lane
Timber Lane
L. Bane
C.W. LAZAR
G. & C. DAVIS
L.A. MEYER
R.J. & E. MARCONI
J.P. WHITE
D.C. & S.A. MERCER
J. & M. Buckett
R. & M. GOLDEN
D. & R. Huston
Emma Gregg
W.A. Leskovec
B. Murphy
T. & C. Smith
D.A. & N.A. McRAE
G. & P. Pettich
J. & M. Niederost
K. & B. BERGER
J.M. & J.A. VISDOS
J. & P. OTT
R.D. CLARK
J. & D. Hagan
R. & N. Yacik
L. & S. KoTerba
J. & C. PURDY
R.B. & J.L. TRUDG
W. & T. Safranko Jr.
B. & V. ODDO
DANIEL & KAREN SPISAK
DENISE J. & DAN'L A. WEED
K. & D. KIEDAISCH
D. & R. KUHNS
B.W. & J.A. TICCONI
J. & D. Schey
R.P. & B.J. KRESSE
C. COOPER
K. & J. Kosinski
J.W. & C.Q. HAAS
J. & J. Yaros
R.E. & T.E. SCHANTZ
T.E. & D.J. HAWLEY
D.M. HAVIS
M. Dulay
S.J. & P.A. BERES
J. & P. Forsell
D.C. & C.M. FRAZIER
J.A.S. Barbetsky
R.J. & C.A. FRENCHIE
J.E. & J.A. TAYLOR
T. & J. HARDY
RICHARD J. BOETTCHER
A. & M. Yesso
R. & T. SCOTT
G. SOLTESZ
D. & J. Kalinowski
J. & D. Jimison
A.P. Kopacz
B.A. Glenn
R.T. & B.L. Palchesko
G. & C. Saraney
S. & A. Di Domenico
C. & D. Heipp
R. Pavlik
W. & P. FENNELL
A.G. & M.A. KRIYNOVICH
A.S. & J.A. BRUSH
W. & C. Kozz
E.M. & C.M. KULAGOSKE
L. DINES
Vol. 10 Pg. 80
* Inadequate description
N
SCALE 1"=300'
JAN 1, 1994
A B C D
E F G H
I J K L
M N O P
AUBURN TWP.
RELATIVE REPRESENTATION
No.
1. R. Randolph 752-305 1 Ac.
2. D.P. SHIEVER 737-1316 0.46 Ac.
3. G.J. & J.T. MATTER 736-143 .55 Ac.
4. M. & M. Yanish 663-1233 1.2 Ac.
5. B. Whitney 239-123 .712 Ac.
7. B. & H. Van Dyke 303-191 1 Ac.

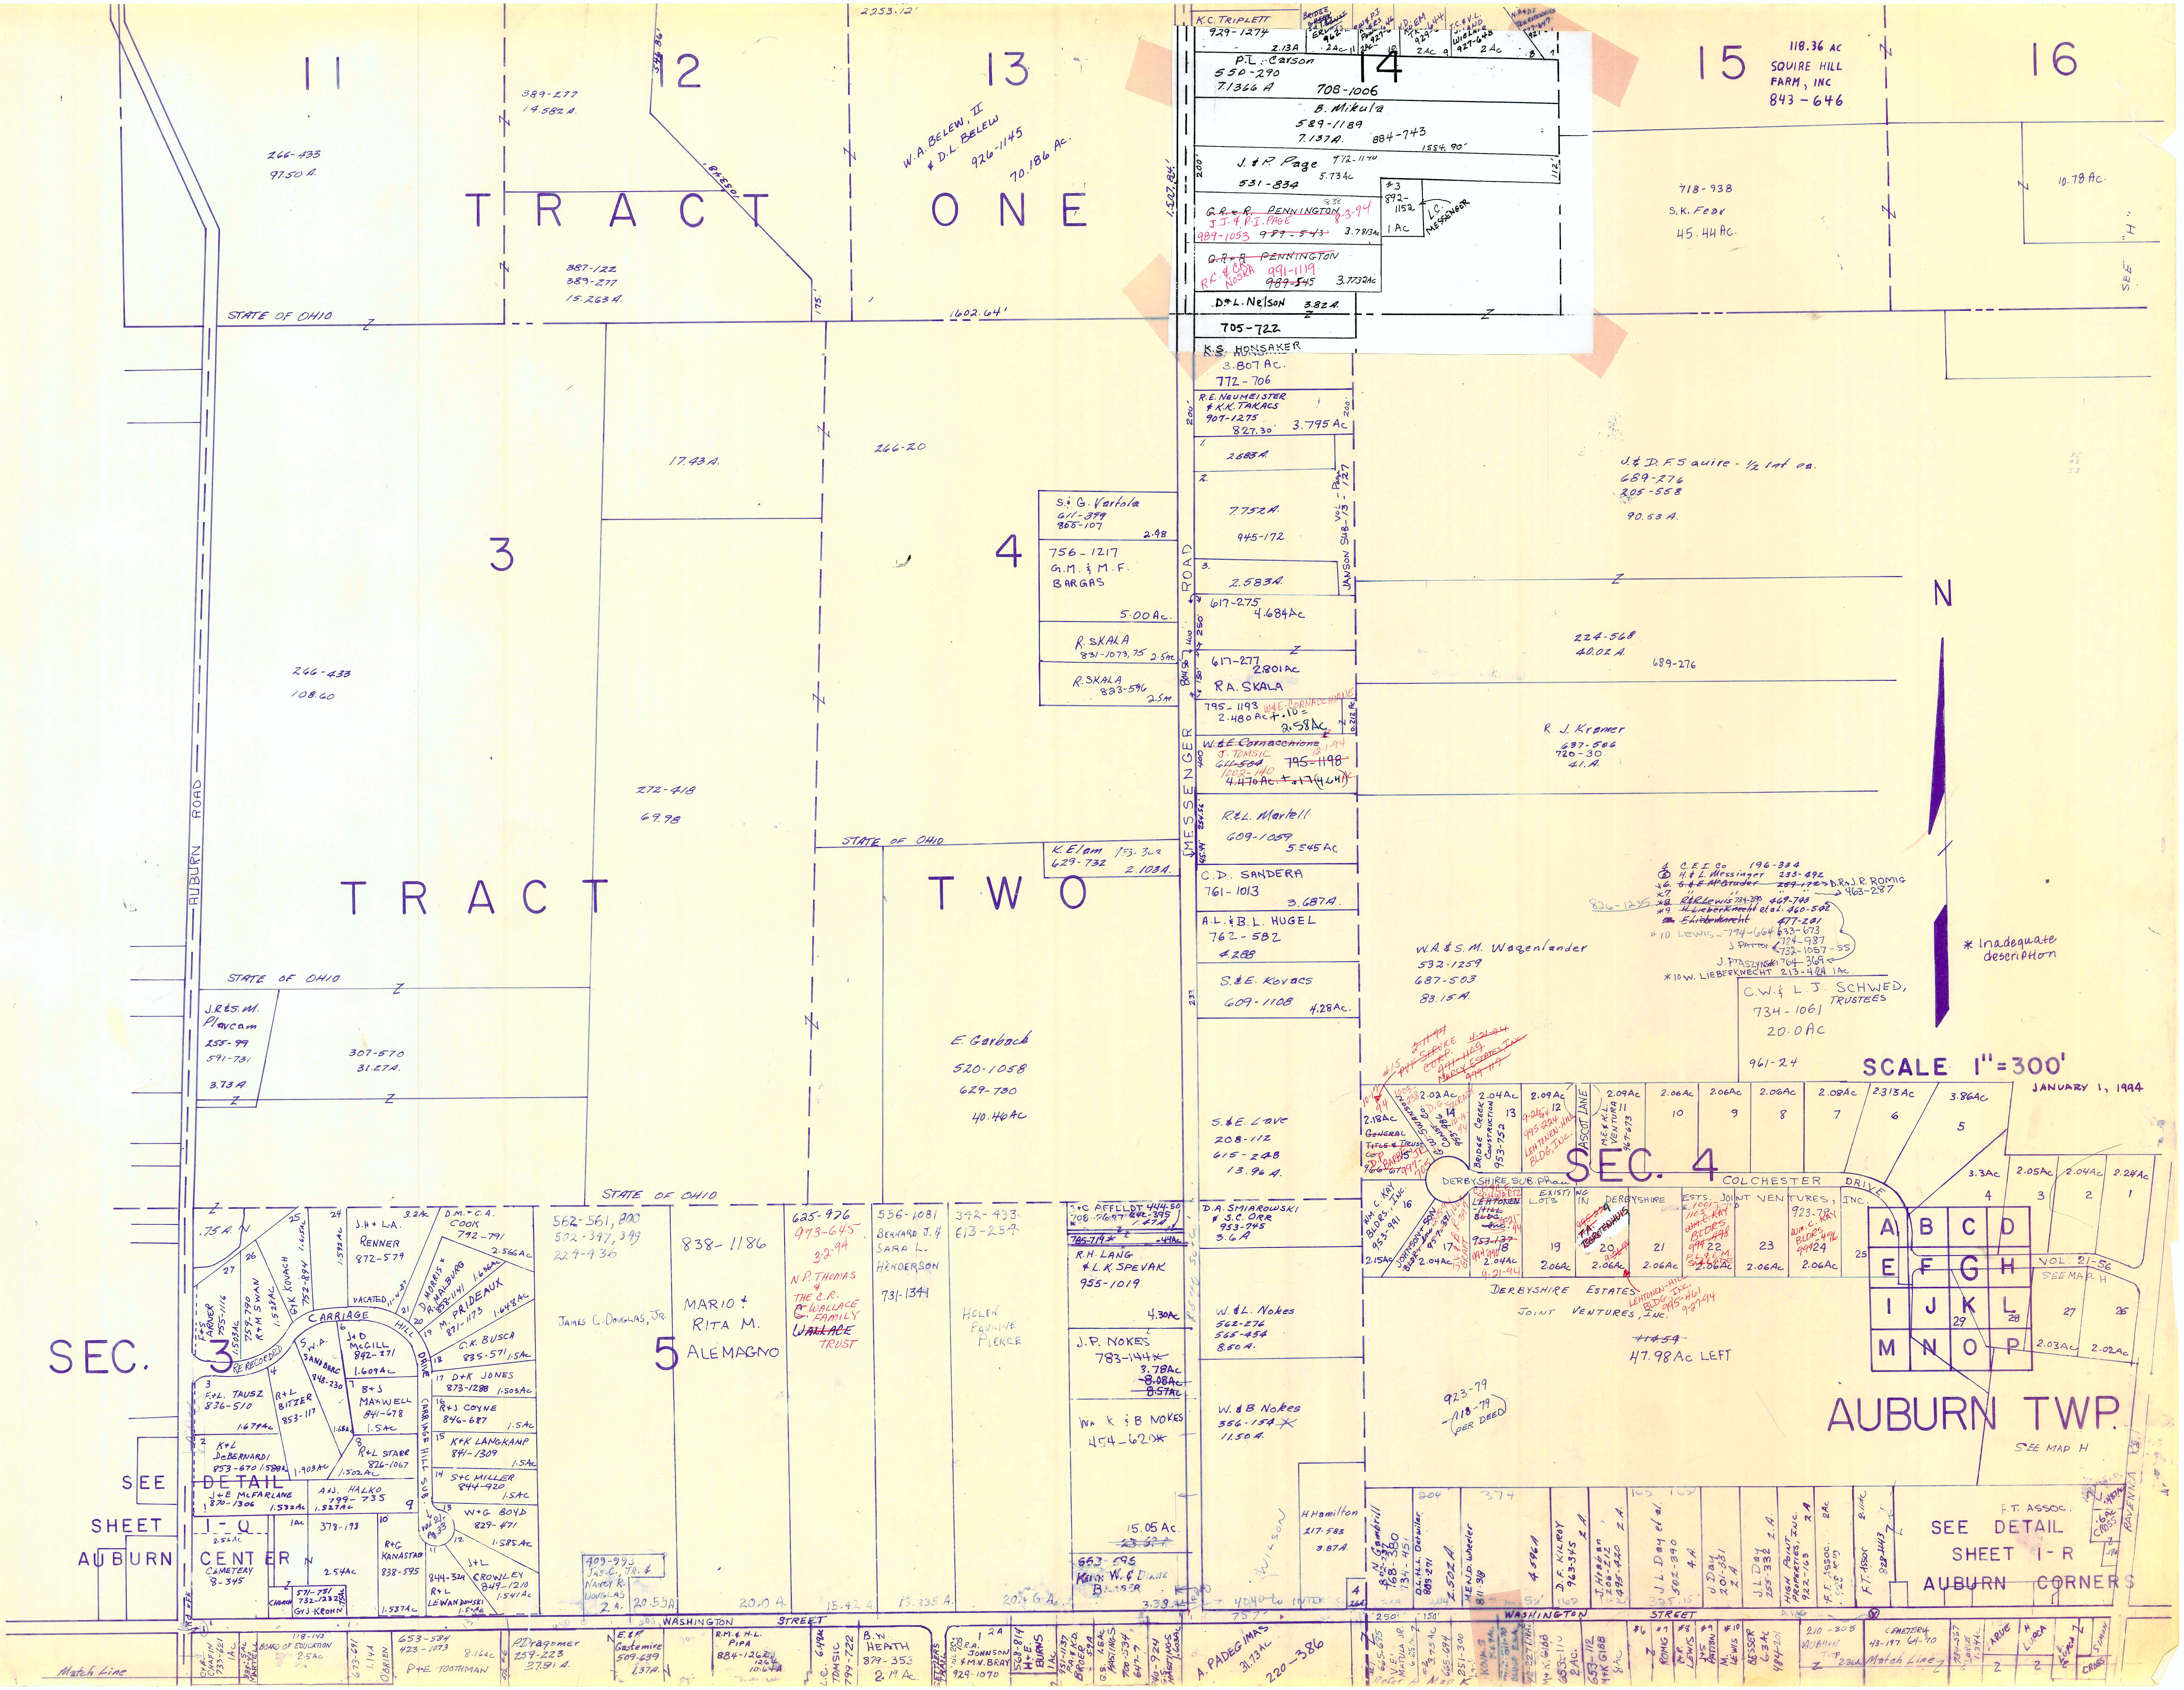

11
12
13
14
15
16
118.36 AC
SQUIRE HILL FARM, INC
843-646
TRACT ONE
TRACT TWO
3
4
5
SEC. 3
SEC. 4
STATE OF OHIO
1602.64'
2253.12'
AUBURN ROAD
MESSENGER ROAD
266-433
97.50 A.
389-277
14.582 A.
W.A. BELEW, II
& D.L. BELEW
926-1145
70.186 Ac.
387-122
389-277
15.263 A.
K.C. TRIPLETT
929-1274
P.L. Carson
550-290
7.1366 A
708-1006
B. Mikula
589-1189
7.137A.
884-743
J. & P. Page
531-834
5.73Ac
G.R. & R. PENNINGTON
J.J. & P.J. PAGE
989-1053
3.781Ac
Q.R. & R. PENNINGTON
991-1119
3.7732Ac
D & L. Nelson
3.82 A
705-722
K.S. HONSAKER
3.807 Ac.
772-706
718-938
S.K. Fear
45.44 Ac
10.78 Ac.
R.E. NEUMEISTER
& K.K. TAKACS
907-1275
827.30
3.795 Ac
266-20
17.43 A.
S. & G. Vartola
611-399
865-107
2.98
756-1217
G.M. & M.F.
BARGAS
5.00 Ac.
R. SKALA
831-1073, 75
R. SKALA
833-596
2.5A
2.583 A.
7.752 A.
945-172
2.583 A.
617-275
4.684 Ac
617-277
2.801 Ac
R.A. SKALA
795-1193
2.480 Ac
2.58 Ac
W. & E. Cornacchione
795-1198
4.470 Ac.
R. & L. Martell
609-1059
5.545 Ac
C.D. SANDERA
761-1013
3.687 A.
A.L. & B.L. HUGEL
762-582
4.288
S. & E. Kovacs
609-1108
4.28 Ac.
J. & D.F. Squire - 1/2 int ea.
689-276
705-558
90.53 A.
224-568
40.02 A.
689-276
R. J. Kramer
637-506
720-30
41. A.
266-433
108.60
272-418
69.98
K. Elam
629-732
2.103 A.
W.A. & S.M. Wagenlander
532-1259
687-503
83.15 A.
C.W. & L.J. SCHWED, TRUSTEES
734-1061
20.0 Ac
961-24
* Inadequate description
N
SCALE 1"=300'
JANUARY 1, 1994
J.R. & S.M. Plencam
255-99
591-731
3.73 A
307-570
31.27 A.
E. Garbach
520-1058
629-730
40.46 Ac
S. & E. Love
208-112
615-248
13.96 A.
562-561, 800
502-397, 399
22.9-436
838-1186
MARIO & RITA M. ALEMAGNO
625-976
973-645
N.P. THOMAS
THE C.R. WALLACE FAMILY TRUST
556-1081
BERNARD J. & SARA L. HENDERSON
731-1341
392-433
613-254
HELEN PAULINE PIERCE
R.H. LANG
& L.K. SPEVAK
955-1019
J.P. NOKES
783-1444
W. & L. Nokes
562-276
565-454
8.50 A.
W. & B. Nokes
356-158
11.50 A.
D.A. SMIAROWSKI
& S.C. ORR
953-745
3.6 A
H. Hamilton
217-585
3.87 A.
COLCHESTER DRIVE
DERBYSHIRE ESTATES JOINT VENTURES, INC.
47.98 Ac LEFT
923-79
DERBYSHIRE SUB.
A B C D
E F G H
I J K L
M N O P
AUBURN TWP.
SEE MAP H
SEE DETAIL SHEET I-R AUBURN CORNERS
SEE DETAIL SHEET I-Q AUBURN CENTER
CARRIAGE HILL DRIVE
CARRIAGE HILL SUB.
J.H. & L.A. RENNER
872-579
D.M. & C.A. COOK
792-791
G.K. BUSCA
835-571
D & K JONES
873-1288
R & J COYNE
846-687
K & K LANGKAMP
841-1309
S & C MILLER
844-920
W & G BOYD
829-471
J & L CROWLEY
849-1210
F. & L. TAUSZ
836-510
K & L DeBERNARDI
953-670
J & E McFARLANE
870-1306
A & J HALKO
299-735
R & G KANASTAB
838-595
CEMETERY
8-345
WASHINGTON STREET
P & E TOOTHMAN
A. PADEGIMAS
31.13 Ac
220-386
B.W. HEATH
879-353
Match Line

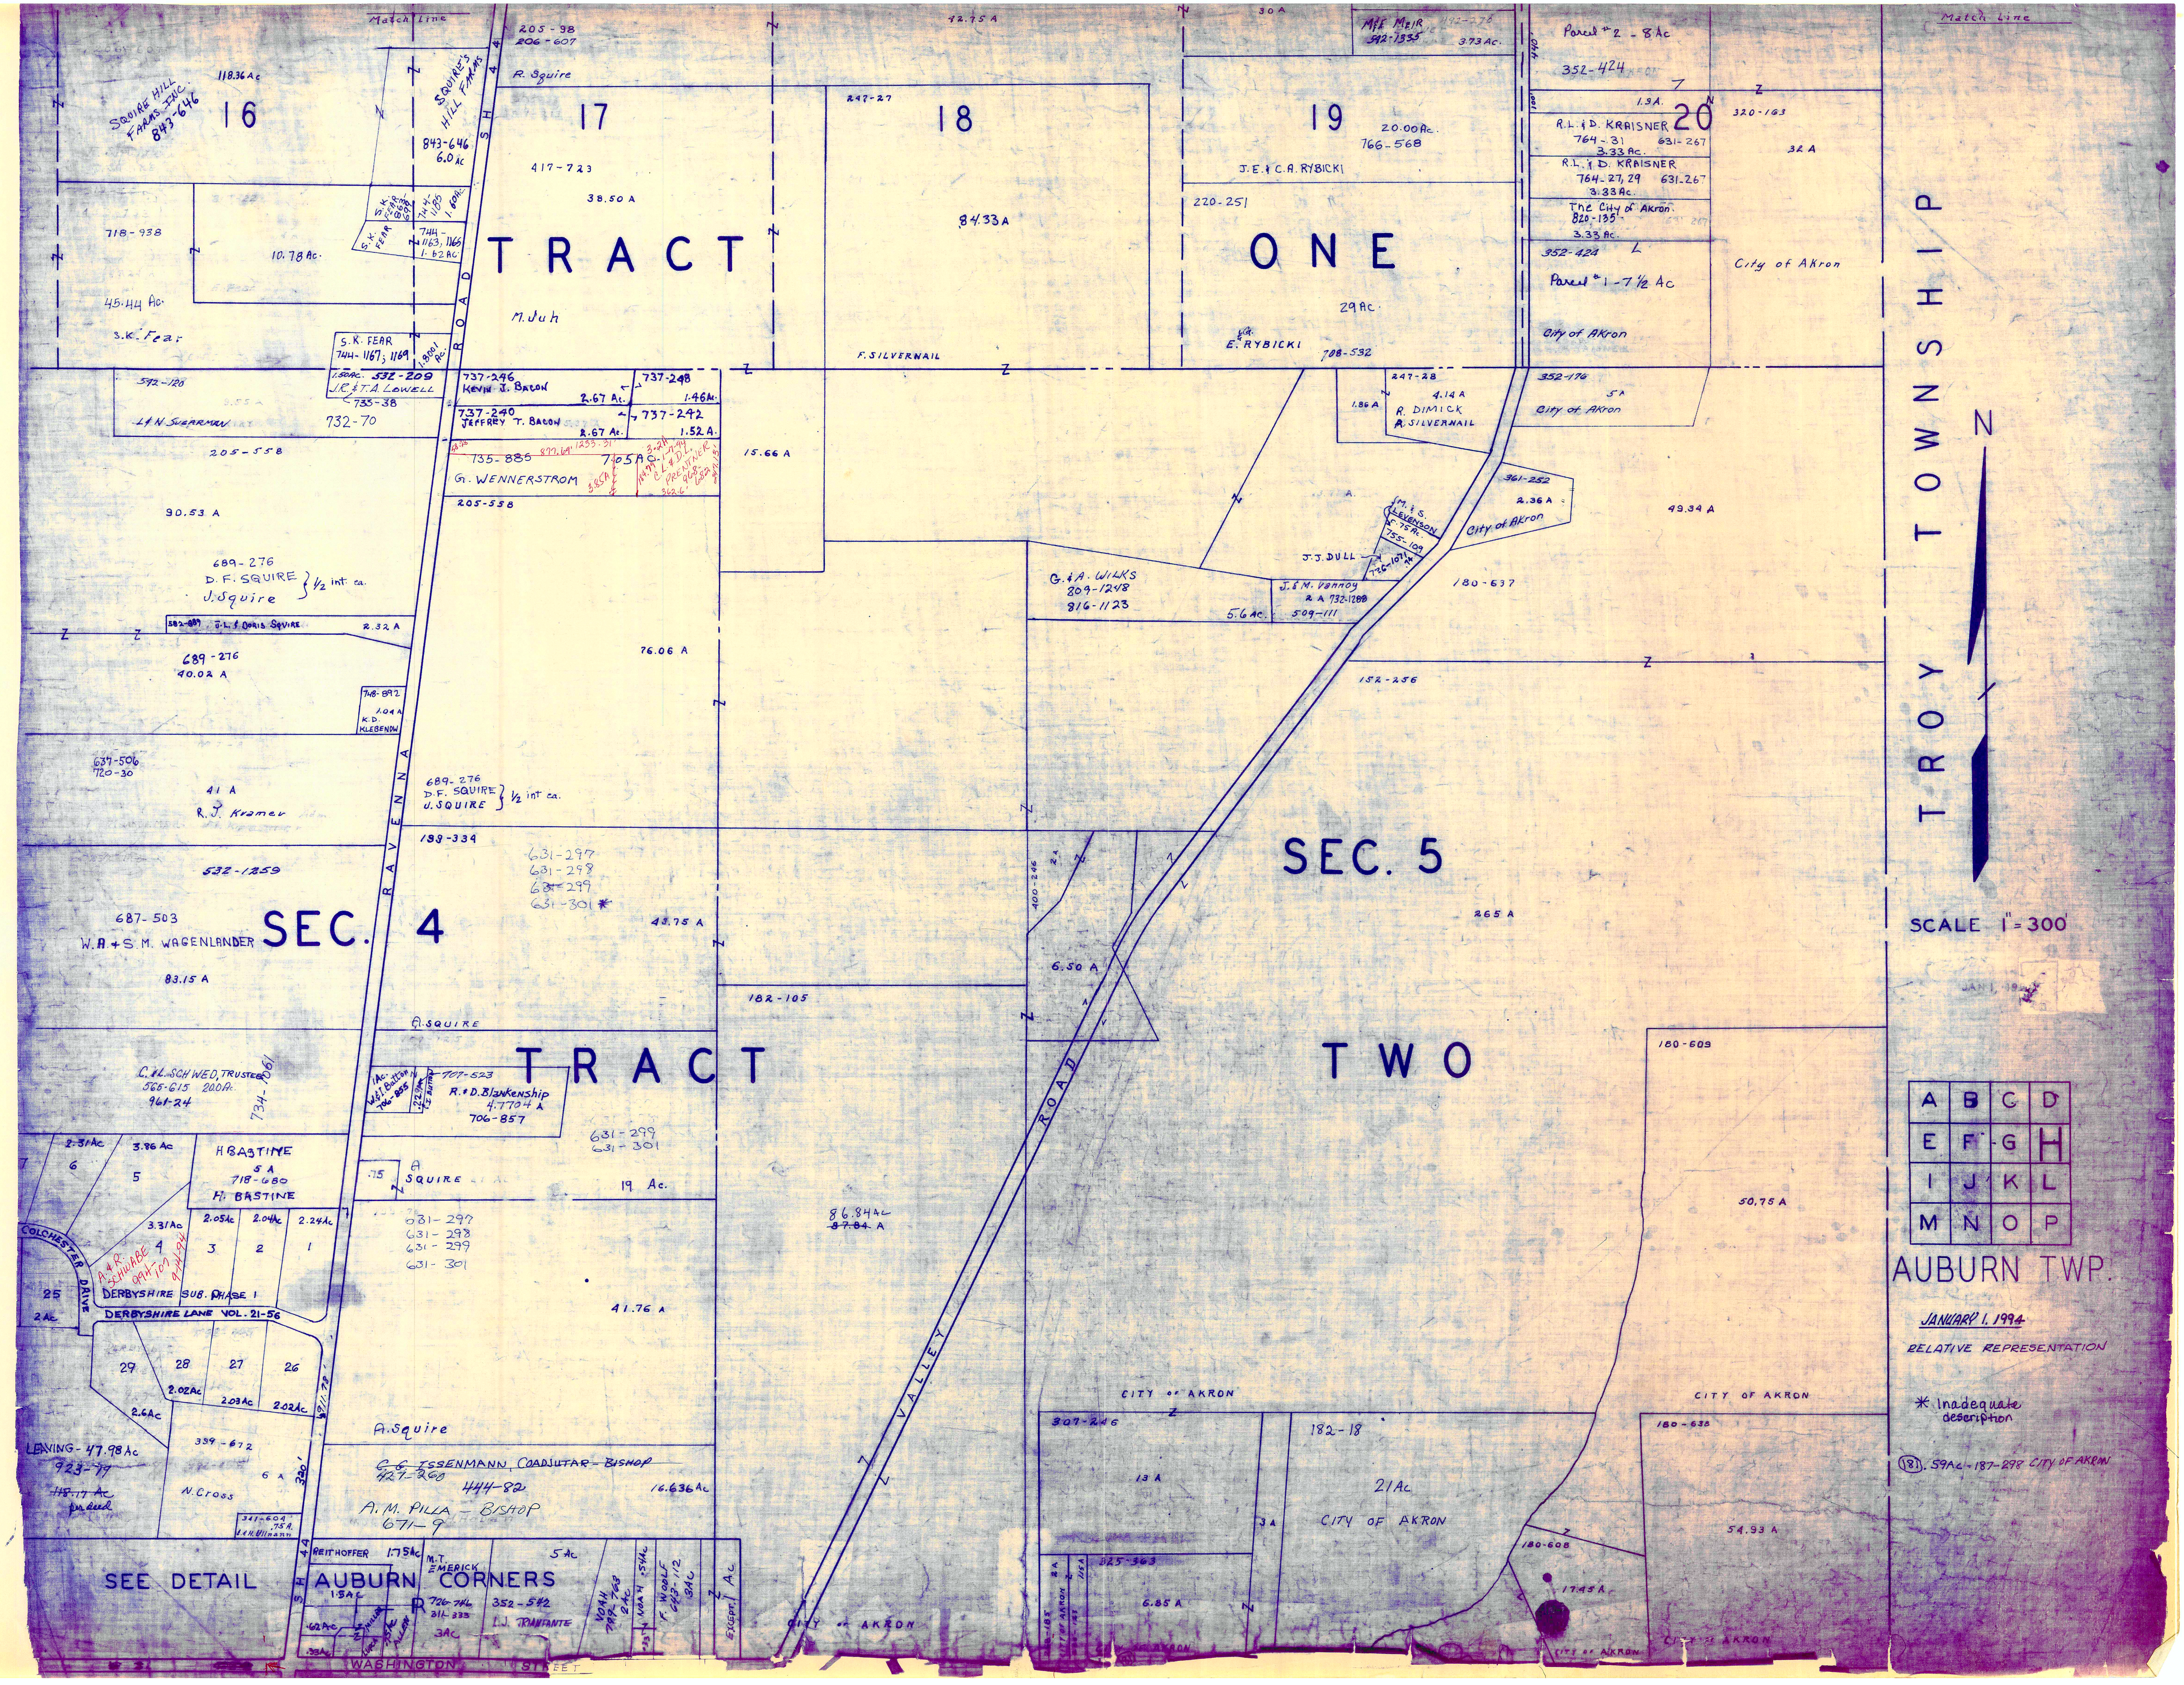
AUBURN TWP.

JANUARY 1, 1994

RELATIVE REPRESENTATION

SCALE 1" = 300'

* Inadequate description

(181). 59Ac - 187-298 CITY OF AKRON

Match Line
Match Line
TROY TOWNSHIP
N
A B C D
E F G H
I J K L
M N O P
JAN 1, 19
TRACT ONE
TRACT TWO
SEC. 4
SEC. 5
16
17
18
19
20
SQUIRE HILL FARMS INC. 843-646
118.36 Ac
SQUIRE'S HILL FARMS
843-646
6.0 Ac
205-98
206-607
R. Squire
417-723
38.50 A
718-938
10.78 Ac.
S.K. FEAR 863-699
744-1185 1.60 Ac.
S.K. FEAR
744-1163, 1165 1.62 Ac
45.44 Ac.
S.K. Fear
S.K. FEAR 744-1167; 1169
1.8001 Ac.
M. Juh
S H 44 ROAD
RAVENNA
592-120
1.50 Ac. 532-209
J.R. & T.A. LOWELL
733-38
L & N SUGARMAN
732-70
737-246 KEVIN J. BACON 2.67 Ac.
737-248 1.46 Ac.
737-240 JEFFREY T. BACON 2.67 Ac.
737-242 1.52 A.
205-558
135-885 7.05 Ac.
58.38
877.69' 1233.31'
G. WENNERSTROM
3.85 A
3.2 A
184.79' 1-7-94
C.L. & D.L. PRENTNER 968-682 362.6' 341.3'
205-558
15.66 A
90.53 A
689-276
D.F. SQUIRE
J. Squire
1/2 int. ea.
582-889 J.L. & DORIS SQUIRE
2.32 A
689-276
40.02 A
748-892 1.04 A K.D. KLEBENOW
76.06 A
637-506
720-30
41 A
R.J. Kramer
689-276
D.F. SQUIRE
J. SQUIRE
1/2 int. ea.
199-334
631-297
631-298
631-299
631-301 *
532-1259
687-503
W.A. & S.M. WAGENLANDER
83.15 A
43.75 A
A. SQUIRE
182-105
C. & L. SCHWED, TRUSTEE
565-615 20.0 Ac.
961-24
734-1061
1 Ac. W. & I. Button 706-855
.229 Ac. I. Button
707-523
R. & D. Blankenship
4.7704 A
706-857
631-299
631-301
7
6
2.31 Ac
3.86 Ac
5
H BASTINE
5 A
718-680
H. BASTINE
.75
A SQUIRE
19 Ac.
3.31 Ac
4
A. & R. SCHWABE 994-107 9-14-94
2.05 Ac
2.04 Ac
2.24 Ac
3
2
1
631-297
631-298
631-299
631-301
COLCHESTER DRIVE
25
2 Ac
DERBYSHIRE SUB. PHASE 1
DERBYSHIRE LANE VOL. 21-56
29
28
27
26
2.02 Ac
2.03 Ac
2.02 Ac
2.6 Ac
911.78'
41.76 A
86.84 Ac
~~87.84~~ A
LEAVING - 47.98 Ac
923-79
~~118.17 Ac~~
per deed
339-672
6 A
N. Cross
320'
341-604 .75 A. L. & H. Ullmann
A. Squire
~~C.G. ISSENMANN, COADJUTAR - BISHOP~~
~~427-260~~
444-82
A.M. PILLA - BISHOP
671-9
16.636 Ac
SEE DETAIL AUBURN CORNERS
S H 44
REITHOFFER 1.75 Ac
1.5 Ac
.62 Ac
.33 Ac
MILLER
LUPCA
.75 Ac
ALLEN
M.T. EMERICK
726-746
311-333
3 Ac
5 Ac
352-542
L.J. TRIANFANTE
NOAH 799-763 2 Ac
NOAH .54 Ac
.33
F. WOOLF 643-112 3 Ac
EXCEPT. 1 Ac
WASHINGTON STREET
42.75 A
30 A
247-27
84.33 A
F. SILVERNAIL
M & E MEIR 592-1335
492-276
3.73 Ac.
20.00 Ac.
766-568
J.E. & C.A. RYBICKI
220-251
29 Ac.
E. & G. RYBICKI
708-532
440'
100'
Parcel #2 - 8 Ac
352-424
1.9 A.
R.L. & D. KRAISNER
764-31 631-267
3.33 Ac.
R.L. & D. KRAISNER
764-27, 29 631-267
3.33 Ac.
The City of Akron
820-135
3.33 Ac.
352-424
Parcel #1 - 7 1/2 Ac
City of Akron
320-163
32 A
City of Akron
247-28
4.14 A
1.86 A
R. DIMICK
R. SILVERNAIL
352-176
5 A
City of Akron
361-252
2.36 A
City of Akron
49.34 A
M. & S. LEVENSON
.75 Ac.
755-109
J.J. DULL
736-1071
G. & A. WILKS
809-1248
816-1123
5.6 Ac.
J. & M. Vannoy
2 A 732-1288
509-111
180-637
152-256
400-246
2 A
6.50 A
265 A
VALLEY ROAD
180-609
50.75 A
CITY OF AKRON
307-246
13 A
3 A
182-18
21 Ac
CITY OF AKRON
325-363
6.85 A
2 A
1.5 A
CITY OF AKRON
CITY OF AKRON
CITY OF AKRON
180-608
17.45 A
CITY OF AKRON
180-638
54.93 A
CITY OF AKRON

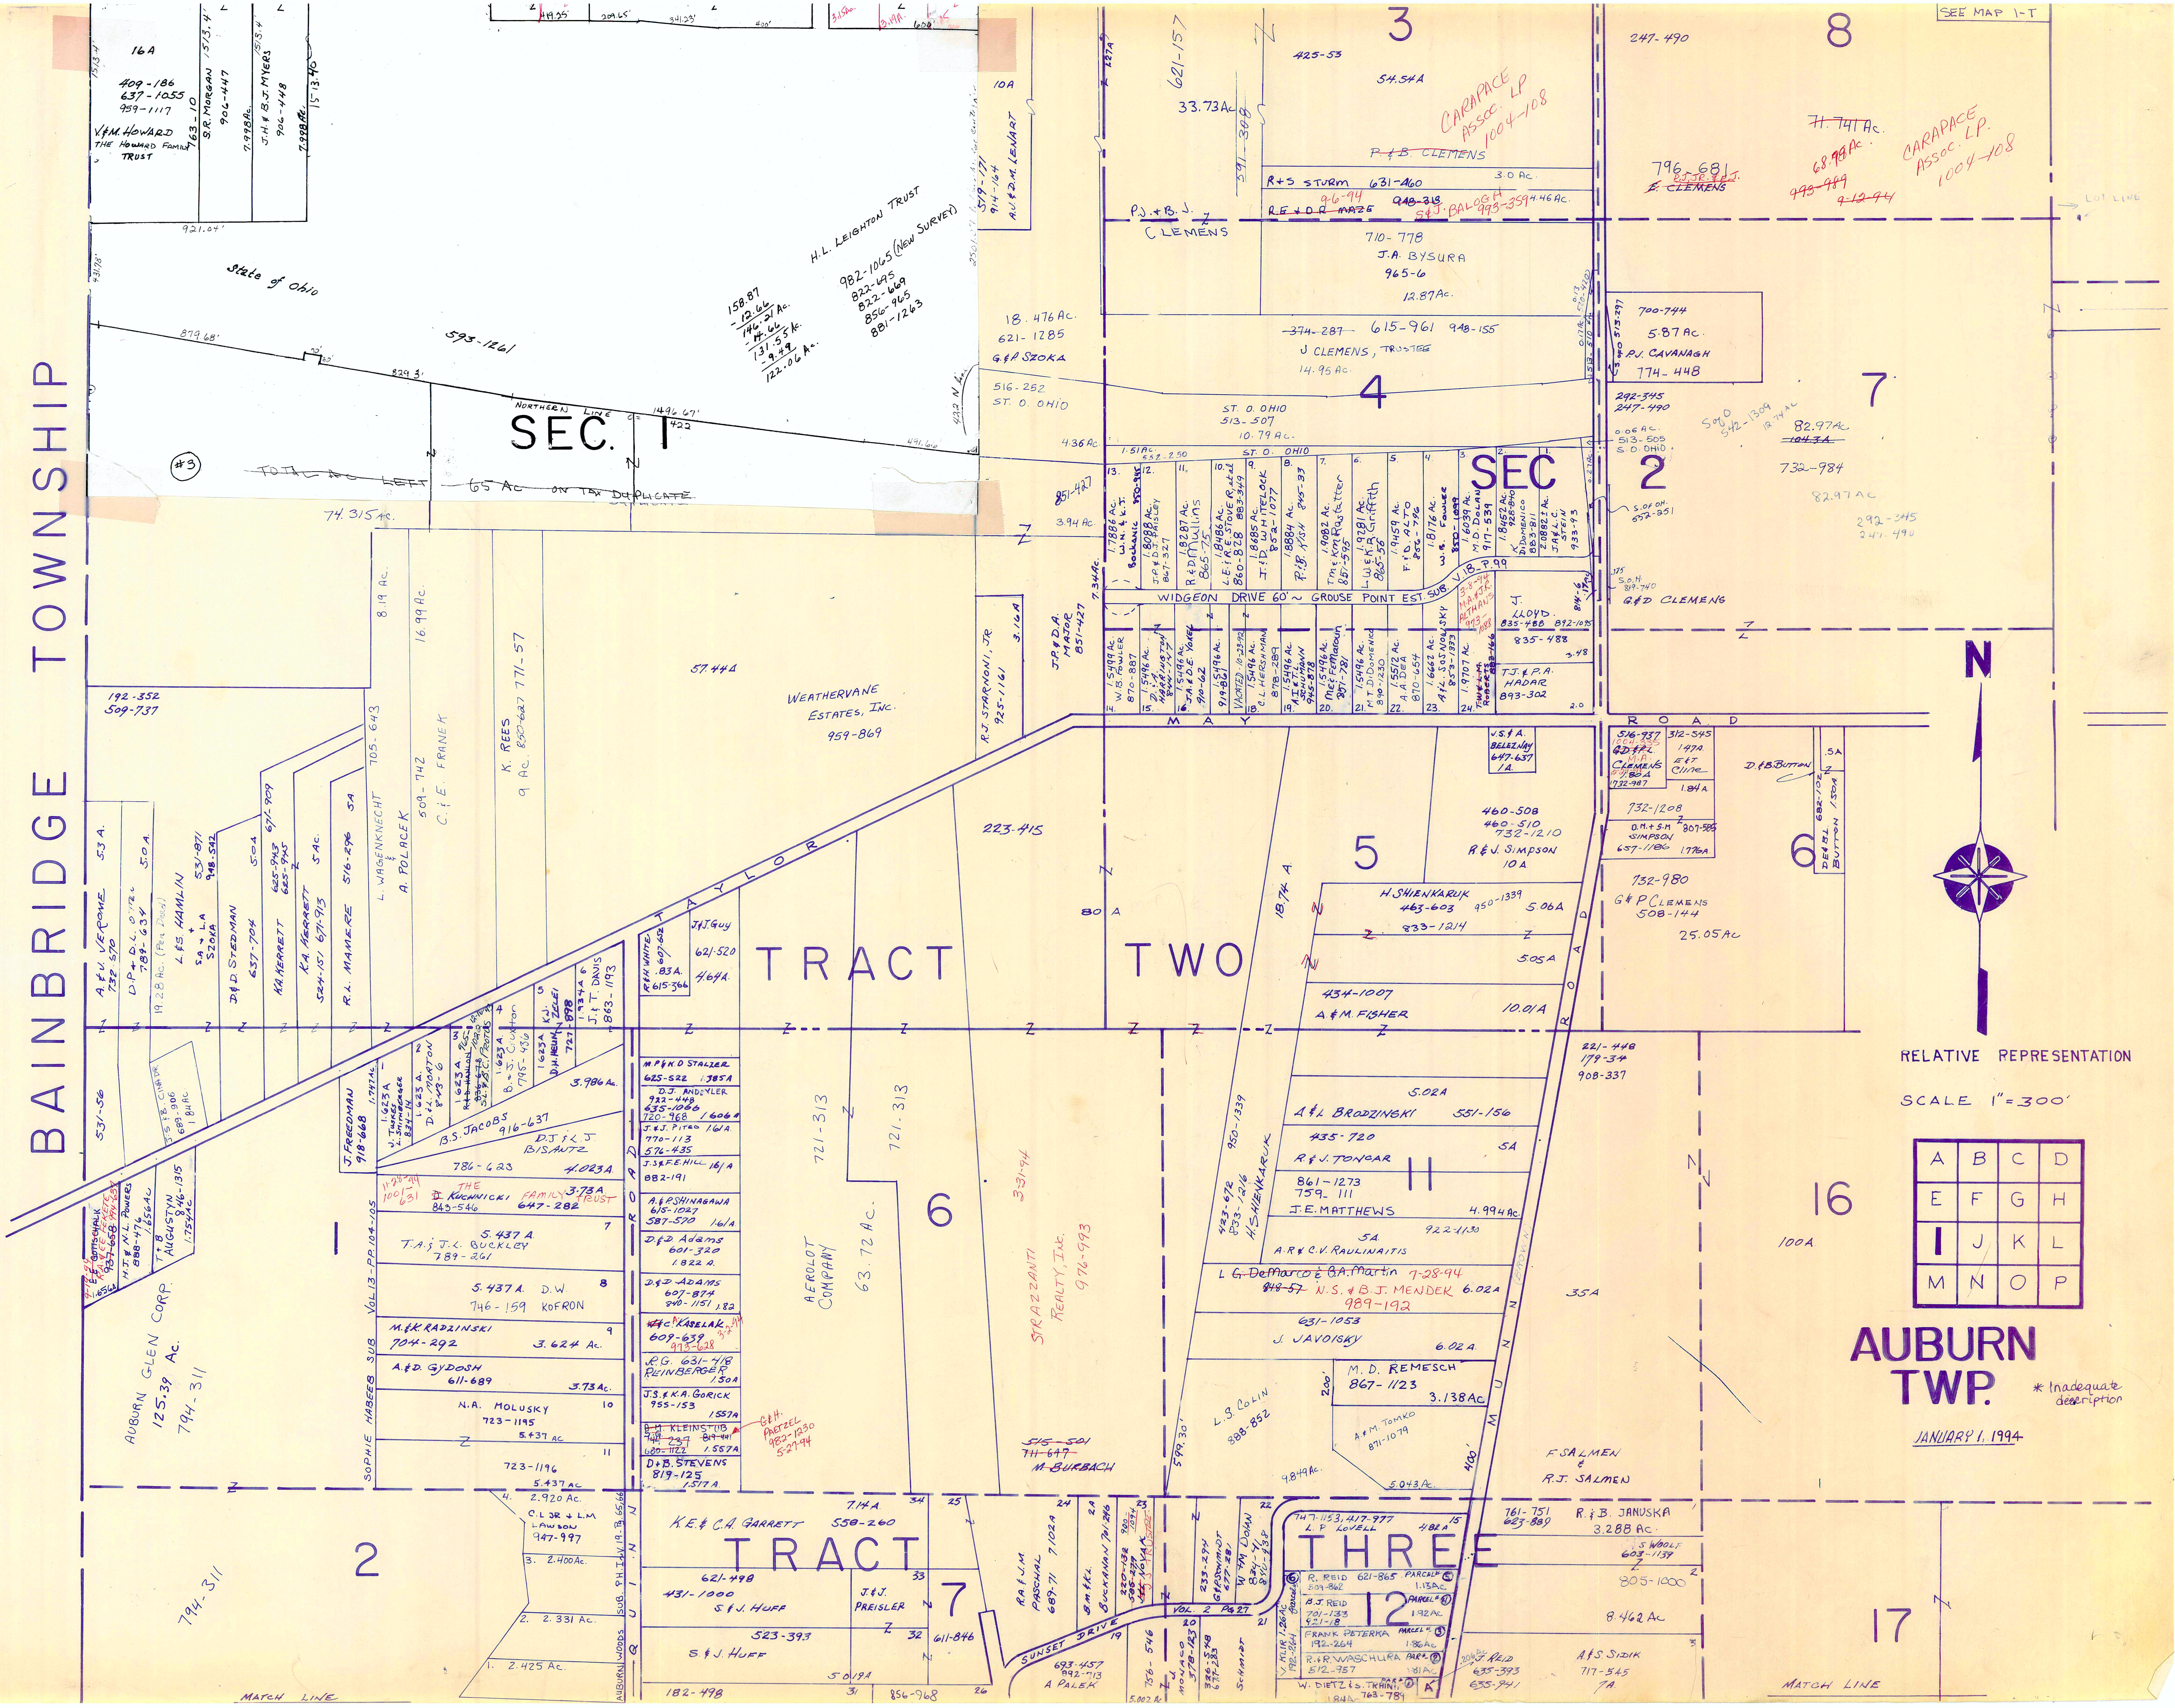
SEE MAP 1-T
BAINBRIDGE TOWNSHIP
SEC. 1
SEC 2
3
8
4
7
5
6
TRACT TWO
TRACT THREE
TRACT 7
1
2
6
11
12
16
17
MAY ROAD
TAYLOR ROAD
MUNN ROAD
SUNSET DRIVE
WIDGEON DRIVE 60' ~ GROUSE POINT EST. SUB. V.18-P.99
State of Ohio
593-1261
H.L. LEIGHTON TRUST
982-1065 (New Survey)
822-695
822-669
856-965
881-1263
158.87
12.66
146.21 Ac.
14.66
131.55 Ac.
9.49
122.06 Ac.
NORTHERN LINE
1496.67'
879.68'
829.3'
921.04'
~~TOTAL AC LEFT~~ 65 Ac ON THE DUPLICATE
#3
74.315 Ac.
16A
409-186
637-1055
959-1117
V&M HOWARD
THE HOWARD FAMILY TRUST
S.R. MORGAN
906-447
J.H. & B.J. MYERS
906-448
10A
A.J.&D.M. LENART
914-164
CARAPACE Assoc. LP 1004-108
~~P&B CLEMENS~~
54.54A
425-53
621-157
33.73Ac.
R+S STURM 631-460
R.E.+D.R. MAZE
S&J. BALOGH 993-359
P.J.+B.J. CLEMENS
710-778
J.A. BYSURA
965-6
12.87Ac.
18.476Ac.
621-1285
G&P SZOKA
516-252
ST. O. OHIO
~~374-287~~ 615-961 948-155
J CLEMENS, TRUSTEE
14.95Ac.
ST. O. OHIO
513-507
10.79Ac.
247-490
~~71.741Ac.~~
68.49Ac.
796-681
~~E. CLEMENS~~
~~993-989~~
700-744
5.87Ac.
P.J. CAVANAGH
774-448
292-345
247-490
82.97Ac.
~~104.3A~~
732-984
G&D CLEMENS
LLOYD
835-488
T.J.&P.A. HADAR
893-302
57.44A
WEATHERVANE ESTATES, INC.
959-869
R.J. STARNONI, JR
925-1161
J.P.&D.A. MAJOR
851-427
192-352
509-737
K. REES
9 Ac. 820-627 771-57
C.I.E. FRANEK
L. WAGENKNECHT
A. POLACEK
A.&V. JEROME
L.&S. HAMLIN
D.&D. STEDMAN
K.A. KERRETT
R.L. MANKRE
223-415
H SHIENKARUK
463-603
833-1214
434-1007
A.&M. FISHER
10.01A
460-508
460-510
732-1210
R.&J. SIMPSON
10A
732-980
G.&P. CLEMENS
508-144
25.05Ac
D.&B. BUTTON
D.M.+S.M. SIMPSON
J&J Guy
621-520
AEROLOT COMPANY
63.72 Ac.
721-313
STRAZZANTI REALTY, Inc. 976-993
A.&L. BRODZINSKI 551-156
435-720
R.&J. TONCAR
861-1273
759-111
J.E. MATTHEWS
A.R.&C.V. RAULINAITIS
L.G. DeMarco & B.A. Martin 7-28-94
N.S.&B.J. MENDEK 989-192
631-1053
J. JAVOISKY
M.D. REMESCH
867-1123
3.138Ac.
L.S. COLIN
888-852
F. SALMEN & R.J. SALMEN
R.&B. JANUSKA
3.288Ac.
8.462Ac.
A.&S. SIDIK
717-545
100A
35A
AUBURN GLEN CORP.
125.39 Ac.
794-311
J. FREEDMAN
918-668
B.S. JACOBS
916-637
D.J.&J. BISANTZ
D. KUCHNICKI FAMILY TRUST
647-282
T.A.&J.C. BUCKLEY
789-261
D.W. KOFRON
746-159
M.&K. RADZINSKI
704-292
A.&D. GYDOSH
611-689
N.A. MOLUSKY
723-1195
723-1196
SOPHIE HABEEB SUB. VOL 13-PP 104-105
C.L. JR + L.M. LAWSON
947-997
M.P.&K.D. STALZER
D.J. ANDEXLER
A.&P. SHINAGAWA
D.&D. Adams
601-320
D.&D. ADAMS
R.G. 631-418 REINBERGER
J.S.&K.A. GORICK
955-153
D.&B. STEVENS
819-125
K.E.&C.A. GARRETT
558-260
621-498
431-1000
S.&J. HUFF
523-393
J.&J. PREISLER
611-846
182-498
856-968
A PALEK
R. REID 621-865
A.J. REID
FRANK PETERKA
R.&R. WASCHURA
W. DIETZ
MATCH LINE
AUBURN WOODS SUB.

RELATIVE REPRESENTATION

SCALE 1" = 300'

A	B	C	D
E	F	G	H
I	J	K	L
M	N	O	P

AUBURN TWP.

JANUARY 1, 1994

* Inadequate description

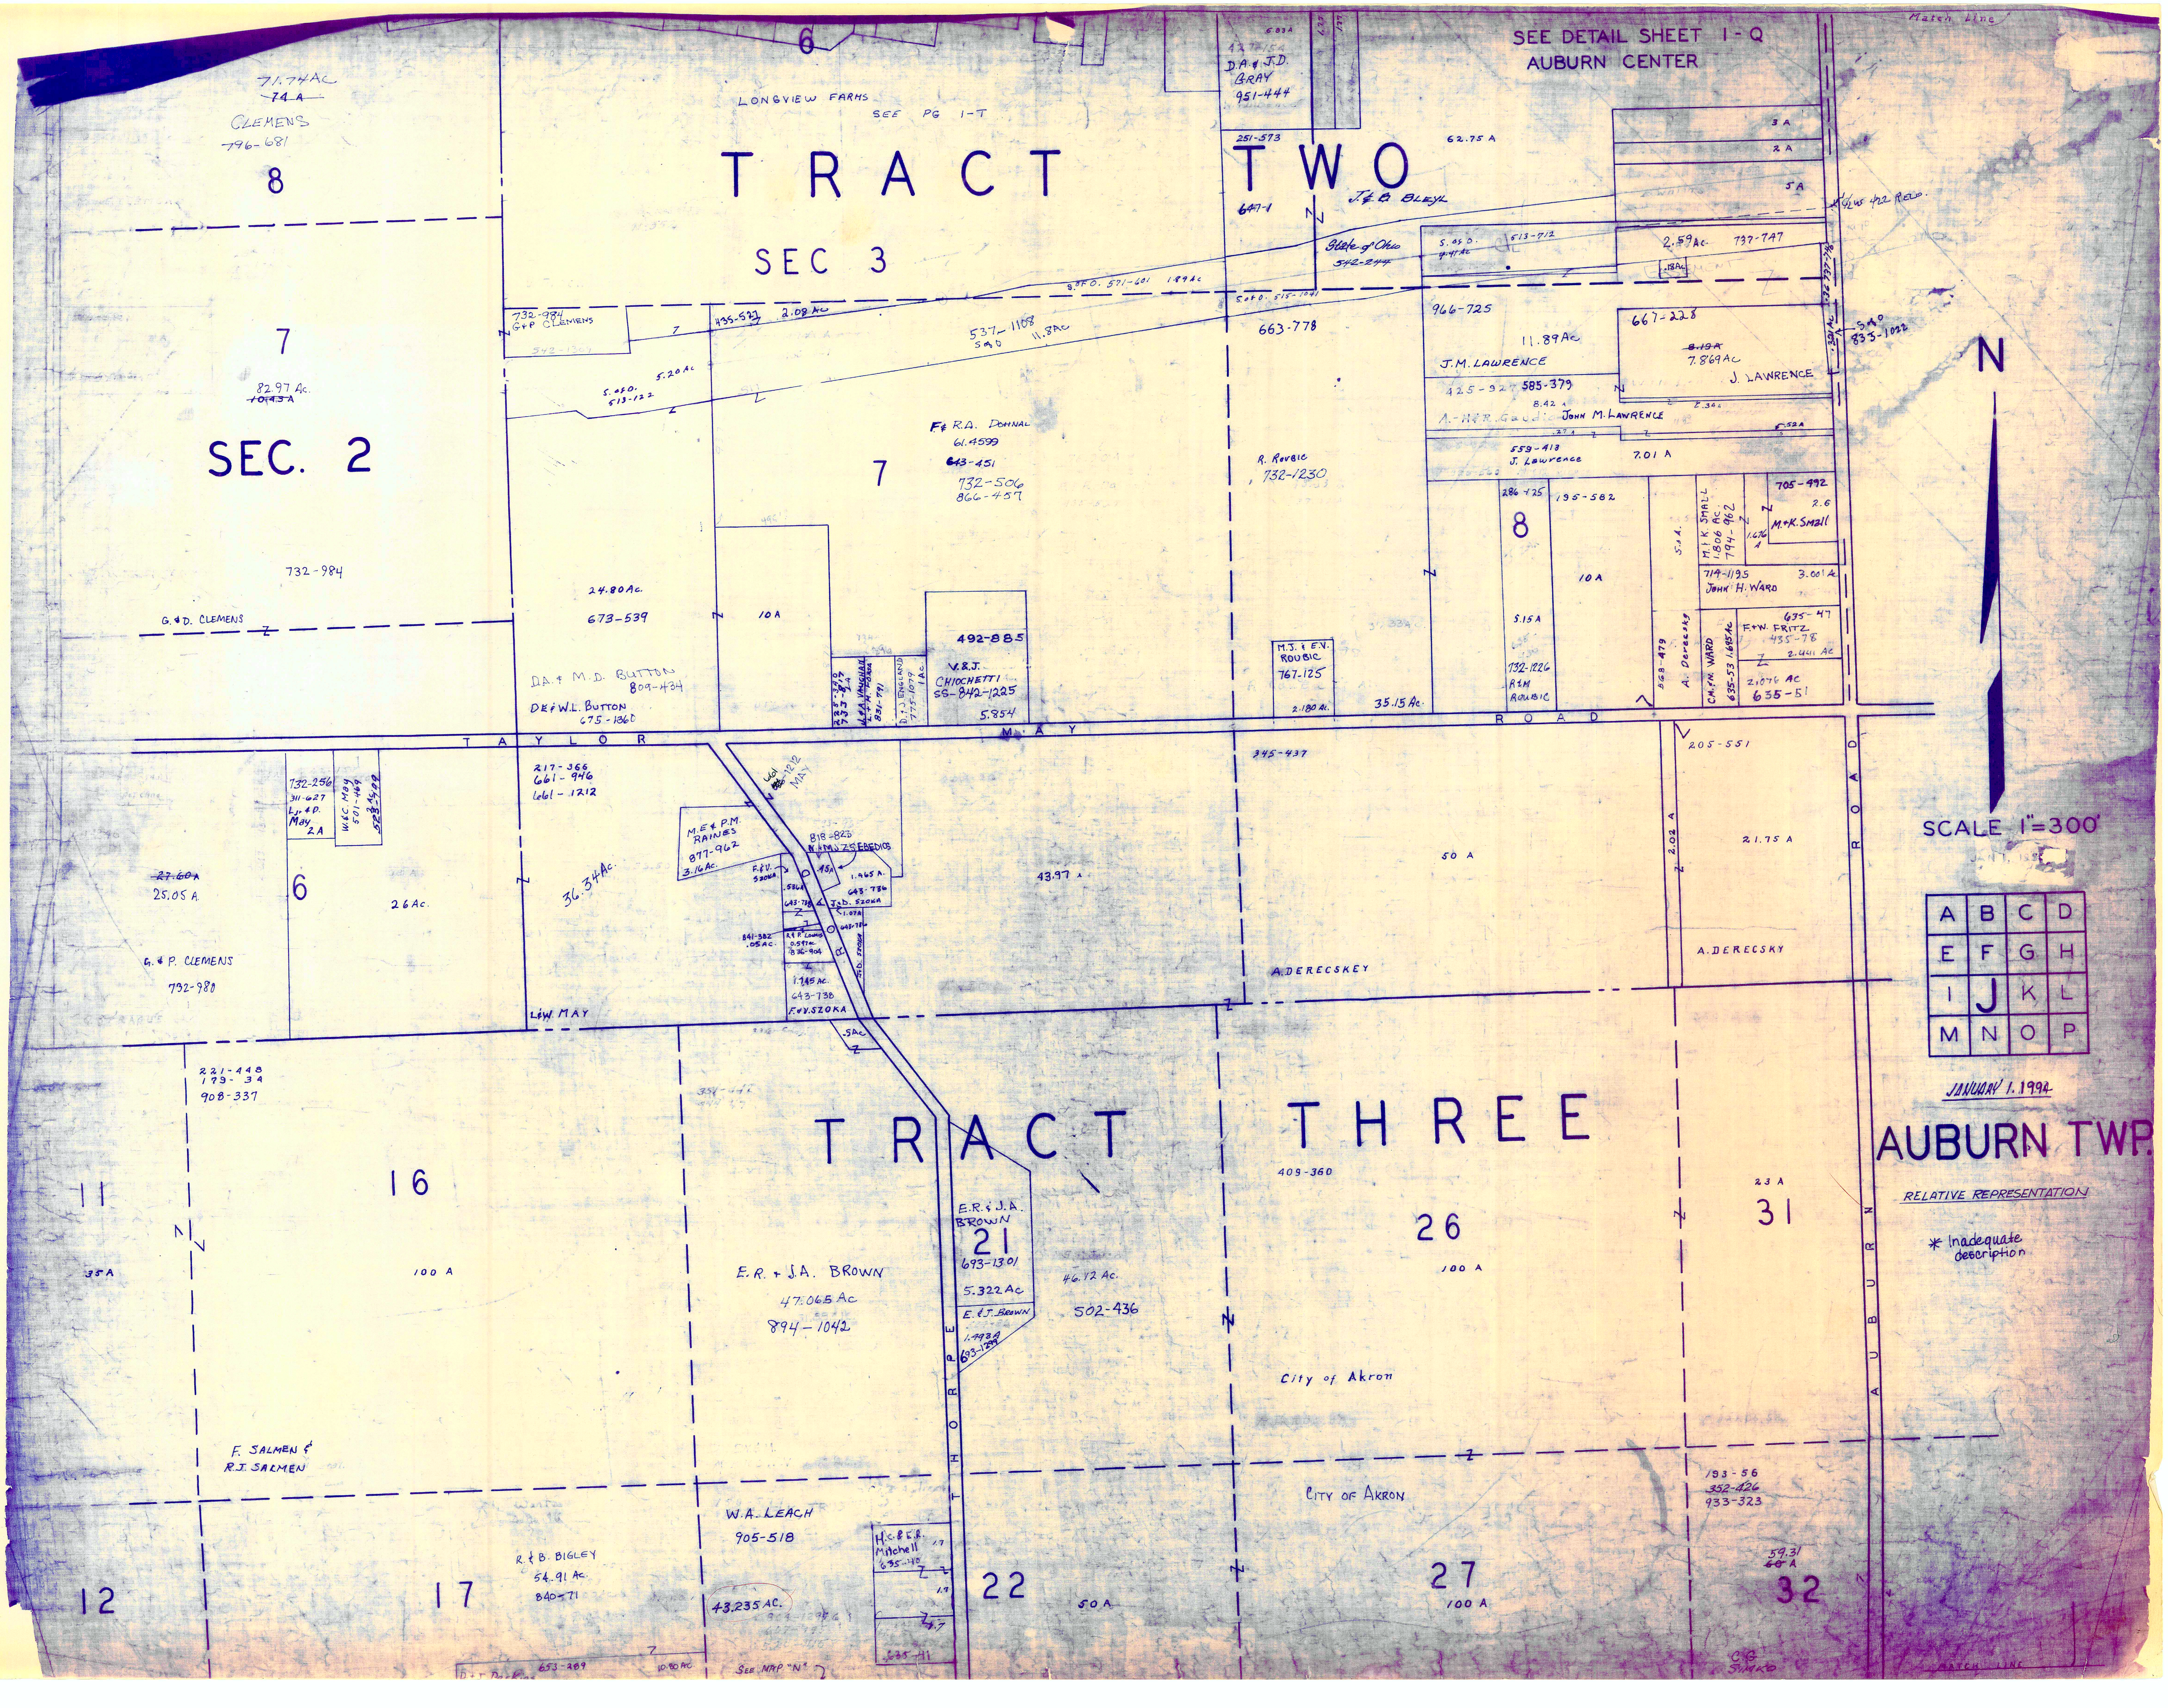
SEE DETAIL SHEET 1-Q
AUBURN CENTER
TRACT TWO
SEC 3
SEC. 2
LONGVIEW FARMS SEE PG 1-T
71.74 AC
74 A
CLEMENS
796-681
8
7
82.97 Ac.
732-984
G.&D. CLEMENS
732-984 G&P CLEMENS
435-521 2.08 Ac
537-1108 S&O 11.8 Ac
S.&O. 513-122 5.20 Ac
F & R.A. DOHNAL
61.4599
643-451
732-506
866-457
24.80 Ac.
673-539
10 A
DA & M.D. BUTTON 809-434
DE & W.L. BUTTON 675-1860
V.& J. CHIOCCHETTI
492-885
842-1225
5.854
DA & J.D. GRAY 951-444
251-573
647-1
J & B. BLEYL
62.75 A
State of Ohio 542-244
663-778
R. ROUBIC 732-1230
M.J. & E.V. ROUBIC 767-125
2.180 Ac.
35.15 Ac.
966-725
11.89 Ac
J.M. LAWRENCE
585-379
JOHN M. LAWRENCE
667-228
7.869 Ac
J. LAWRENCE
559-413 J. Lawrence
7.01 A
2.59 Ac. 737-747
3 A
2 A
5 A
8
10 A
195-582
5.15 A
732-1226 R&M ROUBIC
M & K SMALL
705-492
JOHN H. WARD
714-1195
3.00 A
F & W. FRITZ
635-47
435-78
2.076 AC
635-51
A. DERECSKY
TAYLOR MAY ROAD
217-366
661-946
661-1212
732-256
311-627
L.J. & D. May 2A
27.60 A
25.05 A
6
26 Ac.
36.34 Ac.
G & P. CLEMENS 732-980
L & W MAY
M.E & P.M. RAINES 877-962 3.16 Ac.
818-823
643-736
J. & D. SZOKA
643-738
F & V. SZOKA
43.97 A
345-437
50 A
A. DERECSKY
205-551
2.02 A
21.75 A
A. DERECSKY
TRACT THREE
221-448
173-34
908-337
11
16
35 A
100 A
E.R. & J.A. BROWN
47.065 Ac
894-1042
E.R. & J.A. BROWN
21
693-1301
5.322 Ac
E.& J. BROWN
46.12 Ac.
502-436
409-360
26
100 A
City of Akron
23 A
31
F. SALMEN & R.J. SALMEN
W.A. LEACH 905-518
R & B. BIGLEY 54.91 Ac. 840-71
43.235 AC.
H.C. & E.R. Mitchell
CITY OF AKRON
12
17
22
50 A
27
100 A
193-56
352-426
933-323
59.31 A
32
THORPE ROAD
AUBURN ROAD
SEE MAP "N"
N
SCALE 1"=300'
A B C D
E F G H
I J K L
M N O P

JANUARY 1, 1994

AUBURN TWP.

RELATIVE REPRESENTATION

* Inadequate description

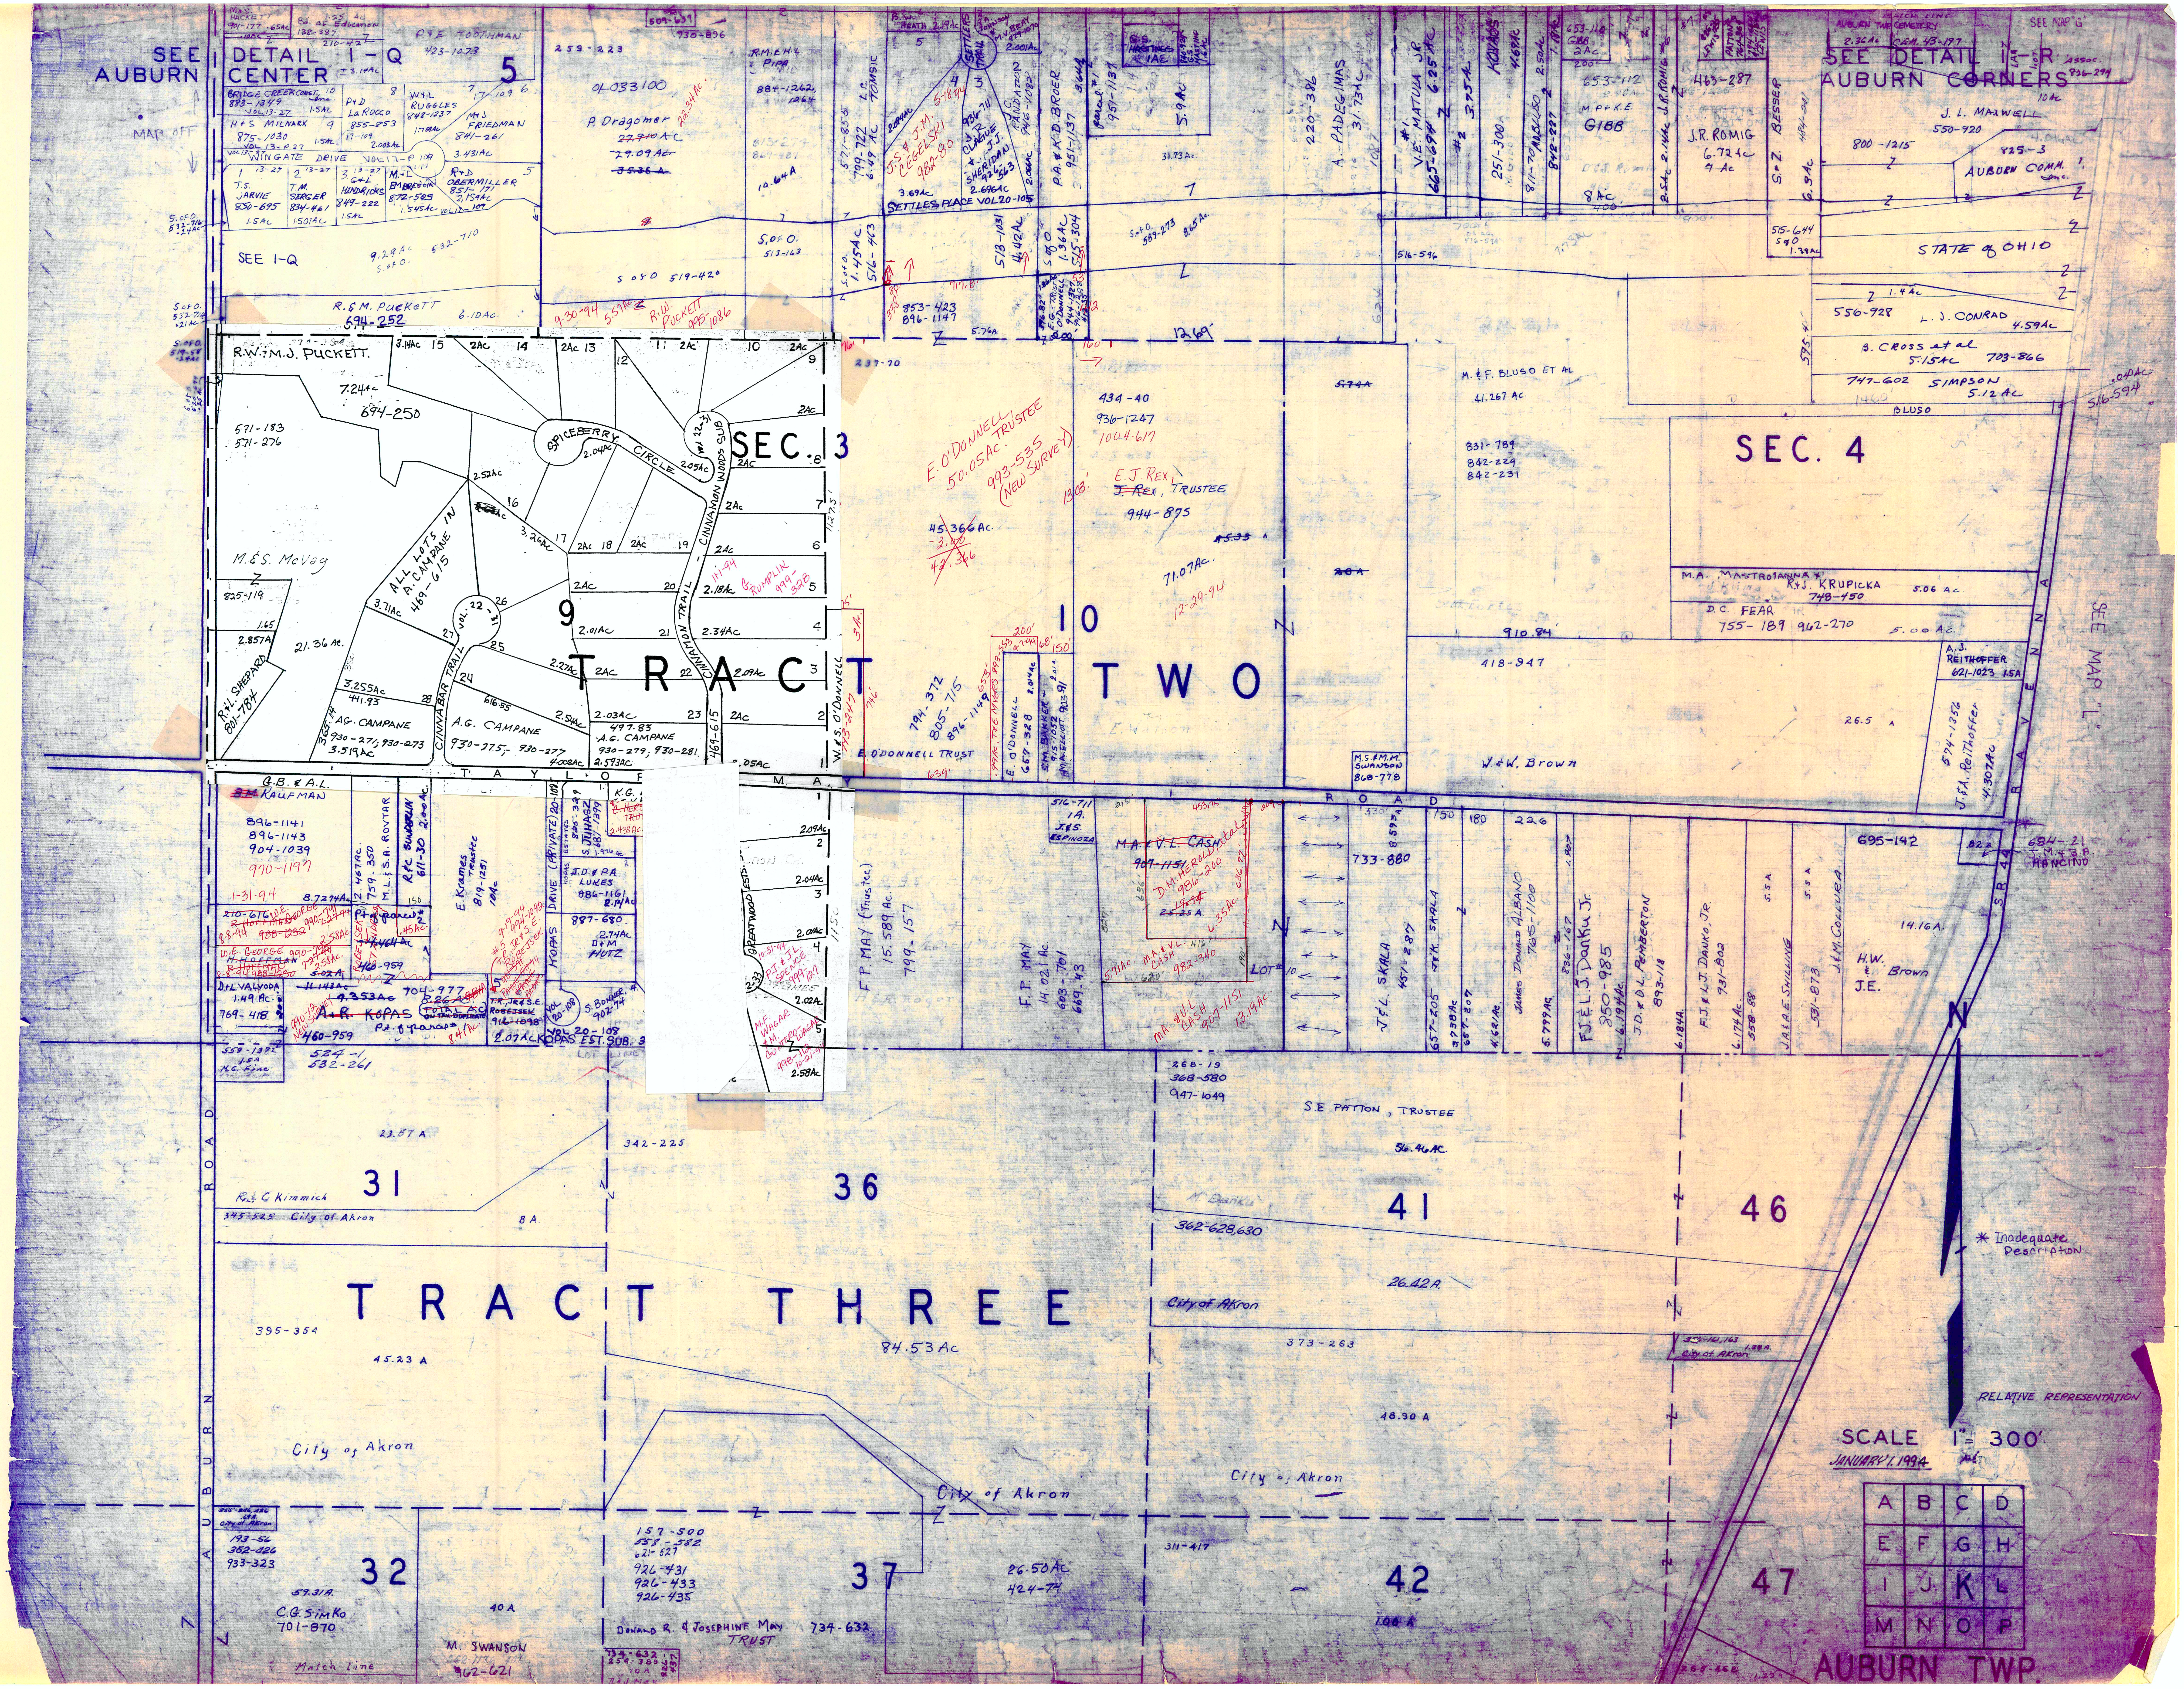
SEE DETAIL I-Q AUBURN CENTER
SEE DETAIL I-R AUBURN CORNERS
SEE MAP "G"
SEE MAP "L"
5
SEC. 3
SEC. 4
9
10
TRACT TWO
TRACT THREE
31
36
41
46
32
37
42
47
TAYLOR MAY ROAD
AUBURN ROAD
RAVENNA ROAD
S.R. 44
SPICEBERRY CIRCLE
CINNAMON TRAIL
CINNABAR TRAIL
CINNAMON WOODS SUB
WINGATE DRIVE
SETTLES TRAIL
SETTLES PLACE VOL 20-105
R.W. & M.J. PUCKETT
R.&M. PUCKETT 694-252
ALL LOTS A.G. CAMPANE 469-615
A.G. CAMPANE 930-275; 930-277
A.G. CAMPANE 930-279; 930-281
M.&S. McVay
P. Dragomer
J.R. ROMIG
J.L. MAXWELL
AUBURN COMM.
STATE of OHIO
L.J. CONRAD
B. CROSS et al
SIMPSON
M.&F. BLUSO ET AL
E. O'DONNELL 50.05 AC. TRUSTEE 993-535 (NEW SURVEY)
E.J. REX, TRUSTEE 944-875
E. O'DONNELL TRUST
W.&S. O'DONNELL
M.A. MASTROIANNI & K.&J. KRUPICKA 748-450
D.C. FEAR 755-189 962-270
A.J. REITHOFFER
J.&W. Brown
M.S.&M.M. SWANSON
G.B.&A.L. KAUFMAN
A.&R. KOPAS
KOPAS EST. SUB.
F.P. MAY (Trustee) 15.589 Ac. 799-157
F.P. MAY
M.A.&V.L. CASH
J.&L. SKALA
J.&L.S. DANKO JR.
J.D.&D.L. PEMBERTON
F.J.&L.J. DANKO JR.
J.A.&E. SHILLING
J.&M. COLONNA
H.W. & J.E. Brown
S.E. PATTON, TRUSTEE
City of Akron
R.&C. Kimmich
C.G. SIMKO 701-870
M. SWANSON
DONALD R. & JOSEPHINE MAY TRUST 734-632
84.53 Ac
* Inadequate Description.
RELATIVE REPRESENTATION
N
SCALE 1" = 300'
JANUARY 1, 1994
A B C D
E F G H
I J K L
M N O P
AUBURN TWP.
Match line

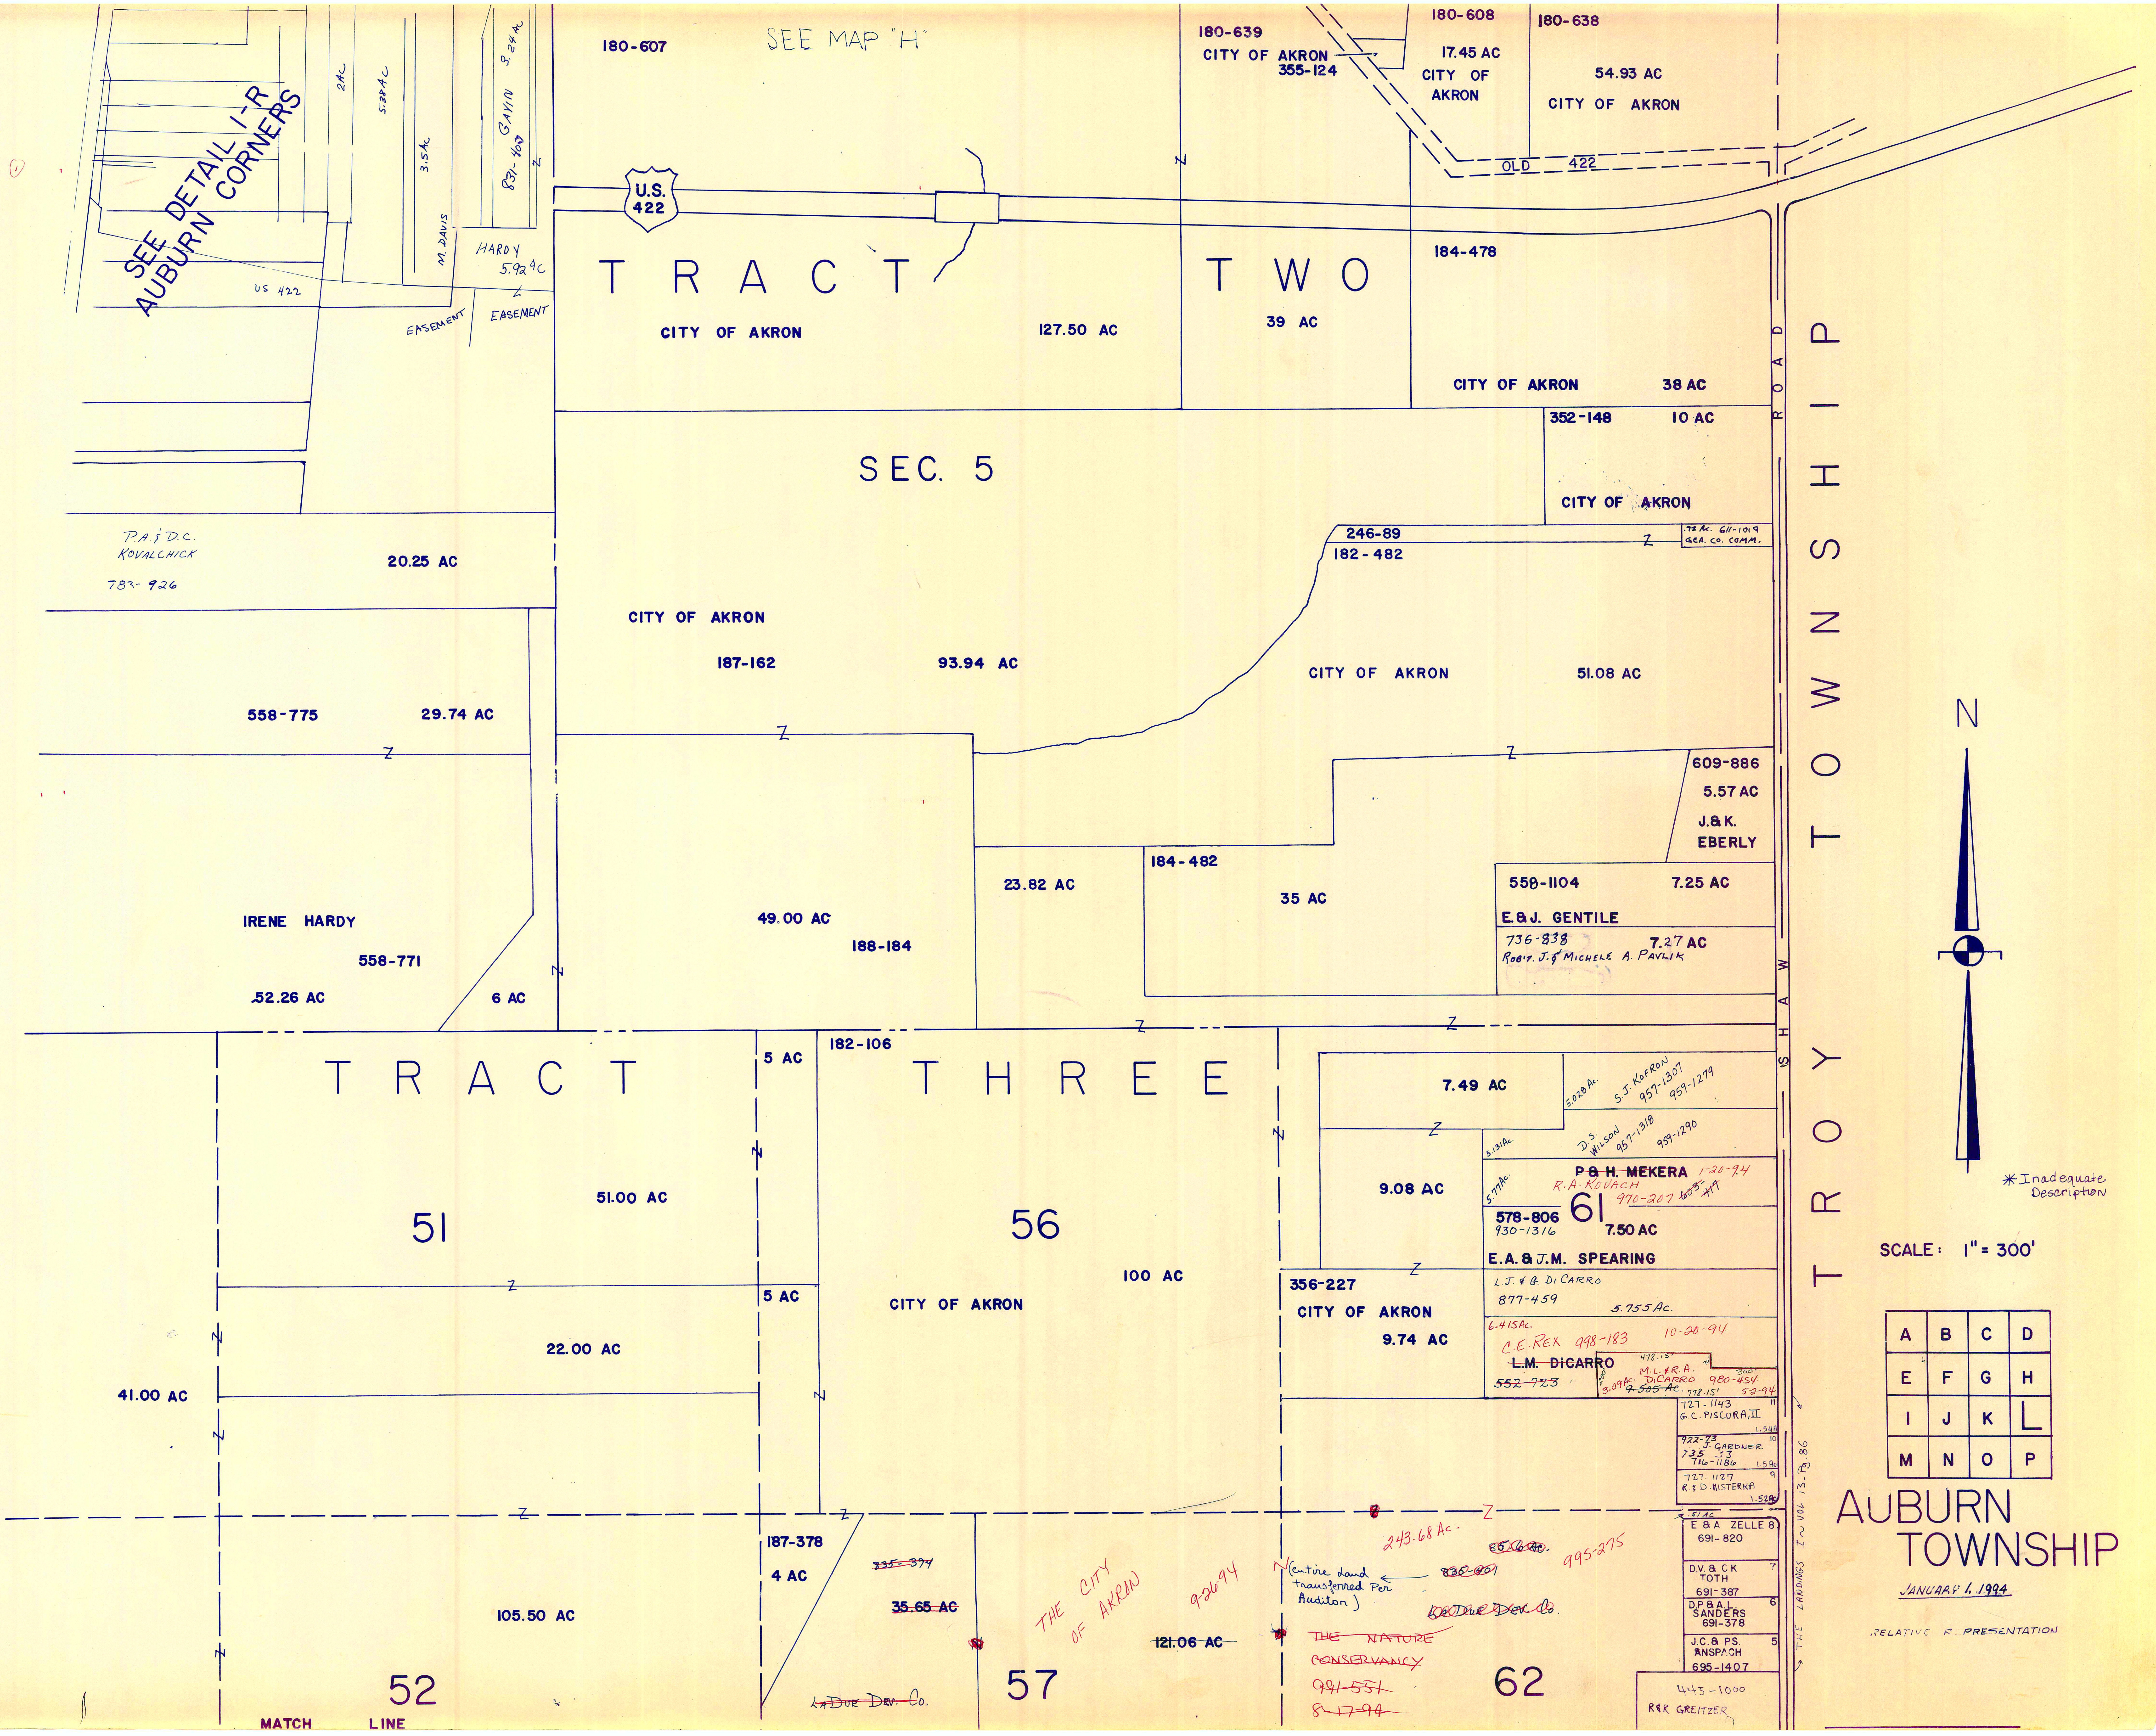
SEE MAP "H"
SEE DETAIL I-R AUBURN CORNERS
180-607
U.S. 422
US 422
2AC
5.28AC
3.5AC
M. DAVIS
GAVIN 3.24AC
831-460
HARDY 5.92AC
EASEMENT
EASEMENT
180-639
CITY OF AKRON
355-124
180-608
17.45 AC
CITY OF AKRON
180-638
54.93 AC
CITY OF AKRON
OLD 422
TRACT TWO
CITY OF AKRON
127.50 AC
39 AC
184-478
CITY OF AKRON
38 AC
352-148
10 AC
CITY OF AKRON
SEC. 5
P.A. & D.C. KOVALCHICK
783-926
20.25 AC
246-89
182-482
.92 Ac. 611-1019 GEA. CO. COMM.
CITY OF AKRON
187-162
93.94 AC
CITY OF AKRON
51.08 AC
558-775
29.74 AC
609-886
5.57 AC
J.& K. EBERLY
184-482
23.82 AC
35 AC
559-1104
7.25 AC
E.& J. GENTILE
736-838
7.27 AC
Rob't. J. & Michele A. Pavlik
IRENE HARDY
558-771
52.26 AC
6 AC
49.00 AC
188-184
TRACT THREE
182-106
5 AC
5 AC
51
51.00 AC
22.00 AC
41.00 AC
56
CITY OF AKRON
100 AC
7.49 AC
5.028 Ac.
S.J. KOFRON
957-1307
959-1279
5.131 Ac.
D.S. WILSON
957-1318
959-1290
9.08 AC
5.77 Ac.
P & H. MEKERA
1-20-94
R.A. KOVACH
970-207
~~603-417~~
61
578-806
930-1316
7.50 AC
E.A. & J.M. SPEARING
356-227
CITY OF AKRON
9.74 AC
L.J. & G. DI CARRO
877-459
5.755 Ac.
6.415 Ac.
C.E. REX 998-183
10-20-94
~~L.M. DiCARRO~~
~~552-723~~
478.15'
M.L. & R.A. DiCARRO 980-454
3.09 Ac.
~~9.505 Ac.~~
778.15'
5-2-94
727-1143
G.C. PISCURA, II
1.54A
922-73
J. GARDNER
735 53
716-1186
1.5 Ac.
727-1127
R. & D. MISTERKA
1.52 Ac.
.51 AC
E & A ZELLE 8
691-820
D.V. & C K TOTH 7
691-387
D.P & A.L. SANDERS 6
691-378
J.C. & P.S. ANSPACH 5
695-1407
443-1000
R & R GREITZER
187-378
4 AC
~~335-394~~
~~35.65 AC~~
~~LaDue Dev. Co.~~
THE CITY OF AKRON
9-26-94
243.68 Ac.
~~85.6 Ac.~~
995-275
~~836-401~~
(entire land transferred Per Auditor)
~~LaDue Dev. Co.~~
~~THE NATURE CONSERVANCY~~
~~991-551~~
~~8-17-94~~
121.06 AC
105.50 AC
52
57
62
MATCH LINE
SHAW ROAD
TROY TOWNSHIP
THE LANDINGS I IN VOL 13 PG. 86
N
*Inadequate Description
SCALE: 1" = 300'
A B C D
E F G H
I J K L
M N O P
AUBURN TOWNSHIP
JANUARY 1, 1994
RELATIVE PRESENTATION

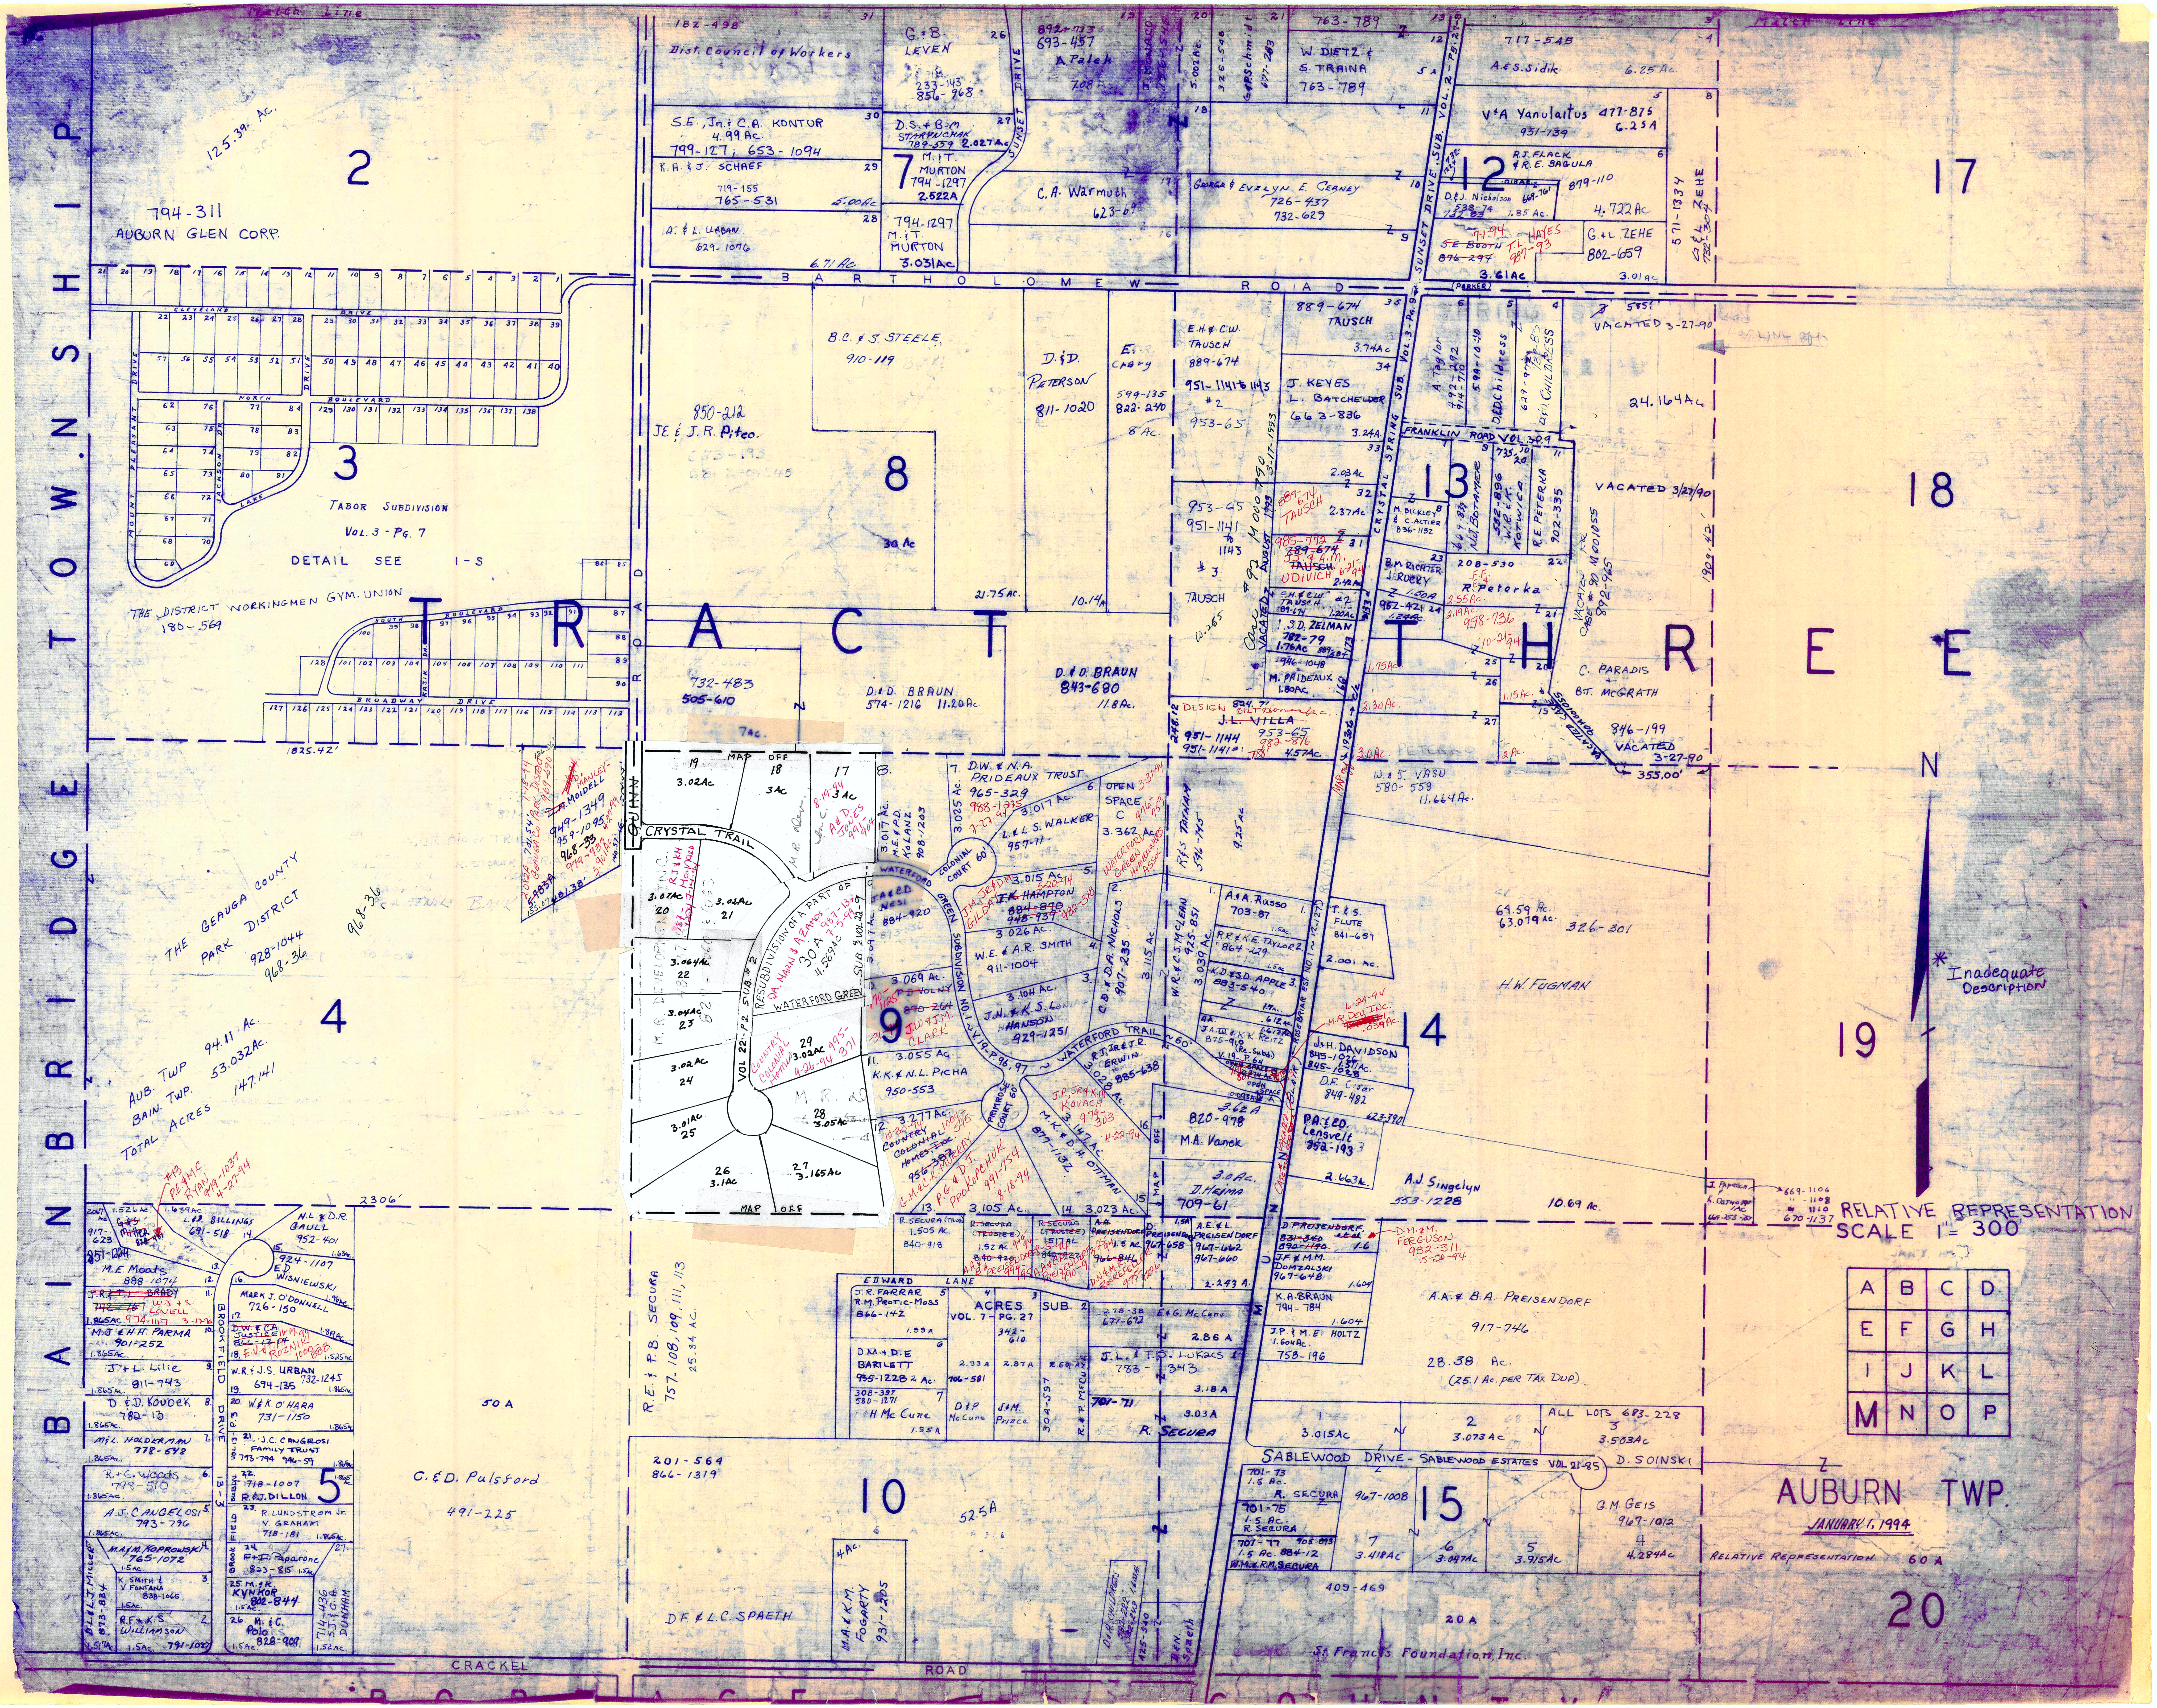

Match Line
BAINBRIDGE TOWNSHIP
TRACT THREE
2
3
4
5
7
8
9
10
12
13
14
15
17
18
19
20
125.39 Ac.
794-311
AUBURN GLEN CORP.
182-498
Dist. Council of Workers
G.&B. LEVEN
S.E. Jr. & C.A. KONTUR 4.99 Ac
799-127; 653-1094
R.A.&J. SCHAEF
A.&L. URBAN
M.&T. MURTON
C.A. Warmuth
SUNSET DRIVE
BARTHOLOMEW ROAD
W. DIETZ & S. TRAINA 763-789
717-545
A.&S. Sidik
V&A Yanulaitus 477-875
R.J. FLACK & R.E. BAGULA
G.&L. ZEHE 802-659
George & Evelyn E. Ceaney 726-437 732-629
TABOR SUBDIVISION VOL. 3 - PG. 7
DETAIL SEE I-S
THE DISTRICT WORKINGMEN GYM. UNION 180-569
BROADWAY DRIVE
B.C. & S. STEELE 910-119
850-212 J.E. & J.R. Piteo
D.&D. PETERSON 811-1020
D.&D. BRAUN 574-1216 11.20 Ac.
D.&D. BRAUN 843-680 11.8 Ac.
732-483 505-610
E.H. & C.W. TAUSCH 889-674
J. KEYES
L. BATCHELDER 663-836
FRANKLIN ROAD
CRYSTAL SPRING SUB. VOL. 3 - PG. 9
VACATED 3-27-90
24.164 Ac.
C. PARADIS
B.T. McGRATH
846-199
J.L. VILLA
W.&S. VASU 580-555 11.664 Ac.
353.00'
1825.42'
CRYSTAL TRAIL
WATERFORD GREEN
RESUBDIVISION OF A PART OF 30A
D.W. & N.A. PRIDEAUX TRUST 965-329
L.&L.S. WALKER
OPEN SPACE C 3.362 Ac.
J.K. HAMPTON
W.E. & A.R. SMITH 911-1004
J.N. & K.S.L. HANSON 929-1251
WATERFORD TRAIL
PRIMROSE COURT
K.K. & N.L. PICHA 950-553
M.R. DEVELOPMENT INC.
VOL. 22 - P.2
THE GEAUGA COUNTY PARK DISTRICT 928-1044 968-36
AUB. TWP. 94.11 Ac.
BAIN. TWP. 53.032 Ac.
TOTAL ACRES 147.141
2306'
A.&A. Russo 703-87
T.&S. FLUTE 841-697
64.59 Ac. 63.079 Ac. 326-301
H.W. FUGMAN
J.&H. DAVIDSON
M.A. Vanek 820-978
A.J. Singelyn 553-1228
10.69 Ac.
* Inadequate Description
N
RELATIVE REPRESENTATION SCALE 1" = 300'
A B C D
E F G H
I J K L
M N O P
AUBURN TWP.
JANUARY 1, 1994
RELATIVE REPRESENTATION
EDWARD LANE
ACRES SUB. VOL. 7 - PG. 27
D.M. & D.E. BARLETT
H. McCune
R. SECURA
R.E. & P.B. SECURA 757-108, 109, 111, 113 25.34 Ac.
J.F.R. FARRAR
E.&G. McCune
J.L. & T.D. Lukacs
A.A. & B.A. PREISENDORF 917-746
28.38 Ac. (25.1 Ac. PER TAX DUP)
K.A. BRAUN
J.P. & M.E. HOLTZ 758-196
D.M. & M. FERGUSON 982-311
SABLEWOOD DRIVE - SABLEWOOD ESTATES VOL. 21-85
D. SOINSKI
ALL LOTS 683-228
G.M. Geis 967-1012
R. SECURA 967-1008
20 A
60 A
St. Francis Foundation, Inc.
C.&D. Pulsford 491-225
50 A
201-564 866-1319
52.5A
D.F. & L.C. SPAETH
M.A. & K.M. FOGARTY 931-1205
N.L. & D.R. BAULL 952-401
ED WISNIEWSKI
MARK J. O'DONNELL 726-150
W.R. & J.S. URBAN 732-1245
W.&K. O'HARA 731-1150
M.E. Moats 888-1074
M.&E. & H.H. PARMA 901-252
J.&L. Lilie 811-743
D.&D. KOUDEK 782-13
M.L. HOLDERMAN 778-543
A.J. CANGELOSI 793-796
BROOKFIELD DRIVE
R.F. & K.S. WILLIAMSON
CRACKEL ROAD

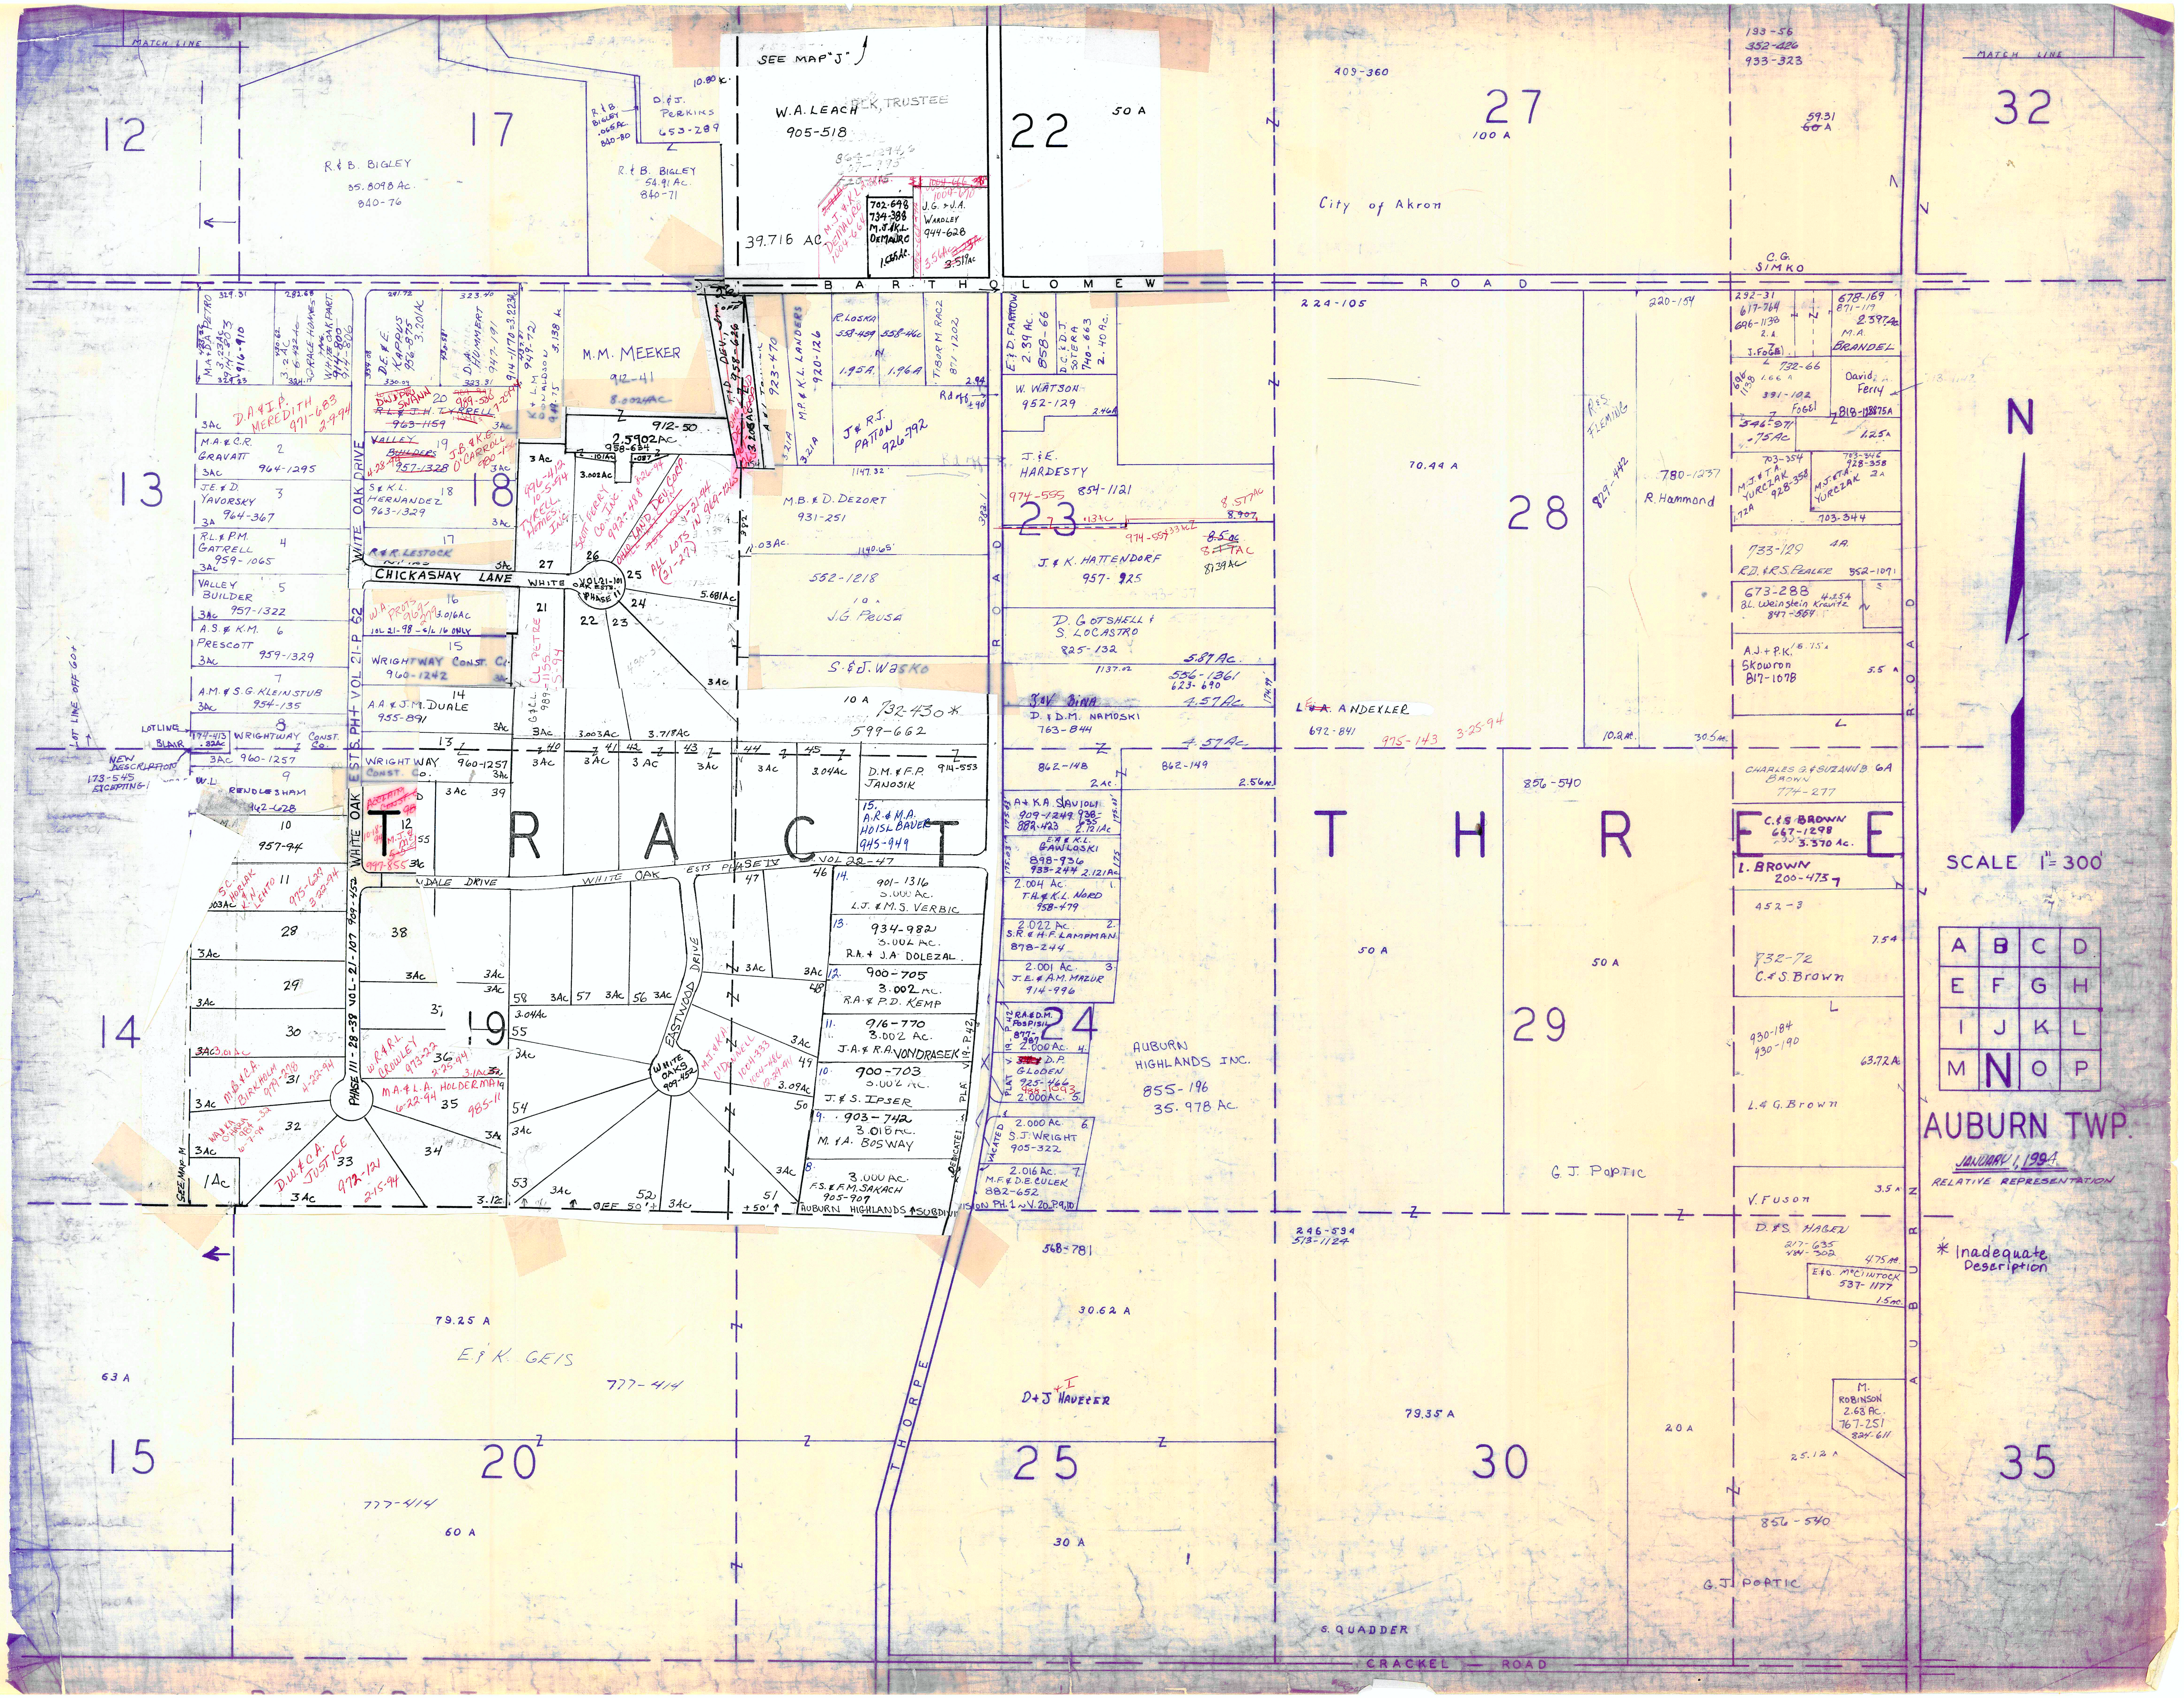
MATCH LINE
12
17
13
18
14
19
15
20
22
23
24
25
27
28
29
30
32
35
SEE MAP "J"
W. A. LEACH, TRUSTEE
905-518
39.716 AC
50 A
R & B. BIGLEY
35.8098 Ac.
840-76
R & B. BIGLEY
54.91 Ac.
840-71
D & J. PERKINS
653-289
409-360
100 A
City of Akron
C.G. SIMKO
BARTHOLOMEW ROAD
M. M. MEEKER
912-41
2.5902 Ac
912-50
WHITE OAK DRIVE
CHICKASHAY LANE
WHITE OAK ESTS. PH. I VOL. 21-P. 62
WHITE OAK ESTS. PHASE IV VOL. 22-47
PHASE III - 28-39 VOL. 21-107
DALE DRIVE
EASTWOOD DRIVE
WHITE OAKS
TRACT THREE
M.B. & D. DEZORT
931-251
J. G. Peusa
S. & J. Wasko
732-430 *
599-662
J. & K. HATTENDORF
957-925
J. & E. HARDESTY
854-1121
W. WATSON
952-129
J. & R.J. PATTON
926-792
D. GOTSHELL & S. LOCASTRO
825-132
D. & D.M. NAMOSKI
763-844
L. ANDEXLER
975-143
70.44 A
780-1257
R. Hammond
856-540
50 A
AUBURN HIGHLANDS INC.
855-196
35.978 Ac.
G. J. POPTIC
AUBURN HIGHLANDS SUBDIVISION
THORPE ROAD
79.25 A
E & K. GEIS
777-414
63 A
60 A
30.62 A
D & J HAVEKER
568-781
79.35 A
30 A
20 A
856-540
G. J. POPTIC
M. ROBINSON
2.63 Ac.
767-251
S. QUADDER
CRACKEL ROAD
AUBURN ROAD
M.A. BRANDEL
David Ferry
C. & S. BROWN
667-1298
3.370 Ac.
L. BROWN
200-473
C. & S. Brown
L. & G. Brown
V. Fuson
D. & S. HAGEN
CHARLES G. & SUZANNE B. BROWN
774-277
A.J. & P.K. Skowron
817-1078
N

SCALE 1" = 300'

A	B	C	D
E	F	G	H
I	J	K	L
M	N	O	P

AUBURN TWP.

JANUARY 1, 1994

RELATIVE REPRESENTATION

* Inadequate Description

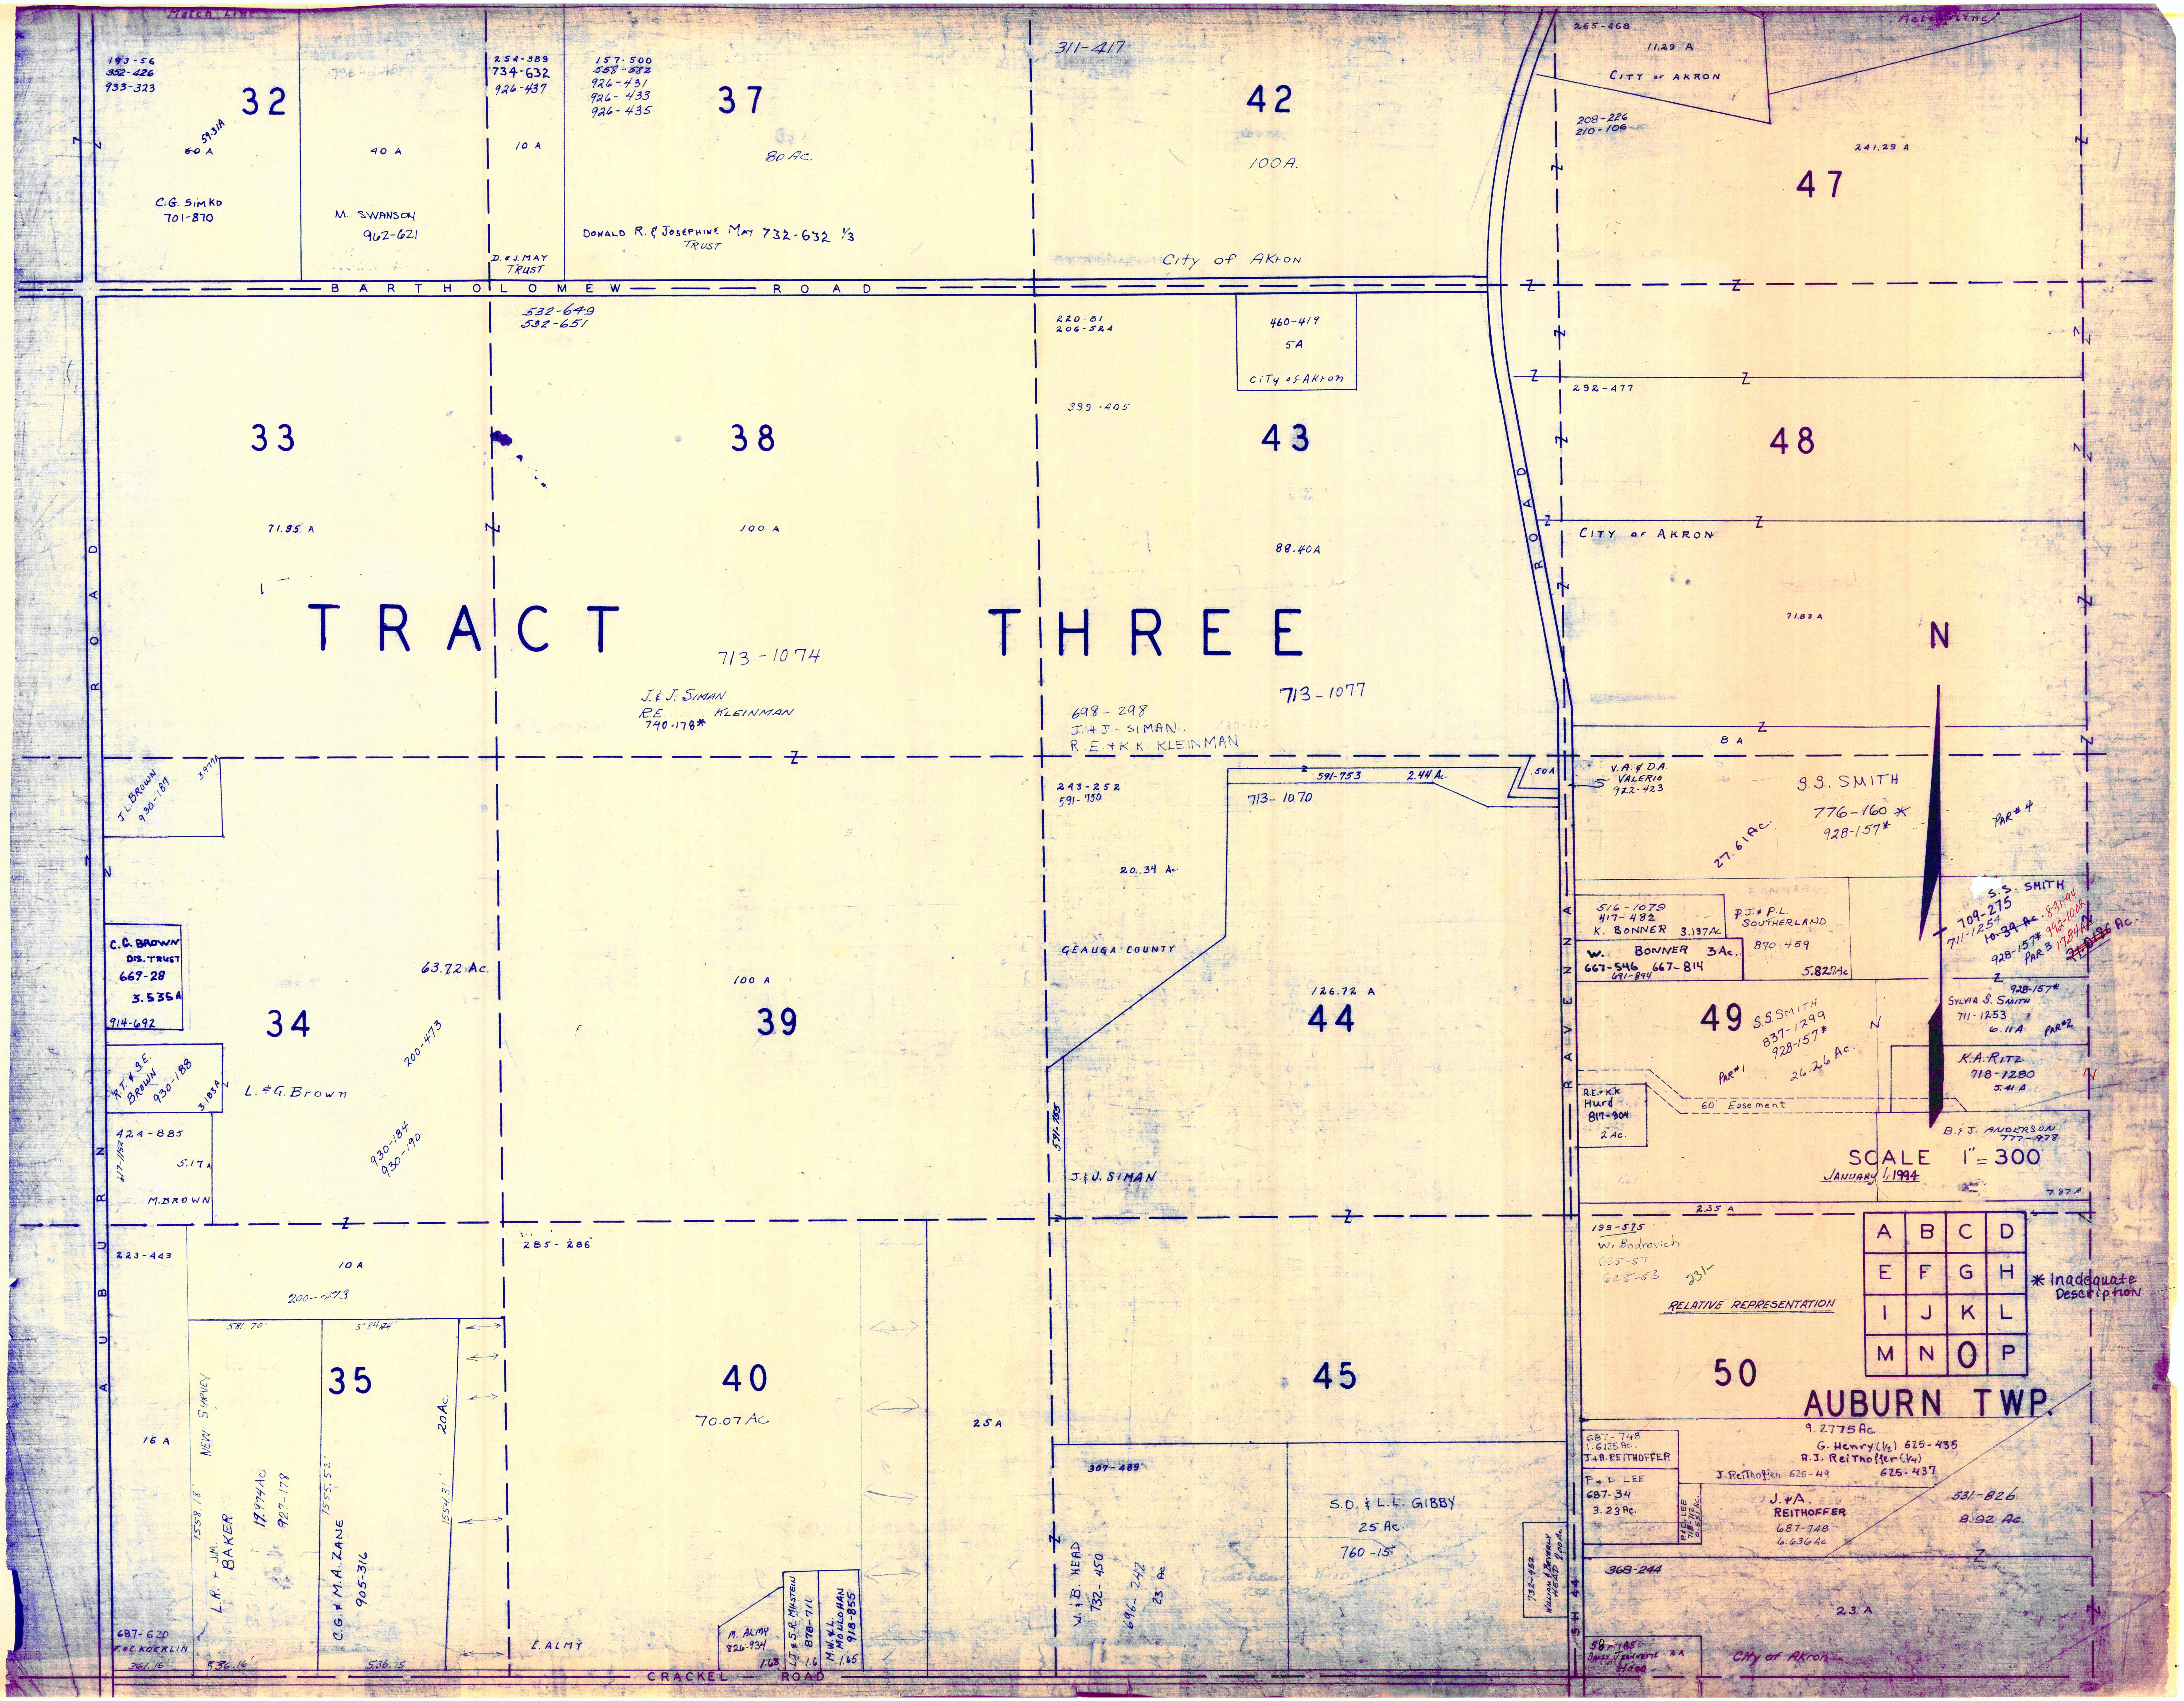
Match Line
193-56
352-426
933-323
32
59.31A
~~50~~ A
C.G. Simko
701-870
40 A
M. SWANSON
962-621
254-389
734-632
926-437
10 A
D. & J. MAY
TRUST
157-500
558-582
926-431
926-433
926-435
37
80 AC.
DONALD R. & JOSEPHINE MAY 732-632 1/3
TRUST
311-417
42
100A.
City of Akron
265-468
11.29 A
CITY of AKRON
208-226
210-106
241.29 A
47
Match Line
BARTHOLOMEW ROAD
532-649
532-651
220-81
206-524
460-419
5A
City of Akron
399-405
292-477
33
71.95 A
38
100 A
43
88.40A
48
CITY of AKRON
71.83 A
TRACT THREE
713-1074
J. & J. SIMAN
R.E. KLEINMAN
740-178*
713-1077
698-298
J. + J. SIMAN
R.E. + K.K. KLEINMAN
N
8 A
AUBURN ROAD
J.L. BROWN
930-187
3.977A
C.G. BROWN
DIS. TRUST
669-28
3.535A
914-692
R.T. & S.E. BROWN
930-188
3.183A
424-885
617-1152
5.17A
M. BROWN
63.72 Ac.
34
200-473
L. & G. Brown
930-184
930-190
100 A
39
243-252
591-750
591-753
2.44 Ac.
713-1070
.50A
20.34 Ac.
GEAUGA COUNTY
126.72 A
44
591-755
J. & J. SIMAN
V.A. & D.A.
VALERIO
922-423
S.S. SMITH
776-160 *
928-157*
27.61Ac.
PAR #4
516-1079
417-482
K. BONNER 3.137Ac.
W. BONNER 3Ac.
667-546 667-814
691-894
P.J. & P.L.
SOUTHERLAND
870-459
5.827Ac
S.S. SMITH
709-275
711-1254
~~10.39 Ac.~~
928-157*
831-94
992-1003
PAR 3
17.84AC
~~21.0186~~ Ac.
49
S.S. SMITH
837-1299
928-157*
PAR #1
26.26 Ac.
928-157*
Sylvia S. Smith
711-1253
6.11A
PAR #2
K.A. RITZ
718-1280
5.41 A
R.E. + K.K.
Hurd
817-304
2 Ac.
60' Easement
B. & J. ANDERSON
777-978
SCALE 1" = 300
JANUARY 1, 1994
7.87 A.
RAVENNA ROAD
223-443
10 A
200-473
285-286
2.35 A
199-575
W. Bodnovich
625-51
625-53
231
RELATIVE REPRESENTATION
A B C D
E F G H
I J K L
M N O P
* Inadequate Description
581.70'
584.84'
35
NEW SURVEY
16 A
1558.18'
L.R. + J.M. BAKER
19.974Ac
927-178
1555.52'
C.G. & M.A. ZANE
905-316
20Ac.
1554.31'
40
70.07 Ac.
25 A
45
50
AUBURN TWP.
9.2775Ac.
G. Henry (1/2) 625-435
A.J. Reithoffer (1/4)
625-437
J. Reithoffer 625-49
687-748
1.6125 Ac.
J + A. REITHOFFER
P. + D. LEE
687-34
3.23Ac.
P.&D. LEE
718-712
0.551 Ac.
J. & A.
REITHOFFER
687-748
6.636 Ac.
531-826
8.92 Ac.
307-489
W. & B. HEAD
732-450
696-242
23 Ac.
S.O. & L.L. GIBBY
25 Ac.
760-15
732-452
WILLIAM & BEVERLY
HEAD 2.00 Ac.
SH 44
368-244
23 A
687-620
F. & C. KOERLIN
361.16'
536.16'
536.15
E. ALMY
M. ALMY
826-934
1.68
L.J. & S.R. MILSTEIN
878-711
1.6
M.W. & L. MOLLOHAN
918-855
1.65
CRACKEL ROAD
58-185
DAISY JEANNETTE HOOD
2 A
City of Akron

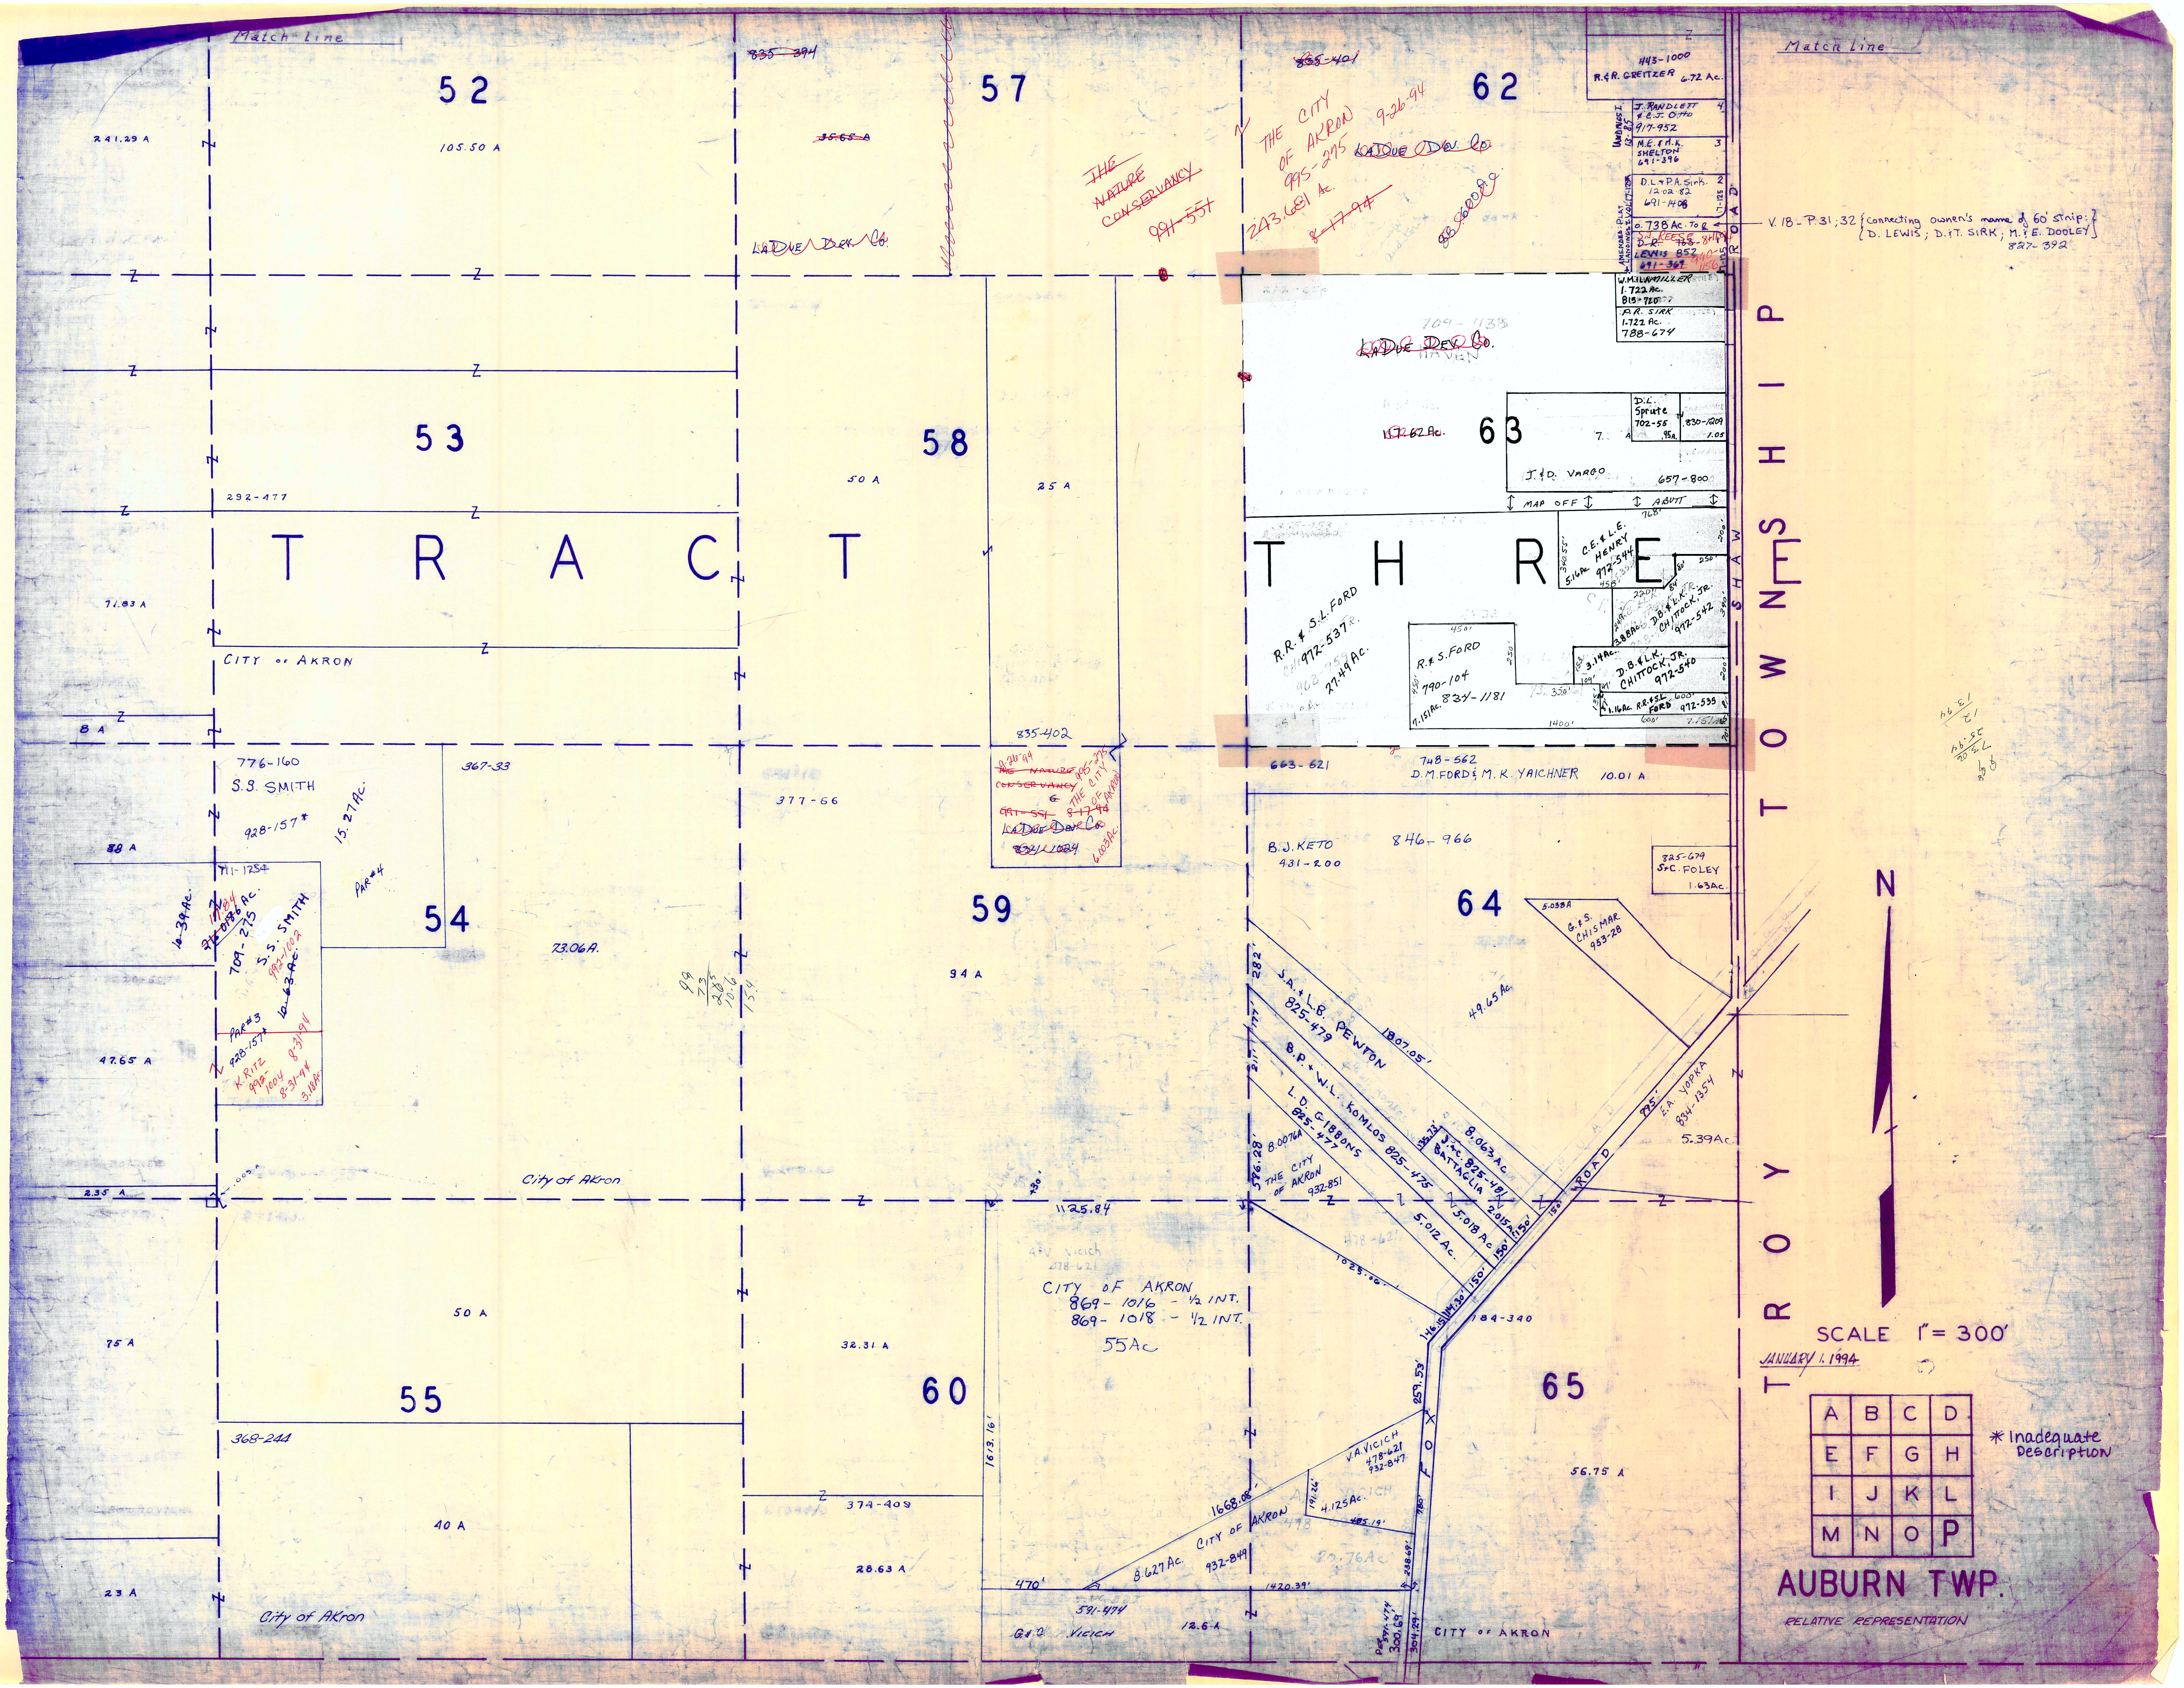Match Line
Match Line
52
105.50 A
241.29 A
57
~~835-394~~
~~35.65 A~~
LaDue Dev. Co.
62
~~835-401~~
~~THE NATURE CONSERVANCY~~
~~991-551~~
THE CITY OF AKRON 9-26-94
995-275
243.681 Ac.
~~8-17-94~~
~~LaDue Dev. Co.~~
~~83.600 Ac.~~
443-1000
R.&R. GREITZER 6.72 Ac.
LANDINGS I. 13-85
J. RANDLETT & E.J. Otto 917-952 4
M.E.&M.K. SHELTON 691-396 3
D.L.&P.A. Sirk. 12.02.82 691-1408 2
AMENDED PLAT LANDINGS I. VOL. 17-125
17-125
0.738 Ac. To ℓ
S.J. REESE
~~D.R.~~ ~~LEWIS~~ ~~765-~~ 852 ~~691-369~~ 8-11-94 990-1156
V. 18 - P. 31; 32 {connecting owner's name of 60' strip: D. LEWIS; D.&T. SIRK; M.&E. DOOLEY} 827-392
W.M.&L.A. MILLER 1.722 Ac. 815-720
P.R. SIRK 1.722 Ac. 788-674
709-1138
~~LaDue Dev. Co.~~
~~117.62 Ac.~~
63
D.L. Sprute 702-55 .95 A.
830-1209 1.05
7. A
J.&D. VARGO 657-800
MAP OFF
ABUTT
768'
C.E.&L.E. HENRY 5.16 Ac. 972-544
340.55'
458'
700'
250'
80'
84'
220'
249.87'
3.88 Ac. D.B.&L.K. CHITTOCK, JR. 972-542
390'
R.R.&S.L. FORD 972-537 R. 27.49 Ac.
450'
R.&S. FORD 790-104 834-1181
7.151 Ac.
250'
450'
350'
3.14 Ac.
153'
109'
D.B.&L.K. CHITTOCK, JR. 972-540
200'
1.16 Ac. R.R.&S.L. FORD 972-535
600'
600'
135'
81'
1400'
7.151
70'
ROAD
SHAW
TROY TOWNSHIP
53
292-477
TRACT THREE
58
50 A
25 A
71.83 A
CITY of AKRON
8 A
835-402
9-26-94
~~THE NATURE CONSERVANCY~~
~~991-551~~
~~8-17-94~~
995-275
THE CITY OF AKRON
~~LaDue Dev. Co.~~
~~834-1024~~
6.003 Ac.
776-160
S.S. SMITH
928-157*
15.27 Ac.
367-33
377-66
38 A
711-1254
~~10.39 Ac.~~
~~2.0186~~ 17.84 Ac.
709-275
S.S. SMITH
992-1002
~~10.63 Ac.~~
PAR #4
54
73.06 A.
PAR #3
928-157*
K. RITZ 992-1004 8-31-94
8-31-94
3.18 Ac.
47.65 A
59
94 A
663-621
748-562
D.M. FORD & M.K. YAICHNER 10.01 A
B.J. KETO 431-200
846-966
825-679 S&C. FOLEY 1.63 Ac.
64
5.038 A
G.&S. CHISMAR 953-28
49.65 Ac.
282'
177'
211'
J.A.&L.B. PEWTON 825-479
1807.05'
B.P.&W.L. KOMLOS 825-475
L.D. GIBBONS 825-477
8.0076 A
596.28'
THE CITY OF AKRON 932-851
135.73'
J.&C. BATTAGLIA 825-481
8.063 Ac
2.015 Ac.
5.018 Ac
5.012 Ac.
150'
150'
150'
150'
114.30'
146.15
795'
E.A. YOPKA 834-1354
5.39 Ac.
ROAD
1025.06'
184-340
City of Akron
2.35 A
.009 A
430'
1125.84
CITY OF AKRON
869-1016 - 1/2 INT.
869-1018 - 1/2 INT.
55 Ac
50 A
75 A
32.31 A
60
55
65
368-244
40 A
374-409
28.63 A
1613.16'
259.53'
FOX ROAD
V.A. VICICH 478-621 932-847
191.26'
4.125 Ac.
485.19'
180'
1668.08'
CITY OF AKRON 932-849
8.627 Ac.
470'
1420.39'
238.69'
591-474
56.75 A
23 A
City of Akron
G.&D. VICICH
12.6 A
PER 591-474
300.69
304.29'
CITY OF AKRON
N
SCALE 1" = 300'
JANUARY 1, 1994
A B C D
E F G H
I J K L
M N O P
* Inadequate Description
AUBURN TWP.
RELATIVE REPRESENTATION

AUBURN TP.

[CENTER]

TRACT 2 SECTION 3

E.&W. Richardson
4.71 Ac.
574-563
731-1241
P. CARLETON
546-180
13.10 Ac.
798-1075
Auburn Township Trustees
509-631
7.19A
24.15 Ac.
LOT 6
P.R. CARLETON
723-372
692-1331
798-1075
1.882 Ac.
W.&L. HEIN
733-192
1.842 Ac.
M.E.&D.H. JACOBS
0.50 Ac.
911-1278
0.33 Ac.
1.21 Ac.
508-880
J.&E. Westover
TWP. TRUSTEES 77-199
665-1098
1.30 Ac.
L. Lee
&
~~L. Bratovich~~
990-1256
671-68
2-2-94
E.&E. FONTANELLE
.70A.
206-152
597-1200
520-778
.398A
C. Klimisch
J. Brooks
0.37 Ac.
713-537
AUBURN ROAD
F.L.&S.T. ARNER
755-1116
1.503 Ac.
27.
759-790
R.D.&M.E. SWAN
26.
739-261
1.528A.
T.J.&K.K. RECKINGER
950-1090
1.615 Ac.
25.
24.
1.592 Ac.
802-826
3.2 Ac.
J.H.&L.A RENNER
781-1043
872-579
VACATED 11-4-87
21.
D.M.&C.A. COOK
792-791
M. KHAKDOUST
~~D.D. MORRIS~~
~~R.A. MALBURG~~
980-920
~~858-1141~~
5-4-94
20.
2.5664 Ac.
1.636 Ac.
J.H.&S.M. SHUBROOK
871-1173
938-497
19.
1.648 Ac.
CARRIAGE HILL DRIVE
CARRIAGE HILL SUB.
13-29
RERECORDED
3.
F.&L. TAUSZ
836-510
4.
R.&L. BITZER
853-117
5.
M.T.&W.S. ABOURJEILY
930-807
848-230
6.
K. deHAAN
930-1141
1.609 Ac.
7.
B.&J. MAXWELL
841-678
1.5 Ac.
18.
G.K. BUSCH
835-571
1.5 Ac.
17.
D.G.&K.R. JONES
873-1288
1.503 Ac.
16.
R.&J. COYNE
846-687
1.5 Ac.
15.
~~K.&K LANGKAMP~~
~~841-1309~~
9-7-94
993-617
J.T.&M.L. WEBER
1.5 Ac.
14.
S.&C. MILLER
844-920
1.5 Ac.
VOL. 21 P. 33-34
1.679 Ac.
2.
K.&L. DeBERNARDI
853-670
1.678 Ac.
8.
E.T.&C.M. Snyder
~~R.&L. STARR~~
~~826-1067~~
991-45
8-12-94
1.588 Ac.
1.903 Ac.
1.502 Ac.
1.
J.W.&E.L. McFARLANE
870-1306
1.532 Ac.
9.
B.K.&K.A. FONTANELLE
~~A.L.&J.L. HALKO~~
~~799-735~~
996-625
10-7-94
1.527 Ac.
LOT 5
13.
1.5 Ac.
W. SR. + G. Boyd
829-471
12.
1.585 Ac.
272-255
.54A
AUBURN TWP. TRUS'T
2.56 Ac.
CEMETERY
8-345
260-442
1A
378-198
2.54 A
119-609
Auburn Community Church .50A
.75 Ac
571-751
732-1232
G.&J. KROHN
10
R.&G. KANASTAB
838-595
1.537 Ac.
11.
R.&L. LEWANDOWSKI
844-324
1.51 Ac.
F.&K.M. MURRAY
951-330
1.541 Ac.
7
WASHINGTON STREET
1.77A.
Charles McVey
731-171
1.77A.
643-1488
M.&C. KROLL
.33A.
2.56A.
453-600
G.&T. Papp
732-258
3.50A.
739-356
GREGORY L. MARCUS & TRACEY D. KODGE
3.5 Ac.
260-89
355-383
H.&A. Kolm
251-573 J.&B. Bleyl 62.75 Ac.
730-767
2.0 Ac.
720-1008
P.T. Carson + K.L. TOMAZIN
815-498
3 Ac.
643-346
623-252
2 Ac.
B.A. VIDRA
State of Ohio
512-231
532-625
1.80 Ac.
R.W.&M.J. PUCKETT
S. of O.
532-78
3.20 Ac.
254-367
5.10 Ac.
L. Weber
116-143
BOARD OF EDUCATION
2.50 Ac.
C.&B. Chafin
1 Ac.
733-621
508-163
388-40
0.50 Ac.
K.&G. Martell
W.M.&D.R. KAHLE
1.14 Ac.
958-535
423-1073
653-564
M.D.&S. HACKETT
901-177
.65 Ac
243-207.10
138-387
210-42
1.25 Ac.
±3.14 A.
8.16 A
P.&E. Toothman
10.
C.F.&P.M. MANACCI
917-163
1.5 Ac.
9.
H.D.&S.K. MILNARK
895-1030
1.5 Ac.
8.
2.003 Ac.
~~P.&D. LoRocco~~
~~855-853~~
9-14-94
S.A.&R.L. MISKIMENS
994-109
7.
1.769 Ac.
W.C.&L.L. RUGGLES
848-1237
6.
3.431 Ac.
M.&J. FRIEDMAN
841-261
WINGATE SUBDIVISION
WINGATE DRIVE
V.13-P.27
Amended PLAT (V.17-P.109)
PVF SERVICE CORP.
829-470
2.159 Ac.
5.
R.&D. OBERMILLER
851-171
T.S. JARVIE
850-695
1.5 Ac.
1.
T.M. SERGER
834-461
1.501 Ac.
2.
G.J.&L.N. HENDRICKS
849-222
1.5 Ac.
3.
M.S.&L.M. EMBRESCIA
872-505
1.545 Ac.
4.
S. of O.
532-710
9.06 Ac.
R.&J. PUCKETT
694-252
6.10 Ac.
US 422

RELATIVE REPRESENTATION

JANUARY 1, 1994

SCALE 1 IN. = 2.5 CH. = 165 FT.

* Inadequate Description

TRACT 2
SECTION 4
ELY TRACT

AUBURN TP.

AUBURN CORNERS
& VINCINITY

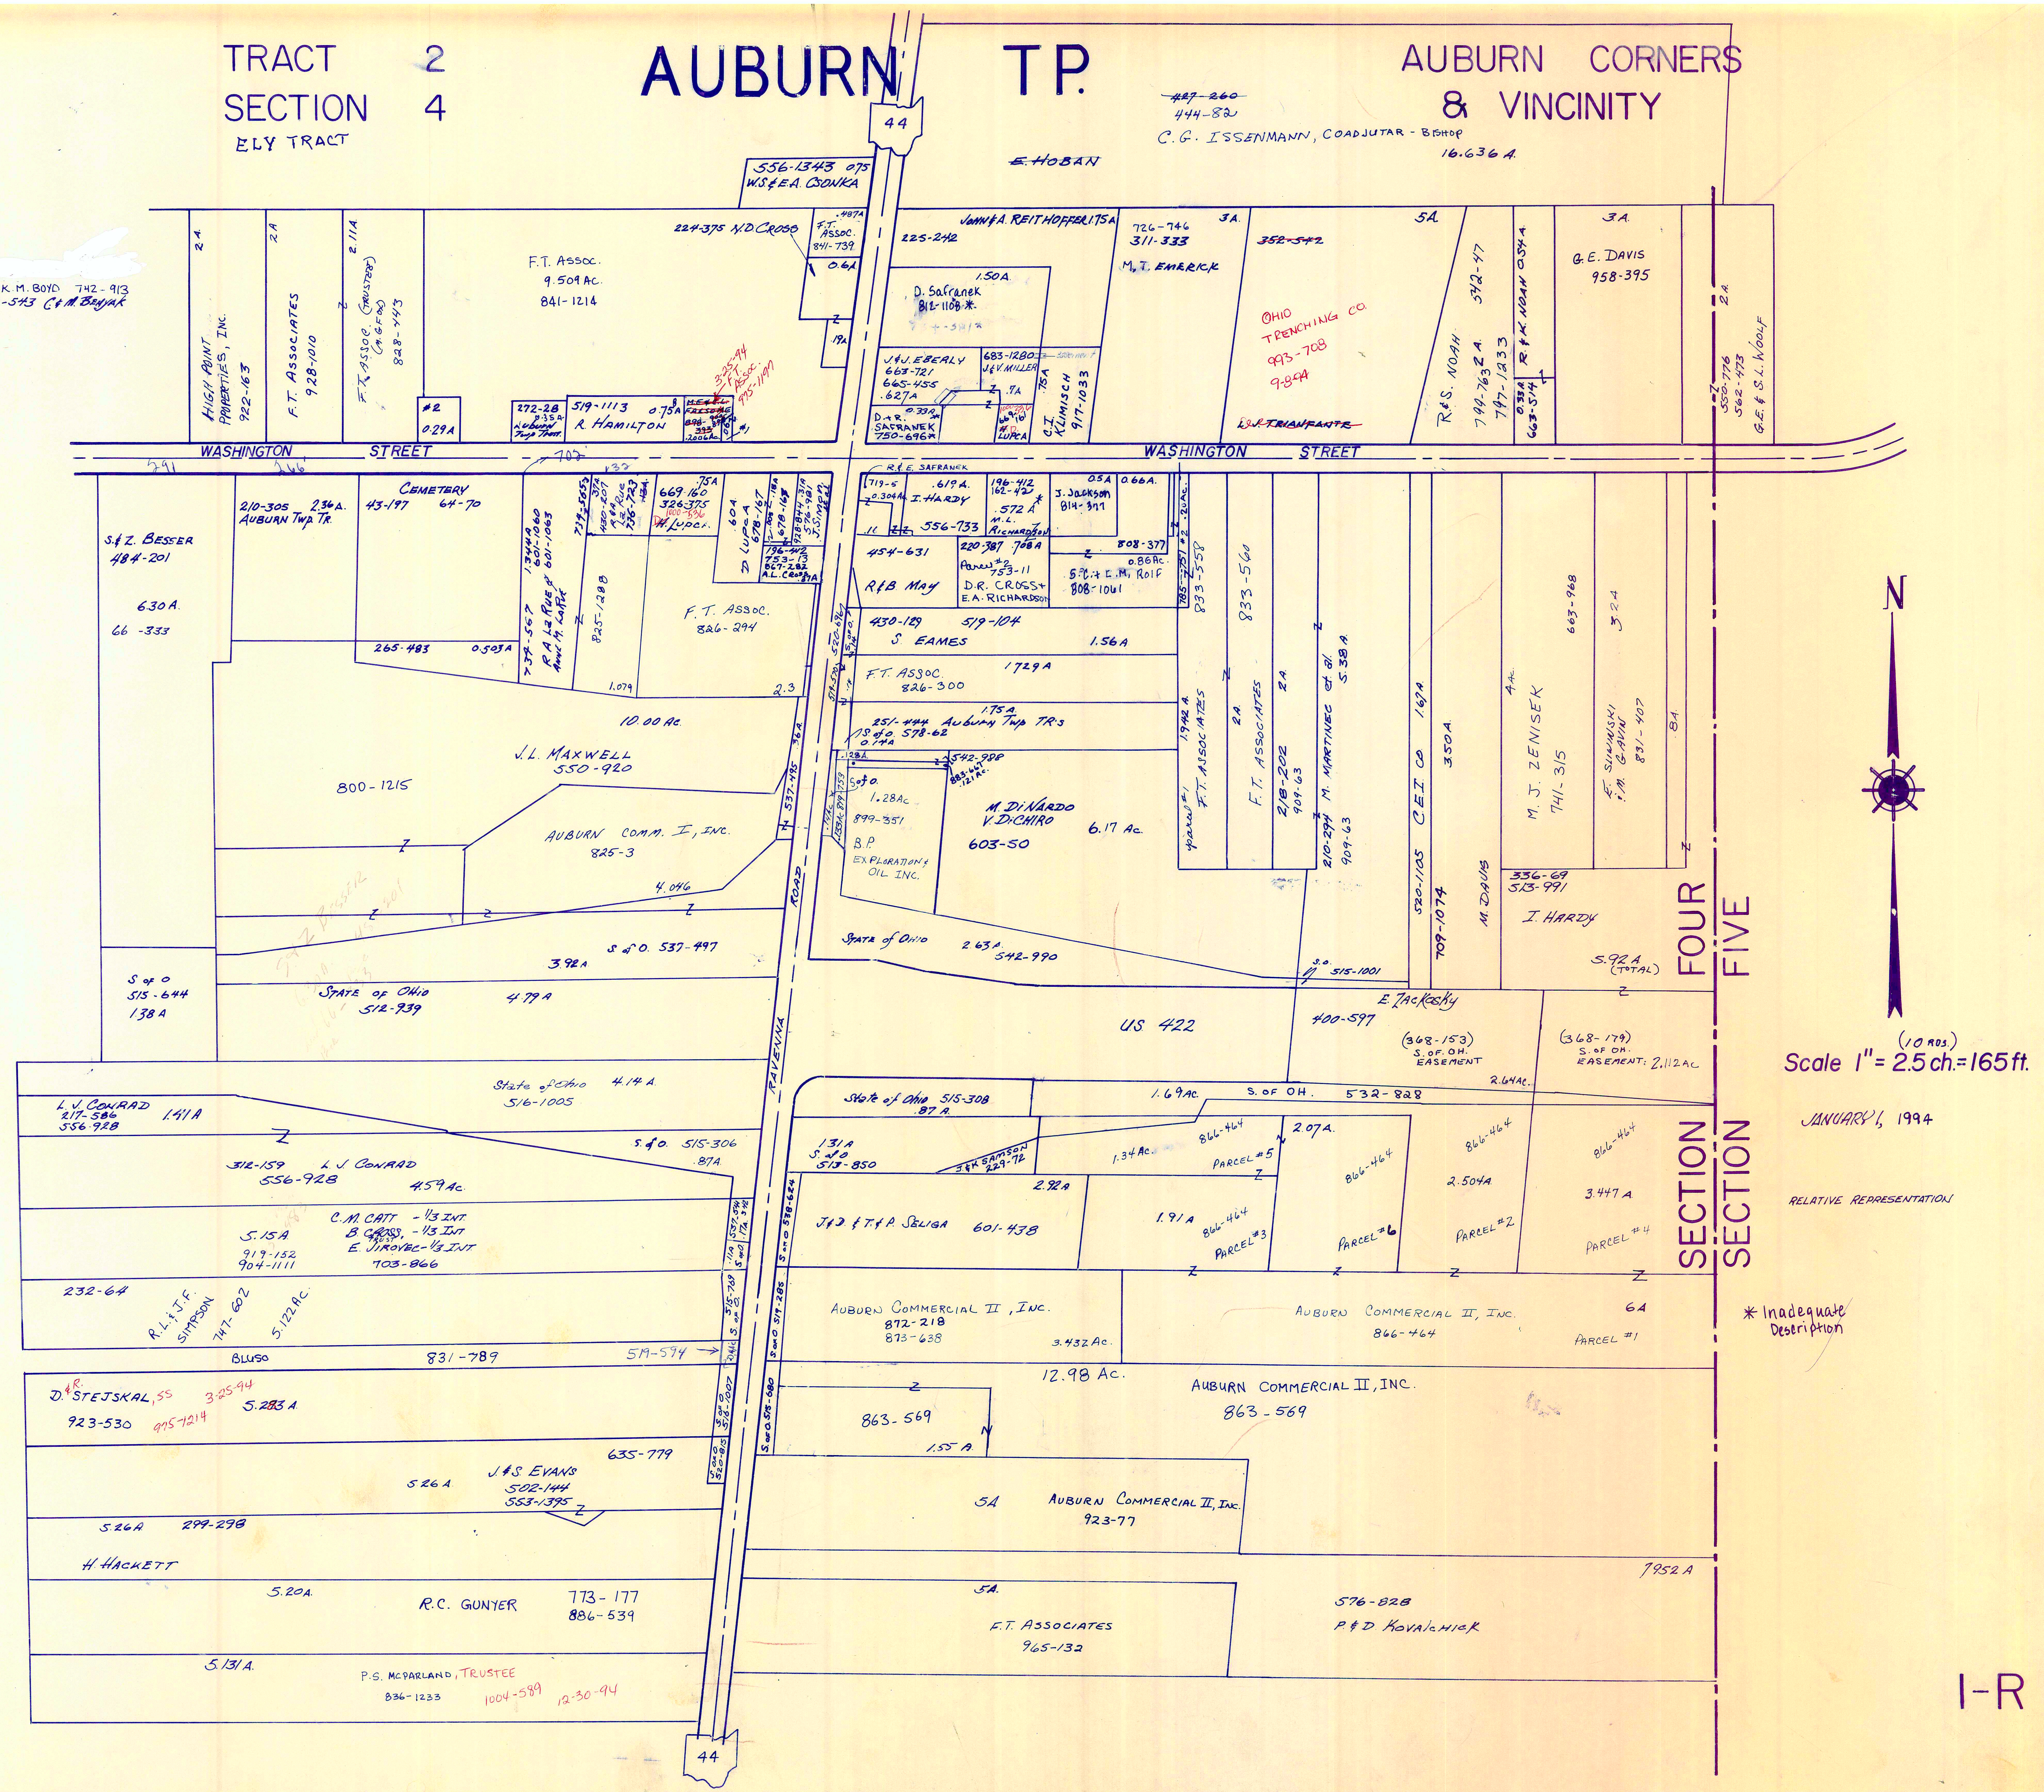

44
556-1343 075
W.S. & E.A. CSONKA
~~427-260~~
444-82
C.G. ISSENMANN, COADJUTAR - BISHOP
16.636 A.
E. HOBAN
#1
#2 J.G. & K.M. BOYD 742-913
#3 373-543 C & M Benjak
HIGH POINT PROPERTIES, INC. 922-163
F.T. ASSOCIATES 928-1010
F.T. ASSOC. (TRUSTEE) 828-443
F.T. Assoc. 9.509 Ac. 841-1214
224-375 N.D. CROSS
F.T. ASSOC. 841-739
John & A. REITHOFFER 1.75A
225-242
D. Safranek 812-1108 *
726-746 311-333
M.T. EMERICK
~~352-542~~
OHIO TRENCHING CO. 993-708 9-894
R & S. NOAH
G.E. DAVIS 958-395
550-776 562-473 G.E. & S.L. WOOLF
J & J. EBEALY 663-721 665-455
683-1280 J & V. MILLER
C.J. KLINISCH 917-1033
D & R. SAFRANEK 750-696
272-28
519-1113 R. HAMILTON
WASHINGTON STREET
WASHINGTON STREET
210-305 AUBURN Twp Tr.
CEMETERY 43-197 64-70
S & Z. BESSER 484-201
6.30A. 66-333
669-160 326-375
D. LUPCA
F.T. ASSOC. 826-294
265-483
10.00 Ac.
J.L. MAXWELL 550-920
800-1215
AUBURN COMM. I, INC. 825-3
4.046
3.92A
S of O. 537-497
S of O 515-644 1.38A
STATE of Ohio 512-939
4.79A
RAVENNA ROAD
I. HARDY
556-733
R & B May
454-631
3. JACKSON 814-397
D.R. CROSS E.A. RICHARDSON
S. & C. & E.M. ROLF 808-1061
430-129 S EAMES
519-104
1.56A
F.T. ASSOC. 826-300
17.29A
251-444 Auburn Twp TR's
542-988
M. DiNARDO V. DiCHIRO 603-50
6.17 Ac.
B.P. EXPLORATION & OIL INC.
899-351
F.T. ASSOCIATES
833-558
833-560
M. MARTINEC
218-202 909-63
CEI CO
M.J. ZENISEK 741-315
E. SILINSKI 831-407
M. DAVIS
336-69 513-991
I. HARDY
State of Ohio 2.63A 542-990
515-1001
E. JACKESKY
400-597
US 422
(368-153) S. OF OH. EASEMENT
(368-179) S. of OH. EASEMENT 2.112Ac.
5.92A (TOTAL)
SECTION FOUR
SECTION FIVE
N
State of Ohio 4.14A 516-1005
L.J. CONRAD 217-586 556-928
1.41A
State of Ohio 515-308
1.69Ac. S. OF OH. 532-828
312-159 L.J. CONRAD 556-928 4.59Ac.
S. of O. 515-306
866-464 PARCEL #5
2.07A
2.504A
3.447A
J & D & T & P. SELIGA 601-438
1.91A
PARCEL #3
PARCEL #6
PARCEL #2
PARCEL #4
C.M. CATT - 1/3 INT.
B. CROSS - 1/3 INT.
E. JIROVEC - 1/3 INT.
703-866
5.15A 919-152 904-1111
232-64
R.L. & J.F. SIMPSON 747-602
5.122Ac.
AUBURN COMMERCIAL II, INC. 872-218 873-638
3.432Ac.
AUBURN COMMERCIAL II, INC. 866-464
6A PARCEL #1
BLVSO 831-789
519-594
D. & R. STEJSKAL, SS 3-25-94 923-530 975-1214
5.283A
12.98 Ac.
AUBURN COMMERCIAL II, INC. 863-569
863-569
1.55A
J & S EVANS 502-144 553-1395
635-779
5.26A
5.26A 299-298
5A AUBURN COMMERCIAL II, INC. 923-77
H HACKETT
5.20A
R.C. GUNYER 773-177 886-539
5A.
F.T. ASSOCIATES 965-132
576-828 P & D KOVALCHICK
79.52A
5.131A.
P.S. McPARLAND, TRUSTEE 836-1233 1004-589 12-30-94

Scale 1" = 2.5 ch. = 165 ft. (10 RDS)

JANUARY 1, 1994

RELATIVE REPRESENTATION

* Inadequate Description

1-R

TABOR SUBDIVISION

VOL.3 – PG.7 PLATS

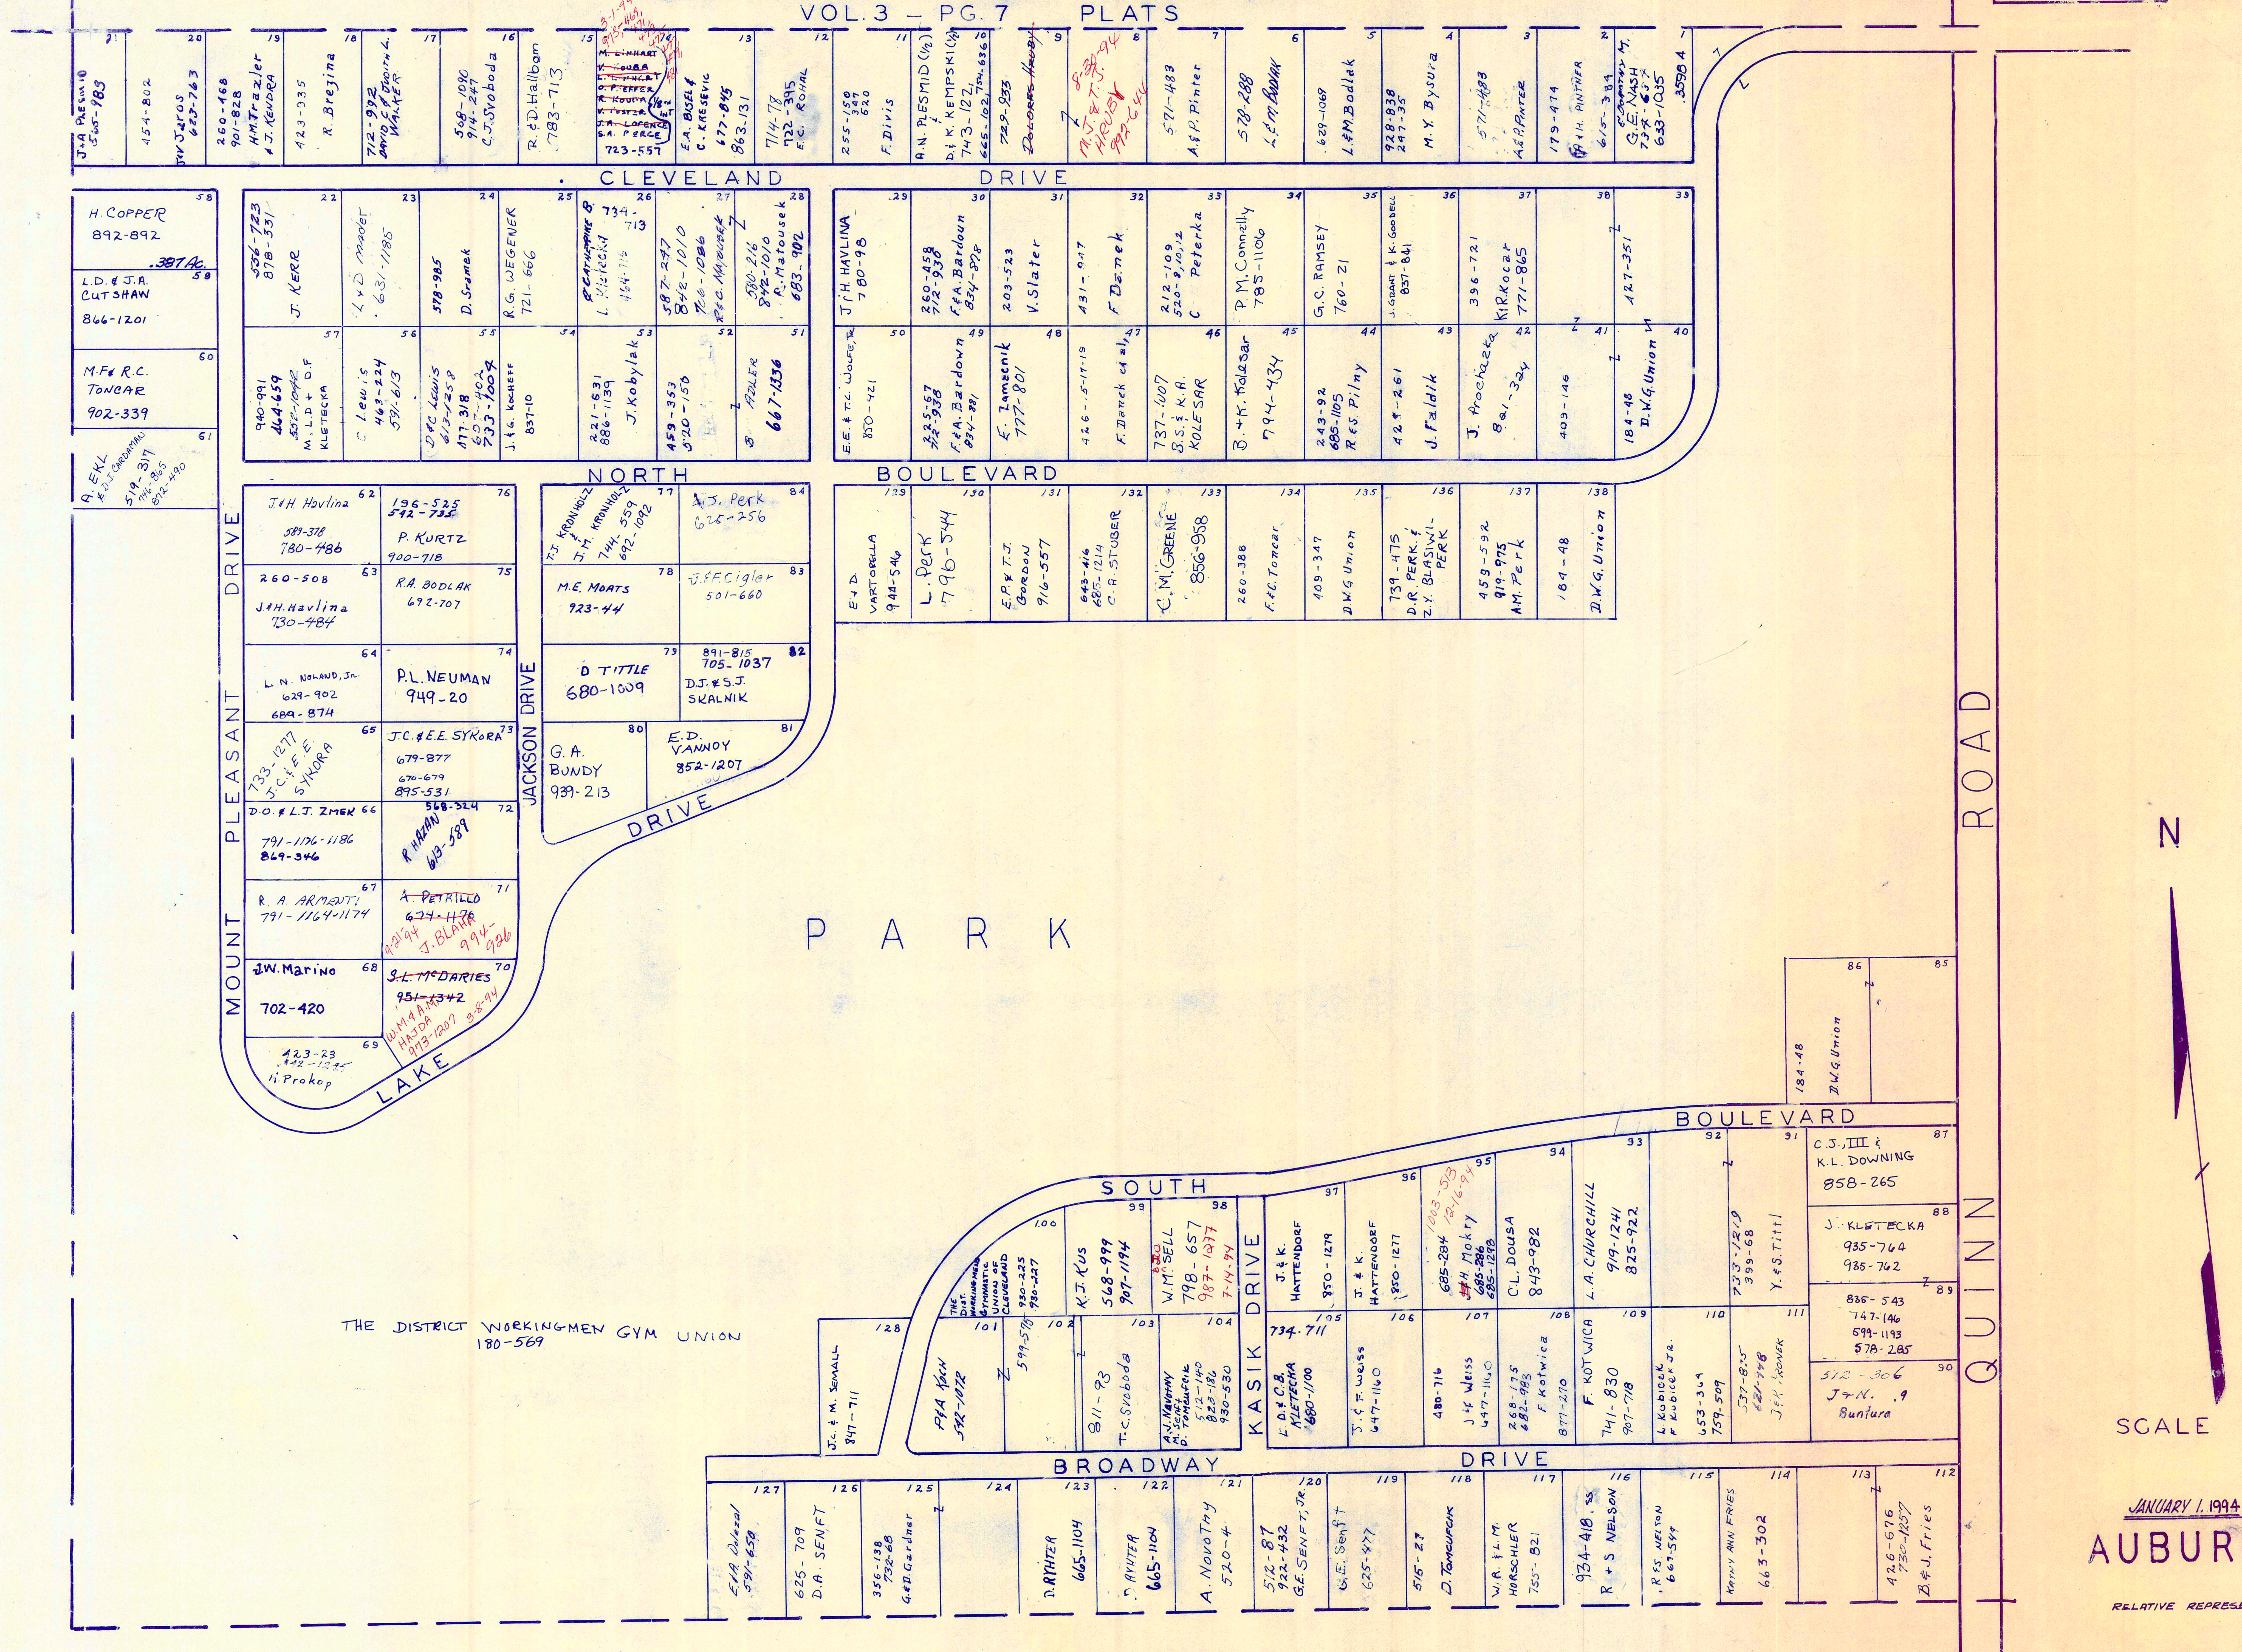

CLEVELAND DRIVE
NORTH BOULEVARD
SOUTH BOULEVARD
BROADWAY DRIVE
MOUNT PLEASANT DRIVE
JACKSON DRIVE
LAKE DRIVE
KASIK DRIVE
QUINN ROAD
PARK
THE DISTRICT WORKINGMEN GYM UNION 180-569
H. COPPER 892-892
L.D. & J.A. CUTSHAW 866-1201
M.F. & R.C. TONCAR 902-339
J&H Havlina 780-486
P. KURTZ 900-718
R.A. BODLAK 692-707
L.N. NOLAND, Jr. 629-902
P.L. NEUMAN 949-20
J.C. & E.E. SYKORA 679-877
D.O. & L.J. ZMEK 791-1176-1186
R. A. ARMENTI 791-1164-1174
J.W. Marino 702-420
M.E. MOATS 923-44
D TITTLE 680-1009
G.A. BUNDY 939-213
E.D. VANNOY 852-1207
DJ. & S.J. SKALNIK
A.J. Perk 625-256
C.M. GREENE 856-958
L. Perk 796-544
D.W.G. Union
J.H. HAVLINA 780-98
J. KERR
R.G. WEGENER 721-666
P.M. Connelly 785-1106
G.C. Ramsey 760-21
J. Kobylak
F. Derek
V. Slater
E. Zamecnik 777-801
J. Faldik
J. Prochazka
C.J. III & K.L. DOWNING 858-265
J. KLETECKA 935-764 935-762
L.A. CHURCHILL 919-1241 825-922
C.L. DOUSA 843-982
F. KOTWICA 741-830
K.J. Kus 568-999
W.M. SELL 798-657
D.A. SENFT
G.E. SENFT
D. RYHTER 665-1104
A. Novotny 520-4
D. Tomczuk
R + S NELSON
B & J. Fries
N

SCALE 1" = 100'

JANUARY 1, 1994

AUBURN TWP.

RELATIVE REPRESENTATION

* Inadequate Description

1 S

AUBURN

O.L. 8 SEC. 2

O.L. 6 SEC. 3 TRACT 2

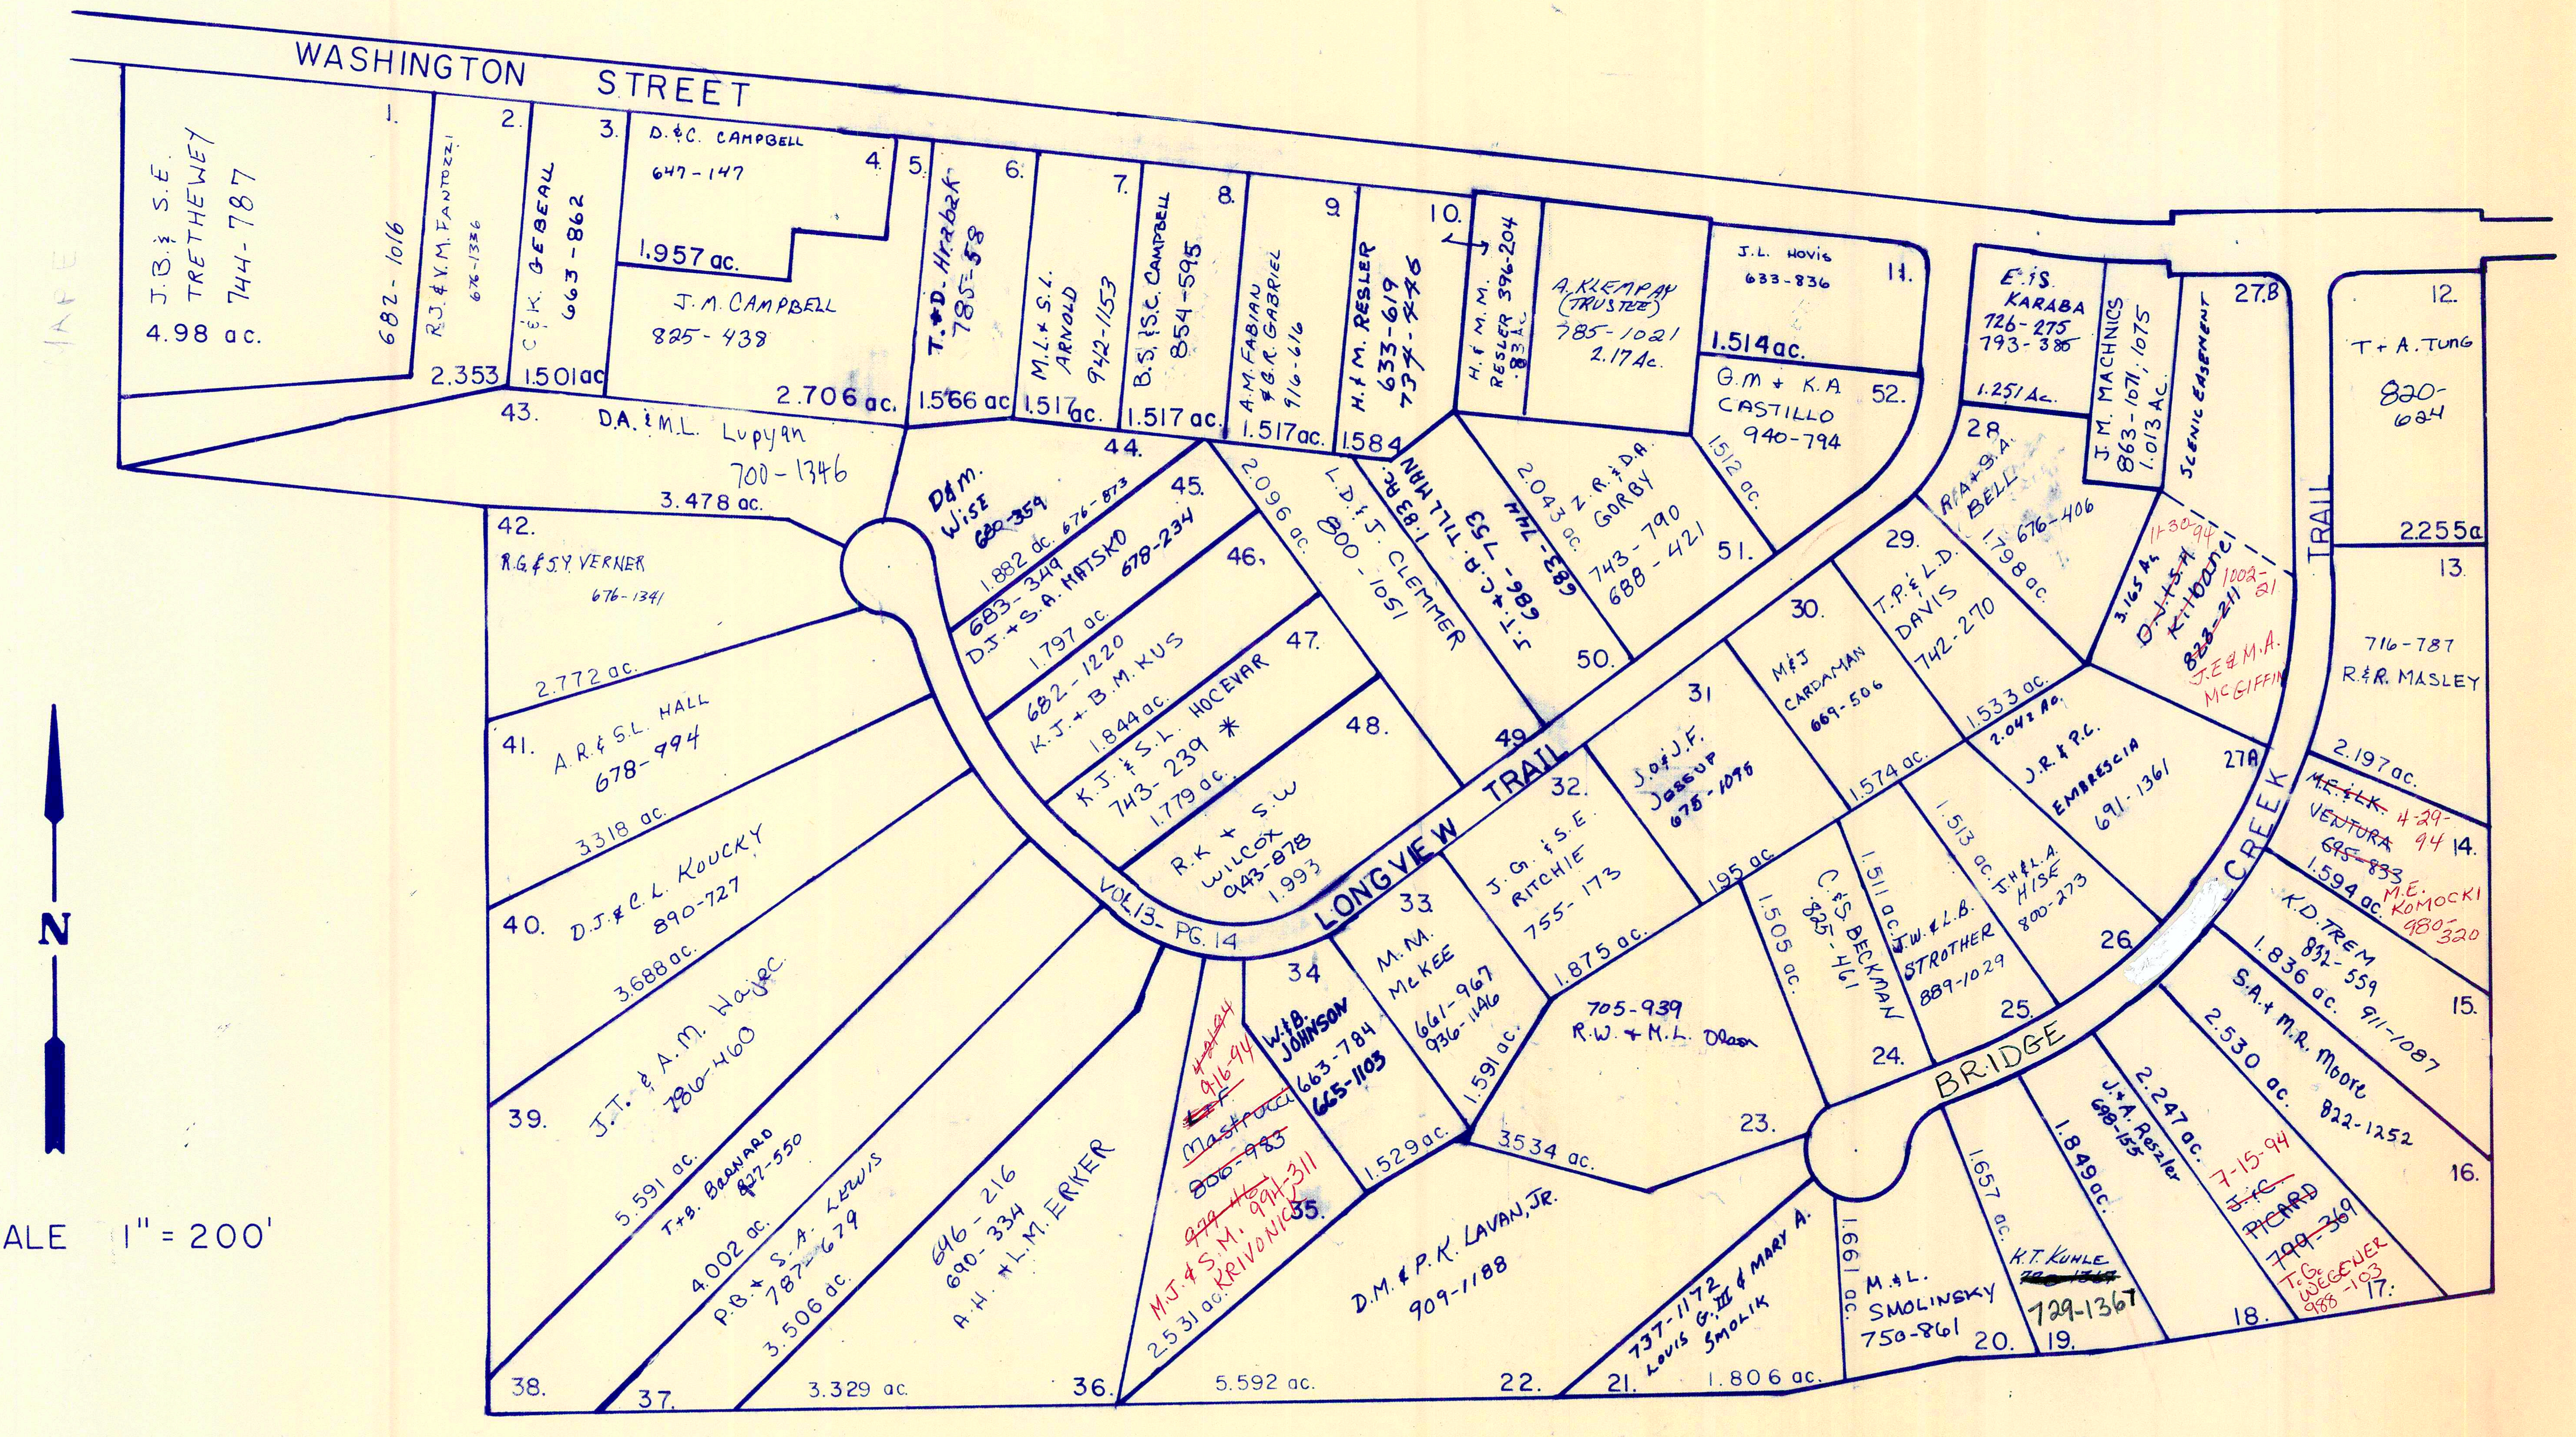
WASHINGTON STREET
LONGVIEW TRAIL
CREEK TRAIL
BRIDGE
VOL.13- PG.14
N
1. J.B. & S.E. TRETHEWEY 744-787 4.98 ac. 682-1016
2. R.J. & V.M. FANTOZZI 676-1336 2.353
C. & K. GEBEAU 663-862 1.501 ac
3. D. & C. CAMPBELL 647-147 1.957 ac.
4. J.M. CAMPBELL 825-438 2.706 ac.
5. T. & D. Hrabak 785-58 1.566 ac
6. M.L. & S.L. ARNOLD 942-1153 1.517 ac.
7. B.S. & S.C. CAMPBELL 854-595 1.517 ac.
8. A.M. FABIAN & G.R. GABRIEL 916-616 1.517 ac.
9. H. & M. RESLER 633-619 734-746 1.584
10. H. & M.M. RESLER 396-204 .83 Ac.
A. KLEMPAY (TRUSTEE) 785-1021 2.17 Ac.
11. J.L. HOVIS 633-836 1.514 ac.
52. G.M. & K.A. CASTILLO 940-794 1.512 ac.
E. & S. KARABA 726-275 793-386 1.251 Ac.
J.M. MACHNICS 863-1071, 1075 1.013 Ac.
SCENIC EASEMENT
27B
12. T. & A. TUNG 820-624 2.255 ac
13. 716-787 R. & R. MASLEY
14. ~~M.E. & L.K. VENTURA 695-833~~ 4-29-94 M.E. KOMOCKI 980-320 2.197 ac.
15. K.D. TREM 832-559 1.594 ac.
16. S.A. & M.R. Moore 822-1252 1.836 ac. 911-1087
17. ~~J.C. PICARD 799-369~~ 7-15-94 T.G. WEGENER 988-103 2.530 ac.
18. J. & A. Reszler 698-155 2.247 ac.
19. K.T. Kuhle ~~729-1367~~ 729-1367 1.849 ac.
20. M. & L. SMOLINSKY 750-861 1.657 ac.
21. 737-1172 Louis G. III & Mary A. Smolik 1.661 ac. 1.806 ac.
22. D.M. & P.K. LAVAN, JR. 909-1188 5.592 ac.
23. 705-939 R.W. & M.L. Olson 3.534 ac.
24. C. & S. BECKMAN 825-461 1.505 ac.
25. J.W. & L.B. STROTHER 889-1029 1.511 ac.
26. J.H. & L.A. HISE 800-273 1.513 ac.
27A J.R. & P.C. EMBRESCIA 691-1361 2.042 Ac.
3.165 Ac. ~~D.J. & S.H. Kilbane 823-211~~ 11-30-94 1002-21 J.E. & M.A. McGIFFIN
28. R.A. & S.A. BELL 676-406 1.798 ac.
29. T.P. & L.D. DAVIS 742-270 1.533 ac.
30. M. & J. CARDAMAN 669-506 1.574 ac.
31. J.O. & J.F. JOSSUP 675-1098 .195 ac.
32. J.G. & S.E. RITCHIE 755-173 1.875 ac.
33. M.M. McKEE 661-967 936-1146 1.591 ac.
34. W. & B. JOHNSON 663-784 665-1103 1.529 ac.
35. ~~L.F. Mastrocci 806-983~~ ~~4-8-94~~ 9-16-94 ~~979-116~~ M.J. & S.M. KRIVONIC 994-311 2.531 ac.
36. 646-216 690-334 A.H. & L.M. ERKER 3.329 ac.
37. P.B. & S.A. LEWIS 787-679 3.506 ac.
38. T. & B. BARNARD 827-550 4.002 ac.
39. J.T. & A.M. Hajec 786-460 5.591 ac.
40. D.J. & C.L. KOUCKY 890-727 3.688 ac.
41. A.R. & S.L. HALL 678-494 3.318 ac.
42. R.G. & S.Y. VERNER 676-1341 2.772 ac.
43. D.A. & M.L. Lupyan 700-1346 3.478 ac.
44. D. & M. WISE 680-359 1.882 ac. 676-873
45. 683-349 D.J. & S.A. MATSKO 678-234 1.797 ac.
46. 682-1220 K.J. & B.M. KUS 1.844 ac.
47. K.J. & S.L. HOCEVAR 743-239 * 1.779 ac.
48. R.K. & S.W. WILCOX 943-878 1.993
49. L.D. & J. CLEMMER 800-1051 2.096 ac.
50. J.T. & C.A. TILLMAN 753-689 683-744 1.83 ac.
51. Z.R. & D.A. GORBY 743-790 688-421 2.043 ac.

SCALE 1" = 200'

S/L 27 RESUB VOL. 14- PG. 50

LONGVIEW FARMS 1&2

VOL. 12 PP. 62-64

VOL. 13 PP. 13-16

*Inadequate Description

JANUARY 1, 1994

Relative Representation

1-T

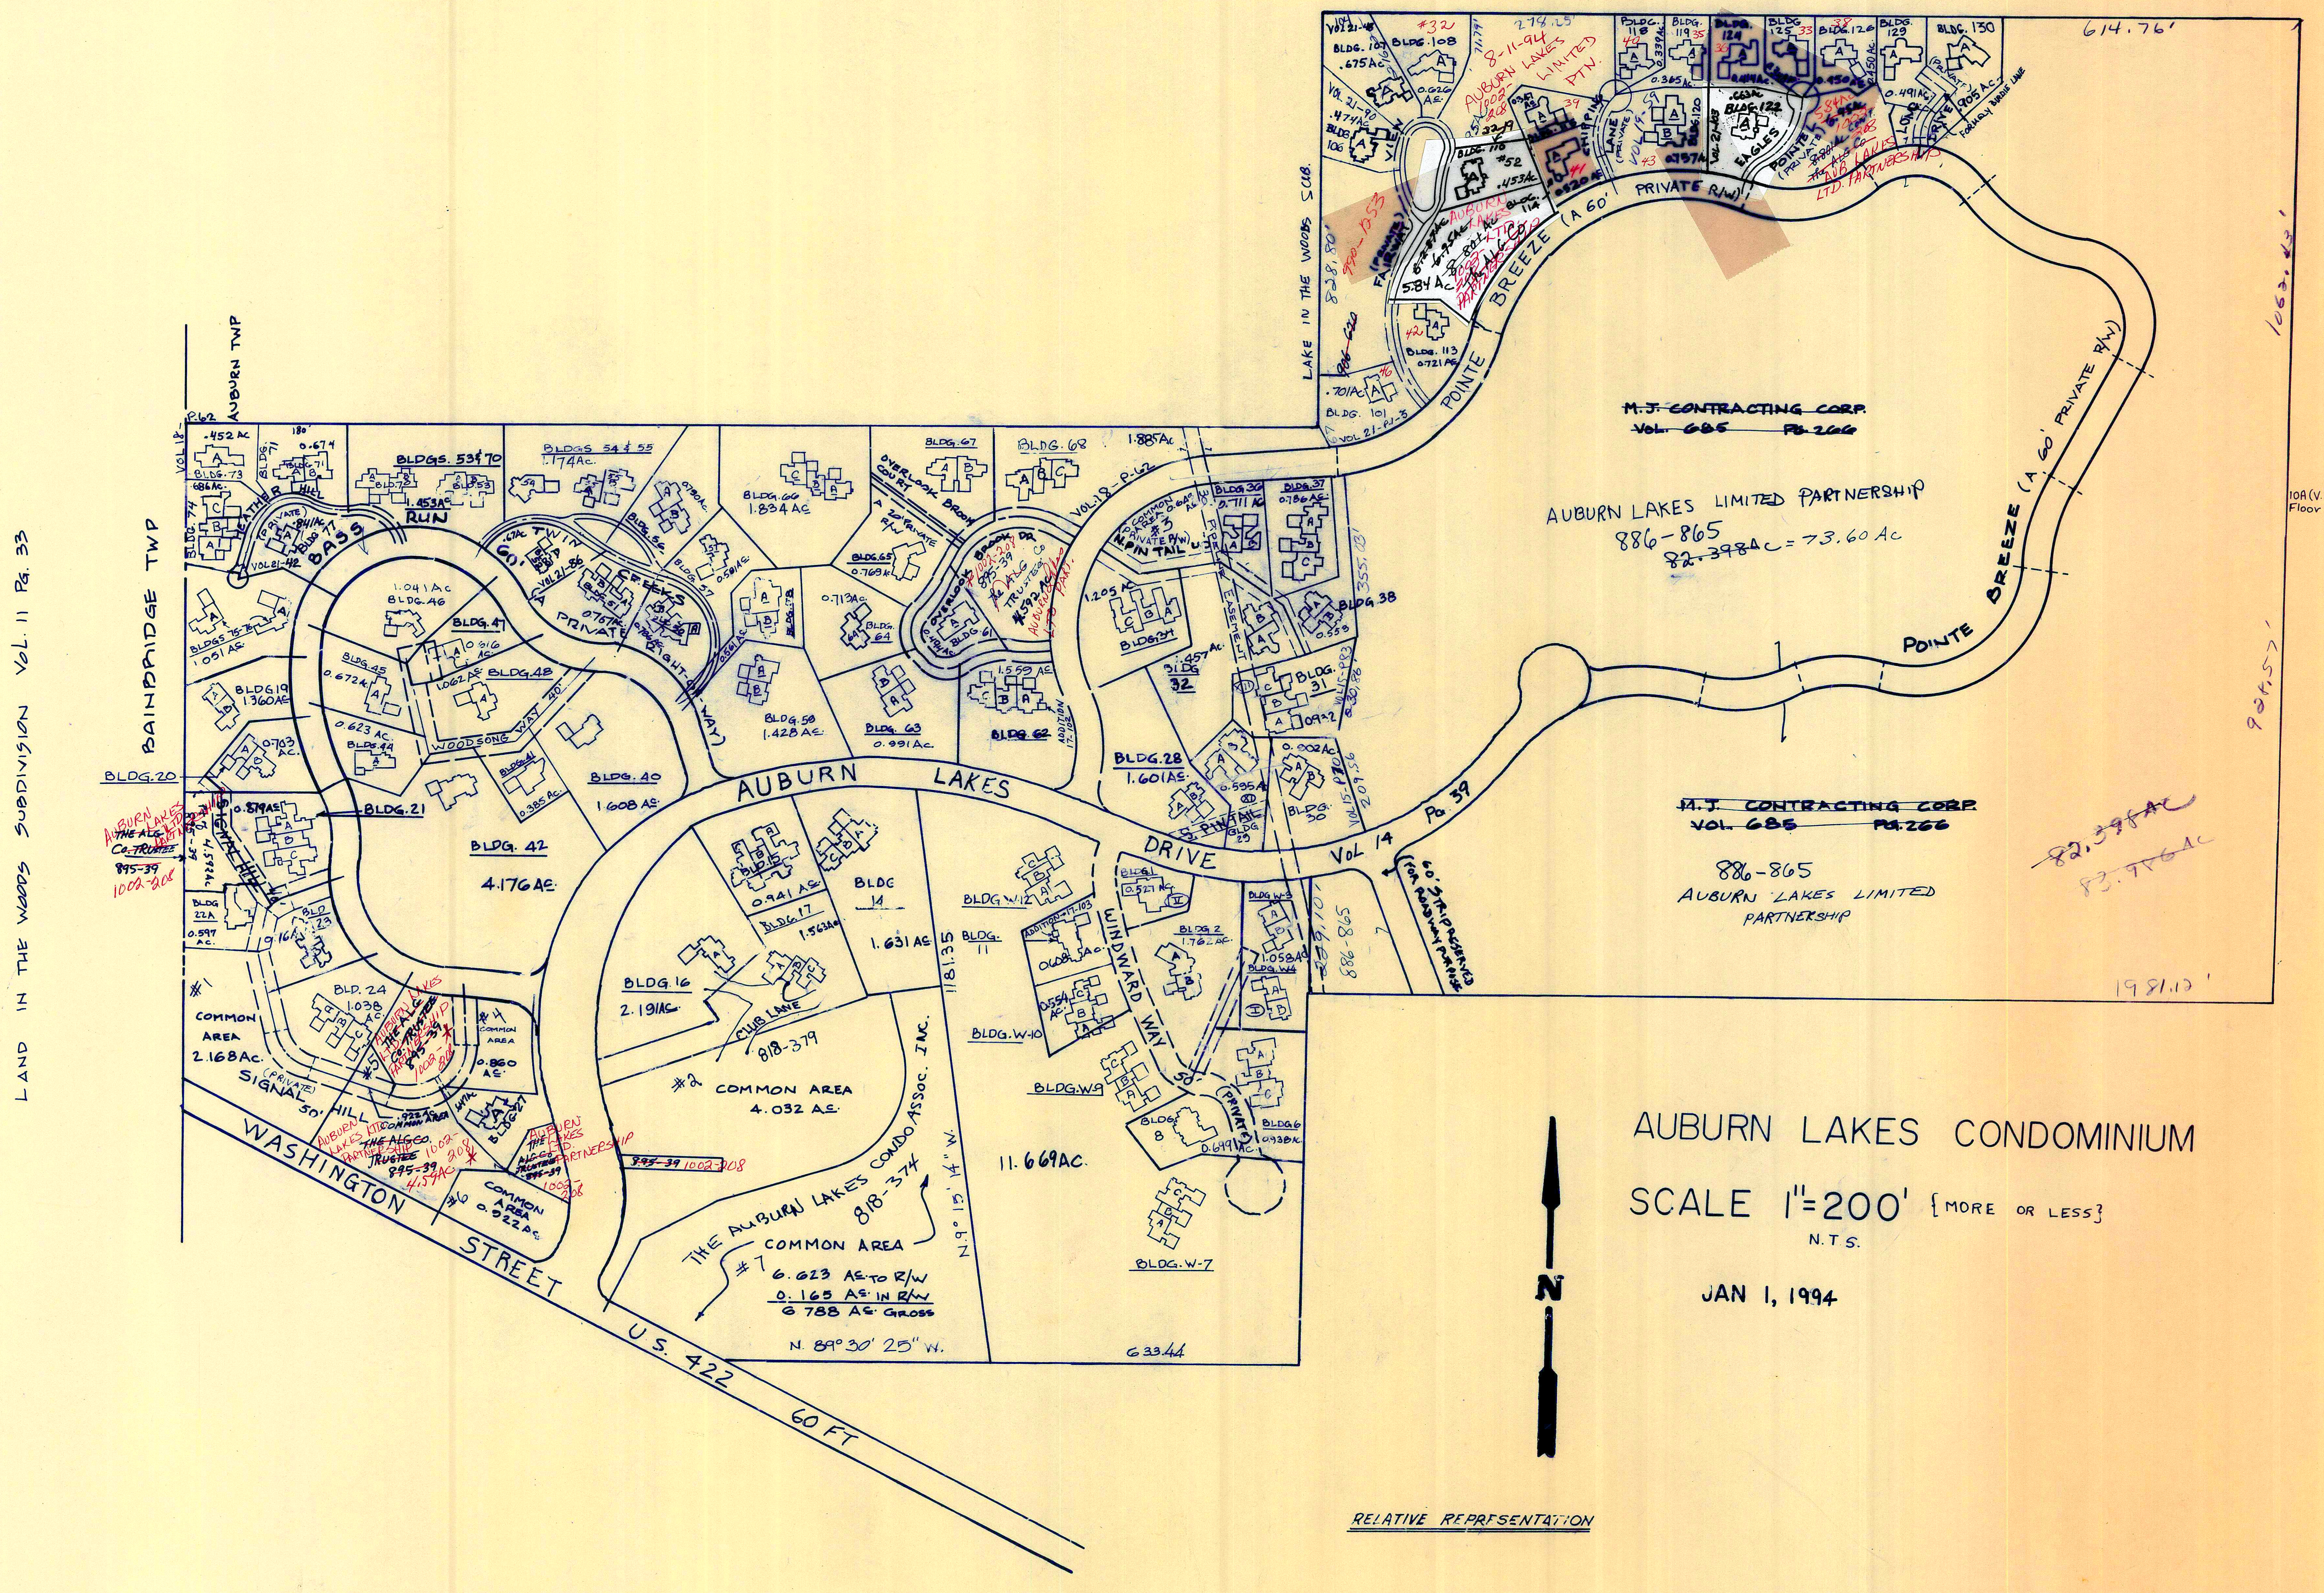
LAND IN THE WOODS SUBDIVISION VOL. 11 PG. 33
BAINBRIDGE TWP
AUBURN TWP
LAKE IN THE WOODS SUB.
AUBURN LAKES
DRIVE
VOL 14 PG 39
POINTE BREEZE (A 60' PRIVATE R/W)
POINTE BREEZE (A 60' PRIVATE R/W)
~~M.J. CONTRACTING CORP.~~
~~VOL. 685 PG. 266~~
AUBURN LAKES LIMITED PARTNERSHIP
886-865
~~82.398Ac~~ = 73.60 Ac
~~M.J. CONTRACTING CORP.~~
~~VOL. 685 PG. 266~~
886-865
AUBURN LAKES LIMITED PARTNERSHIP
~~82.398Ac~~
~~83.956Ac~~
614.76'
1063.43'
928.57'
1981.12'
828.80'
10A (V.16-P.70) Floor Plans
8-11-94
AUBURN LAKES 1002-208
LIMITED PTN.
BLDG. 107
.675Ac
BLDG. 108
#32
0.626 AC.
VOL 21-90
.474Ac
BLDG. 106
VIEW
BLDG. 116
#52
.453Ac
5.84 Ac
AUBURN LAKES LTD. PARTNERSHIP
BLDG. 114
0.520 AC
CHIPPING
LANE (PRIVATE)
BLDG. 118
BLDG. 119
BLDG. 120
BLDG. 122
BLDG. 124
BLDG. 125
BLDG. 126
BLDG. 129
BLDG. 130
0.365 Ac.
0.757 Ac
.663 Ac
0.491 Ac
.905 Ac.
EAGLES
POINTE (PRIVATE)
AUB LAKES LTD. PARTNERSHIP
LONG DRIVE (PRIVATE)
FORMERLY BIRDIE LANE
BLDG. 113
0.721 AC
BLDG. 101
.701 Ac
VOL 21-P1-3
FAIRWAY (PRIVATE)
990-1553
986-620
BLDG. 36
0.711 AC
BLDG. 37
0.786 AC.
BLDG. 38
0.553
BLDG. 31
0.9 3 2
BLDG. 30
0.902 Ac.
355.03'
209.56
VOL 15-P83
VOL 15-P70
N. PIN TAIL
S. PIN TAIL
#3 COMMON AREA PRIVATE R/W
EASEMENT
BLDG 34
1.205 AC
BLDG 32
.457 AC.
BLDG. 28
1.601 AC.
BLDG. 29
0.595 AC
60' STRIP RESERVED FOR ROADWAY PURPOSE
886-865
BLDG W-3
1.058 AC
BLDG. W4
BLDG 6
0.938 AC.
VOL 18-P62
.452 AC
BLDG. 73
.686 Ac.
BLDG. 71
0.674
180'
BLDG. 74
HEATHER HILL
BLDG. 77
.841 AC
VOL 21-42
BASS
RUN
BLDGS. 53 & 70
1.453 AC
BLDGS 54 & 55
1.174 Ac.
TWIN CREEKS
A PRIVATE RIGHT-OF-WAY
VOL 21-86
BLDG. 51
0.767 AC.
BLDG. 56
BLDG. 57
0.501 AC
0.790 AC.
BLDG. 66
1.834 AC
BLDG. 67
OVERLOOK COURT
OVERLOOK BROOK
A 20' PRIVATE R/W
OVERLOOK BROOK DR.
BLDG. 68
1.885 Ac
VOL 18-P-62
BLDG. 65
0.769 AC
BLDG. 64
0.713 AC.
BLDG. 61
0.481 AC
#592 AC
1002-208
895-39
ALG CO TRUSTEE
AUBURN LAKES LTD. PART.
BLDG. 62
1.559 AC
ADDITION 17-102
BLDG. 63
0.991 AC.
BLDG. 58
1.428 AC
0.561 AC
BLDG. 46
1.041 AC
BLDG. 47
0.616 AC.
BLDG. 48
1.062 AC
BLDG. 45
0.672 AC
BLDG. 44
0.623 AC.
WOODSONG WAY 40'
BLDG. 41
0.385 AC.
BLDG. 40
1.608 AC
BLDG. 42
4.176 AC
BLDGS 75-76
1.051 AC
BLDG 19
1.360 AC
0.703 AC.
BLDG. 20
BLDG. 21
0.579 AC
4.529 AC
AUBURN LAKES LTD. PARTNERSHIP
~~THE ALG Co. TRUSTEE~~
895-39
1002-208
BLDG 22A
0.597 AC.
BLD 23
9.16 AC
#1
COMMON AREA
2.168 Ac.
BLD. 24
1.038 AC
#5
AUBURN LAKES LTD. PARTNERSHIP
~~THE ALG CO. TRUSTEE~~
895-39
1002-208
#4
COMMON AREA
0.860 AC.
SIGNAL HILL (PRIVATE) 50'
.922 AC COMMON AREA
AUBURN LAKES LTD. PARTNERSHIP
~~THE ALG CO. TRUSTEE~~
~~895-39~~
1002-208
4.59 AC
BLDG 27
AUBURN LAKES LTD. PARTNERSHIP
~~THE ALG CO. TRUSTEE~~
~~895-39~~
1002-208
#6
COMMON AREA
0.922 AC
~~895-39~~ 1002-208
WASHINGTON STREET
U.S. 422
60 FT
BLDG 15
0.941 AC
BLDG 17
1.563 AC
BLDG 14
1.631 AC
BLDG 16
2.191 AC
CLUB LANE
818-379
#2
COMMON AREA
4.032 AC
THE AUBURN LAKES CONDO. ASSOC. INC.
818-374
#7
COMMON AREA
6.623 AC TO R/W
0.165 AC IN R/W
6.788 AC GROSS
N. 89° 30' 25" W.
N. 9° 15' 14" W.
1181.35
633.44
BLDG. W-12
BLDG. 11
11.669 AC.
ADDITION 17-103
0.608 AC
0.554 AC.
BLDG. W-10
BLDG. W-9
BLDG. W-7
BLDG. 1
0.527 AC
BLDG 2
1.762 AC.
WINDWARD WAY
50'
(PRIVATE)
BLDG 8
0.691 AC.
N

AUBURN LAKES CONDOMINIUM

SCALE 1" = 200' {MORE OR LESS}

N.T.S.

JAN 1, 1994

RELATIVE REPRESENTATION

* INADEQUATE DESCRIPTION

1-U

U-1

ADDRESS

BLDG/ UNIT	TRANSFERRED TO	VOL.	PG	TRANSFERRED TO	VOL.	PG	TRANSFERRED TO	VOL.	PG.	TRANSFERRED TO	VOL	PG
BLDG W-1	(WINDWARD WAY)	15	1									
A-66	M. & N. LAVIN	718	161									
BLDG-W-2	(WINDWARD WAY)	17	47-58									
A-64	P. & A. BRICKENDEN	819	69									
B-62	~~J. KINZIG~~ W.J. EDWARDS	~~820~~	~~200~~	W.J. EDWARDS 5-6-94	980	1137						
BLDG W-3	(WINDWARD WAY)	14	110-115									
A-54	A.D. O'HAVID	815	1040									
B-52	W.J. RINI	708	427									
BLDG W-4	(WINDWARD WAY)	14	110-115									
A-50	D. DOLCH	718	1127									
B-48	G.E. KING, TRUSTEE 941-635 941-641	842 917	553 216									
BLDG W-5												
BLDG W-6	(WINDWARD WAY)	15	1									
A-46	D&J. MATZ	718	203									
B-44	W.L. RISIUS	735	1292									
C-42	W&T. MASTERS	809	405									
BLDG W-7	(WINDWARD WAY)	14	72									
A-40	M.A.BERG QC ~~& S. LYNN~~ 992-877 8-31-94	823	949									
B-38	H. EPPRECHT	700	1300	A.C. Herndon 7-25-94	989	127						
C-36	C. HOLYLAND 873-22	714	720									
BLDG W-8	(WINDWARD WAY)	14	130-136									
A-34	D.F. LEDERER	922	1137									
B-32												
BLDG W-9	(WINDWARD WAY)	14	72									
A-30	E.H. DOLAN	947	211									
B-28	B. DEUTSCH	919	67									
C-26	B.H. WARNER	881	980									
BLDG W-10	(WINDWARD WAY)	14	110-115									
A-24	G&C. HERMAN	861	970									
B-22	K&D. WERNER	707	1185									
C-20	H. EPPRECHT	867	293									
BLDG W-11	(WINDWARD WAY) & VOL. 17 PG 103	14	130-136									
A-16	LAKESIDE ESTATE SERVICES	917 921	485 1&12									
BLDG - W-12	(WINDWARD WAY)	14	72									
A-14	B.A. IRWIN	941	1309									
B-12	C.L. DOBBS, TRUSTEE	887	910									
C-10	S.M. & C.T. QUA	727	160									
BLDG 13												
BLDG 14		15	48-52									
A-68	C.J. & A.D. McBRIDE	749	652									
B-70	THOMAS & GLORIA CAVES	729	1230									
C-72	DONALD & DORIS WISE	730	944									
BLDG 15	(COVE COURT)	15	17									
A-74	T.D. & D.R. CLARK	765	634									
B-76	T. & B. PORTER	826	333									
C-78	M. LIDGEY 844-398	868	550									
BLDG 16	(CLUB LANE)	15	119-127									
A-80	R.L. & R. MINTZ	755	792									
BLDG 17	(CLUB LANE)	15	91									
A-84	N. & A. SCHWARTZ	856	327									
B-86	D.H. DIETZ, JR.	940	265									
C-88	H.T. FAY	748	810									
BLDG 18												
BLDG 19		15	27									
A-92	J.A. ROGERS	945	654									
B-94	J.W. & K.J. LASKEY	934	383									
BLDG 20		14	141-144									
A-96	MARK & NANCY MILLS	729	881									
B-98	R.G. ROBERTS	716	97									
BLDG 21	(SIGNAL HILL) 14-124;	15	21									
A-100	J.R. & E. HAHN	879	641									
B-102	CHICAGO TITLE, TRUSTEE	944	1331	B.O. BAUMGARTNER 9-28-94	995	594						
C-104	B.W. & E.P. HOLMES	907	1149									
BLDG 22	(SIGNAL HILL)	15	70									
A-110	RICHARD J. & KATHRYN A. MANFREDI	740	44									
BLDG 23	(SIGNAL HILL)	15	91									
A-112	T.D. EVANS	749	865									
B-114	A.S. FOX, TRUSTEE	890 929	1226; 1110									
BLDG 24	(SIGNAL HILL)	16	29-34									
A-116	R.J. KICHLER	801	1289									
B-118	R.A. GREEN	782	396									
C-120	J. SMITH	817	747									
BLDG 25												
BLDG 26												
BLDG 27	(SIGNAL HILL)	20	115-118									
A-136	A.G. & L.L. SCHURING	942	693									
BLDG 28	(SOUTH PINTAIL)	15	56									
A-138	P. & R. KYSELA	834	645	R.F. KYSELA	987	448						
B-140	H.B. & S.D. MARX, TRUSTEES 739-493	897	1252									
BLDG 29	(SOUTH PINTAIL)	15	60									
A-142	J.J. & Z.L. LIPTAK	736	427									
B-144	R.E. & P.H. FRUIT	877	143									

1 U

U-1

BLDG/UNIT	TRANSFERRED TO	VOL	PG	TRANSFERRED TO	VOL	PG	TRANSFERRED TO	VOL	PG	TRANSFERRED TO	VOL	PG
BLDG 30	(SOUTH PINTAIL)	15	70									
A-186	L.D. REDA	920	908									
B-184	B.M. VENNETTI	895	987									
BLDG 31	(NORTH PINTAIL)	15	83									
A-146	L.M. & G.A. CORTRIGHT	888	525									
B-148	R.A. FRITZSCHE	750	77									
C-150	R.C. & T.J. JACKSON	890	680									
BLDG 32	(NORTH PINTAIL)	15	91									
A-152	D.C. & R.G. SKINNER	751	889									
B-154	W.K. OLIVIER	751	554									
BLDG 33												
BLDG 34		15	1									
A-160	G. & U. HARTLEY	793	647									
B-162	V. & B. WEBER	822	476									
C-164	R.J. & C.J. SRP	736	979									
BLDG 35												
BLDG 36	(NORTH PINTAIL)	15	119-127									
A-170	~~D.H. & L.W. MATHEWS~~ R.D. STEWART, MD 8-22-94	991 ~~756~~	1215 ~~779~~									
B-172	E.V. GORDON	759	1162									
BLDG 37	(NORTH PINTAIL)	15	143-146									
A-174	E.F. & C.L. GLEASON	879	311									
B-176	R.V. HOUSEL	856	336									
C-178	~~B.A. & G.E. BARTON~~ E.J. & E.W. SCHMIDT 980-45	~~929~~	~~3~~									
BLDG 38	(NORTH PINTAIL)	16	19-23									
A-180	W.N. & J.M. SCHWAIGER	778	1188									
B-182	H. & N. BURSTEIN	789	897									
BLDG 39												
BLDG 40	(WOODSONG WAY)	16	118-122									
40-188	C.T. GROTH	831	681									
BLDG 41	(Woodsong Way)	15	60-67									
190	L.J. & E.H. DOLAN	884	24									
BLDG 42	(WOODSONG WAY)	16	43-46									
A-192	~~H.~~ E.E. HENDERSHOTT TRUST	897	138	E.E. HENDERSHOTT-TRUST 2-22-94	972	874						
BLDG 43												
BLDG 44	(WOODSONG WAY)	18	145-153									
A-196	K. & F. SORACE	853	156									
BLDG 45	(WOODSONG WAY)	17	84-92									
A-198	M. & U. STANTON-HICKS	821	1262									
BLDG 46	(WOODSONG WAY)	17	131-38									
200	R., JR & C. GOWLAND	829	714									
BLDG 47	(WOODSONG WAY)	17	8-16									
A-202	M. PENSIERO	814	749									
BLDG 48	(WOODSONG WAY)	18	33-38									
A-204	W.L. RISIUS	834	370	R.W, JR. & D.S. CRAIG 12-2-94	1002	323						
BLDG 49												
BLDG 50	(TWIN CREEKS)	16	82-92									
A-240	~~L&R CROUSE~~	797	765	J.M. ANDBERG 11-28-94	1001	478						
B-242	P. & E. CHAPPLE	808	59									
BLDG 51	(TWIN CREEKS)	19	88-91									
A-244	R.T. & J. KRAUS	865	428									
B-246	~~K.M. CARLSON~~ ~~F.M. MASTRUCCI 994-219~~ ~~863-310~~	~~895~~	~~72~~	F.M. MASTRUCCI	994	219						
BLDG 52	(TWIN CREEKS)	21	86									
A-	L.D. WEIMER 4-26-94	979	740									
BLDG 53	(TWIN CREEKS DRIVE)	17	8-16									
A-256	J. & B. COLLIER	817	560									
B-258	H. & H. DUNLOP	813	919									
BLDG 54	(TWIN CREEKS DRIVE)	16	148-155									
A-262	F. ADLER	809	284									
BLDG 55	(TWIN CREEKS DRIVE)	16	148-155									
A-264	~~G. & S. VILLERS~~	820	363	A.L. & C.R. HYDE 10-25-94	998	383						
A-266	J. & S. KALISER	861	369									
BLDG 56	(TWIN CREEKS)	16	82-92									
A-268	D. & J. PIPER	853	1086									
B-270	E.A. LEONETTI	797	758									
BLDG 57	(TWIN CREEKS)	16	72-76									
A-276	R.W. SIWIK	794	955									
BLDG 58	(TWIN CREEKS)	15	149-53									
A-278	D.J. JONES	770	1									
A-280	S.H. & R.L. SILVER	774	1079									
BLDG 59	(TWIN CREEKS)	16	35-42									
A-282	R.C. & S.C. MARCHANT	787	412									
B-284	W.K. INDERLIED	833	677									
BLDG 60-												
BLDG 61	(OVERLOOK BROOK DRIVE)	18	145-153									
A-296	E. BELTON	852	84									
BLDG 62	(OVERLOOK BROOK DRIVE)	16	8-11									
A-298	T.J. & P.A. KREBS	848	1229									
B-300	A.M. KOVAL	942	258									
C-302	X. & C. WILSON	773	446									
BLDG 63	(OVERLOOK BROOK DRIVE)	16	82									
A-304	P.L. FARROW	796	130	C.D. FARROW, JR.	983	1035						
B-306	C.R. ZACHEM	796	1056									

BLDG/UNIT	TRANSFERRED TO	VOL	PG.	TRANSFERRED TO	VOL	PG.	TRANSFERRED TO	VOL	PG.	TRANSFERRED TO	VOL	PG.
BLDG 64	(OVERLOOK BROOK DRIVE)	16	148-55									
A-310	M. & S. DUFFY	808	136									
BLDG 65	(OVERLOOK BROOK DRIVE)	16	123-26									
A-312	J. & J. HALLACK	803	927									
BLDG 66	(OVERLOOK BROOK COURT)	16	35-42									
A-326	M.J. SWADEY	904	1279									
B-324	R.C. HUGE, J.R. & P.S. LONGFELLOW	879	10									
C-322	C.J. & M.S. GIBLIN	786	1262									
BLDG 67	(OVERLOOK BROOK DRIVE)	17	84-92									
A-328	J.R. BEAVER 949-594; 595	848	979									
B-330	E. LAZIO	821	301									
BLDG 68	(OVERLOOK BROOK DRIVE)	18	62-68									
A-334	T. & J. JOHNSON	837	18									
B-336	L.H. & F.C. KINCAID	890	23	M.D. YOUNG 6-1-94	983	465						
C-338	A. & S. ARMSTRONG	842	143									
BLDG 69												
BLDG 70	(HEATHER HILL)	17	8-16									
A-210	D. & C. SAZIMA	815	1095									
B-208	V. & P. SCOCOS	813	697									
BLDG 71	(HEATHER HILL)	17	131-138									
A-214	J. & L. GRUNZWEIG	829	754									
B-212	W.J. & E.J. O'BRIEN	849	243									
BLDG 72												
BLDG 73	(HEATHER HILL)	18	62-68									
A-216	M. & R. WILLIAMS	837	528									
BLDG 74	(HEATHER HILL)	17	119-122									
A-222	C.C. SPATH	831	1359									
B-220	W.F. HOTCHKIN	827	422									
C-218	W. & B. MILLER	833	365									
BLDG 75	(HEATHER HILL)	17	47-58									
A-224	R. & E. BLAKE FAMILY TRUST	864	721									
BLDG 76	(HEATHER HILL)	17	47-58									
A-226	G. BIANCHINI & N. BEAN 864-721;	818	676	B.F. PAWLIKOWSKY	967 967	259 262	B.C. RICHARDS & B.H. WARNER 11-25-94	1001	433			
BLDG 77	(HEATHER HILL)	21	42-45									
A-232	J.F. & D.M. GALLAGHER	943	542									
BLDG 78												
BLDG 79												
BLDG 80												
BLDG 81												
BLDG 82												
BLDG 83												
BLDG 84												
BLDG 85												
BLDG 86												
BLDG 87												
BLDG 88												
BLDG 89												
BLDG 90												
BLDG 91												
BLDG 92												
BLDG 93												

1-U

U-4

BLDG/UNIT + ADD	TRANSFERRED TO	VOL	PG.	TRANSFERRED TO	VOL	PG.	TRANSFERRED TO	VOL	PG.	TRANSFERRED TO	VOL.	PG.
BLDG 94												
BLDG 95												
BLDG 96												
BLDG 97												
BLDG 98												
BLDG 99												
BLDG 100												
BLDG 101 —	(FAIRWAY VIEW) —	21	1-3									
A-400	B.C. KAGY 922-200;	923	1013									
BLDG 102												
BLDG 103												
BLDG 104												
BLDG 105												
BLDG 106 —	(FAIRWAY VIEW) —	21	90									
A-420	H.C. FALL, TRUSTEE 963-871											
BLDG 107 —	(FAIRWAY VIEW) →	21	48-51									
A 424	G.L RYE	944	918									
BLDG 108 —	(FAIRWAY VIEW) →	17	143-47									
A-422	E. & S. GALLO	831	478	W.G. & JA PRYOR 8-10-94	990	1039						
BLDG 109												
—	FAIRWAY VIEW — AMENDMENT #52(-453)	22	19 to 21									
BLDG 110	DR SEDIVY & JE BIXBY 8-5-94	989	1216									
BLDG 111												
BLDG 112												
BLDG 113 —	(FAIRWAY VIEW) —	19	31-35									
A-402	S. PETERSON	878	926									
BLDG 114 —	(CHIPPING LANE) —	19	16-18									
A-425	B.R. RESCH	855	433									
BLDG 115 —	(CHIPPING LANE) —	18	137-41									
A-426	D.S. & B.J. MANNING	849	809									
BLDG 116												
BLDG 117												
BLDG 118 —	(CHIPPING LANE) —	18	145-153									
A-429	D.G. WIGGLESWORTH	850	1216									
BLDG 119 —	(CHIPPING LANE) —	18	76-79									
A-430	D.J. & R.M. JOYCE	860	316									
BLDG 120 —	(CHIPPING LANE) —	19	59-62									
A-431	S.L. & M.R. DURCHSLAG	896	678									
B-432	P. & J. LEIKEN	861	935									
BLDG 121												
BLDG 122 —	EAGLES POINTE —	21	103									
A-434	R.A. & G.B. NEWMAN	971	12									

1U

BLDG/UNIT	TRANSFERRED TO	VOL	PG.	TRANSFERRED TO	VOL	PG.	TRANSFERRED TO	VOL.	PG.	TRANSFERRED TO	VOL.	PG.
BLDG 123												
BLDG 124	(EAGLES POINTE)	18	95-98									
A-435	E. O. MARCH	841	253									
BLDG 125	(EAGLES POINTE)	18	137-141									
A-436	W.F. MUNDAY, JR. & R.M. MUNDAY	848	1275									
BLDG 126	(EAGLES POINTE)	18	33-38									
A-437	B. & T. HUNTER	835	337	M.J. BONEBRAKE 10-31-94	998	1116						
BLDG 127												
BLDG 128												
BLDG 129	(LONG DRIVE)	18	133									
A-440	G. & P. O'BRIEN	847	47									
BLDG 130	(LONG DRIVE)	18	121									
A-441	J. & A. HUTSON 844-574	853	1059									
THE AUBURN	LAKES CONDOMINIUM ASSOC., INC	818	374-386									
PAR #1	2.168Ac											
PAR #2	4.032Ac											
PAR #3	.649 Ac											
PAR #4	.860 Ac.											
PAR #5	.092 Ac.											
PAR #6	.922 Ac.											
PAR #7	6.623Ac.											