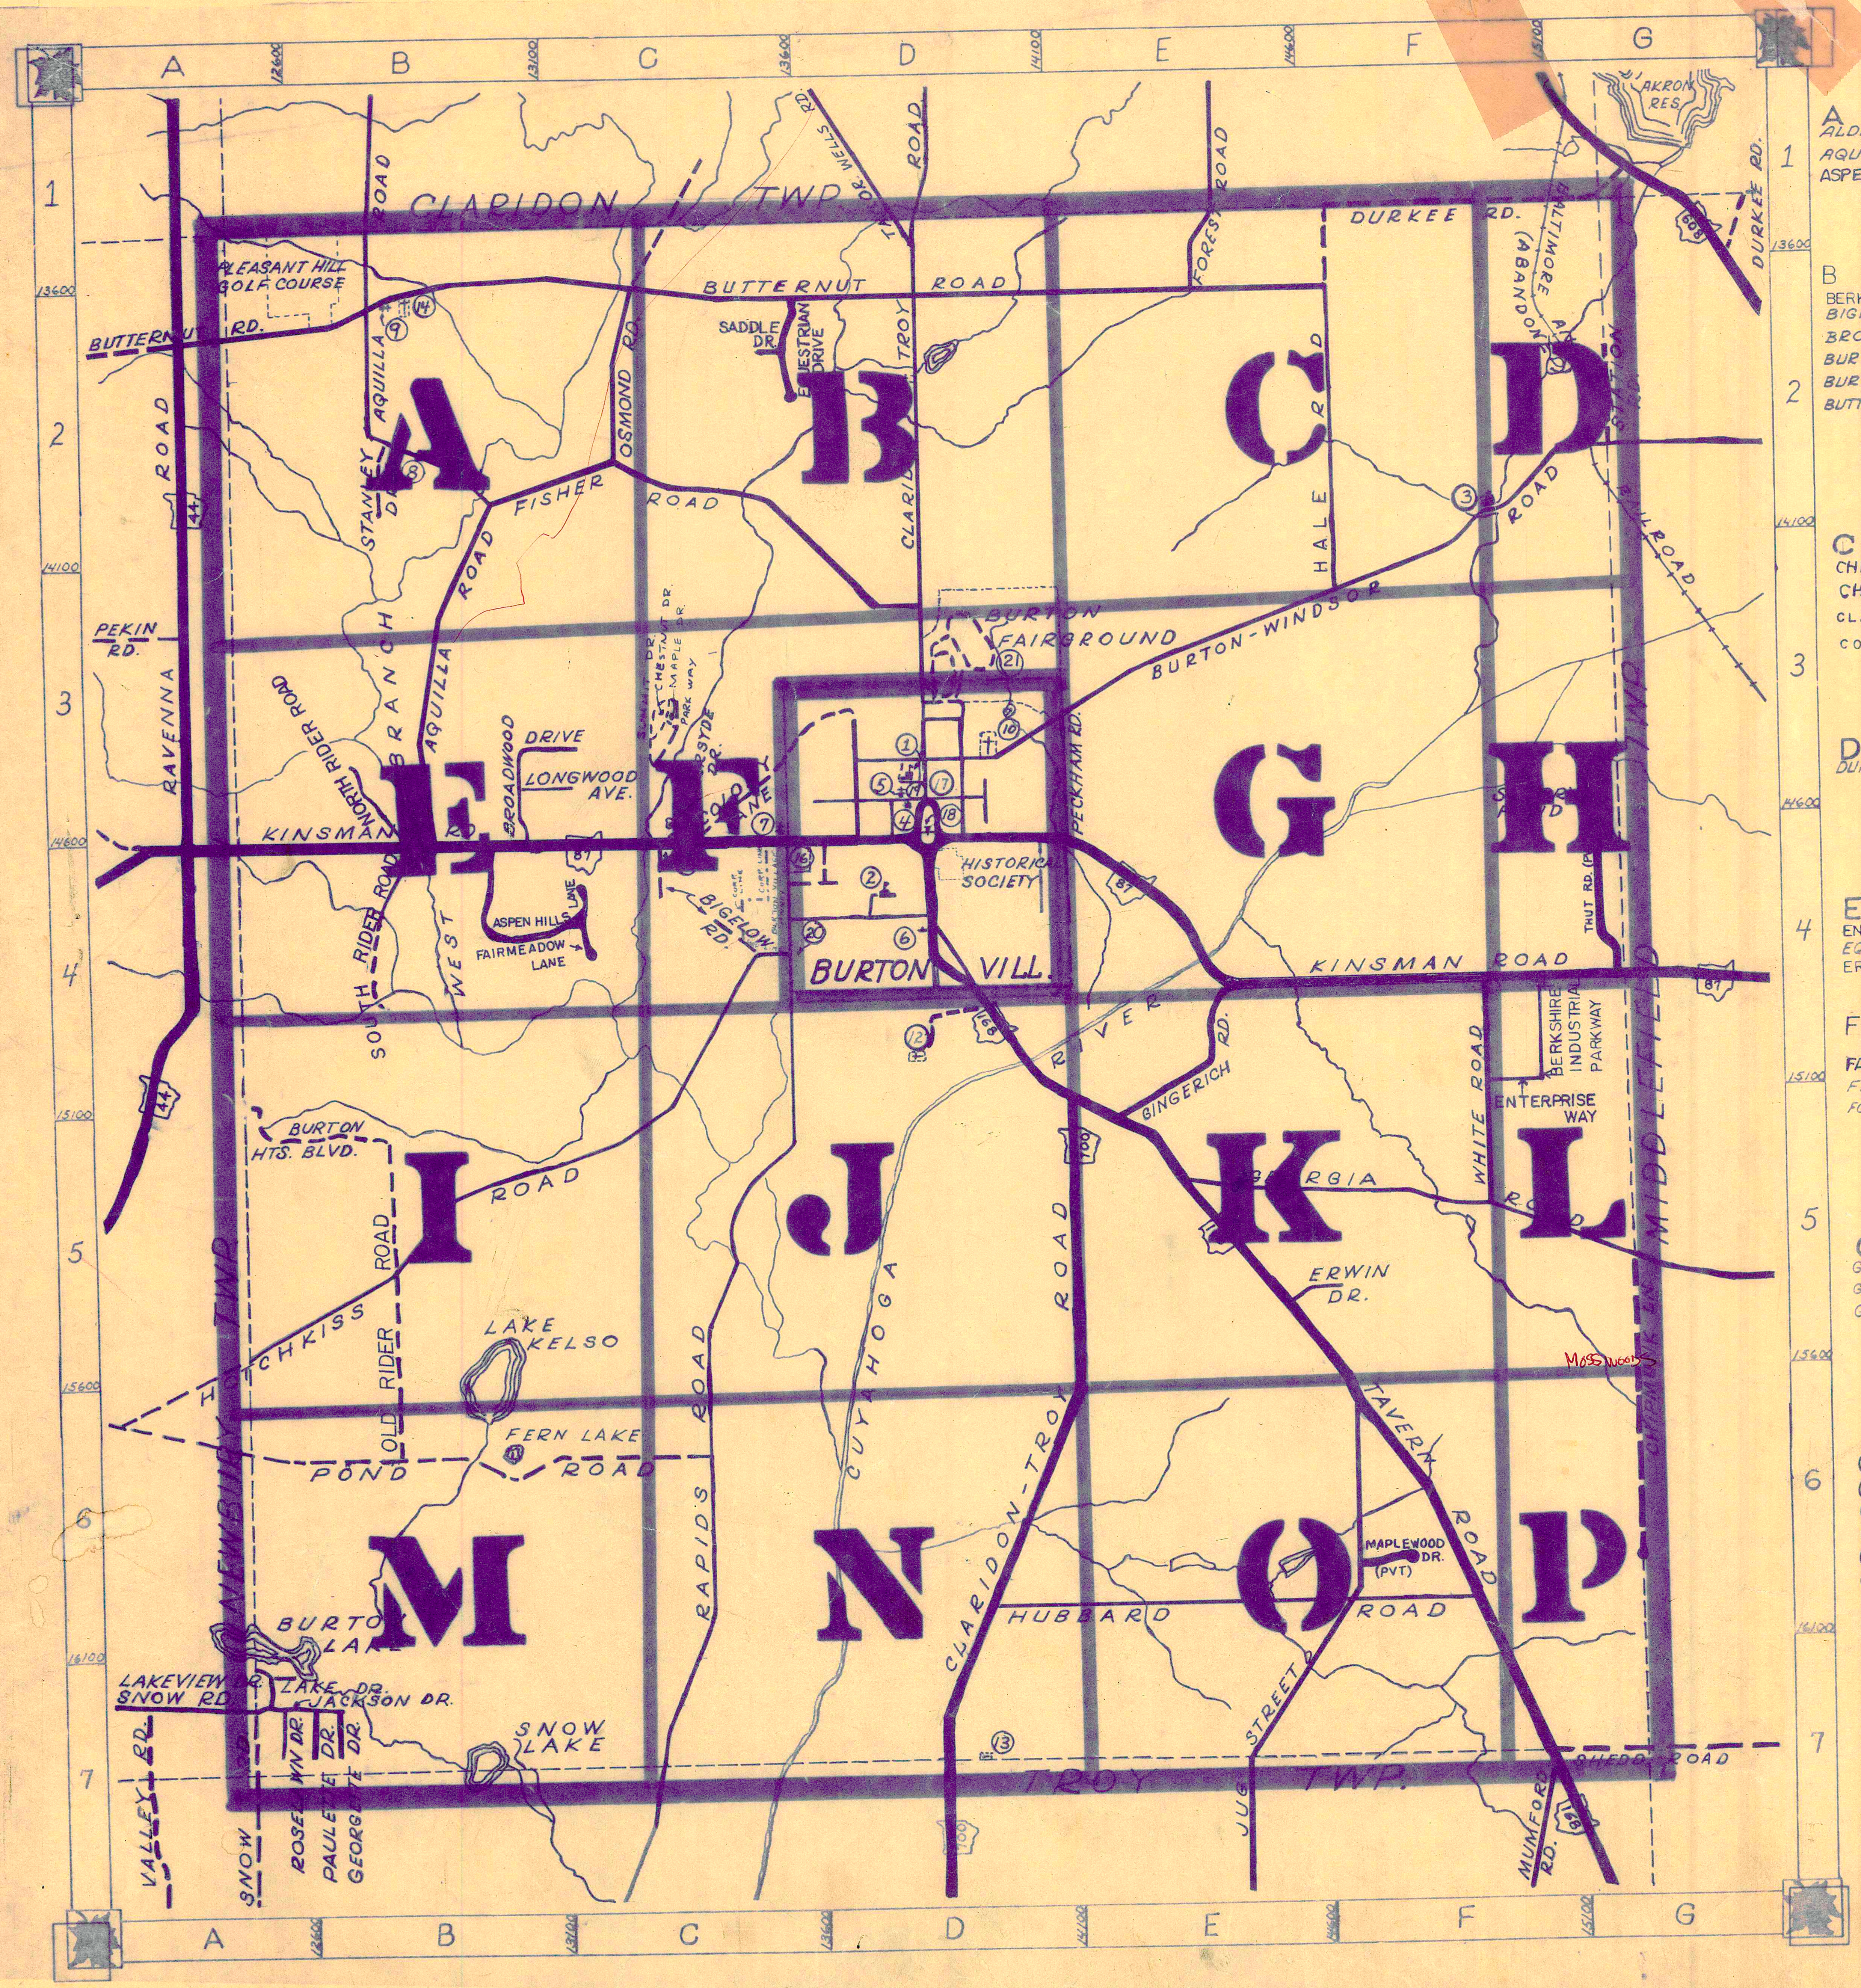
A
B
C
D
E
F
G
1
2
3
4
5
6
7
12600
13100
13600
14100
14600
15100
15600
16100
CLARIDON TWP.
TROY TWP.
NEWBURY TWP.
MIDDLEFIELD TWP.
PLEASANT HILL GOLF COURSE
BUTTERNUT RD.
BUTTERNUT ROAD
RAVENNA ROAD
44
PEKIN RD.
STANLEY DR.
AQUILLA ROAD
OSMOND RD.
FISHER ROAD
SADDLE DR.
EQUESTRIAN DRIVE
CLARIDON TROY
TAYLOR WELLS RD.
ROAD
FOREST ROAD
DURKEE RD.
HALE RD
BALTIMORE (ABANDONED) RD.
STATION RD.
RAILROAD
AKRON RES.
608
BURTON FAIRGROUND
BURTON-WINDSOR ROAD
PECKHAM RD.
BRANCH
NORTH RIDER ROAD
BROADWOOD DRIVE
LONGWOOD AVE.
SUMMIT DR.
CHESTNUT DR.
MAPLE DR.
PARK WAY
ALDERSYDE DR.
COLONY LANE
KINSMAN RD.
KINSMAN ROAD
87
ASPEN HILLS LANE
FAIRMEADOW LANE
SOUTH RIDER ROAD
WEST
BIGELOW RD.
HISTORICAL SOCIETY
BURTON VILL.
THUT RD. (PVT)
BERKSHIRE INDUSTRIAL PARKWAY
ENTERPRISE WAY
WHITE ROAD
168
RIVER
GINGERICH RD.
GEORGIA ROAD
ERWIN DR.
MOSS WOODS
CHIPMUNK LN.
CUYAHOGA
CLARIDON-TROY ROAD
100
TAVERN ROAD
MAPLEWOOD DR. (PVT)
HUBBARD ROAD
JUG STREET
SHEDD ROAD
MUMFORD RD.
BURTON HTS. BLVD.
HOTCHKISS ROAD
OLD RIDER ROAD
LAKE KELSO
FERN LAKE
POND ROAD
RAPIDS ROAD
BURTON LAKE
LAKEVIEW DR.
SNOW RD.
LAKE DR.
JACKSON DR.
SNOW LAKE
VALLEY RD.
SNOW
ROSELAWN DR.
PAULETTE DR.
GEORGETTE DR.
A
B
C
D
E
F
G
H
I
J
K
L
M
N
O
P
①
②
③
④
⑤
⑥
⑦
⑧
⑨
⑩
⑪
⑫
⑬
⑭
⑯
⑰
⑱
⑲
⑳
㉑

ROAD INDEX

A	
ALDERSYDE DR.	C-3
AQUILLA RD.	B1-B3
ASPEN HILLS LN.	B4
B	
BERKSHIRE INDUSTRIAL PARKWAY	F-4
BIGELOW RD.	C-4
BROADWOOD DR.	B-3
BURTON HTS. BLVD.	A-5
BURTON-WINDSOR RD.	D3-G2
BUTTERNUT RD.	A2-F2
C	
CHESTNUT DR. (PVT)	C-3
CHIPMUNK LN.	G-5
CLARIDON TROY RD.	D1-D7
COLONY LN.	C-3
D	
DURKEE RD.	F-1
E	
ENTERPRISE WAY	F-4
EQUESTRIAN DR	C-2
ERWIN DR.	E-5
F	
FAIRMEADOW LN.	C-4
FISHER RD.	B2-D3
FOREST RD.	E-1
G	
GEORGETTE DR.	B-7
GEORGIA RD.	E5-G5
GINGERICH RD.	E-4
H	
HALE RD.	F-2
HOTCHKISS RD.	A6-C4
HUBBARD RD.	D6-F6
I	
J	
JACKSON DR.	A-7
JUG ST.	E7-F6
K	
KINSMAN RD.	A4-G4
L	
LAKE RD.	A-7
LAKEVIEW DR.	A-7
LONGWOOD AVE.	B-3
M	
MAPLE DR. (PVT)	C-3
MAPLEWOOD DR. (PVT)	F-6
MEMORIAL RD.	D-4
MOSS WOODS DR	MAP L+P
N	
NORTH RIDER ROAD	B-3
O	
OLD RIDER ROAD	B-5
OSMOND ROAD	C-2
P	
PARK WAY	C-3
PAULETTE DR.	A-7
P cont.	
PECKHAM RD.	E-3
POND RD.	A6-C6
R	
RAPIDS RD.	C7-C4
ROSELAWN DR.	A-7
S	
SADDLE DR	C-2
SHEDD RD.	G-7
SNOW RD.	A-7
SOUTH RIDER RD	B-3
STANLEY DR	B-2
STATION RD	G 1-2
SUMMIT DR (PVT)	C-3
T	
TAVERN RD.	D4-G7
TAYLORWELLS RD.	D-1
THUT RD. (PVT)	G-4
U	
V	
W	
WHITE RD.	F4-F5

N

① BERKSHIRE HIGH SCHOOL
② BURTON ELEM. SCHOOL
③ MAPLE VIEW MENNONITE CH. & SCH.
④ BURTON CONGREGATIONAL CH.
⑤ ASSEMBLY OF GOD CHURCH
⑥ ONNEN TOIVO (TEMPERANCE SOC.)
⑦ CHRISTIAN SCIENCE CHURCH
⑧ MENNONITE CHURCH
⑨ MENNONITE CHURCH
⑩ WELTON CEMETERY
⑪ WILLIAMS CEMETERY
⑫ LOWER CEMETERY
⑬ SLITOR CEMETERY
⑭ PLEASANT HILL CEMETERY
⑮ GEAUGA COUNTY HIGHWAY DEP
⑯ STATE HIGHWAY DEPT.
⑰ UNITED STATES POST OFFICE
⑱ BURTON SUGAR HOUSE
⑲ BURTON VOL. FIRE DEPT.
⑳ BURTON TOWNSHIP HALL
㉑ BURTON FAIRGROUNDS

BURTON TOWNSHIP

0 5 10 15 20

SCALE: 1" = 2000'

ROBERT L. PHILLIPS,
GEAUGA COUNTY ENGINEER

— — — — UNPAVED ROADS
——— PAVED ROADS
+++++ RAILROAD
— — — — TOWNSHIP LINE
— - — - — VILLAGE CORP. LINE

012496CT
Fisher

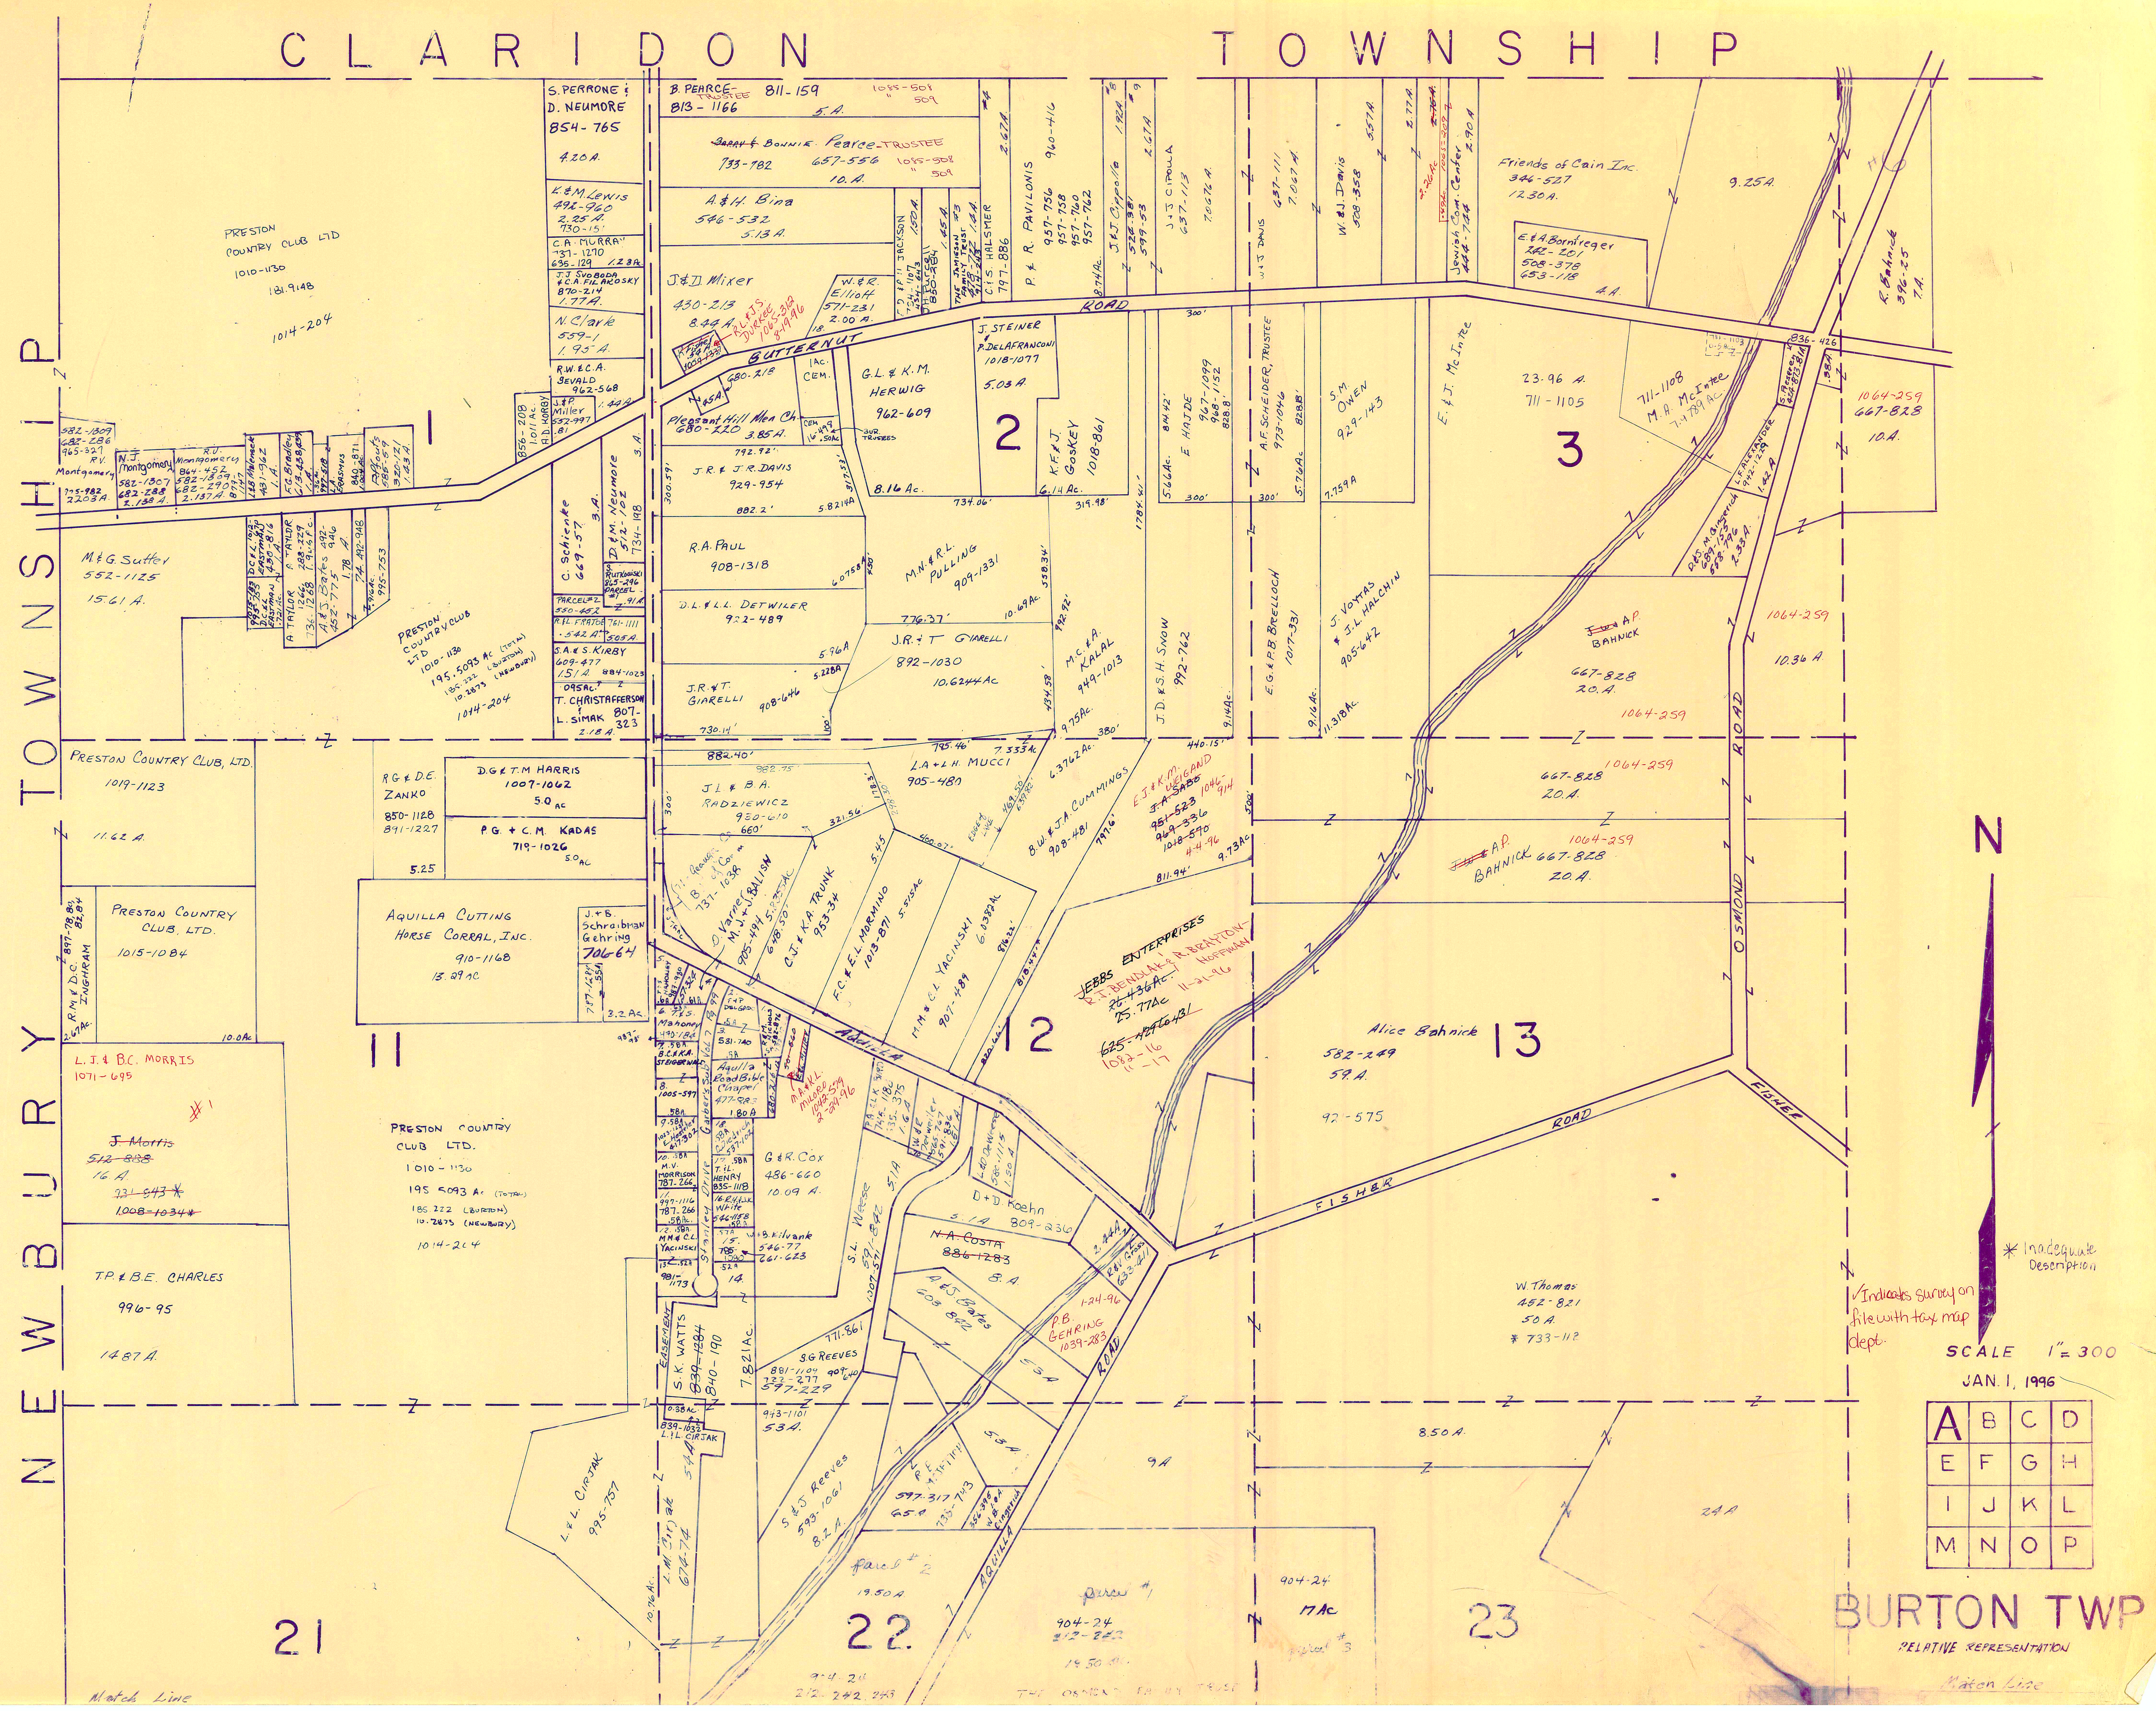
CLARIDON TOWNSHIP
NEWBURY TOWNSHIP
1
2
3
11
12
13
21
22
23
N
PRESTON COUNTRY CLUB LTD
1010-1130
181.9148
1014-204
S. PERRONE & D. NEUMORE
854-765
4.20 A.
K.&M. Lewis
492-960
2.25 A.
730-151
C.A. MURRAY
737-1270
635-129
1.28 Ac.
J.J SVOBODA & C.A. FILAKOSKY
870-214
1.77 A.
N. Clark
559-1
1.95 A.
R.W.&C.A. SEVALD
962-568
1.44 A.
J.&P. Miller
552-997
.81
856-208
1.011 Ac.
A.D. KORBY
582-1309
682-286
965-327
R.V. Montgomery
775-982
2.203 A.
N.J. Montgomery
582-1307
682-288
2.138 A.
R.U. Montgomery
864-452
582-1309
682-2907
2.137 A.
877-147
L.&B. Malensek
431-962
1 A.
F.G. Bradley
613-438, 439
1 A.
.36 Ac.
997-518
L.A. ERASMUS
840-871
1.004 Ac.
R. Pfouts
585-59
320-121
1.43 A.
M.&G. Sutter
552-1125
15.61 A.
D.C.&L. EASTMAN
1013-183
430-816
1 A.
995-755
D.C.&L. EASTMAN
.721 Ac.
A. TAYLOR
288-229
1.9415 Ac.
A. TAYLOR
1266
736-1268
A.&J. Bates
492-946
452-775
1.78 A.
74 492-948
.916 Ac.
995-753
PRESTON COUNTRY CLUB LTD
1010-1130
195.5093 AC (TOTAL)
185.222 (BURTON)
10.2873 (NEWBURY)
1014-204
C. Schienke
669-57
3.A.
D.&M. Neumore
512-102
734-198
3.A.
S. RUTKOWSKI
865-296
PARCEL #1
.91 A.
PARCEL #2
550-452
R.&L. FRATOE
761-1111
.542 A.
.505 A.
S.A.& S. KIRBY
609-477
1.51 A.
884-1023
.095 Ac.
T. CHRISTAFFERSON & L. SIMAK
807-323
2.18 A.
B. PEARCE-TRUSTEE
811-159
813-1166
5.A.
1085-508
" 509
~~BARRY &~~ BONNIE Pearce-TRUSTEE
733-782
657-556
10.A.
1085-508
" 509
A.&H. Bina
546-532
5.13 A.
J.&D. Mixer
430-213
8.44 A.
R.L.&J.S. DURKEE
1065-312
8-19-96
K. Fisher
.54 A.
1059-1331
W.&R. Elliott
571-231
2.00 A.
18.
C.D.&P.H. JACKSON
734-1107
434-643
1.50 A.
J.H. Purcell
850-284
1.45 A.
THE JAMIESON FAMILY TRUST #3
878-772
914-243
1.4 A.
C.&S. HALSMER
797-886
2.67 A.
#4
P.&R. PAVILONIS
960-416
957-756
957-758
957-760
957-762
8.74 Ac.
J.&J. Cippolla
526-381
599-53
1.92 A.
#8
2.67 A.
#9
J.&J. CIPOLLA
637-113
7.0676 A.
W.&J DAVIS
637-111
7.067 A.
W.&J. Davis
508-358
5.57 A.
2.77 A.
~~2.76 A.~~
2.26 Ac.
.49 Ac.
1065-209
Jewish Com. Center
444-744
2.90 A
BUTTERNUT ROAD
.45 A
680-218
Pleasant Hill Men Ch.
680-220
3.85 A.
1 Ac. CEM.
CEM
16-498
.50 Ac
BUR. TRUSTEES
G.L.&K.M. HERWIG
962-609
8.16 Ac.
J. STEINER & P. DELAFRANCONI
1018-1077
5.03 A.
K.F.&J. Goskey
1018-861
6.14 Ac.
300'
814.42'
5.66 Ac.
E. HAJDE
967-1099
968-1152
828.8'
A.F. SCHEIDER, TRUSTEE
973-1046
828.18'
5.76 Ac.
300'
S.M. OWEN
929-143
7.759 A
E.&J. McIntee
23.96 A.
711-1105
711-1108
M.A. McIntee
7.4789 Ac.
711-1103
0.5 Ac.
Friends of Cain Inc.
346-527
12.30 A.
E.&A. Bornfreger
242-201
508-378
653-118
4.A.
9.25 A.
R. Bahnick
396-25
7.A.
836-426
S. Pesaren
424-873
.81 A.
.38 A.
1064-259
667-828
10.A.
L.F. ALEXANDER
942-1229
1.42 A.
D.&S. M. Gingerich
689-155
558-796
2.33 A.
792.92'
J.R.& J.R. DAVIS
929-954
300.59'
317.53'
882.2'
5.8214 A
R.A. PAUL
908-1318
6.0758 A
450'
M.N.&R.L. PULLING
909-1331
558.34'
10.69 Ac.
776.37'
D.L.&L.L. DETWILER
922-489
5.96 A
5.228 A
J.R.&T. GIARELLI
892-1030
10.6244 Ac
J.R.&T. GIARELLI
908-646
100'
730.14'
992.92'
434.58'
M.C.&A. KALAL
949-1013
9.75 Ac.
380'
1784.41'
J.D.&S.H. SNOW
992-762
9.14 Ac.
E.G.&P.B. BRELLOCH
1017-331
9.16 Ac.
J. VOYTAS & J.L. HALCHIN
905-642
11.318 Ac.
~~J.W.&~~ A.P. BAHNICK
667-828
20.A.
1064-259
10.36 A.
OSMOND ROAD
1064-259
667-828
20.A.
1064-259
667-828
20.A.
~~J.W.&~~ A.P. BAHNICK
PRESTON COUNTRY CLUB, LTD.
1019-1123
11.62 A.
R.G.& D.E. ZANKO
850-1128
891-1227
5.25
D.G.& T.M HARRIS
1007-1062
5.0 AC
P.G. + C.M. KADAS
719-1026
5.0 AC
PRESTON COUNTRY CLUB, LTD.
1015-1084
R.M.& D.C. INGHRAM
897-78, 80, 82, 84
2.67 Ac.
10.0 Ac
AQUILLA CUTTING HORSE CORRAL, INC.
910-1168
13.29 AC
J.+B. Schraibman Gehring
706-64
787-1284
.551
3.2 Ac.
987-985
L.J.& B.C. MORRIS
1071-695
#1
~~J. Morris~~
~~512-888~~
16.A.
~~731-543~~ *
~~1.008-1034~~ *
T.P.& B.E. CHARLES
996-95
14.87 A.
PRESTON COUNTRY CLUB LTD.
1010-1130
195.5093 Ac (TOTAL)
185.222 (BURTON)
10.2873 (NEWBURY)
1014-204
882.40'
882.75'
785.46'
7.333 Ac
J.L.& B.A. RADZIEWICZ
930-610
660'
300'
178.3'
298.30'
321.56'
L.A.+L.H. MUCCI
905-480
6.3762 Ac.
Edge of LAKE
469.50'
639.82'
460.07'
B.W.& J.A. CUMMINGS
908-481
797.6'
E.J.&K.M. WEIGAND
~~J.A. SABO~~
~~951-523~~
~~969-336~~
~~1018-590~~
1046-914
4-4-96
9.73 Ac
811.94'
440.15'
500'
Geauga Co. B. of Com
737-1038
.13 Ac
D. Varner
M.J.+J. BALISN
905-494
5.8355 Ac
648.50'
C.J.& K.A. TRUNK
953-34
5.45
F.C.& E.L. MORMINO
1013-871
5.515 Ac
M.M.& C.L. YACINSKI
907-489
6.0382 Ac
816.22'
818.44'
820.66'
JEBBS ENTERPRISES
~~R.J. BENDLAK~~ & R. BRAYTON-HOFFMAN
~~26.436 Ac.~~
25.77 Ac
11-21-96
~~625-429 to 431~~
1082-16
11-17
AQUILLA
T.&S. MAHONEY
987-980
.6 A.
657-324
.61 A.
T.&S. Mahoney
470-184
B.C.&K.A. STEIGERWALD
1005-597
.58 A.
1023-1231
E. Hostetler
417-302
M.V. MORRISON
787-266
997-1116
787-266
.58 Ac.
M.M.& C.L. YACINSKI
981-1173
.52 A
Garber's Sub Vol 7 Pg 99
Stanley Drive
T.&P. DELGADO
531-740
.5 A
R.&M. NICHOLS
582-876
Aquilla Road Bible Chapel
477-983
1.80 A
680-216
M.A.&K.L. MILORO
1042-599
2-29-96
E. MILLER
501-660
L. Diedrich
537-102
T.& L. HENRY
835-1118
R.H.& L.K. White
546-1158
.58 A
W.& B. Kilvank
546-77
661-623
785-1080
G.&R. COX
486-660
10.09 A.
P.A.& L.K. BIRD
745-1180
535-375
1.6 A
W.&E. Detweiler
565-767
591-836
1.51 A.
L.&D. DeWeese
580-1115
1.50 A.
D+D. Koehn
809-236
5.1 A
~~N.A. COSTA~~
~~886-1283~~
8. A.
2.44 A.
R.&V. Gross
633-411
S.L. Weese
591-892
1007-571
5.1 A
A.&J. Bates
603-842
P.B. GEHRING
1039-283
1-24-96
ROAD
EASEMENT
S.K. WATTS
~~839-1284~~
840-190
7.821 Ac.
S.G REEVES
771-861
881-1109
722-277
597-229
909-640
943-1101
5.3 A.
5.3 A
5.3 A.
0.38 Ac.
839-1032
L.&L. CIRJAK
L.&L. CIRJAK
995-757
L.M. Cirjak
674-74
5.4 A
10.76 Ac.
S.&J. Reeves
593-1061
8.2 A
R.E. McIntire
597-317
735-743
6.5 A
356-395
W.B.
Gingerich
.0 A.
9A
AQUILLA
parcel #2
19.50 A.
parcel #1
904-24
212-242
19.50 Ac.
904-24
212-242, 243
THE OSMOND FAMILY TRUST
904-24
17 Ac
parcel #3
Alice Bahnick
582-249
59.A.
921-575
FISHER ROAD
FISHER
W. Thomas
452-821
50 A.
* 733-112
8.50 A.
24 A
Match Line
Match Line
A B C D
E F G H
I J K L
M N O P

BURTON TWP

RELATIVE REPRESENTATION

SCALE 1" = 300

JAN. 1, 1996

* Inadequate Description

✓ Indicates survey on file with tax map dept.

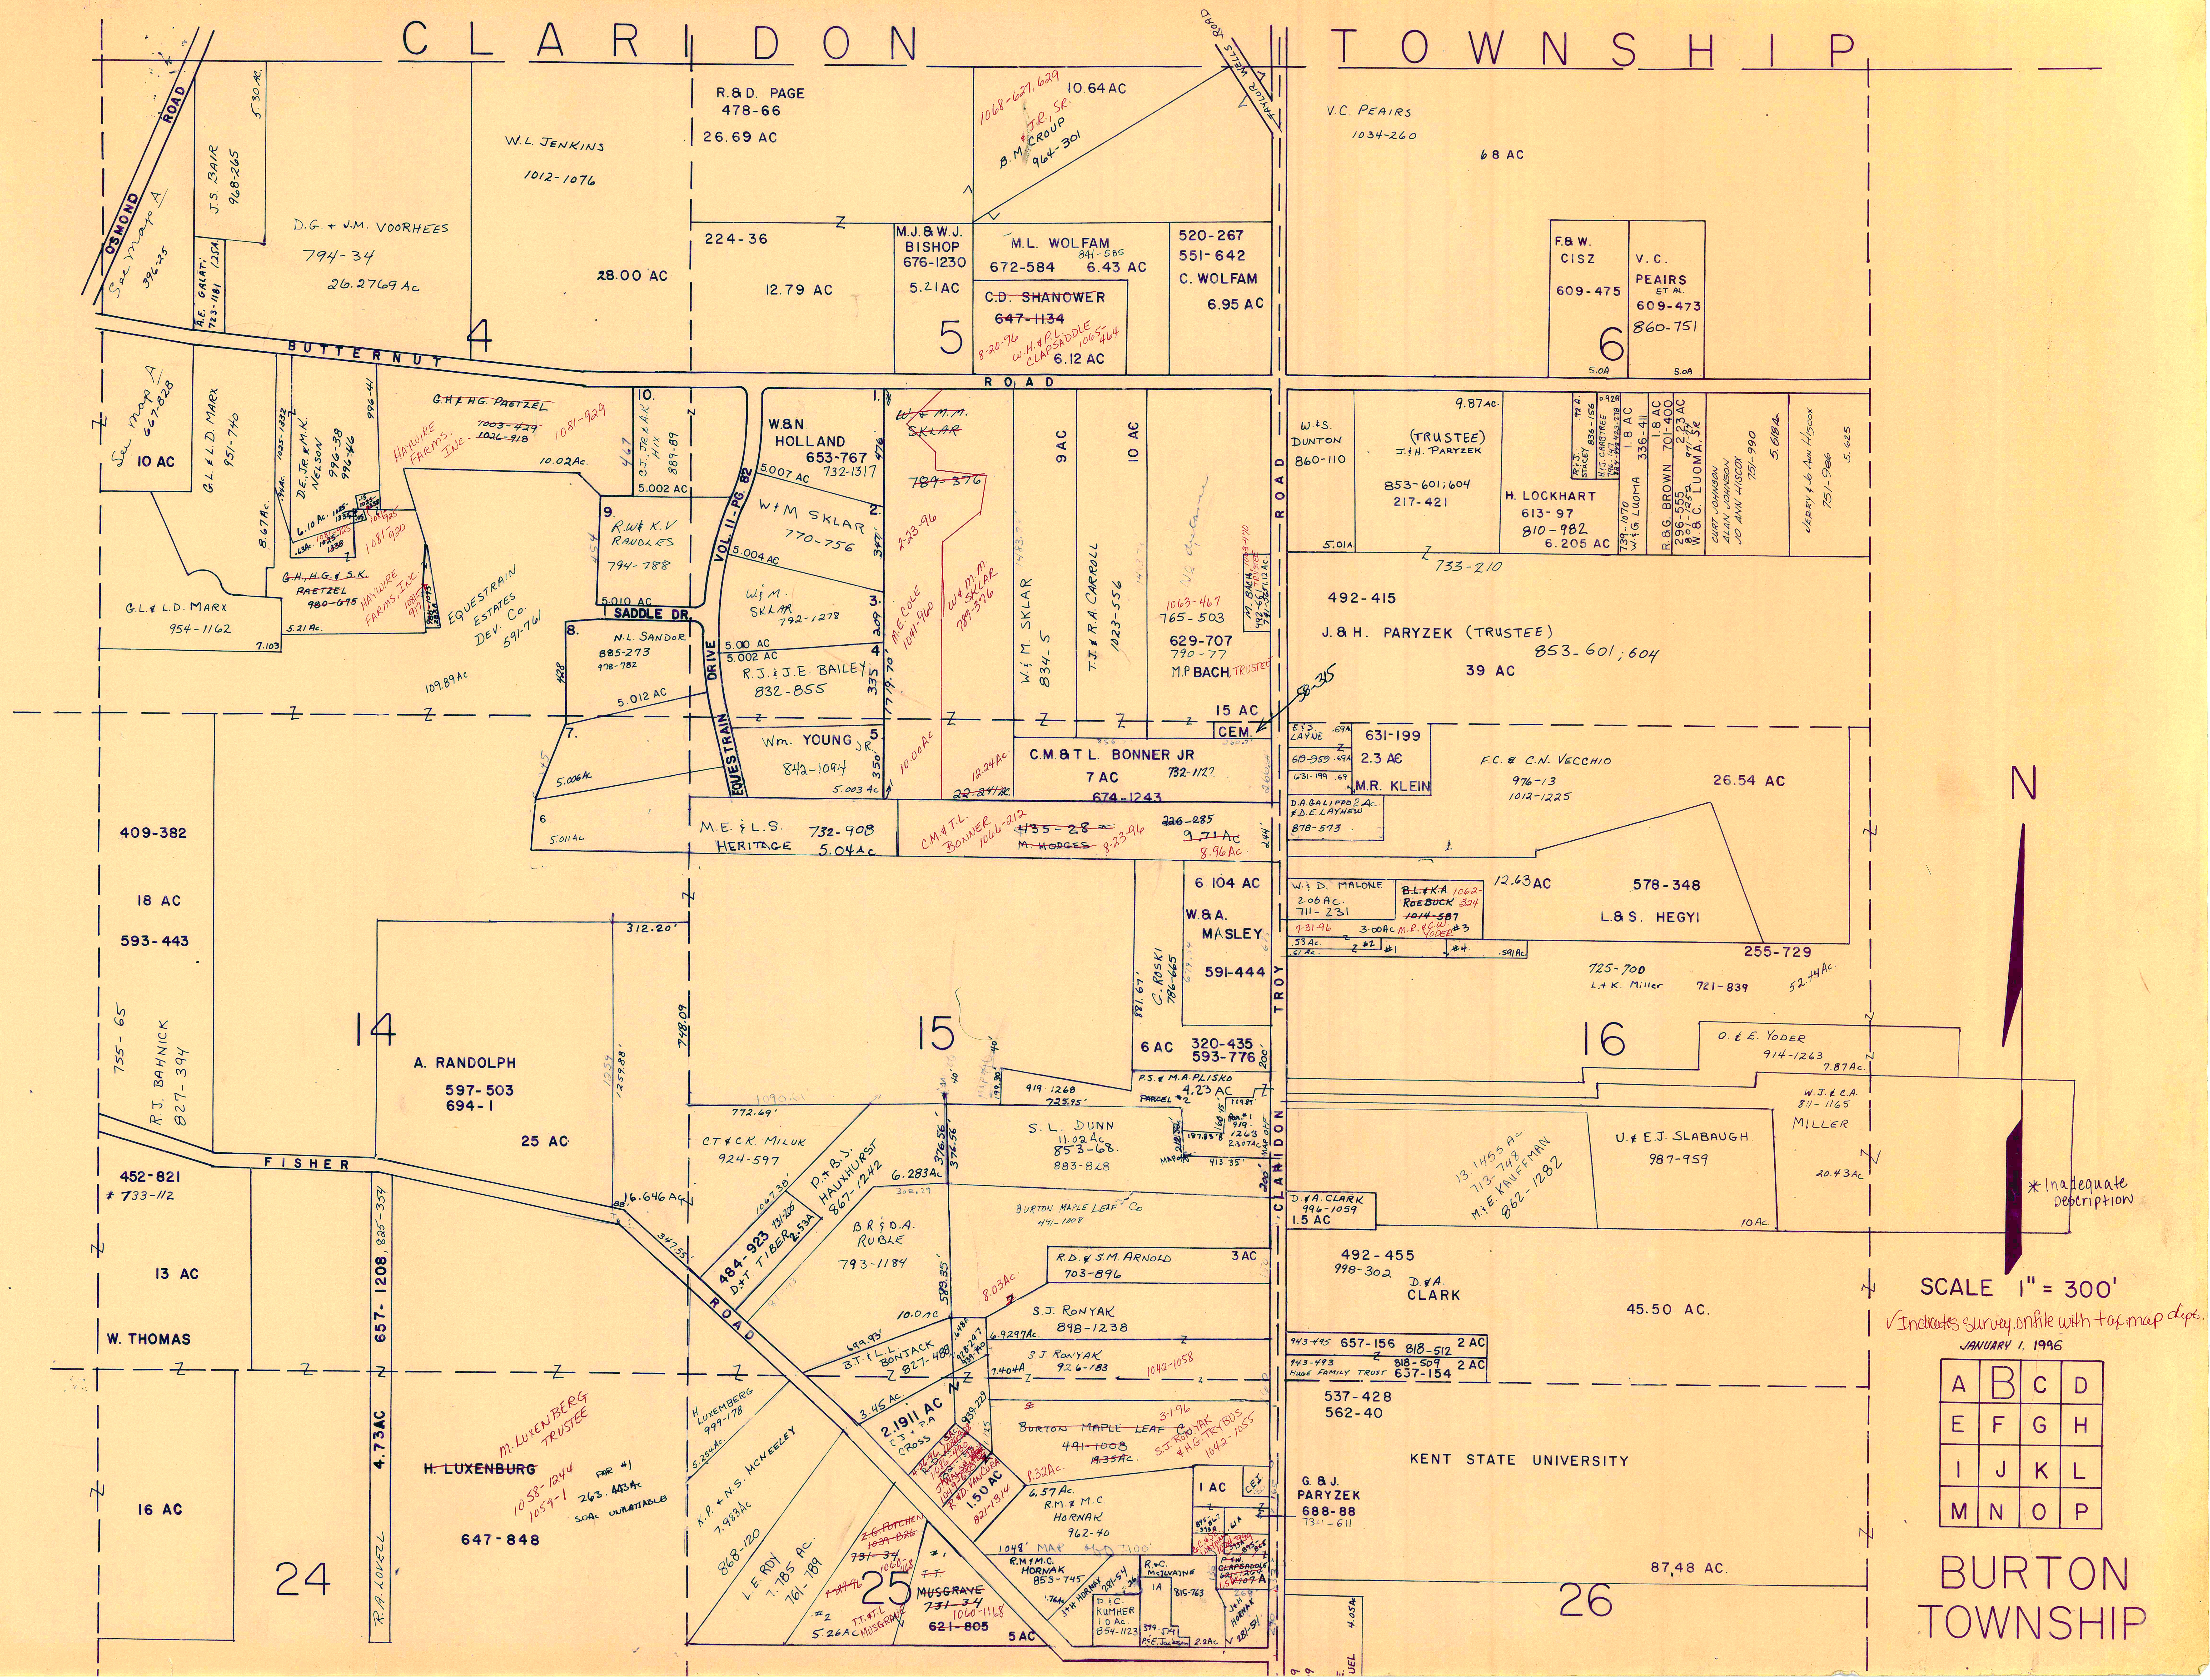
CLARIDON TOWNSHIP
OSMOND ROAD
See map A
J.S. BAIR 968-265
5.30 Ac
R.E. GALATI 723-1181 1.25A
D.G. & J.M. VOORHEES 794-34 26.2769 Ac
W.L. JENKINS 1012-1076
28.00 AC
4
R.&D. PAGE 478-66 26.69 AC
224-36 12.79 AC
M.J.&W.J. BISHOP 676-1230 5.21 AC
5
M.L. WOLFAM 841-585 672-584 6.43 AC
C.D. SHANOWER ~~647-1134~~
8-20-96 W.H.&P.L. CLAPSADDLE 1065-464
6.12 AC
520-267 551-642 C. WOLFAM 6.95 AC
10.64 AC
1068-627,629 B.M. CROUP J.R. SR. 964-301
TAYLOR WELLS ROAD
V.C. PEAIRS 1034-260 68 AC
F&W. CISZ 609-475
V.C. PEAIRS ET AL 609-473 860-751
6
BUTTERNUT ROAD
See map A 647-828
10 AC
G.L.& L.D. MARX 951-740
D.E.JR.& M.K. NELSON 996-38 996-46
HAYWIRE FARMS, INC.
G.H.& H.G. PAETZEL ~~1003-429~~ 1026-918 1081-929
10.02Ac.
C.J. ZELAK HIX 889-89
W.&N. HOLLAND 653-767 732-1317
5.007 AC
5.002 AC
W.&M. SKLAR 770-756
VOL. 11-PG. 82
R.W.& K.V. RANDLES 794-788
5.010 AC
SADDLE DR.
G.H., H.G.& S.K. PAETZEL 980-675
EQUESTRAIN ESTATES DEV. CO. 591-761
G.L.& L.D. MARX 954-1162
5.21 Ac.
109.89 Ac
N.L. SANDOR 885-273 978-782
5.012 AC
W.& M. SKLAR 792-1278
5.00 AC
5.002 AC
R.J.& J.E. BAILEY 832-855
Wm. YOUNG JR. 842-1094
5.003 Ac.
5.006 Ac
5.011 Ac
EQUESTRAIN DRIVE
~~W.& M.M. SKLAR~~ ~~789-376~~
2-23-96
M.E. COLE 1041-960
W.& M.M. SKLAR 789-376
W.& M. SKLAR 834-5
9 AC
T.J.& R.A. CARROLL 1023-556
10 AC
1063-467 765-503 629-707 790-77 M.P. BACH, TRUSTEE
15 AC
CEM
C.M.& T.L. BONNER JR 7 AC 732-1127 674-1243
12.24 Ac.
10.00 Ac.
M.E.& L.S. HERITAGE 732-908 5.04 Ac.
C.M.& T.L. BONNER 1066-212
~~435-28~~ ~~M. HODGES~~ 8-23-96
~~226-285~~ ~~9.71 Ac~~ 8.96 Ac.
W.& S. DUNTON 860-110
(TRUSTEE) J.&H. PARYZEK 853-601;604 217-421
9.87 Ac.
H. LOCKHART 613-97 810-982 6.205 AC
R.&G. BROWN 296-555
W.& C. LUOMA
CURT JOHNSON ALAN JOHNSON JO ANN HISCOX 751-990
JERRY & JO ANN HISCOX 751-966
733-210
492-415
J.& H. PARYZEK (TRUSTEE) 853-601; 604 39 AC
631-199 2.3 AC
M.R. KLEIN
F.C.& C.N. VECCHIO 976-13 1012-1225
26.54 AC
D.A. GALIPPO & F.D. CLAYNEW 878-573
N
W.& D. MALONE 2.06 Ac. 711-231
B.L.& K.A. ROEBUCK 1062-324
12.63 AC
578-348 L.&S. HEGYI
255-729
725-700 L.& K. Miller 721-839 52.44 Ac.
16
O.& E. YODER 914-1263 7.87 Ac.
W.J.& C.A. MILLER 811-1165 20.43 Ac.
U.& E.J. SLABAUGH 987-959
13.1455 Ac 713-748 M.& E. KAUFFMAN 862-1282
*Inadequate Description
10 Ac
6.104 AC
W.&A. MASLEY 591-444
C. ROSKI 796-665
6 AC 320-435 593-776
TROY ROAD
CLARIDON ROAD
409-382 18 AC 593-443
755-65 R.J. BAHNICK 827-394
14
A. RANDOLPH 597-503 694-1 25 AC
312.20'
15
P.S.& M.A. PLISKO 4.23 AC
S.L. DUNN 11.02 Ac. 853-68 883-828
C.T.& C.K. MILUK 924-597
P.& B.J. HAUNHURST 867-1242
6.283 Ac.
B.R.& D.A. RUBLE 793-1184
BURTON MAPLE LEAF CO 441-1008
R.D.& S.M. ARNOLD 703-896
3 AC
D.& A. CLARK 996-1059 1.5 AC
492-455 998-302 D.&A. CLARK
45.50 AC.
FISHER ROAD
452-821 #733-112
16.646 Ac
484-923 D.&T. TIBER 2.53A
13 AC
W. THOMAS
657-1208
S.J. RONYAK 898-1238
S.J. RONYAK 926-183 1042-1058
B.T.& L.L. BONJACK 827-488
10.0 Ac
8.03 Ac.
C.J.& P.A. CROSS 2.1911 AC
1.50 AC 821-1314
BURTON ~~MAPLE LEAF CO~~ ~~491-1008~~ 3-1-96 S.J. RONYAK & H.G. TRYBUS 1042-1055
943-495 657-156 818-512 2 AC
943-493 HUGE FAMILY TRUST 818-509 637-154 2 AC
537-428 562-40
KENT STATE UNIVERSITY
M. LUXENBERG TRUSTEE 1058-1244 1059-1 263-443 Ac SOIL UNSUITABLE
H. LUXENBURG 647-848
H. LUXENBERG 999-178
K.P.& N.S. MCNEELEY 7.983Ac. 868-120
L.E. ROY 7.785 Ac. 761-189
4.73AC
R.A. LOVELL
16 AC
24
25
~~MUSGRAVE~~ ~~731-34~~ 1060-1168 621-805
5 AC
5.26 Ac
6.57 Ac. R.M.& M.C. HORNAK 962-40
R.M.& M.C. HORNAK 853-745
R.& C. MCILVAINE 815-763
D.C. KUMHER 1.0 Ac 854-1123
1 AC
CEM
G.& J. PARYZEK 688-88 731-611
87.48 AC.
26

SCALE 1" = 300'

√ Indicates survey on file with tax map dept.

JANUARY 1, 1996

A	B	C	D
E	F	G	H
I	J	K	L
M	N	O	P

BURTON TOWNSHIP

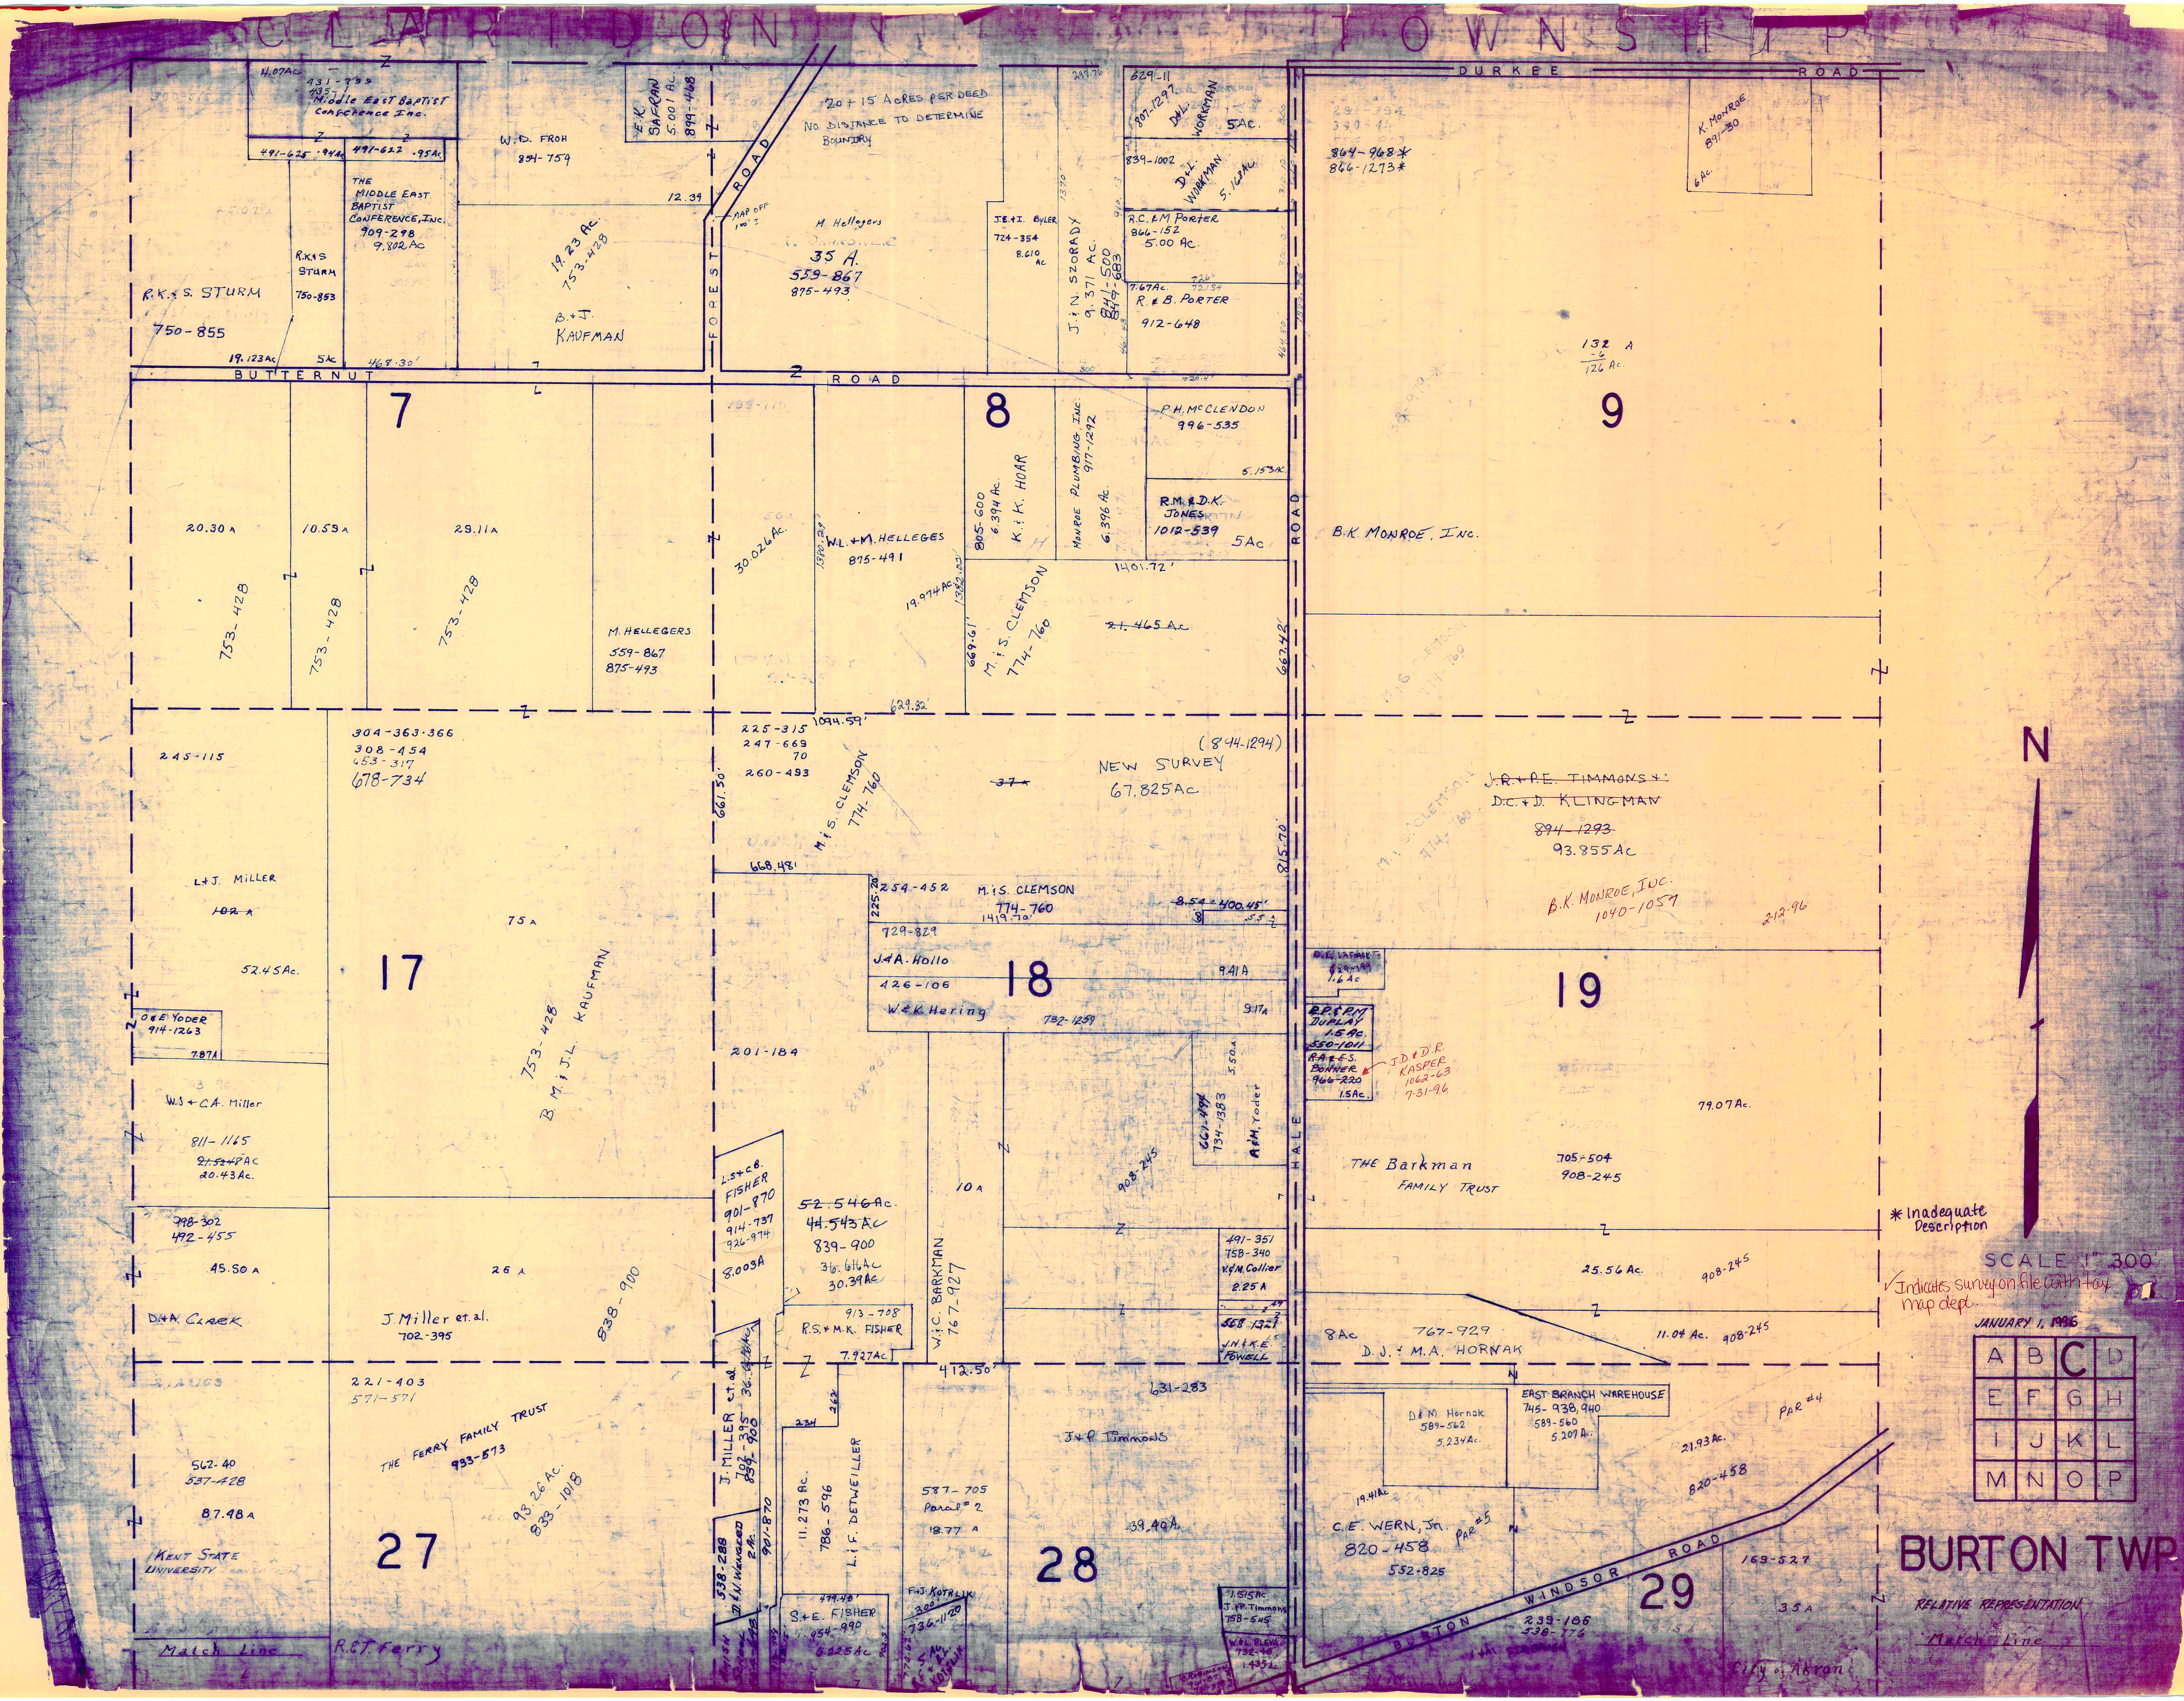
CLARIDON TOWNSHIP
DURKEE ROAD
BUTTERNUT ROAD
FOREST ROAD
HALE ROAD
BURTON WINDSOR ROAD
7
8
9
17
18
19
27
28
29
4.07 Ac
Middle East Baptist Conference Inc.
491-625 .94 Ac
491-622 .95 Ac
THE MIDDLE EAST BAPTIST CONFERENCE, INC.
909-298
9.802 Ac
R.K.&S. STURM
750-853
R.K.&S. STURM
750-855
19.123 Ac
5Ac
468.30'
W.D. FROH
894-759
E.K. SAFRAN
5.001 Ac
899-468
12.39
19.23 Ac.
753-428
B.&J. KAUFMAN
20+15 ACRES PER DEED
NO DISTANCE TO DETERMINE BOUNDRY
M. Hellegers
35 A.
559-867
875-493
J.E.&I. Byler
724-354
8.610 Ac
J.&N. SZORADY
9.371 Ac.
841-500
849-683
629-11
807-1297
D.L. WORKMAN
5Ac.
839-1002
D.L. WORKMAN
5.16 Ac
R.C.&M. Porter
866-152
5.00 Ac.
7.67 Ac
R.&B. PORTER
912-648
864-968*
866-1273*
K. MONROE
891-30
6Ac.
132 A
126 Ac
P.H. McCLENDON
996-535
5.153Ac
R.M.&D.K. JONES
1012-539
5Ac
B.K. MONROE, Inc.
20.30 A
10.59 A
29.11 A
753-428
753-428
753-428
M. HELLEGERS
559-867
875-493
30.026 Ac.
W.L.+M. HELLEGES
875-491
19.974 Ac.
805-600
6.394 Ac.
K.&K. HOAR
MONROE PLUMBING INC.
917-1292
6.396 Ac
M.&S. CLEMSON
774-760
1401.72'
~~21.465 Ac~~
1094.59'
629.32'
664.61'
664.42'
304-363-366
308-454
653-317
678-734
245-115
225-315
247-669
70
260-493
M.&S. CLEMSON
774-760
(844-1294)
NEW SURVEY
67.825 Ac.
~~37~~
~~J.R.+P.E. TIMMONS~~
~~D.C.+D. KLINGMAN~~
~~894-1293~~
93.855Ac
B.K. MONROE, INC.
1040-1057
2-12-96
L+J. MILLER
~~102 A~~
52.45Ac.
75 A
753-428
B.M.&J.L. KAUFMAN
661.50'
668.48'
254-452
225-20
M.&S. CLEMSON
774-760
1419.70'
8.54 400.45'
729-829
J.&A. Hollo
426-106
W.&K. Hering
732-1259
9.41A
9.17A
D.E. LaFave
1.6Ac
R.P.&P.M. DUPLAY
1.5Ac.
550-1011
R.A.&E.S. BONNER
966-220
1.5Ac.
J.D.&D.R. KASPER
1062-63
7-31-96
O.&E. YODER
914-1263
7.87A
W.J.+C.A. Miller
811-1165
~~21.524~~ AC
20.43Ac.
201-184
3.50A
661-494
734-1383
A.&M. Yoder
908-245
10 A
79.07Ac.
THE Barkman FAMILY TRUST
705-504
908-245
L.S.+C.B. FISHER
901-870
914-737
926-974
8.003A
~~52.546Ac.~~
~~44.543Ac~~
839-900
~~36.616Ac~~
30.39Ac
298-302
492-455
45.50 A
26 A
838-900
D.&A. CLARK
J Miller et.al.
702-395
913-708
R.S.+M.K. FISHER
7.927Ac
W.&C. BARKMAN
767-927
491-351
758-340
V.&M. Collier
2.25A
568-1321
J.N.&K.E. Powell
25.56 Ac.
908-245
11.04 Ac.
908-245
8Ac
767-929
D.J.&M.A. HORNAK
412.50'
631-283
221-403
571-571
THE FERRY FAMILY TRUST
933-573
93.26 Ac.
833-1018
562-40
537-428
87.48 A
KENT STATE UNIVERSITY
J. MILLER et.al.
702-395
834-900
901-870
538-288
D.&N. WANGLER
11.273 Ac.
786-596
L.I.F. DETWEILLER
587-705
Parcel # 2
18.77 A
J.&P. Timmons
39.40A
S.&E. FISHER
954-990
F.&J. KOTNIK
736-1120
J.P. Timmons
758-545
EAST BRANCH WAREHOUSE
745-938,940
589-560
5.207Ac.
D.&M. Hornak
589-562
5.234Ac.
19.41Ac.
C.E. WERN, Jr.
820-458
552-825
PAR #5
PAR #4
21.93Ac.
820-458
239-186
538-776
169-527
35A
City of Akron
Match Line
R.C.T. Ferry
N

*Inadequate Description

SCALE 1" 300'

✓ Indicates survey on file with tax map dept.

JANUARY 1, 1996

A	B	C	D
E	F	G	H
I	J	K	L
M	N	O	P

BURTON TWP.

RELATIVE REPRESENTATION

Match Line

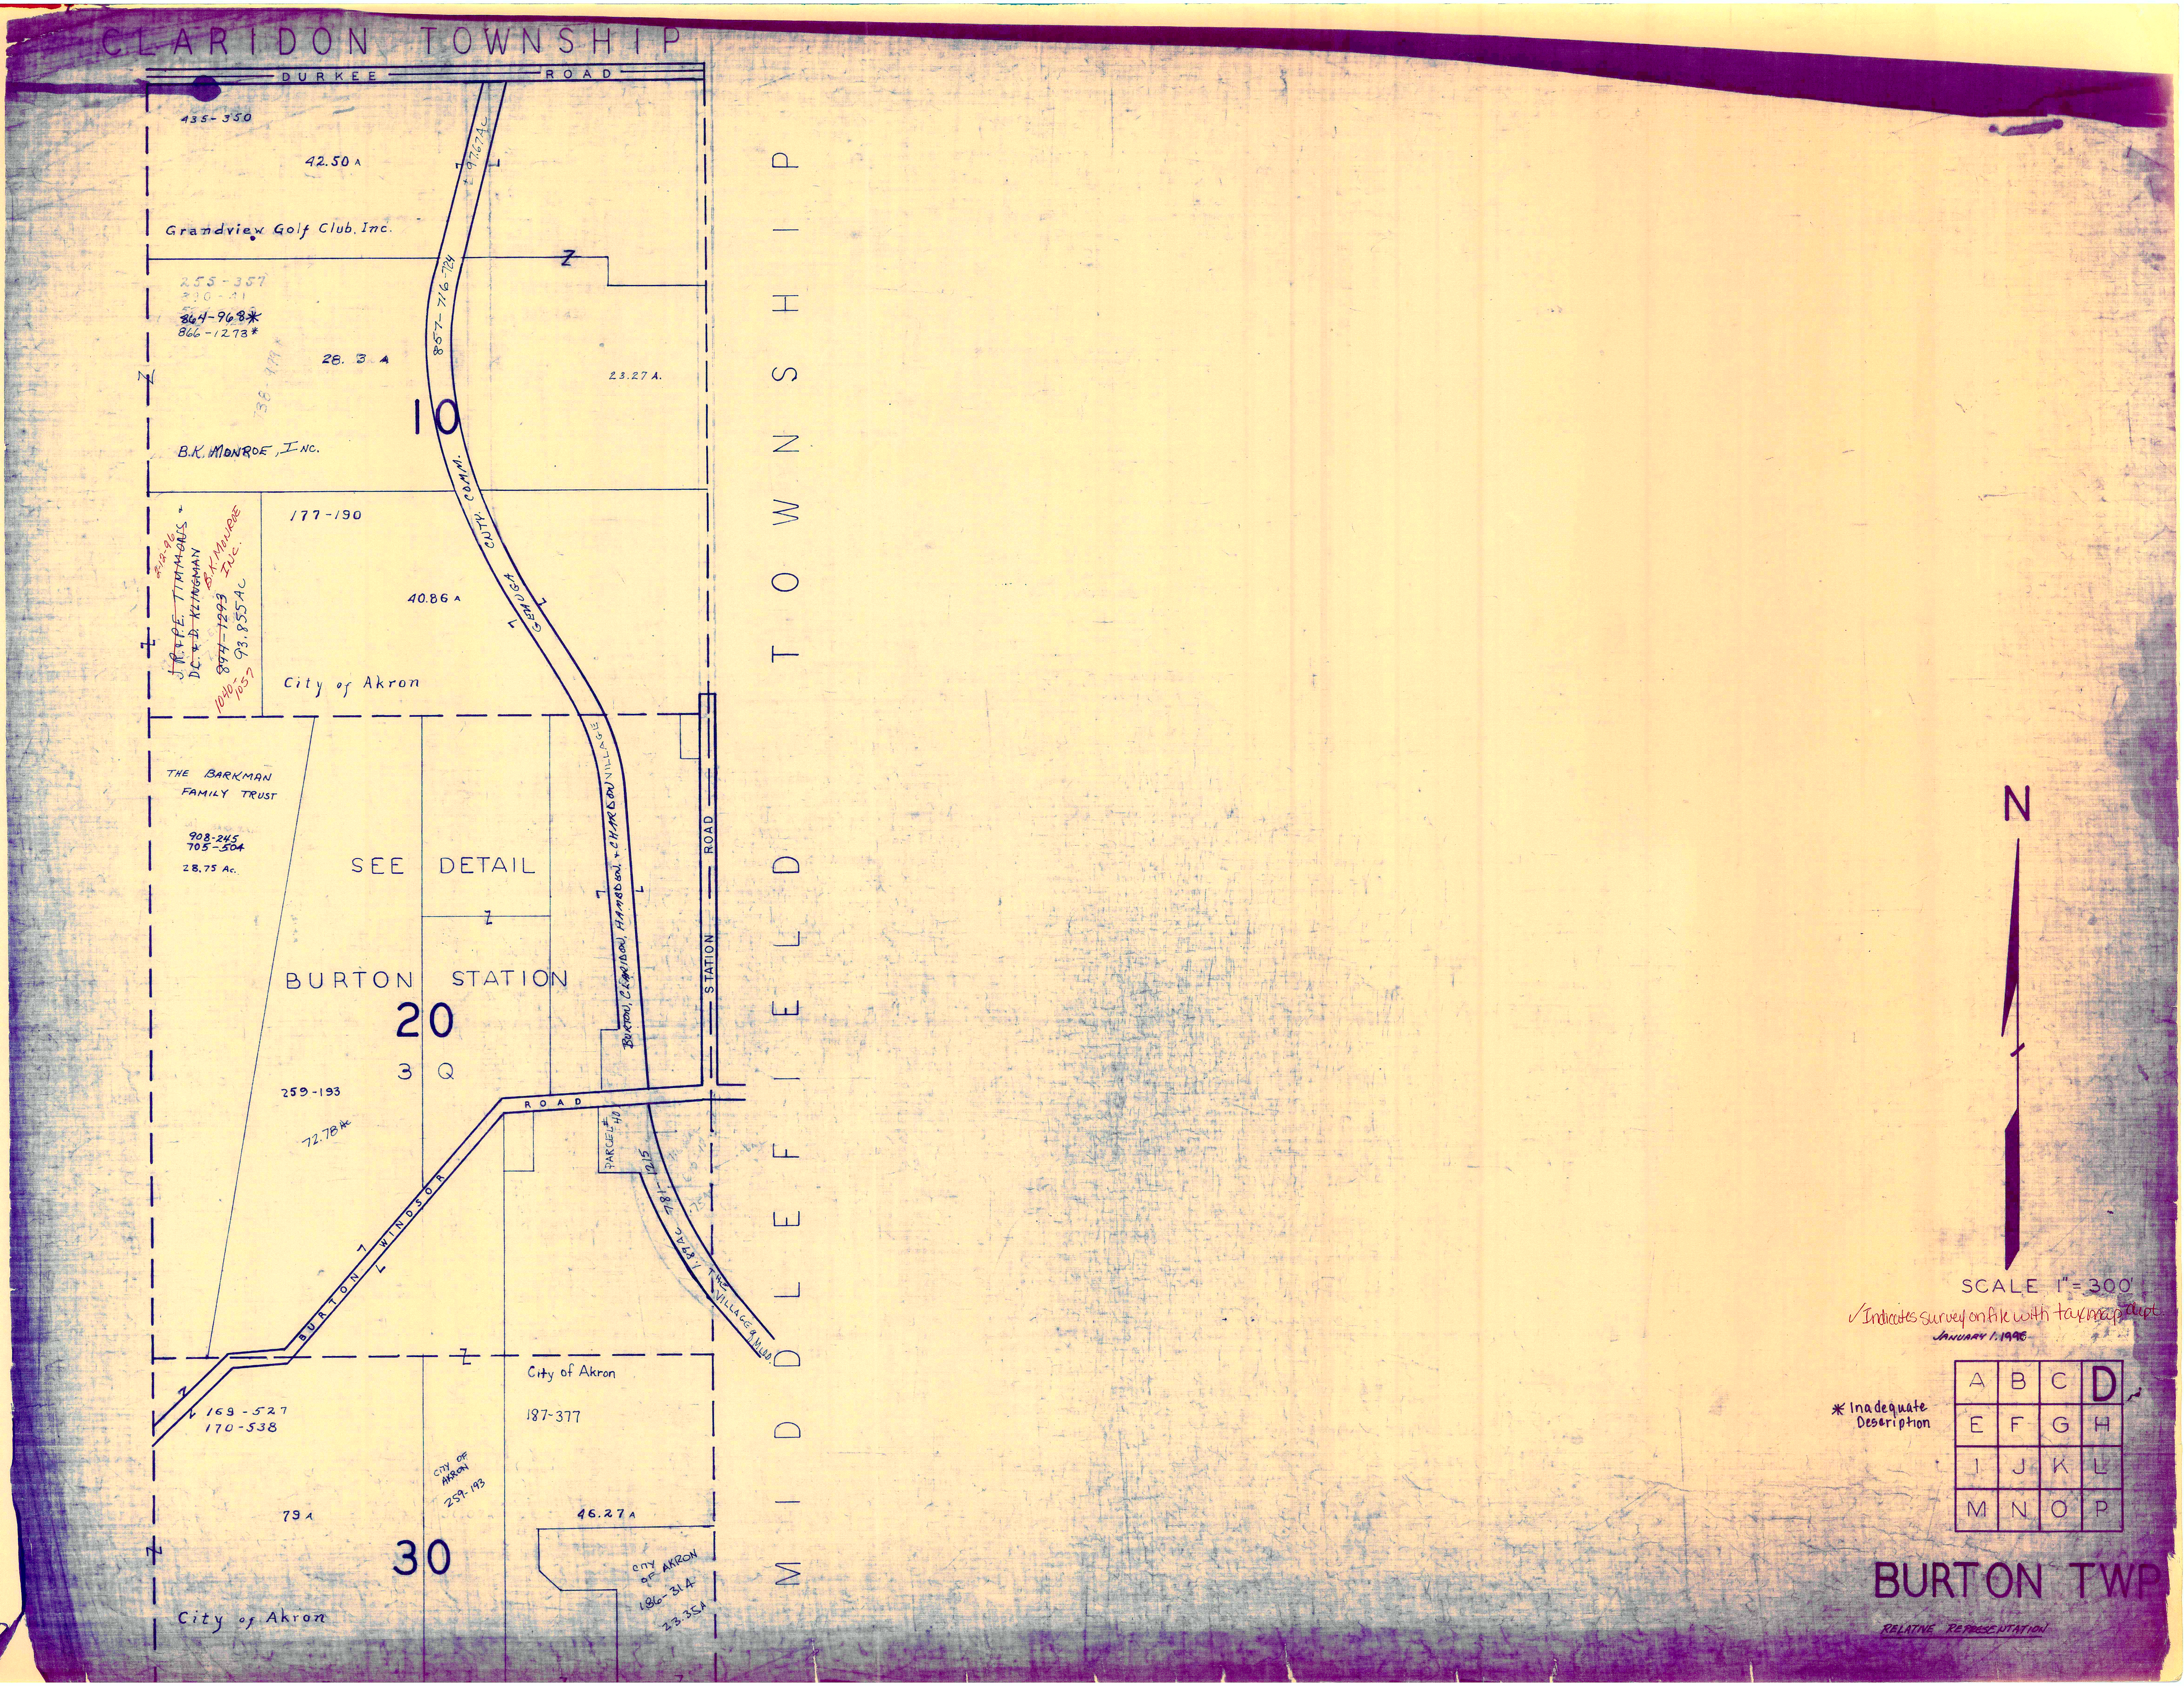
CLARIDON TOWNSHIP
DURKEE ROAD
435-350
42.50 A
±97.67 AC
Grandview Golf Club, Inc.
255-357
864-968*
866-1273*
28.3 A
857-716-724
23.27 A.
10
B.K. MONROE, INC.
177-190
~~J.R.+P.E. TIMMONS~~ +
~~DC.+D. KLINGMAN~~
2-12-96
B.K. MONROE INC.
~~894-1293~~
93.855AC
1040-1057
40.86 A
GEAUGA CNTY. COMM.
City of Akron
MIDDLEFIELD TOWNSHIP
THE BARKMAN FAMILY TRUST
908-245
705-504
28.75 Ac.
SEE DETAIL
BURTON STATION
20
3 Q
BURTON, CLARIDON, HAMBDEN, + CHARDON VILLAGE
STATION ROAD
259-193
72.78 Ac
ROAD
PARCEL # 40
781-1215
1.87 AC
THE VILLAGE of MIDD.
BURTON WINDSOR
169-527
170-538
City of Akron
187-377
CITY OF AKRON
259-193
79 A
46.27 A
30
CITY OF AKRON
186-314
23.35A
City of Akron
N
SCALE 1"=300'
✓Indicates survey on file with tax map dept.
JANUARY 1, 1996
* Inadequate Description
A B C D
E F G H
I J K L
M N O P
BURTON TWP
RELATIVE REPRESENTATION

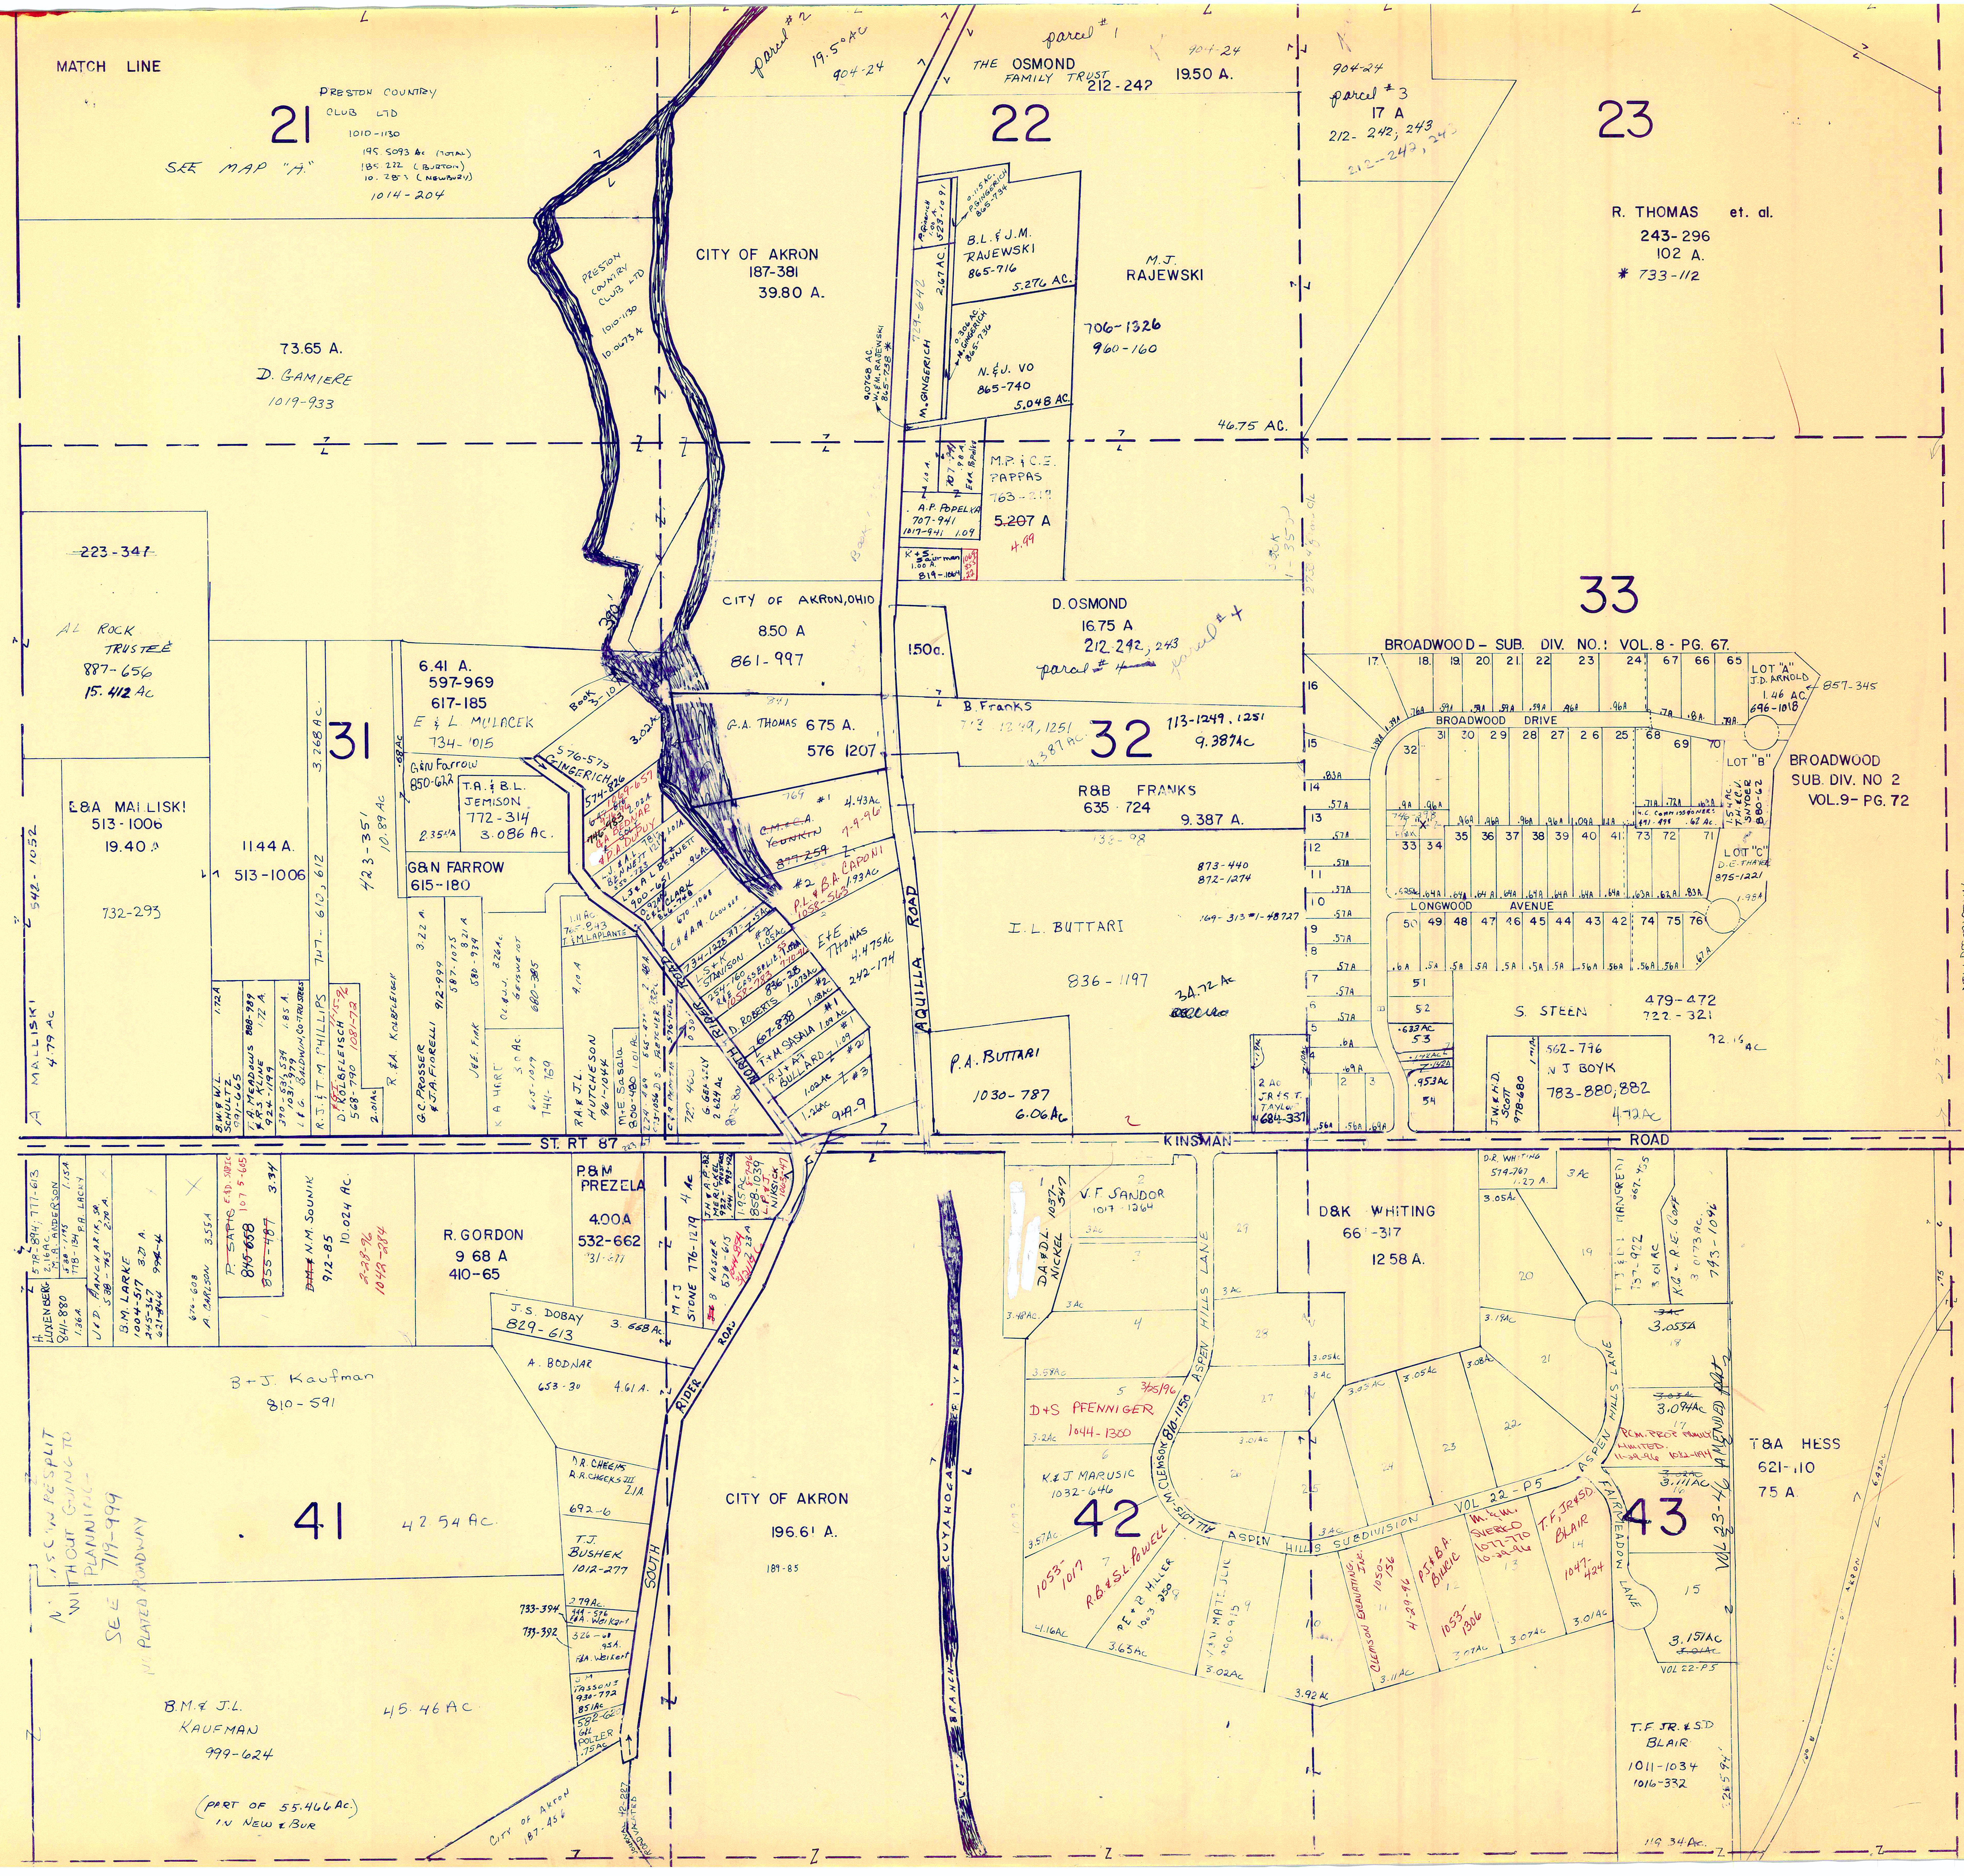
MATCH LINE
21
PRESTON COUNTRY CLUB LTD
1010-1130
195.5093 Ac (TOTAL)
185.222 (BURTON)
10.287 (NEWBURY)
SEE MAP "A"
1014-204
73.65 A.
D. GAMIERE
1019-933
parcel #2
19.5 AC
904-24
PRESTON COUNTRY CLUB LTD
CITY OF AKRON
187-381
39.80 A.
22
THE OSMOND FAMILY TRUST
212-242
19.50 A.
parcel #1
904-24
B.L. & J.M. RAJEWSKI
865-716
5.276 AC.
M.J. RAJEWSKI
706-1326
960-160
N. & J. VO
865-740
5.048 AC
M. GINGERICH
46.75 AC.
904-24
parcel #3
17 A
212-242, 243
23
R. THOMAS et. al.
243-296
102 A.
* 733-112
223-341
AL ROCK TRUSTEE
887-656
15.412 Ac
31
E&A MAILISKI
513-1006
19.40
1144 A.
513-1006
732-293
6.41 A.
597-969
617-185
E & L MULACEK
734-1015
G&N Farrow
850-622
T.A. & B.L. JEMISON
772-314
3.086 AC.
G&N FARROW
615-180
A. MALISKI
4.79 AC
542-1052
423-351
10.89 AC
GINGERICH
CITY OF AKRON, OHIO
850 A
861-997
G.A. THOMAS 6.75 A.
576-1207
M.P. & C.E. PAPPAS
763-219
5.207 A
A.P. POPELKA
707-941
D. OSMOND
16.75 A
212-242, 243
parcel #4
1.50 a.
B Franks
713-1249, 1251
32
713-1249, 1251
9.387 Ac
R&B FRANKS
635-724
9.387 A.
E&E Thomas
4.475 AC
242-174
P.L. & B.A. CAPONI
I.L. BUTTARI
836-1197
873-440
872-1274
AQUILLA ROAD
P.A. BUTTARI
1030-787
6.06 Ac
33
BROADWOOD - SUB. DIV. NO. 1 VOL. 8 - PG. 67.
BROADWOOD DRIVE
LOT "A"
J.D. ARNOLD
1.46 AC
696-1018
857-345
LOT "B"
BROADWOOD SUB. DIV. NO 2 VOL. 9 - PG. 72
LOT "C"
LONGWOOD AVENUE
S. STEEN
479-472
722-321
J.V. BOYK
783-880, 882
4.72 Ac
NEEDS A NEW DESCRIPTION FOR A .142 AC PARCEL
ST. RT 87
KINSMAN
ROAD
P&M PREZELA
4.00 A
532-662
R. GORDON
9.68 A
410-65
J.S. DOBAY
829-613
3.668 Ac
A. BODNAR
653-30
4.61 A.
B+J. Kaufman
810-591
41
42.54 Ac
N. 15 C.W. RESPLIT WITHOUT GOING TO PLANNING
SEE 719-999
NO PLATTED ROADWAY
B.M. & J.L. KAUFMAN
999-624
45.46 AC
(PART OF 55.466 Ac.) IN New & Bur
City of Akron
187-456
T.J. BUSHEK
1012-277
SOUTH RIDER ROAD
CITY OF AKRON
196.61 A.
189-85
CUYAHOGA RIVER
V.F. SANDOR
1017-1264
D.A. & D.L. NICKEL
D&K WHITING
661-317
12.58 A.
ASPEN HILLS LANE
D&S PFENNIGER
1044-1300
K & J MARUSIC
1032-646
42
R.B. & S.L. POWELL
ASPEN HILLS SUBDIVISION VOL 22 - P5
MEADOW LANE
43
T&A HESS
621-110
75 A
T.F. JR. & S.D. BLAIR
1011-1034
1016-332
VOL 22 - P5
3.151 AC
3.055A
119.34 Ac

BROADWOOD SUBDIVISION NUMBERS ONE & TWO

1	G.M. CIGANY 565-405	740-753	
2	M.W Dailey	894-892	
3	N.M. PAGE 910-714	865-131	
4	P.T. SODEE	531-1193	
5	D&B. MARIOLA	884-150	
6	~~B. KRESNYE~~ E.J. KUNZE ~~865-678~~	~~520-68~~	1073-569
7	W.M. SIMON & S.C. DELMORE	859-776	
8	R+P. Cook	822-1332	
9	L&A. BEEDLOW	558-1303	
10	W.&F. MINICK	470-78	
11	F&J. McBEIDE 732-598	469-780	
12	J&L. MYERS	667-511	
13	J.+L. Frajter	815-1119	
14	G&B FISH	678-190	
15	R&K HURD	665-1236	
16	H&D KLEVE	684-1255	
17	G&M STETTINO	665-510	
18	D&P BRAUNLICH		
19	D&M. CHARVAT, TRUSTEE 927-832	520-681	
20	R HOLLAND	926-1236	
21	C&I LILLY	550-1329	
22	M&M. LOVAS 772-1120	629-265	
23	R.A. + C.L JOHNSON	791-320	
24	G.G. & D.M. PODBOY	761-1281	
25	R.E + R.L GRUBER	951-1128	
26	M.J. & K.M. ALLISON	831-733	5-22-96
27	~~P.J. & B.A. BILICIC~~ R.G. & V.K. TIMMONS	~~857-809~~	1052-646
28	L.A. SWANEY	764-1283	
29	T.E. DAVIS & B.L. RUA	855-1034	
30	A.L. & D. COSTA	986-137	
32	J&J GONCZY	621-1258	
33	~~G.P. & J.D. PAWLAK~~ M.E. NYITRAY 5-20-96	~~977-413~~	1052-296
34	L.A. & S.B. SLATER, Jr. (-40') TRUSTEES 772-766	410-348	961-1007, 1007
35	K&E LOUMA 733-500	478-392	
36	H.J., III & D.M. MURPHY	1026-961	
37	J&B Kessinger	611-141	
38	J&M PAUL	542-4	
39	WILLIAM & PATRICIA DUTCHMAN	751-511	
40	R. EPPRECHT	538-263	
41	A&L GORRIS	528-818	
42	C.P. & L.T. CHEUNG 1043-439	906-666;	1047-211
43	C.A. DEWEESE	982-1029	
44	M+B. Pfiester	804-374	
45	R&D BUSBY	609-54	
46	~~D&B~~ O'Brien 12-2-96 1082-139	849-977	
47	A.V. Skupinski	695-379	
48	A&A HURLEY	565-660	
49	S. Steen	695-1381	
50	B.L. FELTON & D.M. BODA	864-1056	
51	J&M Stephens	807-1251	
52	P.E. & S.L. CARROLL	954-326	
53	T&S RING - .633Ac + .142Ac	621-573	
54	R.J. SCHWENDEMAN - .953A + .142Ac	576-34	
X	• ELEANOR FINKE	746-598	
65	J&G SUNDBERG	574-996	
66	~~D.R. & D.M. MOTZER~~ R.W. & L.M. SKOLARIS	~~881-230~~	1047-282
67	R.L. & C.A. LANDL	836-814	
68	J.+D. Riley	807-416	
69	D.E. & K.A. HOLUB	995-975	
70	M+S CHAPMAN	683-63	
71	D.A. & M.G. ZEIGLER	897-371	
72	T.A. WRIGHT 921-144	740-285	
73	D&J HIRSCH	706-695	
74	R&S SICIRIANO TRUST	542-819;	915-386
75	C.F., IV & D.L. BIXLER	891-1056	
76	F&B FONTANELLE	726-1398	
A	C. SMITH	631-631	
B	T.H. & C.V. SNYDER	880-62	
C	D.E. THAYER	875-1221	
31	C.M. Bosler	810-1275	

• BEING PART OF S'L,s-- 31, 32, 33, & 34.

*Inadequate Description

JANUARY 1, 1996

SCALE, 1" = 300'

✓ Indicates survey on file with tax map dept.

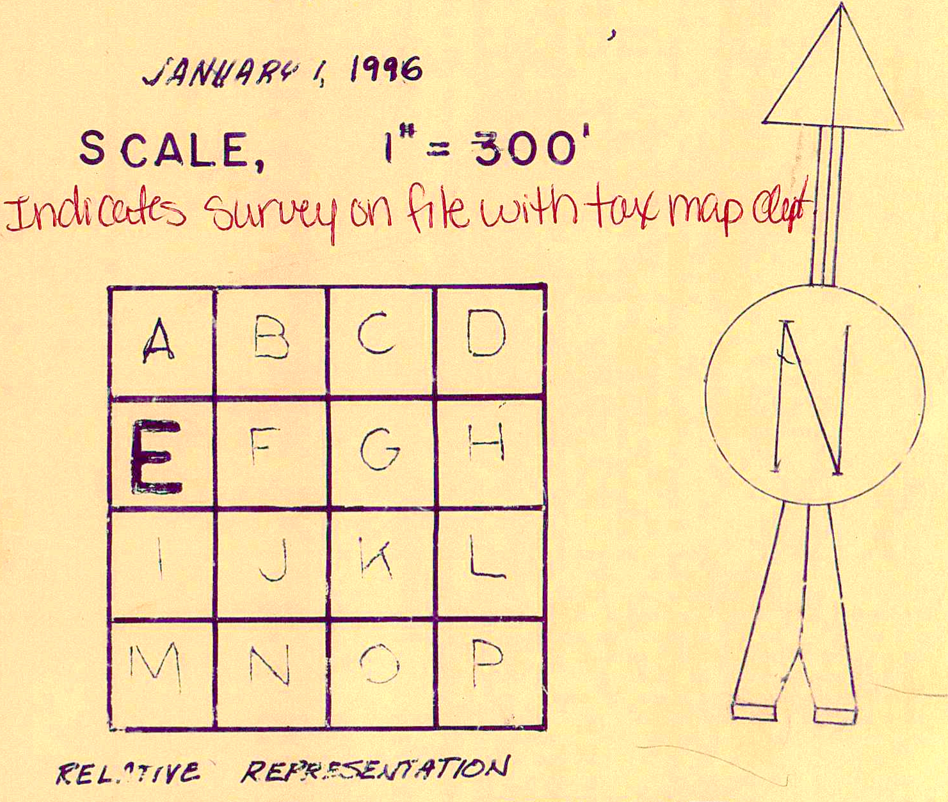
A
B
C
D
E
F
G
H
I
J
K
L
M
N
O
P
N

RELATIVE REPRESENTATION

BURTON TWP.

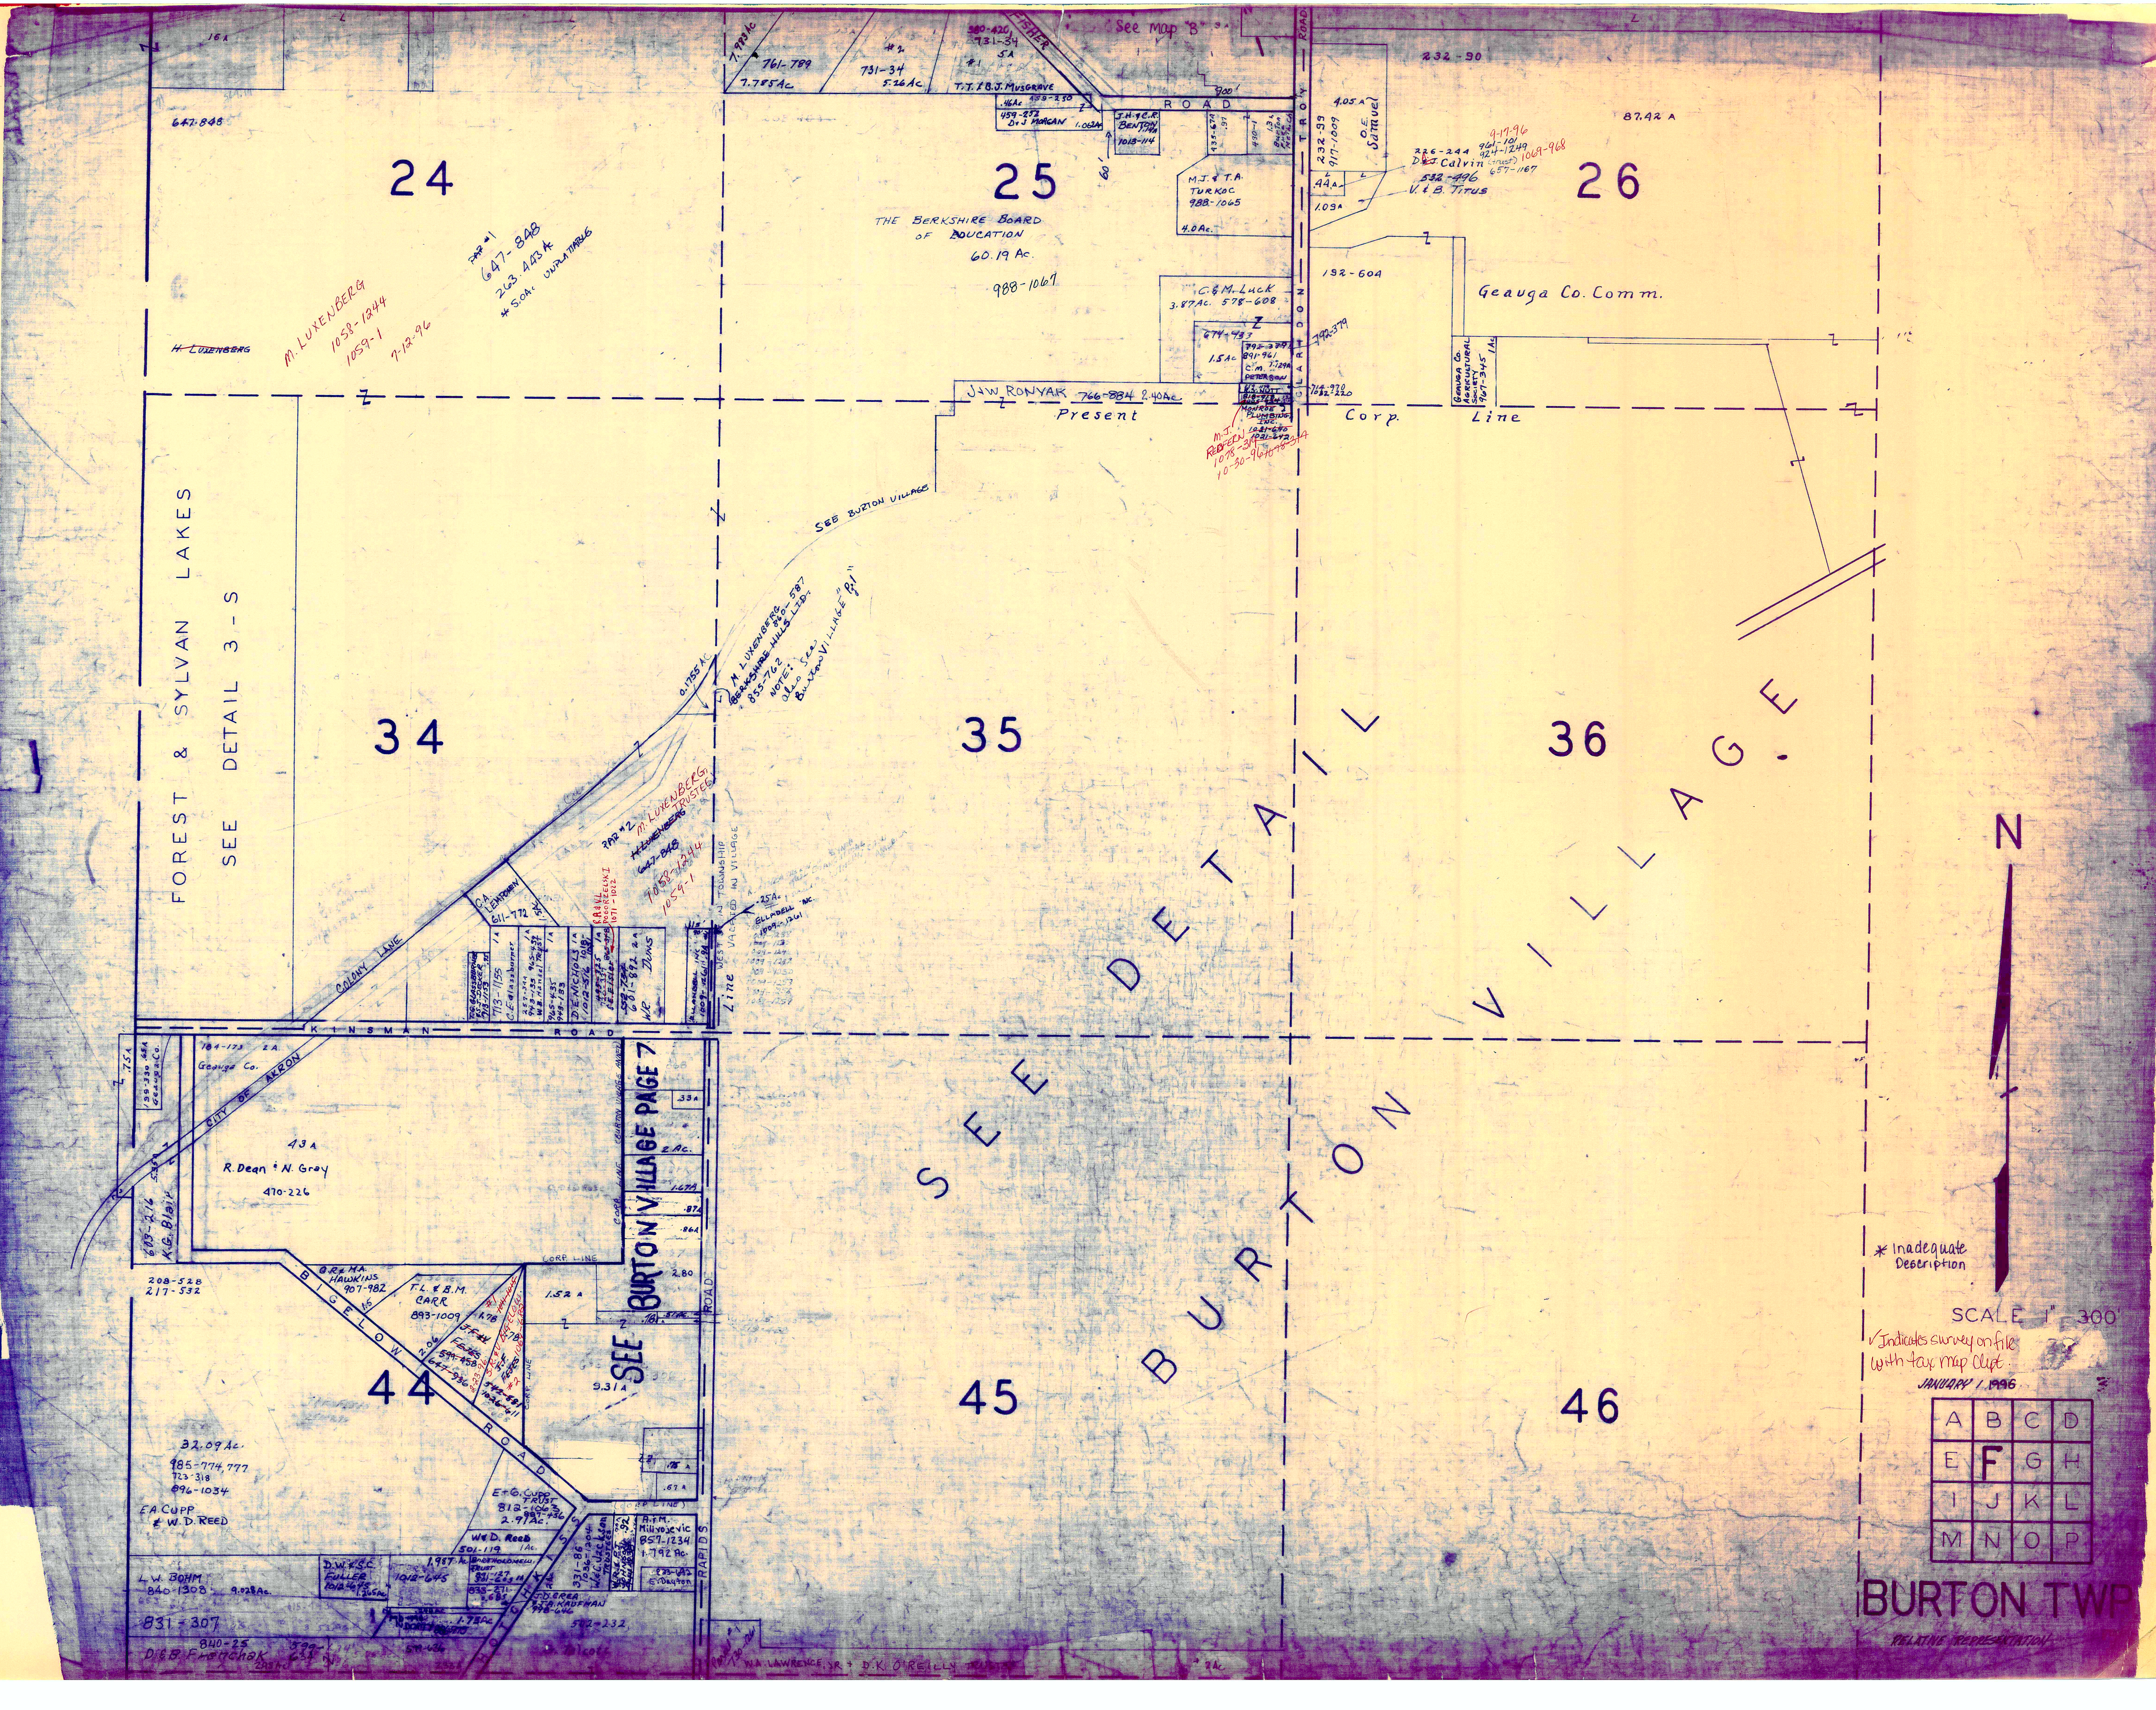
24
25
26
34
35
36
44
45
46
See Map "8"
TROY ROAD
ROAD
LARDON
647-848
7.785 Ac
761-789
731-34
5.26 Ac
T.T. & B.J. Musgrave
J.H. & C.R. Benton
M.J. & T.A. Turkoc
988-1065
4.0 Ac.
D.E. Samuel
232-90
87.42 A
D & J Calvin
V. & B. Titus
THE BERKSHIRE BOARD OF EDUCATION
60.19 Ac.
988-1067
C. & M. Luck
3.87 Ac. 578-608
192-60A
Geauga Co. Comm.
Geauga Co. Agricultural Society
M. LUXENBERG
1058-1244
1059-1
7-12-96
647-848
263.403 A
H. LUXENBERG
J. & W. RONYAK 766-884 2.40 Ac.
Present Corp. Line
SEE BURTON VILLAGE
FOREST & SYLVAN LAKES
SEE DETAIL 3-S
COLONY LINE
KINSMAN ROAD
CITY OF AKRON
Geauga Co.
R. Dean & N. Gray
470-226
43 A
SEE BURTON VILLAGE PAGE 7
CORP LINE
BIGELOW ROAD
T.L. & B.M. CARR
893-1009
HAWKINS
907-982
9.31 A
E.A. CUPP & W.D. REED
32.09 Ac.
985-774,777
896-1034
L.W. BOHM
840-1308
831-307
RAPIDS ROAD
SEE DETAIL BURTON VILLAGE
Township Line
N
* Inadequate Description
SCALE 1" = 300'
√ Indicates survey on file with tax map dept.
JANUARY 1, 1996
A B C D
E F G H
I J K L
M N O P
BURTON TWP.

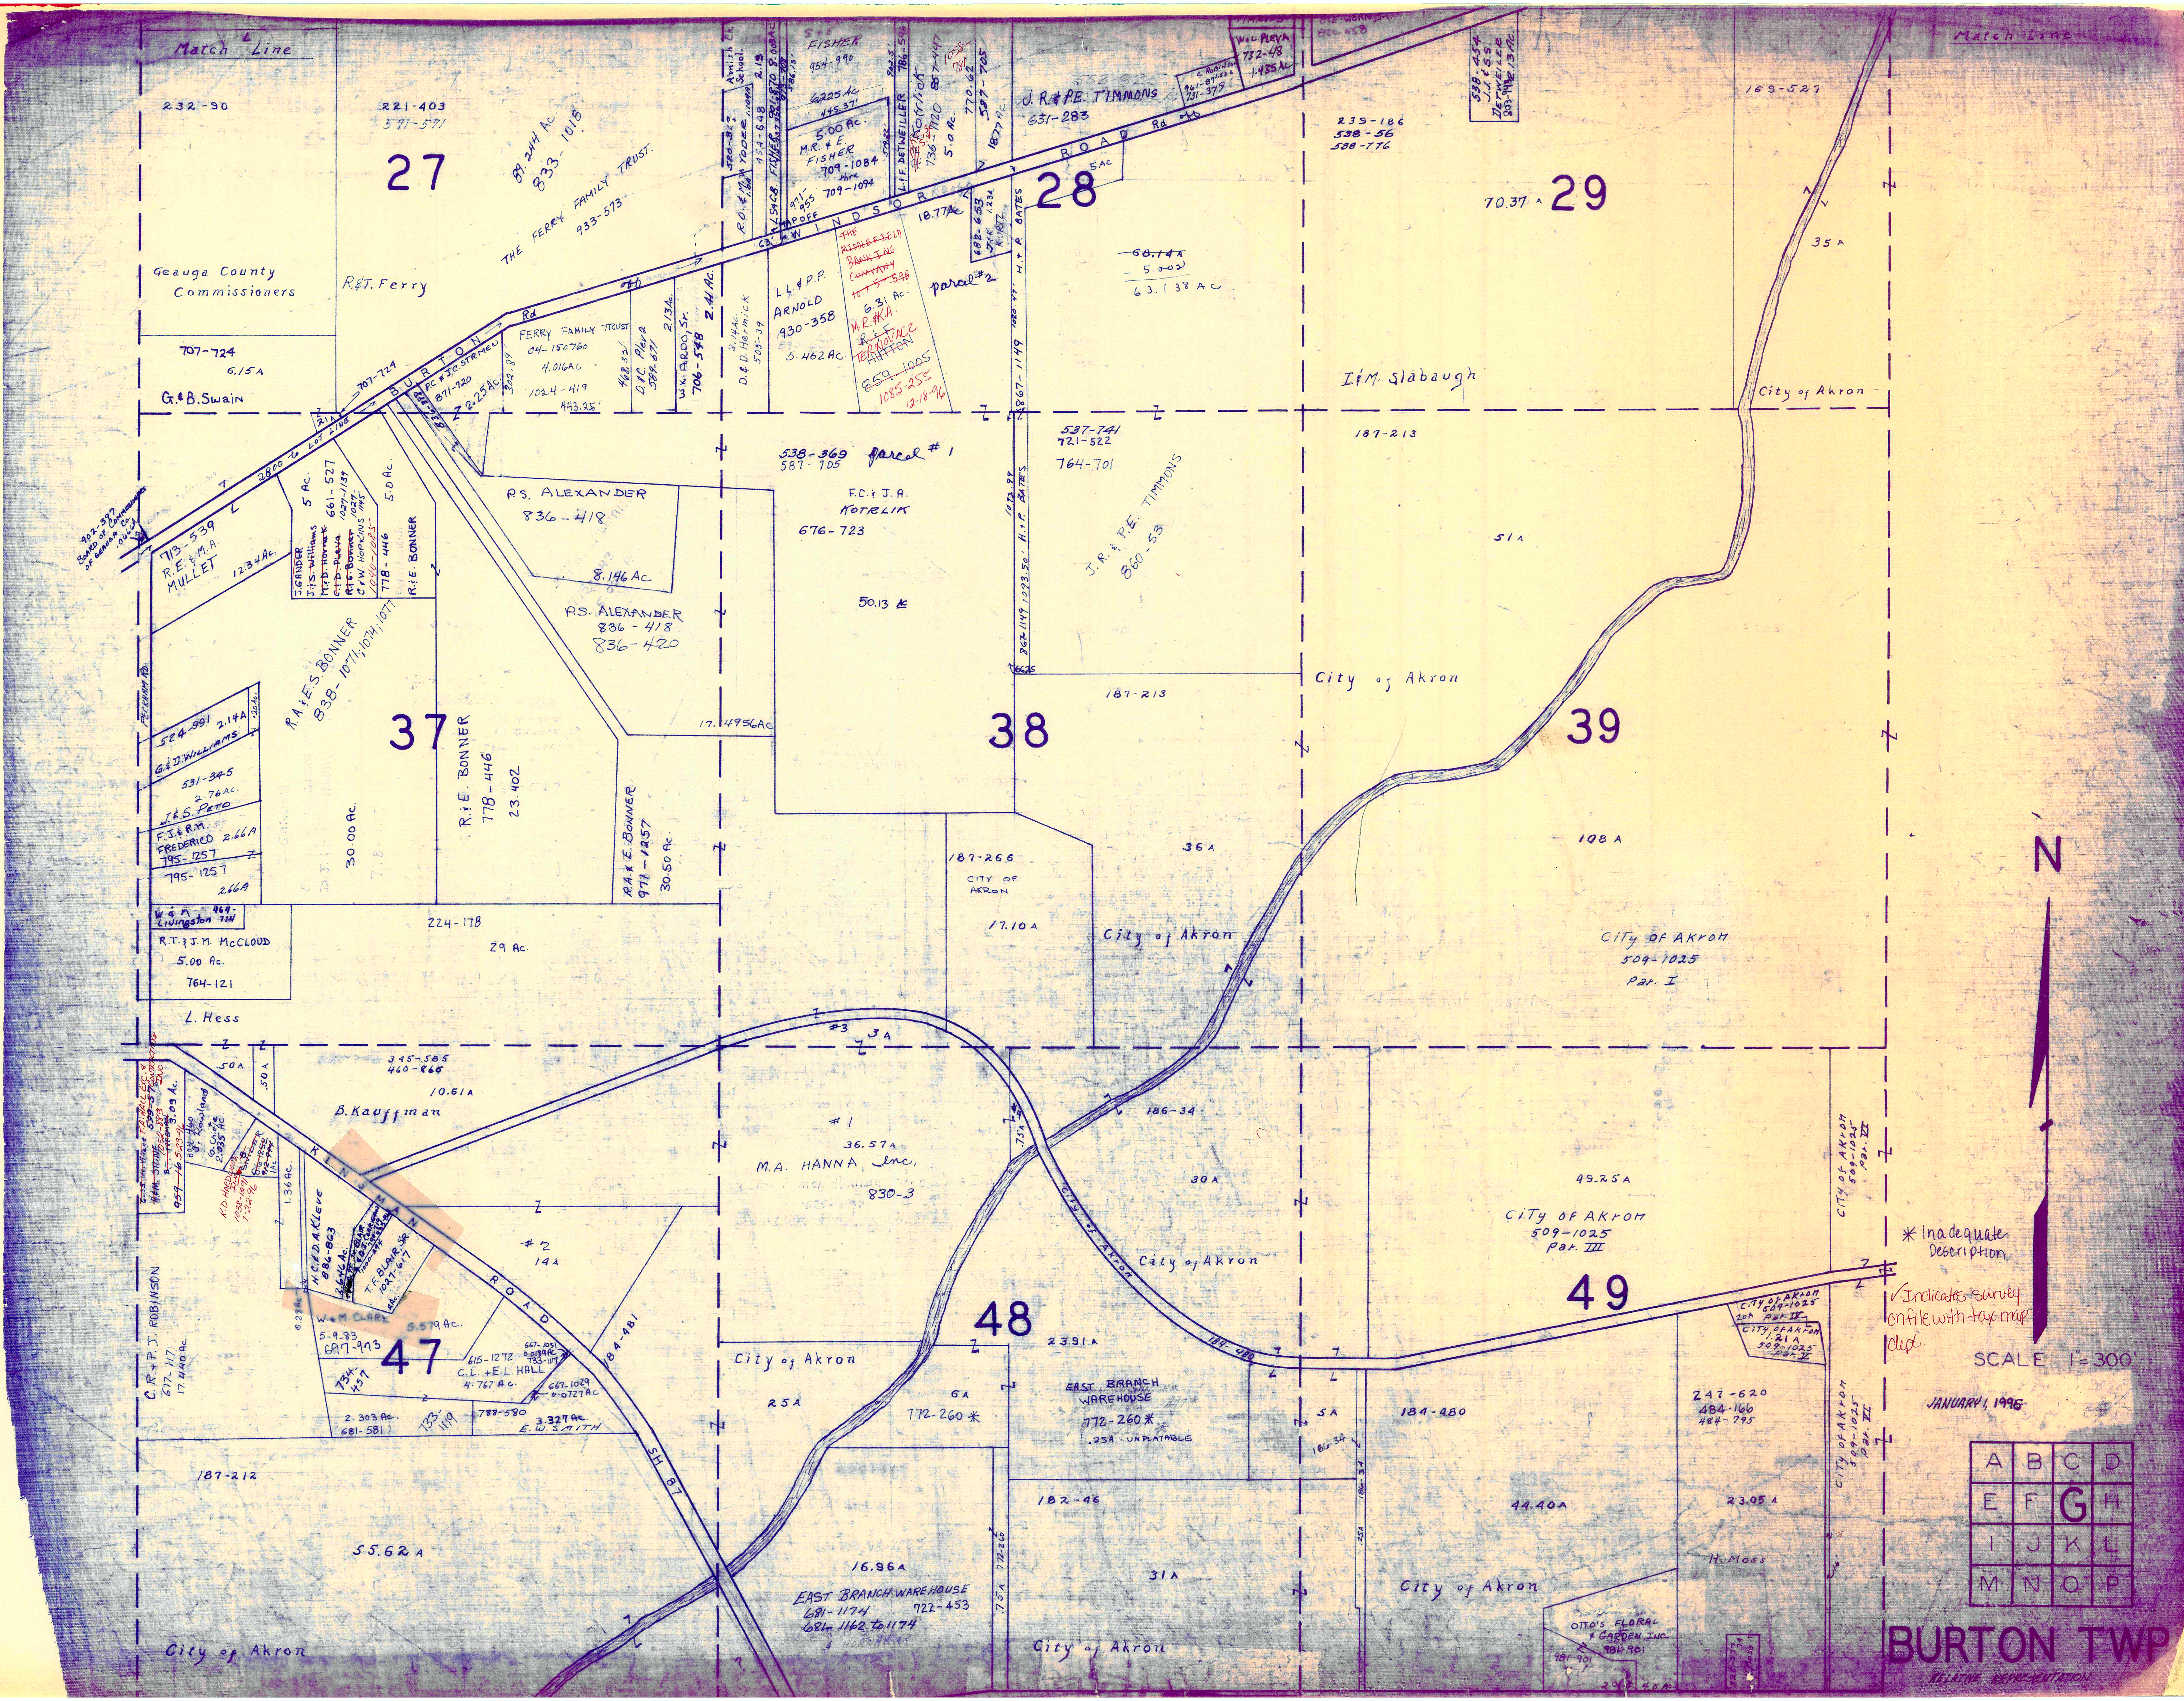
Match Line
Match Line
27
28
29
37
38
39
47
48
49
232-90
221-403
571-571
89.24H Ac.
833-1018
THE FERRY FAMILY TRUST
933-573
Geauga County Commissioners
R&T. Ferry
707-724
6.15A
G.&B. Swain
FISHER
954-990
M.R. & E. FISHER
709-1084
J.R.&P.E. TIMMONS
631-283
WINDSOR ROAD
BURTON Rd
L.L.&P.P. ARNOLD
930-358
5.462 Ac.
FERRY FAMILY TRUST
04-150760
4.016AC
18.77Ac.
6.31 Ac.
parcel #2
859-1005
1085-255
12-18-96
H.P. BATES
235-186
538-56
538-776
70.37A
68.14A
5.002
63.138 AC
169-527
35A
I.&M. Slabaugh
City of Akron
187-213
538-369 parcel #1
587-705
F.C.&J.A. KOTRLIK
676-723
50.13A
537-741
721-522
764-701
J.R.&P.E. TIMMONS
860-53
51A
P.S. ALEXANDER
836-418
8.146 Ac
P.S. ALEXANDER
836-418
836-420
17.4956AC
713-539
R.E.&M.A. MULLET
12.34 Ac.
R.A.&E.S. BONNER
838-1071, 1074, 1077
R.&E. BONNER
778-446
23.402
30.00 Ac.
R.A.&E. BONNER
971-1257
30.50 Ac.
524-991
2.14A
G.&J. WILLIAMS
531-345
2.76Ac.
J.&S. PETO
F.J.&R.M. FREDERICO
2.66A
795-1257
795-1257
2.66A
R.T.&J.M. McCLOUD
5.00 Ac.
764-121
224-178
29 Ac.
L. Hess
187-213
187-266
CITY OF AKRON
17.10A
City of Akron
36A
108A
CITY OF AKRON
509-1025
Par. I
345-585
460-866
10.61A
B. Kauffman
#1
36.57A
M.A. HANNA, Inc.
830-3
#2
14A
#3
3A
KINSMAN ROAD
SH 87
186-34
30A
City of Akron
49.25A
CITY OF AKRON
509-1025
Par. III
W.&M. CLARK
5-9-83
697-993
5.579 Ac.
C.L.+E.L. HALL
4.767 Ac.
2.303 Ac.
681-581
3.327 Ac.
E.W. SMITH
184-481
C.R.+P.J. ROBINSON
677-117
17.440 Ac.
187-212
55.62A
City of Akron
City of Akron
25A
6A
772-260 *
23.91A
EAST BRANCH WAREHOUSE
772-260 *
.25A UNPLATABLE
182-46
16.86A
EAST BRANCH WAREHOUSE
681-1174
681-1162 to 1174
722-453
31A
City of Akron
5A
184-480
44.40A
City of Akron
247-620
484-166
484-795
23.05A
H. Moss
OTTO'S FLORAL & GARDEN, INC.
CITY OF AKRON
509-1025
Par. VI
N
* Inadequate Description
√ Indicates survey on file with tax map dept.
SCALE 1"=300'
JANUARY 1, 1995
A B C D
E F G H
I J K L
M N O P
BURTON TWP
RELATIVE REPRESENTATION

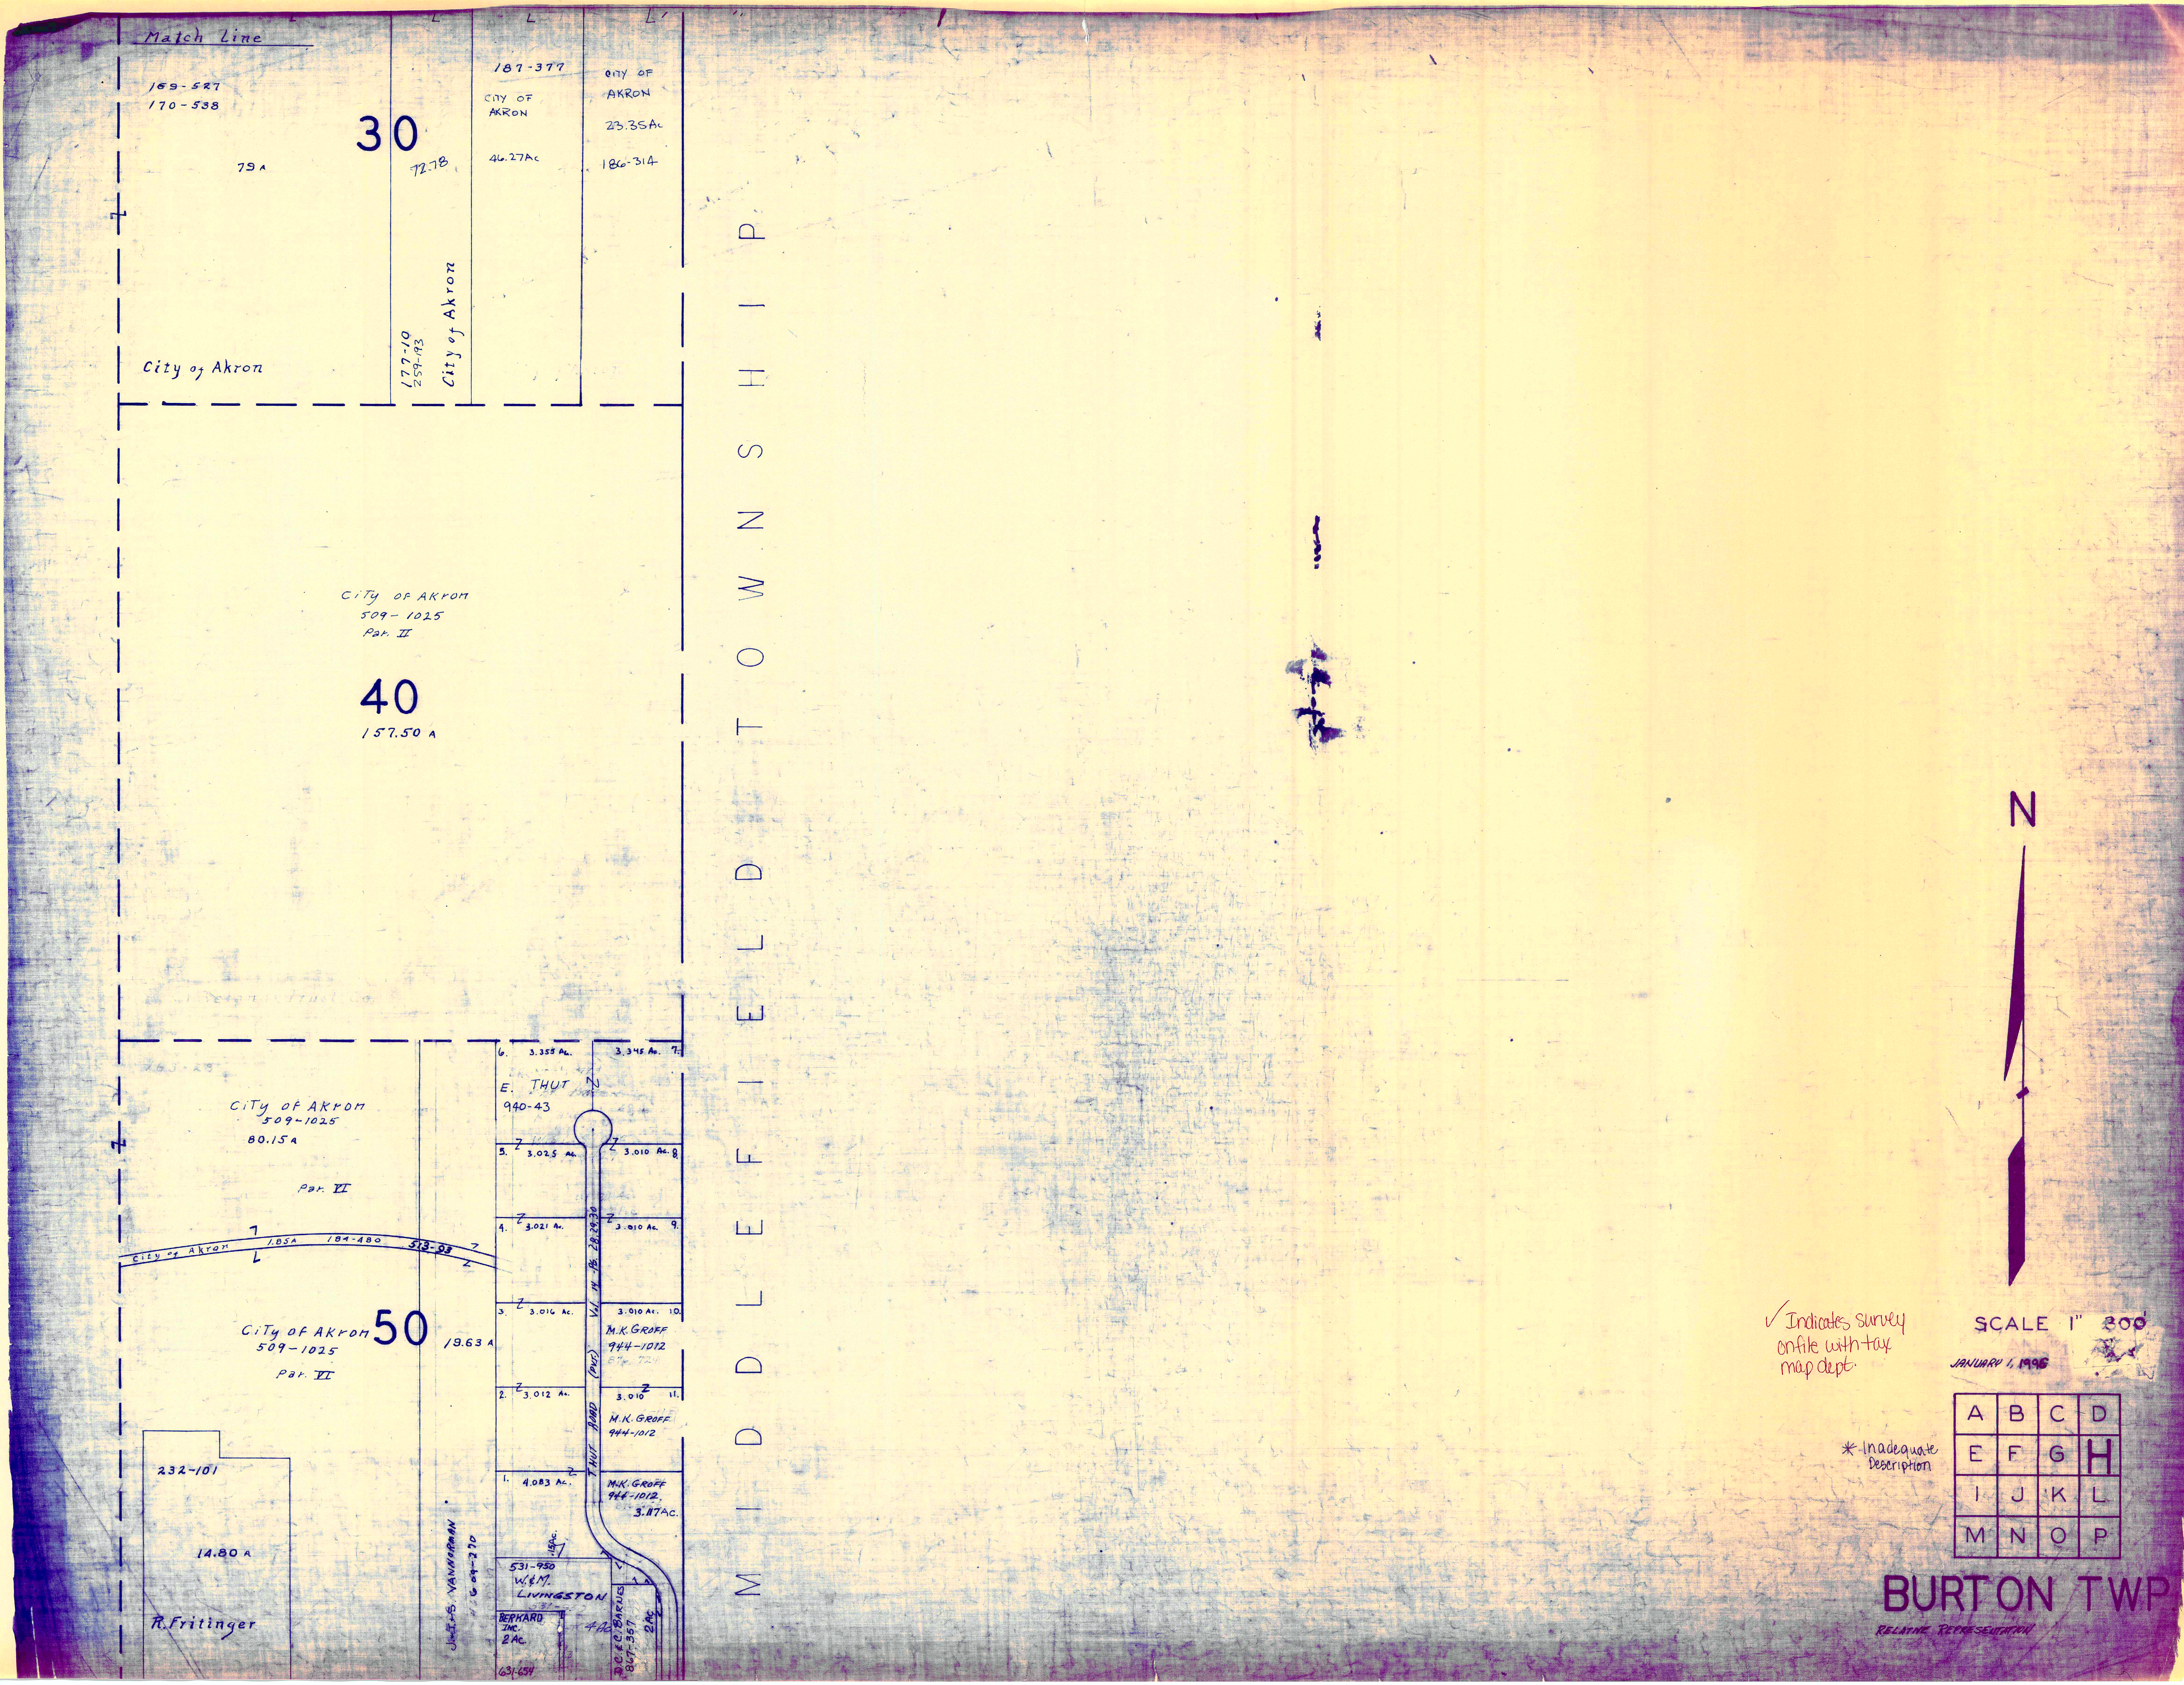
Match Line
169-527
170-538
30
79 A
72.78
187-377
CITY OF AKRON
46.27Ac
CITY OF AKRON
23.35Ac
186-314
177-10
259-93
City of Akron
City of Akron
CITY OF AKRON
509-1025
Par. II
40
157.50 A
MIDDLEFIELD TOWNSHIP
City of Akron
509-1025
80.15 A
Par. VI
City of Akron
1.85A
184-480
513-93
City of Akron
509-1025
Par. VI
50
19.63 A
6.
3.355 Ac.
3.345 Ac.
7.
E. THUT
940-43
5.
3.025 Ac.
3.010 Ac.
8.
4.
3.021 Ac.
3.010 Ac.
9.
3.
3.016 Ac.
3.010 Ac.
10.
M.K. GROFF
944-1012
2.
3.012 Ac.
3.010
11.
M.K. GROFF
944-1012
1.
4.083 Ac.
M.K. GROFF
944-1012
3.117Ac.
THUT ROAD (PVT.) Vol. 14 Pg. 28, 29, 30
232-101
14.80 A
R. Fritinger
J.+I.S. VANNORMAN
469-270
.15Ac.
531-950
W.&M.
LIVINGSTON
BERKARD
INC.
2Ac.
631-654
4Ac.
D.C.&C.C. BARNES
867-357
2Ac.
N

✓ Indicates survey on file with tax map dept.

* Inadequate Description

SCALE 1" 300'

JANUARY 1, 1996

A	B	C	D
E	F	G	**H**
I	J	K	L
M	N	O	P

BURTON TWP

RELATIVE REPRESENTATION

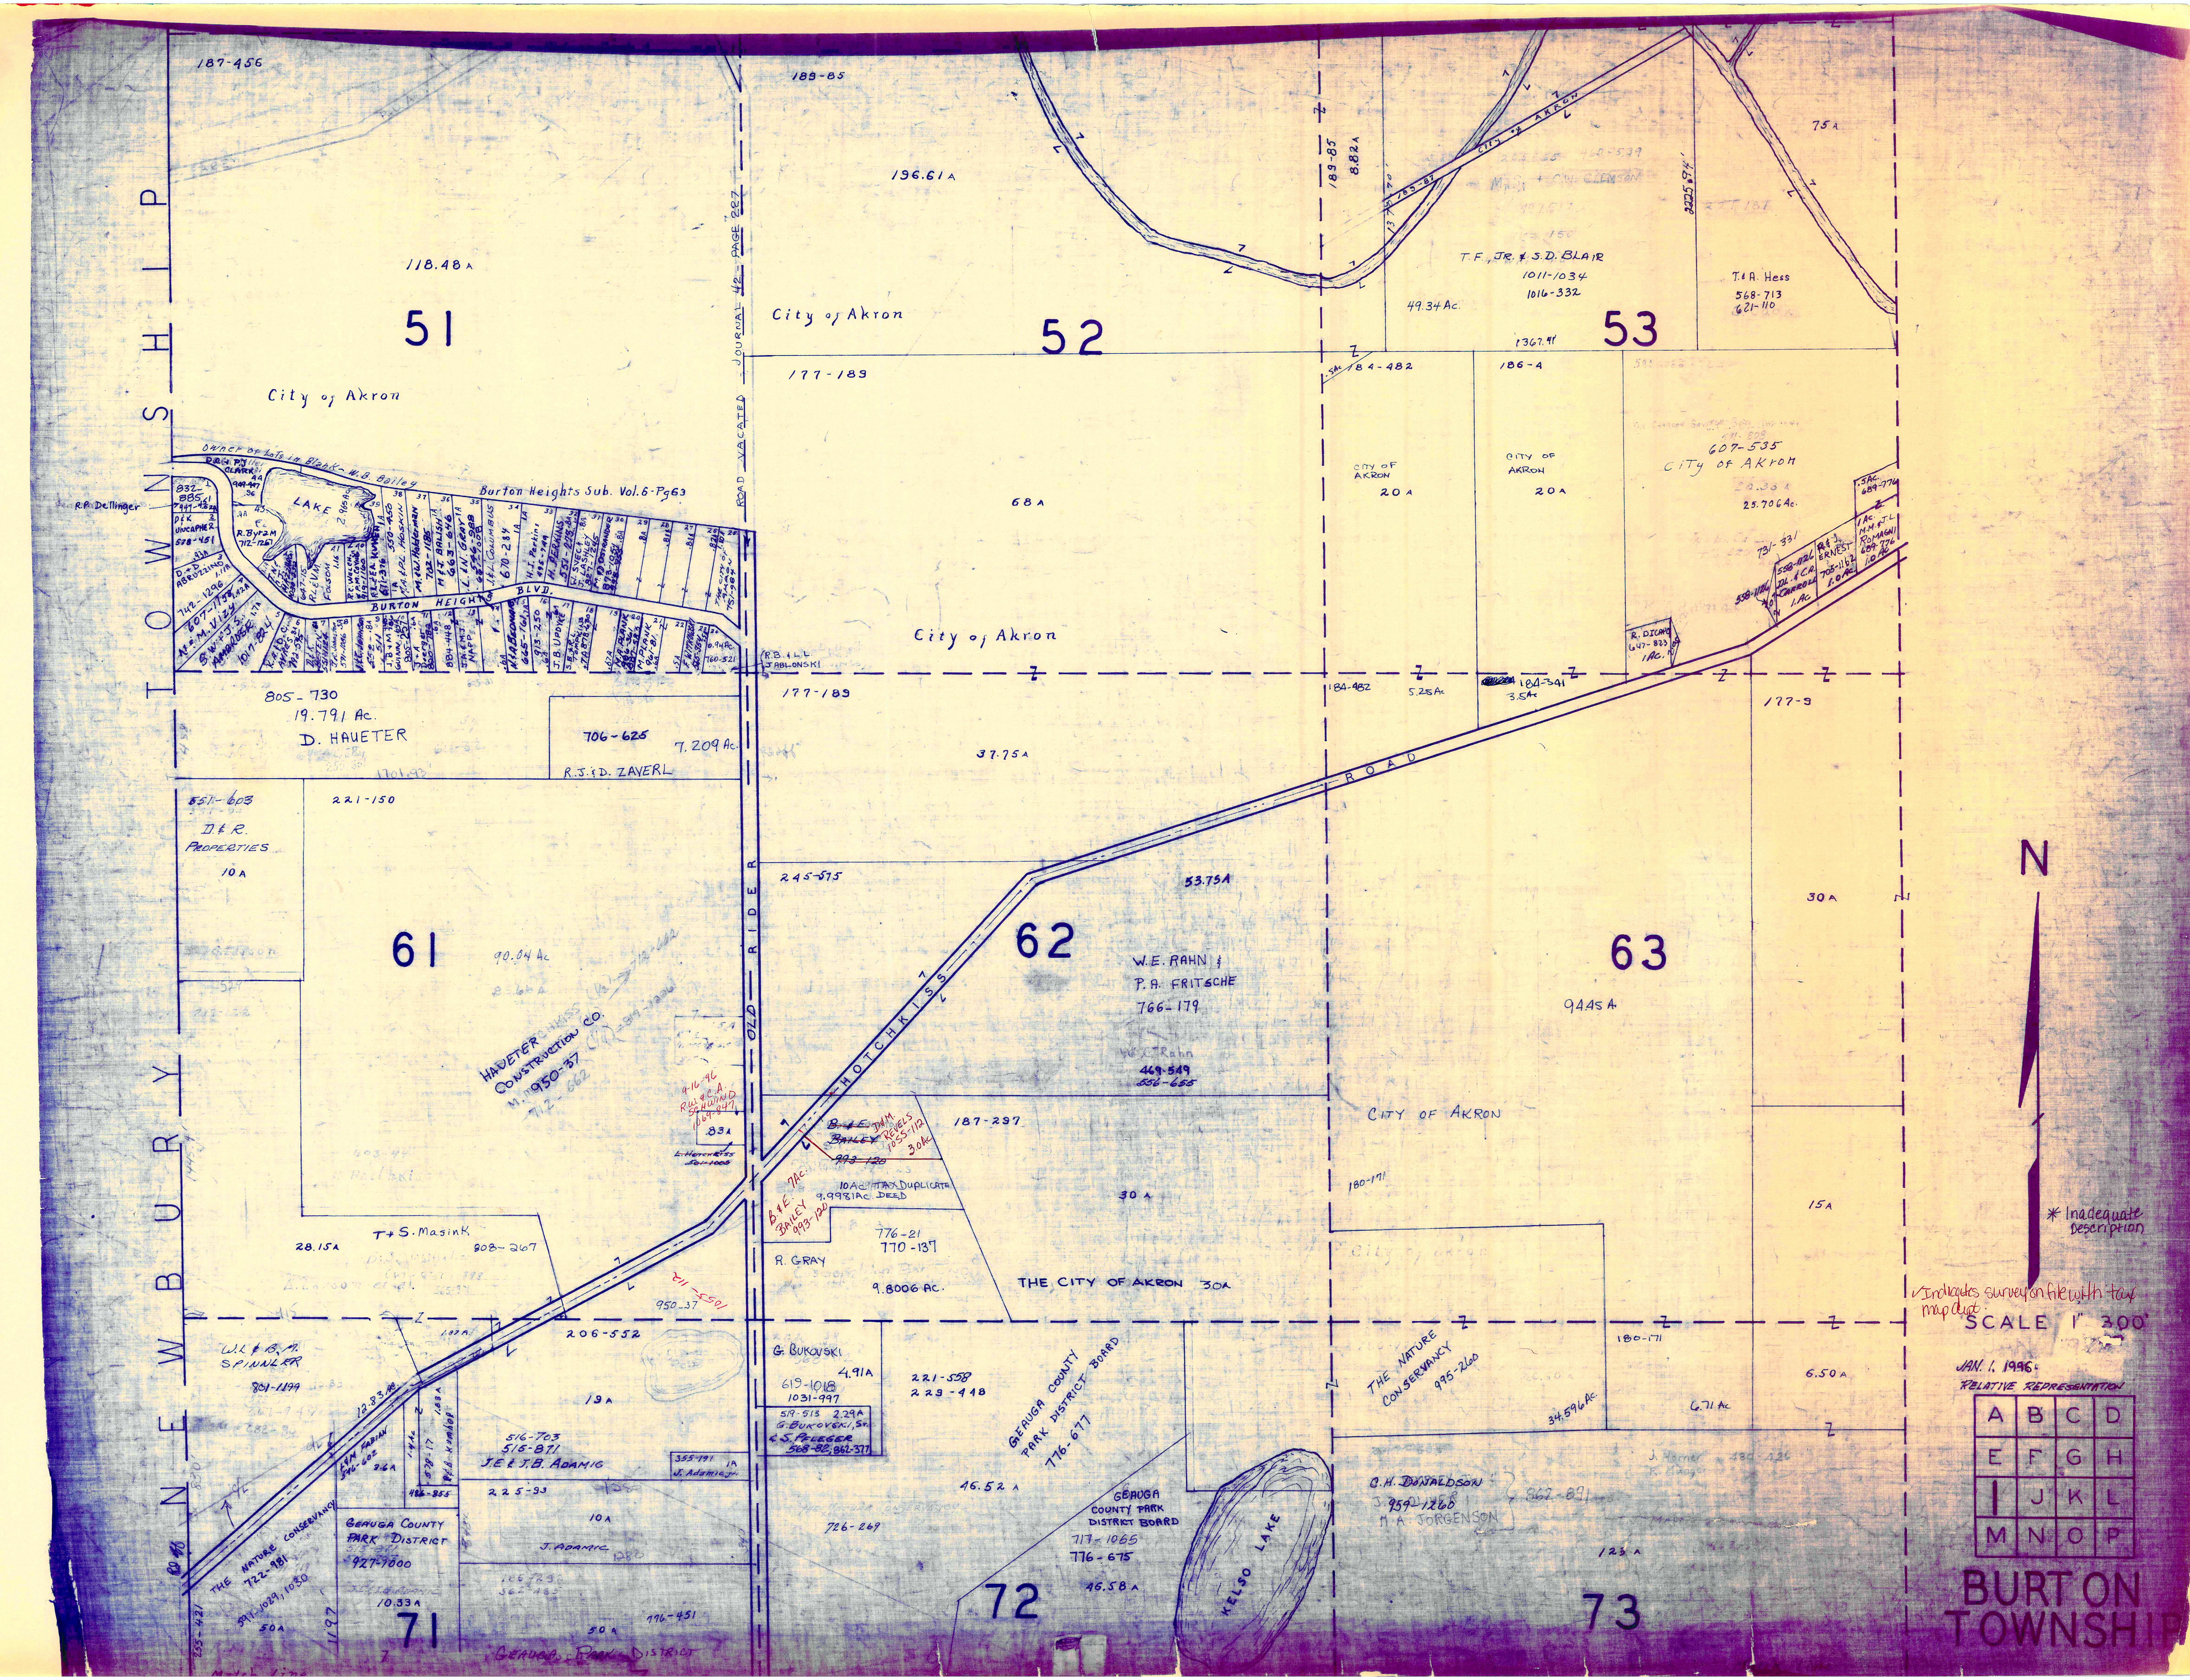

NEWBURY TOWNSHIP
51
52
53
61
62
63
71
72
73
187-456
118.48 A
City of Akron
189-85
196.61 A
177-189
68 A
City of Akron
ROAD VACATED JOURNAL 42 - PAGE 227
Owner of Lots in Block - W. B. Bailey
Burton Heights Sub. Vol. 6 - Pg 63
BURTON HEIGHTS BLVD.
LAKE
R. P. Dellinger
R. B. & L. L. JABLONSKI
189-85
8.82 A
T. F., JR. & S. D. BLAIR
1011-1034
1016-332
49.34 Ac.
T & A. Hess
568-713
621-110
75 A
1367.91
184-482
186-4
CITY OF AKRON
20 A
CITY OF AKRON
20 A
607-535
CITY of AKRON
25.706 Ac.
R. DICKO
647-823
1 Ac.
184-391
3.5 A
5.25 A
177-9
805-730
19.791 Ac.
D. HAUETER
706-625
7.209 Ac.
R. J. & D. ZAVERL
37.75 A
221-150
551-603
D & R PROPERTIES
10 A
90.04 Ac.
HAUETER CONSTRUCTION CO.
M. 950-37
712-662
OLD RIDER
HOTCHKISS
ROAD
245-575
53.75 A
W. E. RAHN &
P. A. FRITSCHE
766-179
469-549
656-655
9445 A
30 A
CITY OF AKRON
B. & E. BAILEY
993-120
J & M REVELS
1055-112
3.0 Ac.
187-297
10 Ac. TAX DUPLICATE
9.998 Ac DEED
776-21
770-137
R. GRAY
9.8006 Ac.
30 A
THE CITY OF AKRON 30 A
180-171
15 A
28.15 A
T + S. Masink
808-267
950-37
L. Hotchkiss
83 A
W. L. & B. A. SPINNLER
801-1199
206-552
G. BUKOVSKI
4.91 A
619-1018
1031-997
221-558
229-448
519-513 2.29 A
G. Bukovski, Sr.
E. S. Pfleger
568-80 862-377
19 A
516-703
515-871
J. E. & J. B. ADAMIC
225-93
355-191
J. Adamic
THE NATURE CONSERVANCY
722-981
591-1029, 1030
50 A
GEAUGA COUNTY PARK DISTRICT
927-1000
10.33 A
10 A
J. ADAMIC
776-451
50 A
GEAUGA COUNTY PARK DISTRICT BOARD
776-677
46.52 A
726-249
GEAUGA COUNTY PARK DISTRICT BOARD
717-1065
776-675
46.58 A
KELSO LAKE
THE NATURE CONSERVANCY
995-260
34.596 Ac.
180-171
6.50 A
6.71 Ac.
G. H. DONALDSON
959-1260
M. A. JORGENSON
862-891
123 A
N
* Inadequate Description
✓ Indicates survey on file with tax map dept.
SCALE 1" 300'
JAN. 1, 1996
RELATIVE REPRESENTATION
A B C D
E F G H
I J K L
M N O P
BURTON TOWNSHI

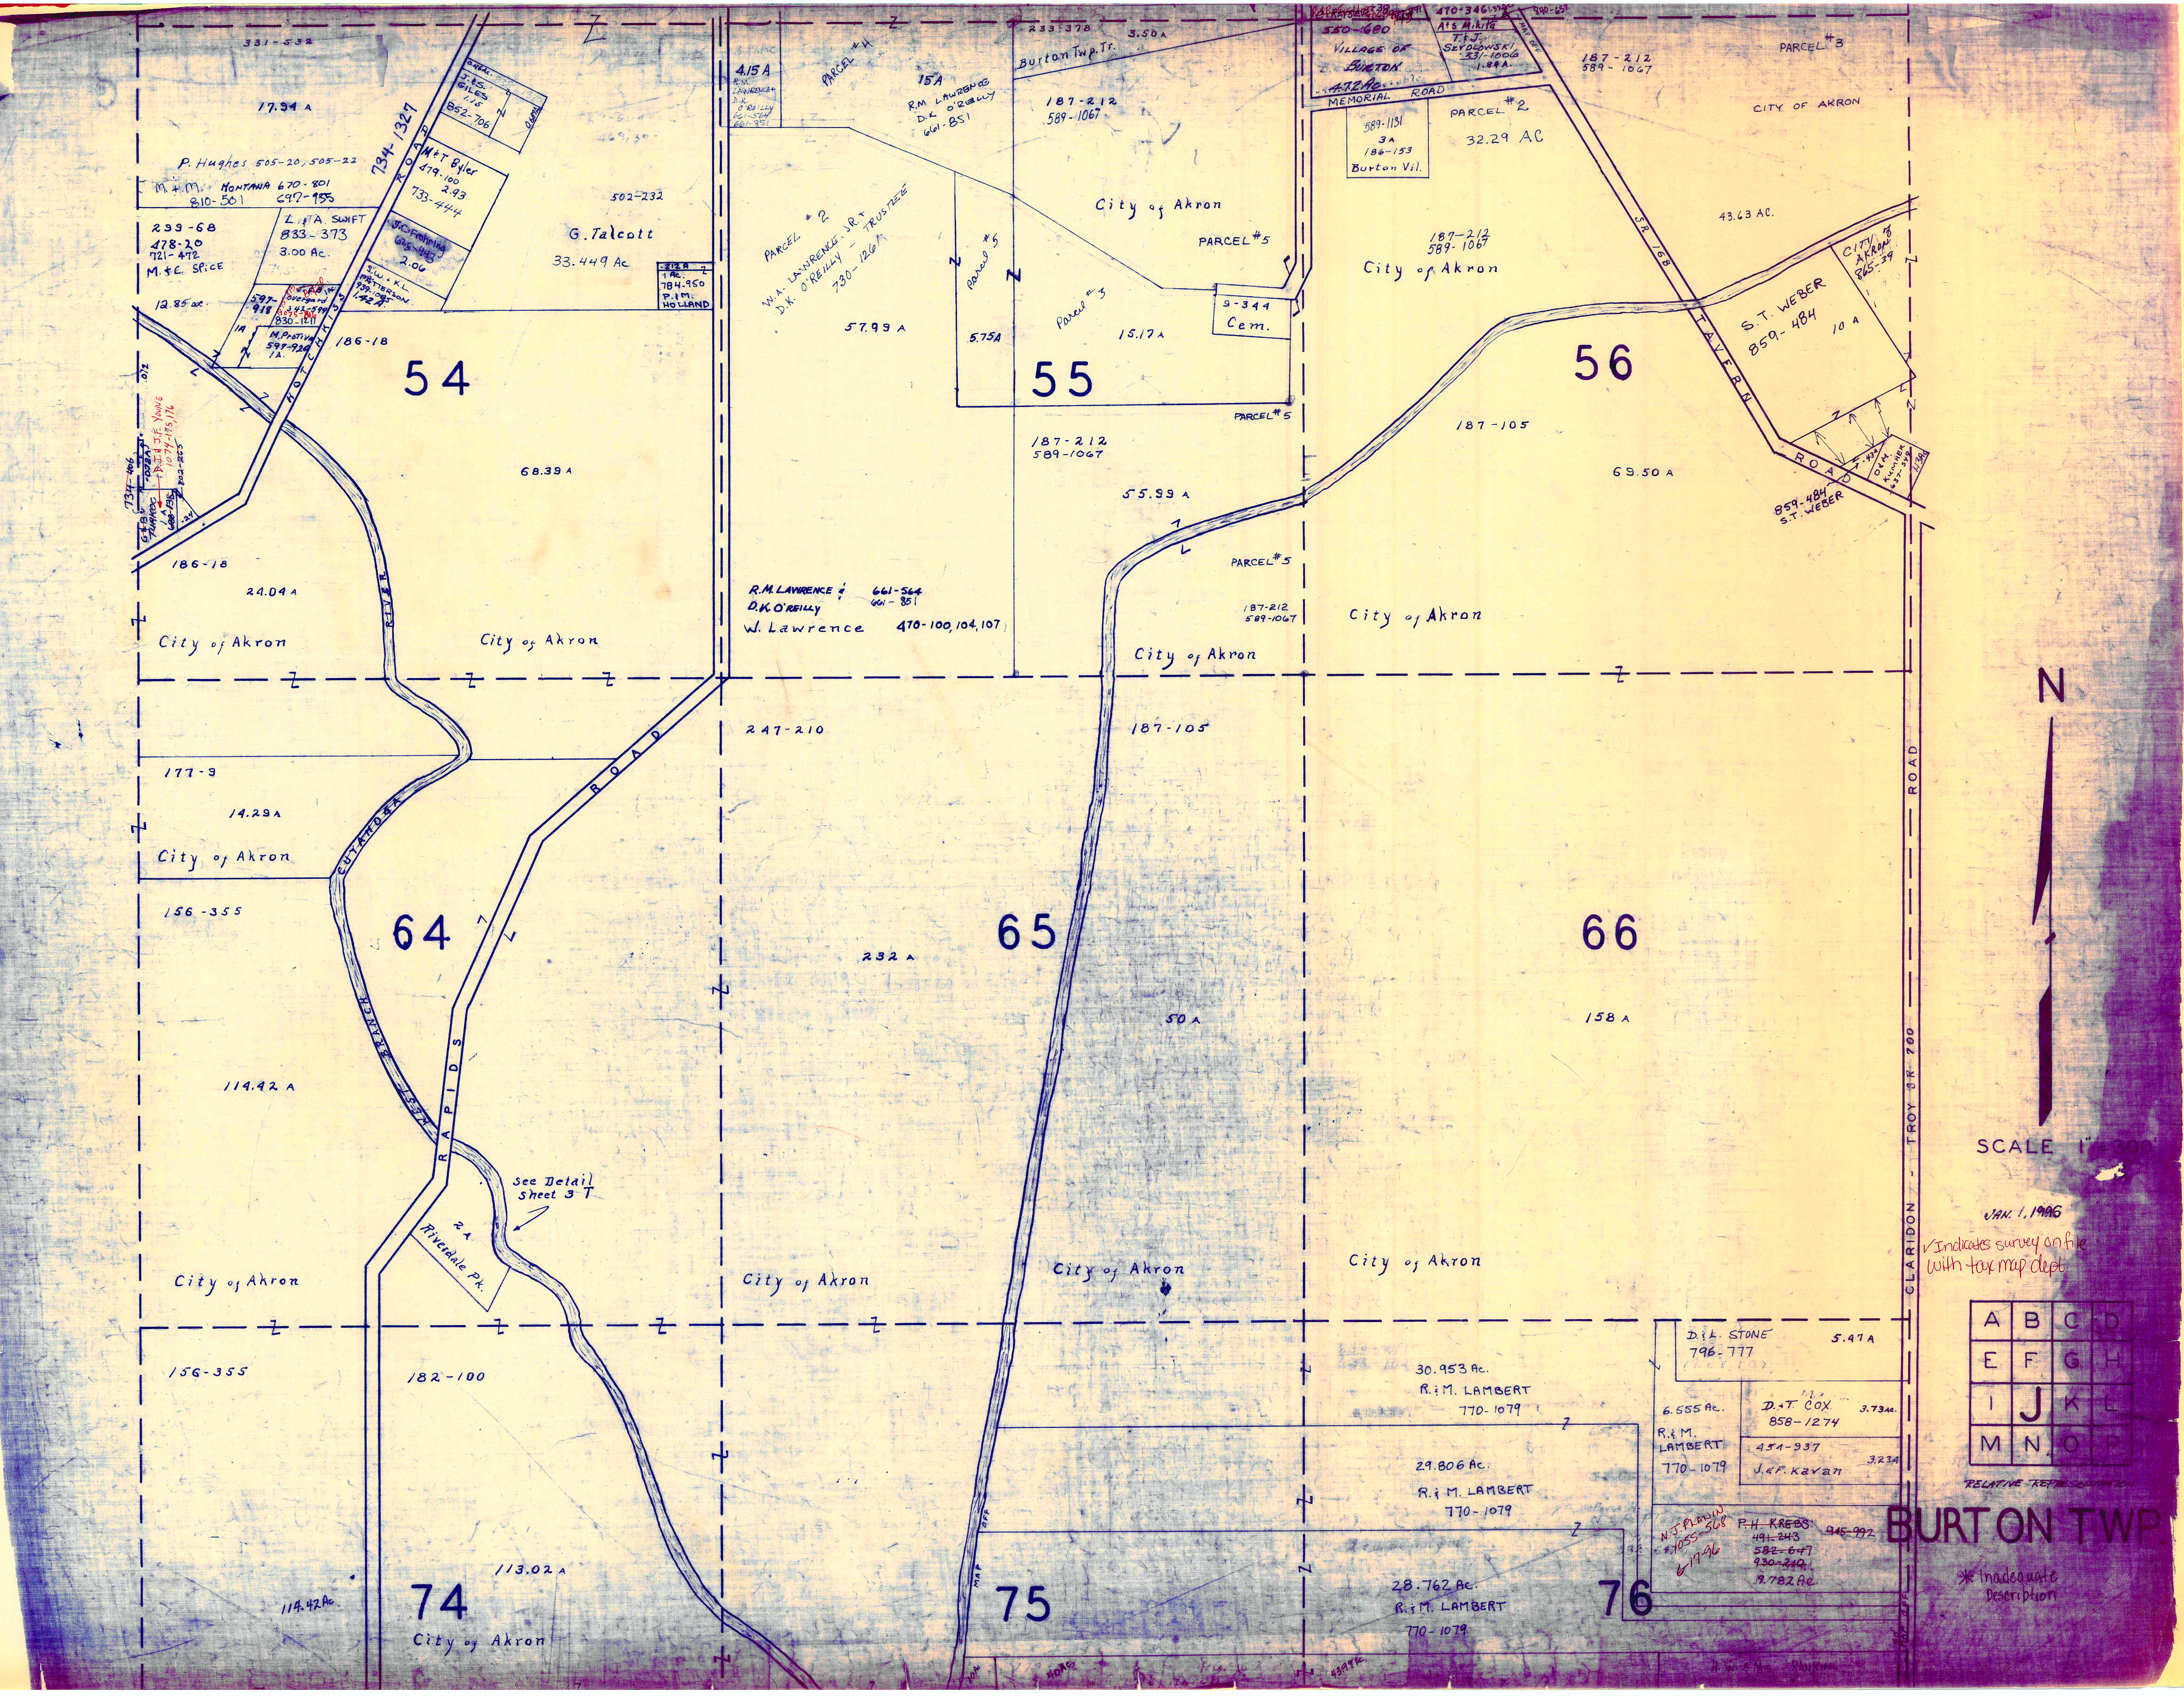
331-532
17.94 A
0.46Ac.
J. & S. GILES
1.15
852-706
0.689Ac.
734-1327
P. Hughes 505-20, 505-22
M+M. MONTANA 670-801
810-501 697-955
M+T Byler
479-100
2.93
733-444
502-232
299-68
478-20
721-472
M.+C. SPICE
L. & A. SWIFT
833-373
3.00 Ac.
J.C. Frohring
625-443
2.06
G. Talcott
33.449 Ac.
.212 A
1 Ac.
784-950
P.&M. HOLLAND
12.85 ac.
597-918
Overgard
341-599
830-1211
1A
M. Protiva
597-929
1A.
S.W. & K.L. PATTERSON
939-1085
1.42 A.
HOTCHKISS ROAD
186-18
54
.072
D.J. & J.F. YOUNG
1074-175, 176
734-406
G.&B. TURHOC
1 A
202-265
.24
68.39 A
186-18
24.04 A
RIVER
City of Akron
City of Akron
4.15 A
R.M. LAWRENCE & D.K. O'REILLY
661-564
661-851
PARCEL #4
15A
R.M LAWRENCE
D.K O'REILLY
661-851
233-378
3.50 A
Burton Twp. Tr.
187-212
589-1067
City of Akron
PARCEL #2
W.A. LAWRENCE, JR. + D.K. O'REILLY - TRUSTEE
730-1261
Parcel #5
Parcel #3
PARCEL #5
9-344
Cem.
57.99 A
5.75A
15.17 A
55
PARCEL #5
187-212
589-1067
55.99 A
PARCEL #5
R.M. LAWRENCE & D.K. O'REILLY 661-564
661-851
W. Lawrence 470-100, 104, 107
187-212
589-1067
City of Akron
550-680
VILLAGE OF BURTON
4.72 Ac.
470-346
A. & S. Mikita
T. & J. SZYDLOWSKI
331-1006
1.84 A.
840-651
MAP OFF
MEMORIAL ROAD
187-212
589-1067
PARCEL #3
CITY OF AKRON
589-1131
3A
186-153
Burton Vil.
PARCEL #2
32.29 AC
43.63 AC.
187-212
589-1067
City of Akron
SR 168
TAVERN ROAD
CITY of AKRON
865-39
S.T. WEBER
859-484
10 A
56
187-105
69.50 A
.434
D. & M. KUMHER
637-549
1.13Ac.
859-484
S.T. WEBER
City of Akron
247-210
187-105
177-9
14.29 A
City of Akron
CUYAHOGA
156-355
64
232 A
65
66
50 A
158 A
WEST BRANCH
RAPIDS ROAD
114.42 A
See Detail Sheet 3 T
2 A
Riverdale Pk.
City of Akron
City of Akron
City of Akron
City of Akron
156-355
182-100
N
SCALE 1"=300'
JAN. 1, 1996
√ Indicates survey on file with tax map dept.
CLARIDON - TROY SR 700 ROAD
D. & L. STONE
796-777
5.47 A
30.953 Ac.
R. & M. LAMBERT
770-1079
6.555 Ac.
R. & M. LAMBERT
770-1079
D. & T. COX
858-1274
3.73 Ac.
451-937
J. & F. Kavan
3.23 A
29.806 Ac.
R. & M. LAMBERT
770-1079
N.J. PLANIN
1055-568
6-17-96
~~P.H. KREBS~~
~~491-243~~
~~582-647~~
~~930-210~~
~~945-992~~
9.782 Ac.
28.762 Ac.
R. & M. LAMBERT
770-1079
76
113.02 A
114.42 Ac.
74
City of Akron
75
MAP OFF
43.99 Ac.
A B C D
E F G H
I J K L
M N O P
RELATIVE REPRESENTATION
BURTON TWP.
* Inadequate Description

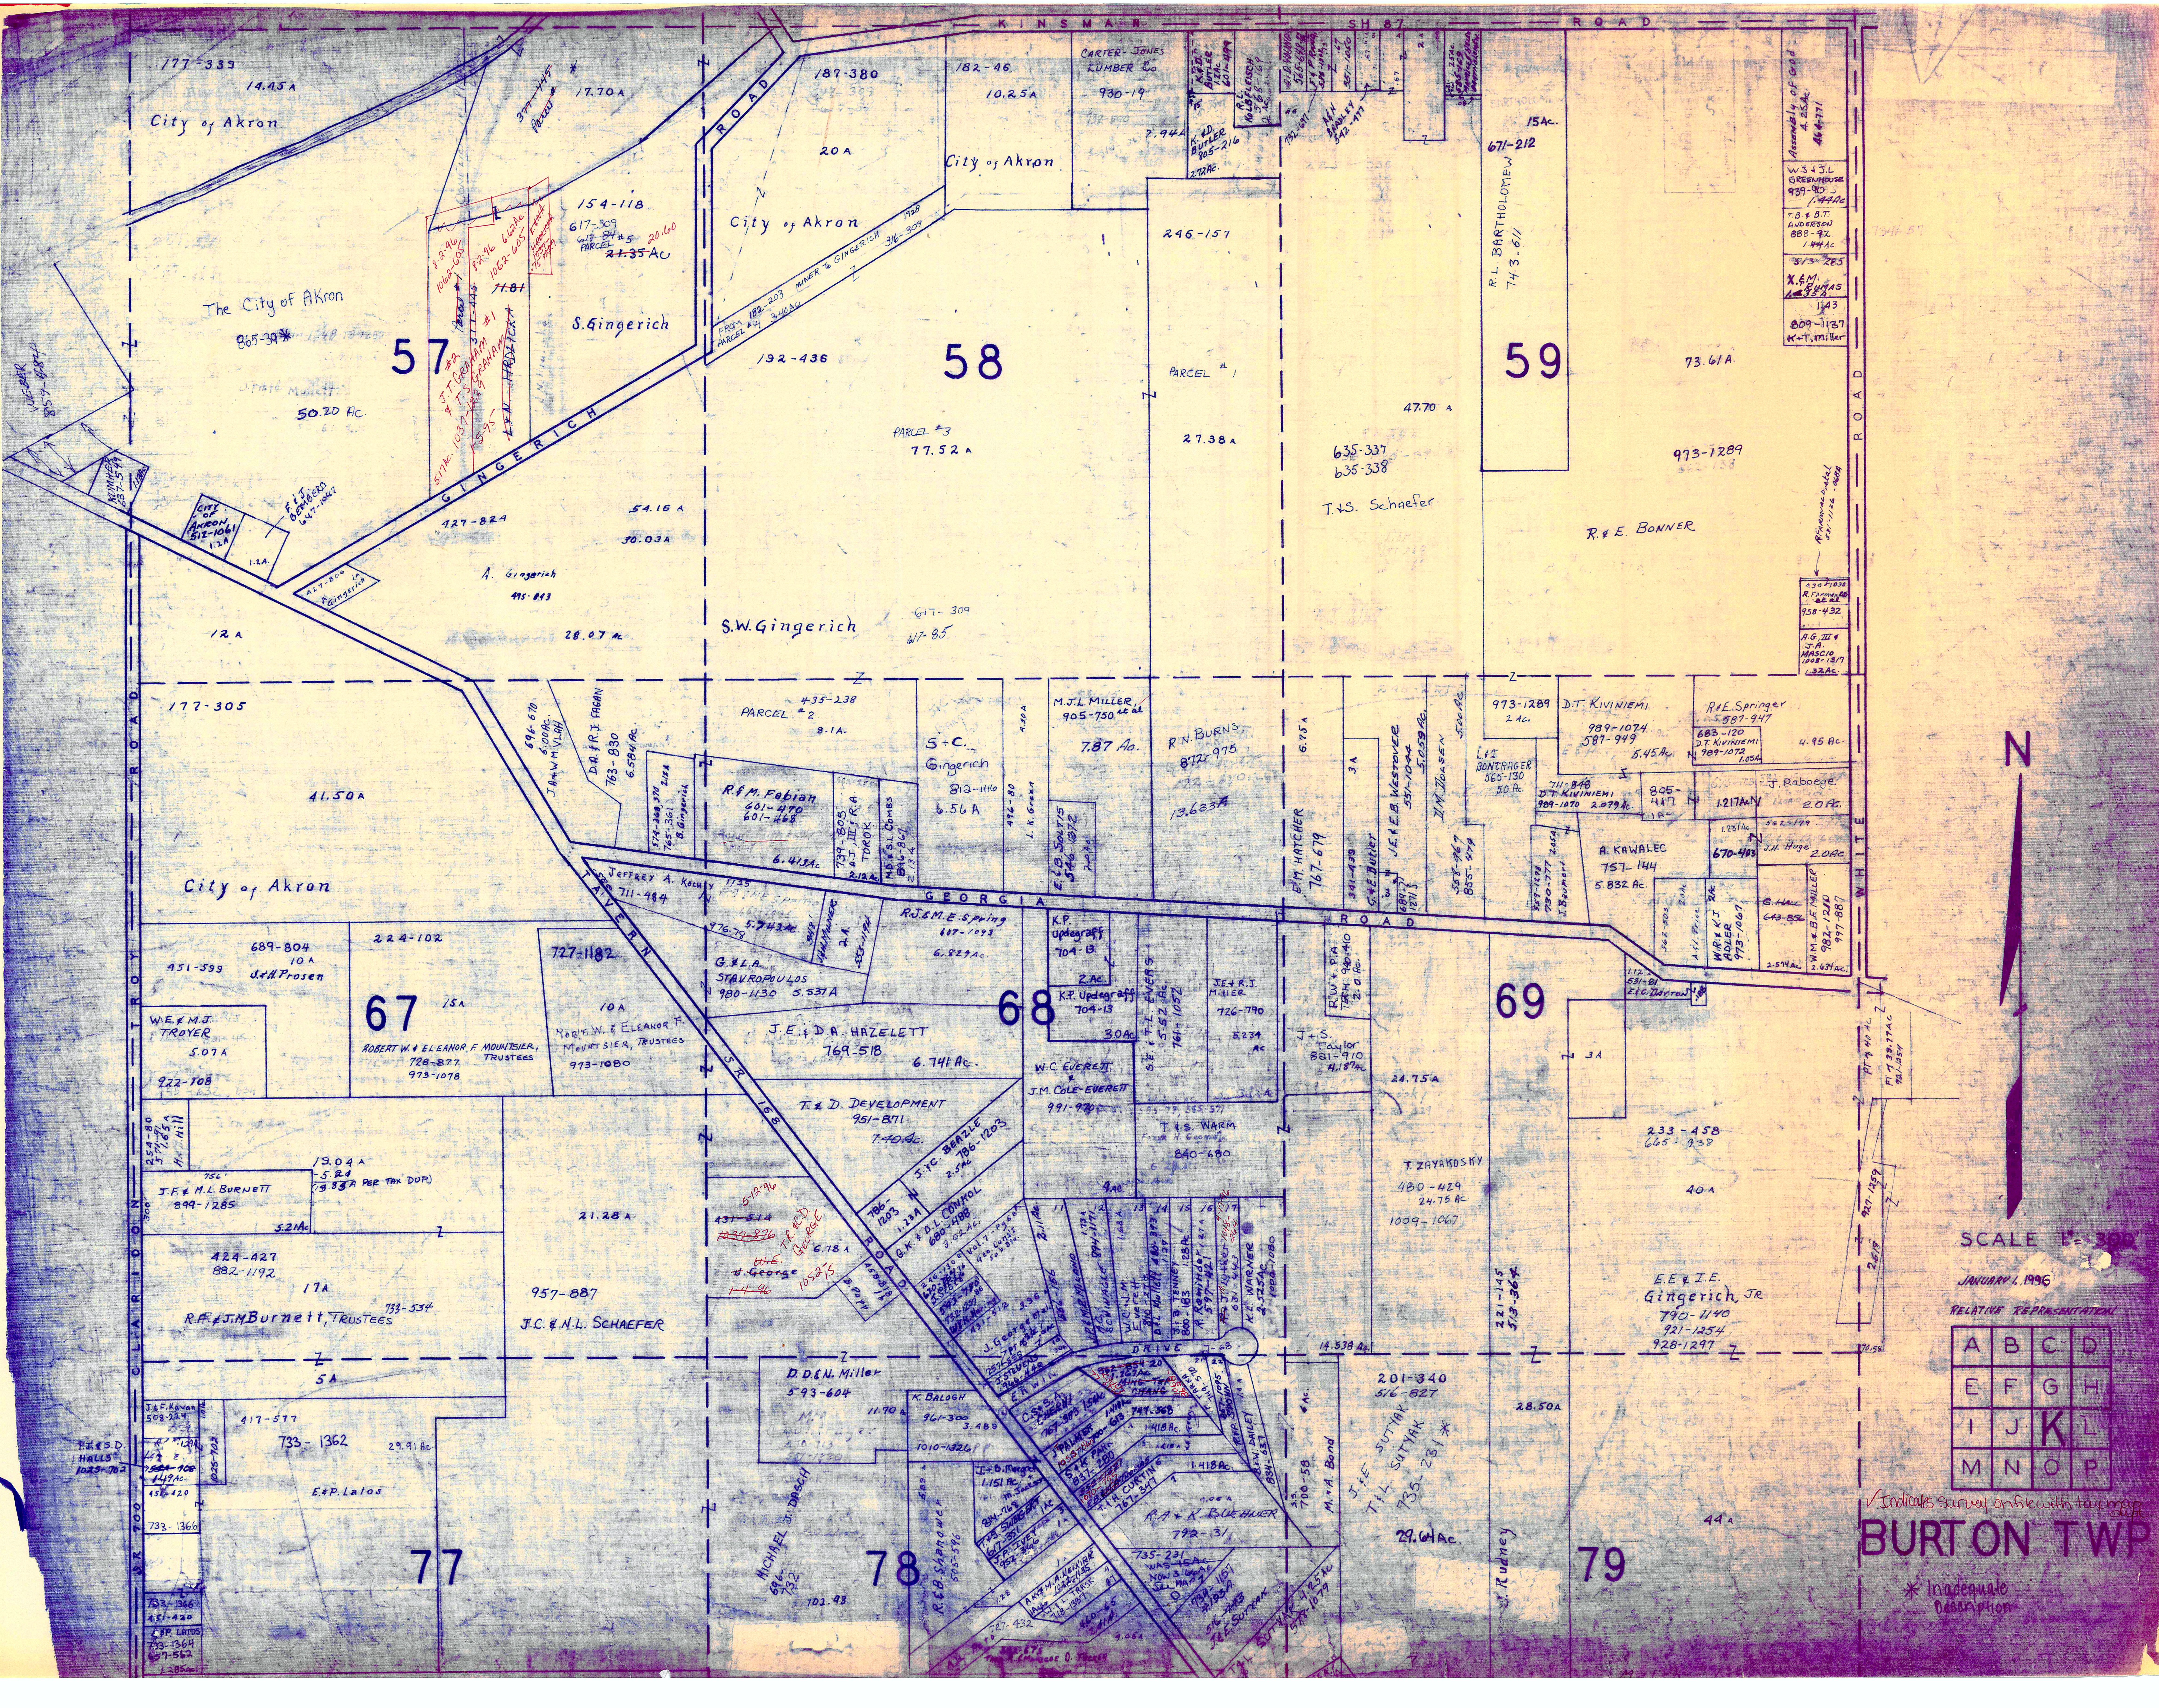
KINSMAN SH 87 ROAD
WHITE ROAD
TROY ROAD
CLARIDON TROY ROAD
GINGERICH ROAD
GEORGIA ROAD
TAVERN ROAD
SR 168
SR 700
EDWIN DRIVE
57
58
59
67
68
69
77
78
79
City of Akron
The City of Akron
865-39*
50.20 Ac.
177-339
14.45 A
17.70 A
154-118
617-309
21.35 Ac
S.Gingerich
427-824
A. Gingerich
54.16 A
50.03 A
28.07 Ac
12 A
187-380
20 A
City of Akron
192-436
Parcel #3
77.52 A
S.W.Gingerich
617-309
617-85
182-46
10.25 A
Carter-Jones Lumber Co.
930-19
246-157
Parcel #1
27.38 A
47.70 A
635-337
635-338
T.&S. Schaefer
R.L. Bartholomew
743-611
671-212
15 Ac.
73.61 A
973-1289
R.& E. Bonner
177-305
41.50 A
City of Akron
435-238
Parcel #2
8.1 A
R.& M. Fabian
601-470
601-468
6.41 Ac.
S+C. Gingerich
813-1116
6.56 A
M.J.L. Miller
905-750
7.87 Ac.
R.N. Burns
872-975
13.623 A
E.M. Hatcher
767-679
973-1289
D.T. Kiviniemi
989-1074
587-949
5.45 Ac.
R&E Springer
587-947
J. Rabbege
A. Kawalec
757-144
5.882 Ac.
Jeffrey A. Kochy
711-484
R.J.&M.E. Spring
G.& L.A. Stavropoulos
980-1130
5.537 A
K.P. Updegraff
704-13
689-804
10 A
451-599
224-102
15 A
W.E.& M.J. Troyer
5.07 A
922-708
Robert W. & Eleanor F. Mountsier, Trustees
728-877
973-1078
727-1182
10 A
Robert W. & Eleanor F. Mountsier, Trustees
973-1080
J.E.& D.A. Hazelett
769-518
6.741 Ac.
T.& D. Development
951-871
7.40 Ac.
W.C. Everett
J.M. Cole-Everett
991-970
T.& S. Warm
840-680
J.& S. Taylor
801-910
24.75 A
T. Zayakosky
480-429
24.75 Ac
1009-1067
233-458
665-938
40 A
E.E.& I.E. Gingerich, Jr
790-1140
921-1254
928-1297
J.F.& M.L. Burnett
899-1285
5.21 Ac.
424-427
882-1192
17 A
R.F.& J.M. Burnett, Trustees
733-534
21.28 A
957-887
J.C.& N.L. Schaefer
5 A
417-577
733-1362
29.91 Ac
E.& P. Lalos
D.D.& N. Miller
593-604
11.70 A
Michael J. Dorsch
K. Balogh
R.& B. Sapower
R.A.& K. Buehner
792-31
J.& E. Suttak
T.& L. Suttak
735-231 *
201-340
516-827
28.50 A
M.A. Bond
29.64 Ac.
J. Rudney
44 A
N
SCALE 1" = 300'
JANUARY 1, 1996
RELATIVE REPRESENTATION
A B C D
E F G H
I J K L
M N O P
✓ Indicates survey on file with tax map dept.
BURTON TWP
* Inadequate Description

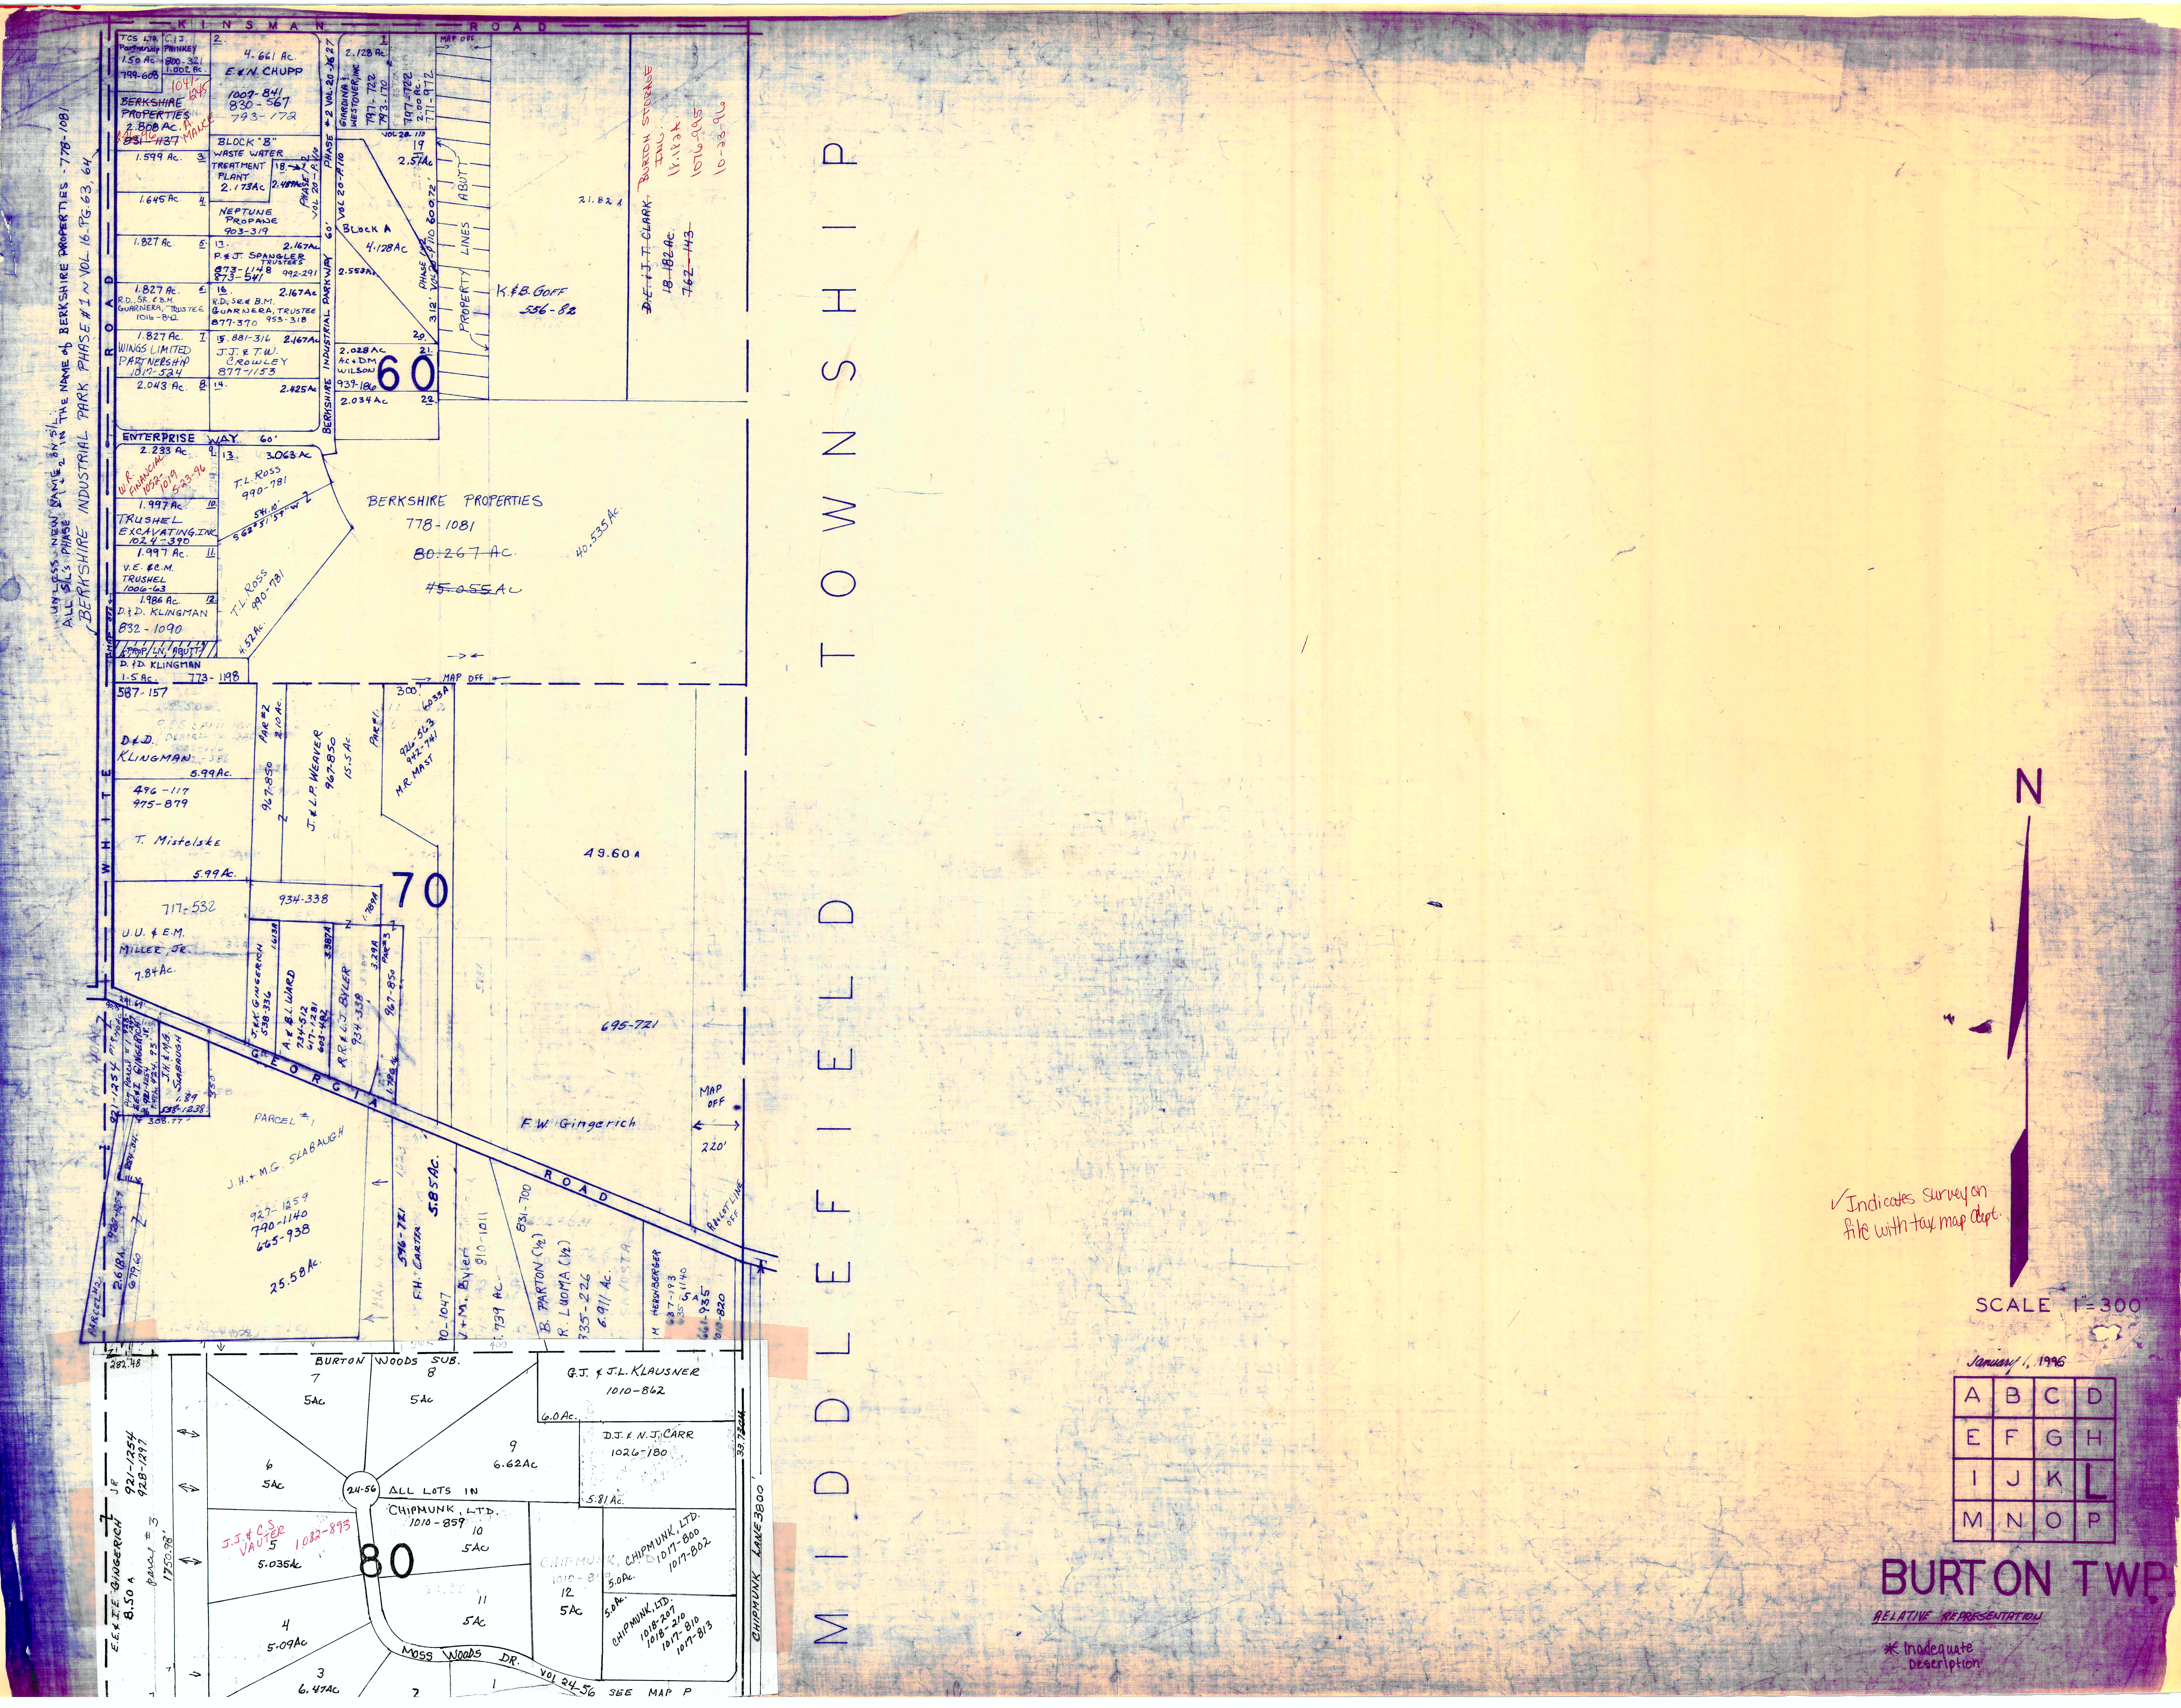
KINSMAN ROAD
WHITE ROAD
GEORGIA ROAD
MIDDLEFIELD TOWNSHIP
N
MAP OFF
TCS LTD. Partnership 1.50 Ac. 799-608
C.&J. PRINKEY 800-321 1.002 Ac.
2. 4.661 Ac. E.&N. CHUPP 1007-841 830-567 793-172
1041-1245
~~BERKSHIRE PROPERTIES~~ 2.808 Ac. ~~831-1137~~
A. MANCE 2-16-96
1.599 Ac. 3.
1.645 Ac. 4.
1.827 Ac. 5.
1.827 Ac. 6. R.D., SR. & B.M. GUARNERA, TRUSTEE 1016-842
1.827 Ac. 7. WINGS LIMITED PARTNERSHIP 1017-524
2.043 Ac. 8.
BLOCK "B" WASTE WATER TREATMENT PLANT 2.173Ac
18. 2.489Ac
PHASE 1/2 VOL 20-P.110
NEPTUNE PROPANE 903-319
17. 2.167Ac P.&J. SPANGLER TRUSTEES 873-1148 873-541 992-291
16. 2.167Ac R.D., SR.& B.M. GUARNERA, TRUSTEE 877-370 953-318
15. 881-316 2.167Ac J.J. & T.W. CROWLEY 877-1153
14. 2.425Ac
BERKSHIRE INDUSTRIAL PARKWAY 60'
PHASE #2 VOL.20-P.127
1. 2.128 Ac.
GIARDINA & WESTOVER, INC. 797-722 793-170
797-722 2.00 Ac. 771-972
VOL 20-110
19 2.57Ac
VOL 20-P.110
BLOCK A 4.128Ac
2.553Ac
PHASE 1/2 VOL 20-P.110 600.72' 312'
20. 21. 22.
2.028 Ac AC & D.M. WILSON 939-186
2.034 Ac
60
PROPERTY LINES ABUTT
K.&B. GOFF 556-82
21.82 A
~~D.E. & J.T. CLARK~~ ~~18.182 Ac.~~ ~~762-143~~
BURTON STORAGE INC. 18.182A 1016-995 10-23-96
BERKSHIRE INDUSTRIAL PARK PHASE #1 N VOL. 16 PG. 63, 64
ALL S/L'S PHASE 1 & 2 IN THE NAME of BERKSHIRE PROPERTIES - 778-1081
UNLESS NEW NAME ON S/L
ENTERPRISE WAY 60'
9. 2.233 Ac.
W.R. FINANCIAL 1052-1019 5-23-96
13. 3.063 Ac
T.L. ROSS 990-781
541.10' S62°51'57"W
10. 1.997 Ac. TRUSHEL EXCAVATING, INC 1024-390
11. 1.997 Ac. V.E. & C.M. TRUSHEL 1006-63
12. 1.986 Ac. D.&D. KLINGMAN 832-1090
T.L. ROSS 990-781 4.52 Ac.
BERKSHIRE PROPERTIES 778-1081 ~~80.267 Ac.~~ ~~45.055~~ Ac
40.535 Ac.
PROP. LN. ABUTT
D.&D. KLINGMAN 1.5 Ac. 773-1198
587-157
D&D. KLINGMAN 5.99 Ac.
496-117 975-879
T. Mistelske 5.99 Ac.
717-532
U.U. & E.M. MILLER, JR. 7.84Ac.
PAR #2 2.10 Ac. 967-850
J.&L.P. WEAVER 967-850 15.5 Ac.
PAR #1 300' 6.033A 926-563 942-741 M.R. MAST
934-338
70
49.60 A
695-721
J.&K. GINGERICH 538-336 1.613A
A.&B.L. WARD 734-512 617-1281 603-482
3.387A
R.R.&L.J. BYLER 934-338
1.789A
PAR #3 3.29A 967-850
1.796 Ac
241.69'
921-1254 PT 40 AC
Pt of Parcel #1 E.E. & I. GINGERICH JR. 921-1254 924.93
J.H. & M.G. SLABAUGH 1.89 538-1238
350
308.77
PARCEL #1
J.H. + M.G. SLABAUGH 927-1259 790-1140 665-938 25.58 Ac.
PARCEL #2 2.618A 927-1259 679.60
F.W. Gingerich
MAP OFF 220'
RAILOT LINE OFF
546-721 F.H. CARTER 5.85 Ac.
810-1047
J+M. Byler 810-1011
.739 Ac.
831-700
B. PARTON (1/2) R. LUOMA (1/2) 335-226 6.911 Ac.
M. HERSHBERGER 637-193 635-1140 5A
661-935 1010-820
282.48
BURTON WOODS SUB.
7 5Ac
8 5Ac
G.J. & J.L. KLAUSNER 1010-862 6.0 Ac.
D.J. & N.J. CARR 1026-180 5.81 Ac.
6 5Ac
9 6.62Ac
24-56
ALL LOTS IN CHIPMUNK, LTD. 1010-859
J.J. & C.S. VAUTER 1082-893
5 5.035Ac
10 5Ac
80
CHIPMUNK, LTD. 1017-800 1017-802 5.0Ac.
12 5Ac
11 5Ac
CHIPMUNK, LTD. 1018-207 1018-210 1017-810 1017-813 5.0Ac.
4 5.09Ac
3 6.47Ac
2
1
MOSS WOODS DR. VOL 24-56 SEE MAP P
E.E. & I.E. GINGERICH JR 8.50 A 921-1254 928-1297
Parcel #3 1750.98'
CHIPMUNK LANE 3800'
33.73CH

✓ Indicates survey on file with tax map dept.

SCALE 1"=300'

January 1, 1996

A	B	C	D
E	F	G	H
I	J	K	L
M	N	O	P

BURTON TWP.

RELATIVE REPRESENTATION

* Inadequate Description

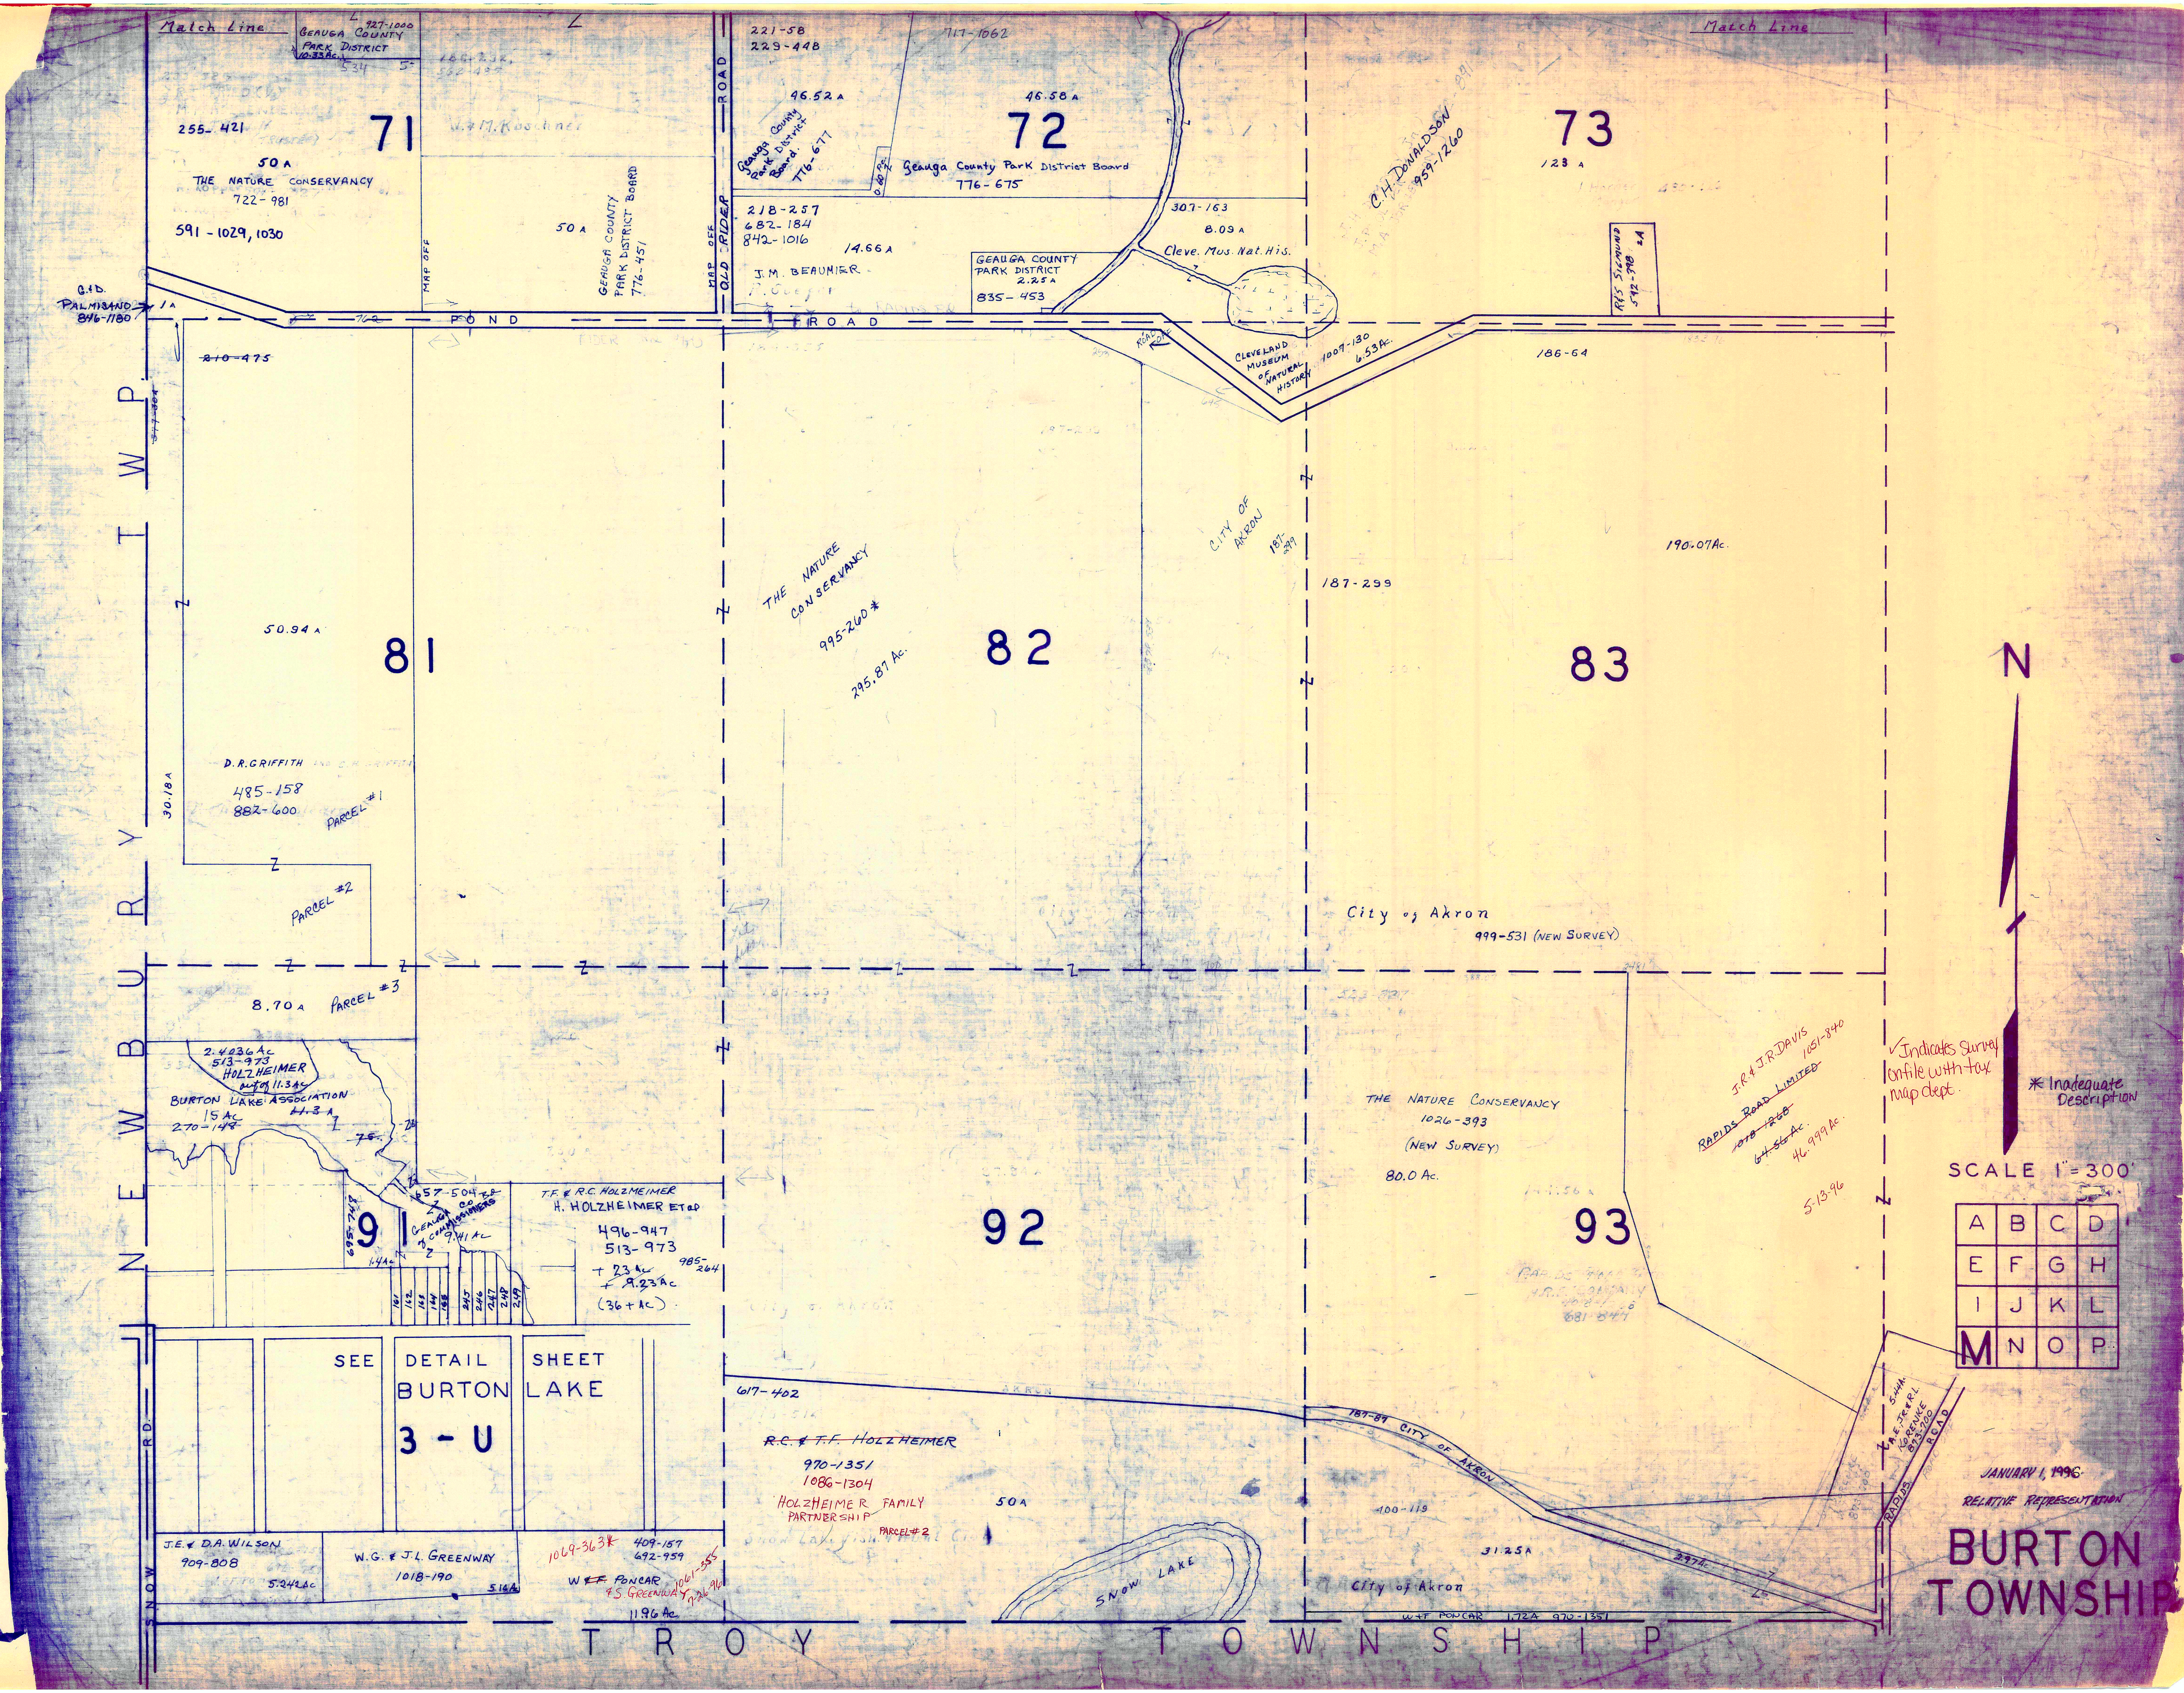
Match Line
Match Line
71
72
73
81
82
83
91
92
93
GEAUGA COUNTY PARK DISTRICT 10.33 Ac.
927-1000
255-421
50 A
THE NATURE CONSERVANCY
722-981
591-1029, 1030
W.&M. Koschner
50 A
GEAUGA COUNTY PARK DISTRICT BOARD 776-451
MAP OFF
MAP OFF
OLD RIDER ROAD
POND ROAD
G.&D. PALMISANO 846-1180
1 A
~~210-475~~
221-58
229-448
46.52 A
Geauga County Park District Board. 776-677
0.60 Ac
46.58 A
Geauga County Park District Board
776-675
717-1062
218-257
682-184
842-1016
14.66 A
J.M. BEAUMIER
GEAUGA COUNTY PARK DISTRICT 2.25 A
835-453
307-163
8.09 A
Cleve. Mus. Nat. His.
ROAD OFF
CLEVELAND MUSEUM OF NATURAL HISTORY
1007-130
6.53 Ac.
C.H. DONALDSON
959-1260
123 A
R&S SIEGMUND 592-998
186-64
THE NATURE CONSERVANCY
995-260 *
295.87 Ac.
CITY OF AKRON
187-299
187-299
190.07 Ac.
50.94 A
30.18 A
D.R. GRIFFITH
485-158
882-600
PARCEL #1
PARCEL #2
PARCEL #3
8.70 A
City of Akron
999-531 (NEW SURVEY)
2.4036 Ac
513-973
HOLZHEIMER
out of 11.3 Ac
BURTON LAKE ASSOCIATION
15 Ac
270-148
~~11.3 A~~
695-748
1.4 Ac
657-504
GEAUGA CO BD of COMMISSIONERS
9.41 Ac
161
162
163
164
165
245
246
247
248
249
T.F. & R.C. HOLZMEIMER
H. HOLZHEIMER ET AL
496-947
513-973
+ 23 Ac
+ 9.23 Ac
985-264
(36 + Ac)
SEE DETAIL SHEET
BURTON LAKE
3 - U
J.E. & D.A. WILSON
909-808
5.242 Ac
W.G. & J.L. GREENWAY
1018-190
5.14 Ac
1069-363*
409-157
692-959
W ~~& F.~~ PONCAR & S. GREENWAY
1061-355
7-26-96
11.96 Ac
617-402
~~R.C. & T.F. HOLZHEIMER~~
970-1351
1086-1304
HOLZHEIMER FAMILY PARTNERSHIP
PARCEL #2
50 A
SNOW LAKE
187-87 CITY OF AKRON
100-119
31.25 A
2.97 Ac.
City of Akron
W&F PONCAR 1.72 A 970-1351
THE NATURE CONSERVANCY
1026-393
(NEW SURVEY)
80.0 Ac.
J.R. & J.R. DAVIS
1051-840
~~RAPIDS ROAD LIMITED~~
~~1018-1268~~
~~64.56 Ac.~~
46.999 Ac.
5-13-96
5.44 A
A.E. JR. & R.L. KORENKE
873-700
RAPIDS ROAD
SNOW RD.
NEWBURY TWP.
TROY TOWNSHIP
N
SCALE 1" = 300'
A
B
C
D
E
F
G
H
I
J
K
L
M
N
O
P
✓ Indicates Survey on file with tax map dept.
* Inadequate Description

JANUARY 1, 1996

RELATIVE REPRESENTATION

BURTON TOWNSHIP

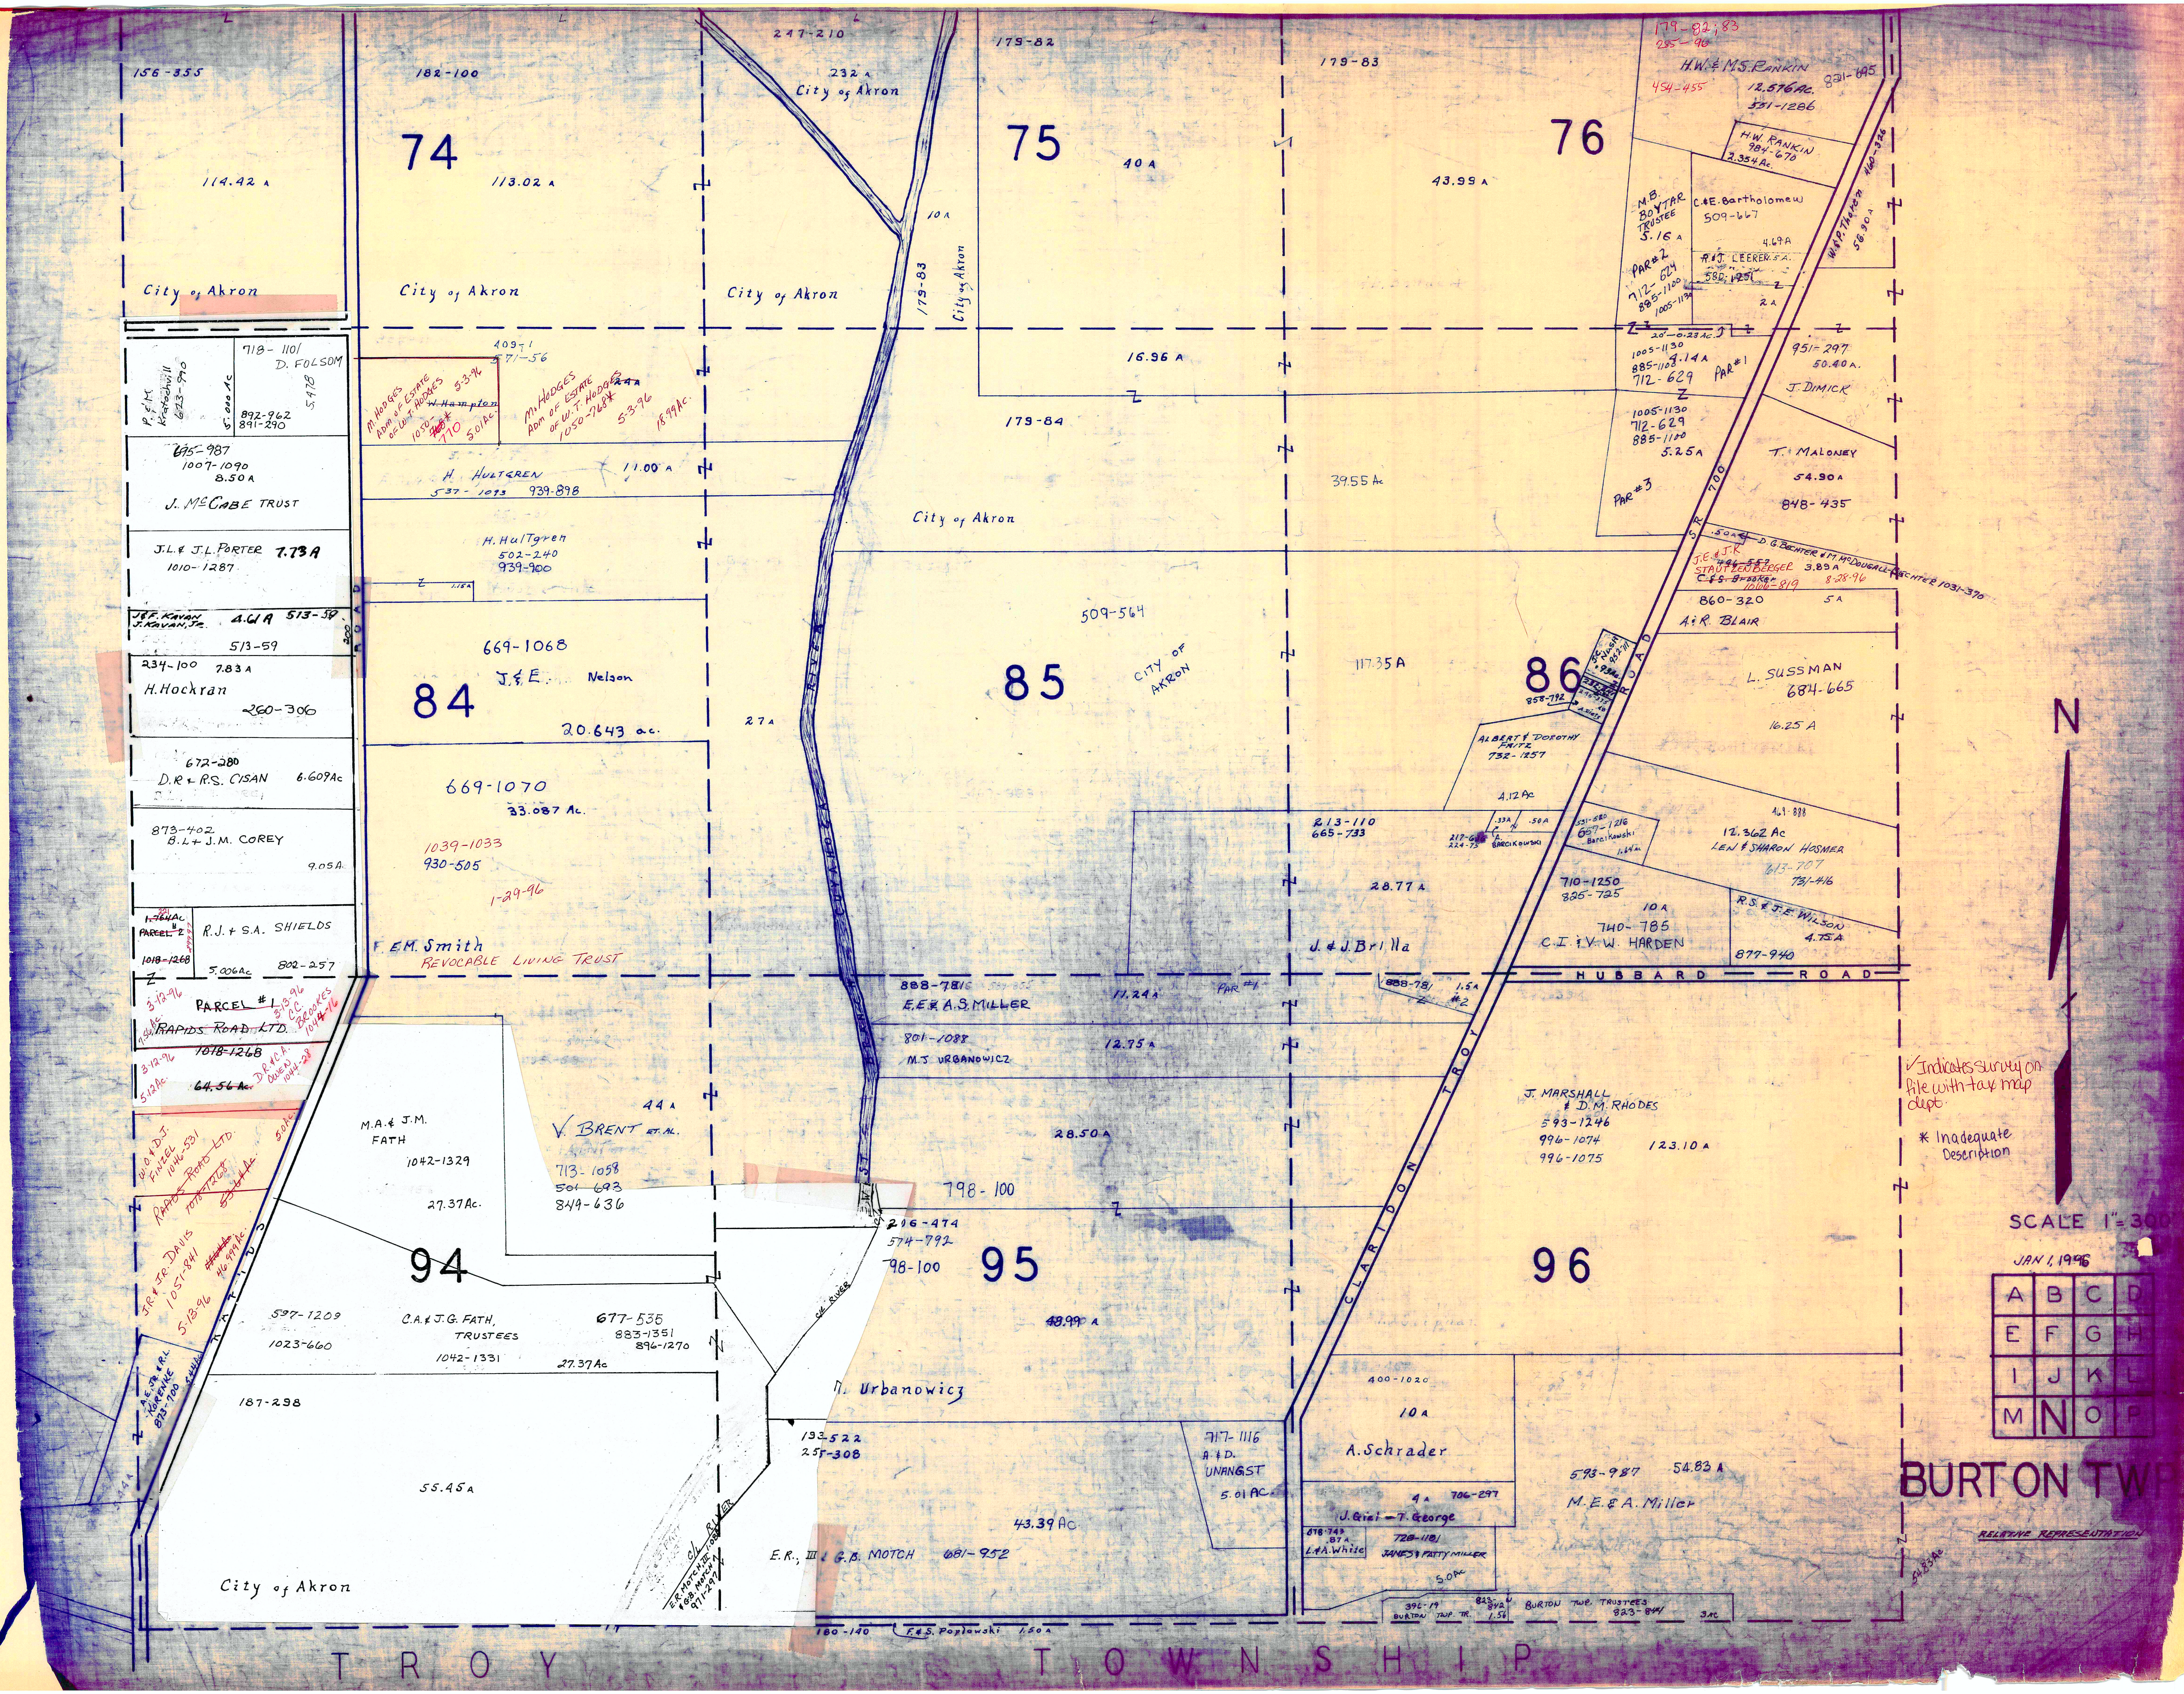

74
75
76
84
85
86
94
95
96
156-355
114.42 A
182-100
113.02 A
247-210
232 A
City of Akron
179-82
40 A
179-83
43.99 A
179-82, 83
285-96
H.W. & M.S. RANKIN
454-455
12.576 Ac.
351-1286
821-695
H.W. RANKIN
984-670
2.354 Ac.
M.B. BOYTAR TRUSTEE
5.16 A
C & E Bartholomew
509-667
4.69 A
R & J. LEERER
582-1251
PAR #2
712-629
885-1100
1005-1130
W & P Thayer 460-336
58.90 A
2 A
10 A
179-83
City of Akron
16.96 A
179-84
City of Akron
39.55 Ac
20 - 0.23 Ac
8.14 A
PAR #1
951-297
50.40 A
J. DIMICK
5.25 A
PAR #3
T. MALONEY
54.90 A
848-435
718-1101
D. FOLSOM
P. & M. Kratochvil
623-990
5.000 Ac
892-962
891-290
5478
1097-1
571-56
M. HODGES Adm of Estate of W.T. HODGES
1050-768
5-3-96
5.01 Ac
W. Hampton
18.99 Ac
675-987
1007-1090
8.50 A
J. McCABE TRUST
H. HULTGREN
537-1093
939-898
11.00 A
H. Hultgren
502-240
939-900
J.L. & J.L. PORTER
7.73 A
1010-1287
J & F. KAVAN
J. KAVAN, Jr.
4.61 A
513-59
234-100
7.83 A
H. Hockran
260-306
669-1068
J. & E. Nelson
20.643 ac.
669-1070
33.087 Ac.
1039-1033
930-505
1-29-96
672-280
D.R. & R.S. CISAN
6.609 Ac
873-402
B.L. & J.M. COREY
9.05 A
R.J. & S.A. SHIELDS
PARCEL #2
1018-1268
5.006 Ac
802-257
F. E.M. Smith
REVOCABLE LIVING TRUST
27 A
509-564
CITY OF AKRON
117.35 A
D.G. BECHTER & M. McDOUGALL-BECHTER 1031-370
J.E. & J.K. STAUFFENBERGER
1006-819
8-28-96
3.89 A
860-320
5 A
A. & R. BLAIR
L. SUSSMAN
684-665
16.25 A
858-792
ALBERT & DOROTHY FRITZ
732-1257
4.12 A
12.362 Ac
LEN & SHARON HOSMER
613-707
731-416
R.S. & J.E. WILSON
4.75 A
877-940
213-110
665-733
Barcikowski
28.77 A
710-1250
825-725
10 A
740-785
C.I. & V.W. HARDEN
J. & J. Brilla
HUBBARD ROAD
RAPIDS ROAD
888-781
E.E. & A.S. MILLER
11.24 A
PAR #1
1.5 A
#2
801-1088
12.75 A
M.J. URBANOWICZ
PARCEL #1
RAPIDS ROAD LTD.
1018-1268
3-12-96
64.56 Ac
D.R. & C.A. OWEN
C.C. BROOKS
M.A. & J.M. FATH
1042-1329
27.37 Ac.
V. BRENT ET. AL.
44 A
713-1058
501-693
849-636
28.50 A
798-100
J. MARSHALL & D.M. RHODES
593-1246
996-1074
996-1075
123.10 A
✓ Indicates survey on file with tax map dept.
* Inadequate Description
SCALE 1" = 300
JAN 1, 1996
A B C D
E F G H
I J K L
M N O P
BURTON TWP
RELATIVE REPRESENTATION
N
D. & D.J. FINCEL 1046-531
RAPIDS ROAD LTD.
J.R. & J.R. DAVIS
1051-841
5-18-96
597-1209
1023-660
C.A. & J.G. FATH, TRUSTEES
1042-1331
677-535
883-1351
896-1270
27.37 Ac
216-474
574-792
798-100
48.99 A
187-298
55.45 A
M. Urbanowicz
133-522
251-308
717-1116
A. & D. UNANGST
5.01 Ac.
400-1020
10 A
A. Schrader
4 A
706-297
J. Gial - T. George
726-1181
J. & L. White
JAMES & PATTY MILLER
593-987
54.83 A
M.E. & A. Miller
43.39 Ac
E.R. III & G.B. MOTCH
681-952
City of Akron
CLARIDON TROY ROAD
S.R. 700
CUYAHOGA RIVER
A.E. & B.R. GARINKE
180-140
F. & S. Poplowski
1.50 A
396-19
BURTON TWP. TR.
BURTON TWP. TRUSTEES
823-844
TROY TOWNSHIP

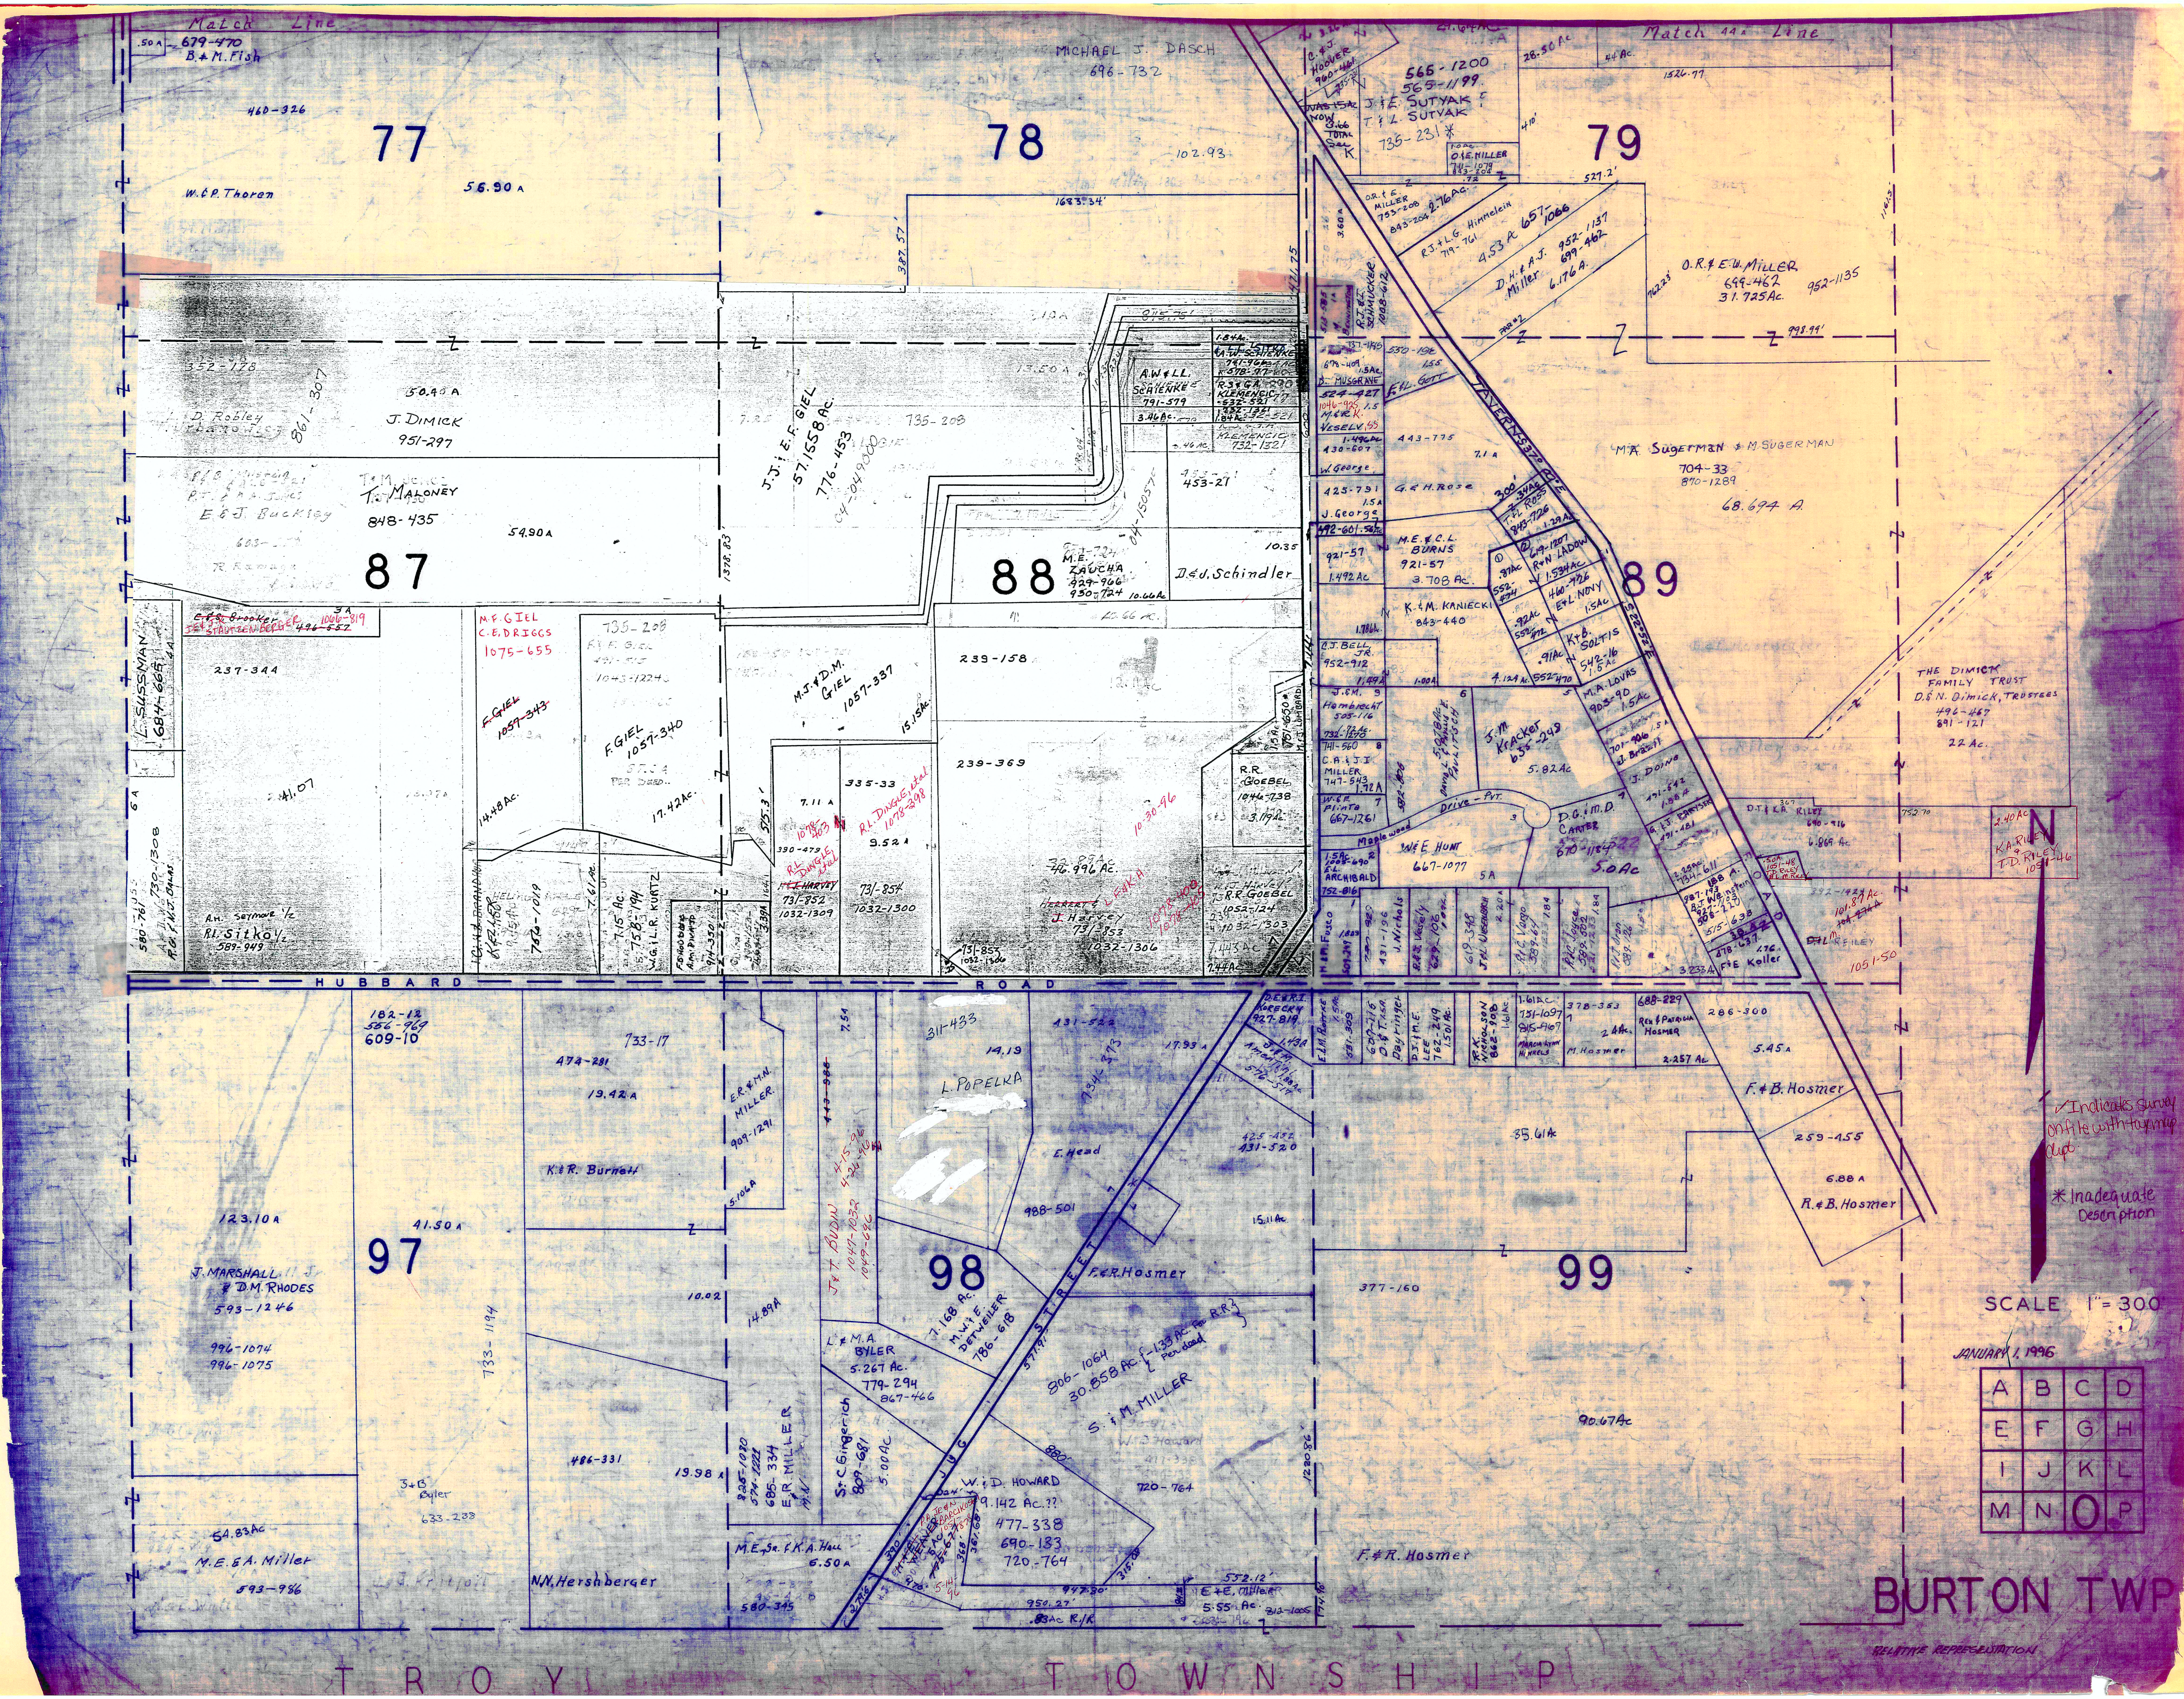
Match Line
679-470
B.&M. Fish
460-326
77
W.G.P. Thoren
56.90 A
78
MICHAEL J. DASCH
696-732
102.93
1683.34'
79
Match 44a Line
565-1200
565-1199
J.&E. SUTYAK
T.&L. SUTYAK
735-231 *
O.&E. MILLER
O.R.&E. MILLER
R.J.&L.G. Himmelein
D.H.&A.J. Miller
952-1137
699-462
6.176 A.
O.R.&E.U. Miller
699-462
31.725 Ac.
952-1135
352-178
D. Robley
861-307
J. DIMICK
951-297
50.90 A
J.J.&E.F. GIEL
57.1558 Ac.
776-453
735-208
A.W.&L.L. SCHIENKE
791-579
KLEMENCIC
732-1321
D. MUSGRAVE
524-427
F.&L. GOTT
M.&K.R. VESELY
443-775
M.A. Sugerman & M. SUGERMAN
704-33
890-1289
68.694 A.
T. MALONEY
848-435
E.&J. Buckley
54.90 A
87
88
M.E. ZAUCHA
929-966
950-724
D.&J. Schindler
10.66 Ac.
J. George
425-791
G.R.H. Rose
J. George
M.E.&C.L. BURNS
921-57
3.708 Ac.
RON LADOW
E.&L. NOVY
K.&M. KANIECKI
843-440
89
K.&B. SOLTIS
542-16
M.A. LOVAS
903-90
J. DOINO
THE DIMICK FAMILY TRUST
D.&N. Dimick, TRUSTEES
496-467
891-121
22 Ac.
E.&S. Brooks
J.E. STAUFFENBERGER
L. SUSSMAN
684-665
237-344
M.F. GIEL
C.E. DRIGGS
1075-655
F. GIEL
1057-343
735-208
F. GIEL
1057-340
17.42 Ac.
14.48 Ac.
M.J.&D.M. GIEL
1057-337
15.15 Ac.
239-158
239-369
C.J. BELL JR.
J.M. Hambrecht
C.A.&J.J. MILLER
747-543
J.M. Kracker
655-243
5.82 Ac.
R.R. GOEBEL
1046-738
3.19 Ac.
Drive Pvt.
Maplewood
W.&E. HUNT
667-1077
D.G.&M.D. CARTER
670-1153
5.0 Ac
D.T.&K.R. RILEY
K.A. RILEY & T.D. RILEY
1051-46
335-33
9.52 A
R.L. DINGLE et al
1078-398
731-852
1032-1309
731-854
1032-1300
46.996 Ac.
J. Harvey
731-853
1032-1306
R.R. GOEBEL
1052-124
1032-1303
R.L. Sitko 1/2
589-949
KURTZ
F.&E. Koller
1051-50
HUBBARD ROAD
182-12
556-969
609-10
733-17
474-281
19.42 A
E.R.&M.N. MILLER
909-1291
311-433
L. POPELKA
431-522
17.93 A
F.&R. NORBERY
927-819
M. Hosmer
Rev.&Pauline Hosmer
2.257 Ac.
286-300
5.45 A
F.&B. Hosmer
35.61 A
259-455
6.88 A
R.&B. Hosmer
✓ Indicates survey on file with township clerk
* Inadequate Description
N
123.10 A
J. MARSHALL
& D.M. RHODES
593-1246
996-1074
996-1075
97
41.50 A
K.&R. Burnett
10.02
14.89 A
J.&T. DUDON
E. Head
988-501
15.11 Ac.
98
F.&R. Hosmer
377-160
99
SCALE 1"=300
JANUARY 1, 1996
L.&M.A. BYLER
5.267 Ac.
779-294
867-466
7.168 Ac.
M.W.&E. DETWEILER
786-618
806-1064
30.858 Ac.
S.&M. MILLER
90.67 Ac.
JUG STREET
733-1194
486-331
E.R. MILLER
Sr. C. Singerich
809-681
5.00 Ac.
W.&D. HOWARD
19.142 Ac.??
477-338
690-183
720-764
3.&B. Byler
633-233
19.98 A
54.83 Ac.
M.E.&A. Miller
593-986
N.N. Hershberger
M.E. Sr.&K.A. Hall
6.50 A
580-345
E.&E. Miller
5.55 Ac.
F.&R. Hosmer
A B C D
E F G H
I J K L
M N O P
BURTON TWP
RELATIVE REPRESENTATION
TROY TOWNSHIP

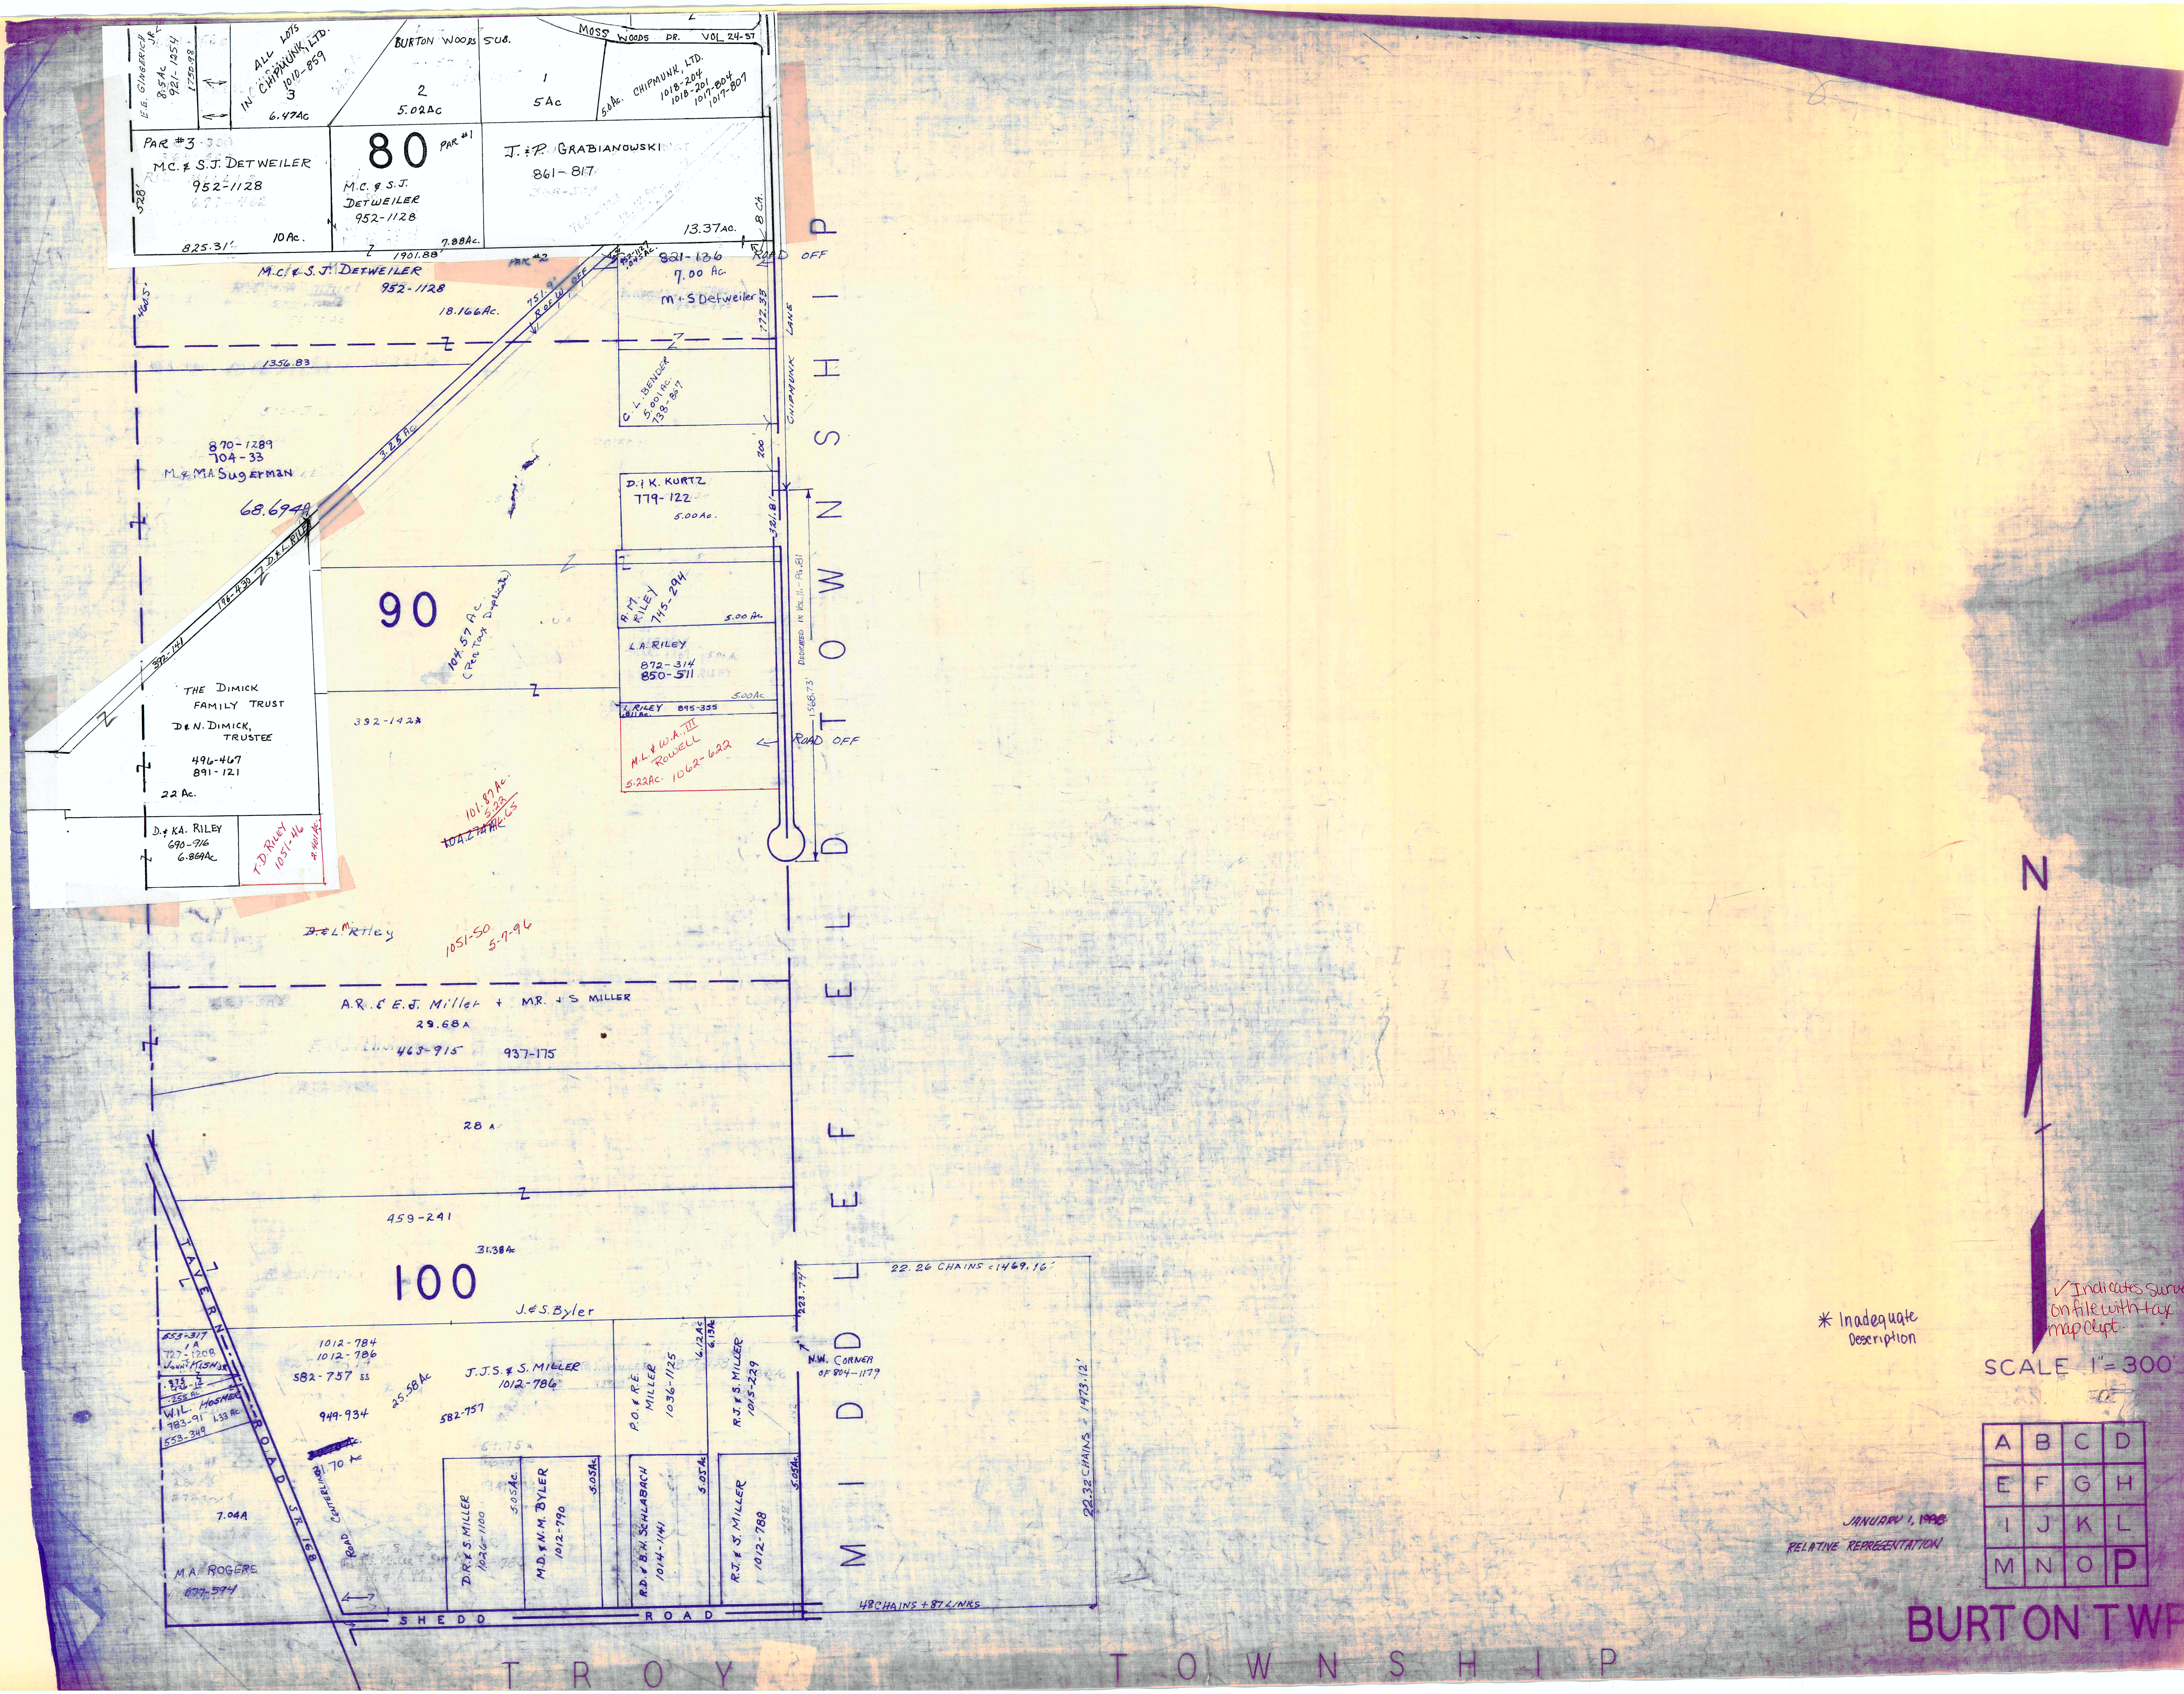
E.E. GINGERICH JR.
8.5Ac
921-1254
1750.98
ALL LOTS IN CHIPMUNK, LTD.
1010-859
3
6.47Ac
BURTON WOODS SUB.
2
5.02Ac
1
5Ac
MOSS WOODS DR.
VOL 24-57
5.0Ac.
CHIPMUNK, LTD.
1018-204
1018-201
1017-804
1017-807
PAR #3
M.C. & S.J. DETWEILER
952-1128
528'
10Ac.
825.31'
80
PAR #1
M.C. & S.J. DETWEILER
952-1128
7.88Ac.
1901.88'
J. & P. GRABIANOWSKI
861-817
13.37Ac.
8 Ch.
PAR #2
952-1127
.045Ac.
821-136
7.00 Ac.
m + S Detweiler
ROAD OFF
M.C. & S.J. DETWEILER
952-1128
18.166Ac.
751.9'
R OF W OFF
460.5'
1356.83
772.33
CHIPMUNK LANE
C.L. BENDER
5.001Ac.
738-867
3.25Ac.
870-1289
704-33
M.& M.A. Sugerman
68.6949
200
D. & K. KURTZ
779-122
5.00Ac.
321.81'
D. & L. RILEY
196-430
392-141
THE DIMICK FAMILY TRUST
D & N. DIMICK, TRUSTEE
496-467
891-121
22 Ac.
D. & KA. RILEY
690-916
6.869Ac
T.D. RILEY
1051-46
2.401Ac.
90
104.57 Ac.
(Rec Tax Duplicate)
392-142*
A.M. RILEY
745-294
5.00 Ac
L.A. RILEY
872-314
850-511
5.00Ac
L. RILEY 895-355
.811Ac.
M.L. & W.A. III ROWELL
5.22Ac. 1062-622
ROAD OFF
DEDICATED IN VOL.11.-PG.81
1568.73'
101.87Ac.
5.22
~~104.27Ac~~
.65
~~D.&~~ L.M. Riley
1051-50
5-7-96
A.R. & E.J. Miller + M.R. & S MILLER
29.68A
463-915
937-175
28A
459-241
31.38Ac
100
J. & S. Byler
22.26 CHAINS = 1469.16'
223.74'
553-317
1A
727-1208
JOHN J. KISH JR.
.375
936-12
.255Ac.
W.L. HOSMER
783-91
1.33Ac.
553-349
TAVERN ROAD SR 168
1012-784
1012-786
582-757 SS
25.58Ac
949-934
J.J.S. & S. MILLER
1012-786
582-757
~~[illegible]~~
1.70 Ac
ROAD CENTERLINE
7.04A
M.A. ROGERS
677-594
D.R. & S. MILLER
1026-1100
5.05Ac.
M.D. & N.M. BYLER
1012-790
5.05Ac.
P.O. & R.E. MILLER
1036-1125
6.12Ac
6.13Ac
R.D. & B.H. SCHLABACH
1014-1141
5.05Ac
R.J. & S. MILLER
1015-229
R.J. & S. MILLER
1012-788
5.05Ac.
N.W. CORNER OF 804-1179
22.32 CHAINS = 1473.12'
48 CHAINS + 87 LINKS
SHEDD ROAD
MIDDLEFIELD TOWNSHIP
TROY TOWNSHIP
N
A B C D
E F G H
I J K L
M N O P

* Inadequate Description

✓Indicates surve
on file with tax
map dept.

SCALE 1" = 300'

JANUARY 1, 1996
RELATIVE REPRESENTATION

BURTON TWP

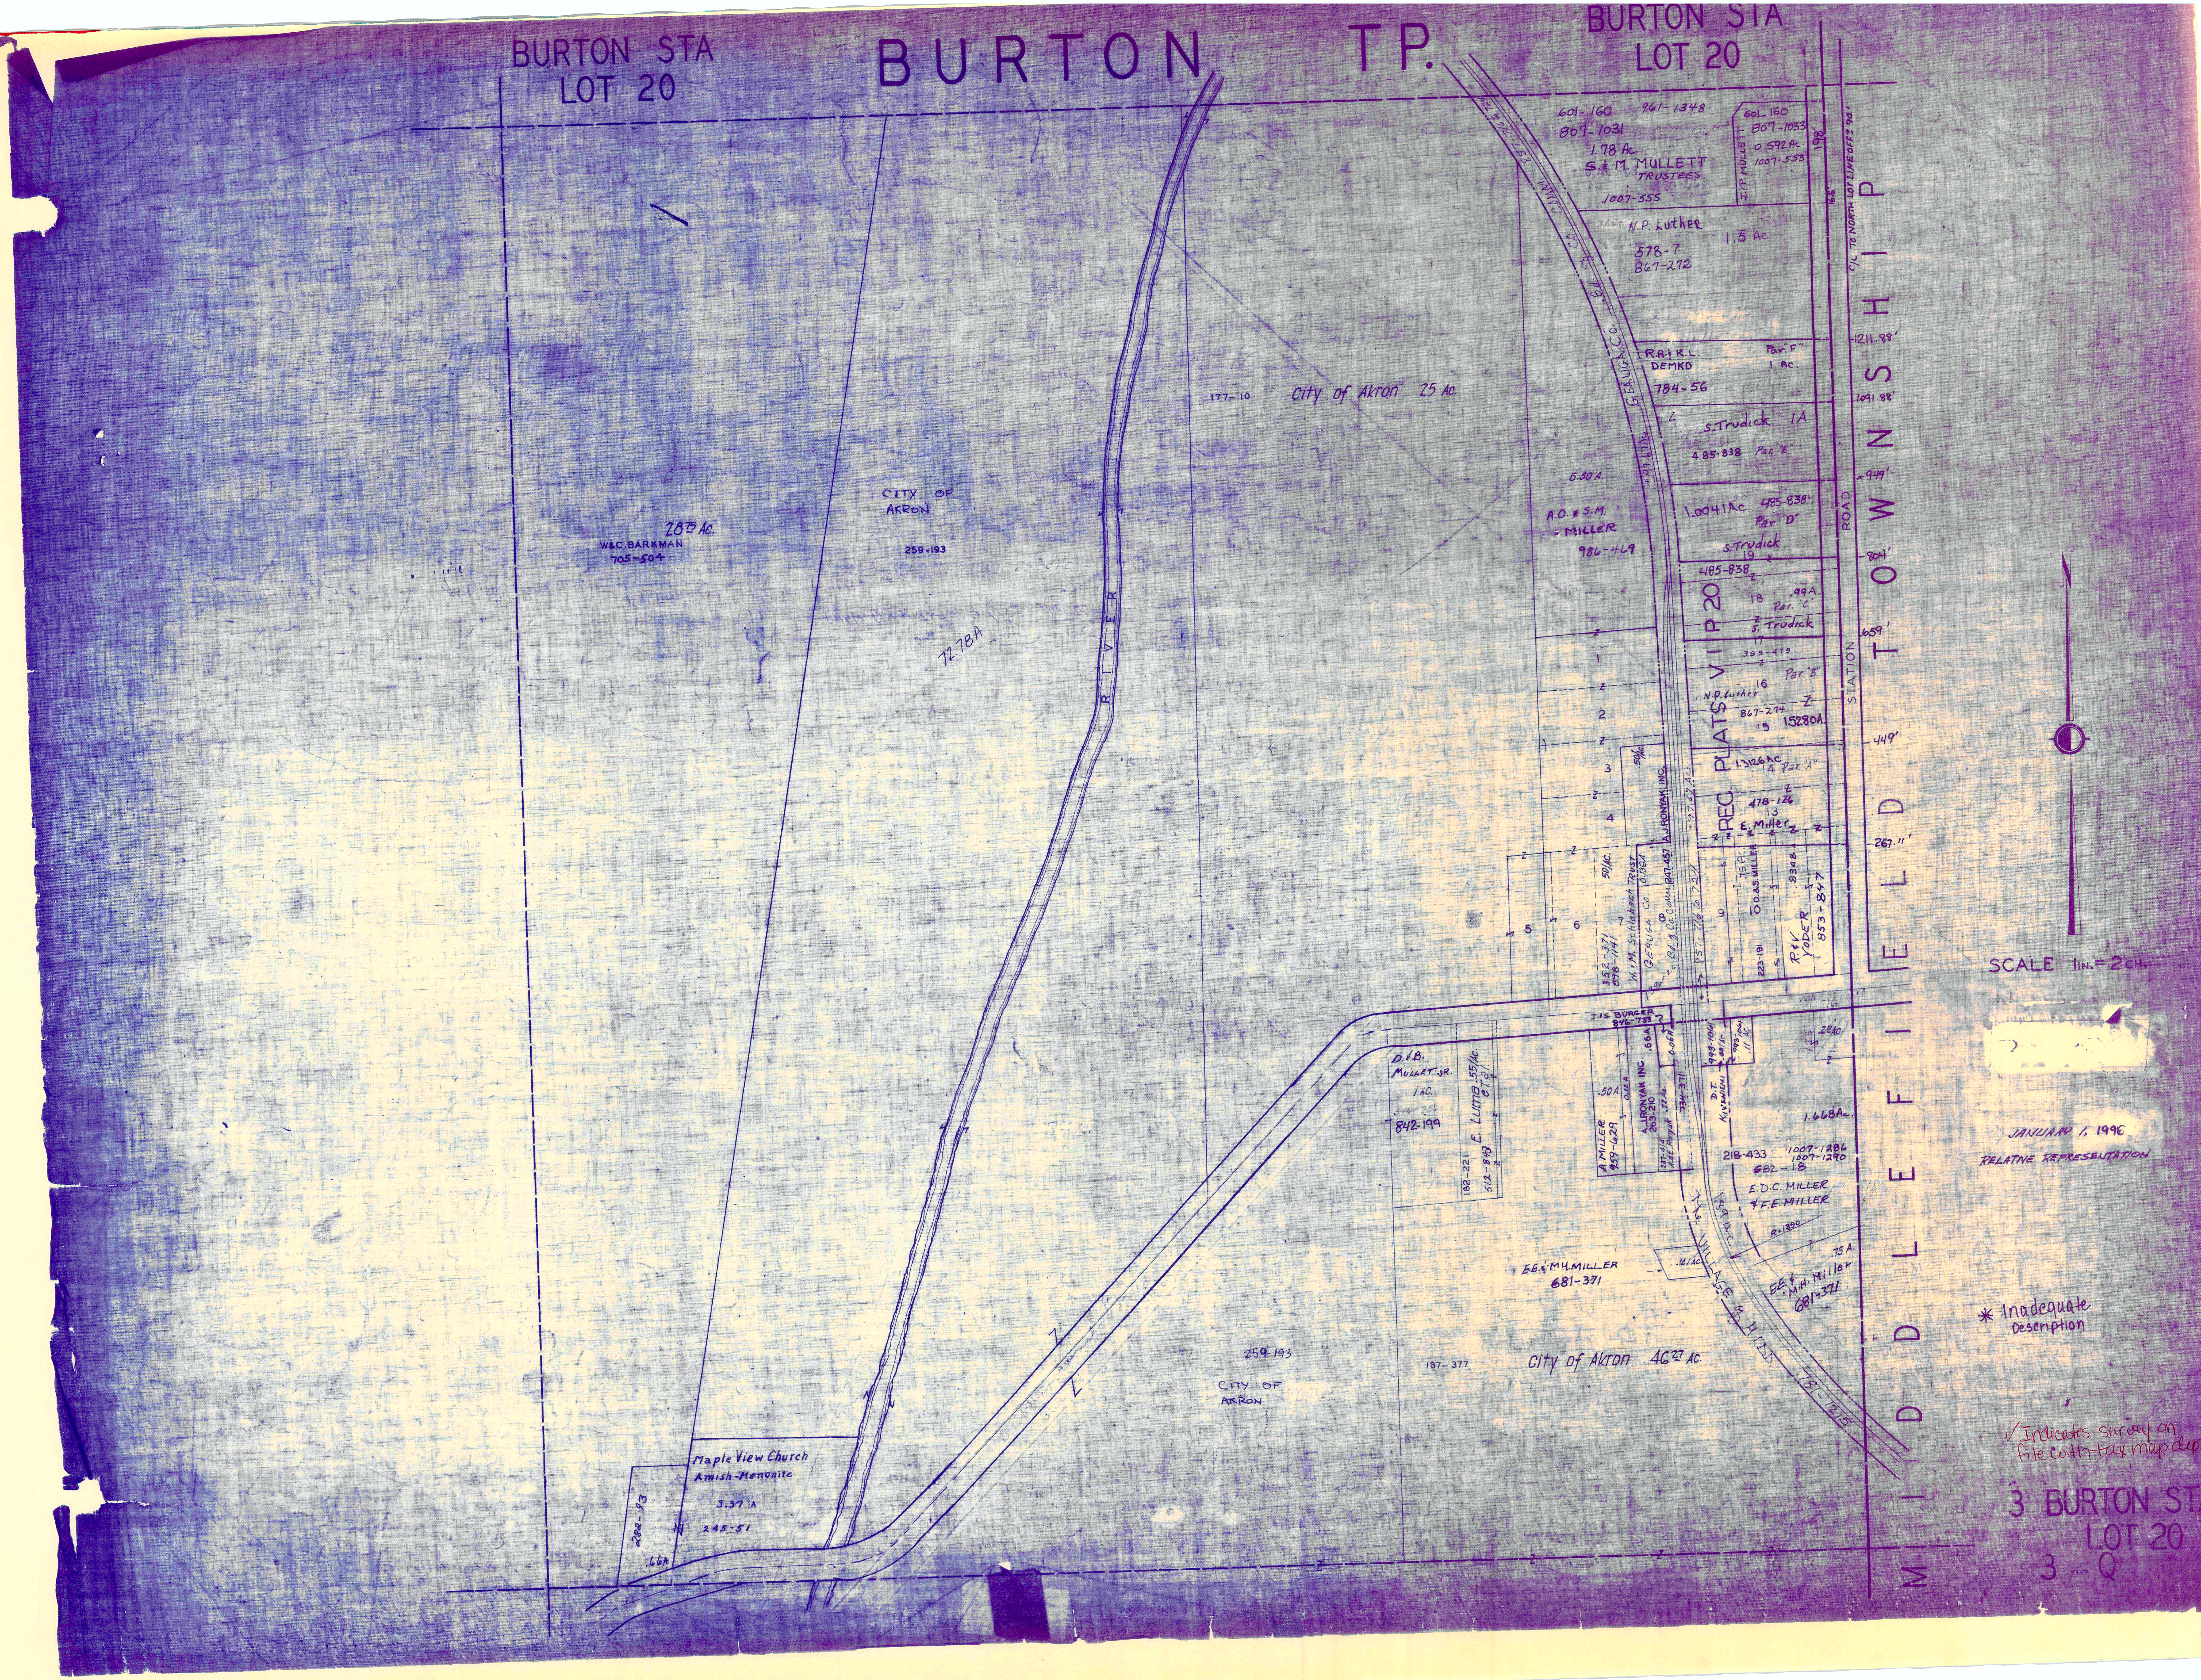
BURTON STA
LOT 20
BURTON TP.
BURTON STA
LOT 20
MIDDLEFIELD TOWNSHIP
STATION ROAD
C/L TO NORTH LOT LINE OFF = 90'
198'
16.5'
601-160
961-1348
807-1031
1.78 Ac.
S.& M. MULLETT
TRUSTEES
1007-555
601-160
807-1033
0.592 Ac.
1007-553
J.& P. MULLETT
N.P. Luther
1.5 Ac
578-7
867-272
R.A.& K.L.
DEMKO
Par. "F"
1 Ac.
784-56
1211.88'
1091.88'
S.Trudick 1A
485-838 Par. "E"
949'
1.0041Ac 485-838
Par "D"
S.Trudick
19
804'
485-838
18 .99A.
Par. "C"
S. Trudick
17
659'
399-479
Par. "B"
16
N.P. Luther
867-274
15 15280A.
449'
1.3126 AC
14 Par. "A"
478-126
13
E. Miller
267.11'
REC. PLATS VI P 20
GEAUGA CO. Bd. of CO. COMM.
857-716 & 724
97.67 AC
6.50 A.
A.O. & S.M.
MILLER
986-469
1
2
3
4
5
6
7
8
9
10
50/AC.
352-371
898-1141
W.& M. Schlabach TRUST
0.136A
247-457
A.J.RONYAK INC.
10 0.& S. MILLER
.150 Ac
223-191
.8348
R.& V. YODER
853-847
J.& S. BURGER
846-733
D.& B.
MULLET JR.
1 AC.
842-199
E. Luma .55/AC. et al
182-221
512-843
.50A.
A. MILLER
959-629
.66A
A.J.RONYAK INC.
263-210
0.06A
.22 Ac.
A.& E. Ronyak
734-371
993-1061
.08/Ac
993-1061
.11 AC
D.T. Kivuniemi
.22 AC.
1.668 Ac.
218-433
1007-1286
1007-1290
682-18
E.D.C. MILLER
& F.E. MILLER
R=1390
.75 A
E.E. & M.H. Miller
681-371
.14/AC
1.89 AC
The VILLAGE of MIDD
781-1215
E.E. & M.H. MILLER
681-371
City of Akron 25 Ac.
177-10
CITY OF
AKRON
259-193
W.& C. BARKMAN
28.75 AC.
705-504
72.78A
RIVER
City of Akron 46.27 AC.
187-377
259-193
CITY OF
AKRON
Maple View Church
Amish-Menonite
3.37 A
245-51
282-93
.66A

SCALE 1 IN.= 2 CH.

JANUARY 1, 1996

RELATIVE REPRESENTATION

* Inadequate Description

✓ Indicates survey on file with tax map dep

3 BURTON STA
LOT 20
3 - Q

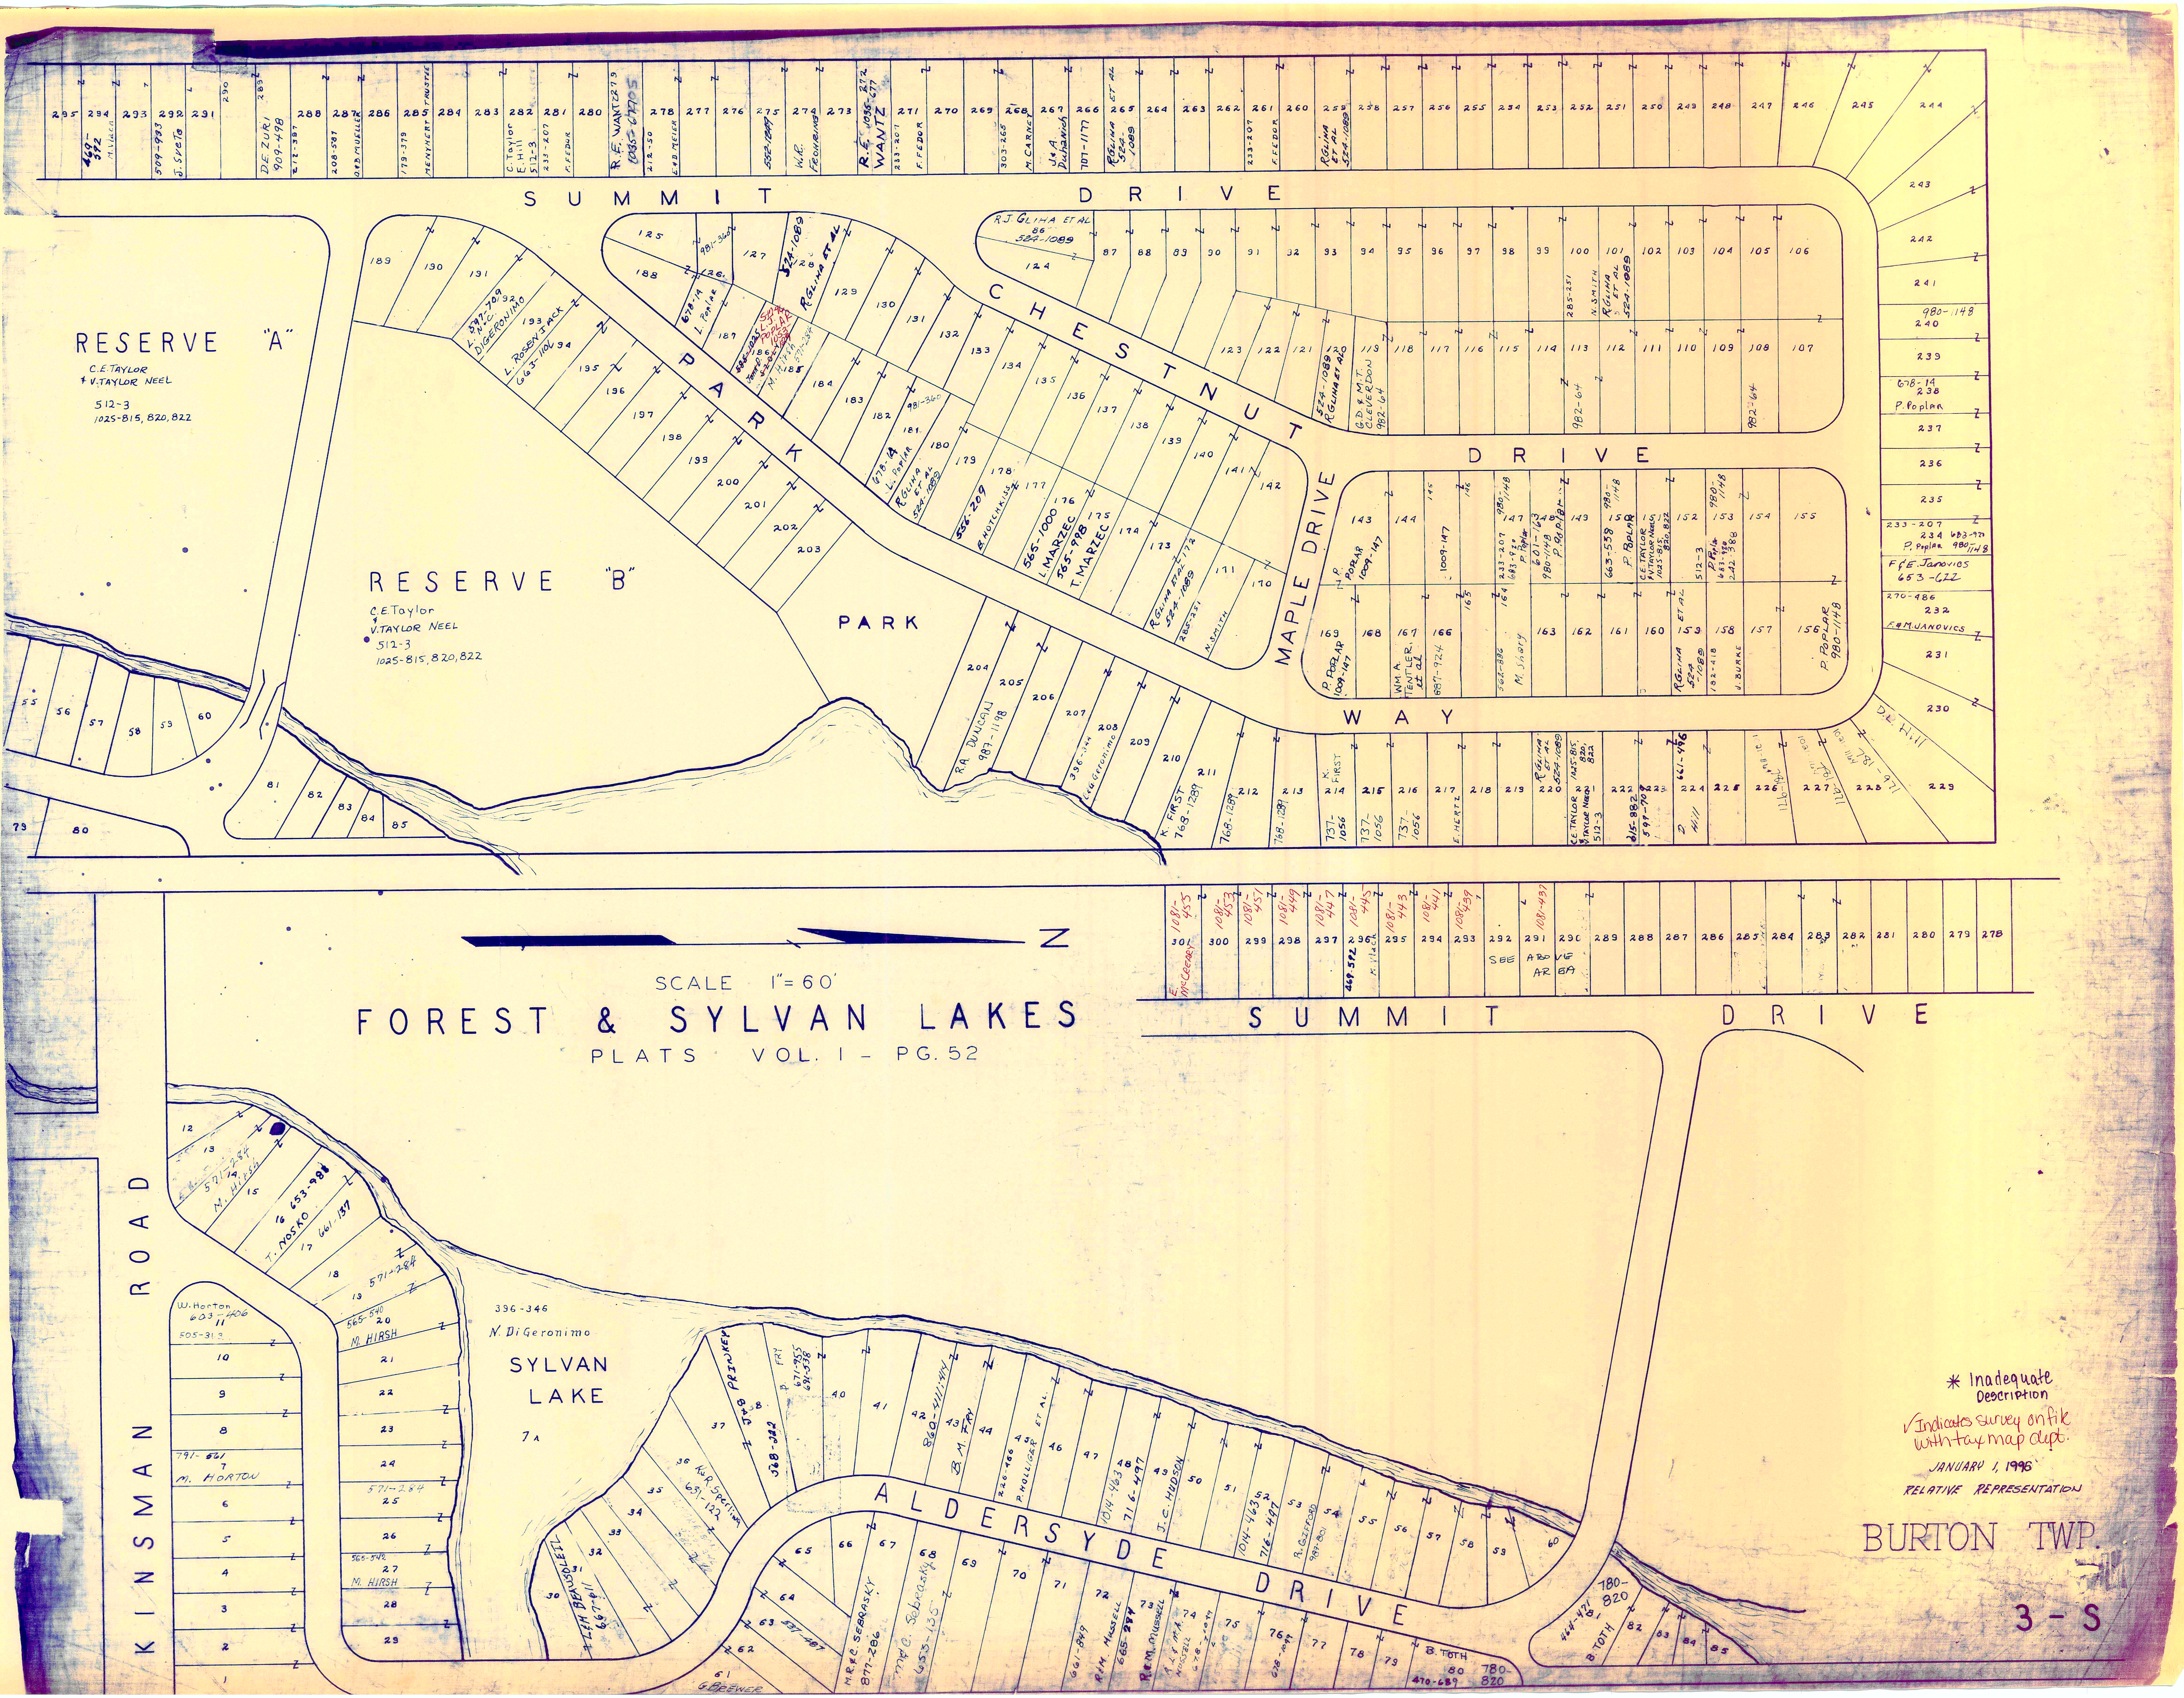

SCALE 1" = 60'

FOREST & SYLVAN LAKES

PLATS VOL. 1 - PG. 52

* Inadequate Description

√ Indicates survey on file with tax map dept.

JANUARY 1, 1996

RELATIVE REPRESENTATION

BURTON TWP.

3 - S

SUMMIT DRIVE
CHESTNUT DRIVE
PARK WAY
MAPLE DRIVE
RESERVE "A"
C.E. TAYLOR
& V. TAYLOR NEEL
512-3
1025-815, 820, 822
RESERVE "B"
C.E Taylor
& V. TAYLOR NEEL
512-3
1025-815, 820, 822
PARK
SUMMIT DRIVE
KINSMAN ROAD
SYLVAN LAKE
7A
396-346
N. Di Geronimo
ALDERSYDE DRIVE
N
SEE ABOVE AREA
R.E. WANTZ 279
1035-677
DE ZURI
909-498
R.E. WANTZ
1035-272
R.J. GLIHA ET AL
524-1089
L. ROSENJACK
663-1106
L. DIGERONIMO
547-709
R.A. DUNCAN
987-1198
L. MARZEC
565-1000
T. MARZEC
565-998
K. FIRST
768-1289
F&E Janovics
653-622
P. Poplar
980-148
M. HIRSH
571-284
T. NOSKO
653-988
W. Horton
653-406
M. HORTON
791-621
B.M. FRY
860-411
J.C. HUDSON
716-497
B. TOTH
780-820
G. BREWER
M.R. & C. SEBRASKY
877-286

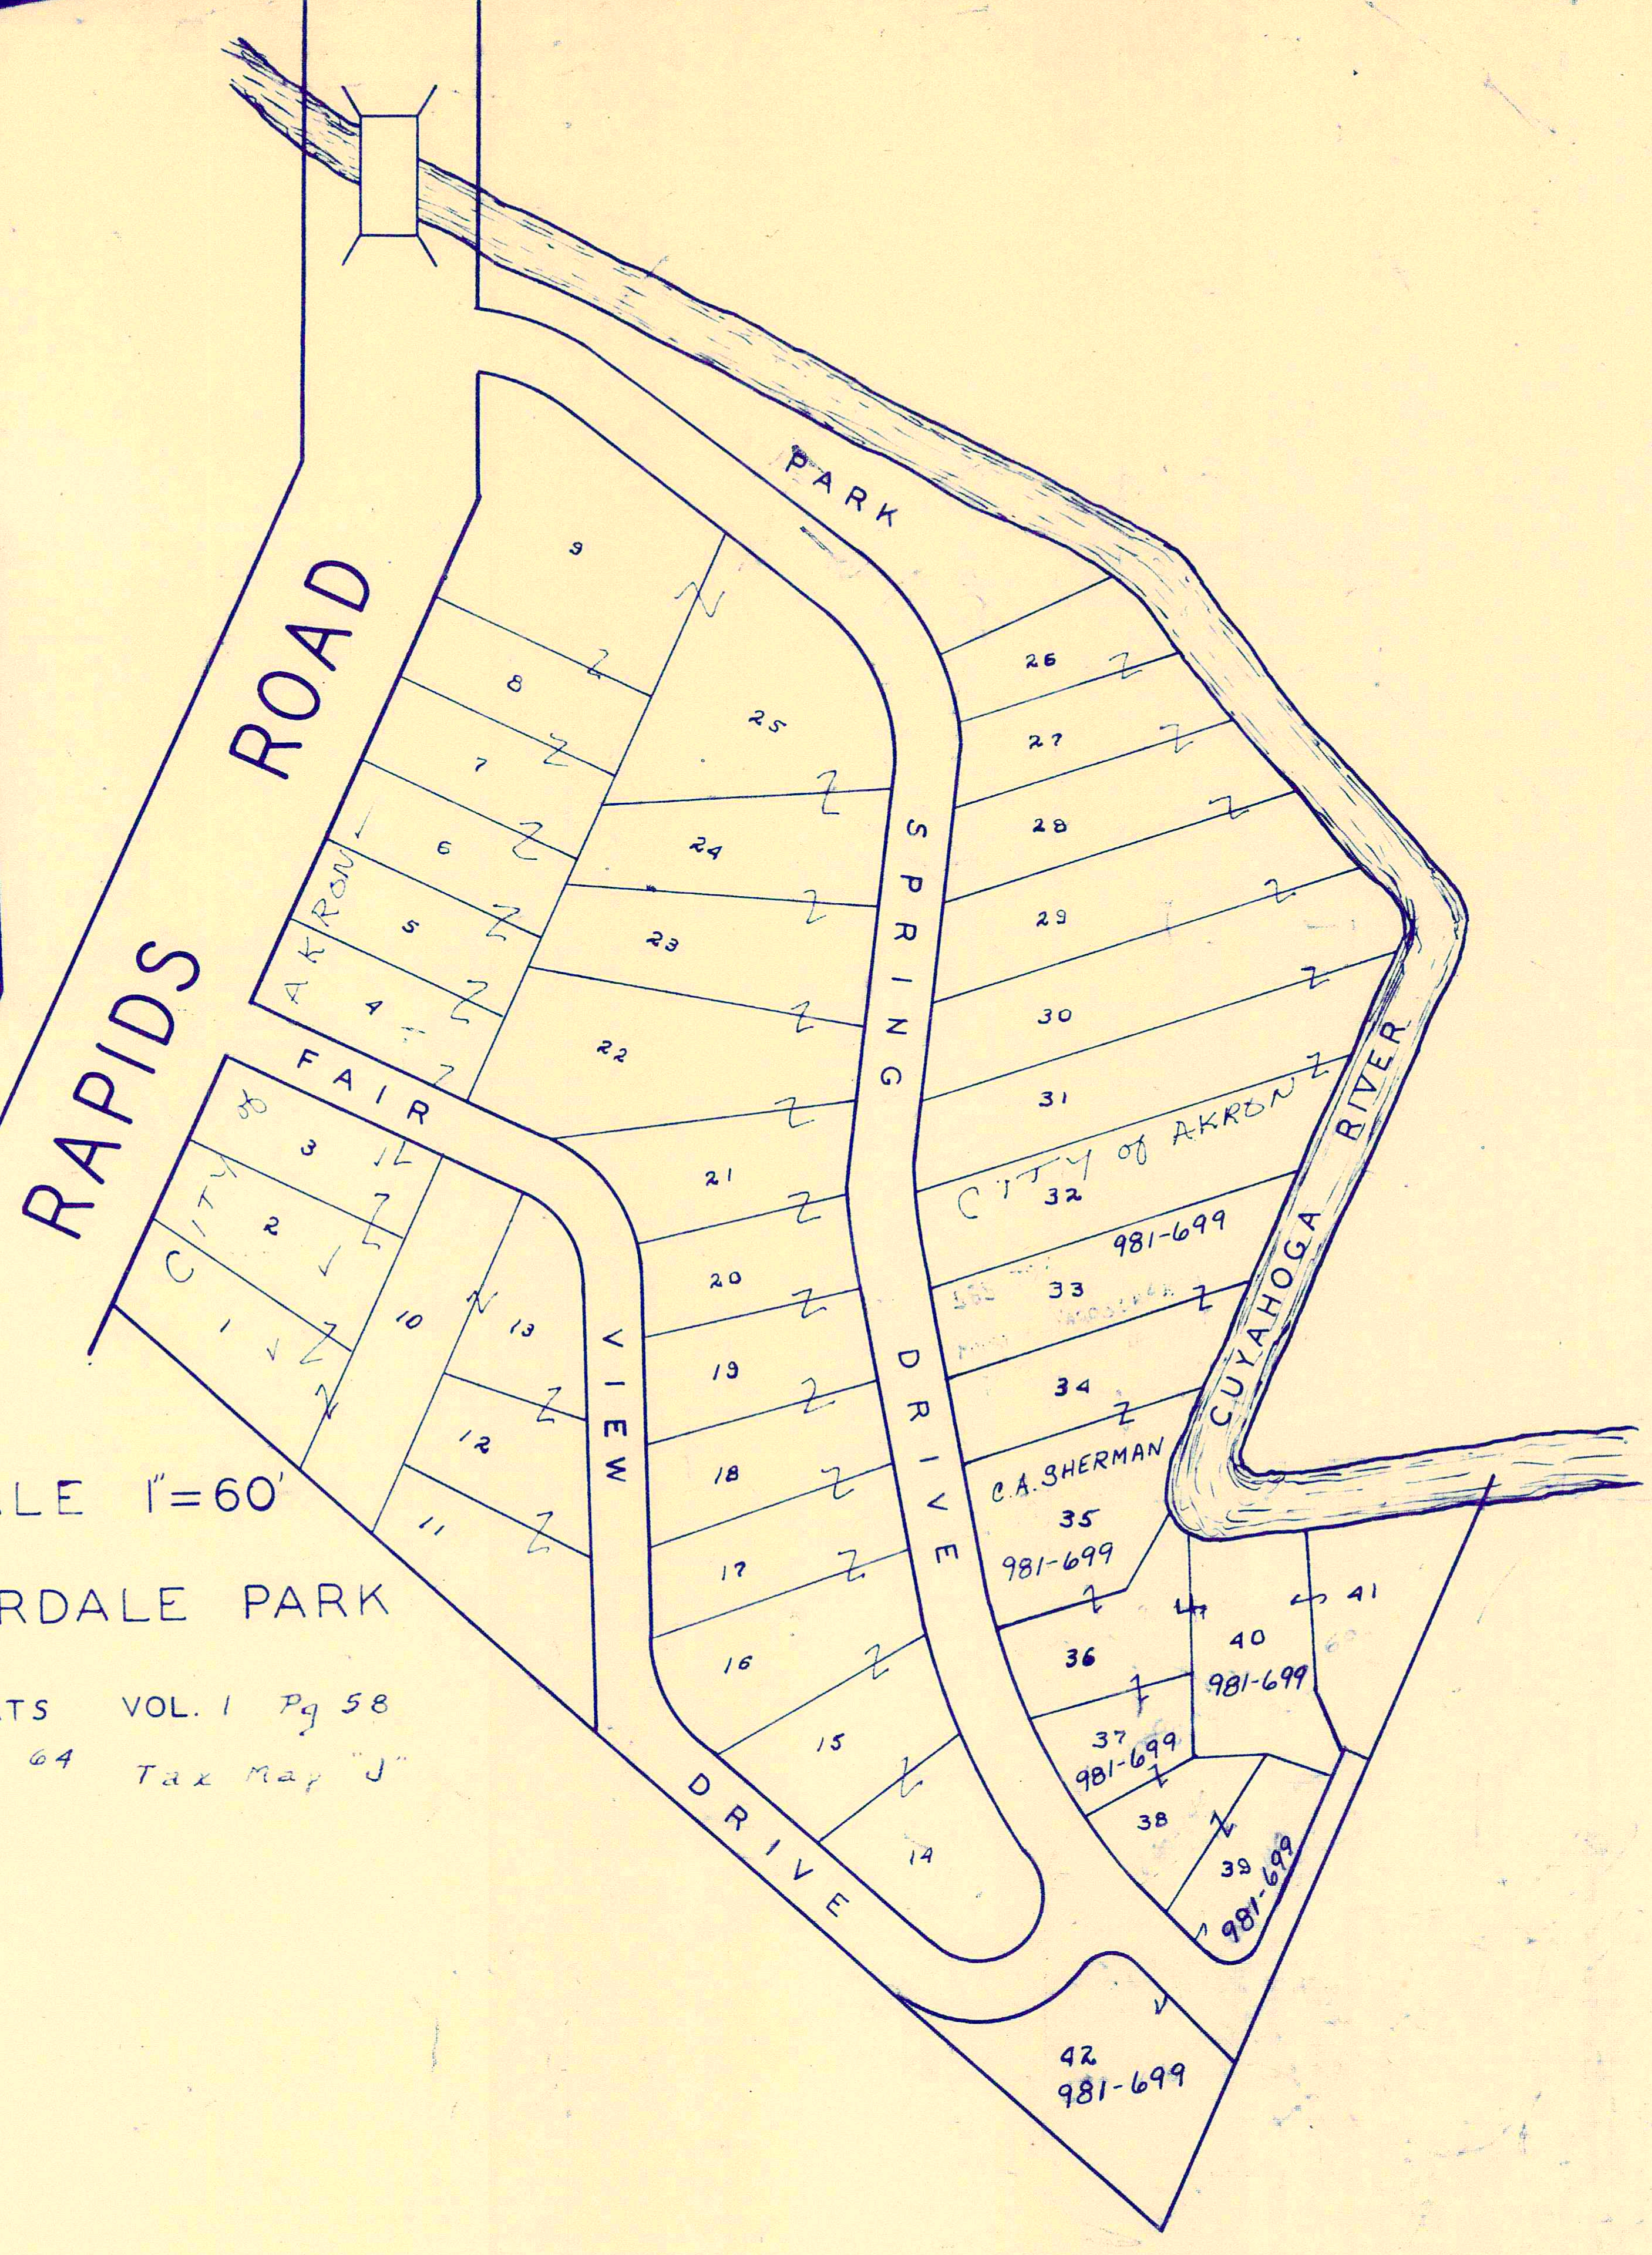
RAPIDS ROAD
PARK
SPRING DRIVE
FAIR VIEW DRIVE
CUYAHOGA RIVER
City of Akron
City of Akron
1
2
3
4
5
6
7
8
9
10
11
12
13
14
15
16
17
18
19
20
21
22
23
24
25
26
27
28
29
30
31
32
981-699
33
34
C.A. SHERMAN
35
981-699
36
37
981-699
38
39
981-699
40
981-699
41
42
981-699

SCALE 1"=60'

RIVERDALE PARK

PLATS VOL. 1 Pg 58

Lot 64 Tax Map "J"

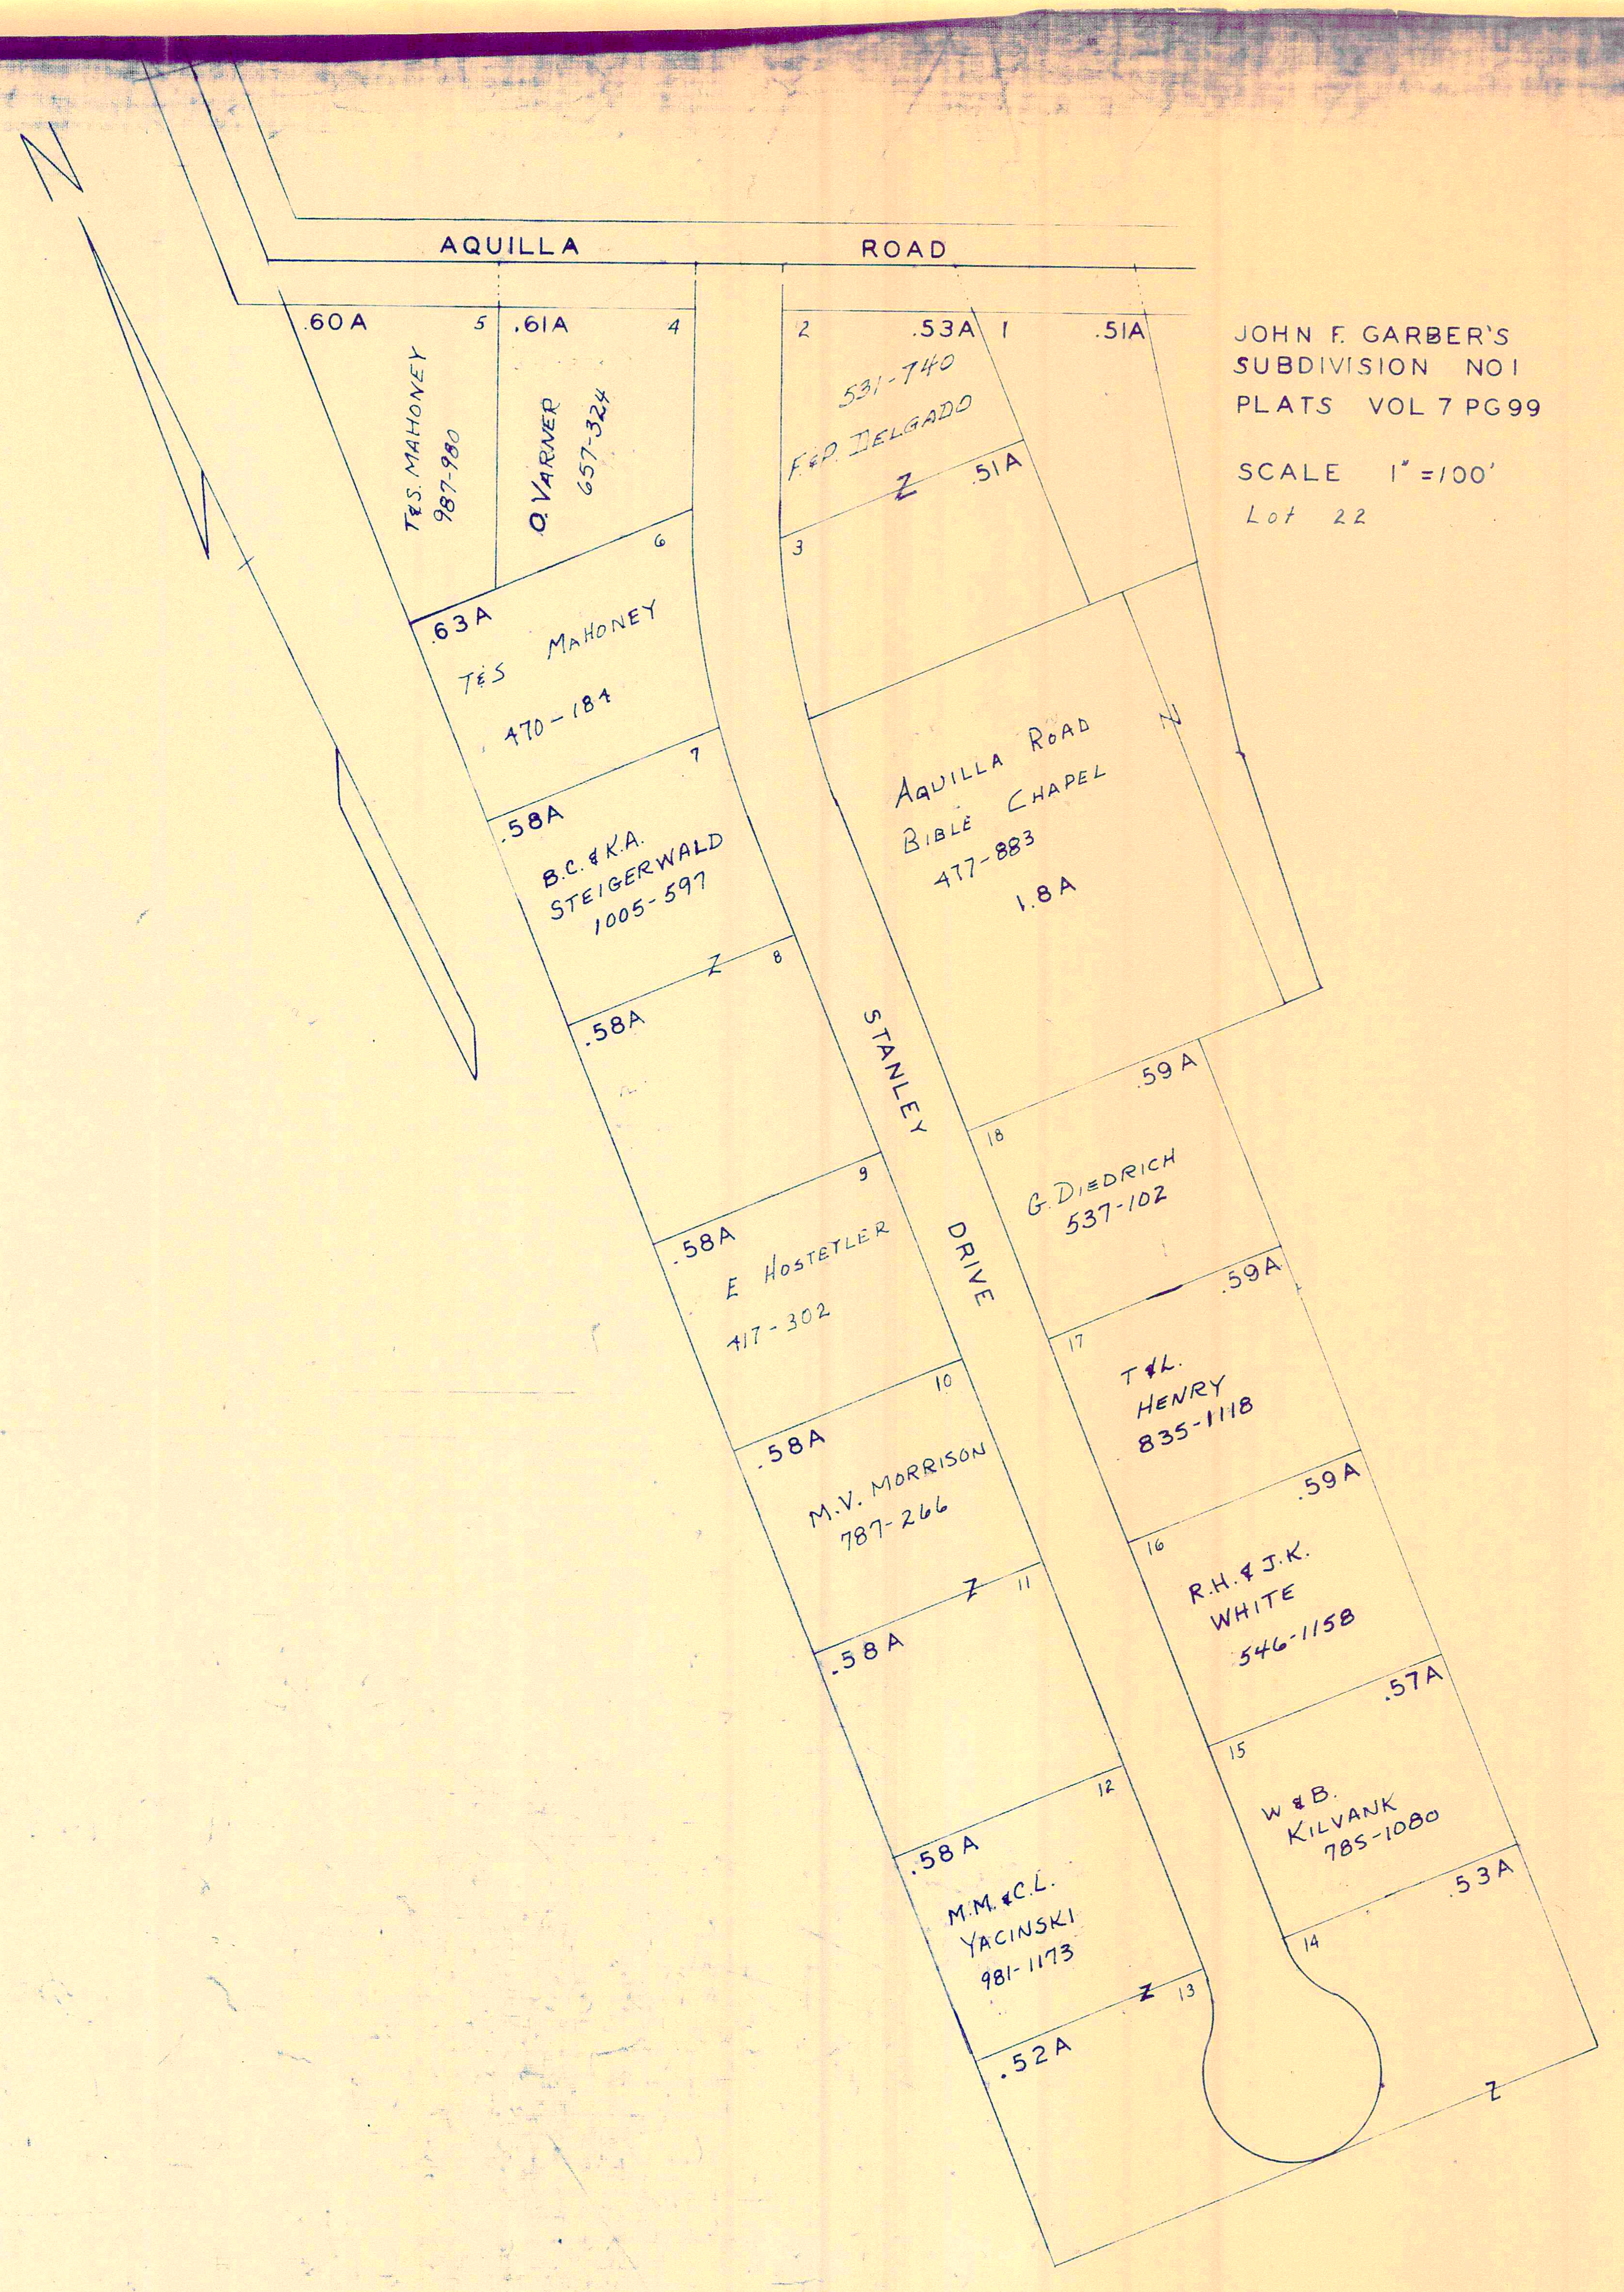
AQUILLA ROAD
STANLEY DRIVE
N
.60A
5
T&S. MAHONEY
987-980
.61A
4
O. VARNER
657-324
2
.53A
1
.51A
531-740
F&P. DELGADO
.51A
3
6
.63A
T&S MAHONEY
470-184
7
.58A
B.C.&K.A.
STEIGERWALD
1005-597
AQUILLA ROAD
BIBLE CHAPEL
477-883
1.8A
8
.58A
9
.58A
E HOSTETLER
417-302
18
.59A
G. DIEDRICH
537-102
17
.59A
T&L.
HENRY
835-1118
10
.58A
M.V. MORRISON
787-266
16
.59A
R.H.&J.K.
WHITE
546-1158
11
.58A
15
.57A
W&B.
KILVANK
785-1080
12
.58A
M.M.&C.L.
YACINSKI
981-1173
14
.53A
13
.52A

JOHN F. GARBER'S
SUBDIVISION NO 1
PLATS VOL 7 PG 99

SCALE 1"=100'

Lot 22

✓ Indicates survey on file with tax map dept.

✱ Inadequate Description

JANUARY 1, 1996

RELATIVE REPRESENTATION

BURTON TWP.

3 T

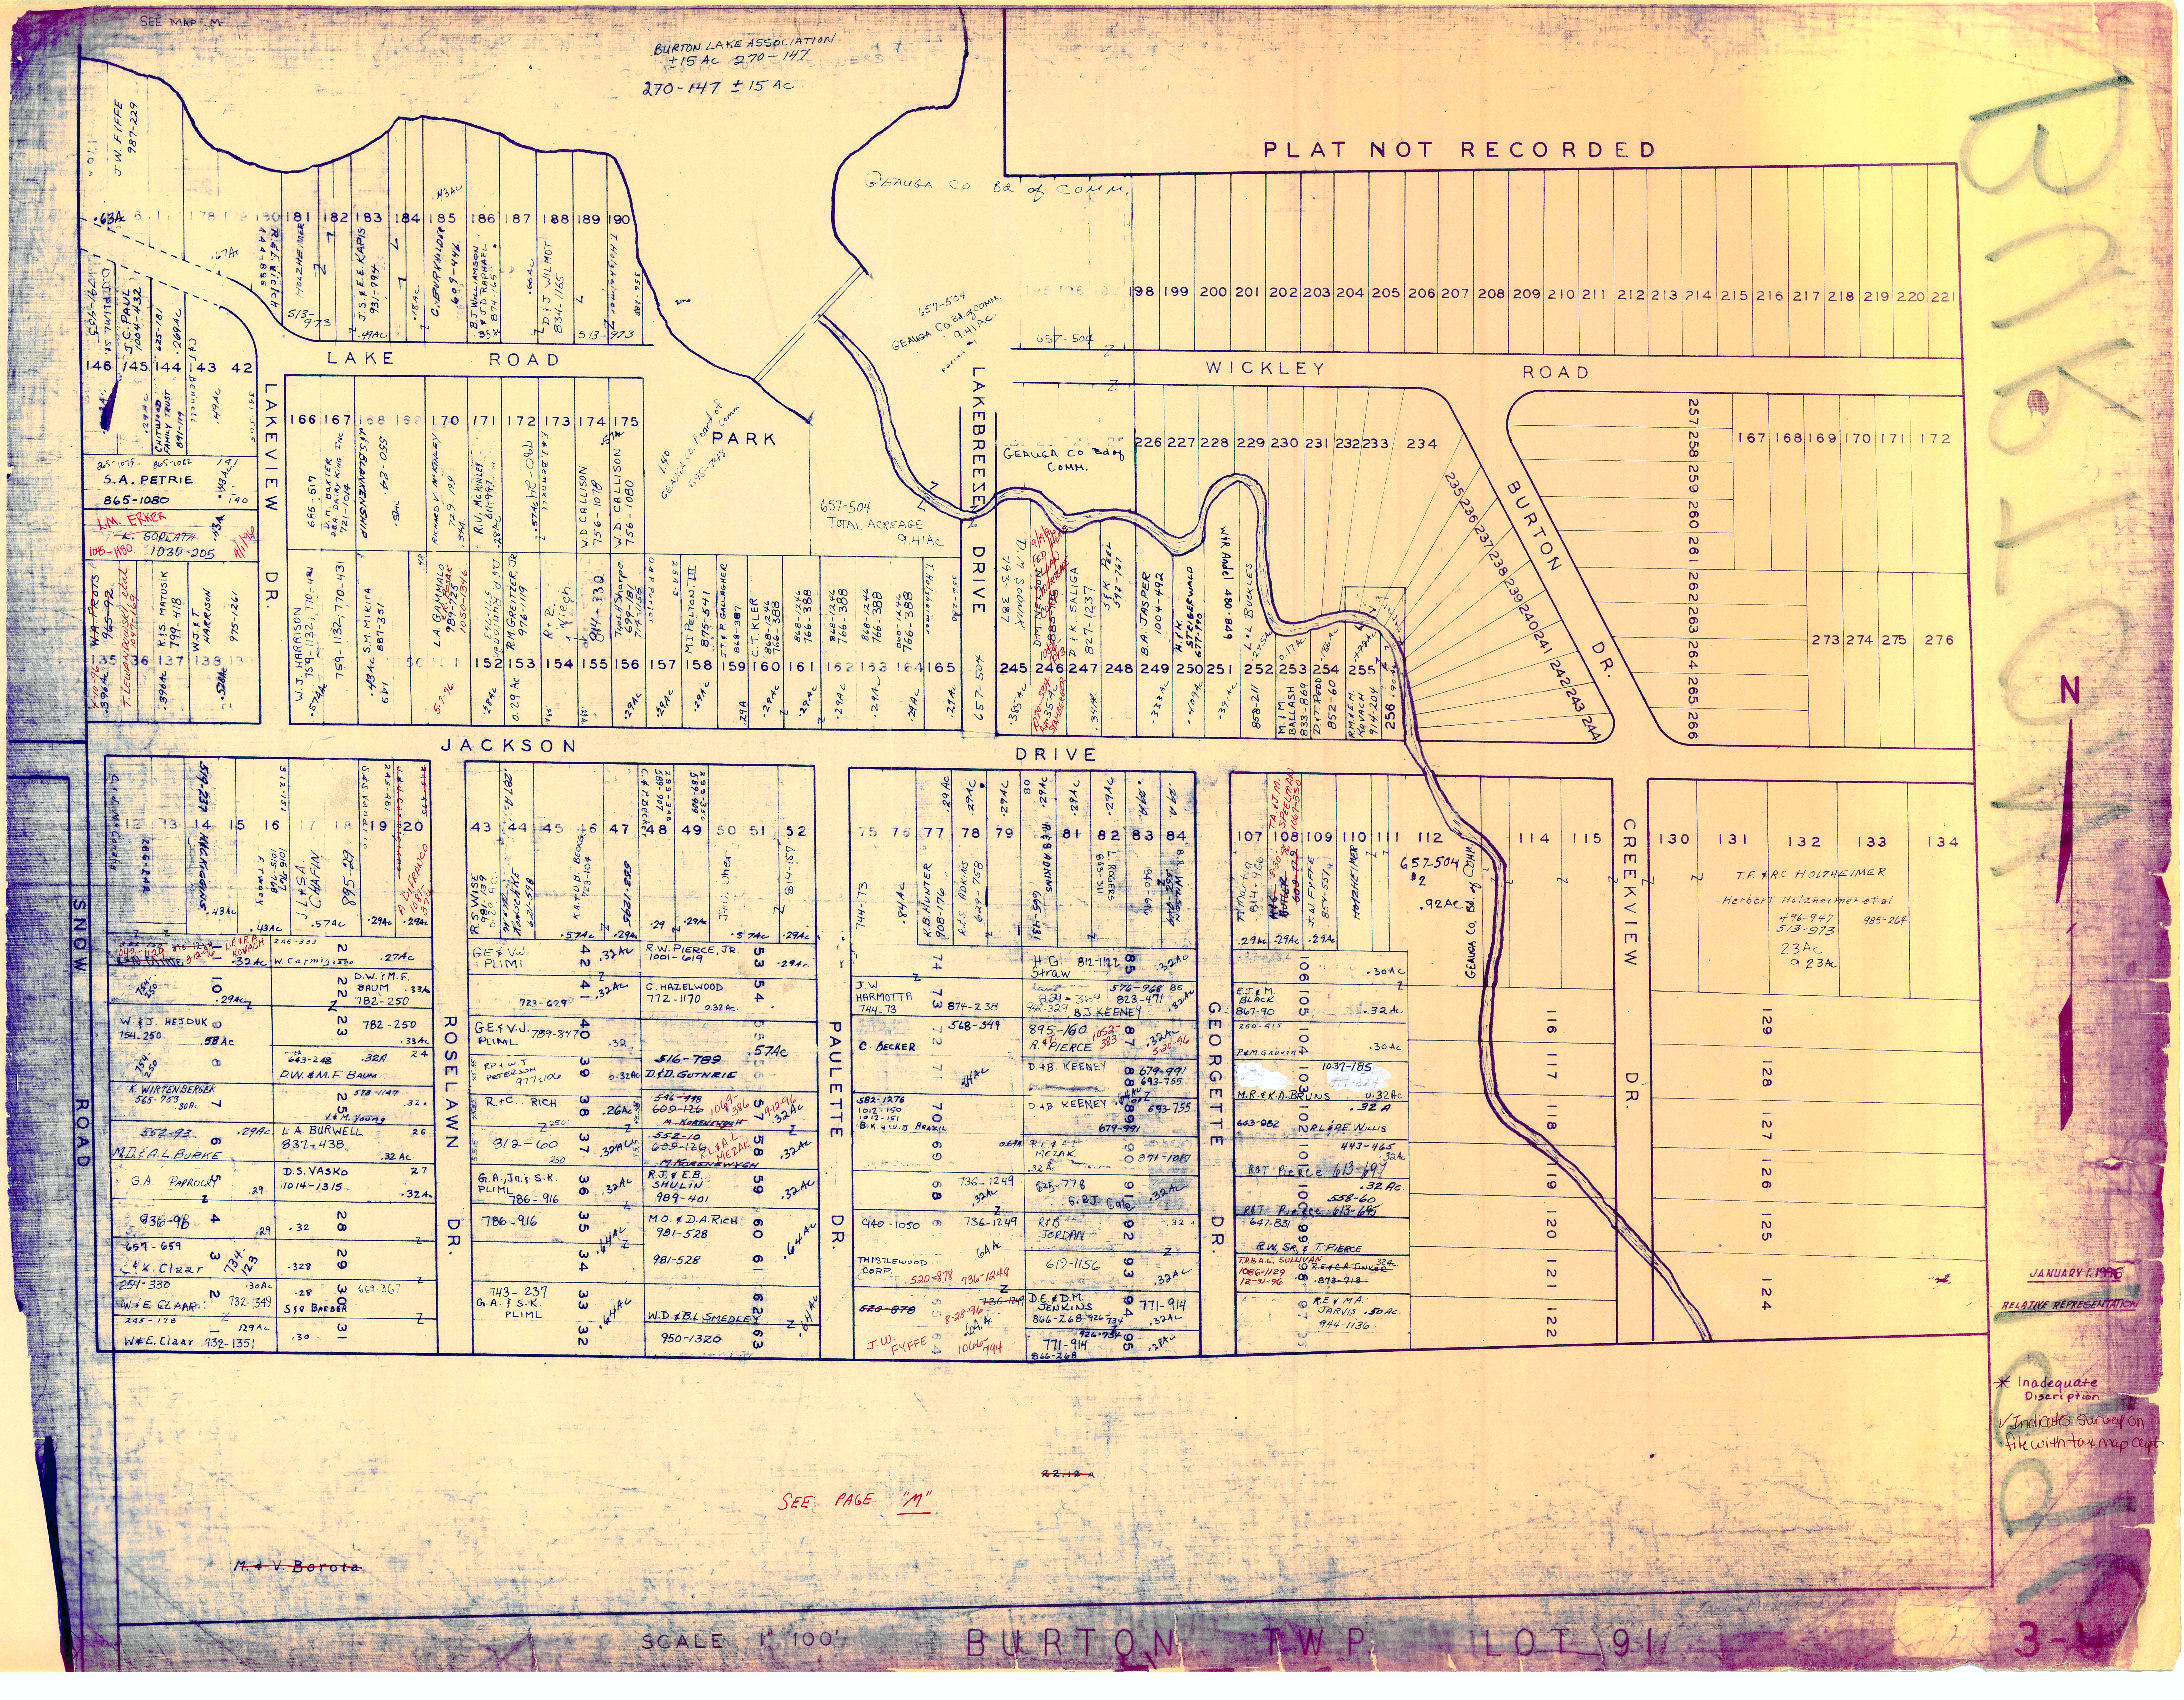
SEE MAP M
BURTON LAKE ASSOCIATION ±15 Ac 270-147
270-147 ±15 Ac
PLAT NOT RECORDED
GEAUGA CO Bd of COMM.
LAKE ROAD
WICKLEY ROAD
LAKEVIEW DR.
LAKEBREEZE DRIVE
BURTON DR.
PARK
657-504 TOTAL ACREAGE 9.41AC
JACKSON DRIVE
SNOW ROAD
ROSELAWN DR.
PAULETTE DR.
GEORGETTE DR.
CREEKVIEW DR.
J.W. FYFFE 987-229
J.C. PAUL 1004-432
S.A. PETRIE 865-1080
K.M. ERKER
L. GORLATA 1030-205
J.S.&E.E. KAPIS 931-994
L.D.&J. VILMOT 834-1165
W.D. CALLISON 756-1080
M.I. PELTON III 875-541
C.T. KLER
D.&K. SALIGA 827-1237
B.A. JASPER 1004-492
W.J. HARRISON 759-1182, 770-431
L.A. GAMMALO
R.M. GREITZER, JR. 976-119
W.A. PROTS 965-92
K.B. HUNTER 908-176
J.&S.A. CHAFIN 895-62
R.S. WISE
R.W. PIERCE, JR. 1001-619
GE&VJ PLIML
C. HAZELWOOD 772-1170
D.W.&M.F. BAUM 782-250
W.&J. HEJDUK 754-250
K. WIRTENBERGER 565-759
D.&D. GUTHRIE 516-789
M. KORENKEVICH
R.J.&E.B. SHULIN 989-401
M.O.&D.A. RICH 981-528
W.D.&B.L. SMEDLEY 950-1320
L.A. BURWELL 837-438
M.II&A.L. BURKE
D.S. VASKO 1014-1315
G.A. PAPROCKI
W.&E. CLAAR 732-1349
W.&E. Claar 732-1351
S.&O. BARBER
J.W. HARMOTTA 744-73
C. BECKER
B.K.&V.J. BOZZIL
THISTLEWOOD CORP.
J.W. FYFFE
H.G. Straw
B.J. KEENEY
R. PIERCE
D.&B. KEENEY
R.L.&A.L. MEZAK
G.B.J. Cole
R.&B. JORDAN
D.E.&D.M. JENKINS 866-268
E.J.&M. BLACK 807-90
P.&M. Gauvin
M.R.&K.A. BRUNS
R.L.&D.E. WILLIS
R.&T. Pierce
R.W. SR.&T. PIERCE
T.R.&A.L. SULLIVAN 1086-1129 12-31-96
R.E.&M.A. JARVIS 944-1136
T.F.&R.C. HOLZHEIMER
Herbert Holzheimer et al
657-504 #2 .92AC GEAUGA CO. Bd of COMM.
N
SEE PAGE "M"
M.&V. Borota
SCALE 1" 100'
BURTON TWP LOT 91
3-U
BURTON 3U

JANUARY 1, 1996

RELATIVE REPRESENTATION

* Inadequate Discription

✓ Indicates survey on file with tax map dept.