

LAKE COUNTY



CUYAHOGA COUNTY

SCALE 1"=300
JANUARY, 1995
RELATIVE REPRESENTATION

* Inadequate description

A	B	C	D
E	F	G	H
I	J	K	L
M	N	O	P








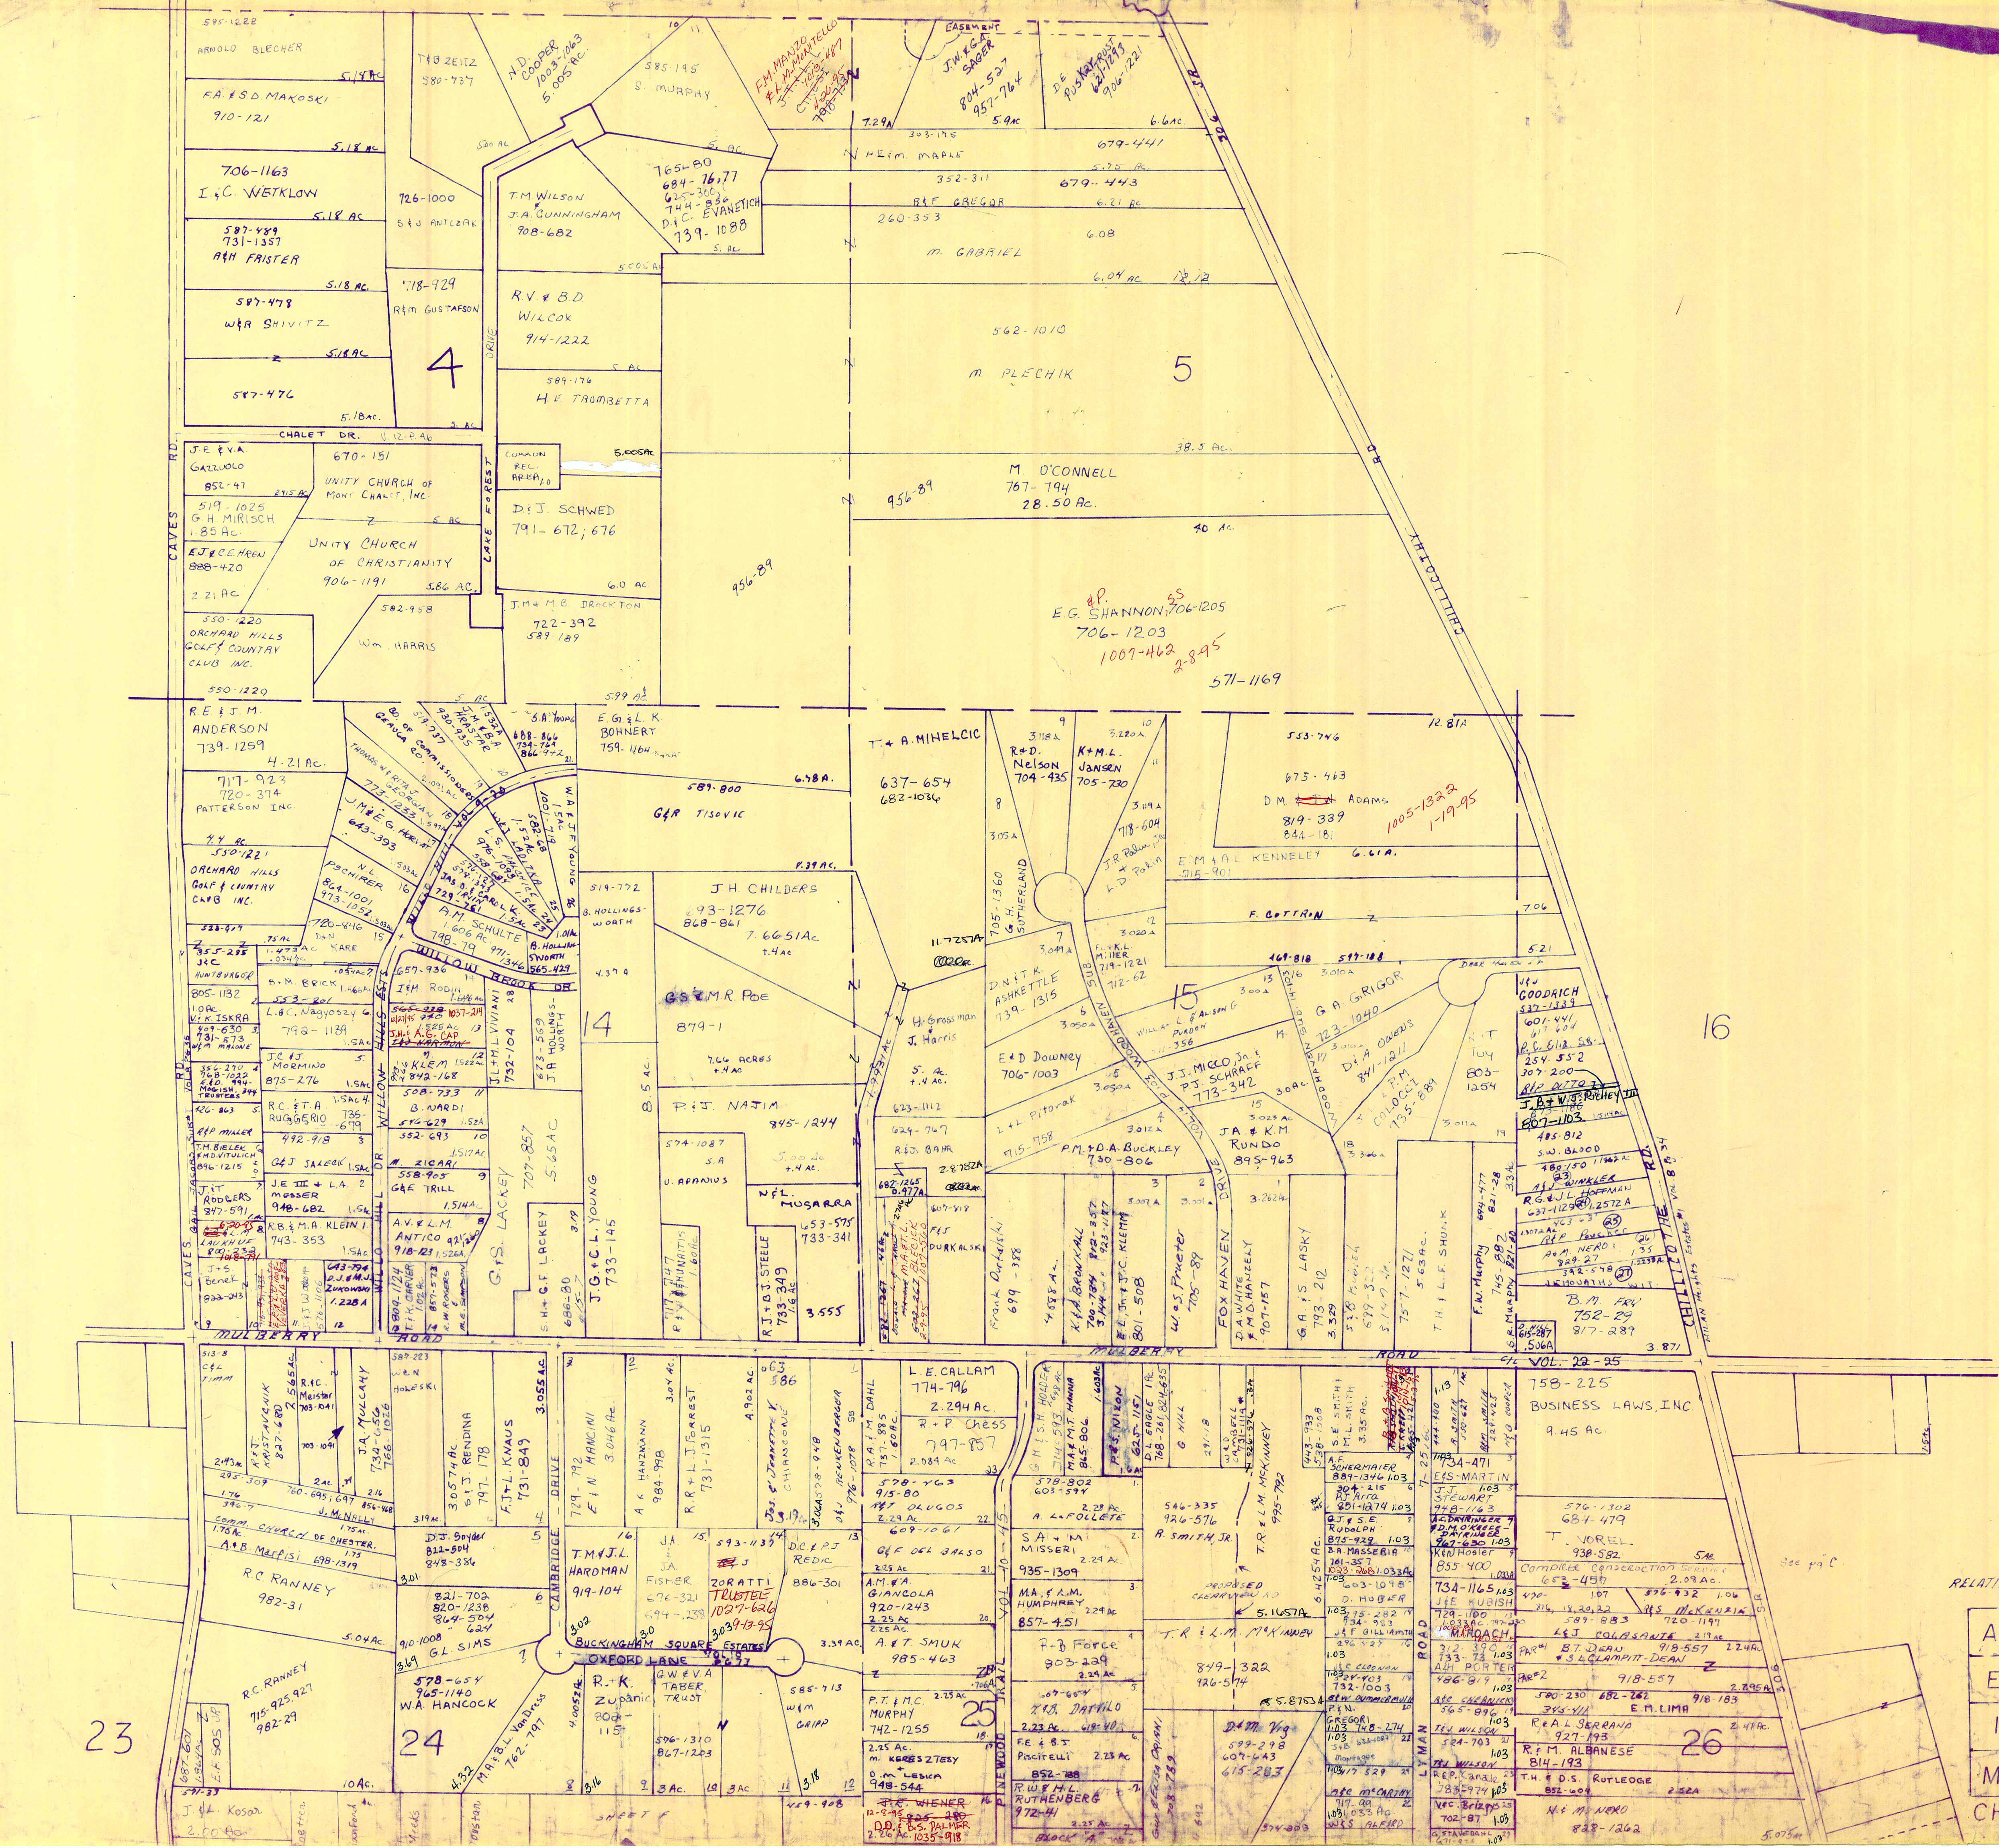

SCALE 1"=300'
 JANUARY 1, 1995

* Inadequate description

RELATIVE REPRESENTATION

A	B	C	D
E	F	G	H
I	J	K	L
M	N	O	P

CHESTER B

23

24


25

26

L A K E C O U N T Y

E SHARP SURVEY VOL 6-PC 103 (PLATS)

1	SENN M. SANICK	1081-933-1297
2	D. COCHELLA	263-208, 100-1040
3	SENN M. SANICK	409-979, 629-714
4	SENN M. SANICK	731-1002, 1000-353
5	B.L. HOLDER	413-786
6	F.M. MARRA	863-356
7	D. BLASIO	430-956, 111-335
8	VIT. IANARO	835-188
9	V. IANARO	635-245
10	A.B. WHITNEY	588-111, 828-168
11	A.B. TAYLOR	685-155, 940-466
12	J.T. SKIRO TRUST	351-243, 992-863
13	J.M. SMITH	550-377
14	S.J. PLA	878-600
15	M.C. KOVARIK	846-865
16	A.L.E. DIBARDO	752-187
17	C.T.S. G. BREZINA	284-279, 743-639
18	A.P.O. ORBANAU	822-1148
19	J.A. WARGELIN	780-464
20	W.A. COOPER	574-126
21	J.F. DUJMOVIC	681-233
22	J.A.D. BOZIC	484-981, 849-828
23	J.A.D. BOZIC	278-278
28	M.R. J. KOSLEY	834-1324
29	F. RUZIC	989-913, 732-229
30	C.E. HESMAN	661-1206, 750-336
31	G.U.M. REESE	447-270
32	G.A.M. REESE	464-217
33	M.P. HIESH	687-1202
34	P.W. DAVID & L.R. KLAUSS	897-184
35	T.A.A. METRUL	629-396
36	T.A.A. METRUL	675-684
37	D. WEY	W-20 #38, 519-80
38	D. CORCELLI (E-60)	793-1
39	K.W. HAASE & K.L. SMITH (W-40)	868-540
40	K.W. HAASE & K.L. SMITH	868-540
41	R.A. CALABRESE	917-1249
42	R.A. CALABRESE	917-1249
43	H.T.E.J. RACHENSKI	733-556
44	R.L. MLAKAR	870-1339
45	T.R. VERNON	997-278, 240-593
46	J.H. KRÄMER	784-493, 421-1014
47	G.W.S.L. STUHT	716-360
48	K.A. SCHAUER	951-1044
49	G.L. COX	784-475, 625-423
50	G.D. NODD	447-270
51	K.F. GREGOR & M. VALERKA	1068-2148
52	R.P. SHULTIS	733-448
53	N.C. GRASSI	619-54
54	R.K. SHISLA	557-266
55	R.K. SHISLA	557-266
56	B.S. STEBIC	1015-1010, 538-1094
57	M.A.E.P.J. PETTI	951-289
58	F.C. CARLO	512-492
59	E. SHARP	217-246
60	S.L. SHARP	735-751
61	A.G. MULLIKEN	823-251
62	R.G.M. SHARPLI & FRANCO	1015-530
63	E.S. IR-KIDDER LINCOLN TRUST	1015-530
64	G.D. WHITE & M. GRAF	1001-285
65	G.D. WHITE	915-637
66	J.A.A.D.L. BEARDRY	733-302
67	T. KEOLOVIC	736-1253

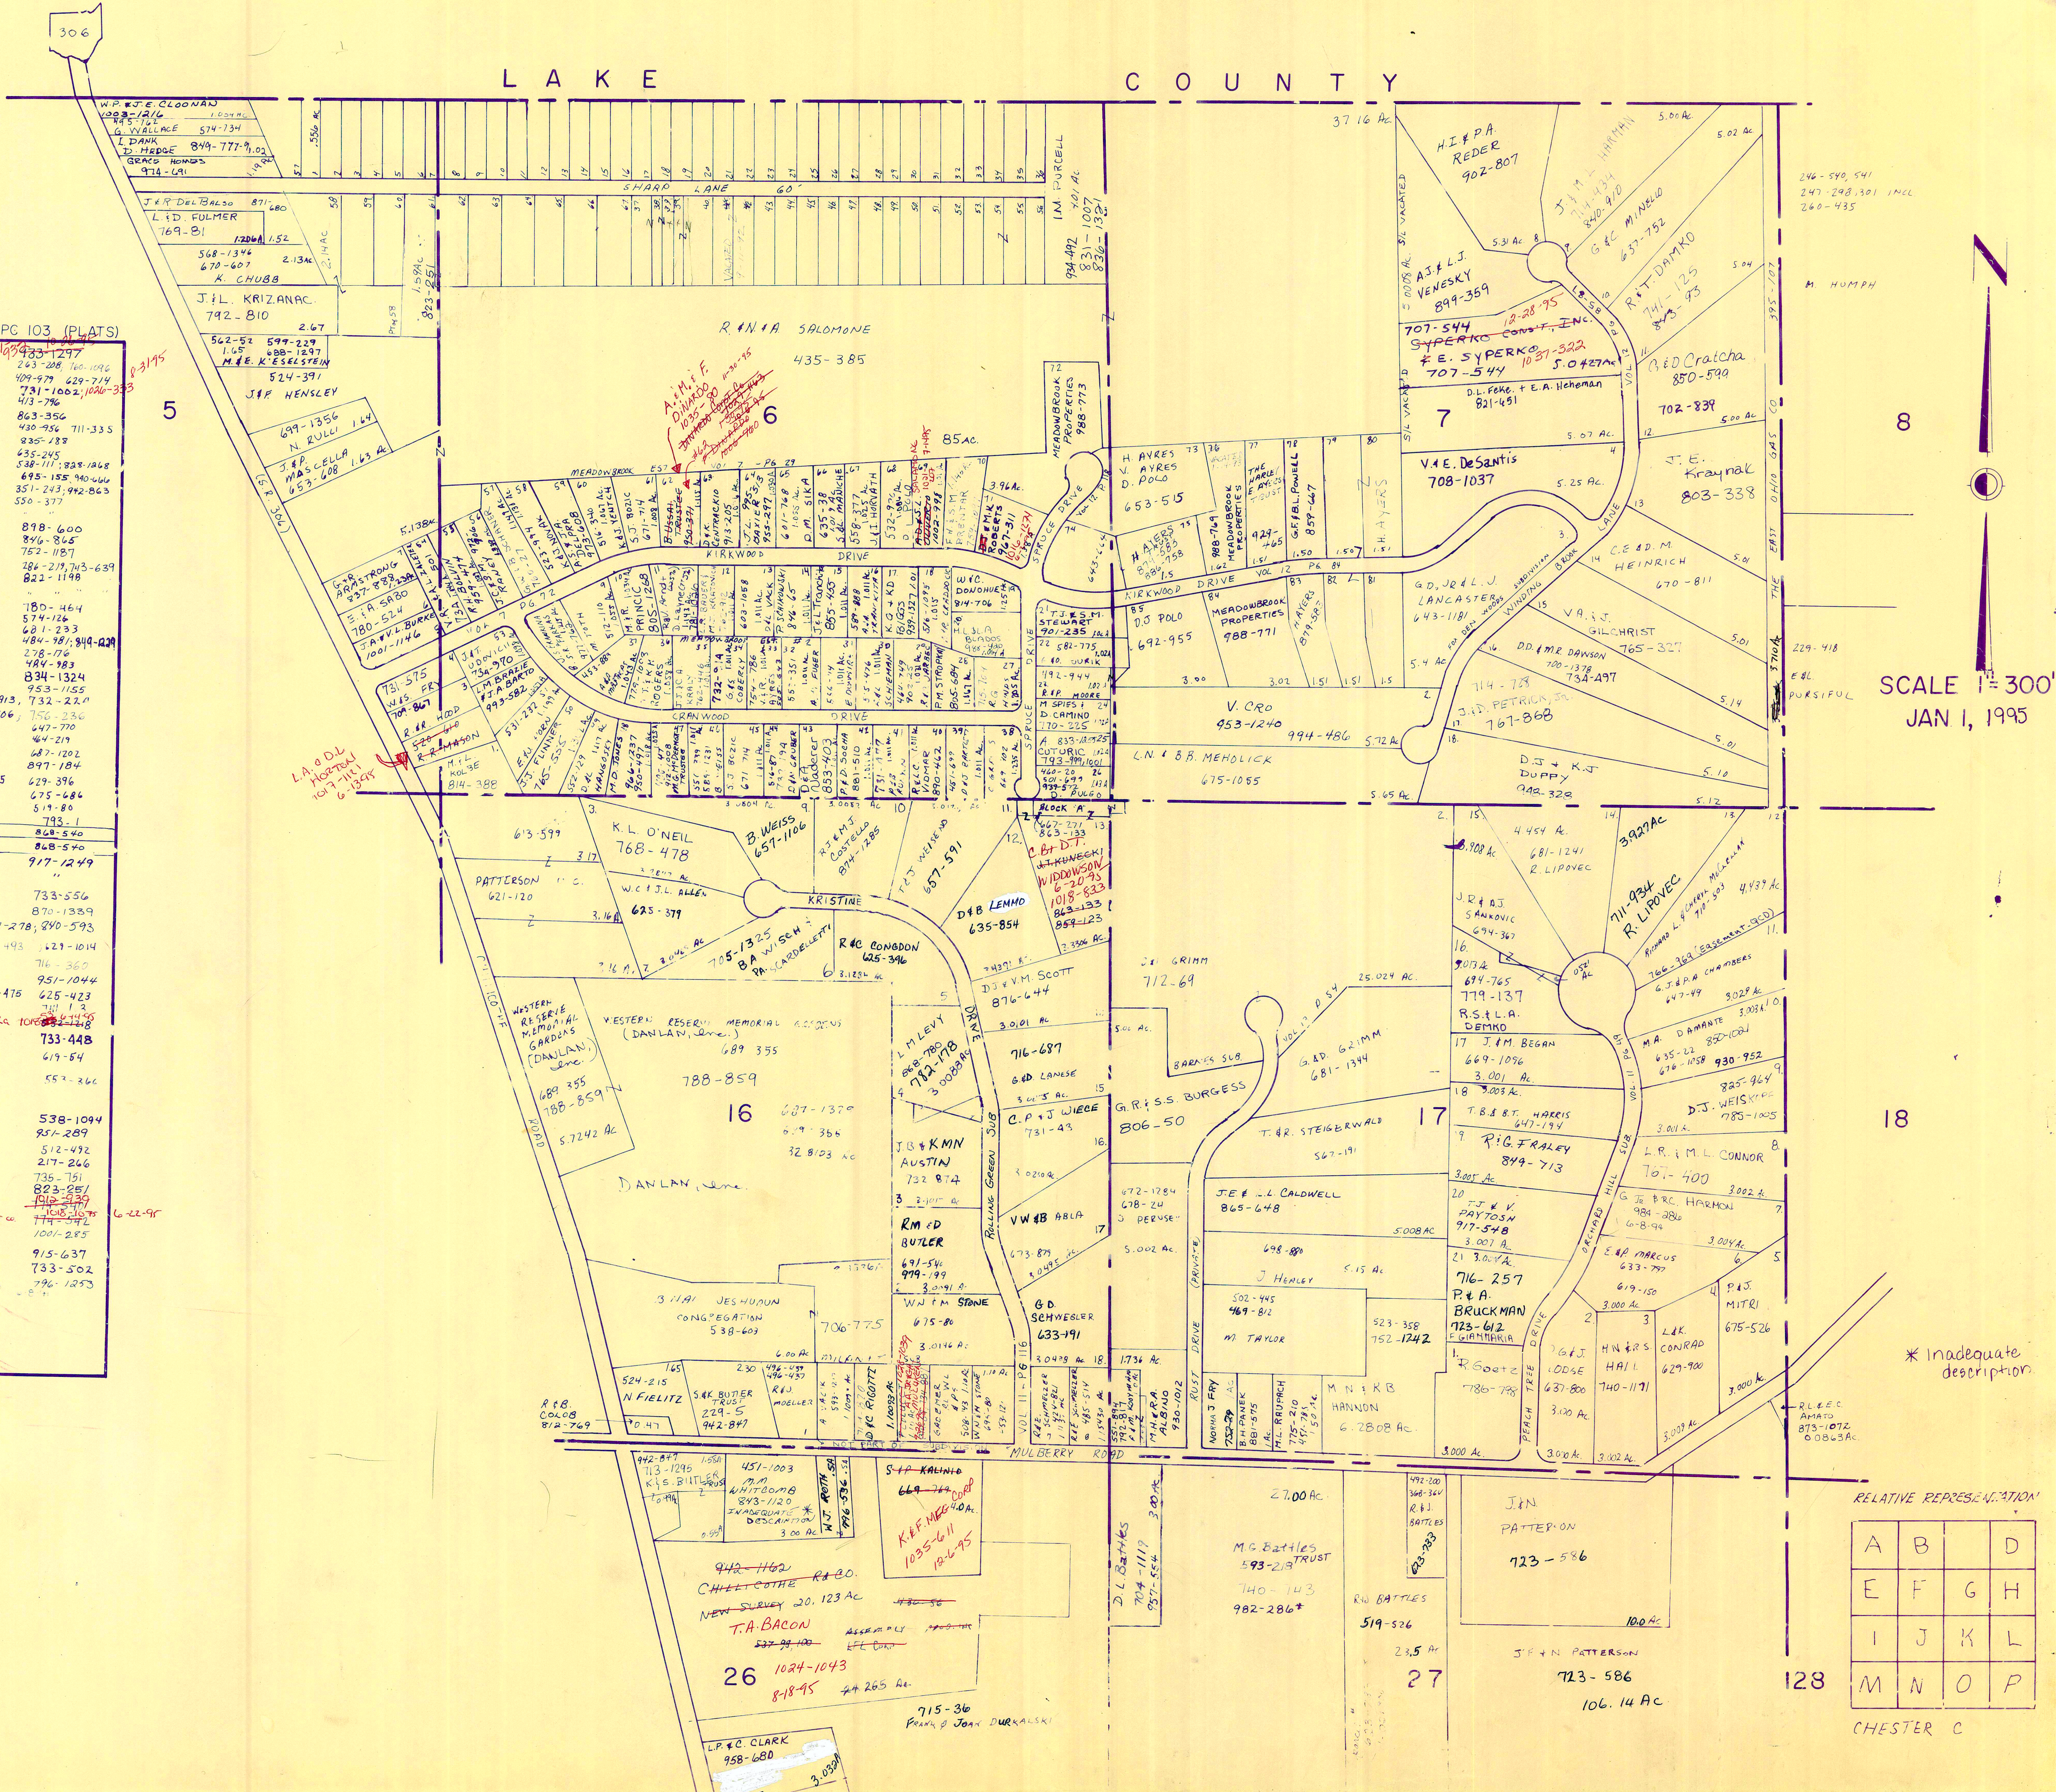


SCALE 1" = 300'
JAN 1, 1995

RELATIVE REPRESENTATION

A	B	C	D
E	F	G	H
I	J	K	L
M	N	O	P

CHESTER C

* Inadequate description

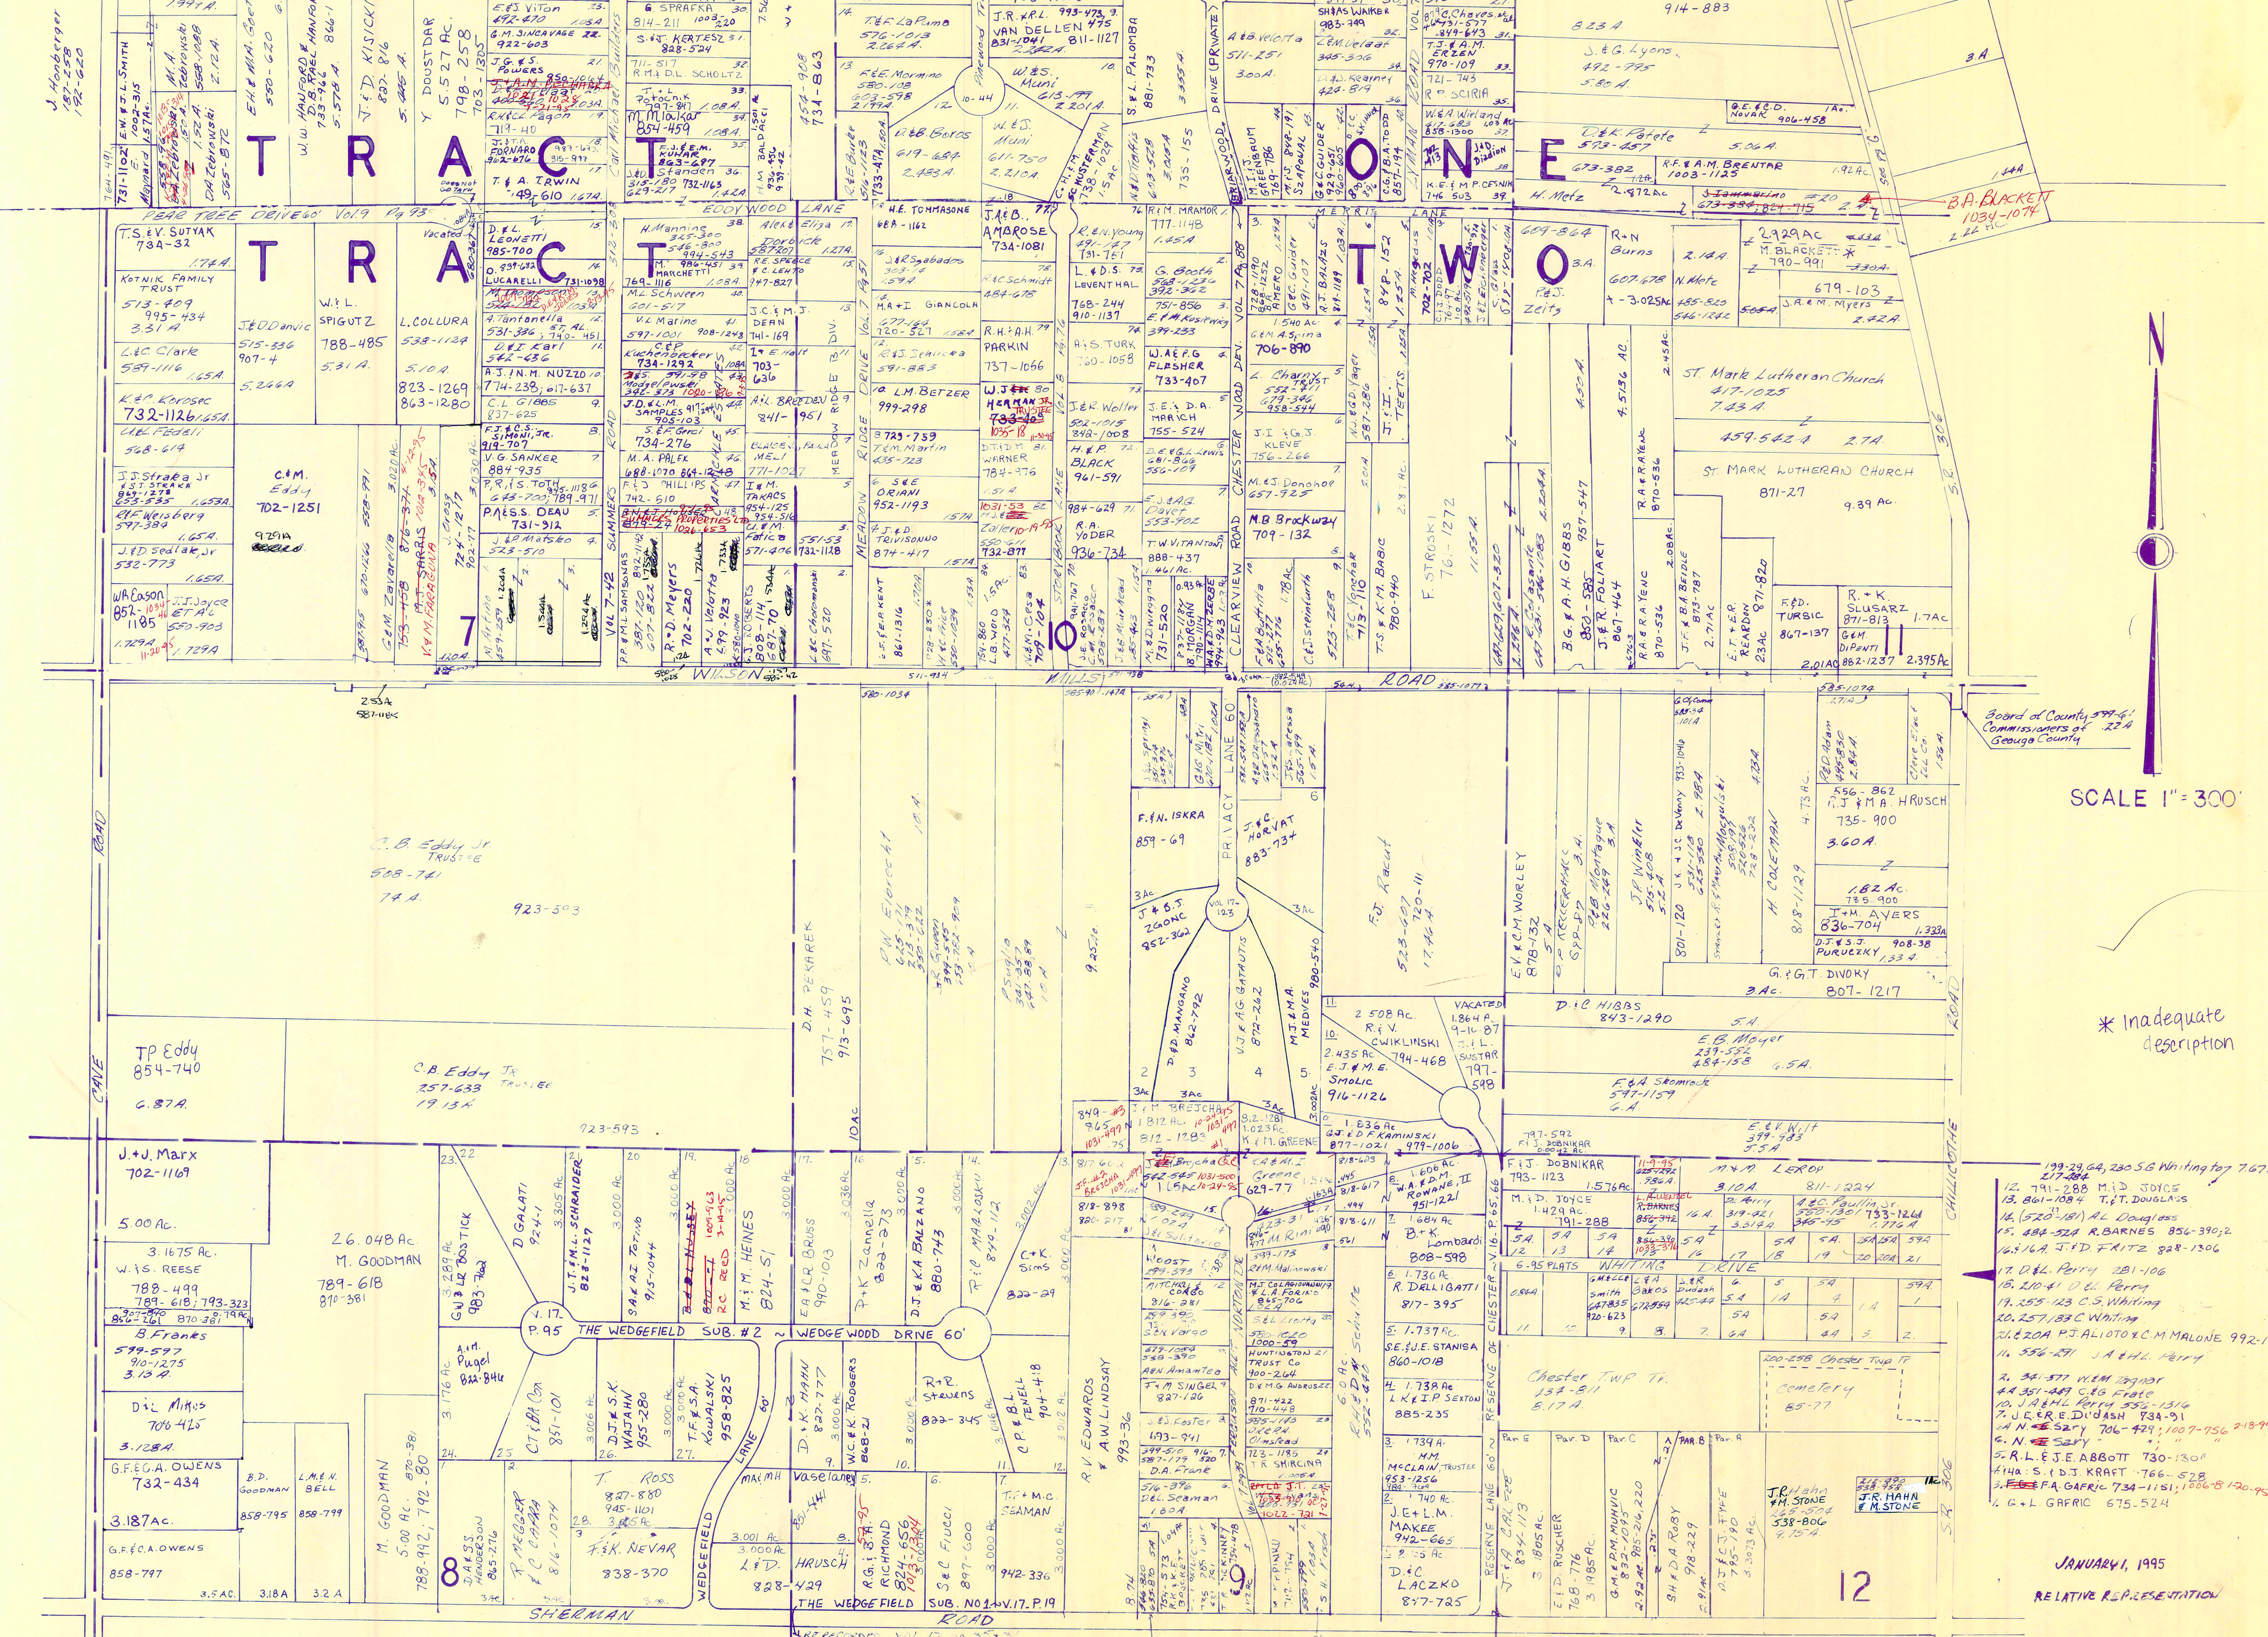


SCALE 1" = 300'


* Inadequate description

- 199-29, 66, 230 S.G. Whiting to 7.67A
- 12. 791-288 M.D. JOYCE
- 13. 861-108 T.T. DOUGLASS
- 14. (520-181) AL Doughtless
- 15. 484-524 R. BARNES 856-390, 2
- 16. 161A J.F.D. FRITZ 828-1306
- 17. D.L. Perry 281-106
- 18. 210-41 U.C. Perry
- 19. 255-123 C.S. Whiting
- 20. 257-183 C. Whiting
- 21. 420A P.J. ALIOTO & C.M. MALONE 992-1046
- 11. 556-271 J.A. & H.L. Perry
- 2. 341-577 W.M. 109-107
- 4. 351-487 C.G. FROST
- 10. 104 H.L. Perry 555-1516
- 7. J.E. & E. D. DASH 73A-91
- 14. N. Esary 706-429, 1007-756 218-95
- 6. N. Esary
- 5. R.L. & J.E. ABBOTT 730-1301
- 4. H.A. S. D.J. KRAT 766-528
- 3. E.P.A. GARRIC 73A-1151, 1066-8 120-95
- 2. G.L. GARRIC 675-524

JANUARY, 1995
RELATIVE REPRESENTATION

A	B	C	D
E	F	G	H
I	J	K	L
M	N	O	P

TRACT ONE

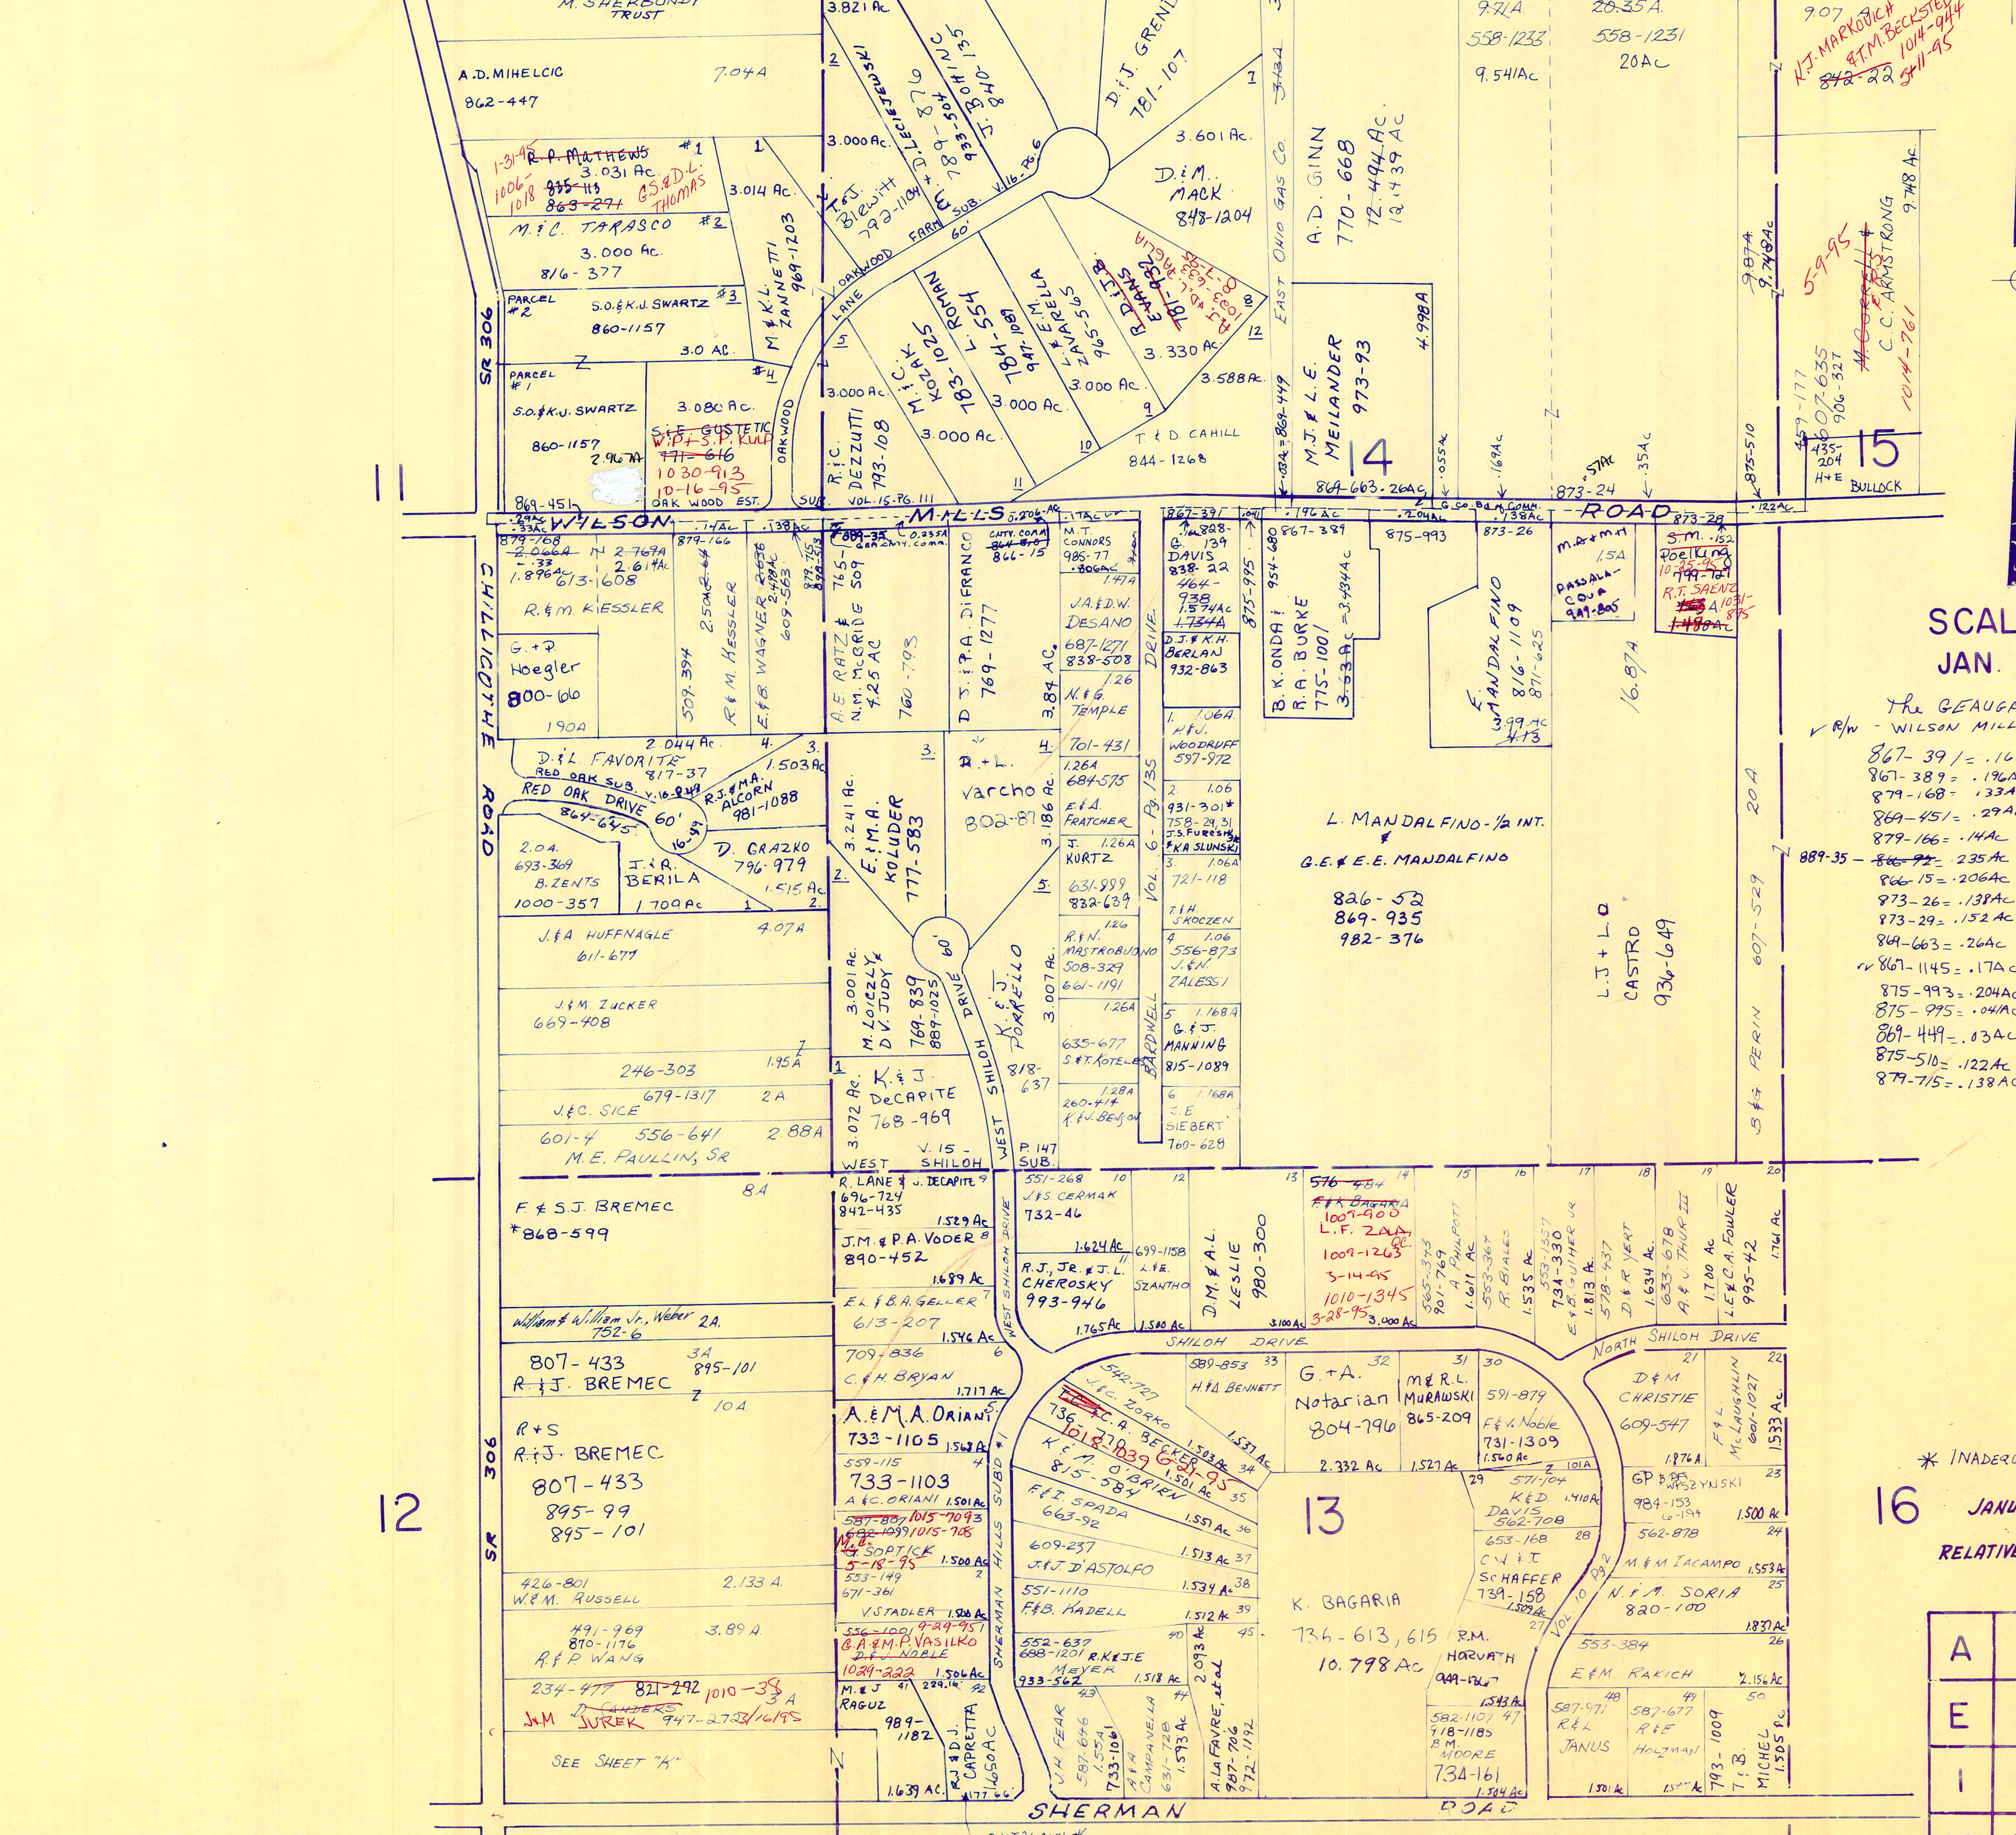


SCALE 1"=300'
 JAN 1, 1990

THE GEAUGA CO. Bd. of COMMISSIONERS
 Wilson Mills Rd.
 867-391 = .16AC
 867-389 = .19AC
 874-168 = .33AC
 869-451 = .29AC
 879-166 = .14AC
 889-35 = .235AC
 866-15 = .206AC
 973-26 = .131AC
 873-29 = .152AC
 874-663 = .26AC
 861-1145 = .17AC
 875-993 = .204AC
 875-975 = .04AC
 861-449 = .03AC
 875-510 = .122AC
 871-715 = .138AC

* INADEQUATE DESCRIPTION
 JANUARY 1, 1995
 RELATIVE REPRESENTATION

A	B	C	D
E	F	G	H
I	J	K	L
M	N	O	P

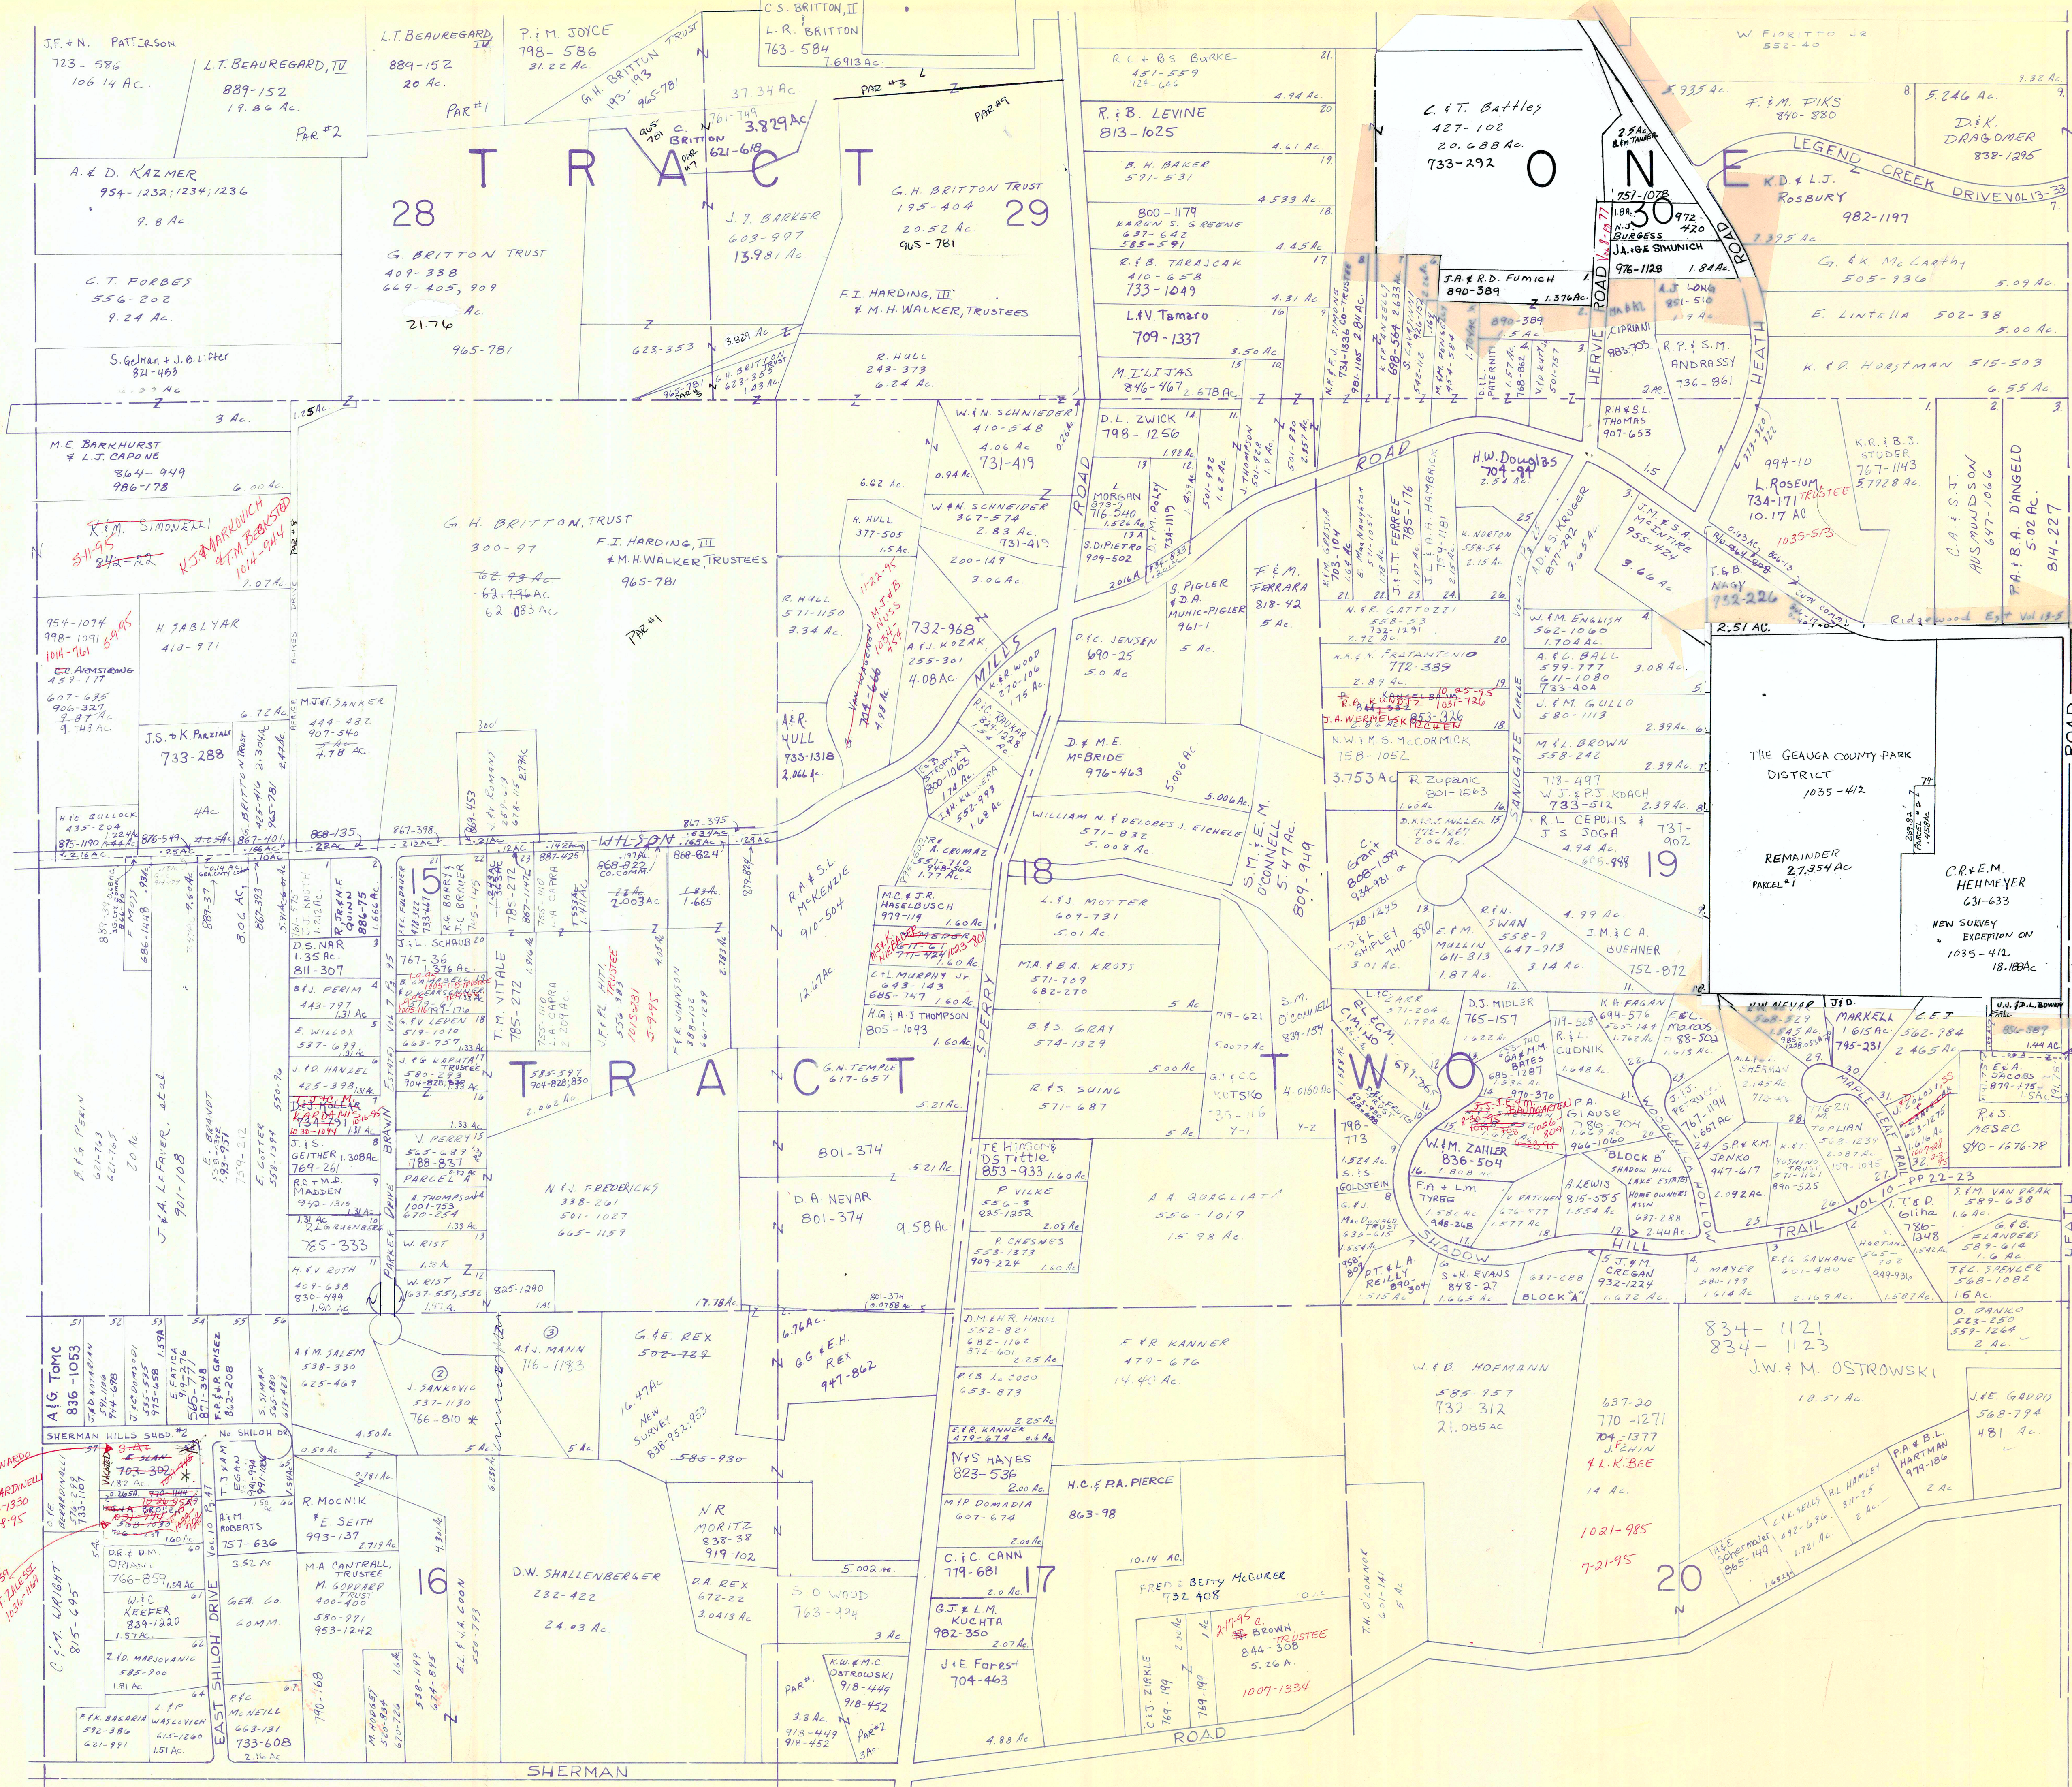

*B. BERNARDI
P. BERARDINELLI
1026-1930
9495*

SCALE 1" = 300'

THE GEAUGA COUNTY PARK DISTRICT 1035-412

REMAINDER 27,954 AC PARCEL #1

C.P. & E.M. HEHMEYER 631-633

NEW SURVEY EXCEPTION ON 1035-412 18.103 AC


* Inadequate description

JANUARY 1, 1995

RELATIVE REPRESENTATION

A	B	C	D
E	F	G	H
I	J	K	L
M	N	O	P

CHESTER H

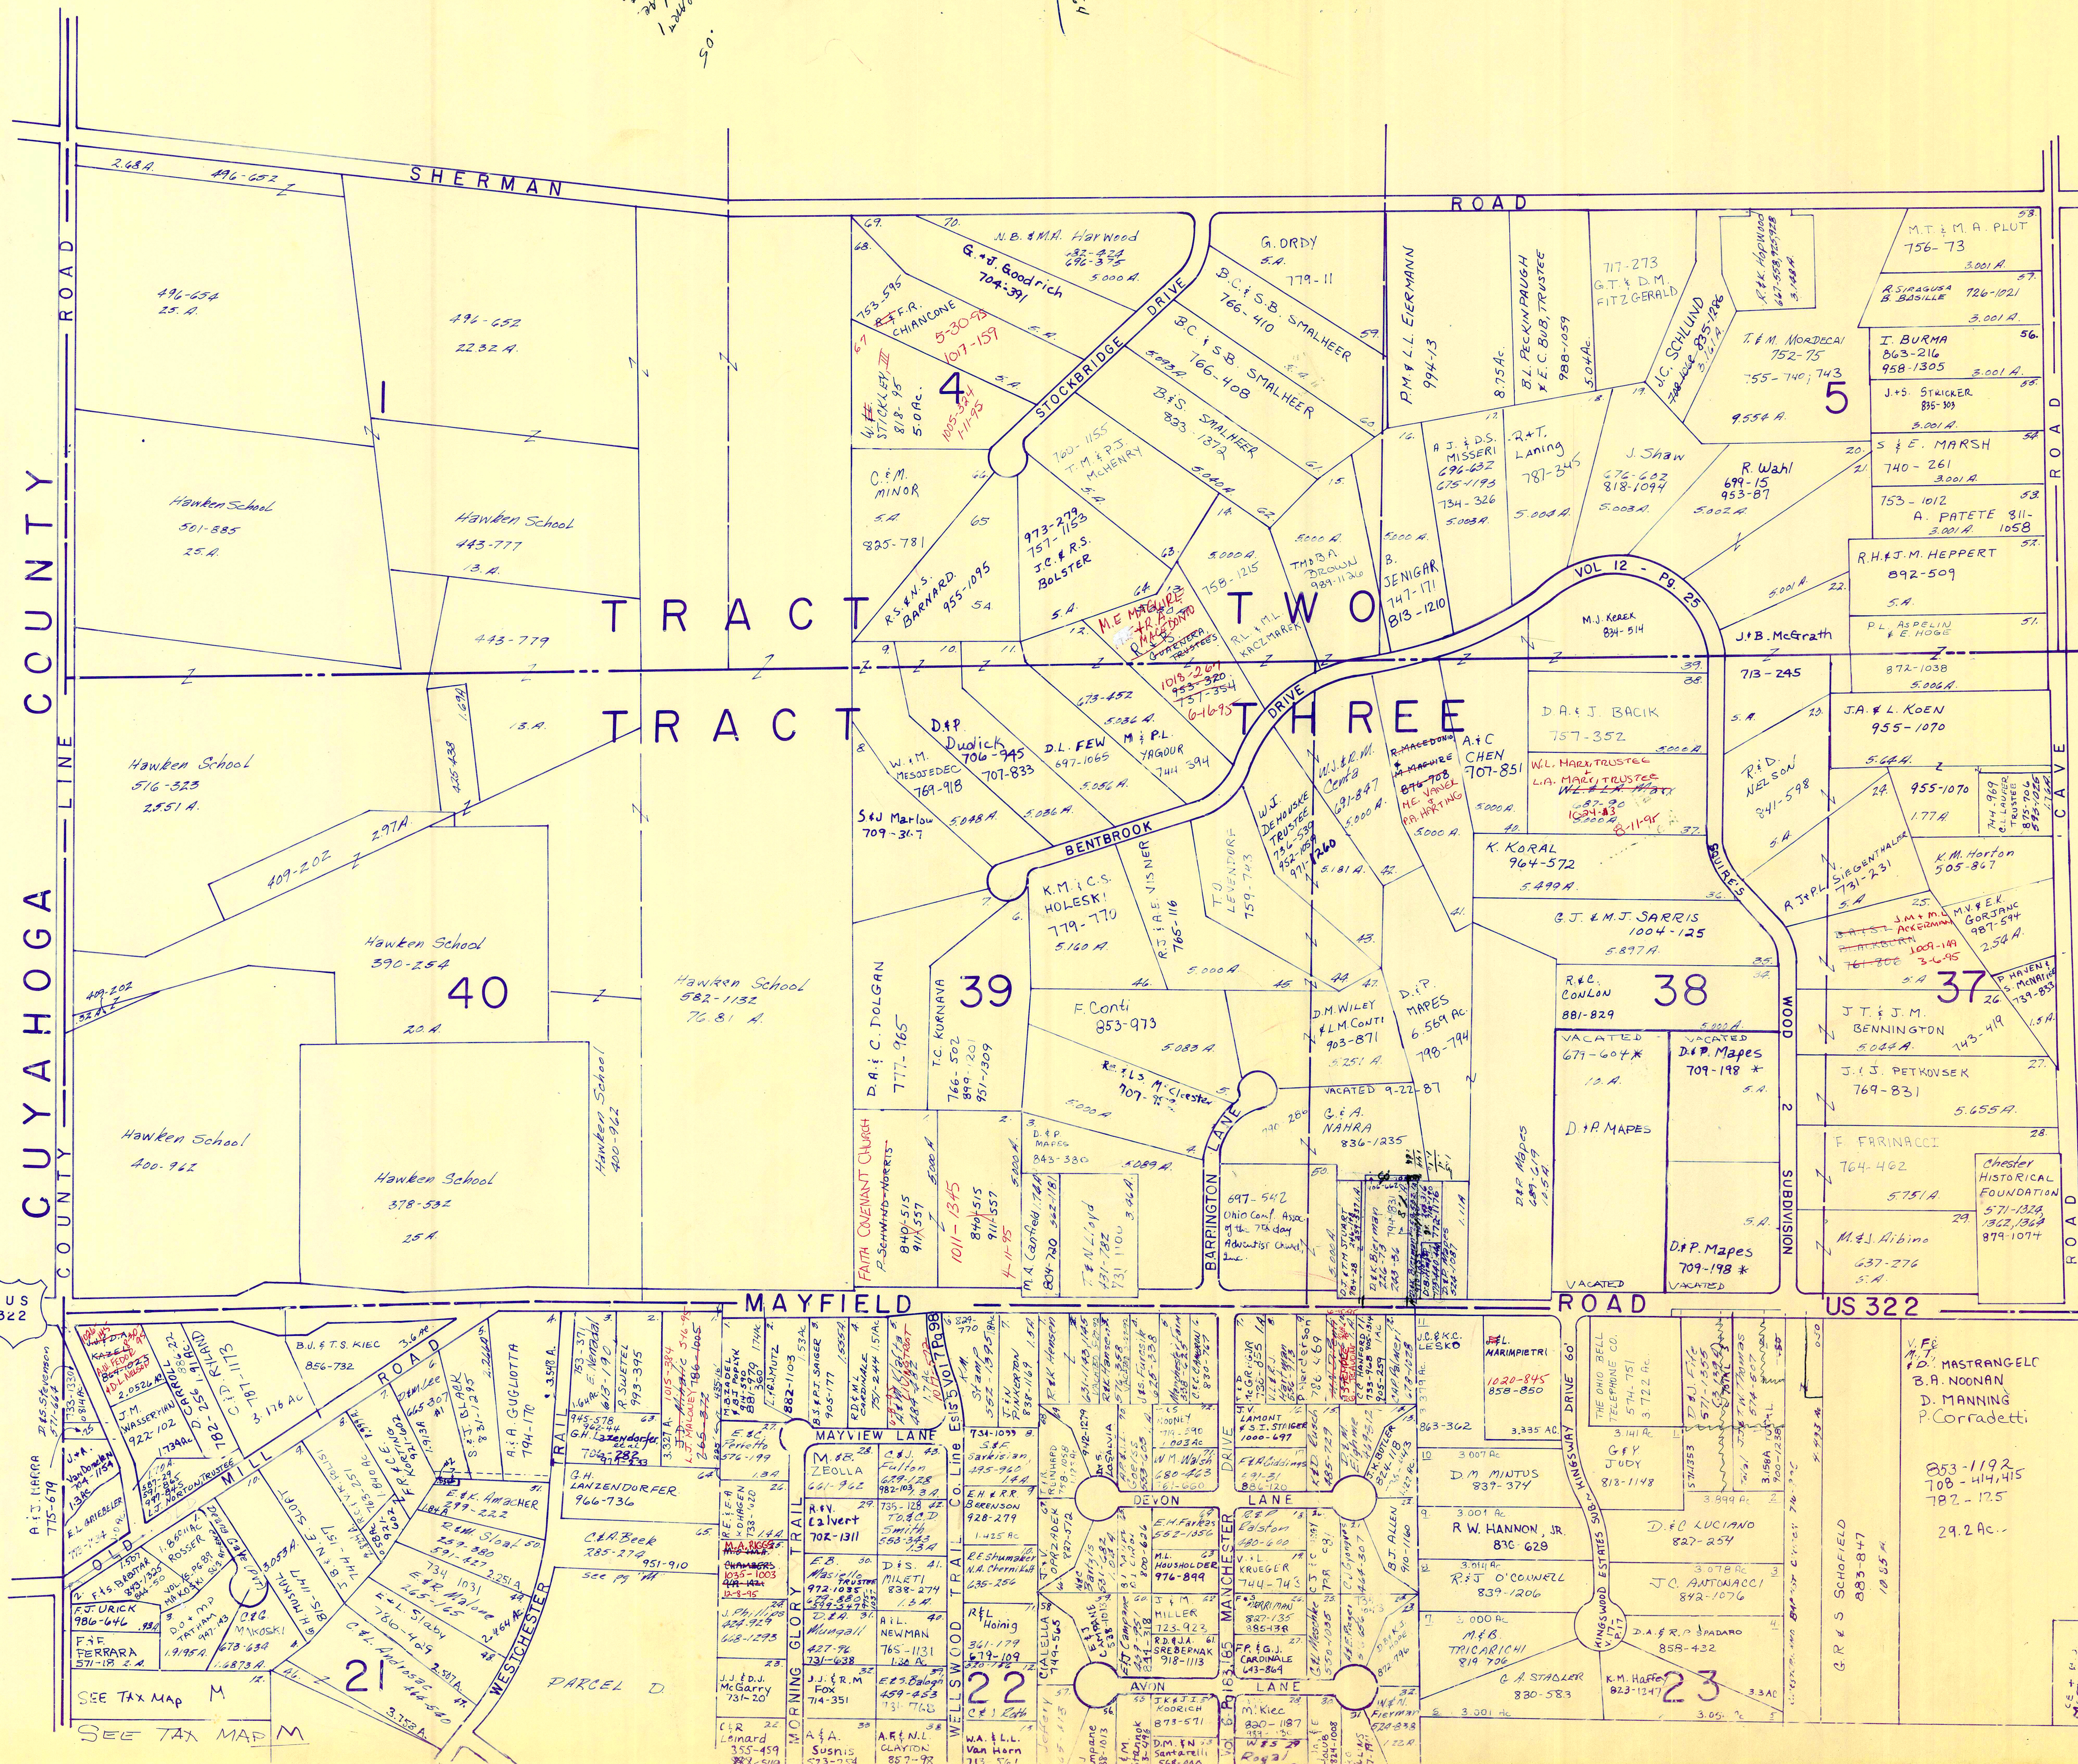

Hand
written
notes
50.

50.

SCALE 1"=300

JANUARY 1, 1995

A	B	C	D
E	F	G	H
J	K	L	
M	N	O	P

CHESTER I

RELATIVE REPRESENTATION

* Inadequate description



CHESTER

US 322

US 322

SEE TAX MAP M
SEE TAX MAP M

HAROLD DRIVE		ALLOT. VOL 5 PG 43		
1	J. T. EICHS	421-9	21	H. Podewski
2	J. P. NITRAN	154-918	22	PH. Mautman et al
3	D. H. GRASSO	647-627	23	BIT Doctor
4	M. B. PAVLIAS	576-290	24	S. SKOCH
5	ATL WILKIS	923-1047	25	D. J. Sapanaro
6	R. M. PLATEK	741-1045	26	REX A Horn
7	A. A. BARGIULO	976-985	27	C. Smith
8	E. G. VANJOUR	741-184	28	M. J. M. Lukacs
9	E. D. NEWTON	998-1244	29	W. J. Kozak
10	W. J. Kozak	508-765	30	E. D. Marchand
11	K. N. S. Desgraves	1002-1038	31	M. L. Waller
12	J. D. Kravovec	744-476	32	A. H. M. Colborn
13	P. C. Taddeo	997-344	33	541-478
14	M. C. Searvelli	562-394		
15	T. B. Roach	733-482	34	559-23
16	J. P. MAYNARD	752-544		
17	PH. C. DRESING	106-706	35	813-995
18	J. A. DADDARIO	965-881		
19	J. F. HART	805-371	36	549-981
20	S. J. ...	1030-810	37	447-284

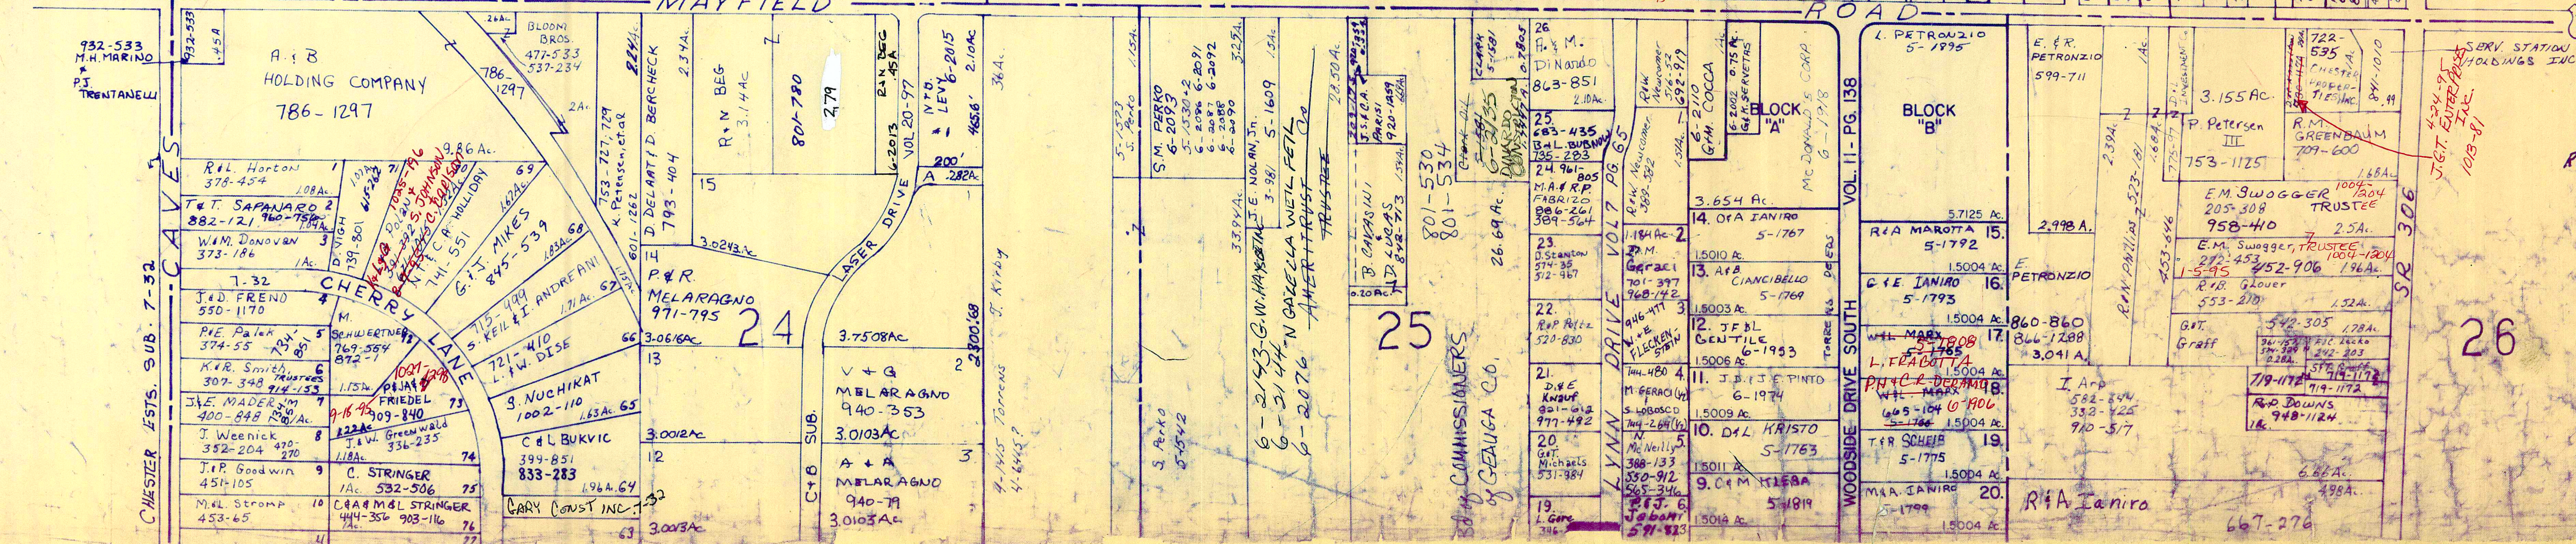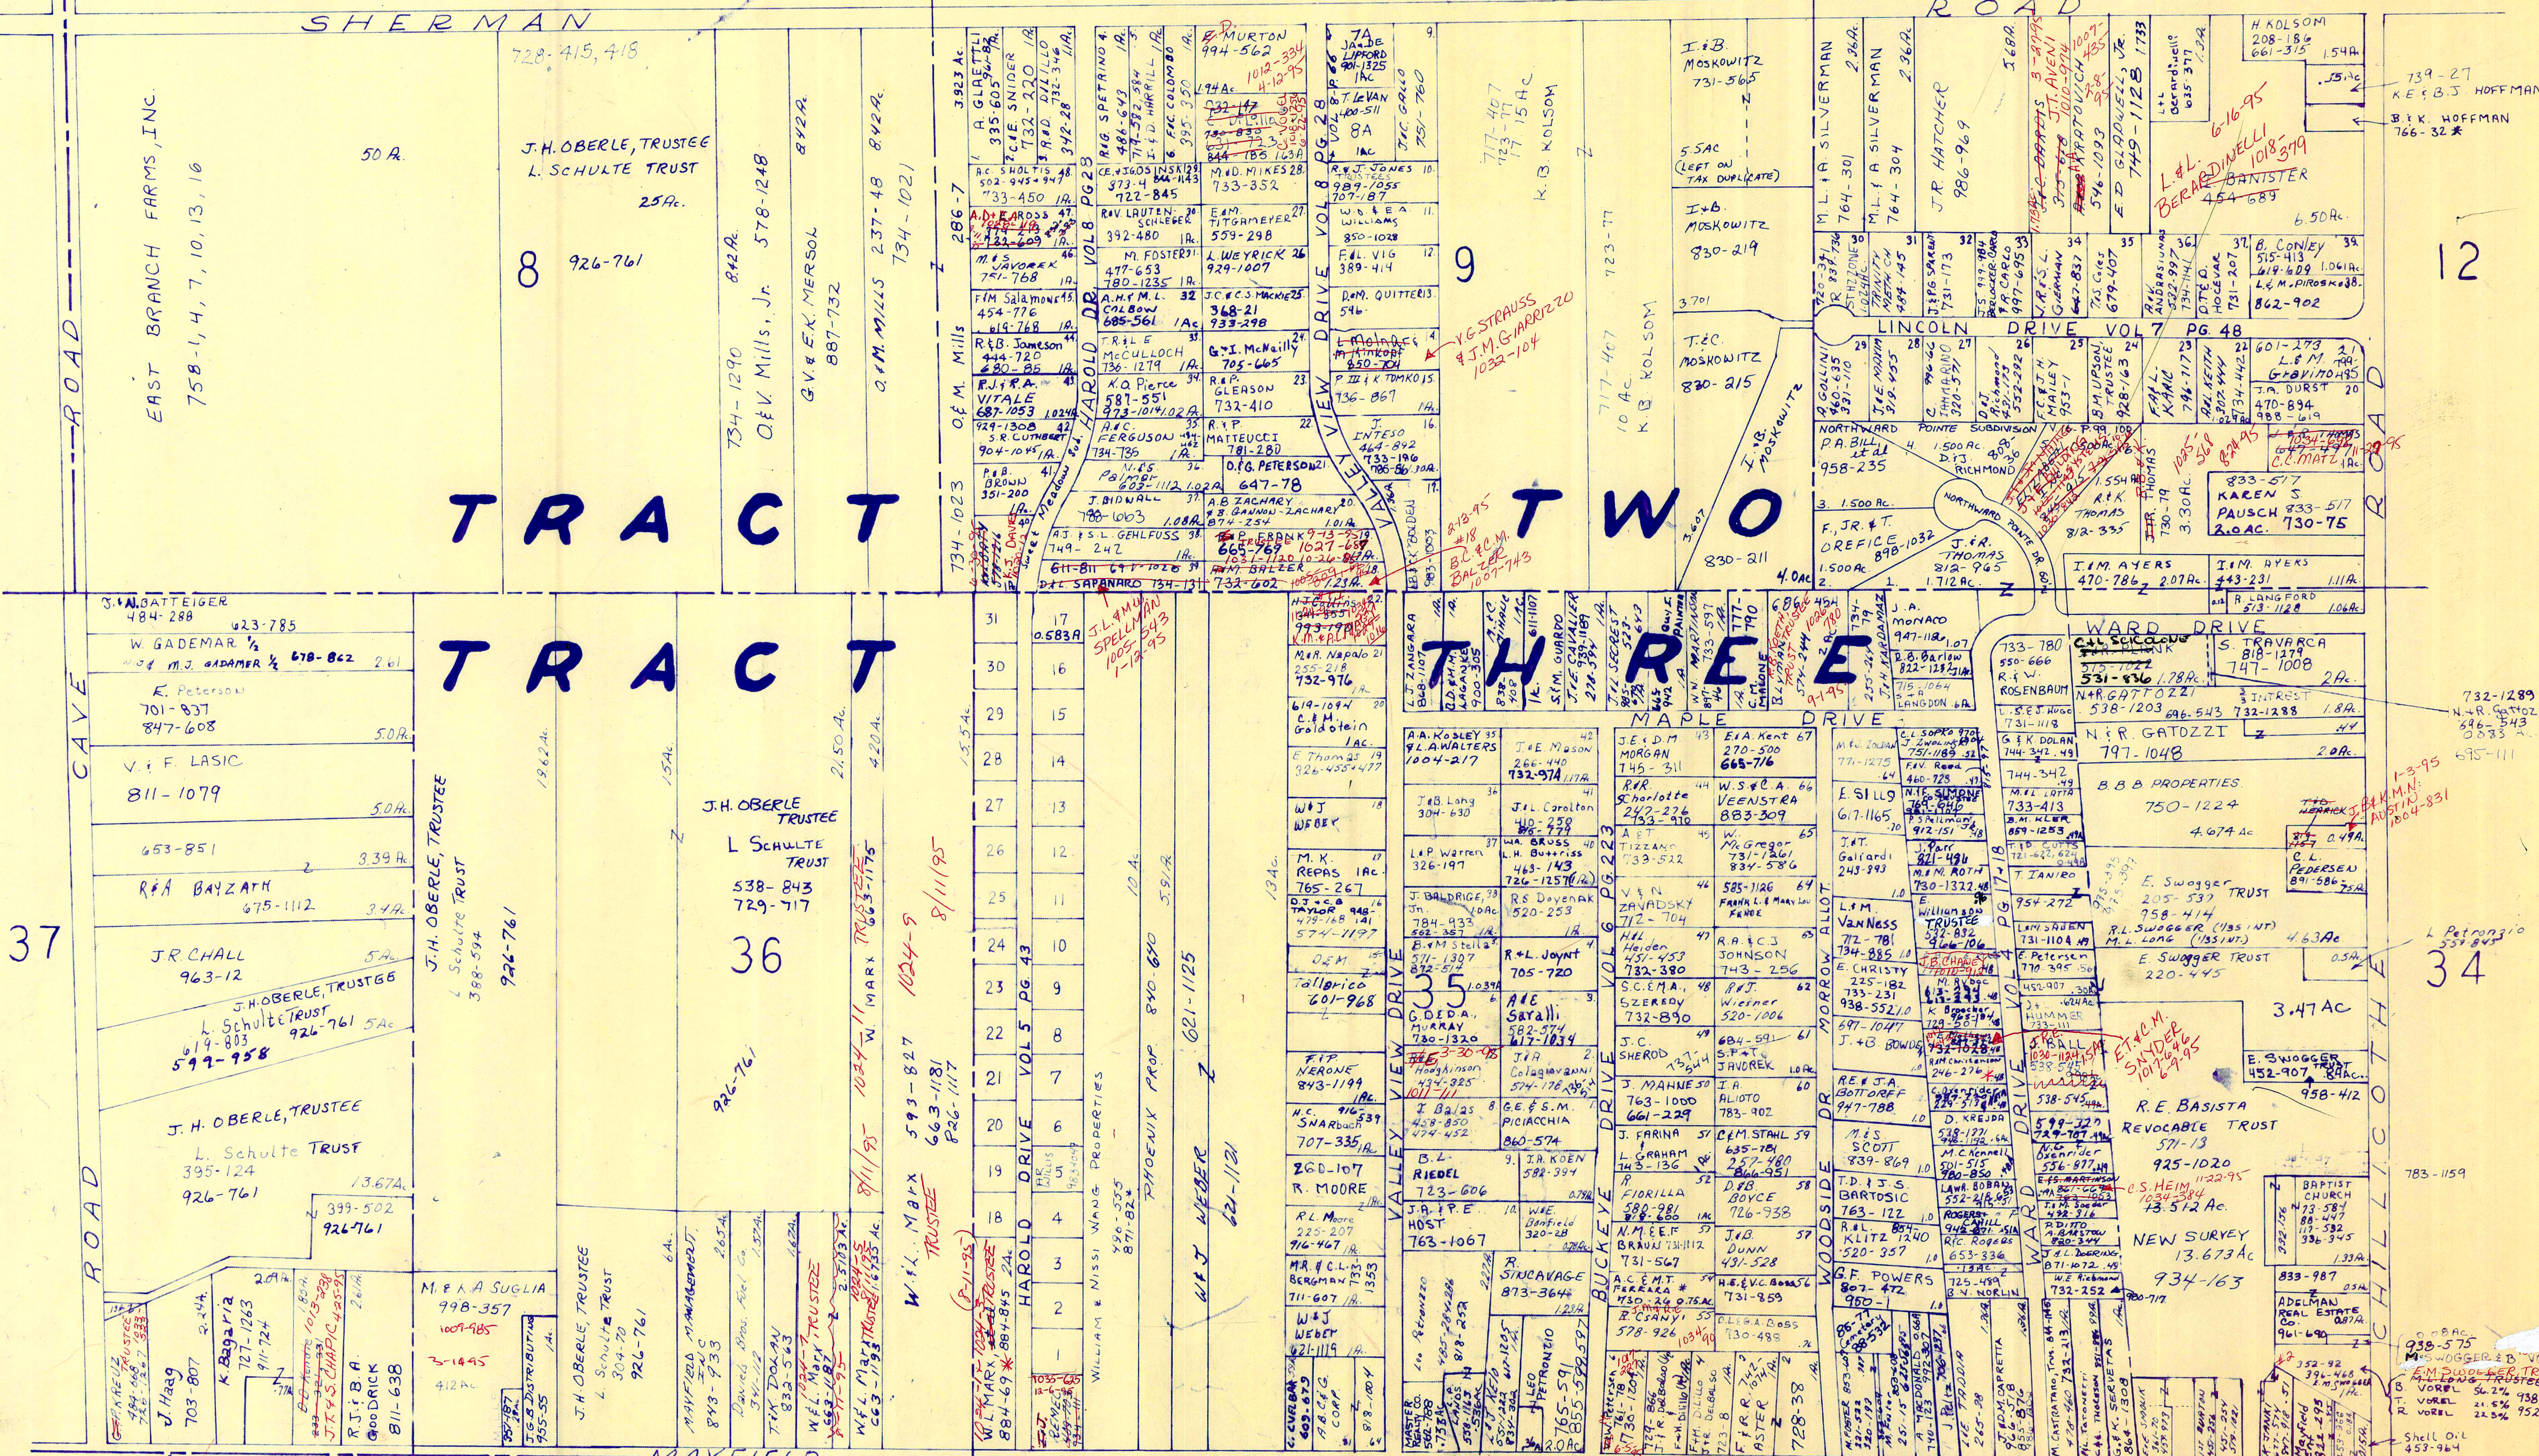

SCALE 1"=300

JANUARY 1, 1995
RELATIVE REPRESENTATION

A	B	C	D
E	F	G	H
I	J	K	L
M	N	O	P

CHESTER

WARD DRIVE
1035-153
10/1/95
K.L. RANNEY
J.A. CHRISTENSEN

*Inadequate description

358-575
M. W. GOSSEL & B. VORL
EM SWIGGER TRUST 1014-400, 402
VORL 5627 976-393
R. VORL 2154 952-1248
Shell Oil 457-984

34

12

306

37

36

8

9

SHERMAN

ROAD

ROAD

CAVE

ROAD

MAYFIELD

ROAD


CHESTER ESTS. SUB. T-32

SCALE 1"=300

JANUARY 1, 1995
RELATIVE REPRESENTATION

A	B	C	D
E	F	G	H
I	J	K	L
M	N	O	P

CHESTER

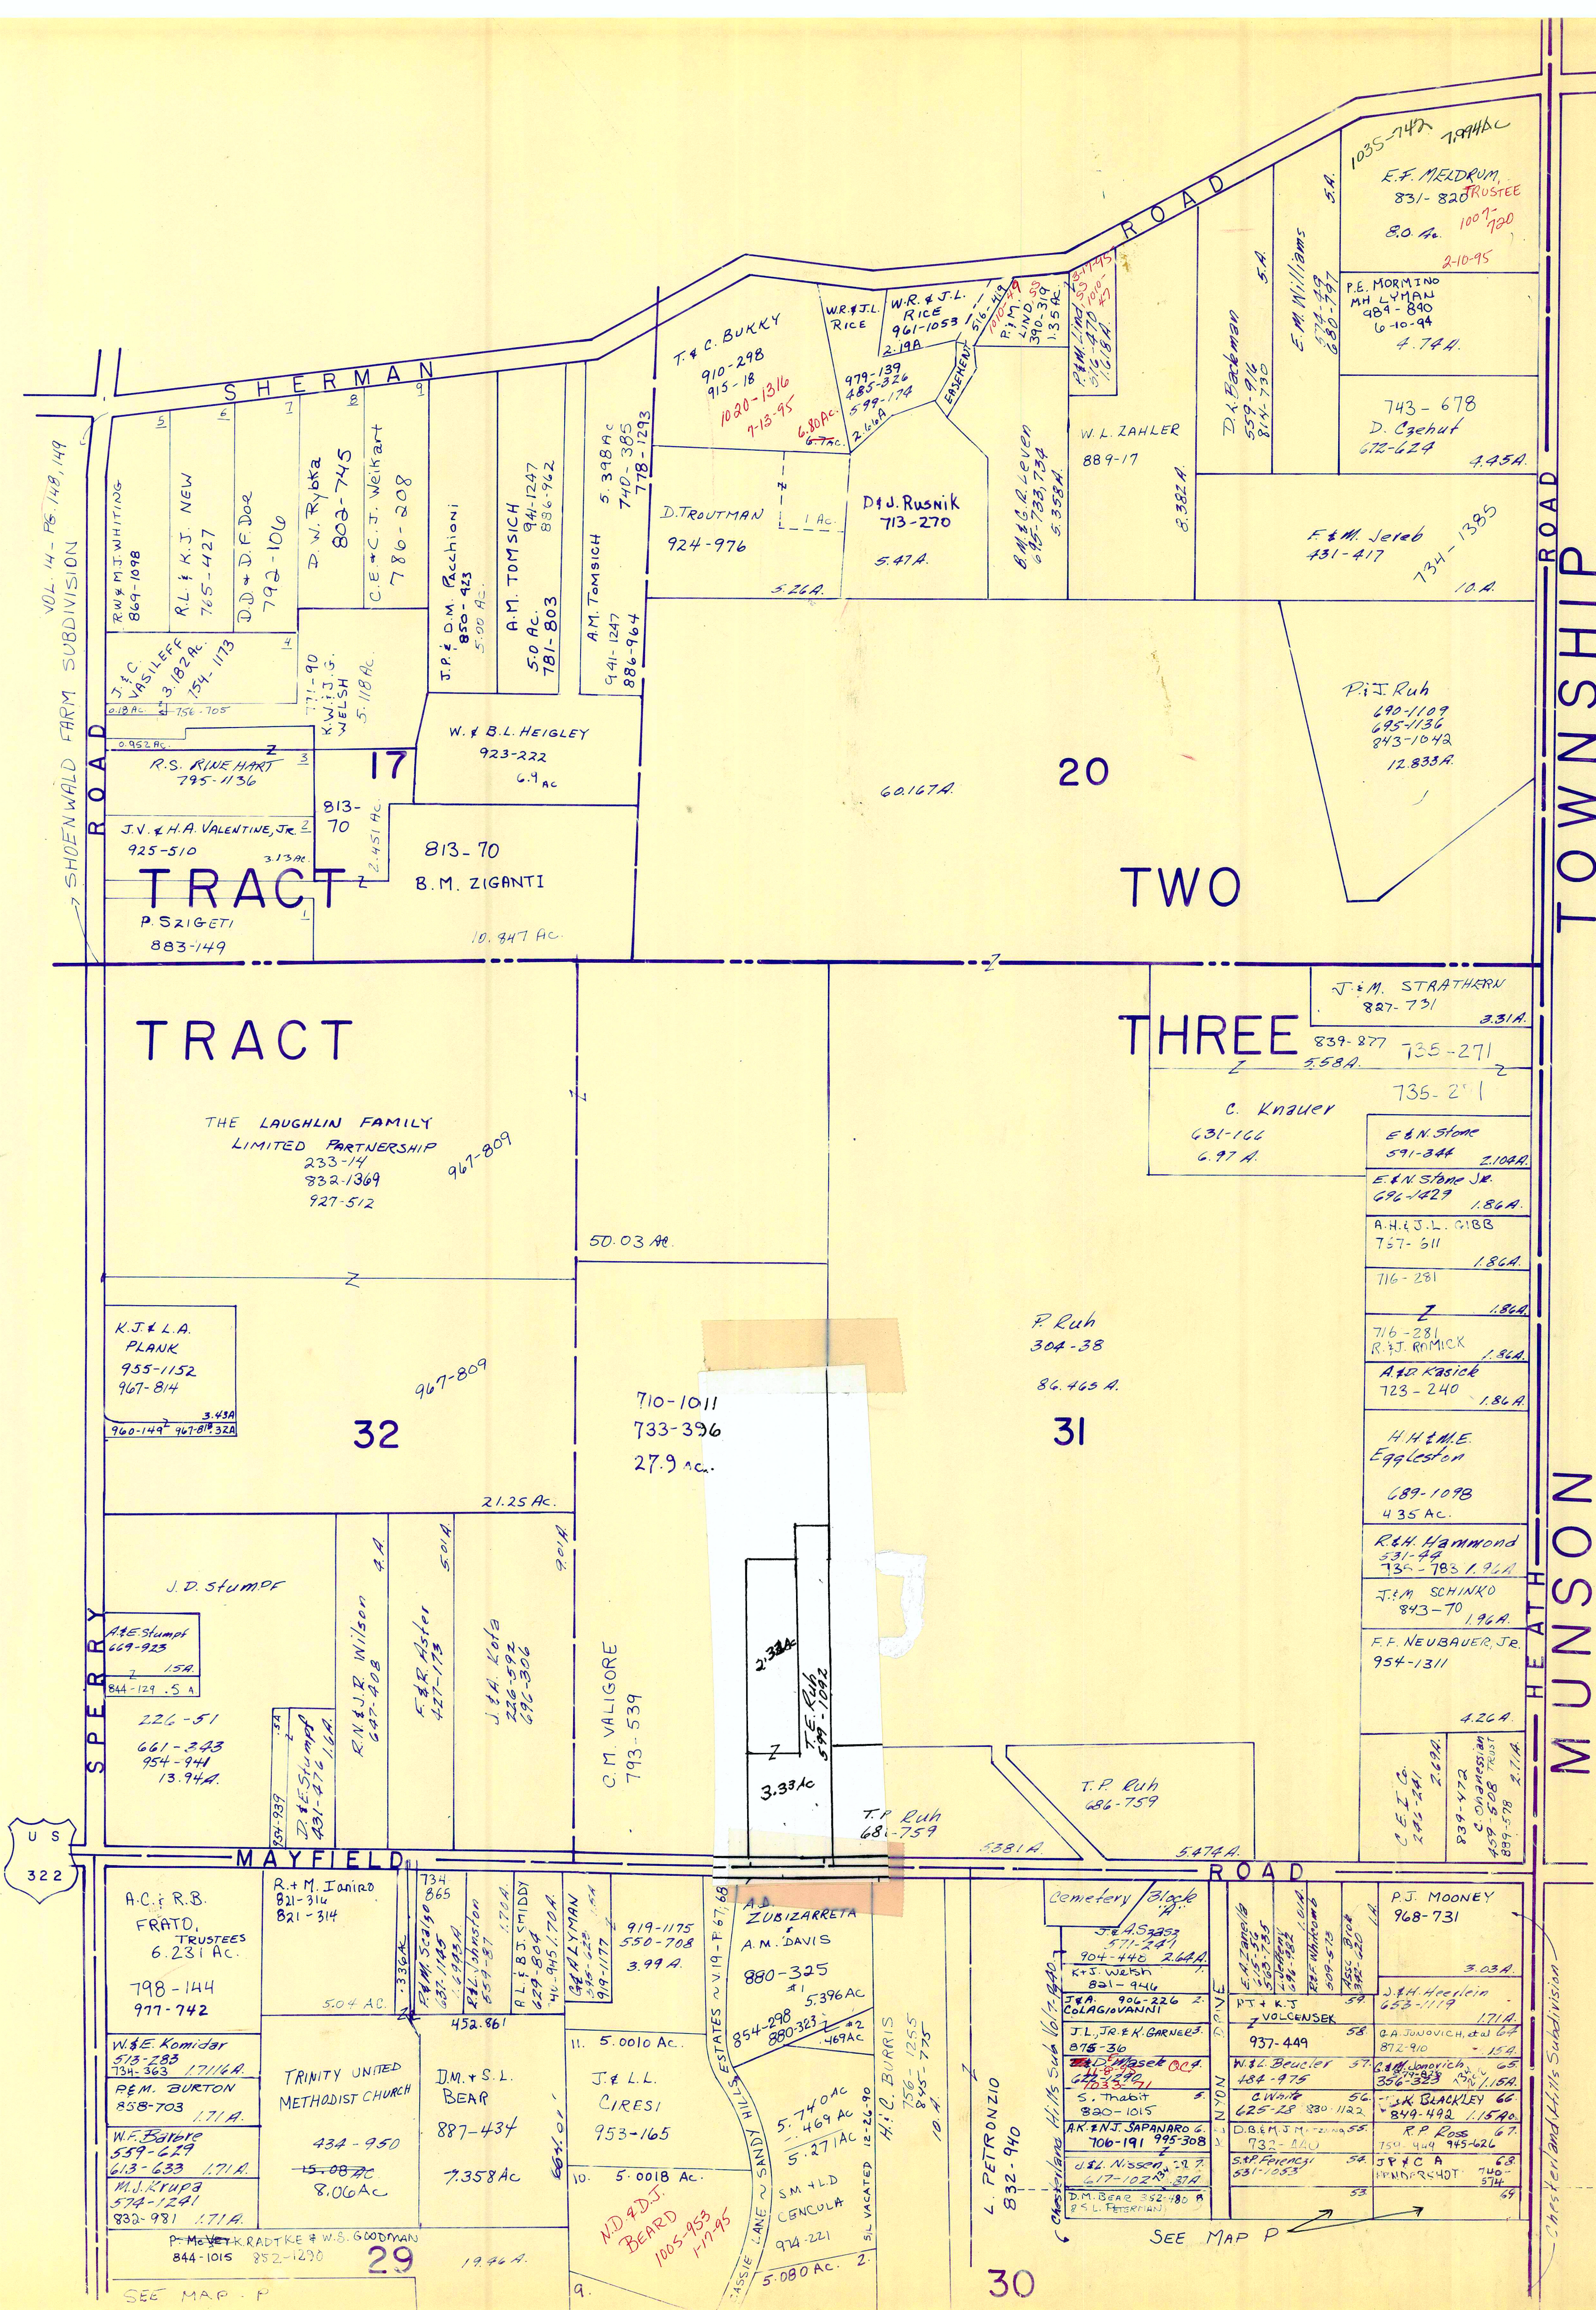

SCALE 1" = 300'
JAN 1, 1983

MAYFIELD ROAD US 322

MYRLIN HEIGHTS SUB.
VOL. 3 Pg. 4 PLATS
SCALE 1" = 100'

W.M. GARDI 150-850	1	150-850
T.P. Phillips III 647-1147	2	647-1147
E.M. Kosarko 875-1267	3	875-1267
D.J. & S.L. WIELAND 898-121	4	898-121
C.C. Stevens 703-1340	5	703-1340
P.T. Crowl 846-434	6	846-434
M.M. Plumptre 806-1113	7	806-1113
J.E. Hoover 990-1005	8	990-1005
R.T. & C.L. RYON 920-130	9	920-130
B.A. Woss 925-549	10	925-549
A.J. & G.B. Braham 988-741	11	988-741
L.E. & H. Schill 760-422	12	760-422
H.F. & E.M. KALLAGE 796-578	13	796-578
R.B. & L.M. BARBER 855-1201	14	855-1201
P.E. Shellhammer 753-215	15	753-215
L.L. Crosby 756-1123	16	756-1123
E.P. & L. Paganini 889-434	17	889-434
A.V. Carrezi 767-189	18	767-189
S.J. Thornberry 964-453	19	964-453
P.A. & G.A. Ostrowsky 934-374	20	934-374
M.E. & K.E. Orazen 917-977	21	917-977
W.J. Dever 728-713	22	728-713
E. Evans 206-278	23	206-278
E. Evans 189-132	24	189-132
E. Evans 206-490	25	206-490
R.R. Adams 670-1256	26	670-1256
D.R.S. Wiggins Trust 435-327	27	435-327
A.E. Holo 434-553	28	434-553
R.T. & S.F. Conforti 1030-756	29	1030-756
M. Burnett 792-643	30	792-643
K.H. Hall 836-1051	31	836-1051
J.J. & M.J. Pavlonis 811-1023	32	811-1023
R.M. Janiro 751-1012	33	751-1012
J.L. Pfeiffer 983-824	34	983-824

P.S. NESTVOLD
& D.R. ELEGANTIAN
1044-863
540-95


* Inadequate description

JANUARY 1, 1995
RELATIVE REPRESENTATION

A	B	C	D
E	F	G	H
I	J	K	L
M	N	O	P

CHESTER L

CUYAHOGA COUNTY

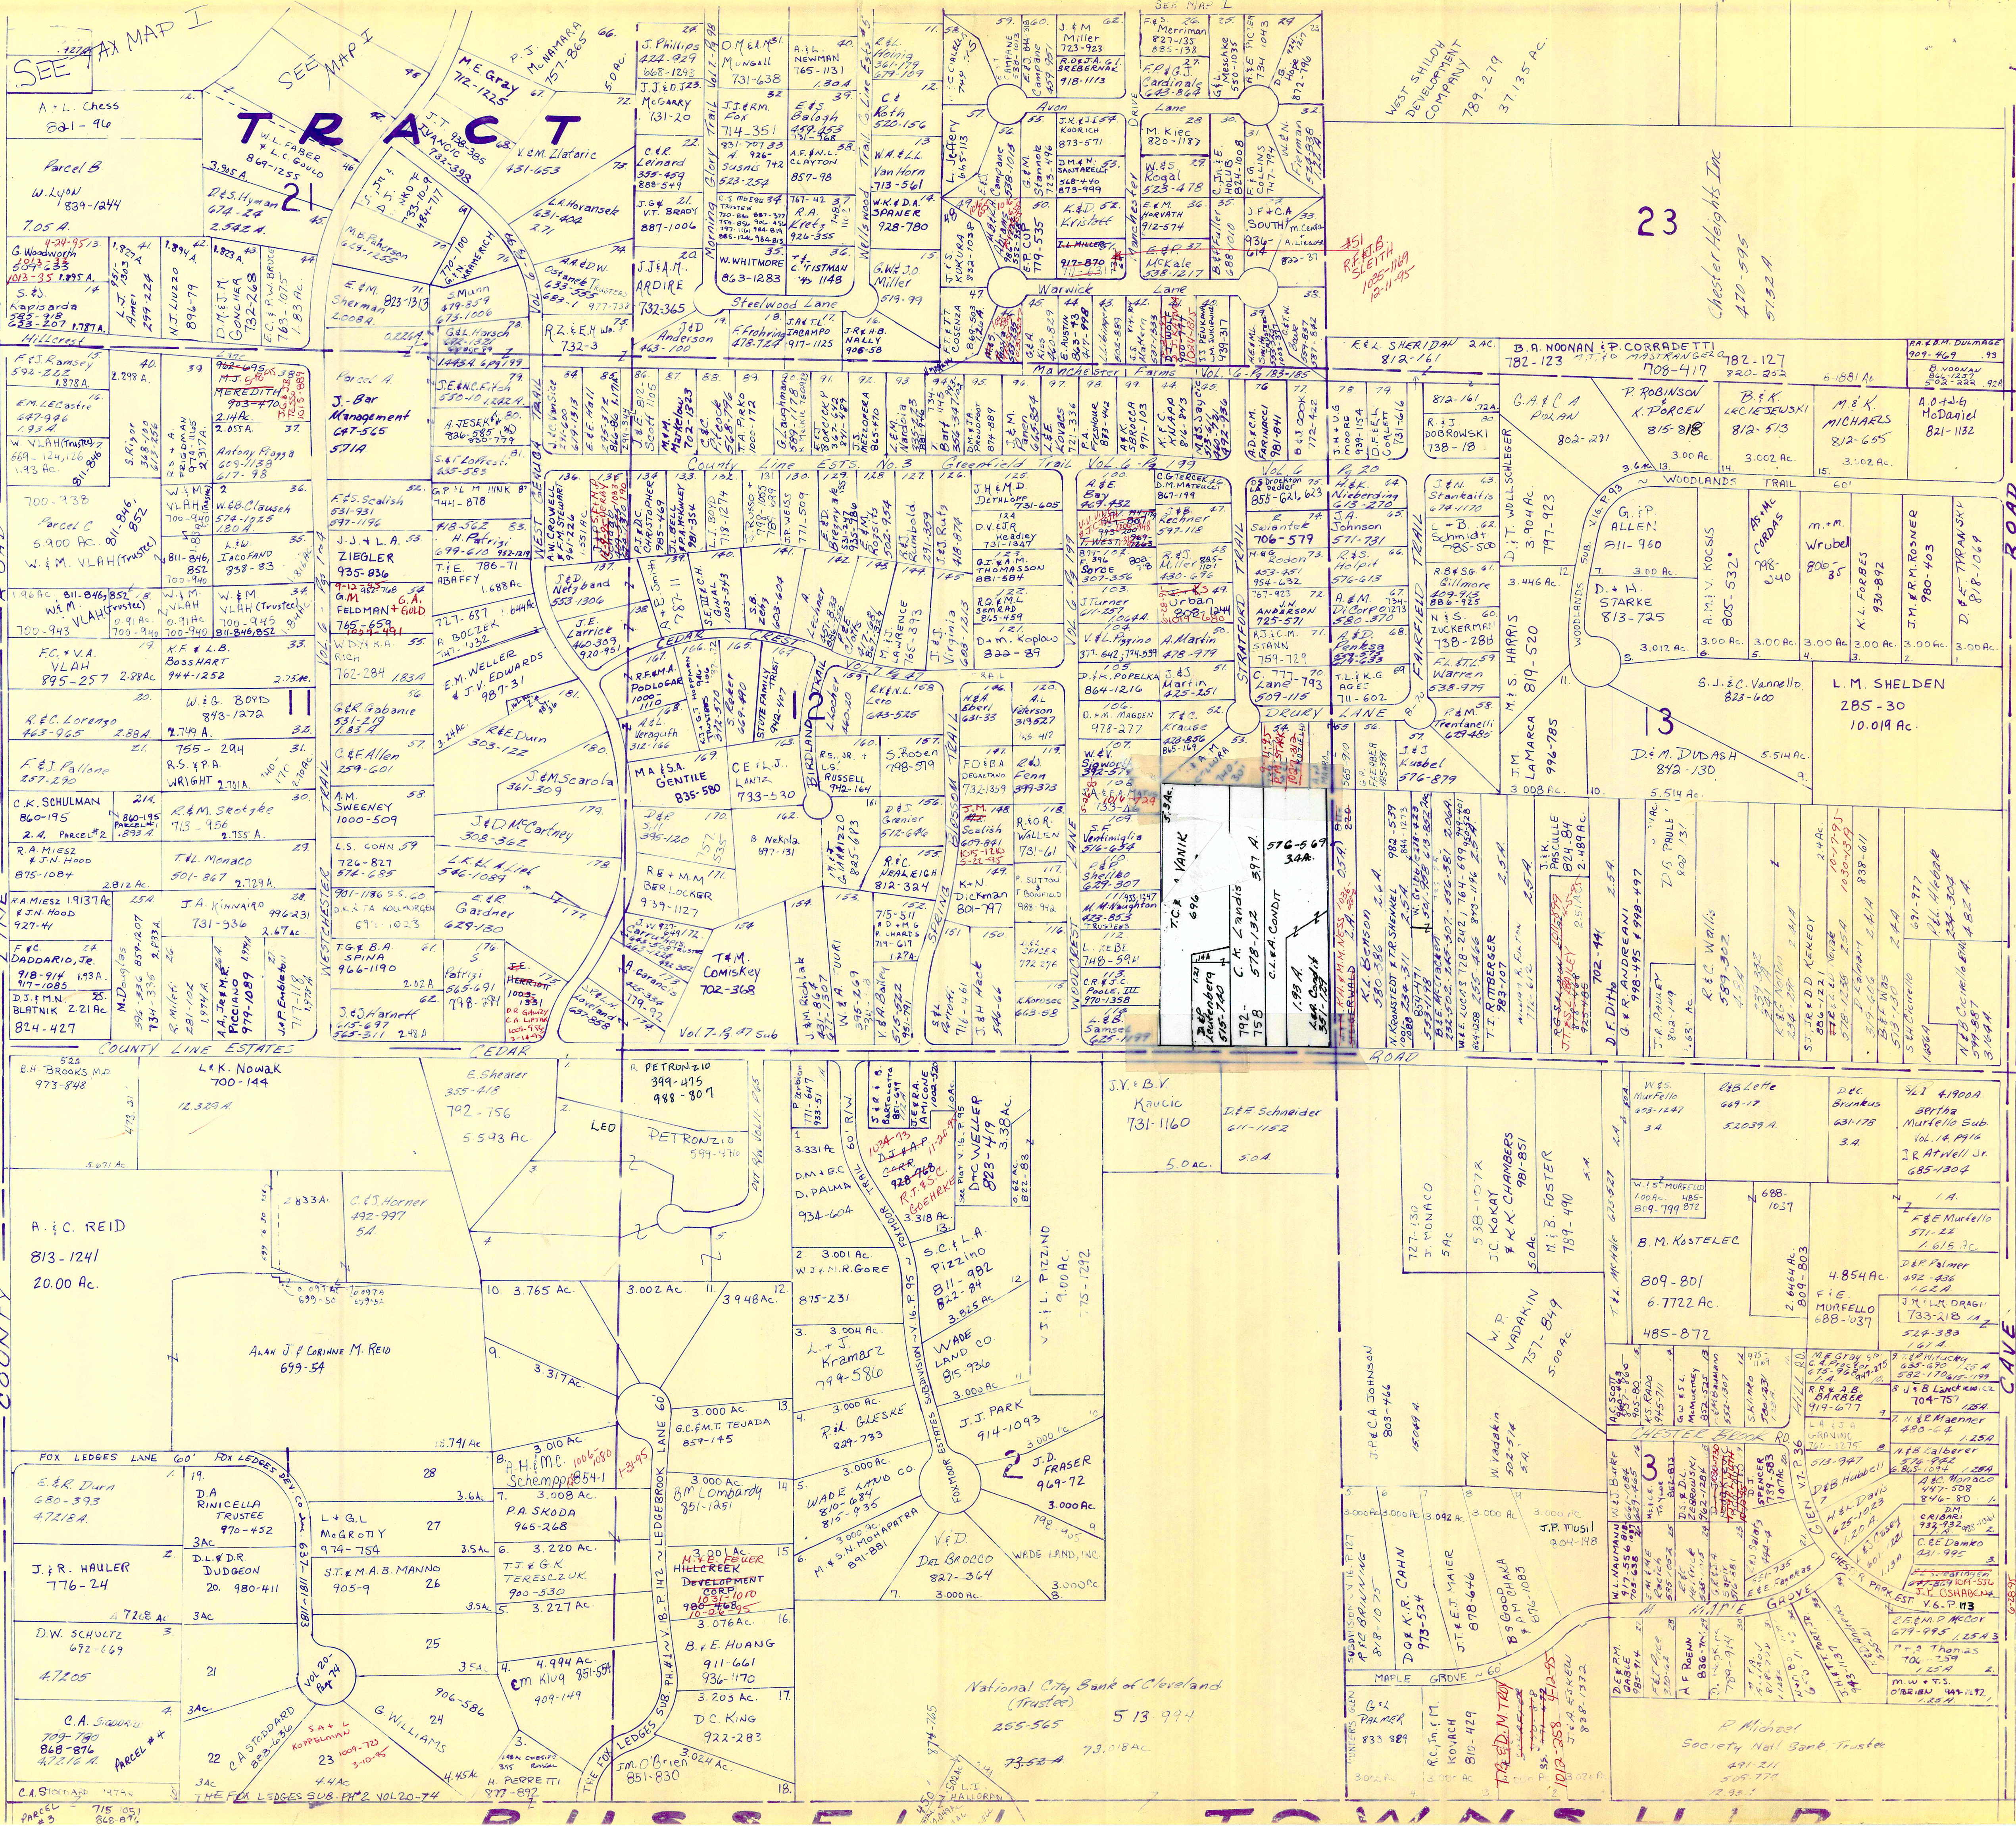

23

Chester Heights Inc
470-595
5732 A

SCALE 1"=300'

JAN. 1, 1995


* inadequate description

RELATIVE REPRESENTATION

A	B	C	D
E	F	G	H
I	J	K	L
M	N	O	P

CHESTER M

#19
D.L. Moore
& L.H. Elliott
106-1912
5-31-45

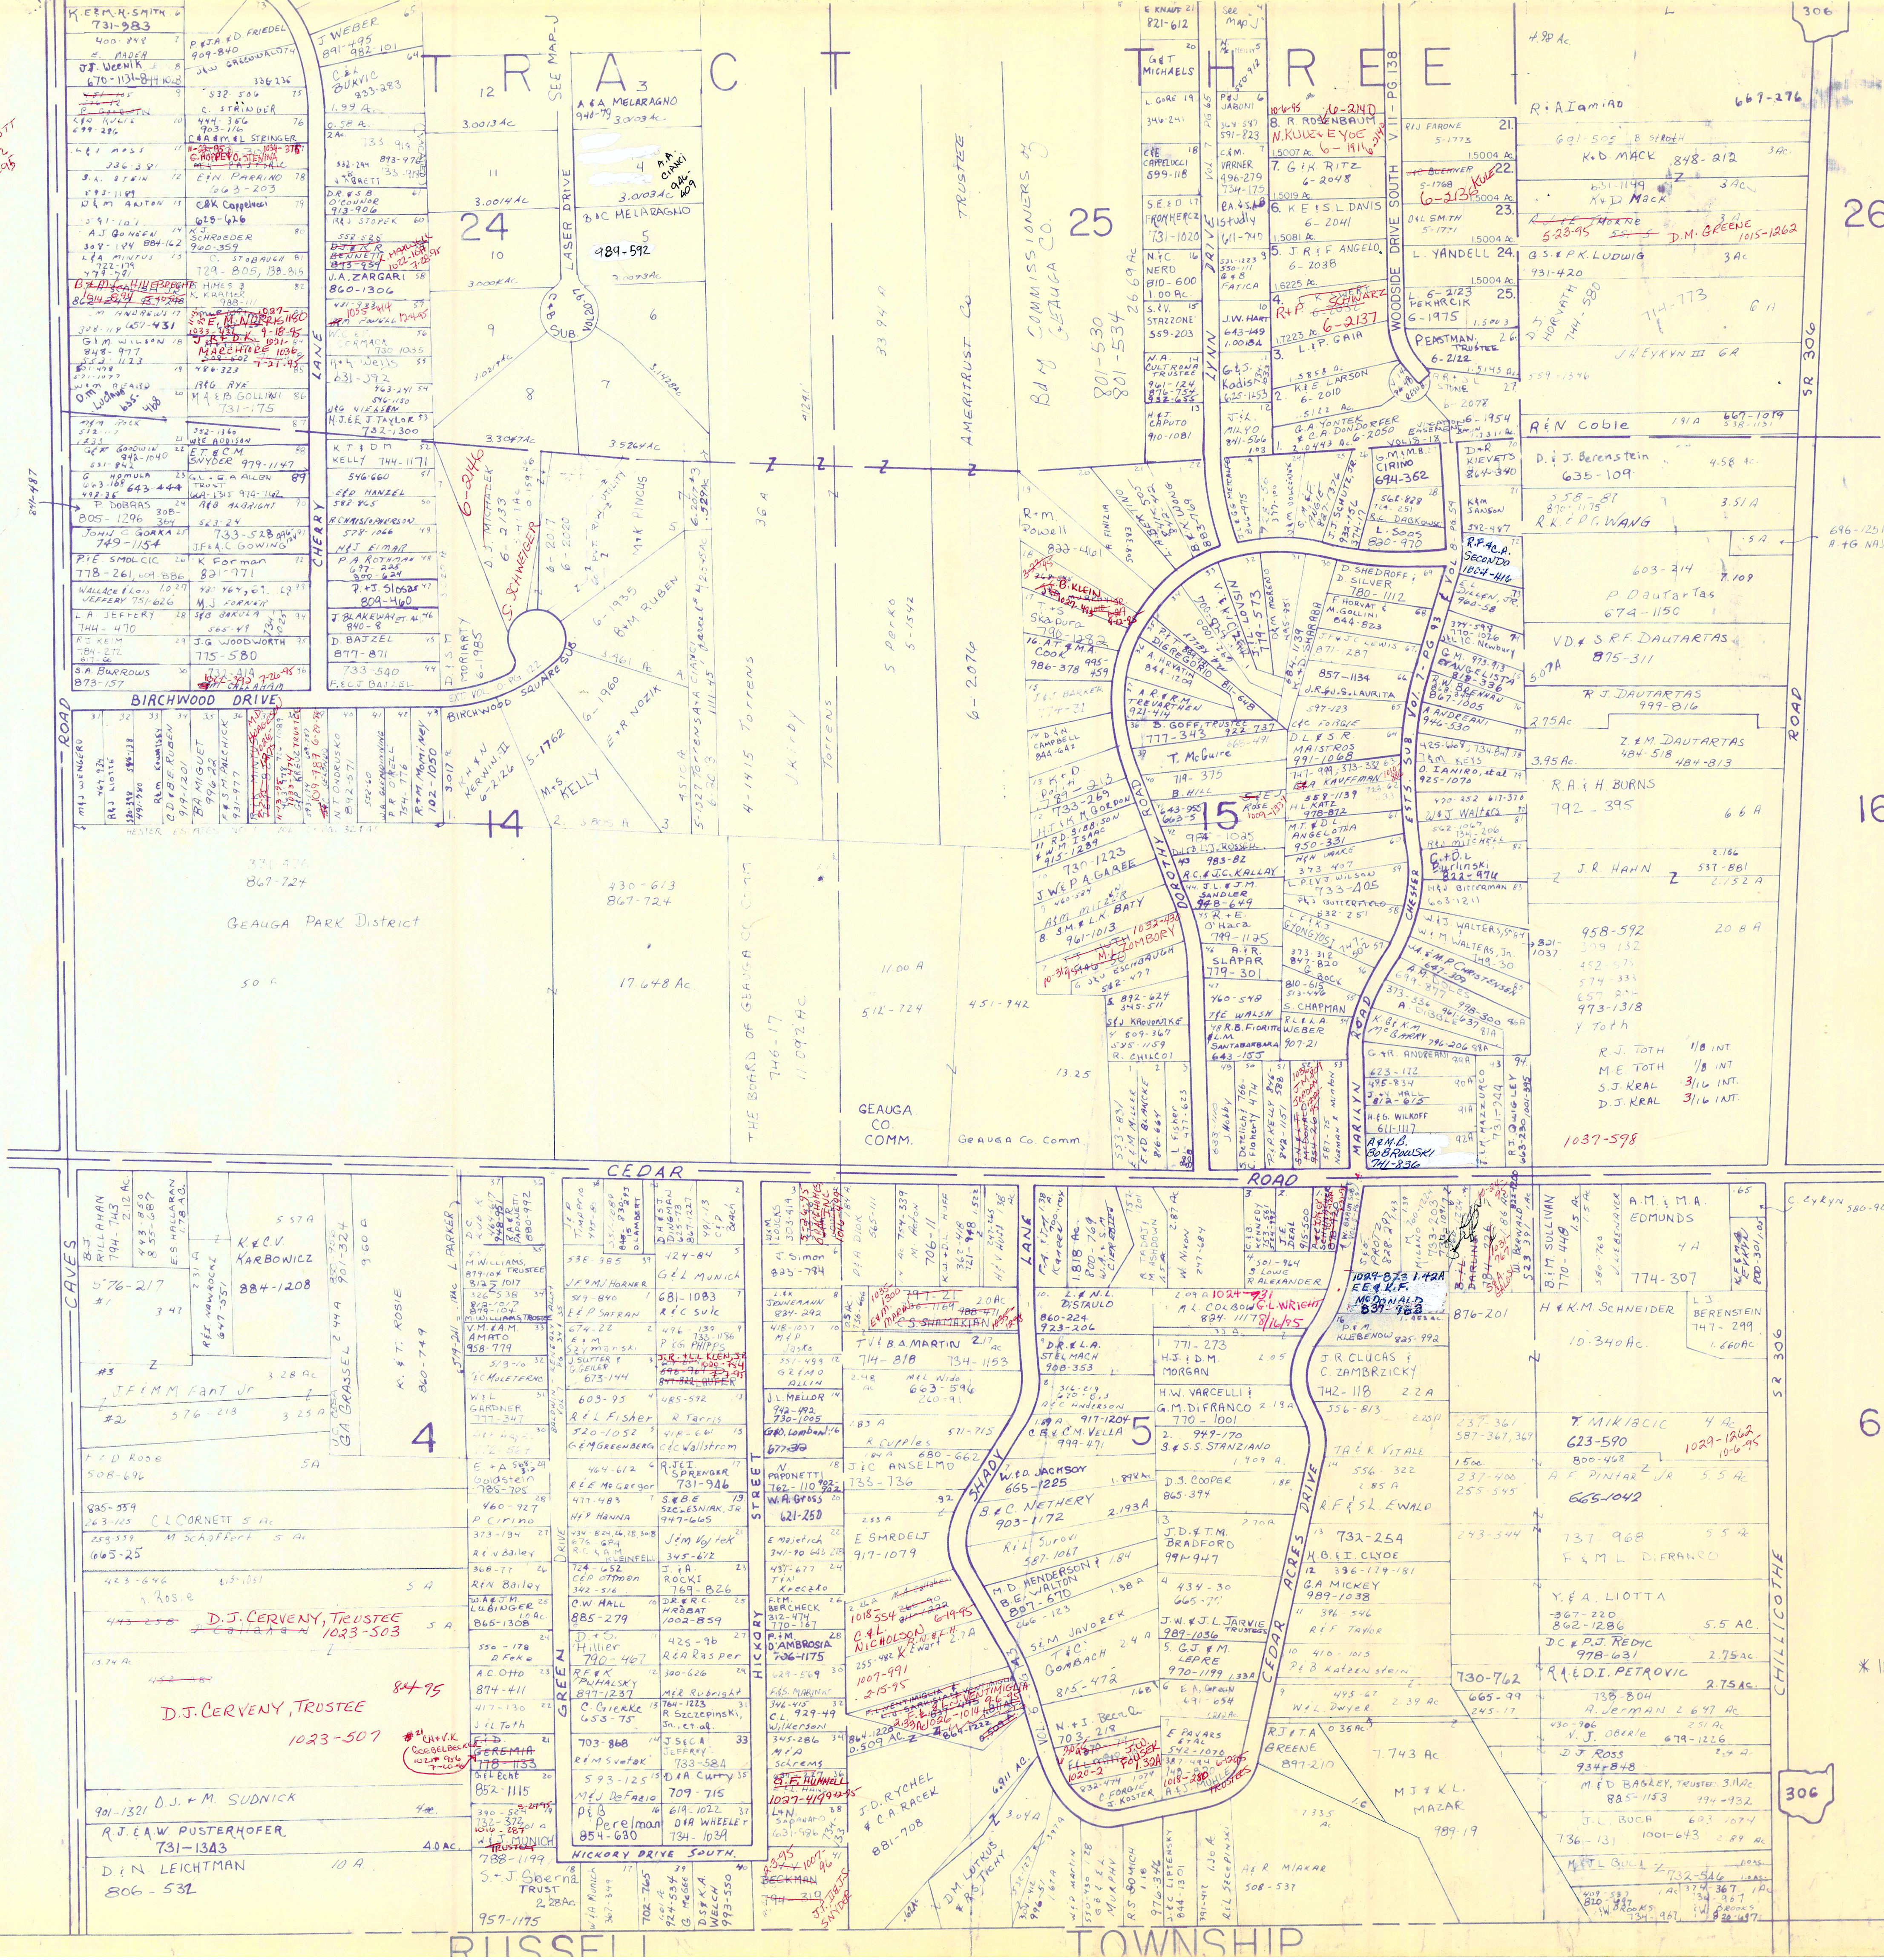

SCALE 1"=300'

RELATIVE REPRESENTATION


A	B	C	D
E	F	G	H
I	J	K	L
M	O	P	

CHESTERN

* Inadequate description

306

306 T R A C T THREE

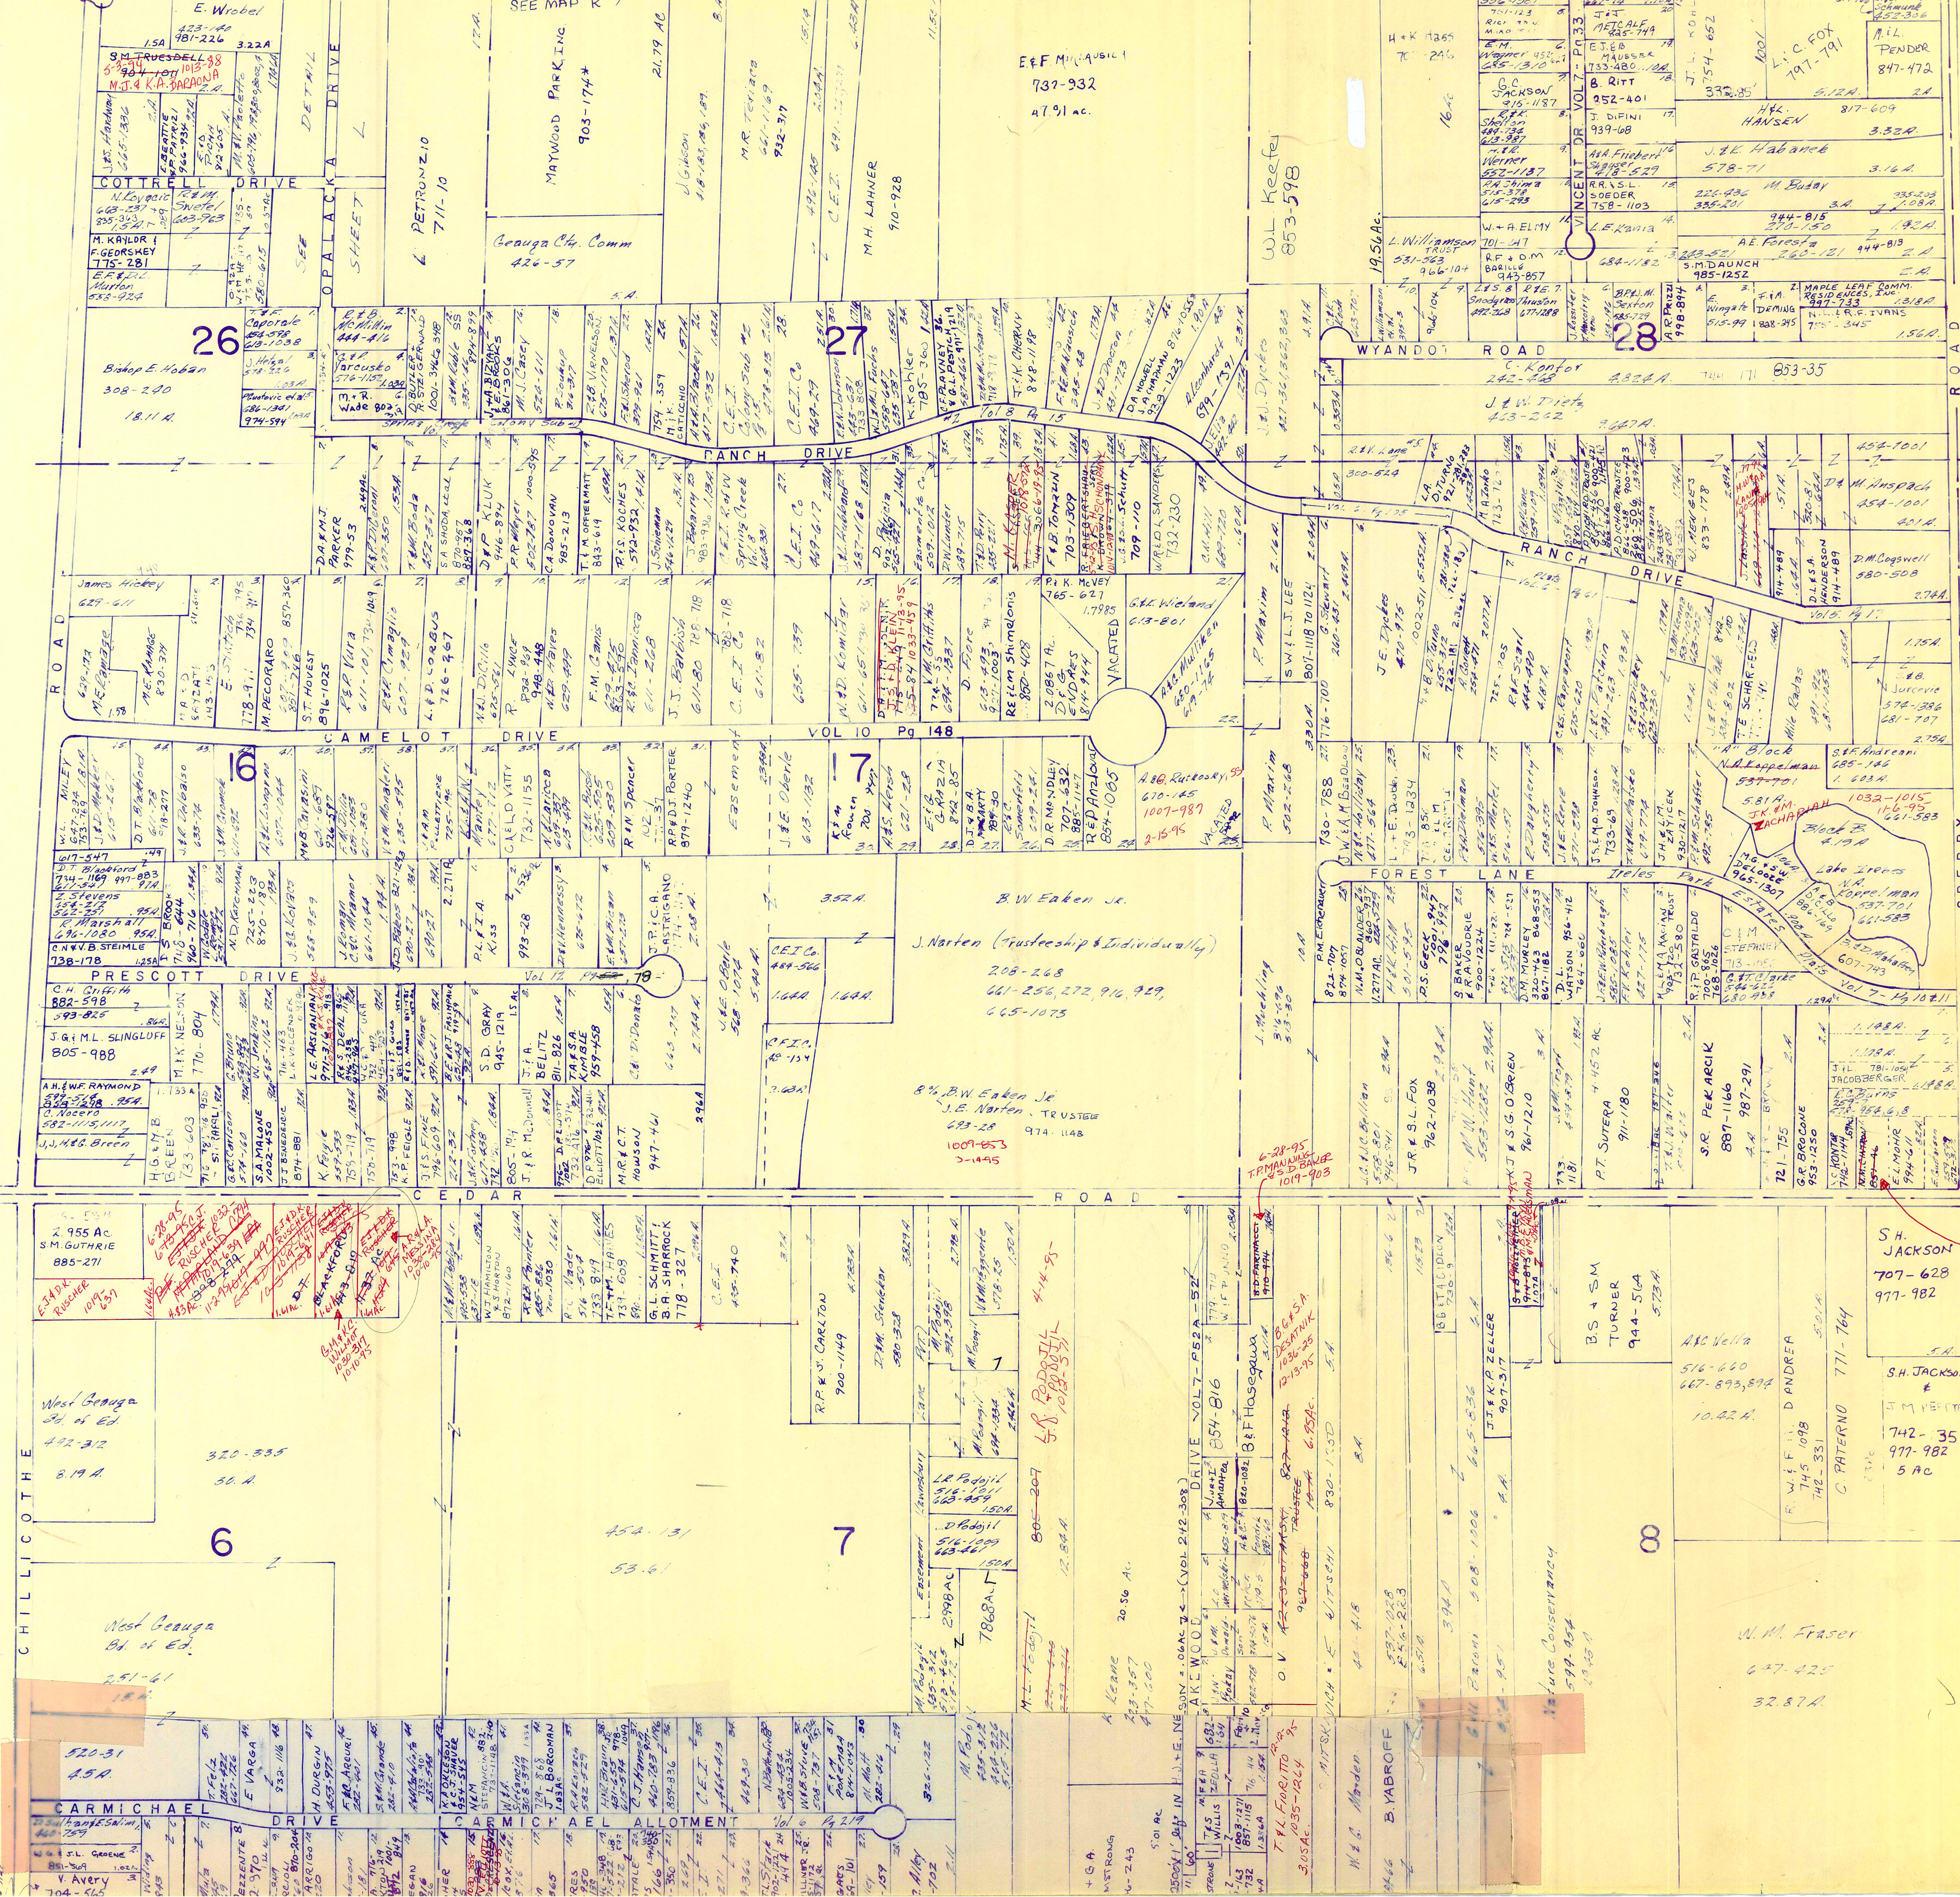

SCALE 1" = 300'

- SWAGGER SURVEY 466 Pg. 49 Plots
1. EL. IN. M. LINTON 200-812
 2. EL. MAHO 994-611
 3. E. GUSTAFSON 259-899, 412-312
 4. R. C. BURNS 259-757, 256-608
 5. T. L. JACOBBERGER 78-1054
 - 6.
 - 7.




JANUARY 1, 1995
RELATIVE REPRESENTATION

A	B	C	D
E	F	G	H
I	J	K	L
M	N	O	P

CHESTER O

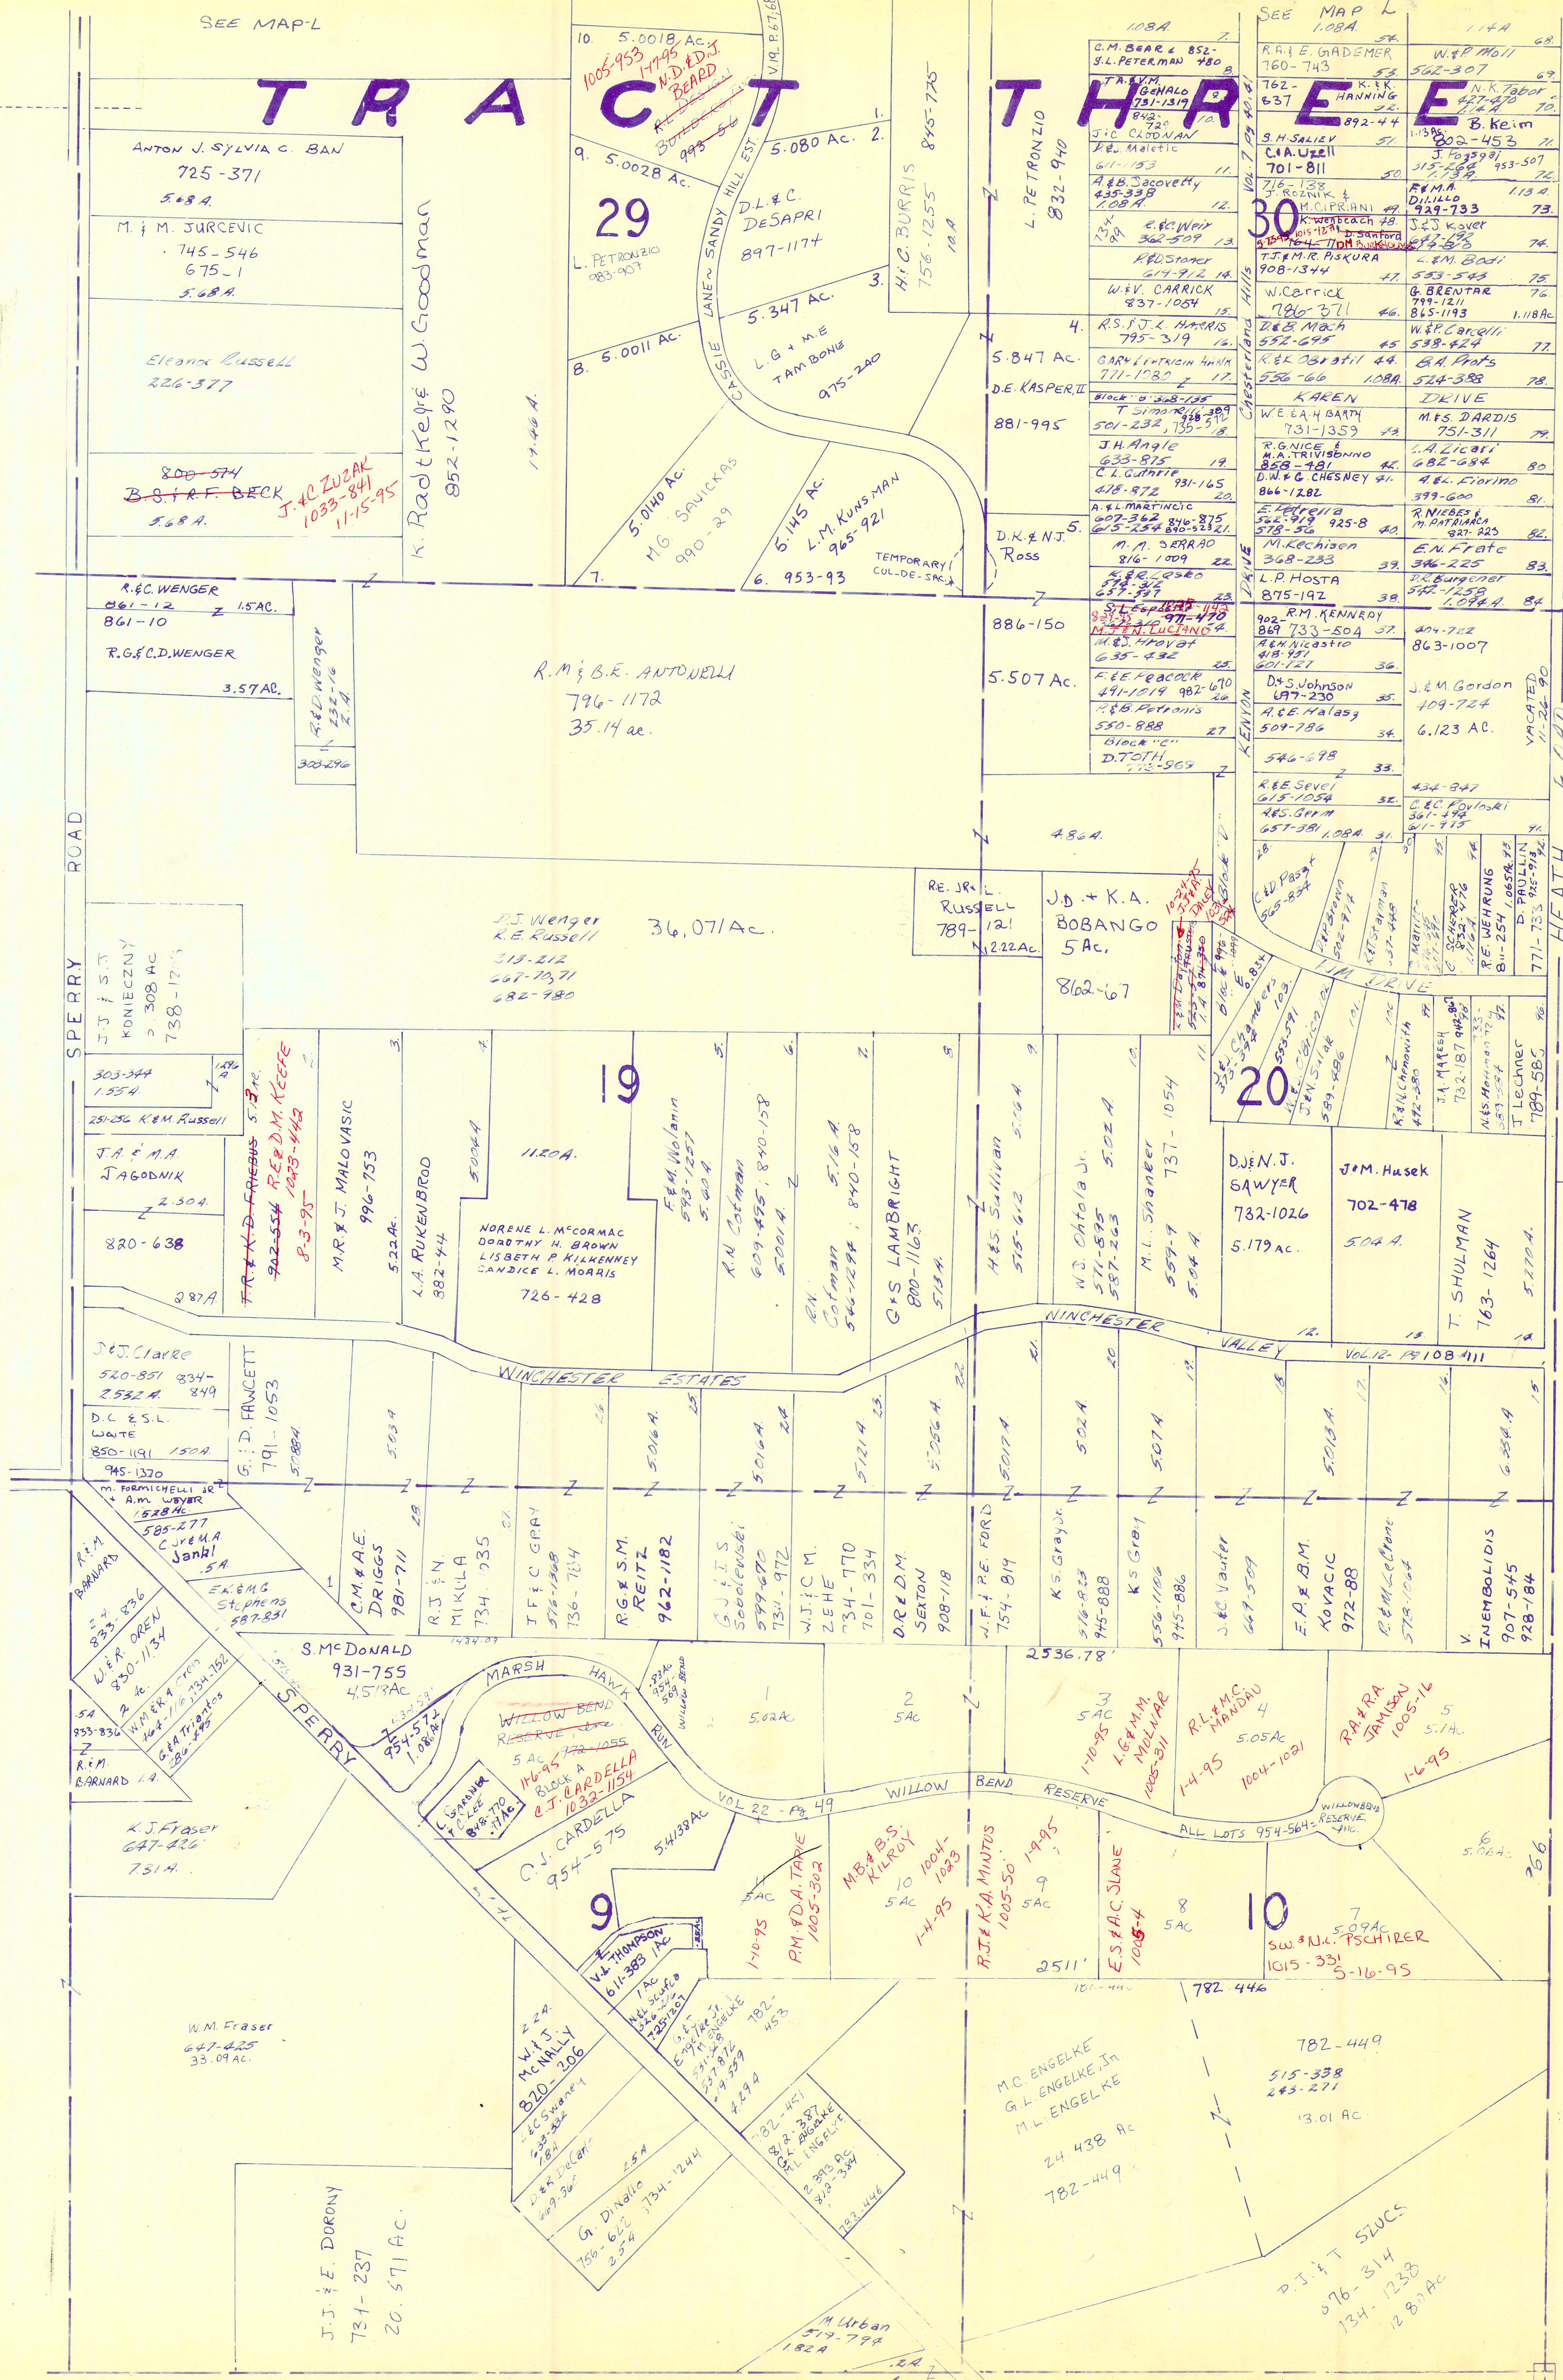

MUNSON TOWNSHIP

SCALE " = 300'
JANUARY 1, 1995

RELATIVE REPRESENTATION

* Inadequate description

A	B	C	D
E	F	G	H
I	J	K	L
M	N	O	

CHESTER P

CHESTER DR