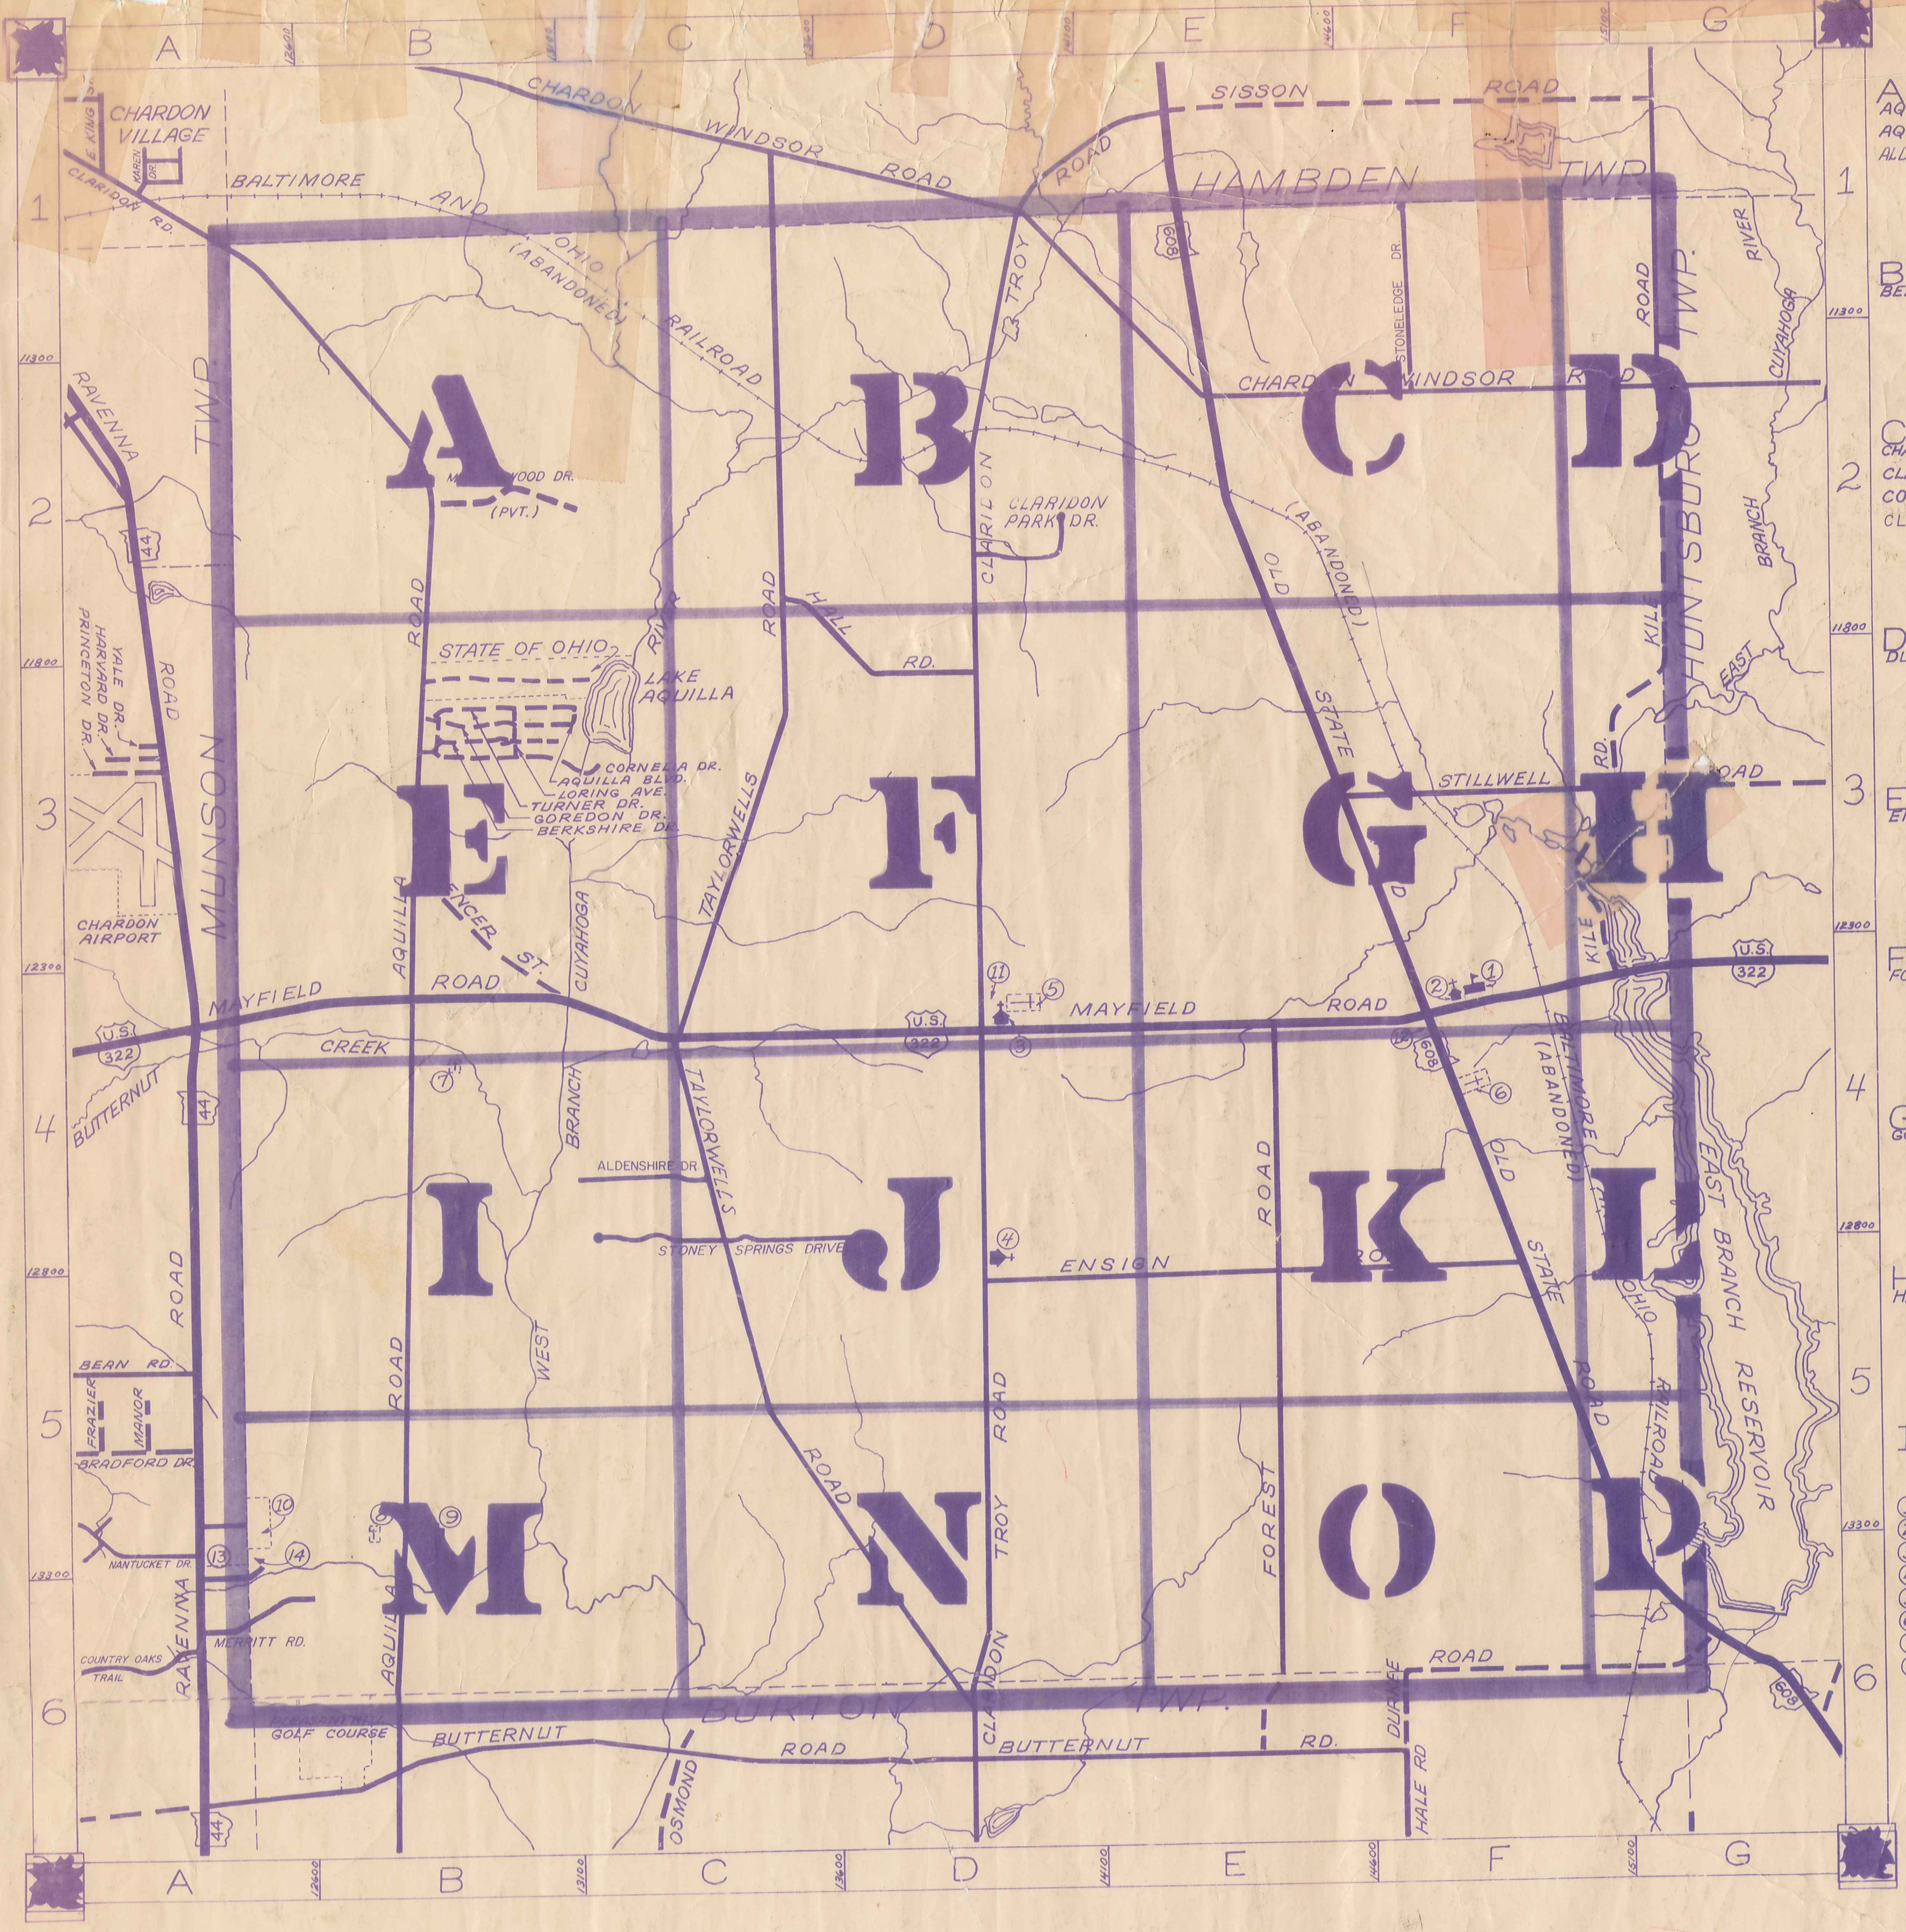
A
B
C
D
E
F
G
1
2
3
4
5
6
CHARDON VILLAGE
CLARIDON RD.
BALTIMORE AND OHIO (ABANDONED) RAILROAD
CHARDON WINDSOR ROAD
SISSON ROAD
HAMBDEN TWP.
CLARIDON TROY ROAD
CHARDON WINDSOR RD.
STONELEDGE DR.
HUNTSBURG TWP.
KILE ROAD
CUYAHOGA RIVER
EAST BRANCH
MEADOWWOOD DR. (PVT.)
CLARIDON PARK DR.
OLD STATE ROAD (ABANDONED)
RAVENNA ROAD
YALE DR.
HARVARD DR.
PRINCETON DR.
CHARDON AIRPORT
MUNSON TWP.
STATE OF OHIO
LAKE AQUILLA
CORNELIA DR.
AQUILLA BLVD.
LORING AVE.
TURNER DR.
GOREDON DR.
BERKSHIRE DR.
HALL RD.
TAYLORWELLS
SPENCER ST.
CUYAHOGA
AQUILLA ROAD
MAYFIELD ROAD
U.S. 322
44
CREEK
BUTTERNUT
STILLWELL
ROAD
WEST BRANCH
ALDENSHIRE DR.
STONEY SPRINGS DRIVE
ENSIGN
FOREST ROAD
TROY ROAD
BALTIMORE AND OHIO RAILROAD (ABANDONED)
EAST BRANCH RESERVOIR
608
BEAN RD.
FRAZIER
MANOR
BRADFORD DR.
NANTUCKET DR.
MERRITT RD.
COUNTRY OAKS TRAIL
GOLF COURSE
BUTTERNUT ROAD
BURTON TWP.
OSMOND
DURKEE
HALE RD.
A
B
C
D
E
F
G
H
I
J
K
L
M
N
O
P
11300
11800
12300
12800
13300
13800
14300
14800
15300
① ② ③ ④ ⑤ ⑥ ⑦ ⑧ ⑨ ⑩ ⑪ ⑫ ⑬ ⑭

ROAD INDEX

A	
AQUILLA BLVD.	C3
AQUILLA RD.	A1-B6
ALDENSHIRE DR.	C4
B	
BERKSHIRE DR.	B3
C	
CHARDON WINDSOR RD.	D1-G2
CLARIDON TROY RD.	D1-D6
CORNELIA DR.	B3
CLARIDON PARK DR.	D-2
D	
DURKEE RD.	F6-G6
E	
ENSIGN RD.	D5-F5
F	
FOREST RD.	E4-E6
G	
GOREDON DR.	B3
H	
HALL RD.	C2-D3
I	
I con't	
J	
K	
KILE RD.	F4-G1
L	
LORING AVE.	B3
M	
MAYFIELD RD.	A4-G4
MEADOWWOOD DR.	B2
MERRITT RD.	A6
N	
O	
OLD STATE RD.	E1-G6
P	
Q	
R	
S	
SPENCER ST.	B3-B4
STILLWELL RD.	F3-G3
STONELEDGE DR.	F1-F2
STONEY SPRINGS DR.	C4
T	
TAYLORWELLS RD.	C1-D6
TURNER DR.	B3
U	
V	
W	
X	
Y	
Z	

① CLARIDON LOCAL SCHOOL
② EAST CLARIDON METHODIST CHURCH
③ THE FIRST CONGREGATIONAL CHURCH
④ CHRISTIAN MISSIONARY ALLIANCE CH.
⑤ CLARIDON CENTER CEMETERY
⑥ EAST CLARIDON CEMETERY
⑦ WEST CLARIDON CEMETERY
⑧ CEMETERY
⑨ PLEASANT HILL COUNTY HOME
⑩ GEAUGA COUNTY COMM. HOSPITA
⑪ CLARIDON TOWN HALL
⑫ U.S. POST OFFICE (CLARIDON)
⑬ GEAUGA COUNTY SAFETY CENTER
⑭ GEAUGA COUNTY WELFARE DEPT.
⑮
⑯

CLARIDON TOWNSHIP

0 5 10 15 20

SCALE = 1" = 2000'

ROBERT L. PHILLIPS,
GEAUGA COUNTY ENGINEER

— — UNPAVED ROAD
—— PAVED ROAD
+—+—+ RAILROAD
- - - TOWNSHIP LINE

carried forward from 84
1-25-93
KB

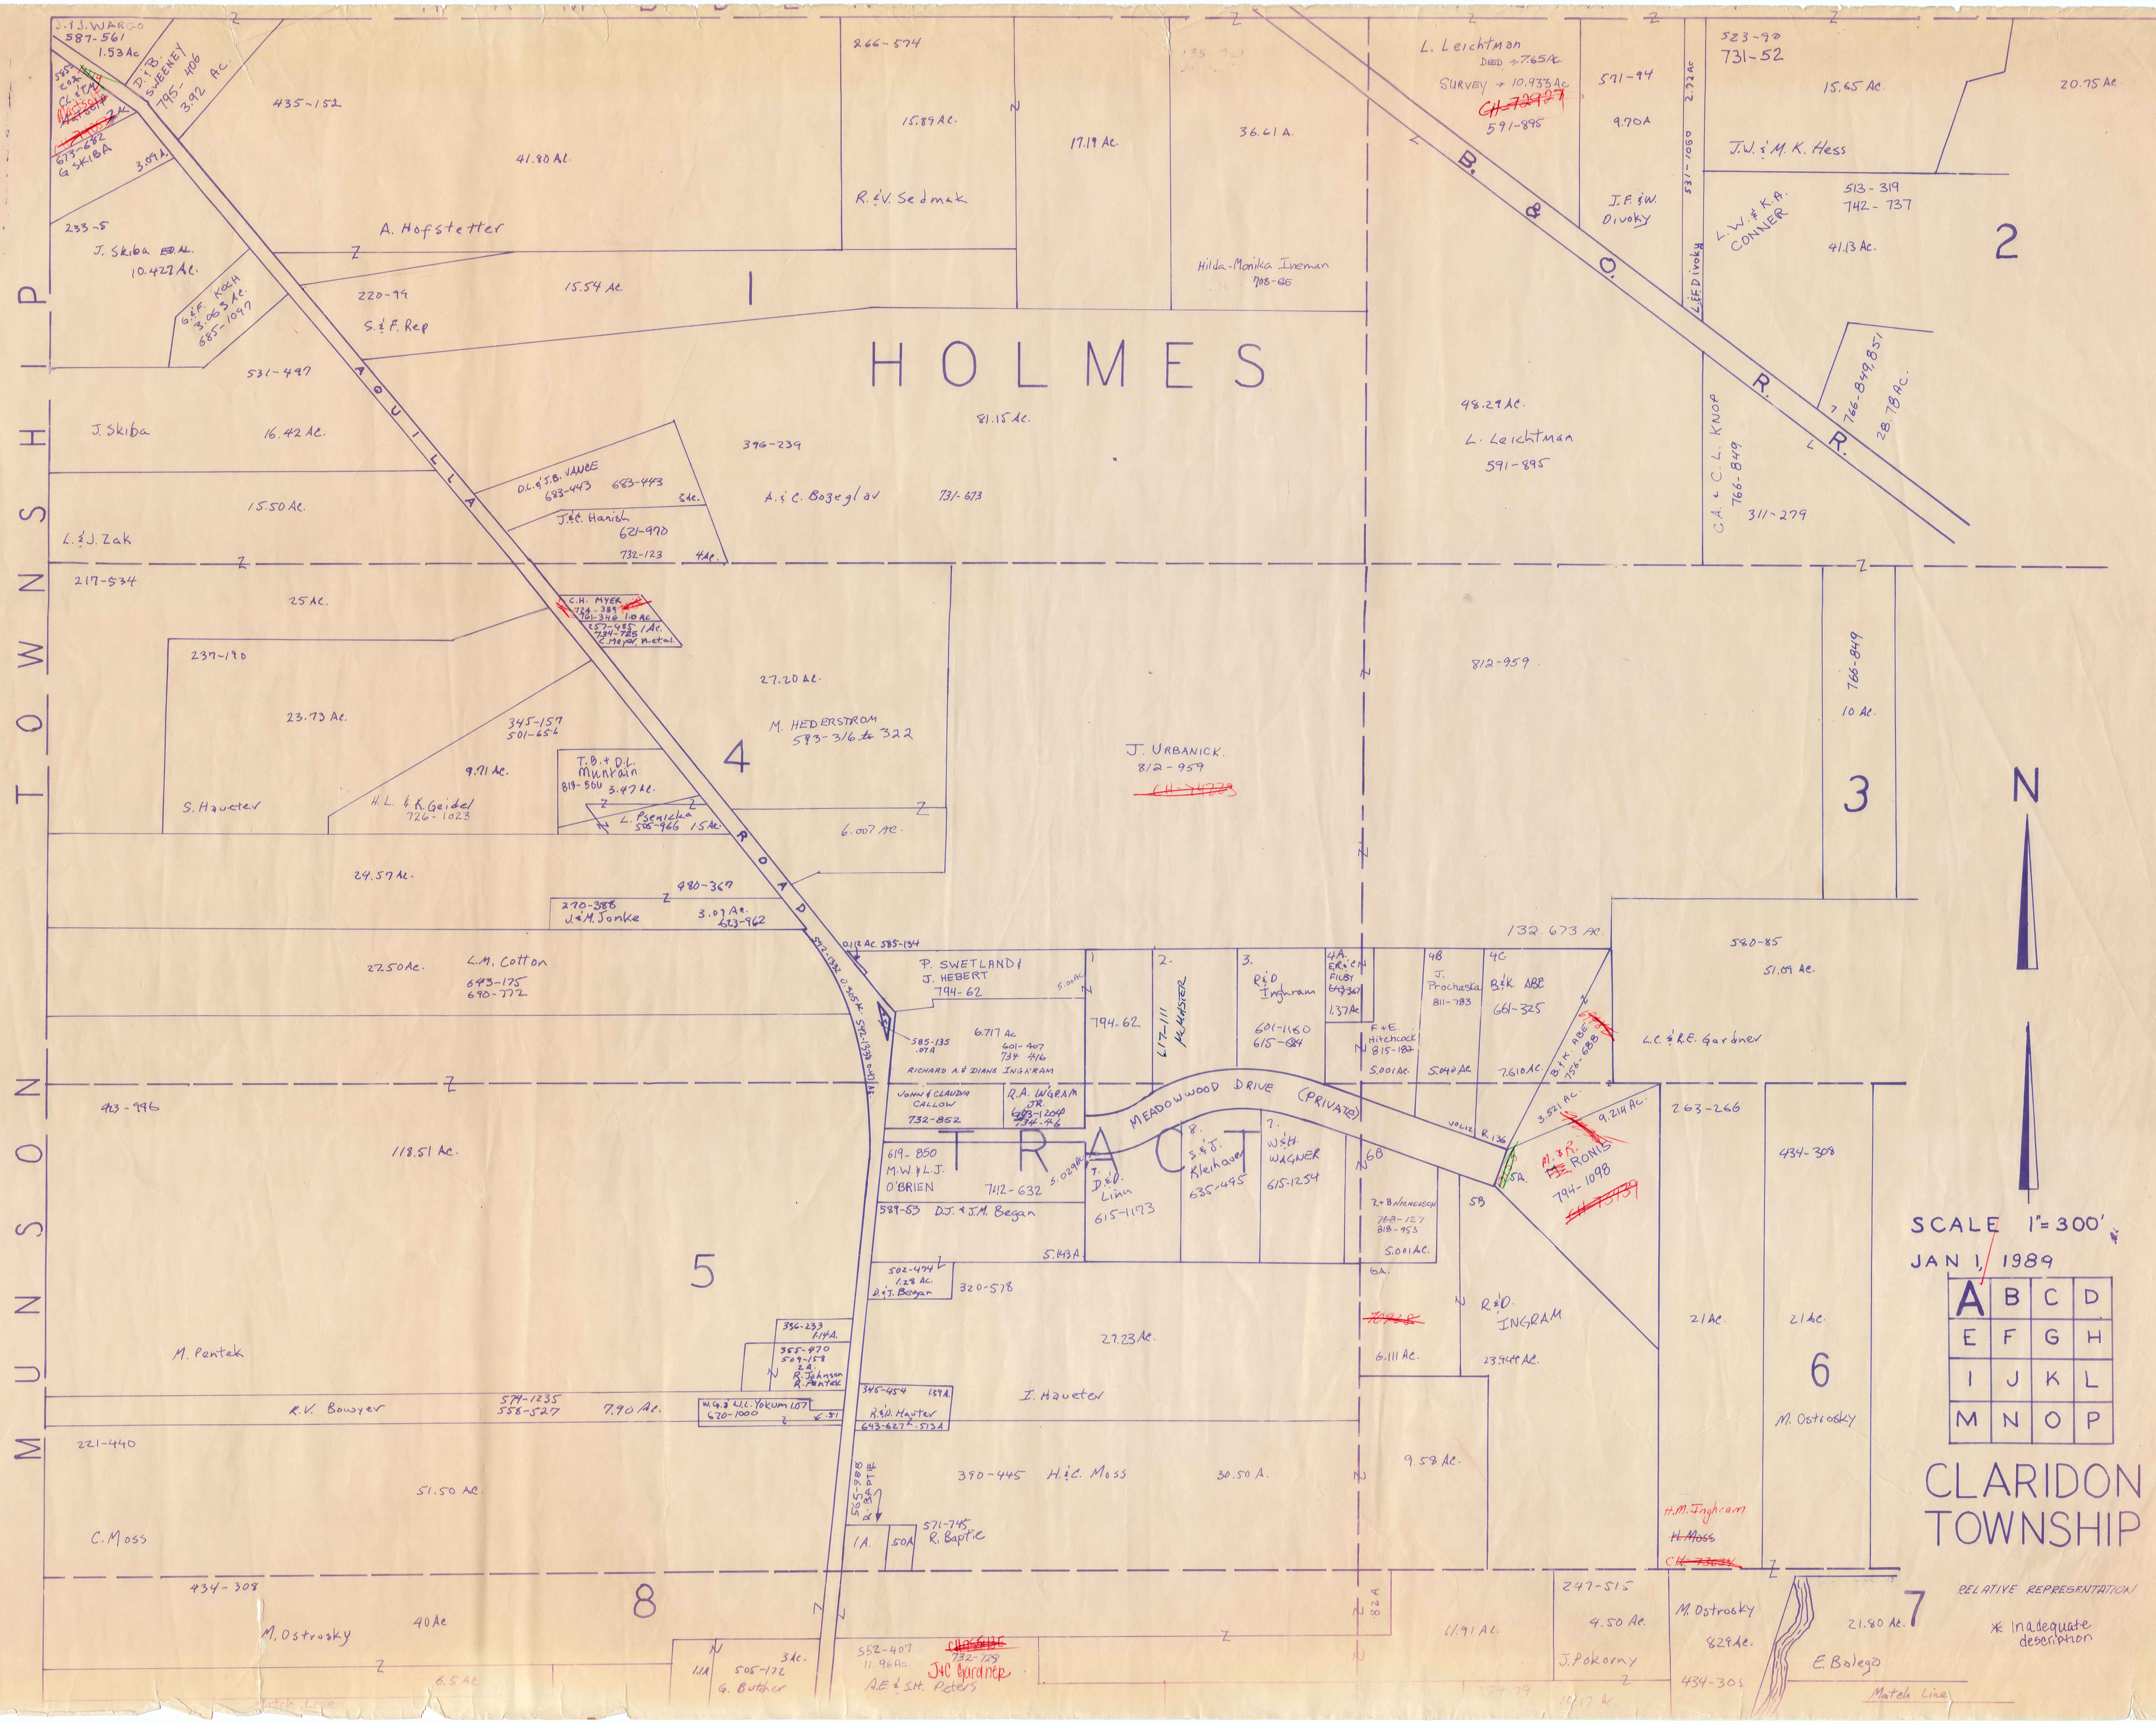
J.&J. WARGO
587-561
1.53 Ac
D.&B. SWEENEY
795-406
3.92 Ac.
673-682
G SKIBA
3.09 A.
435-152
41.80 Ac.
266-574
15.89 Ac.
R.&V. Sedmak
17.19 Ac.
36.61 A.
Hilda-Monika Ineman
708-65
233-5
J. Skiba ET AL.
10.427 Ac.
G.&F. Koch
3.063 Ac.
685-1097
A. Hofstetter
220-79
S.&F. Rep
15.54 Ac
1
HOLMES
81.15 Ac.
531-497
J. Skiba
16.42 Ac.
396-239
D.L.&J.B. VANCE
683-443
683-443
3Ac.
J.&C. Hanish
621-970
732-123
4Ac.
A.&C. Bozeglav
731-673
15.50 Ac.
L.&J. Zak
AQUILLA ROAD
L. Leichtman
DEED → 7.65 Ac.
SURVEY → 10.933 Ac
~~CH-72927~~
591-895
571-94
9.70A
2.72 Ac
531-1060
J.F.&W. Divoky
L.&F. Divoky
523-90
731-52
15.65 Ac.
20.75 Ac.
J.W.&M.K. Hess
513-319
742-737
L.W.&K.A. CONNER
41.13 Ac.
2
B.&O. R.R.
766-849,851
28.78 Ac.
48.29 Ac.
L. Leichtman
591-895
C.A.+C.L. KNOP
766-849
311-279
217-534
25 Ac.
C.H. MYER
724-389
761-346 1.0 Ac
257-485 1 Ac.
734-725
C. Meyer, n. et al.
237-190
23.73 Ac.
27.20 Ac.
M. HEDERSTROM
583-316 to 322
345-157
501-656
9.71 Ac.
H.L.&K. Geidel
726-1023
T.B.+D.L. Muntain
819-560 3.47 Ac.
L. Psenicka
585-966 1.5Ac.
S. Haueter
4
6.007 Ac.
J. URBANICK
812-959
~~CH-74273~~
812-959
766-849
10 Ac.
3
N
24.57 Ac.
480-367
270-388
J.&M. Jonke
3.07 Ac.
623-962
22.50 Ac.
L.M. Cotton
643-175
690-772
132.673 Ac.
0.112 AC. 585-134
542-1332 0.305 Ac.
542-1332 0.47 AC.
P. SWETLAND & J. HEBERT
794-62
5.00 Ac
585-135
.07A
6.717 Ac
601-407
734-416
RICHARD A.& DIANE INGRAM
1
794-62
2.
617-111 McMASTER
3.
R.&D. Inghram
601-1160
615-684
4A.
E.R.&C.N. FILBY
643-367
1.37 Ac
F+E. Hitchcock
815-182
5.001 Ac.
4B
J. Prochaska
811-783
5.040 Ac
4C
B.&K. ABE
661-325
7.610 Ac.
B.&K. ABE
756-688
580-85
51.09 Ac.
L.C.&R.E. Gardner
443-496
JOHN & CLAUDIA CALLOW
732-852
R.A. INGRAM JR.
693-1204
734-46
MEADOWWOOD DRIVE (PRIVATE)
TRACT
VOL.112 R.136
3.521 Ac.
9.214 Ac.
M.&R. ~~M.E.~~ RONIS
794-1098
~~CH-73139~~
263-266
434-308
118.51 Ac.
619-850
M.W.&L.J. O'BRIEN
742-632
5.029 Ac.
589-53 D.J.&J.M. Began
5.143A
7.
D.&D. Linn
615-1173
8.
S.&J. Kleinhauer
635-495
7.
W.&H. WAGNER
615-1254
6B
R+B NICHOLSON
768-127
818-953
5.001 Ac.
5A.
5B
6A.
~~70928~~
6.111 Ac.
R.&D. INGRAM
23.944 Ac.
21 Ac.
21 Ac.
6
M. Ostrosky
5
502-474
1.28 Ac.
D.&J. Began
320-578
27.23 Ac.
336-233
1.14A.
355-470
509-158
2A.
R. Johnson
R. Pentek
M. Pentek
R.V. Bowyer
574-1235
558-527
7.90 Ac.
W.G.& N.L. Yokum 1.07
620-1000
.51
345-454
1.39A.
R.&D. Hauter
643-627 .513A
I. Haueter
221-440
51.50 Ac.
565-988 R. BAPTIE
390-445
H.&C. Moss
30.50 A.
9.58 Ac.
C. Moss
1A.
.50A
571-745
R. Baptie
H.M. Inghram
~~H. Moss~~
~~CH-73634~~
434-308
8
M. Ostrosky
40 Ac
6.5 Ac
1.1A
505-172
3Ac.
G. Butcher
552-407
11.96 Ac.
~~CH-65185~~
732-728
J&C Gardner
A.E.&S.H. Peters
.82A
11.91 Ac.
247-515
4.50 Ac.
J. Pokorny
M. Ostrosky
829 Ac.
434-308
21.80 Ac.
7
E. Bolego
Match Line
Match Line
N
SCALE 1"=300'
JAN 1, 1989
A B C D
E F G H
I J K L
M N O P
CLARIDON TOWNSHIP
RELATIVE REPRESENTATION
* Inadequate description
MUNSON TOWNSHIP

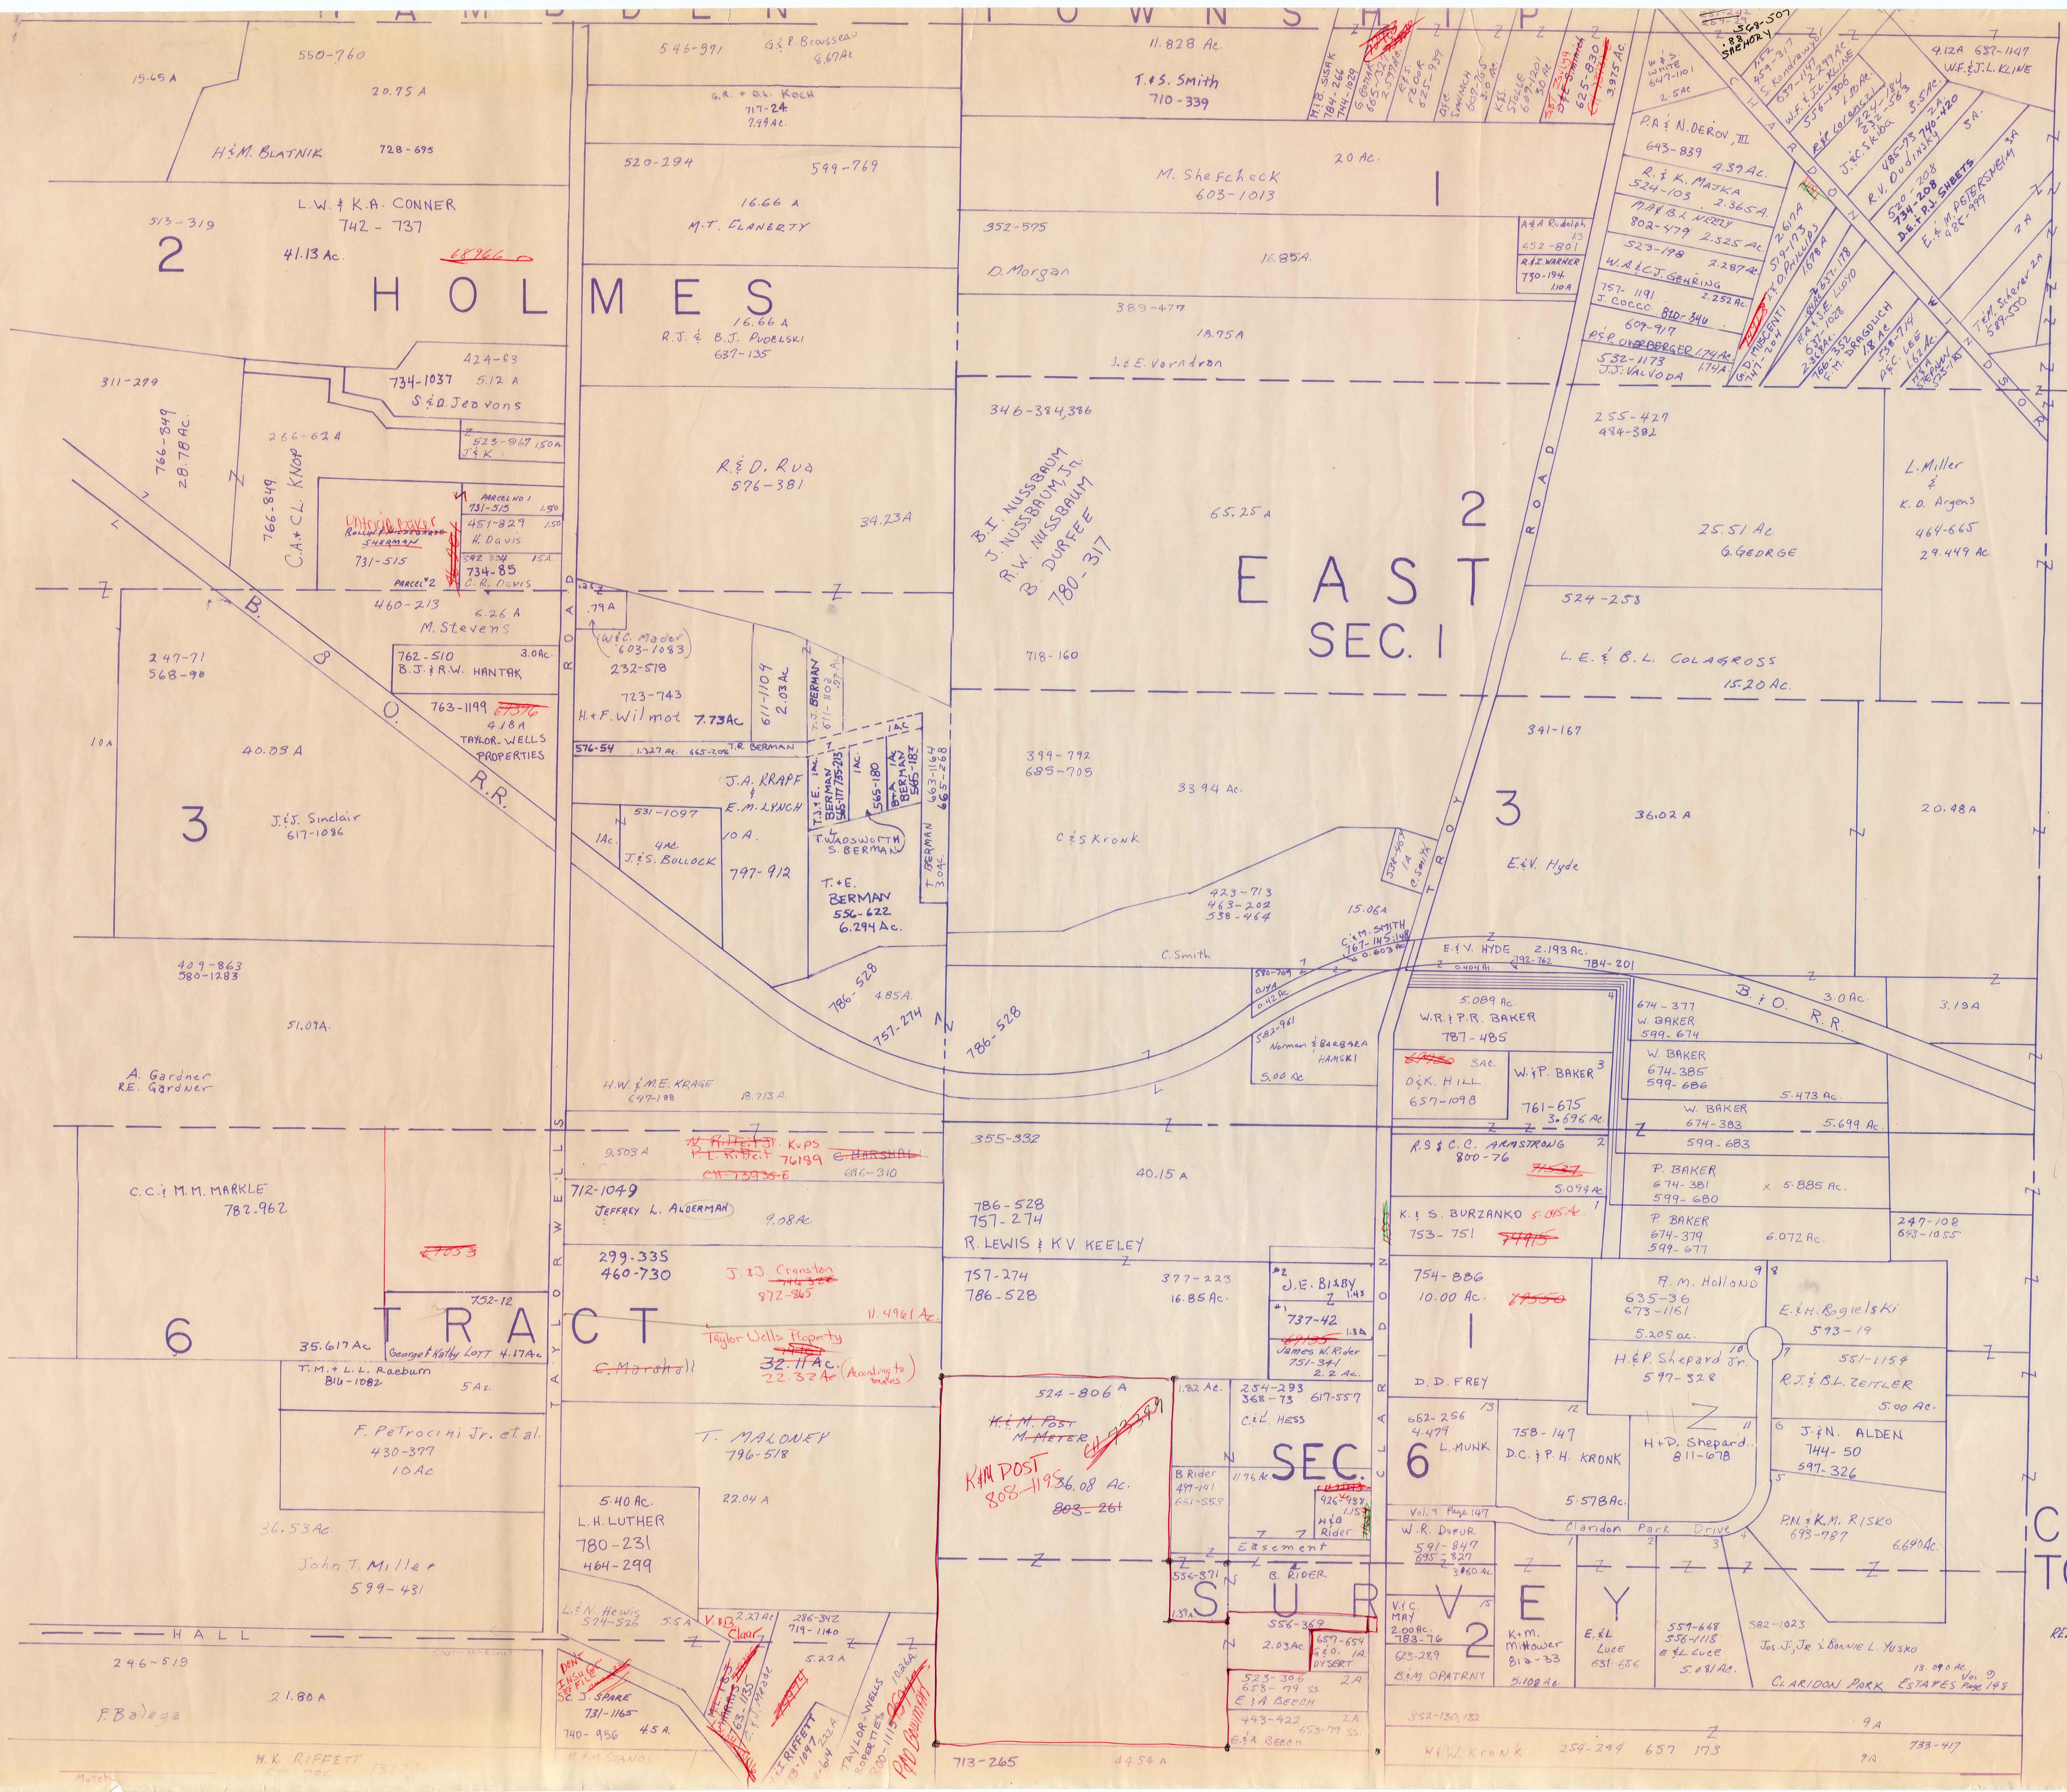
HAMBDEN TOWNSHIP
2
HOLMES
3
6
TRACT
2
EAST
SEC. I
3
I
SEC. 6
SURVEY
2
B. & O. R.R.
TAYLOR WELLS ROAD
CLARIDON TROY ROAD
HALL
Claridon Park Drive
CLARIDON PARK ESTATES Vol. 9 Page 148
550-760
15.65 A
20.75 A
H&M. BLATNIK
728-695
L.W. & K.A. CONNER
742-737
513-319
41.13 Ac.
~~68966~~
546-991
G.& R. Brousseau 8.67 Ac.
G.R. & D.L. KOCH 717-24 7.49 Ac.
520-294
599-769
16.66 A
M.T. CLANERTY
16.66 A
R.J. & B.J. PUDELSKI
637-135
424-83
734-1037
5.12 A
S & D. Jedvons
311-279
766-849 28.78 Ac.
266-624
766-849
C.A. + C.L. KNOP
523-867 .150 A
J & K
R & D. Rua
576-381
34.23 A
451-829
H. Davis
734-85
O.R. Davis
731-515
460-213
6.26 A
M. Stevens
762-510
3.0 Ac.
B.J. & R.W. HANTAK
763-1199
4.18 A
TAYLOR WELLS PROPERTIES
247-71
568-90
40.03 A
10 A
J & J. Sinclair
617-1086
W & E. Mader 603-1083
232-518
723-743
H+F. Wilmot
7.73 Ac
611-1104
2.03 Ac.
576-54
1.327 Ac.
665-208
T.R. BERMAN
J.A. KRAFF & E.M. LYNCH
531-1097
4 Ac.
1 Ac.
J.& S. BULLOCK
10 A.
797-912
T. WADSWORTH
S. BERMAN
T. + E. BERMAN
556-622
6.294 Ac.
663-1164
665-268
T. BERMAN 3.0 Ac.
786-528
4.85 A.
757-274
409-863
580-1283
51.07 A.
A. Gardner
R.E. Gardner
H.W. & M.E. KRAGE
647-188
18.713 A.
11.828 Ac.
T. & S. Smith
710-339
20 Ac.
M. Shefcheck
603-1013
352-575
D. Morgan
16.85 A.
389-477
18.75 A
J. & E. Vorndran
346-384,386
B.I. NUSSBAUM
J. NUSSBAUM, Jr.
R.W. NUSSBAUM
B. DURFEE
780-317
65.25 A
718-160
399-792
685-705
33.94 Ac.
C & S Kronk
423-713
463-202
538-464
15.06 A
C. Smith
E.&V. HYDE
2.193 Ac.
784-201
Norman & BARBARA HAMSKI
5.00 Ac
W.R. & P.R. BAKER
787-485
5.089 Ac.
O&K. HILL
657-1098
W. & P. BAKER
761-675
3.696 Ac.
674-377
W. BAKER
599-674
W. BAKER
674-385
599-686
5.473 Ac.
W. BAKER
674-383
599-683
5.699 Ac.
3.0 Ac.
3.19 A
P.A. & N. DERON, III
643-839
4.39 Ac.
R. & K. MAJKA
524-103
2.365 A.
802-479
2.325 Ac.
523-198
W.A. & C.J. GEHRING
2.287 Ac.
757-1191
J. COCCO
2.252 Ac.
609-917
R.S.P. OVERBERGER
532-1173
J.J. VALVODA
A&A Rudolph
652-801
R & I. WARNER
730-194
4.12 A
637-1147
W.F. & J.L. KLINE
R.V. Oudinsky
E. & M. PETERSHEIM
T & M. Scherer
255-427
484-382
25.51 Ac.
G. GEORGE
L. Miller & K.D. Argons
464-665
29.449 Ac.
524-258
L.E. & B.L. COLAGROSS
15.20 Ac.
341-167
36.02 A
E.&V. Hyde
20.48 A
C.C. & M.M. MARKLE
782-962
9.503 A
~~R. Riffett~~ KIPS
~~P.L. Riffett~~ 76199
~~C. MARSHALL~~
646-310
712-1049
JEFFREY L. ALDERMAN
9.08 Ac
299-335
460-730
J. & J. Cranston
872-865
11.4961 Ac
Taylor Wells Property
~~32.11 Ac.~~
22.32 Ac (According to taxes)
~~C. Marshall~~
752-12
35.617 Ac
George & Kathy LOTT
4.17 Ac
T.M. & L.L. Raeburn
816-1082
5 Ac.
F. Petrocchi Jr. et al.
430-377
10 Ac
T. MALONEY
796-518
22.04 A
5.40 Ac.
L.H. LUTHER
780-231
464-299
36.53 Ac.
John T. Miller
599-431
246-519
21.80 A
F. Baloga
H.K. RIFFETT
L. & N. Hewis
574-526
5.5 A
2.27 Ac
V. & D. Clair
286-342
719-1140
5.22 A
S.E.J. SPARE
731-1165
4.5 A.
740-956
TAYLOR WELLS PROPERTIES
PAD Development
355-332
40.15 A
786-528
757-274
R. LEWIS & K.V. KEELEY
757-274
786-528
377-223
16.85 Ac.
J.E. BISBY
737-42
James W. Rider
751-341
2.2 Ac.
524-806
~~K&M. Post~~
~~M. Meter~~
K&M POST
808-1195
36.08 Ac.
~~803-261~~
1.82 Ac.
254-293
368-73
617-557
C & L Hess
B. Rider
497-141
651-555
1.176 Ac.
H & B Rider
Easement
556-871
B. RIDER
556-369
2.03 Ac
657-654
1 A
DYSERT
523-306
683-79
E.&A. BEECH
443-422
653-79
E.&A. Beech
713-265
44.54 A
R.S. & C.C. ARMSTRONG
800-76
5.094 Ac.
K. & S. BURZANKO
753-751
P. BAKER
674-381
599-680
5.885 Ac.
P. BAKER
674-379
599-677
6.072 Ac.
247-108
693-1055
754-886
10.00 Ac.
D.D. FREY
A.M. Holland
635-36
673-1161
5.205 Ac.
H.&P. Shepard Jr.
597-328
E.&H. Rogielski
593-19
551-1154
R.J. & B.L. ZEITLER
5.00 Ac.
662-256
4.479
L. MUNK
758-147
D.C. & P.H. KRONK
5.578 Ac.
H + D. Shepard
811-678
J. & N. ALDEN
744-50
597-326
P.N. & K.M. RISKO
693-787
6.640 Ac.
Vol. 9 Page 147
W.R. DUFUR
591-847
695-827
2.860 Ac.
V.C. MAY
2.00 Ac.
783-76
625-289
B.M. OPATRNY
K + M. Mittower
813-33
5.108 Ac.
E. & L. Luce
631-656
559-648
556-1118
E. & L. Luce
5.081 Ac.
582-1023
Jos. J. Jr. & Bonnie L. Yusko
13.090 Ac.
352-130, 132
H.W. Kronk
254-294
657-173
9 A
733-417
N

SCALE 1" = 300'

JAN 1, 1989

A	B	C	D
E	F	G	H
I	J	K	L
M	N	O	P

CLARIDON TOWNSHIP

RELATIVE REPRESENTATION

* Inadequate description

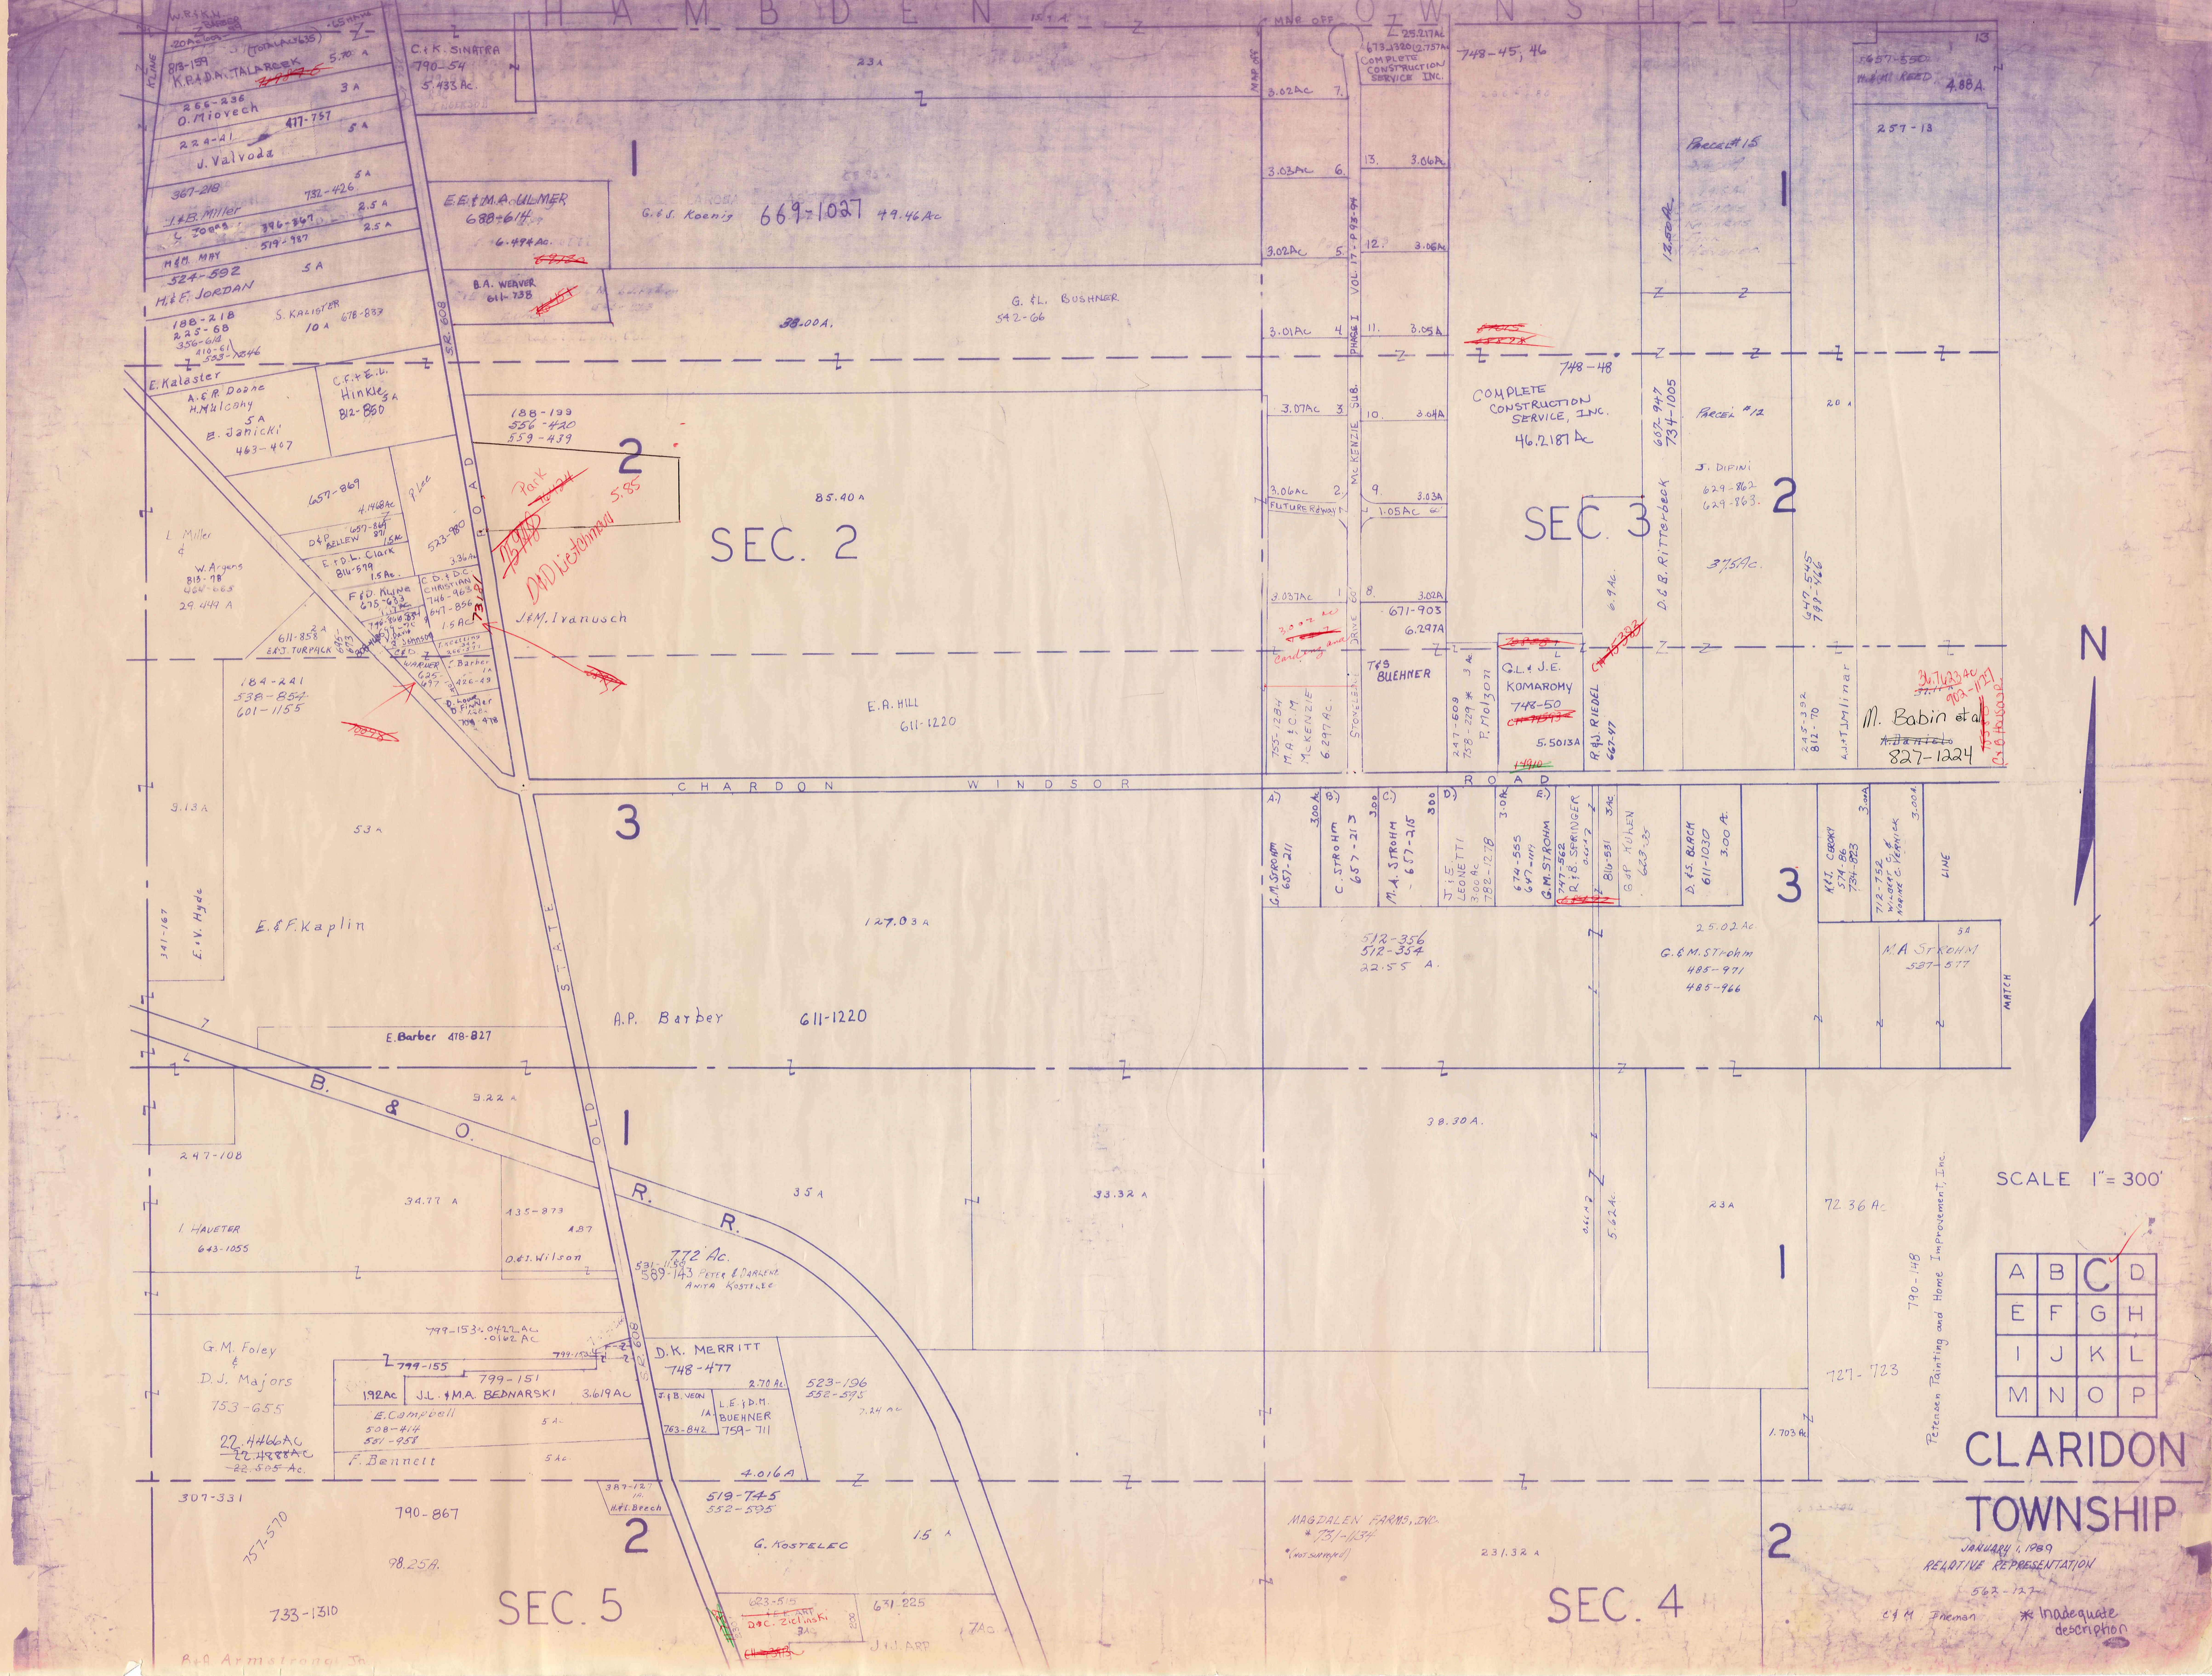
HAMBDEN TOWNSHIP
SEC. 2
SEC. 3
SEC. 4
SEC. 5
CHARDON WINDSOR ROAD
STATE ROAD
S.R. 608
OLD S.R. 608
B. & O. R.R.
N
MATCH LINE
K.P.&D.A. Talarcek
C.&K. Sinatra 790-54 5.433 Ac.
O. Miovech
J. Valvoda
M.&M. May 524-592
M.&E. Jordan
S. Kalister
E.E.&M.A. Ulmer 688-614 6.494 Ac.
B.A. Weaver 611-738
G.&S. Koenig 669-1027 49.46 Ac.
G.&L. Bushner 542-66 38.00 A.
E. Kalaster
A.&R. Dozhe
H. Mulcahy
E. Janicki 463-407
C.F.&E.L. Hinkle 812-850
188-199 556-420 559-439
Park 5.55
D&D Lieberman
J.&M. Ivanusch
E.A. Hill 611-1220
L. Miller & W. Argens 29.444 A
E.V. Hyde 341-167
E.&F. Kaplin
A.P. Barber 611-1220
E. Barber 478-827
I. Haueter 643-1055
D.&I. Wilson
Peter & Darlene Anita Kostelec 7.72 Ac.
G.M. Foley & D.J. Majors 753-655
J.L.&M.A. Bednarski
E. Campbell
F. Bennett
D.K. Merritt 748-477
L.F.&D.M. Buehner 759-711
G. Kostelec
D.&C. Zielinski
J.J. Arp
R.&D. Armstrong
790-867 98.25 A.
733-1310
Magdalen Farms, Inc. 731-1134
231.32 A
Complete Construction Service, Inc. 748-48 46.2187 A
Complete Construction Service Inc. 748-45, 46
McKenzie Sub.
G.L.&J.E. Komaromy 748-50 5.5013 A
R.&J. Riedel 667-47
D.&B. Ritterbeck
J. Difini
Parcel #12
Parcel #15
M. Babin et al 827-1224
J.&J. Milinar
T.&S. Buehner
G.M. Strohm 657-211
C. Strohm 657-213
M.A. Strohm 657-215
J.E. Leonetti
G.M. Strohm
R.&B. Springer
G.&P. Kuhen
D.&S. Black 611-1030
G.&M. Strohm 485-971 485-966
M.A. Strohm 527-577
Peterson Painting and Home Improvement, Inc. 790-48
72.36 Ac.
127.03 A
38.30 A.
33.32 A
C&M Fireman
* Inadequate description

CLARIDON TOWNSHIP

JANUARY 1, 1989

RELATIVE REPRESENTATION

SCALE 1" = 300'

A	B	C	D
E	F	G	H
I	J	K	L
M	N	O	P

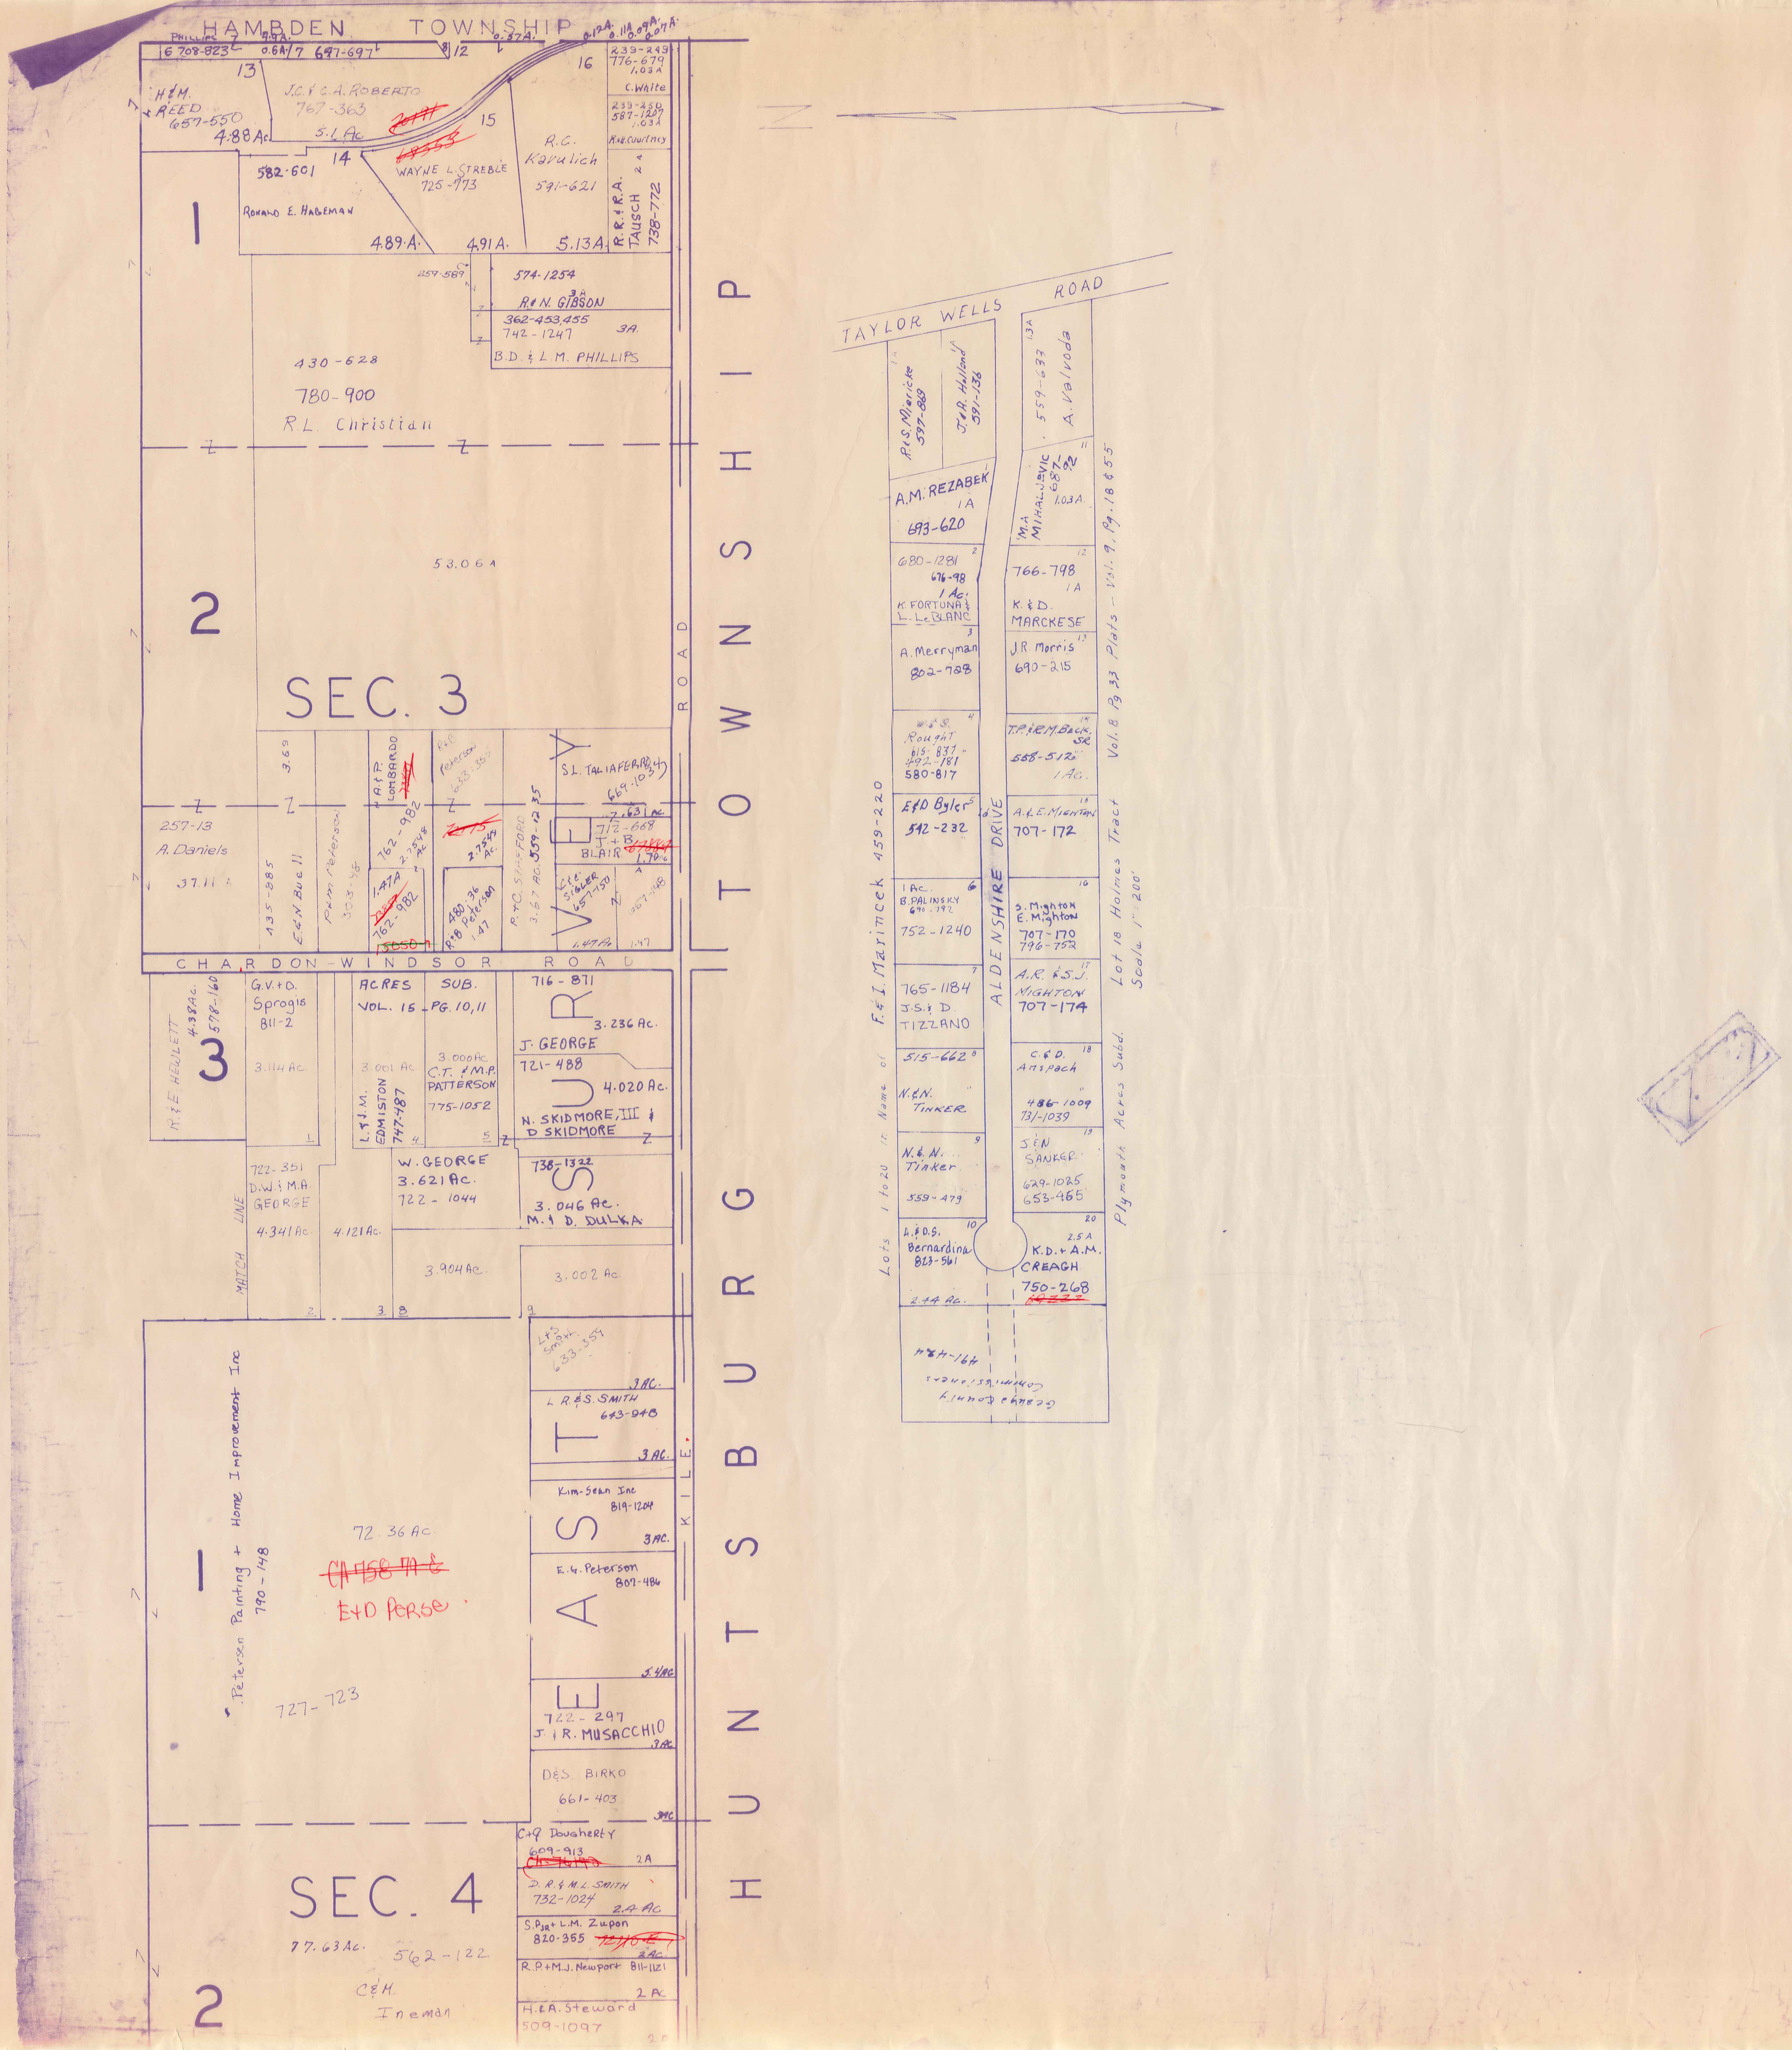
HAMBDEN TOWNSHIP
PHILLIPS
6 708-823
0.6A
7 697-697
9.9A
12
0.57A
0.12A
0.11A
0.09A
0.07A
13
H&M. REED 657-550
4.88 Ac.
J.C. & C.A. ROBERTO 767-363
5.1 Ac
~~70111~~
~~68353~~
15
16
239-249 776-679 1.03A
C. White
239-250 587-1207 1.03A
R.&H. Courtney
R.C. Kavulich 591-621
14
582-601
WAYNE L. STREBLE 725-773
RONALD E. HABEMAN
R.R. & R.A. TAUSCH 2A 738-772
4.89 A.
4.91 A.
5.13 A.
1
259-589
574-1254
3A
R. & N. GIBSON
362-453,455
742-1247
3A.
B.D. & L.M. PHILLIPS
430-628
780-900
R.L. Christian
53.06 A
2
SEC. 3
257-13
A. Daniels
37.11 A
3.69
135-885
E & N. Buell
R & M Peterson 303-98
A. & R. LOMBARDO
~~73117~~
762-982
2.7548 Ac.
1.47A
~~73857~~
762-982
~~15050~~
R & B Peterson 633-355
~~72775~~
2.7544 Ac.
480-36 R & B Peterson 1.47
R. & C. STAFFORD 3.67 AC. 559-1235
S.L. TALIAFERRO 669-1034
7.63 Ac.
712-668
J. & B. BLAIR
~~67884~~
1.70 Ac
C & C SIGLER 657-150
657-148
1.47 Ac
1.47
VEE
CHARDON-WINDSOR ROAD
R. & E. HEWLETT 4.38 Ac. 578-160
3
G.V. & D. Sprogis 811-2
3.114 Ac.
ACRES SUB. VOL. 15 - PG. 10,11
3.001 Ac.
L. & J.M. EDMISTON 747-487
3.000 Ac.
C.T. & M.P. PATTERSON 775-1052
716-871
3.236 Ac.
J. GEORGE 721-488
4.020 Ac.
N. SKIDMORE, III & D SKIDMORE
1
4
5
722-351
D.W. & M.A. GEORGE
4.341 Ac.
MATCH LINE
4.121 Ac.
W. GEORGE 3.621 Ac. 722-1044
738-1322
3.046 Ac.
M. & D. DULKA
3.904 Ac.
3.002 Ac.
2
3
8
9
EAST SURREY
L & S Smith 633-359
3 AC.
L R. & S. SMITH 643-948
3 AC.
Kim-Sean Inc 819-1204
3 AC.
E. & Peterson 807-486
5.4 AC
722-297
J. & R. MUSACCHIO
3 AC.
D & S. BIRKO 661-403
3 AC
KILE
1
Peterson Painting + Home Improvement Inc 790-148
72.36 Ac.
~~CA 758 79-E~~
E & D Perse
727-723
C & Q Dougherty 609-913
~~CA 76193~~
2A
D.R. & M.L. SMITH 732-1024
2.4 Ac
S.P. JR + L.M. Zupon 820-355
~~72110-E~~
2 Ac.
R.P. + M.J. Newport 811-1121
2 Ac
H. & A. Steward 509-1097
SEC. 4
77.63 Ac.
562-122
C & M. Ineman
2
HUNTSBURG TOWNSHIP
ROAD
N
TAYLOR WELLS ROAD
1A
P. & S. Mioricke 597-883
1A
J. & A. Holland 591-136
1.3A
559-633
A. Valvoda
1
A.M. REZABEK 1A 693-620
11
M.A. MIHALJEVIC 687-92
1.03A.
2
680-1281
676-98
1 Ac.
K. FORTUNA & L. LeBLANC
12
766-798
1A
K. & D. MARCKESE
3
A. Merryman 802-728
13
J.R. Morris 690-215
4
W. & S. Rought 615-837 492-181 580-817
14
T.P. & R.M. Beck, SR
558-512
1 Ac.
5
E & D Byler 542-232
ALDENSHIRE DRIVE
15
A. & E. Mighton 707-172
6
1 Ac.
B. PALINSKY 690-792
752-1240
16
S. Mighton E. Mighton 707-170 796-752
7
765-1184
J.S. & D. TIZZANO
17
A.R. & S.J. MIGHTON 707-174
8
515-662
N. & N. TINKER
18
C. & D. Anspach 486-1009 731-1039
9
N. & N. Tinker 559-479
19
J. & N SANKER 629-1025 653-465
10
L. & D.S. Bernardina 823-561
2.44 Ac.
20
2.5A
K.D. & A.M. CREAGH 750-268
~~69222~~
484-164
Geauga County Commissioners
Lots 1 to 20 in Name of F. & I. Marincek 459-220
Plymouth Acres Subd. Lot 18 Holmes Tract Vol. 8 Pg 33 Plats - Vol. 9, Pg. 18 & 55
Scale 1" = 200'

N

SCALE 1" = 300'

* Inadequate description

JANUARY 1, 1989
RELATIVE REPRESENTATION

A	B	C	D
E	F	G	H
I	J	K	L
M	N	O	P

CLARIDON TOWNSHIP

CLARIDON TOWNSHIP

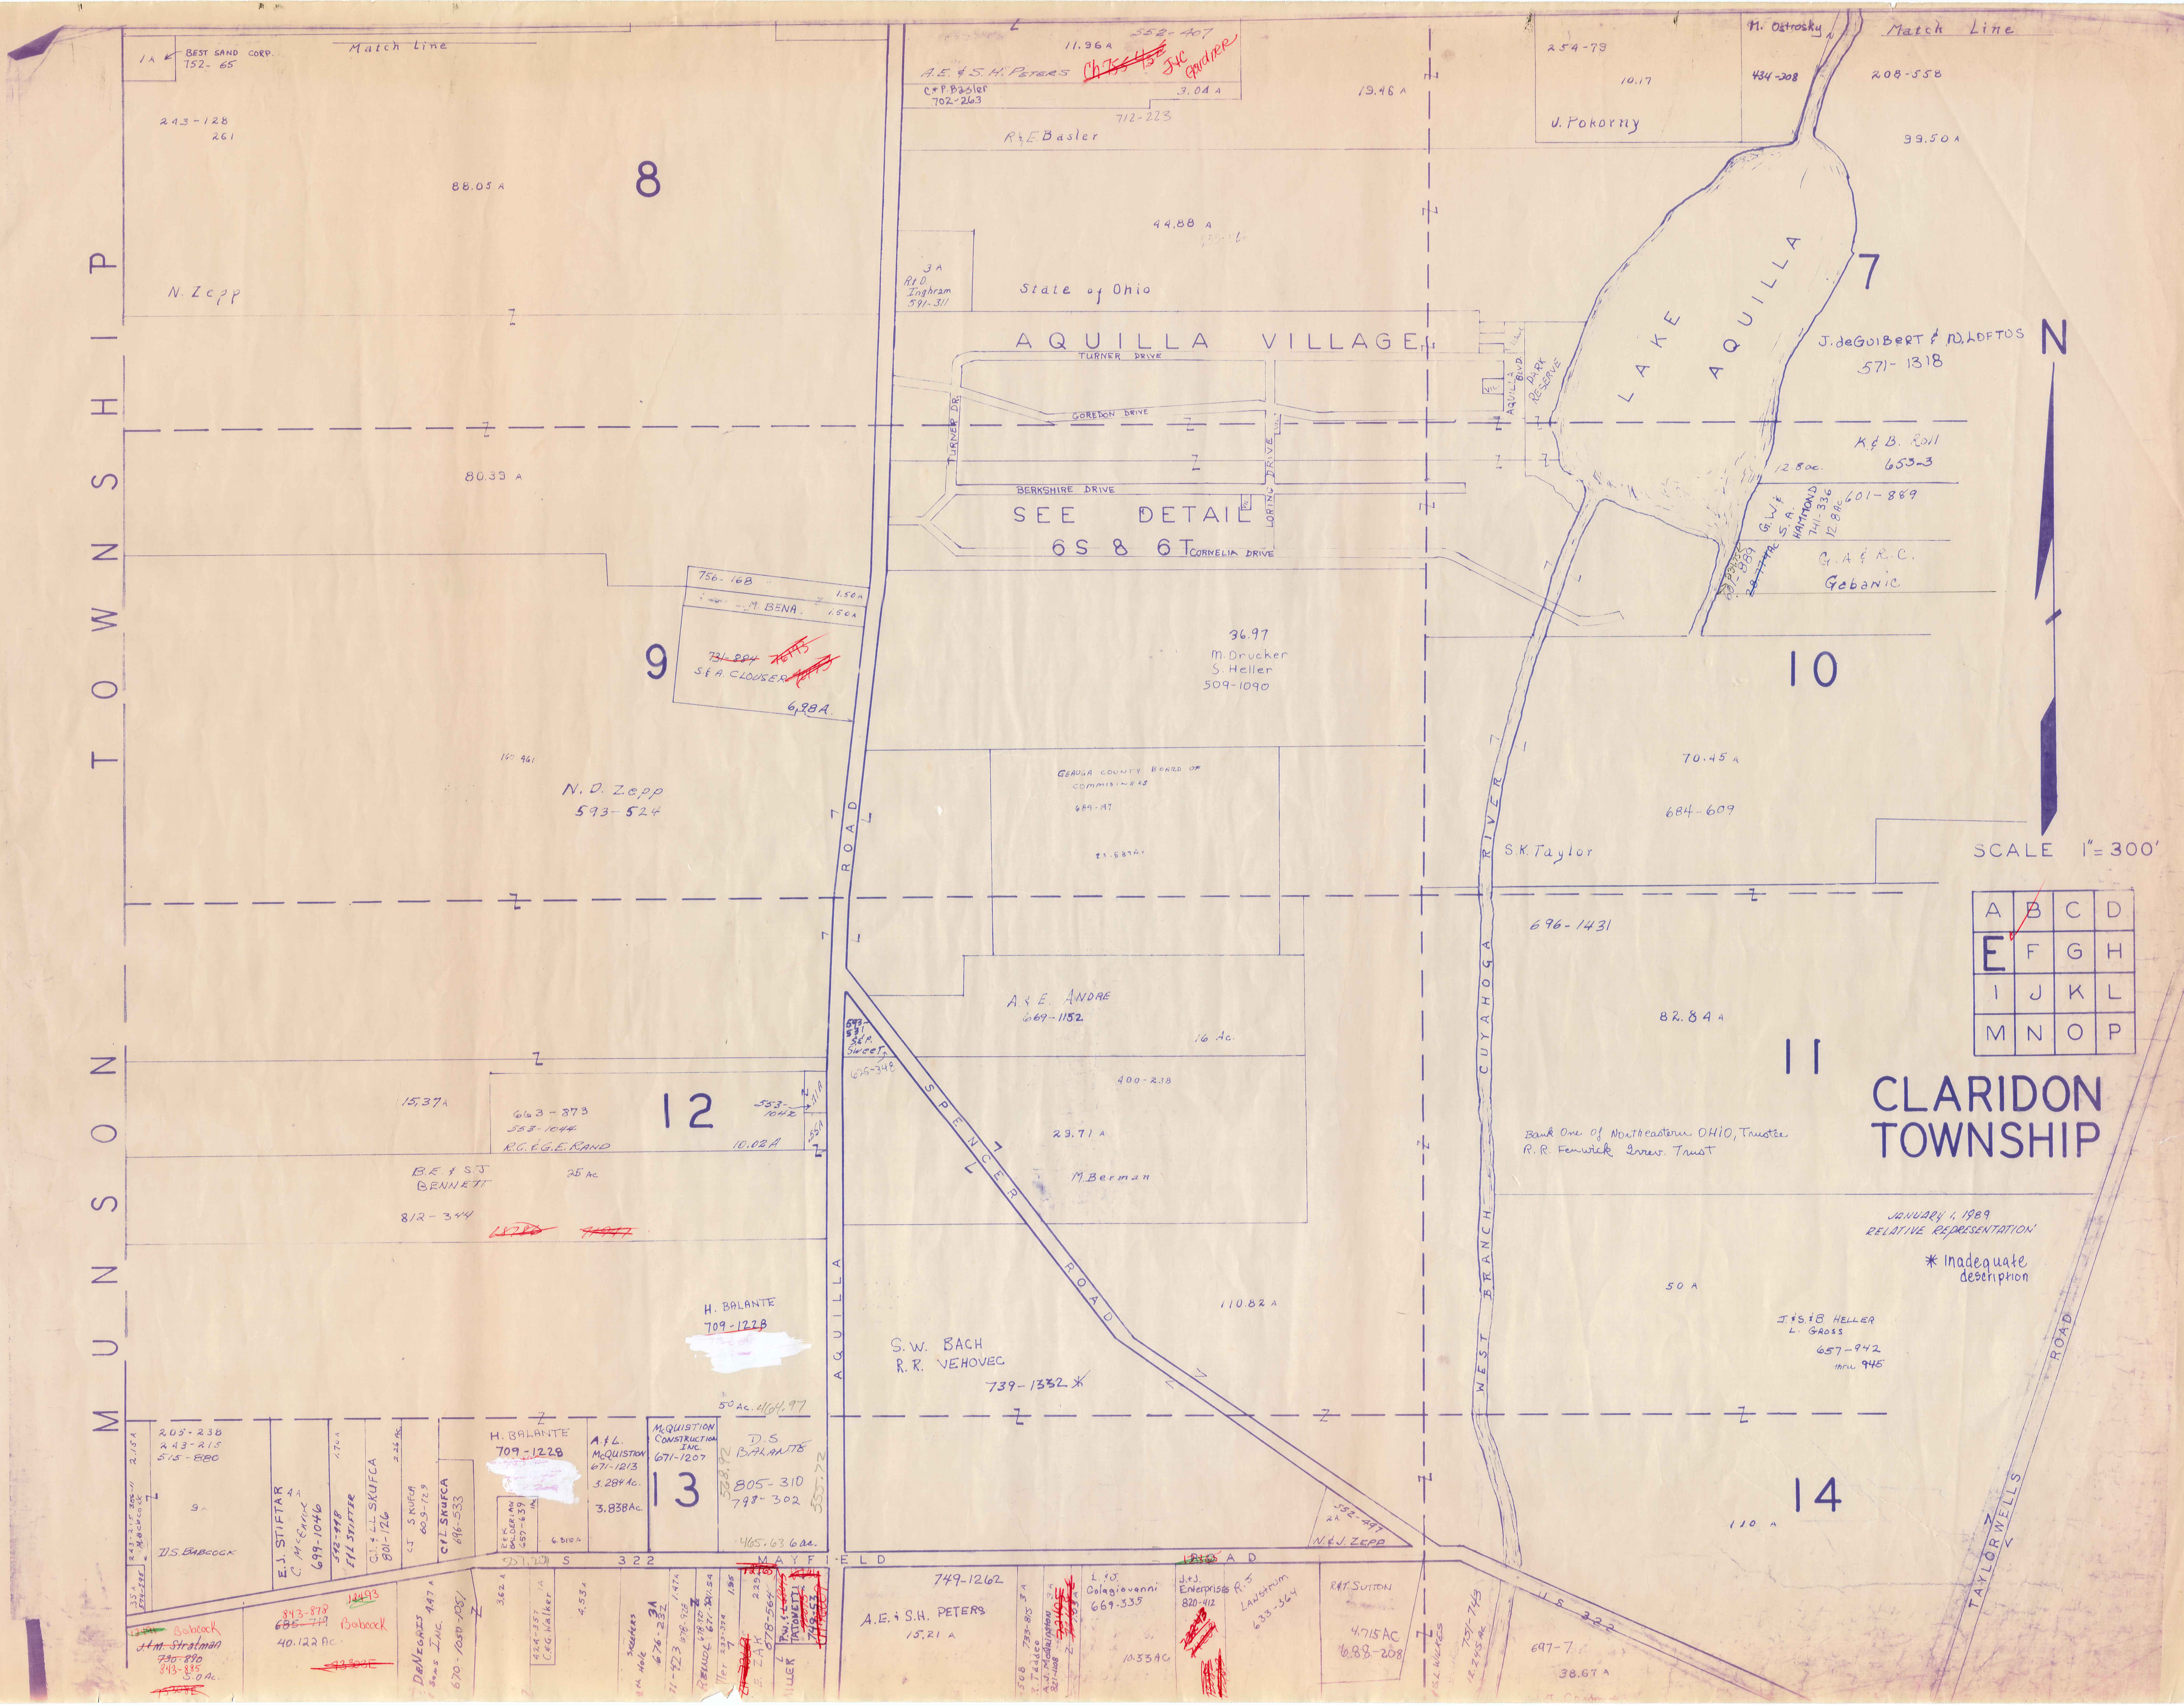

JANUARY 1, 1989
RELATIVE REPRESENTATION

* Inadequate description

SCALE 1" = 300'

MUNSON TOWNSHIP
Match Line
1A BEST SAND CORP. 752-65
243-128
261
8
88.05 A
N. Zepp
80.39 A
9
756-168 1.50 A
M. BENA 1.50 A
~~731-884~~ 76445
S & A CLOUSER
6.98 A
160.461
N. D. Zepp
593-524
12
15.37 A
663-873
553-1044
R.C. & G.E. RAND
10.02 A
553-1042
B.E. & S.J. BENNETT
25 Ac.
812-344
H. BALANTE
709-1228
50 Ac. 464.97
205-238
243-215
515-880
2.15 A
243-215 356-11 Babcock
9 A
D.S. BABCOCK
.35 A 574-596
E.J. STIFTAR
C. McCann
699-1046
4 A
592-998
F & L STIFTER
1.74 A
G.J. & L.L SKUFCA
801-126
2.26 Ac.
C.J. SKUFCA
609-729
C & L SKUFCA
696-533
H. BALANTE
709-1228
R & K BALDERIAN 657-639
1A
6.310 A
A. & L. McQUISTION
671-1213
3.284 Ac.
3.838 Ac.
McQUISTION CONSTRUCTION INC.
671-1207
13
D.S. BALANTE
805-310
798-302
328.92
555.72
465.636 ac.
S 322
MAYFIELD ROAD
Babcock
~~J & M. Stratman~~
~~730-890~~
843-885
5.0 Ac.
843-878
~~685-719~~
Babcock
12493
40.122 Ac.
DeNIGRIS & SONS INC.
4.47 A
670-1050-1051
3.62 A
424-357
C & G Walker
1A
4.53 A
Skeeters
3A
676-232
1.47A
678-928
1.54
671-1221
1.95
233-374
2.29
E. ZAK
678-564
P.W. & L. TATONETTI
749-53
ILLER
A.E. & S.H. PETERS
11.96 A
552-407
~~Ch 755-432~~
J & C Gardner
C & P Basler
702-263
3.04 A
712-223
R & E Basler
19.46 A
44.88 A
3 A
R & D. Ingraham
591-311
State of Ohio
AQUILLA VILLAGE
TURNER DRIVE
GORDON DRIVE
TURNER DR.
LORING DRIVE
BERKSHIRE DRIVE
SEE DETAIL 6S & 6T
CORNELIA DRIVE
VIL.
AQUILLA BLVD.
PARK RESERVE
36.97
M. Drucker
S. Heller
509-1090
GEAUGA COUNTY BOARD OF COMMISSIONERS
684-97
AQUILLA ROAD
A & E. ANDRE
669-1182
16 Ac.
400-218
543-531 S & R Sweet
695-348
23.71 A
M. Berman
SPENCER ROAD
S.W. BACH
R.R. VEHOVEC
739-1332 *
110.82 A
552-497
2A
N. & J. ZEPP
749-1262
A.E. & S.H. PETERS
15.21 A
508 733-815 3A
R. Taddeo
A.J. McQuistion
821-1108
L. & J. Colagiovanni
669-335
10.33 AC
J. & J. Enterprises
820-412
R. S. LANSTRUM
633-364
R & T. SUTTON
4.715 AC
688-208
S.L. WILKES
751-743
12.245 Ac.
697-7
38.67 A
US 322
254-79
10.17
J. Pokorny
M. Ostrosky
434-308
208-558
99.50 A
7
LAKE AQUILLA
J. deGUIBERT & W. LOFTUS
571-1318
N
K & B. Roll
653-3
12.8 ac.
G.W. & S.A. HAMMOND
741-336
12.8 Ac.
601-889
G.A. & R.C. Gebanic
10
70.45 A
684-609
S.K. Taylor
696-1431
WEST BRANCH CUYAHOGA RIVER
82.84 A
11
Bank One of Northeastern OHIO, Trustee
R.R. Fenwick Irrev. Trust
50 A
J & S & B HELLER
L. GROSS
657-942
thru 945
14
110 A
TAYLOR WELLS ROAD
A B C D
E F G H
I J K L
M N O P

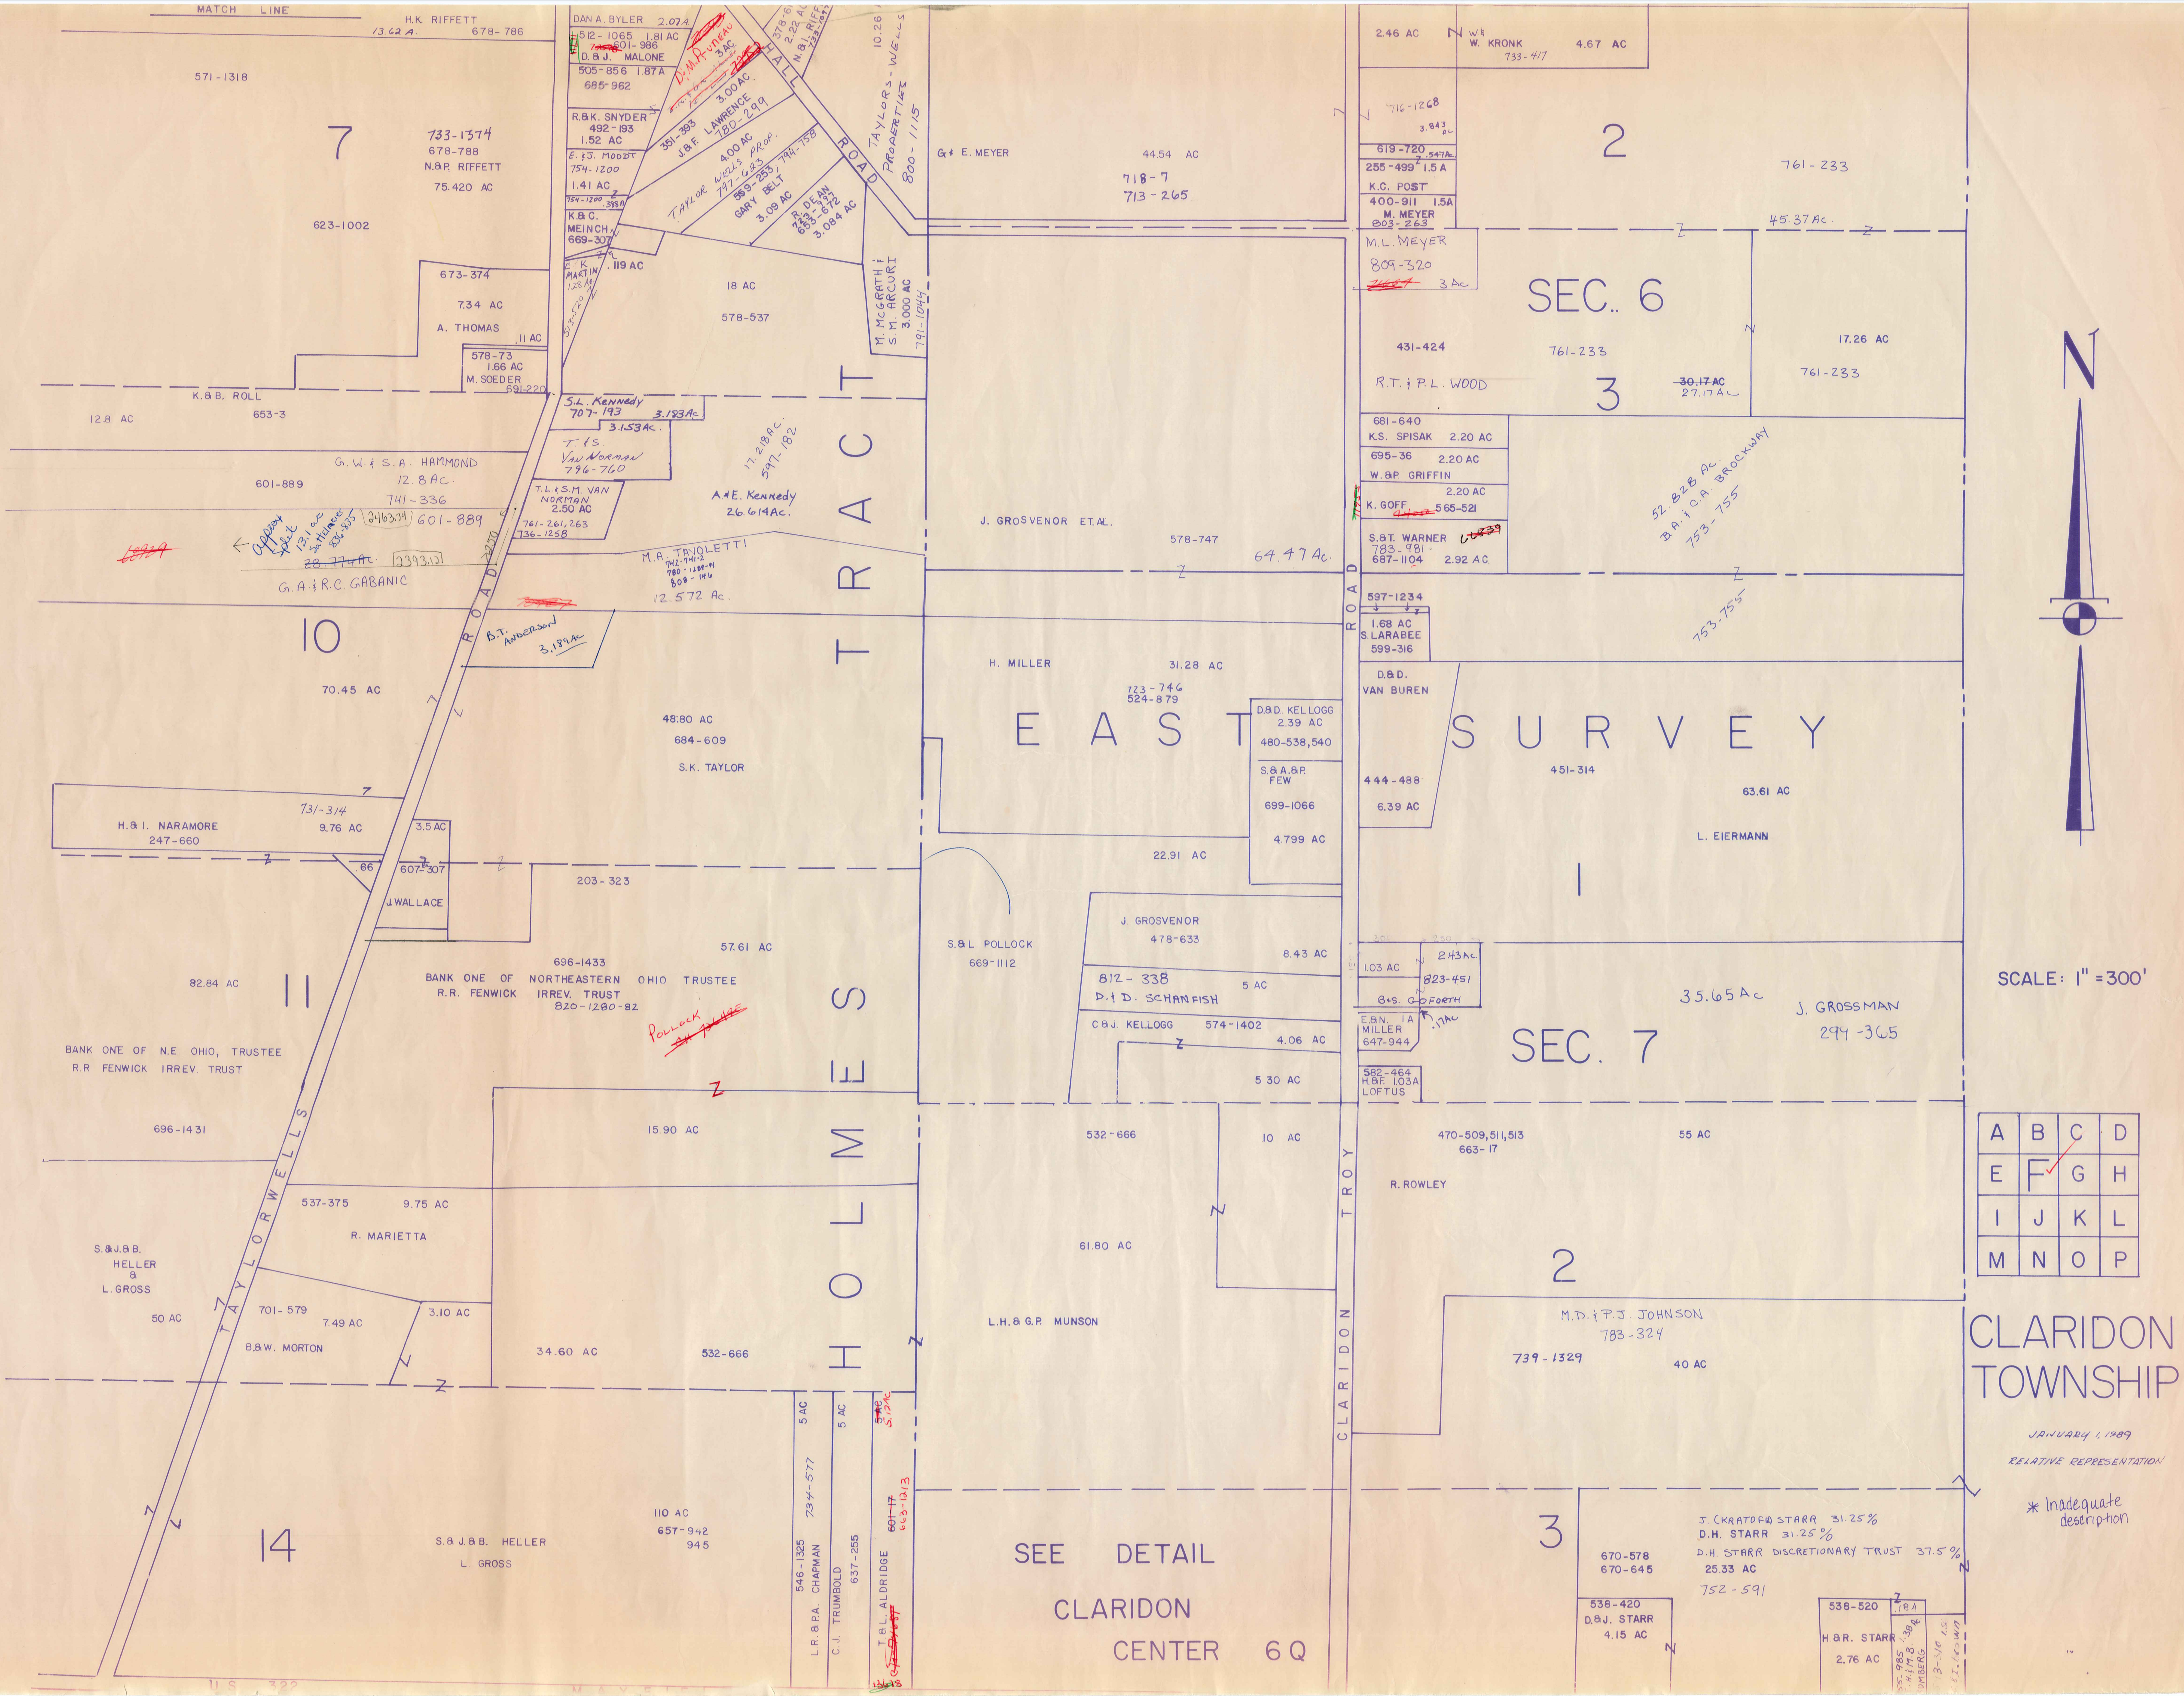
MATCH LINE
H.K. RIFFETT
13.62 A.
678-786
571-1318
7
733-1374
678-788
N.&P. RIFFETT
75.420 AC
623-1002
673-374
7.34 AC
A. THOMAS
.11 AC
578-73
1.66 AC
M. SOEDER
691-220
K.&B. ROLL
12.8 AC
653-3
G.W. & S.A. HAMMOND
12.8 AC.
601-889
741-336
601-889
G.A. & R.C. GABANIC
10
70.45 AC
H.& I. NARAMORE
247-660
731-314
9.76 AC
3.5 AC
.66
607-307
J. WALLACE
203-323
82.84 AC
11
BANK ONE OF N.E. OHIO, TRUSTEE
R.R. FENWICK IRREV. TRUST
696-1431
537-375
9.75 AC
R. MARIETTA
S.&J.B.B. HELLER & L. GROSS
50 AC
701-579
7.49 AC
B.&W. MORTON
3.10 AC
34.60 AC
532-666
14
S.& J.B.B. HELLER
L. GROSS
110 AC
657-942
945
TAYLORWELLS ROAD
DAN A. BYLER 2.07 A
512-1065 1.81 AC
D.& J. MALONE
505-856 1.87 A
685-962
R.& K. SNYDER
492-193
1.52 AC
E. & J. MOODY
754-1200
1.41 AC
K.& C. MEINCH
669-307
E.K. MARTIN
.119 AC
J.& F. LAWRENCE
780-299
3.00 AC
4.00 AC
TAYLOR WELLS PROP.
747-683
GARY BELT
3.09 AC
R. DEAN
3.084 AC
HALL ROAD
TAYLORS-WELLS PROPERTIES
800-1115
M. McGRATH & S.M. ARCURI
3.000 AC
791-1044
18 AC
578-537
S.L. Kennedy
707-193
3.153 Ac.
T. & S. Van Norman
796-760
T.L. & S.M. VAN NORMAN
2.50 AC
761-261, 263
736-1258
A & E. Kennedy
26.614 Ac.
17.218 Ac.
597-782
M.A. TAVOLETTI
12.572 Ac.
B.T. Anderson
3.184 Ac.
48.80 AC
684-609
S.K. TAYLOR
57.61 AC
696-1433
BANK ONE OF NORTHEASTERN OHIO TRUSTEE
R.R. FENWICK IRREV. TRUST
820-1280-82
POLLOCK
15.90 AC
HOLMES TRACT
5 AC
5 AC
546-1325
L.R. & P.A. CHAPMAN
734-577
C.J. TRUMBOLD
637-255
T.& L. ALDRIDGE
601-17
G. & E. MEYER
44.54 AC
718-7
713-265
J. GROSVENOR ET. AL.
578-747
64.47 Ac.
H. MILLER
31.28 AC
723-746
524-879
EAST SURVEY
D.& D. KELLOGG
2.39 AC
480-538, 540
S.& A.B.P. FEW
699-1066
4.799 AC
22.91 AC
S.& L. POLLOCK
669-1112
J. GROSVENOR
478-633
8.43 AC
812-338
D. & D. SCHANFISH
5 AC
C.& J. KELLOGG
574-1402
4.06 AC
5.30 AC
532-666
10 AC
61.80 AC
L.H.& G.P. MUNSON
SEE DETAIL
CLARIDON CENTER 6Q
CLARIDON TROY ROAD
2.46 AC
W. KRONK
733-417
4.67 AC
716-1268
3.843 AC
619-720
255-499 1.5 A
K.C. POST
400-911 1.5 A
M. MEYER
803-263
M.L. MEYER
809-320
3 Ac.
2
761-233
45.37 Ac.
SEC. 6
431-424
761-233
R.T. & P.L. WOOD
3
~~30.17 AC~~
27.17 AC
17.26 AC
761-233
681-640
K.S. SPISAK 2.20 AC
695-36 2.20 AC
W.& P. GRIFFIN
2.20 AC
K. GOFF 565-521
S.& T. WARNER
783-981
687-1104 2.92 AC.
52.828 Ac.
B.A. & C.A. BROCKWAY
753-755
597-1234
1.68 AC
S. LARABEE
599-316
753-755
D.& D. VAN BUREN
444-488
6.39 AC
451-314
63.61 AC
L. EIERMANN
1
1.03 AC
2.43 Ac.
823-451
B.& S. GOFORTH
E.& N. MILLER 1A
647-944
.17 Ac
582-464
H.& F. LOFTUS 1.03 A
35.65 Ac
J. GROSSMAN
294-365
SEC. 7
470-509, 511, 513
663-17
55 AC
R. ROWLEY
2
M.D. & P.J. JOHNSON
783-324
739-1329
40 AC
3
670-578
670-645
J. CRAWFORD STARR 31.25%
D.H. STARR 31.25%
D.H. STARR DISCRETIONARY TRUST 37.5%
25.33 AC
752-591
538-420
D.& J. STARR
4.15 AC
538-520
H.& R. STARR
2.76 AC
N
A B C D
E F G H
I J K L
M N O P
U.S. 322

SCALE: 1" = 300'

CLARIDON TOWNSHIP

JANUARY 1, 1989

RELATIVE REPRESENTATION

* Inadequate description

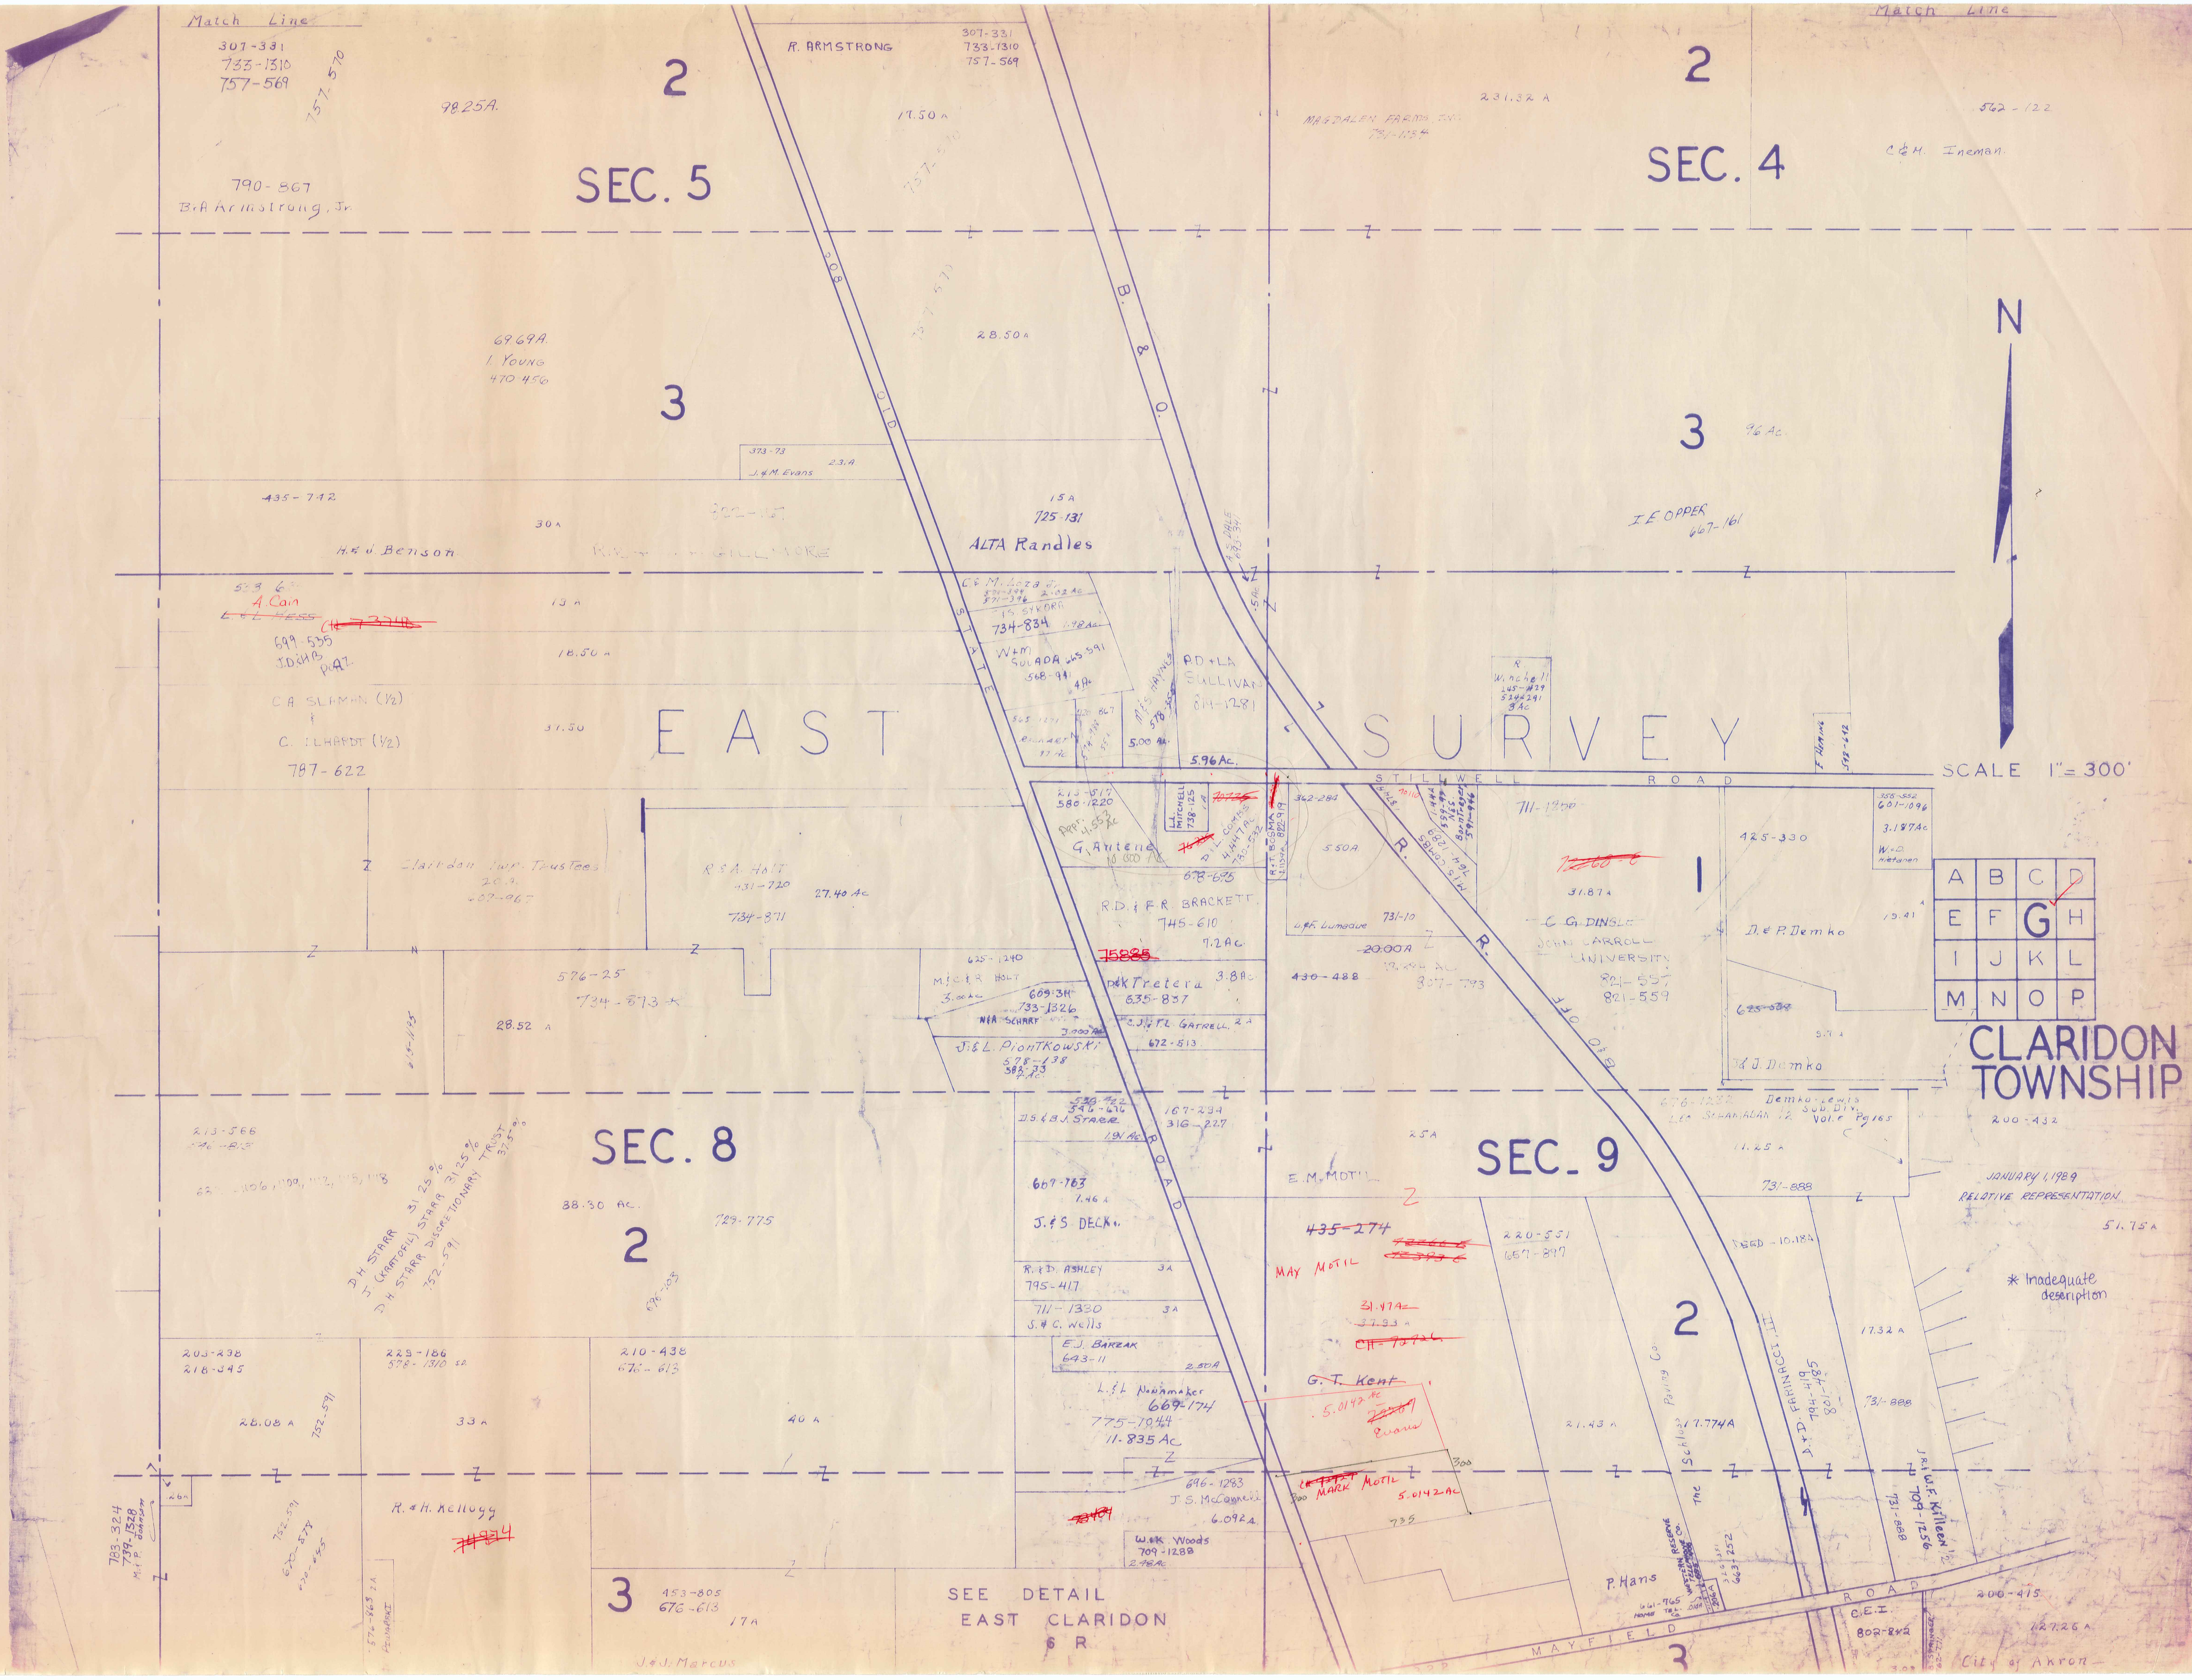
Match Line
307-331
733-1310
757-569
757-570
98.25A.
2
SEC. 5
790-867
B.A Armstrong, Jr.
R. ARMSTRONG
307-331
733-1310
757-569
17.50 A
757-570
Match Line
231.32 A
MAGDALEN FARMS INC.
2
SEC. 4
562-122
C&M. Ineman
OLD 608
B. & O.
757-570
28.50 A
69.69A.
I. Young
470-456
3
373-73
2.3A.
J.&M. Evans
435-742
30 A
822-167
H.& J. Benson
R.R. GILLMORE
15 A
725-131
ALTA Randles
A.S. DALE
693-341
.5Ac
3
96 Ac
I.E. OPPER
667-161
N
533-6
A. Cain
~~L.& L HESS~~
~~CH 73748~~
699-535
J.D.&H.B.
18 A
18.50 A
C.A. SLAMAN (1/2)
C. EHARDT (1/2)
787-622
31.50
EAST
SURVEY
STATE ROAD
C.& M. Loza Jr.
571-394 2.02 Ac
571-396
J.&S. SYKORA
734-834 1.98 Ac.
W+M SULADA 665-591
568-941
4 Ac
565-1271
Eckart
.97 Ac
820-867
574-988
.55 A
M.&S. HAYNES
578-355
5.00 Ac.
P.D.+L.A. SULLIVAN
814-1281
5.96 Ac.
R. Winchell
245-429
524-291
3 Ac
F. Heming
578-642
SCALE 1" = 300'
STILLWELL ROAD
213-517
580-1220
Appr. 4.553 Ac
G. Antene
10.000 Ac
L.L. MITCHELL
738-125
1 A
~~70725~~
D.&L. COMBS
4.447 Ac.
730-532
R.&T. BOSMA
1.159 A
822-919
678-695
362-284
5.50A.
M.&S. COMBS
1.444
764-1289
559-99
N.&S. Borntreger
591-946
70110
711-1250
~~12260-C~~
1
31.87 A
425-330
558-552
601-1096
3.187 Ac
W.D. Hietanen
L.&F. Lumadue
731-10
~~20.00A~~
13.894 Ac
~~430-488~~
307-793
C.G. DINGLE
JOHN CARROLL UNIVERSITY
821-557
821-559
D.& P. Demko
15.41
B. & O. R.R.
~~625-538~~
5.7 A
J.& J. Demko
A B C D
E F G H
I J K L
M N O P
CLARIDON TOWNSHIP
1
Claridon Twp. Trustees
2 A
607-967
R.& A. Holt
431-720
734-871
27.40 Ac
R.D. & F.R. BRACKETT
745-610
7.2 Ac.
~~75885~~
625-1240
M.&C.&R. HOLT
3.00 Ac
609-314
733-1326
N&A SCHARF
3.000 Ac
P&K Tretera
635-837
3.8 Ac
C.J.&T.L. GATRELL 2 A
672-513
J.&L. PIONTKOWSKI
578-138
583-33
4 Ac.
576-25
734-873
28.52 A
215-1125
213-566
546-815
SEC. 8
38.30 Ac.
2
729-775
D.H. STARR 31.25%
J. (KRATOFIL) STARR 31.25%
D.H. STARR DISCRETIONARY TRUST 37.5%
752-591
696-103
538-422
546-676
D.S.& B.J. STARR
1.91 Ac.
167-234
316-227
25 A
SEC. 9
676-1232
Demko-Lewis Sub. Div.
Leo Schamadan 1/2
Vol. E Pg 165
11.25 A
200-432
E.M. MOTIL
731-888
JANUARY 1, 1989
RELATIVE REPRESENTATION
51.75 A
667-763
7.46 A
J.&S. DECK
~~435-274~~
~~72266-C~~
~~72393-C~~
MAY MOTIL
220-551
657-897
DEED - 10.18A
R.&D. ASHLEY 3 A
795-417
711-1330
S.& C. Wells
3 A
~~31.47A~~
~~37.93 A~~
~~CH 72726~~
2
17.32 A
* Inadequate description
E.J. BARZAK
643-11
2.50A
G.T. Kent
5.0142 Ac
~~72567~~
Evans
L.&L. Nonamaker
669-174
775-1044
11-835 Ac
21.43 A
The Schloss Paving Co.
17.774A
A.+D. FARINACCI II
794-419
801-485
731-888
J.R.& W.F. Killeen 1/2
709-1256
731-888
203-238
218-345
28.08 A
752-591
225-186
578-1310
33 A
210-438
676-613
40 A
696-1283
J.S. McConnell
6.092 A
~~72404~~
300
~~CH 72727~~
MARK MOTIL
5.0142 Ac
300
735
W.&K. Woods
709-1288
2.48 Ac
783-324
799-1528
M.&P. Hanson
2 A
752-591
670-578
720-245
R.& H. Kellogg
~~74434~~
3
453-805
676-613
17 A
576-863
J.&J. Marcus
SEE DETAIL
EAST CLARIDON
6 R
P. Hans
661-765
HOME TEL. CO.
WESTERN RESERVE TELEPHONE CO.
.206A
326-351
663-252
MAYFIELD ROAD
C.E.I.
802-842
3
200-415
127.26 A
City of Akron

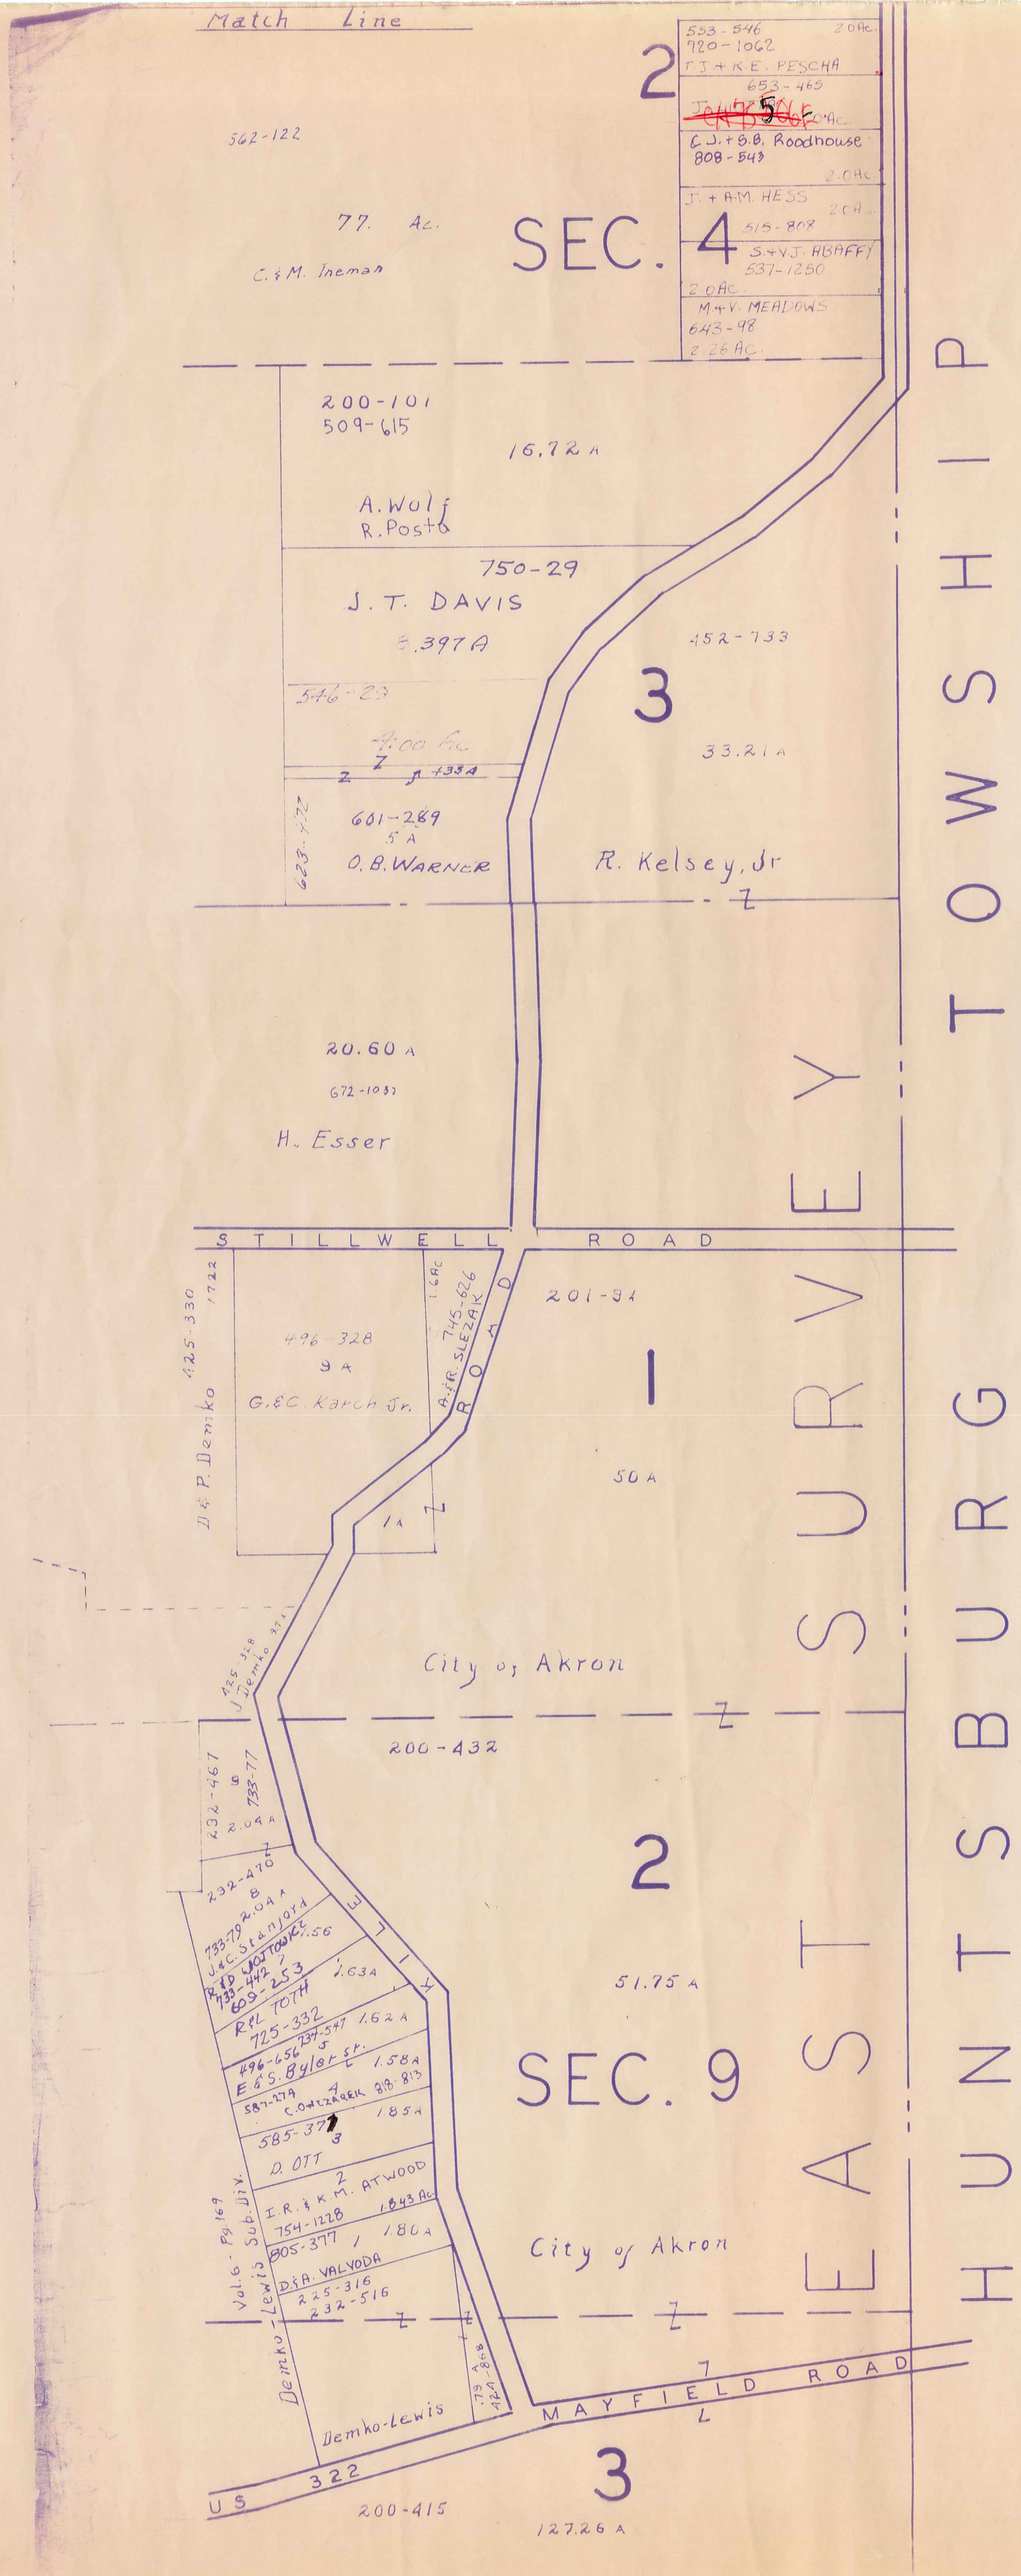
Match Line
2
553-546 2.0Ac.
720-1062
T.J.+K.E. PESCHA
653-465
~~J~~ 5 2.0 Ac.
C.J. + S.B. Roodhouse
808-543
2.0Ac.
J. + A.M. HESS
2.CA.
515-808
S.+V.J. ABAFFY
537-1250
2.0Ac.
M.+V. MEADOWS
643-98
2.26 AC.
562-122
77. Ac.
C.&M. Ineman
SEC. 4
200-101
509-615
16.72 A
A. Wolf
R. Posta
750-29
J.T. DAVIS
3.397 A
546-29
4.00 Ac
Z
Z
.433A
601-289
5 A
O.B. WARNER
623-472
3
452-733
33.21 A
R. Kelsey, Jr
Z
20.60 A
672-1033
H. Esser
STILLWELL ROAD
425-330 1722
D.& P. Demko
496-328
9 A
G.&C. Karch Jr.
1.6Ac
745-626
A.&R. SLEZAK
ROAD
1 A
Z
201-91
1
50 A
425-328
J. Demko 9.7 A
City of Akron
Z
200-432
232-467
9
733-77
2.04 A
Z
232-470
8
2.04 A
733-79
J.&C. Stanford
R.&D. WOJTOWICZ 1.56
733-442 7
609-253
1.63 A
R.&L. TOTH
725-332
496-656 734-547 1.62 A
5
E.&S. Byler Sr.
1.58 A
587-274 4
C. OWCZAREK 818-813
1.85 A
585-377
3
D. OTT
2
I.R.&K.M. ATWOOD
754-1228 1.843 Ac.
805-377 1 1.80 A
D.&A. VALVODA
225-316
232-516
Vol. 6 - Pg. 169
Demko-Lewis Sub. Div.
Demko-Lewis
Z
Z
Z
.79 A
424-868
KILE
2
51.75 A
SEC. 9
City of Akron
EAST SURVEY
HUNTSBURG TOWNSHIP
MAYFIELD ROAD
US 322
200-415
3
127.26 A

SCALE 1"=300'

JANUARY 1, 1989
RELATIVE REPRESENTATION

* Inadequate description

A	B	C	D
E	F	G	**H** ✓
I	J	K	L
M	N	O	P

CLARIDON TOWNSHIP

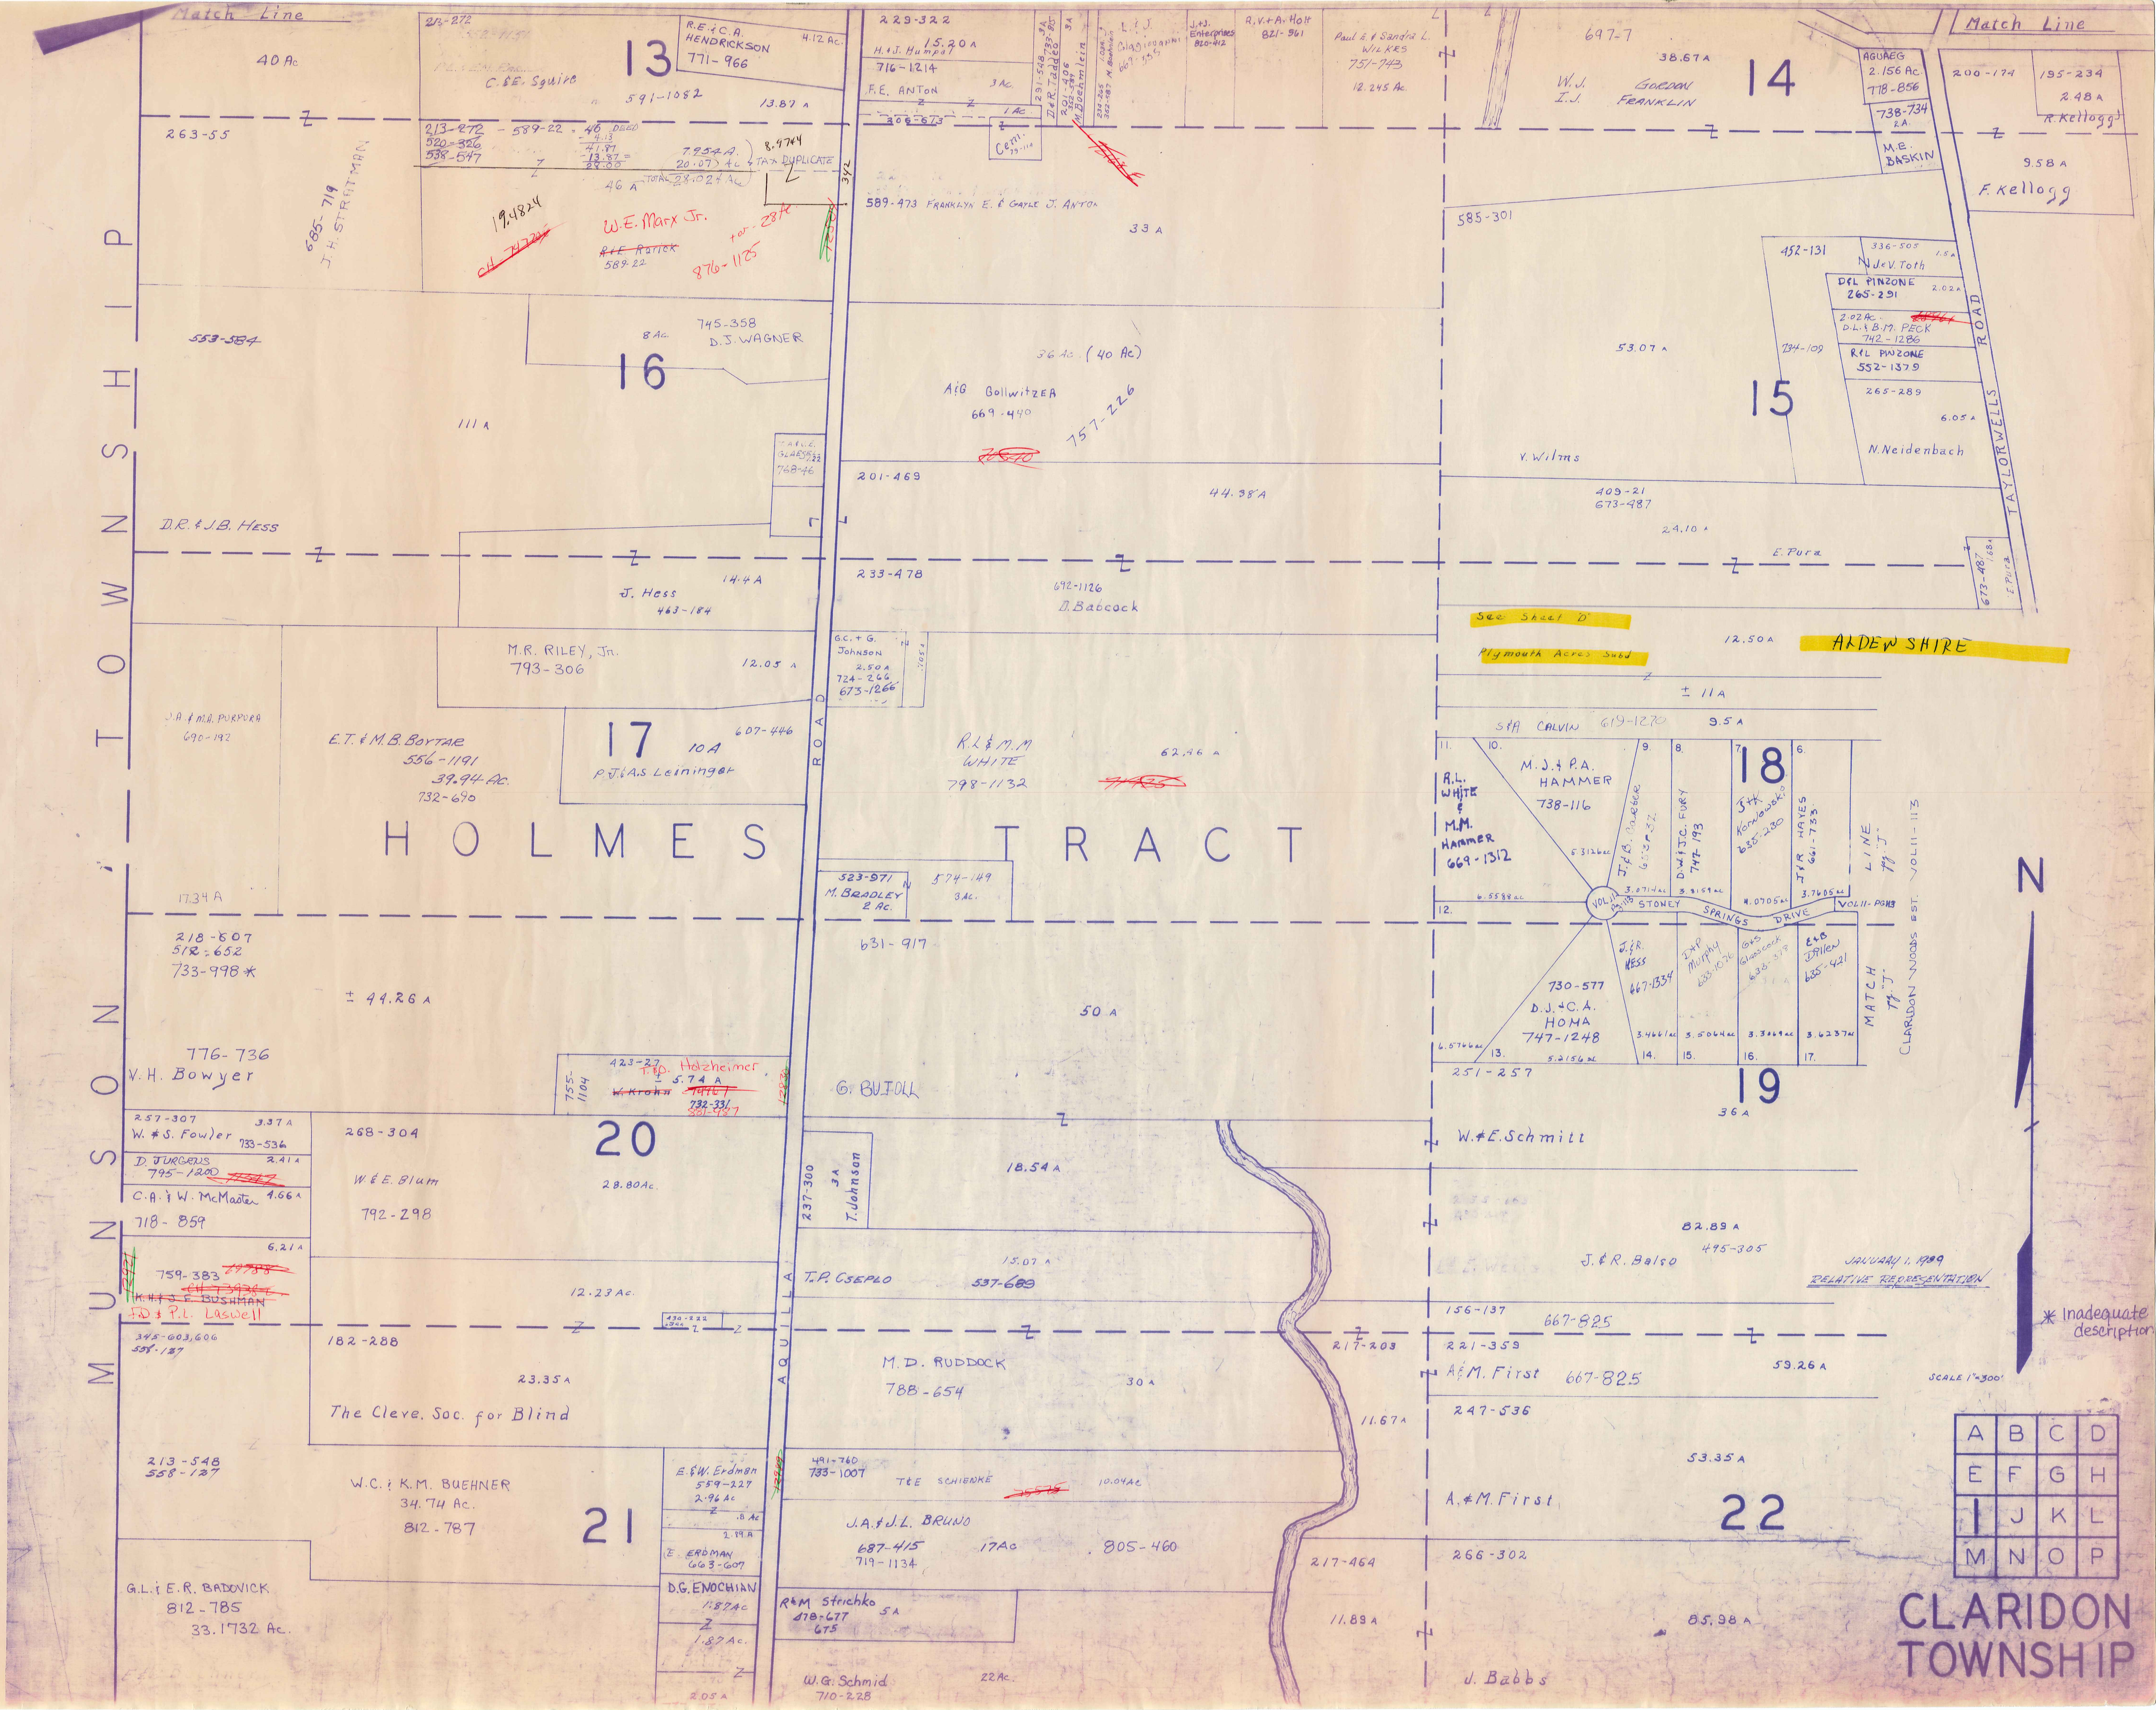
Match Line
40 Ac
263-55
685-719 J.H. STRATMAN
553-584
D.R. & J.B. Hess
MUNSON TOWNSHIP
213-272
13
R.E. & C.A. HENDRICKSON 771-966
4.12 Ac
C. & E. Squire
591-1082
13.87 A
213-272 520-326 538-547
589-22
7.954 A.
20.07 Ac
TAX DUPLICATE
46 A
19.4824
W.E. Marx Jr.
R & E Rotick 589-22
876-1125
16
8 Ac
745-358 D.J. WAGNER
111 A
14.4 A
J. Hess 463-184
M.R. RILEY, Jr. 793-306
12.05 A
17
10 A
607-446
P.J. & A.S. Leininger
J.A. & M.B. PURPURA 690-192
E.T. & M.B. BOYTAR 556-1191 39.94 Ac. 732-690
HOLMES TRACT
17.34 A
218-607 512-652 733-998 *
± 44.26 A
776-736 V.H. Bowyer
423-27 T.P. Holzheimer 5.74 A
732-331
755-1104
257-307 W. & S. Fowler 733-536 3.37 A
D. JURGENS 795-1200 2.41 A
C.A. & W. McMaster 718-859 4.66 A
6.21 A
759-383
F.D. & P.L. Laswell
~~K.H. & S.E. BUSHMAN~~
20
268-304
W & E Blum 792-298
28.80 Ac.
12.23 Ac.
345-603,606 538-127
182-288
23.35 A
The Cleve. Soc. for Blind
213-548 558-127
W.C. & K.M. BUEHNER 34.74 Ac. 812-787
21
E. & W. Erdman 559-227 2.96 Ac
E. ERDMAN 663-607
D.G. ENOCHIAN 1.87 Ac
1.87 Ac.
2.05 A
G.L. & E.R. BADOVICK 812-785 33.1732 Ac.
AQUILLA ROAD
342
223-322
H. & J. Bumpas 716-1214
15.20 A
F.E. ANTON
3 Ac
1 Ac
206-673
Cem.
L. & J.
J. & J. Enterprises
R.V. & A. Holt 821-961
Paul E. & Sandra L. WILKES 751-743 12.245 Ac
589-473 FRANKLYN E. & GAYLE J. ANTON
33 A
36 Ac (40 Ac)
A & G Gollwitzer 669-440
757-226
201-469
44.38 A
233-478
692-1126 D. Babcock
G.C. & G. Johnson 2.50 A 724-266 673-1266
R.L. & M.M. WHITE 798-1132
62.46 A
523-971 M. BRADLEY 2 Ac.
574-149 3 Ac.
631-917
50 A
G. BUJOLL
237-300
3 A T. Johnson
18.54 A
15.07 A
T.P. CSEPLO
537-689
M.D. RUDDOCK 788-654
30 A
11.67 A
491-760 733-1007
T & E SCHIENKE
10.04 Ac
J.A. & J.L. BRUNO 687-415 719-1134
17 Ac
805-460
R & M Strichko 478-677 675
5 A
W.G. Schmid 710-228
22 Ac
697-7
38.67 A
W.J. & I.J. GORDON FRANKLIN
14
AGUAEG 2.156 Ac 718-856
738-734 2 A.
M.E. BASKIN
200-174
195-234 2.48 A R. Kellogg
9.58 A
F. Kellogg
585-301
452-131
336-505 J. & V. Toth
D & L PINZONE 265-291
2.02 Ac D.L. & B.M. PECK 742-1286
R & L PINZONE 552-1379
265-289
6.05 A
N. Neidenbach
53.07 A
734-109
15
V. Wilms
403-21 673-487
24.10 A
E. Pura
673-487
TAYLORWELLS ROAD
See Sheet 'D'
Plymouth Acres Subd
12.50 A
ARDEN SHIRE
± 11 A
S & A CALVIN 619-1270
9.5 A
18
R.L. WHITE & M.M. HAMMER 669-1312
M.J. & P.A. HAMMER 738-116
J & B. Dorner
D.W. & J.C. FURY 747-193
J & K Kornowski 635-230
J & R. HAYES 661-733
STONEY SPRINGS DRIVE
J & R. HESS 667-1334
J & P Murphy
G & S Glasscock
E & B Dillon 635-421
730-577 D.J. & C.A. HOMA 747-1248
MATCH LINE
CLARIDON WOODS EST. VOL 11-113
19
36 A
251-257
W. & E. Schmitt
82.89 A
J. & R. Balso 495-305
156-137
667-825
221-359
A. & M. First 667-825
59.26 A
247-536
53.35 A
A. & M. First
22
217-203
217-464
266-302
11.89 A
85.98 A
J. Babbs
N
JANUARY 1, 1989
RELATIVE REPRESENTATION
* Inadequate description
SCALE 1"=300'
A B C D
E F G H
I J K L
M N O P
CLARIDON TOWNSHIP

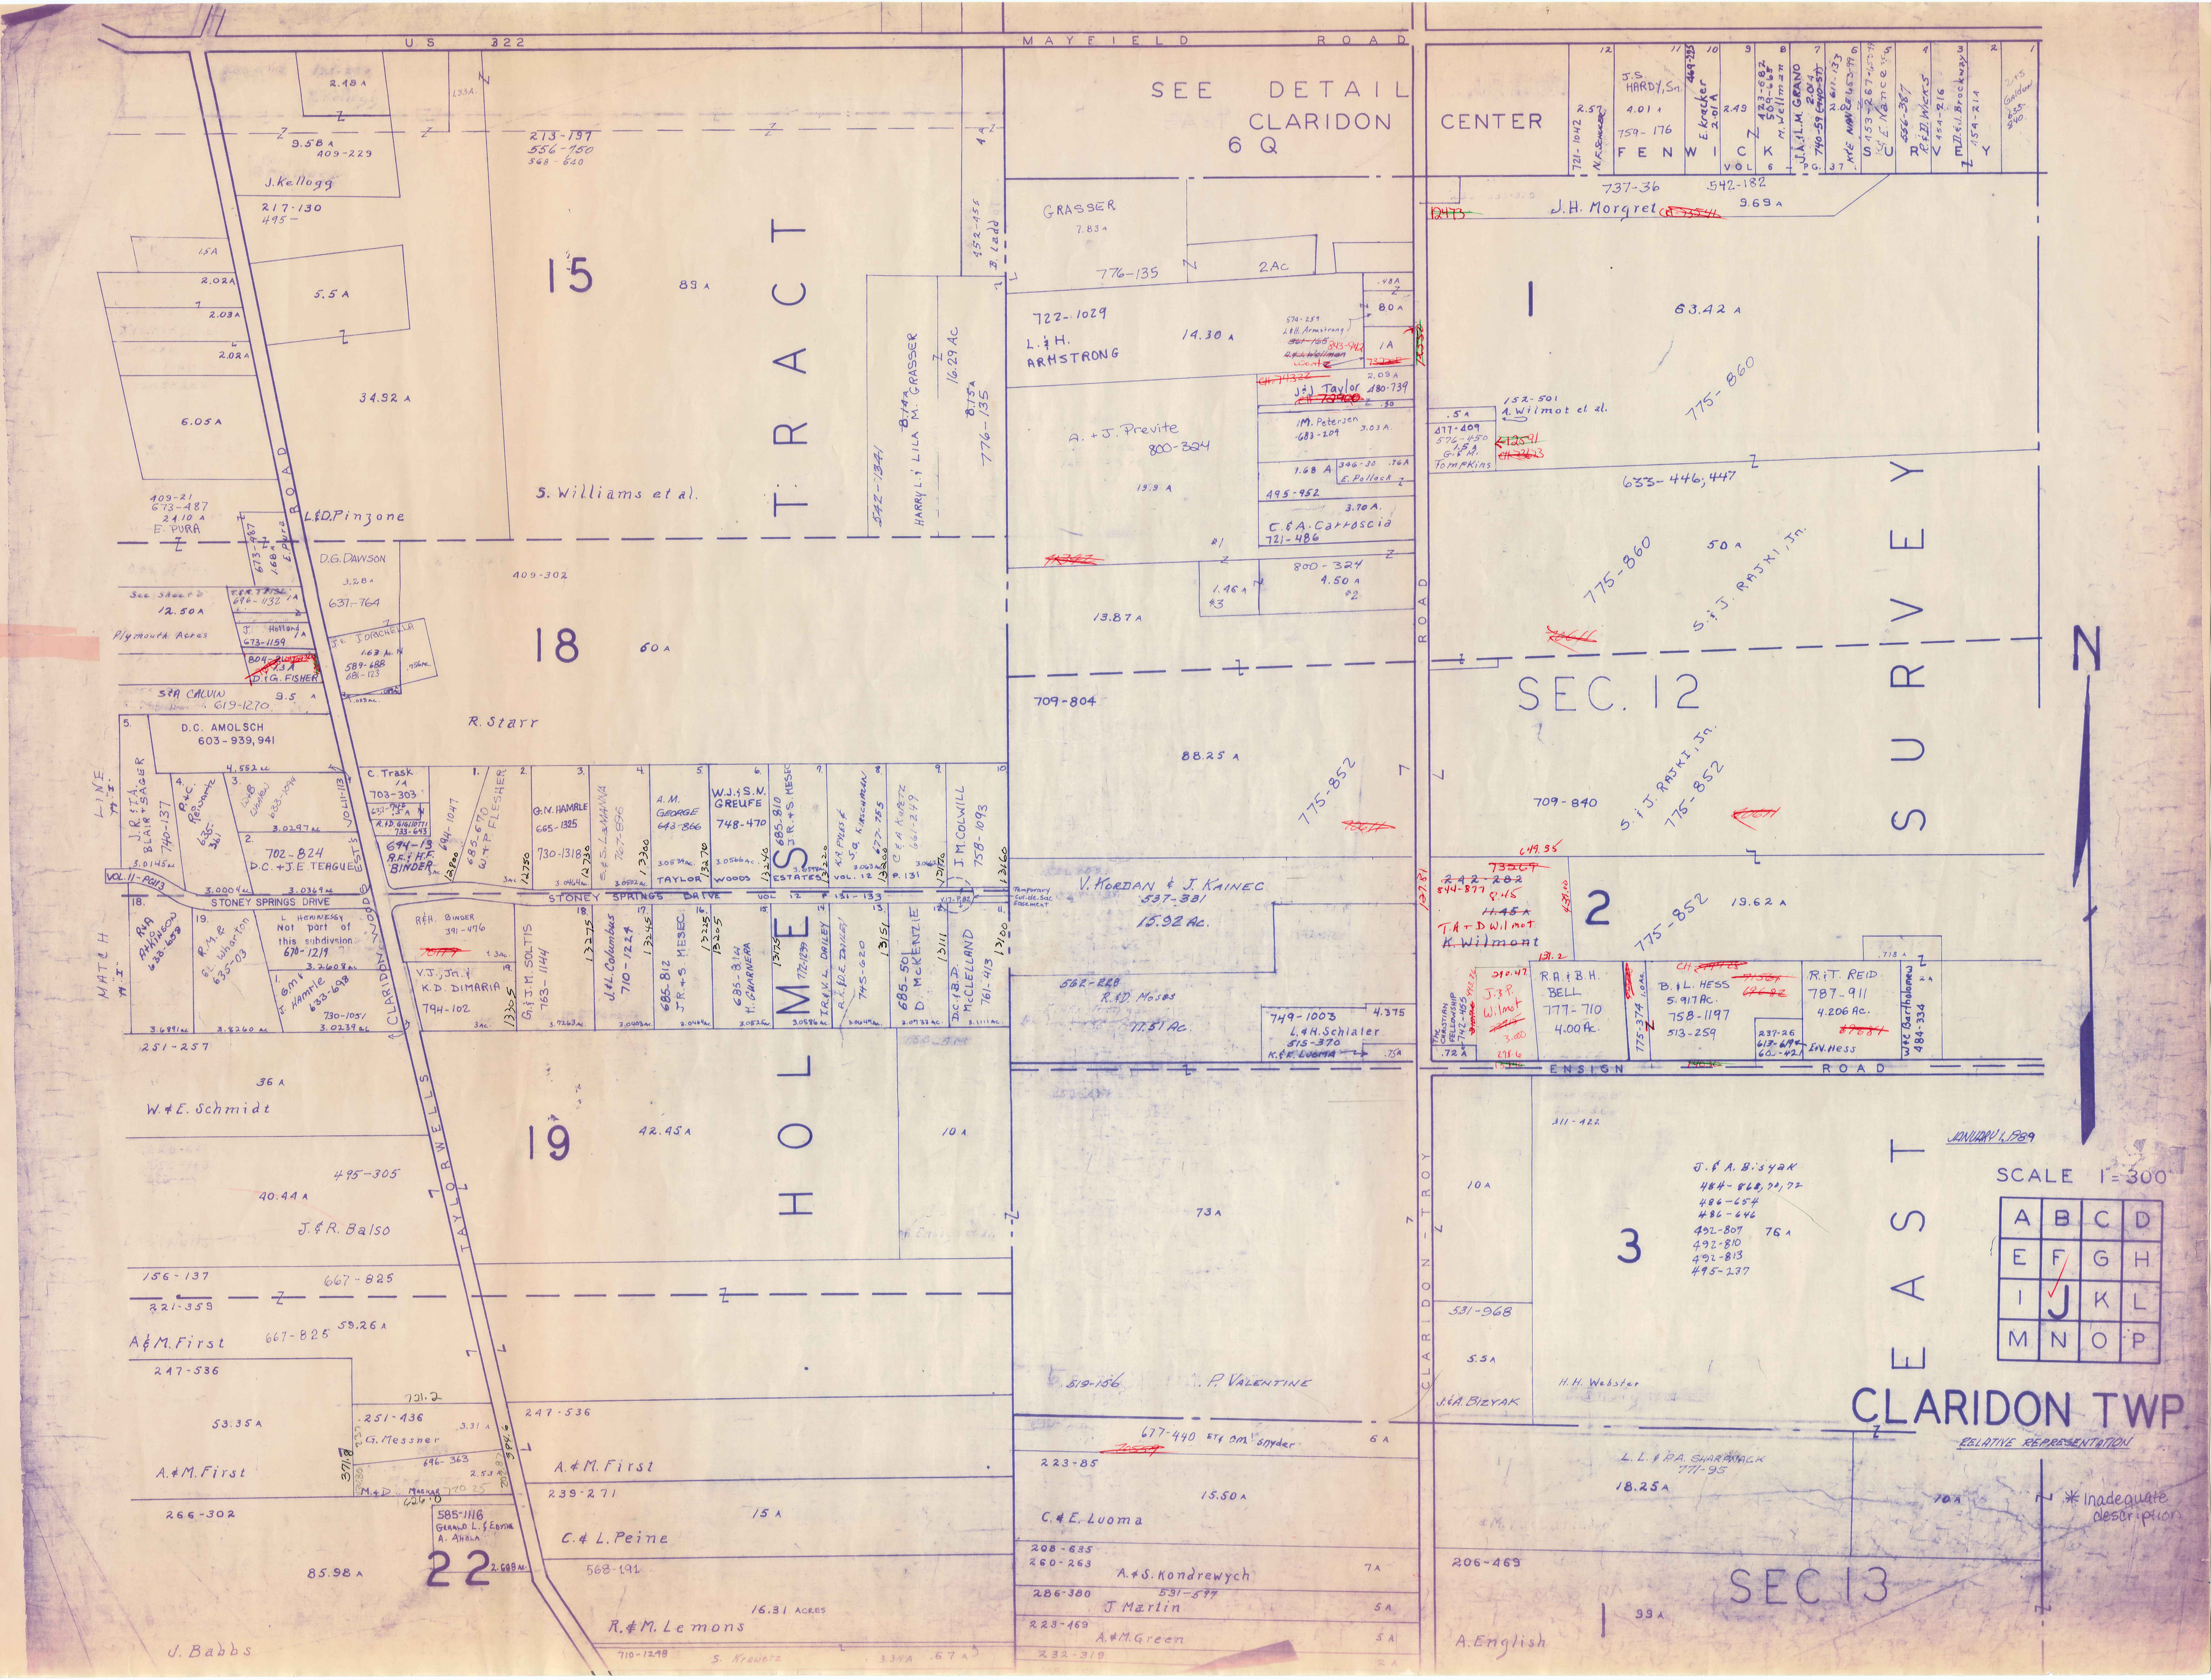
US 322
MAYFIELD ROAD
SEE DETAIL CLARIDON CENTER 6Q
FENWICK VOL 6
J.S. HARDY, Sr. 4.01 A 759-176
E. Kracker 2.01 A
N.F. Schuler 721-1042 2.57
J.H. Morgret 9.69 A
737-36
542-182
GRASSER 7.83 A
776-135
2 Ac
722-1029 L. & H. ARMSTRONG 14.30 A
J & J Taylor 480-739
M. Peterson 683-209 3.03 A
A. + J. Previte 800-324
E. Pollock
495-952
C. & A. Carroscia 721-486
800-324 4.50 A
1.46 A
13.87 A
A. Wilmot et al. 152-501
Tompkins
775-860
633-446, 447
63.42 A
1
50 A
S. & J. RAJSKI, Jr.
15
89 A
18
60 A
19
42.45 A
22
TRACT
HOLMES
EAST SURVEY
SEC. 12
SEC. 13
2
3
J. Kellogg 9.58 A 409-229
217-130 495-
2.48 A
273-197 556-750 568-640
5.5 A
2.02 A
2.03 A
6.05 A
34.92 A
S. Williams et al.
L & D. Pinzone
E. PURA 409-21 673-487
D.G. DAWSON 3.28 A 637-764
409-302
Plymouth Acres
12.50 A
J. Holland 673-1159
J. Jirgnella 589-688
D. & G. FISHER
S & A CALVIN 619-1270
R. Starr
D.C. AMOLSCH 603-939, 941
HARRY L. & LILA M. GRASSER
16.29 Ac
8.15 A
776-135
542-1341
B. Ladd
709-804
88.25 A
775-852
709-840
V. KORDAN & J. KAINEC 537-381 15.92 Ac.
562-228 R. & D. Moses 77.51 Ac.
749-1003 L. & H. Schlater
4.375
K. Wilmont
T.A. & D. Wilmot
R.A. & B.H. BELL 777-710 4.00 Ac.
B. & L. HESS 5.917 Ac. 758-1197 513-259
R. & T. REID 787-911 4.206 Ac.
E.N. Hess
W & E Bartholomew 484-334
19.62 A
ENSIGN ROAD
CLARIDON - TROY ROAD
STONEY SPRINGS DRIVE
C. Trask 703-303
G.N. HAMRLE 665-1325 730-1318
A.M. GEORGE 643-866
W.J. & S.N. GREUFE 748-470
TAYLOR WOODS ESTATES
J.M. COLWILL 758-1093
D.C. TEAGUE 702-824
R. & H. BINDER 391-496
V.J., Jr. & K.D. DIMARIA 794-102
J. & L. Columbus 710-1224
J.R. & S. MESEC 685.812
H. CHARNERA 685.814
D. McKENZIE 685-501
D.C. & B.D. McCLELLAND 761-413
L. HENNESSEY Not part of this subdivision 670-1219
R.A. Atkinson 633-658
E. Hamrle 730-1051
251-257
W. & E. Schmidt 36 A
495-305
40.44 A
J. & R. Balso
156-137
221-359
667-825
A & M. First
53.26 A
247-536
53.35 A
A. & M. First
G. Messner
266-302
585-1116 Gerald L. & Edith A. Ahola
85.98 A
A. & M. First
239-271
15 A
C. & L. Peine
568-191
R. & M. Lemons
16.31 ACRES
J. Babbs
S. Krawietz
10 A
73 A
519-156
P. VALENTINE
677-440 Sny
6 A
223-85
15.50 A
C. & E. Luoma
208-635
260-263
A. & S. Kondrewych
286-380
J. Martin
223-469
A. & M. Green
7 A
5 A
5 A
J. & A. Bizyak
J. & A. Bizyak 484-868, 72, 77 486-654 486-646 492-807 492-810 492-813 495-237
76 A
10 A
531-968
5.5 A
H.H. Webster
L.L. & R.A. Sharnack 771-95
18.25 A
10 A
206-469
A. English
33 A
TAYLOR WELLS ROAD
CLARIDON WOODS ESTATES
MATCH LINE
N
JANUARY 1, 1989

SCALE 1" = 300'

A	B	C	D
E	F	G	H
I	J	K	L
M	N	O	P

CLARIDON TWP

RELATIVE REPRESENTATION

* inadequate description

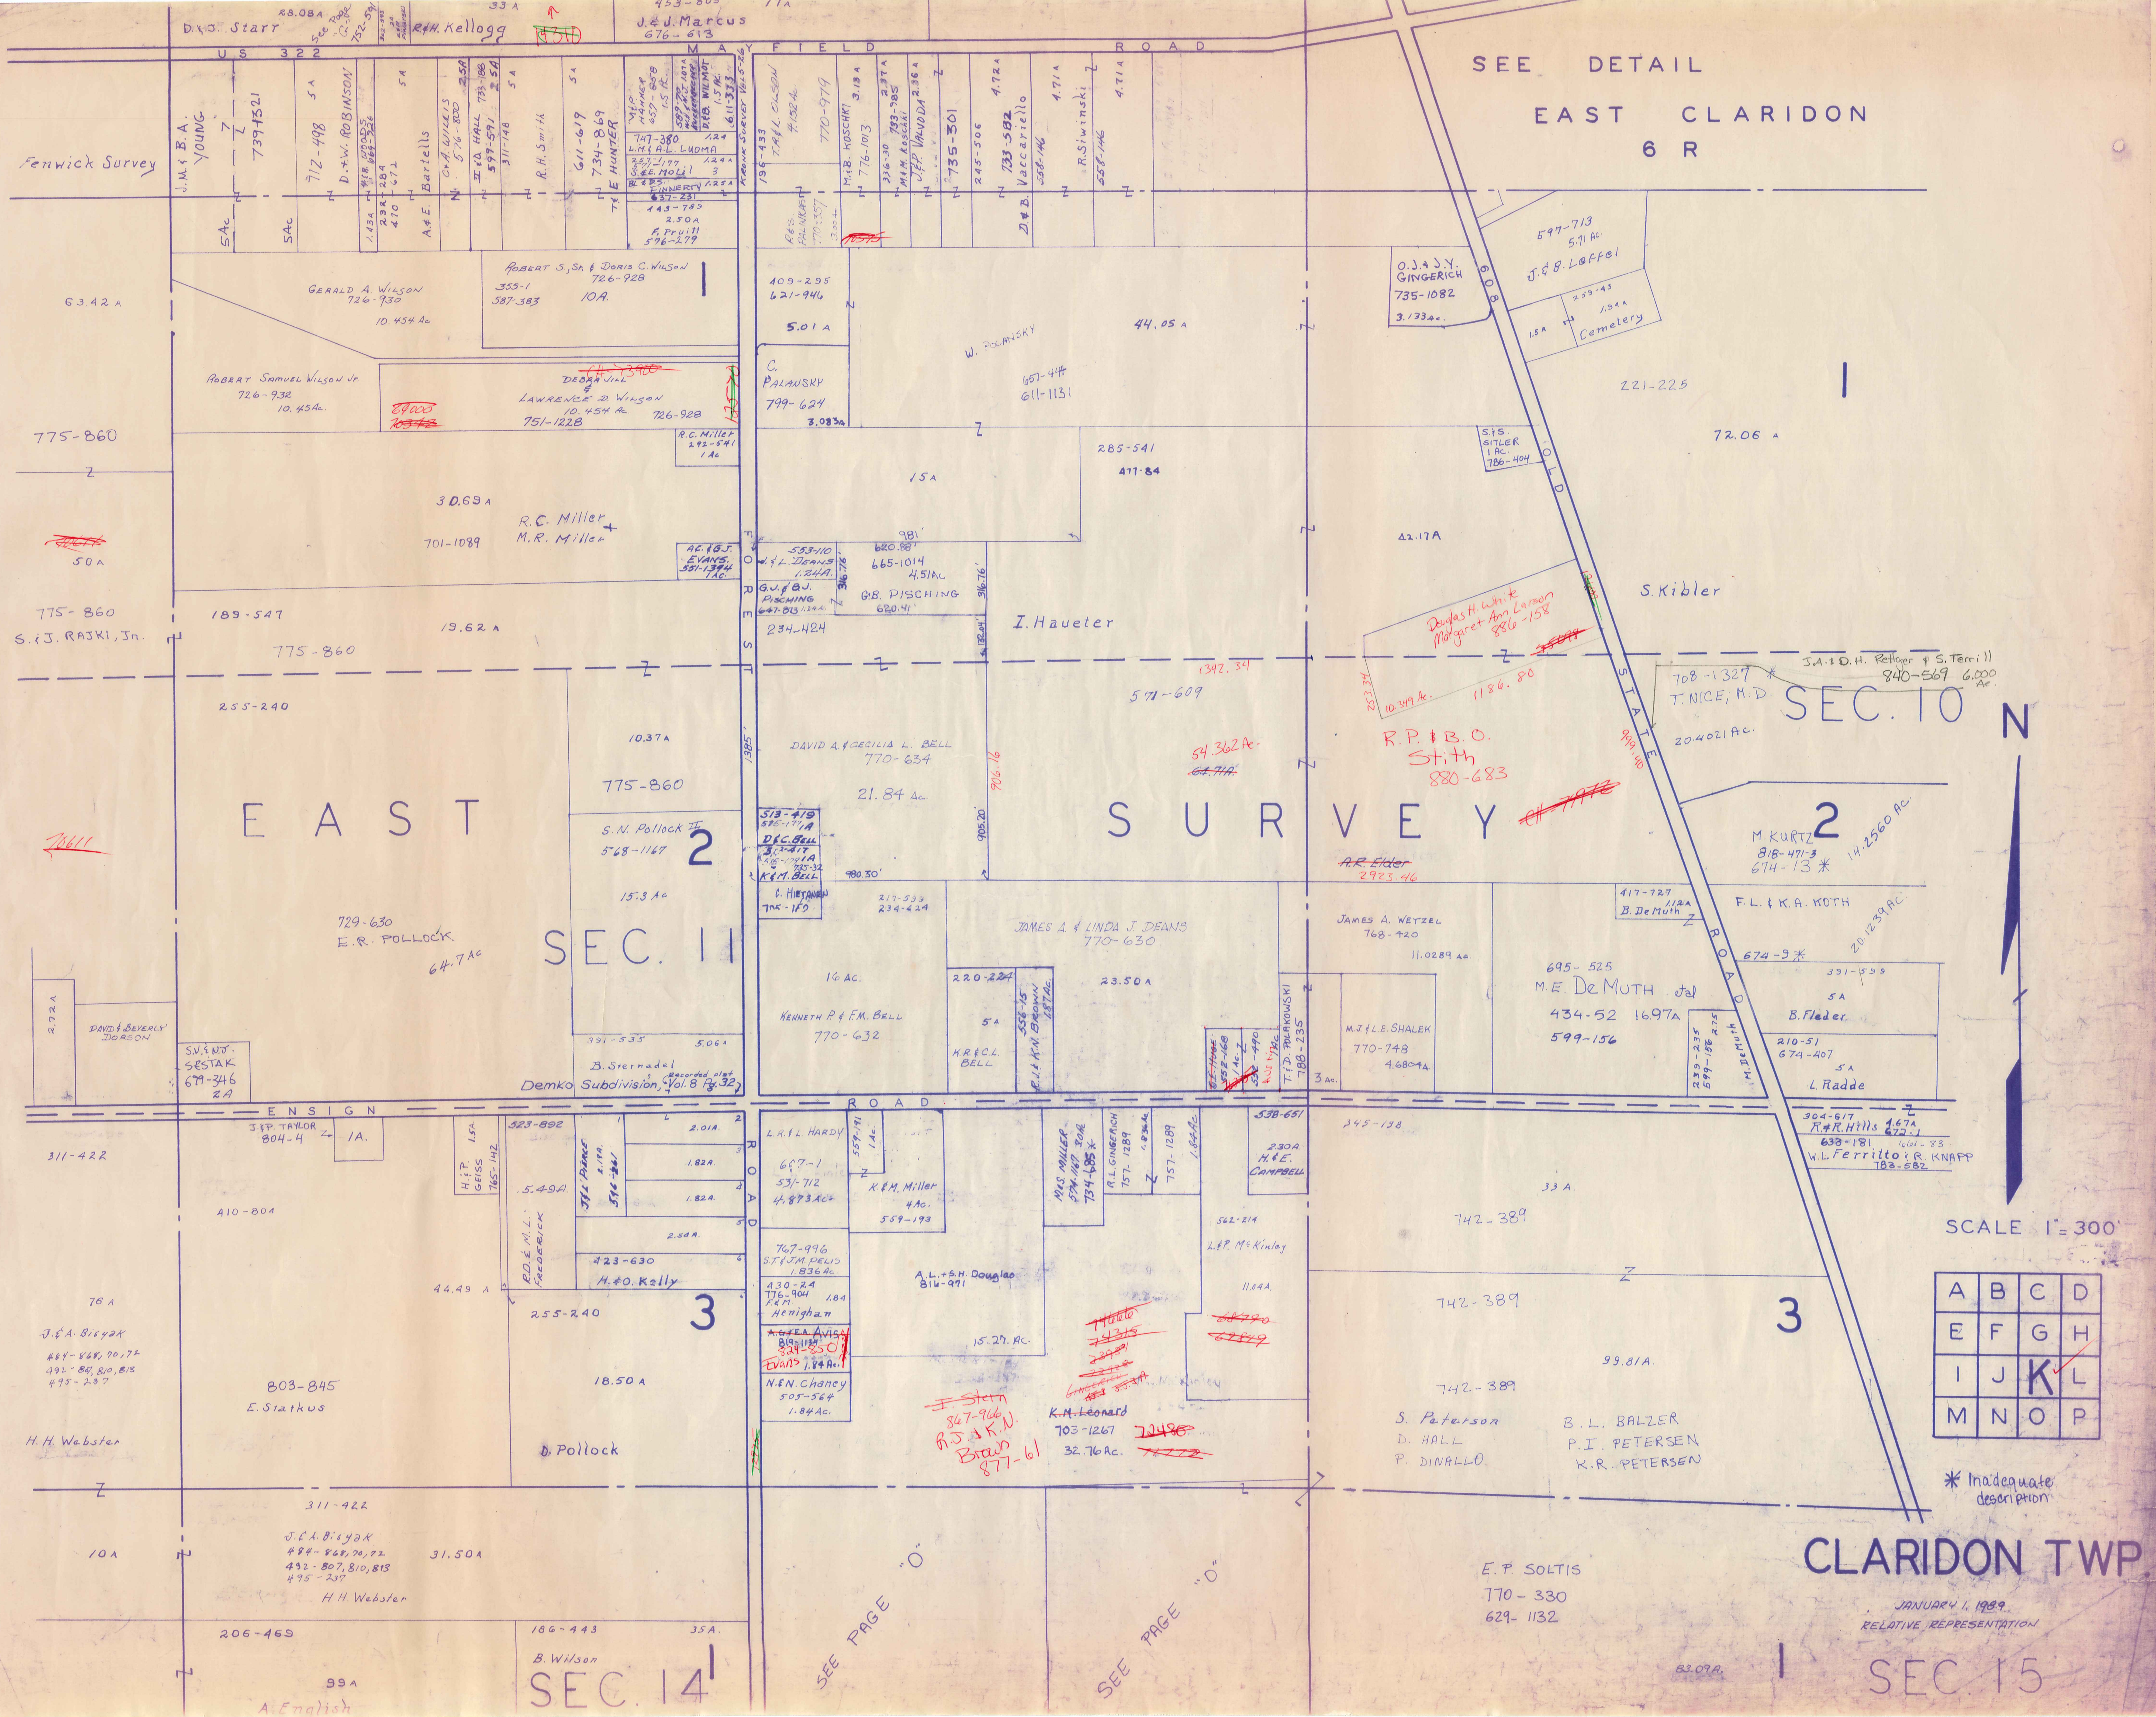

SEE DETAIL
EAST CLARIDON
6 R
MAYFIELD ROAD
US 322
D. & J. Starr
R & H. Kellogg
J. & J. Marcus
676-613
Fenwick Survey
J.M. & B.A. YOUNG
739-1321
712-498
D. & W. ROBINSON
A & E Bartells
C & R. WILKIS
I & A HALL
R.H. Smith
611-619
734-869
E HUNTER
L.H. & A.L. LUOMA
FINNERTY
F. Pruill
596-279
770-979
M. & B. KOSCHKI
776-1013
J & P VALVODA
735-301
245-506
D & B Vaccariello
R. Siwinski
558-146
GERALD A. WILSON
726-930
10.454 Ac
ROBERT S. Sr. & DORIS C. WILSON
726-928
355-1
587-383
10A.
ROBERT SAMUEL WILSON Jr.
726-932
10.45 Ac
DEBRA JILL & LAWRENCE D. WILSON
10.454 Ac
751-1228
R.C. Miller
292-541
1 Ac
63.42 A
775-860
50 A
30.69 A
R.C. Miller
M.R. Miller
701-1089
A.C. & G.J. EVANS
551-1394
1 Ac
409-295
621-946
5.01 A
C. PALANSKY
799-624
3.083 A
W. PALANSKY
44.05 A
611-1131
285-541
477-84
15 A
553-110
J. & L. DEANS
1.24 A
665-1014
4.51 Ac
G.B. PISCHING
G.J. & B.J. PISCHING
234-424
I. Haueter
O.J. & J.Y. GINGERICH
735-1082
3.133 Ac
597-713
5.71 Ac
J. & B. LOFFEL
Cemetery
221-225
72.06 A
S.I.S. SITLER
1 Ac
786-404
42.17 A
S. Kibler
Douglas H. White
Margaret Ann Larson
886-158
OLD STATE ROAD
608
775-860
S. & J. RAJKI, Jr.
189-547
19.62 A
255-240
10.37 A
775-860
EAST SURVEY
S.N. Pollock II
568-1167
15.3 Ac
729-630
E.R. POLLOCK
64.7 Ac
SEC. 11
391-535
5.06 A
B. Sternadel
Demko Subdivision, Vol. 8 Pg. 32
DAVID & BEVERLY DORSON
S.V. & N.J. SESTAK
679-346
2A
2.72 A
DAVID A. & CECILIA L. BELL
770-634
21.84 Ac
D & C BELL
K & M BELL
C. HIETANEN
217-533
234-424
JAMES A. & LINDA J. DEANS
770-630
23.50 A
KENNETH P. & F.M. BELL
770-632
16 Ac.
K.R. & C.L. BELL
B.J. & K.N. BROWN
T.D. PALANKOWSKI
788-235
571-609
54.362 A
~~64.71A~~
R.P. & B.O. Stith
880-683
1186.80
10.349 Ac
~~A.R. Elder~~
2925.46
JAMES A. WETZEL
768-420
11.0289 Ac
M.J. & L.E. SHALEK
770-748
4.6804 A
417-727
B. DeMuth
695-525
M.E. DeMuth
434-52
1697 A
599-156
M. DeMuth
708-1327
T. NICE, M.D.
J.A. & D.H. Rettger & S. Terrill
840-569
6.000 Ac
SEC. 10
20.4021 Ac
M. KURTZ
818-471
674-13
14.2560 Ac
F.L. & K.A. KOTH
20.1239 Ac
674-9
B. Fleder
210-51
674-407
L. Radde
R & R Hills
W.L. Ferritto
R. KNAPP
783-582
ENSIGN ROAD
FOREST ROAD
J. & P. TAYLOR
804-4
1A.
311-422
410-804
H. & P. GEISS
765-142
R.D. & M.L. FREDERICK
5.49 A
523-892
423-630
H. & O. Kelly
L.R. & L. HARDY
667-1
53-712
4.873 Ac
K. & M. Miller
4 Ac.
559-193
767-996
S.T. & J.M. PELIS
1.836 Ac
430-24
776-904
F.M. Henighan
Evans
N. & N. Chaney
505-564
1.84 Ac.
A.L. & S.H. Douglas
816-971
15.27 Ac.
R.L. GINGERICH
757-1289
H. & E. CAMPBELL
538-651
L. & P. McKinley
11.04 A.
245-128
33 A.
742-389
742-389
99.81 A
742-389
S. Peterson
D. HALL
P. DINALLO
B.L. BALZER
P.I. PETERSEN
K.R. PETERSEN
~~I. Stern~~
867-966
R.J. & K.N. Brown
877-61
K.M. Leonard
703-1267
32.76 Ac.
76 A
J. & A. Bisyak
803-845
E. Slatkus
18.50 A
D. Pollock
44.49 A
255-240
H.H. Webster
311-422
J. & A. Bisyak
31.50 A
10 A
206-469
99 A
A. English
186-443
B. Wilson
35 A.
SEC. 14
SEE PAGE "O"
SEE PAGE "O"
E.P. SOLTIS
770-330
629-1132
SEC. 15
1
2
3
N

SCALE 1" = 300'

A	B	C	D
E	F	G	H
I	J	K	L
M	N	O	P

* Inadequate description

CLARIDON TWP.

JANUARY 1, 1989
RELATIVE REPRESENTATION

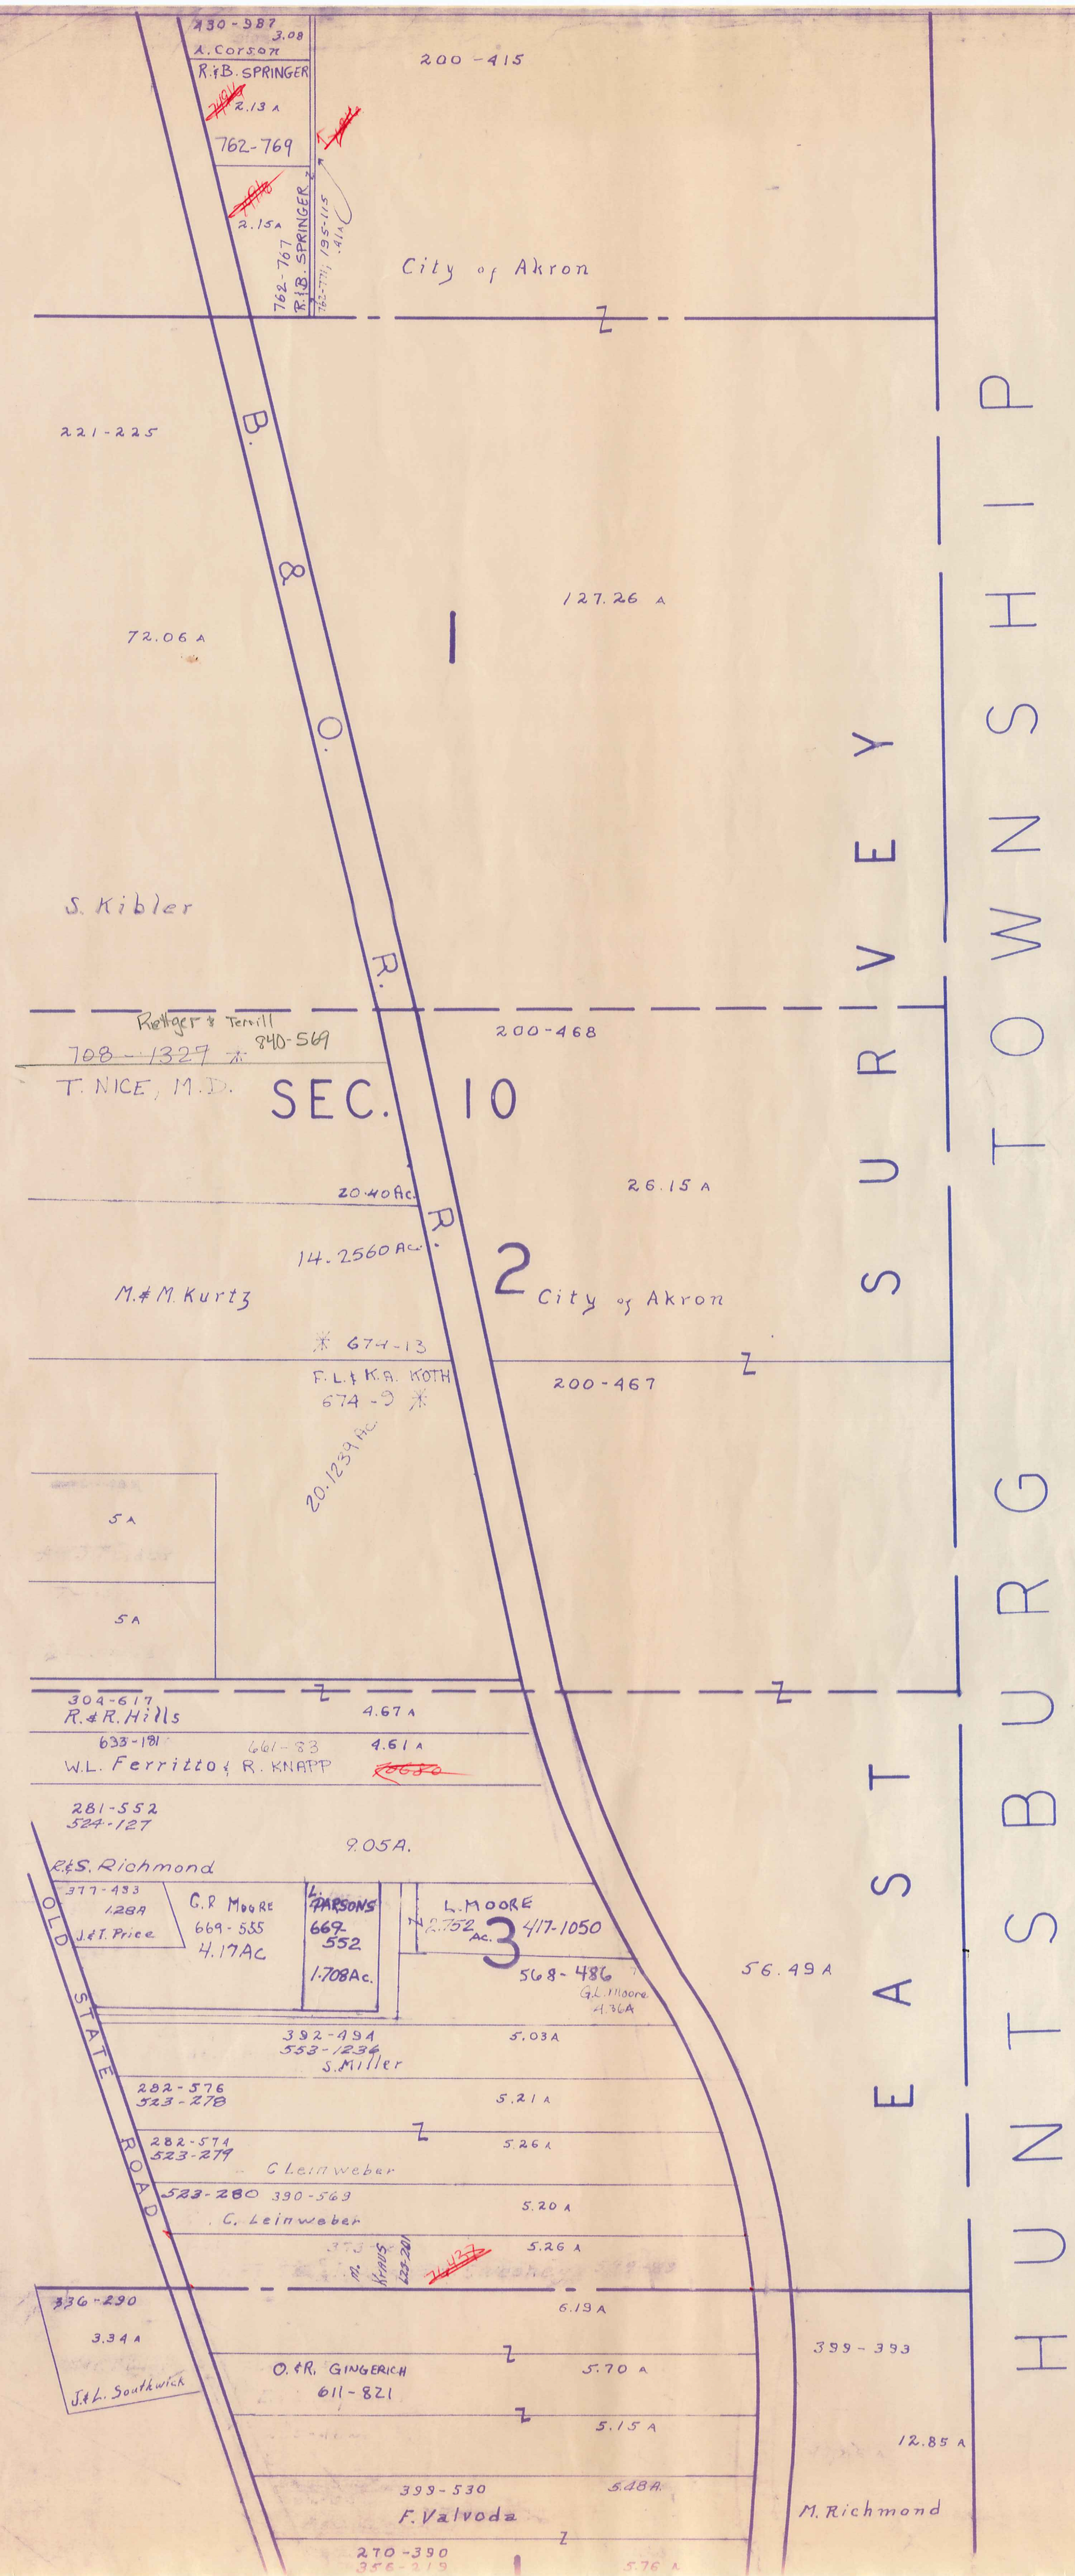
430-987
3.08
A. Corson
R.&B. SPRINGER
2.13 A
762-769
2.15 A
762-767
R.&B. SPRINGER
762-771; 195-115
.41 A
200-415
City of Akron
221-225
B. & O. R. R.
72.06 A
127.26 A
1
S. Kibler
Rettger & Terrill
~~708-1327~~ * 840-569
T. NICE, M.D.
SEC. 10
200-468
20.40 Ac.
26.15 A
14.2560 Ac.
2
City of Akron
M.& M. Kurtz
* 674-13
F.L. & K.A. KOTH
674-9 *
20.1239 Ac.
200-467
5 A
5 A
304-617
R.& R. Hills
4.67 A
633-181
661-83
4.61 A
W.L. Ferritto & R. KNAPP
281-552
524-127
9.05 A.
R.&S. Richmond
377-483
1.28 A
J.& T. Price
C.R. Moore
669-555
4.17 AC
L. PARSONS
669-552
1.708 Ac.
L. MOORE
2.752 Ac.
3
417-1050
568-486
G.L. Moore
4.36 A
56.49 A
392-494
553-1236
S. Miller
5.03 A
282-576
523-278
5.21 A
282-574
523-279
C. Leinweber
5.26 A
523-280 390-569
C. Leinweber
5.20 A
M. Kraus 523-201
5.26 A
OLD STATE ROAD
336-290
3.34 A
J.& L. Southwick
6.19 A
O.&R. GINGERICH
611-821
5.70 A
5.15 A
399-393
12.85 A
399-530
F. Valvoda
5.48 A
M. Richmond
270-390
356-219
5.76 A
EAST SURVEY
HUNTSBURG TOWNSHIP

* Inadequate description

SCALE 1" = 300'

JANUARY 1, 1969
RELATIVE REPRESENTATION

A	B	C	D
E	F	G	H
I	J	K	L ✓
M	N	O	P

CLARIDON TWP.

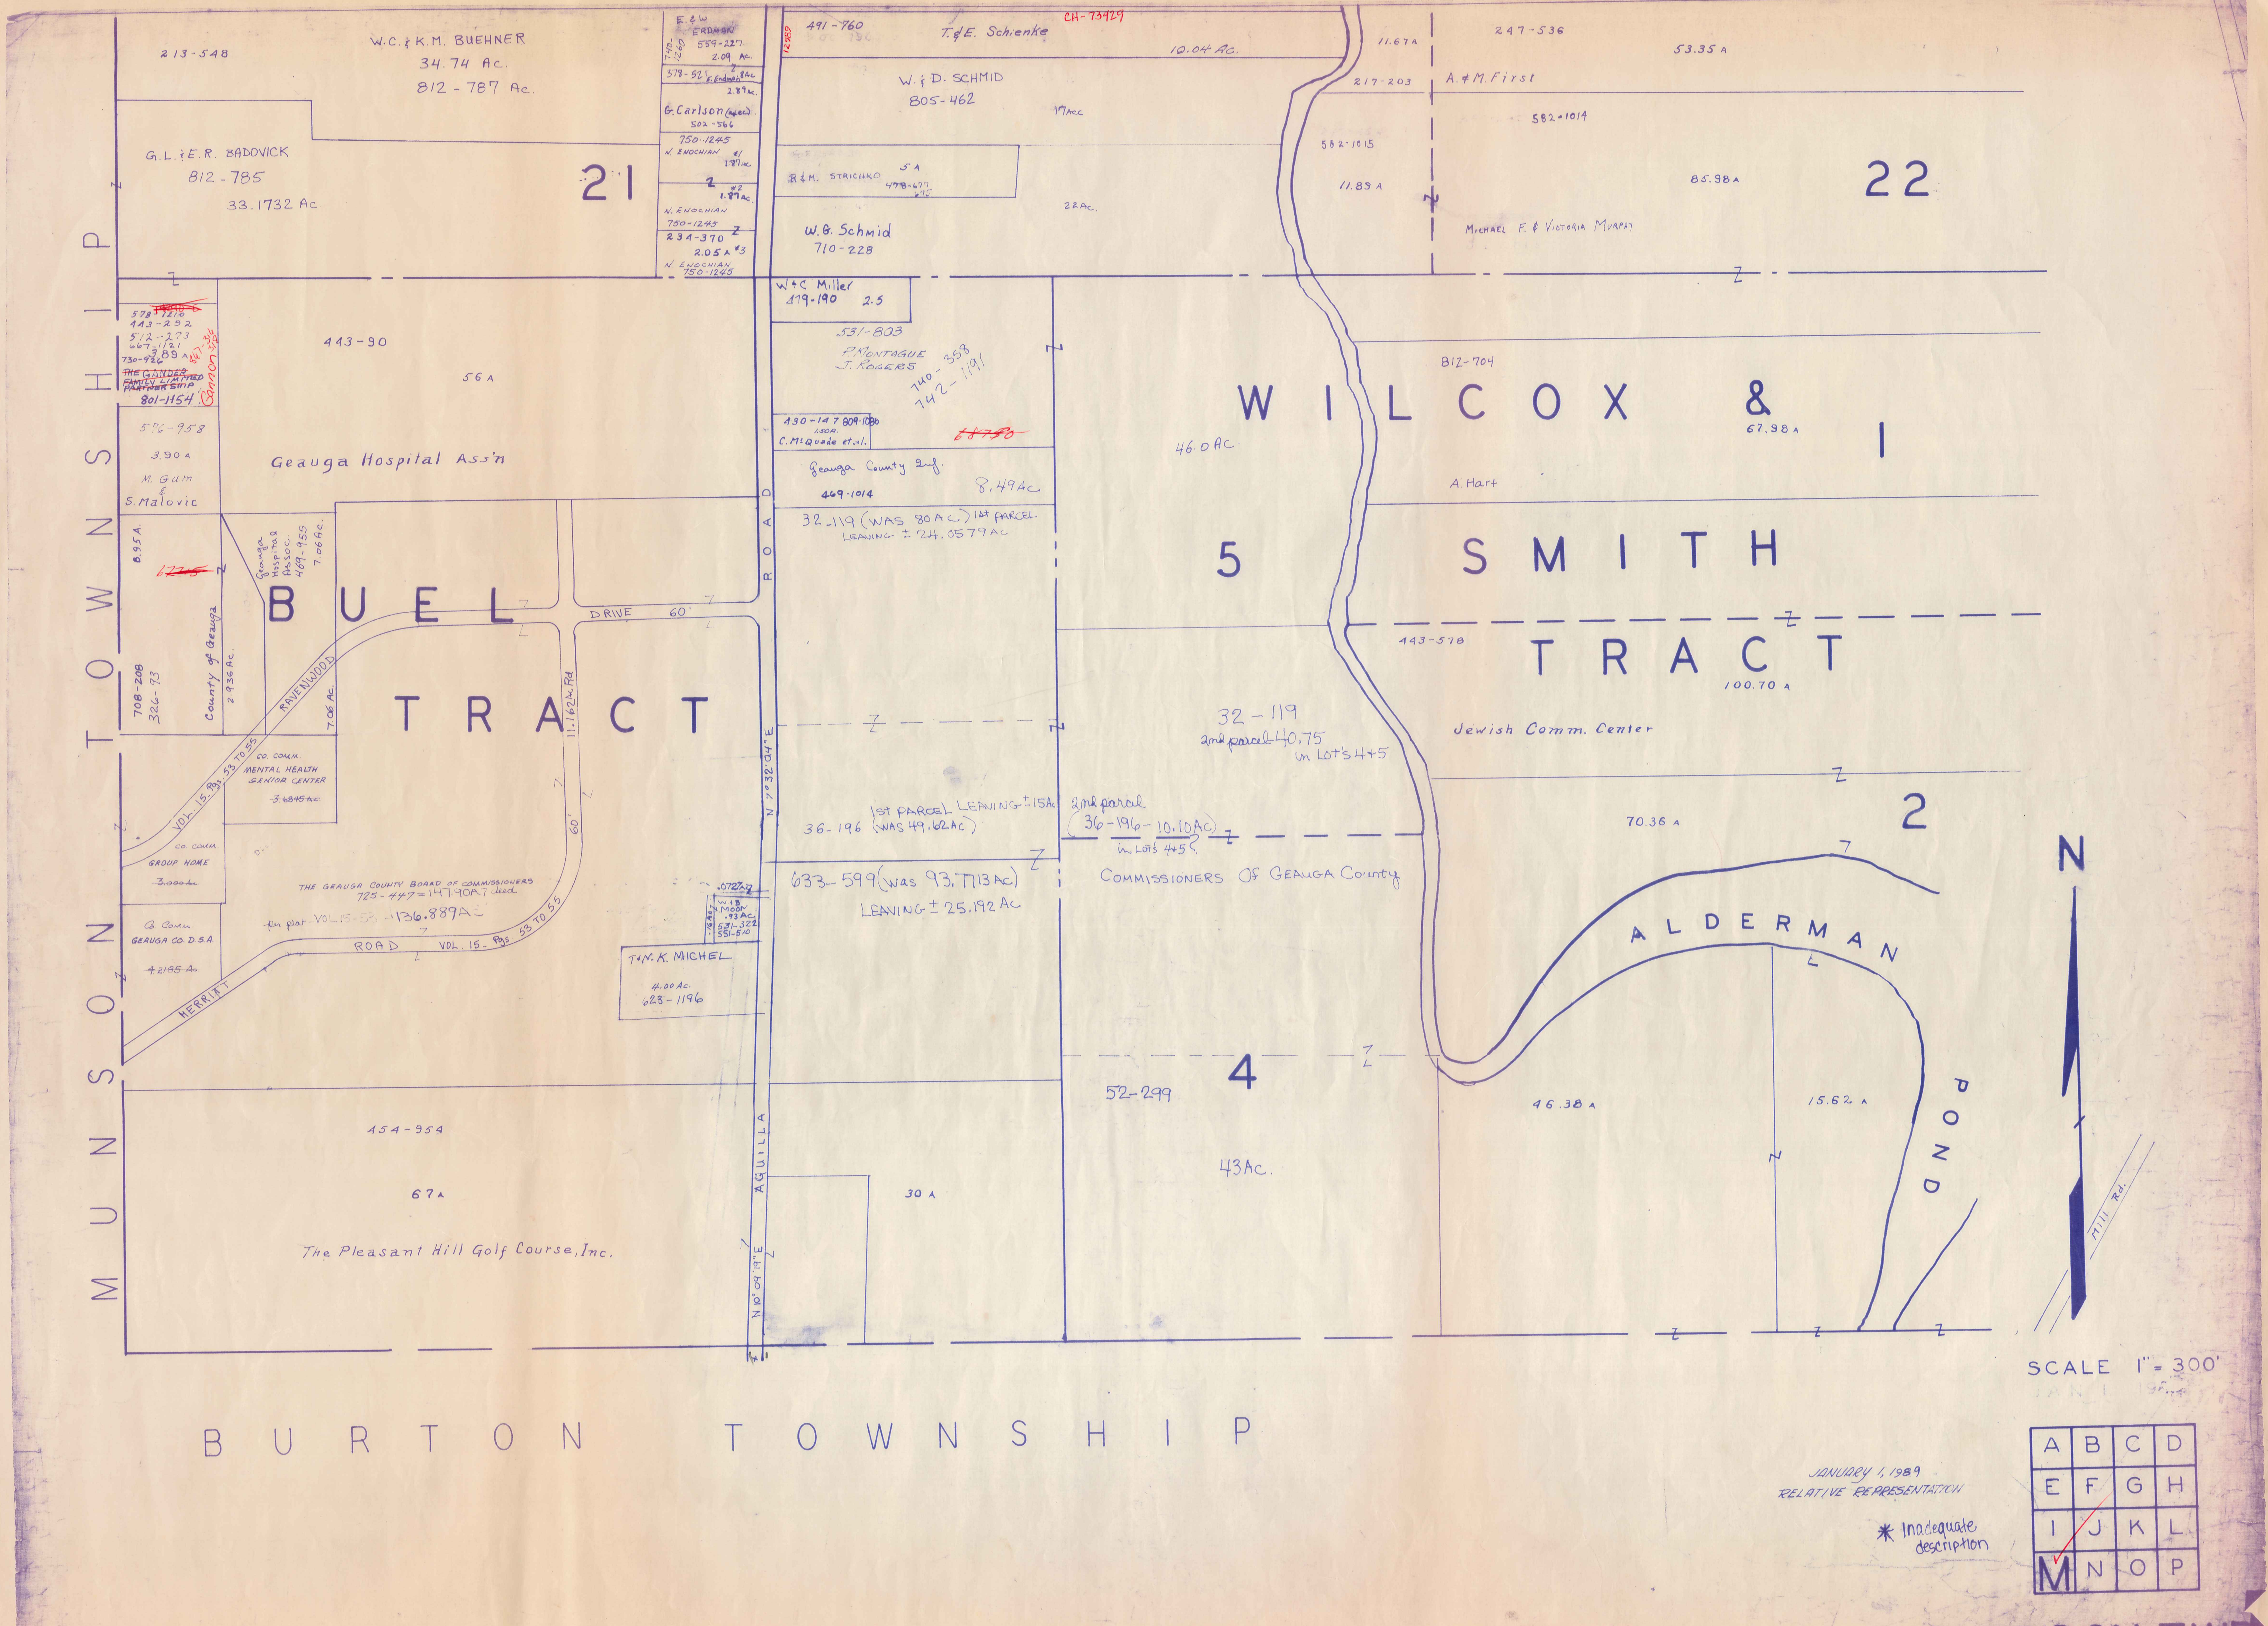
MUNSON TOWNSHIP
BURTON TOWNSHIP
21
22
WILCOX & SMITH TRACT
BUEL TRACT
1
2
4
5
213-548
W.C. & K.M. BUEHNER
34.74 Ac.
812-787 Ac.
G.L. & E.R. BADOVICK
812-785
33.1732 Ac
E. & W. ERDMAN
559-227
2.09 Ac.
579-521
G. Carlson
502-566
750-1245
N. Enochian
234-370
2.05 A
491-760
T. & E. Schienke
CH-73429
10.04 Ac.
W. & D. SCHMID
805-462
17 Ac
R. & M. Strichko
5 A
478-697
22 Ac.
W.G. Schmid
710-228
11.67 A
247-536
53.35 A
217-203
A. & M. First
582-1014
582-1015
11.89 A
85.98 A
Michael F. & Victoria Murphy
W & C Miller
419-190
2.5
531-803
P. Montague
J. Rogers
740-358
742-1191
430-147
809-1086
C. McQuade et al.
Geauga County Inf.
449-1014
8.49 Ac
32-119 (WAS 80 AC.) 1st PARCEL LEAVING ± 24.0579 AC
46.0 Ac.
812-704
67.98 A
A. Hart
443-578
100.70 A
Jewish Comm. Center
32-119
2nd parcel 40.75
in LOT'S 4+5
1st PARCEL LEAVING ± 15 Ac
36-196 (WAS 49.62 AC)
2nd parcel (36-196 - 10.10 Ac)
in Lots 4+5
633-599 (was 93.7713 Ac)
LEAVING ± 25.192 Ac
COMMISSIONERS OF GEAUGA County
70.36 A
ALDERMAN POND
46.38 A
15.62 A
52-299
43 Ac.
30 A
443-90
56 A
Geauga Hospital Ass'n
576-958
3.90 A
M. Gum
S. Malovic
8.95 A
801-1154
Geauga Hospital Assoc. 489-955 7.06 Ac
County of Geauga 2.936 Ac.
708-208
326-93
RAVENWOOD
DRIVE 60'
11.162 Rd.
60'
7.06 Ac.
CO. COMM. MENTAL HEALTH SENIOR CENTER
CO. COMM. GROUP HOME
G. Co. Geauga Co. D.S.A.
THE GEAUGA COUNTY BOARD OF COMMISSIONERS
725-447 = 147.90 A
VOL. 15 Pgs 53 TO 55
ROAD VOL. 15 Pgs 53 TO 55
MERRITT
T. & K. K. MICHEL
4.00 Ac.
623-1196
ROAD
N 7°32'04" E
AQUILLA
N 6°04'17" E
454-954
67 A
The Pleasant Hill Golf Course, Inc.
N
Hill Rd.
SCALE 1" = 300'
JANUARY 1, 1989
RELATIVE REPRESENTATION
* Inadequate description
A B C D
E F G H
I J K L
M N O P

CLARIDON TWP.

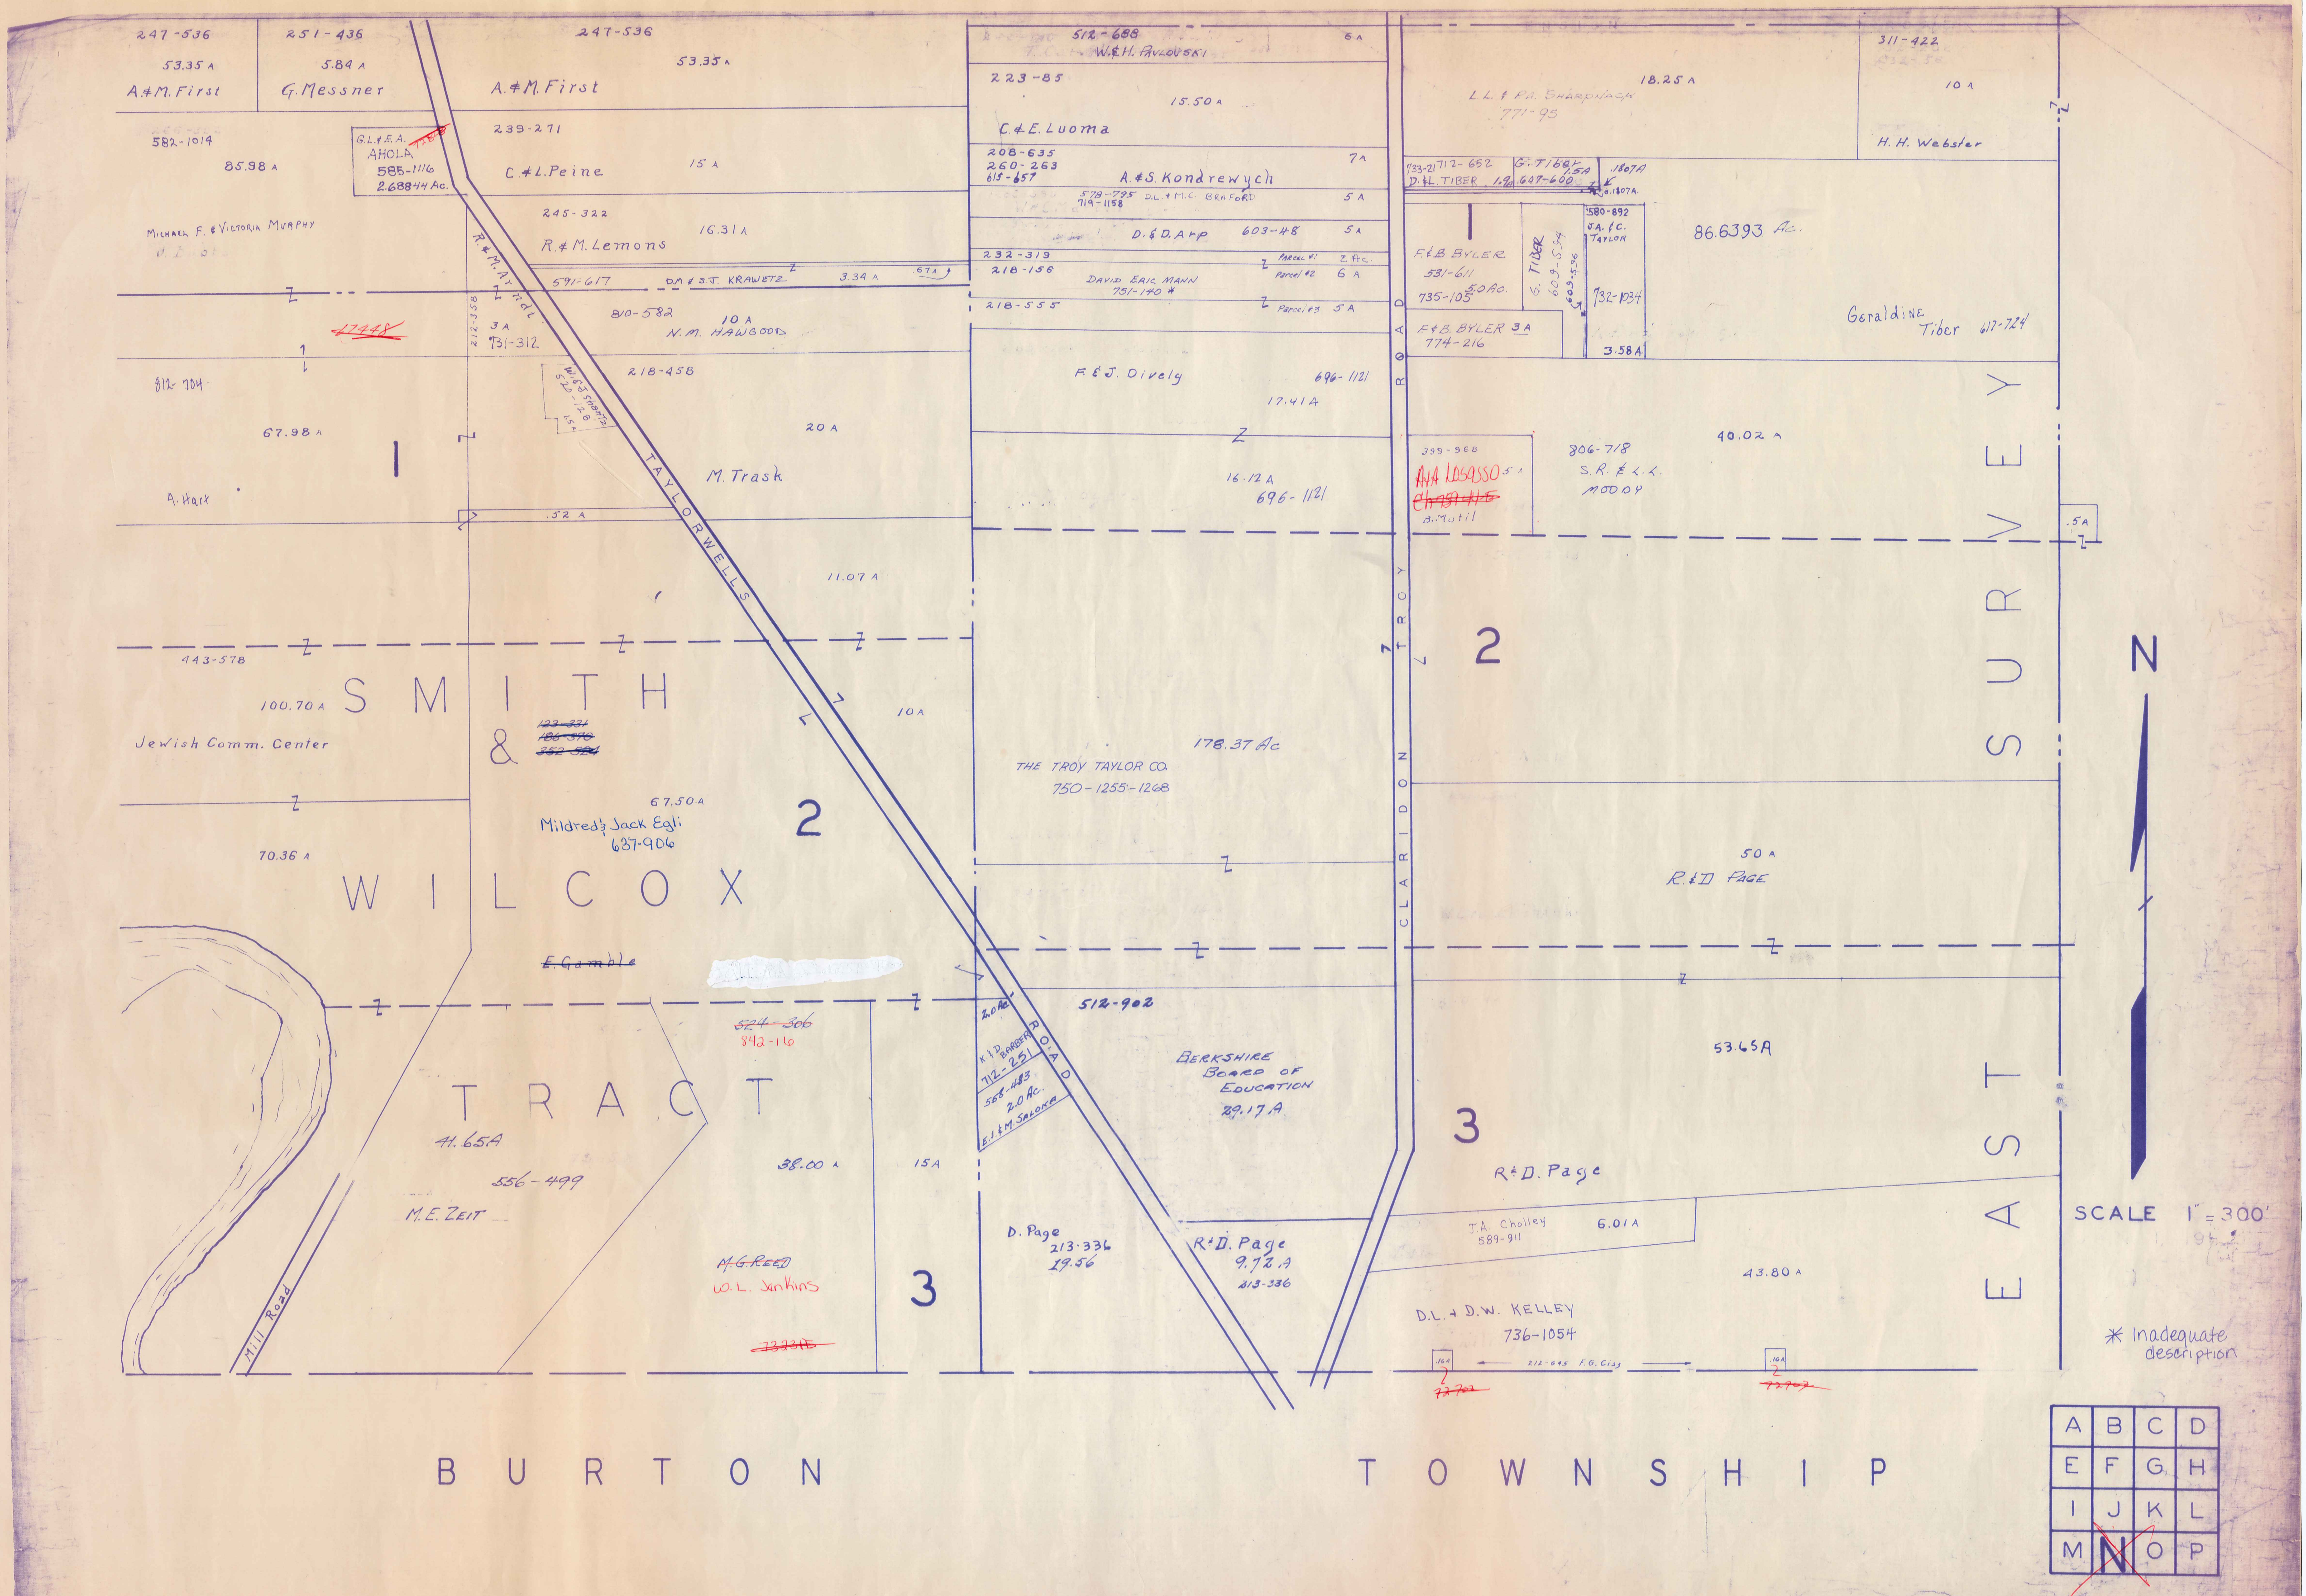
247-536
53.35 A
A.&M. First
251-436
5.84 A
G. Messner
247-536
53.35 A
A.&M. First
582-1014
85.98 A
G.L.&E.A. AHOLA ~~7188~~ 585-1116 2.68844 Ac.
239-271
C.&L. Peine
15 A
245-322
R.&M. Lemons
16.31 A
Michael F. & Victoria Murphy
591-617
D.M. & S.J. KRAWETZ
3.34 A
.67 A
R.&M. Arndt
212-358
3 A
731-312
810-582
10 A
N.M. HAWGOOD
~~17448~~
812-704
W.&E.J. Shantz 520-128 1.5 A
218-458
67.98 A
1
20 A
M. Trask
A. Hart
.52 A
TAYLOR WELLS
11.07 A
443-578
100.70 A
SMITH
&
~~123-331~~
~~186-370~~
~~252-524~~
Jewish Comm. Center
10 A
67.50 A
Mildred & Jack Egli
637-906
2
70.36 A
WILCOX
~~E. Gamble~~
~~524-306~~
842-16
TRACT
41.65A
556-499
M.E. Zeit
38.00 A
15 A
~~M.G. Reed~~
W.L. Jenkins
~~732315~~
3
Mill Road
512-688
W.&H. Pavlovski
6 A
223-85
15.50 A
C.&E. Luoma
208-635
260-263
615-657
A.&S. Kondrewych
7 A
578-795
719-1158
D.L.&M.C. BRAFORD
5 A
D.&D. Arp
603-48
5 A
232-319
218-156
DAVID ERIC MANN
751-140 *
Parcel #1 2 Ac.
Parcel #2 6 A
218-555
Parcel #3 5 A
F.&J. Dively
696-1121
17.41 A
16.12 A
696-1121
THE TROY TAYLOR CO.
750-1255-1268
178.37 Ac
2.0 Ac.
K.&D. BARBER
712-251
568-483
2.0 Ac.
E.J.&M. SALOKA
ROAD
512-902
BERKSHIRE BOARD OF EDUCATION
29.17 A
D. Page
213-336
19.56
R.&D. Page
9.72 A
213-336
CLARIDON TROY ROAD
L.L.&P.A. SHARPNACK
771-95
18.25 A
311-422
10 A
H.H. Webster
733-21
712-652
D.&L. TIBER
1.9 A
G. Tiber
1.5 A
607-600
.1807 A
.1807 A
580-892
J.A.&C. TAYLOR
732-1034
3.58 A
F.&B. BYLER
531-611
735-105
5.0 Ac.
G. TIBER
609-594
609-596
F.&B. BYLER 3 A
774-216
86.6393 Ac.
Geraldine Tiber 617-724
1
399-968
ANA LOSASSO
~~Ch 731-115~~
5 A
B. Motil
806-718
S.R.&L.L. MOODY
40.02 A
.5 A
2
50 A
R.&D. PAGE
53.65 A
3
R.&D. Page
T.A. Cholley
589-911
6.01 A
43.80 A
D.L.&D.W. KELLEY
736-1054
.16 A
212-645 F.G. Ciss
.16 A
~~72702~~
~~72702~~
EAST SURVEY
N
SCALE 1" = 300'
* Inadequate description
BURTON TOWNSHIP
A B C D
E F G H
I J K L
M N O P

CLARIDON TWP.

JANUARY 1, 1989
RELATIVE REPRESENTATION

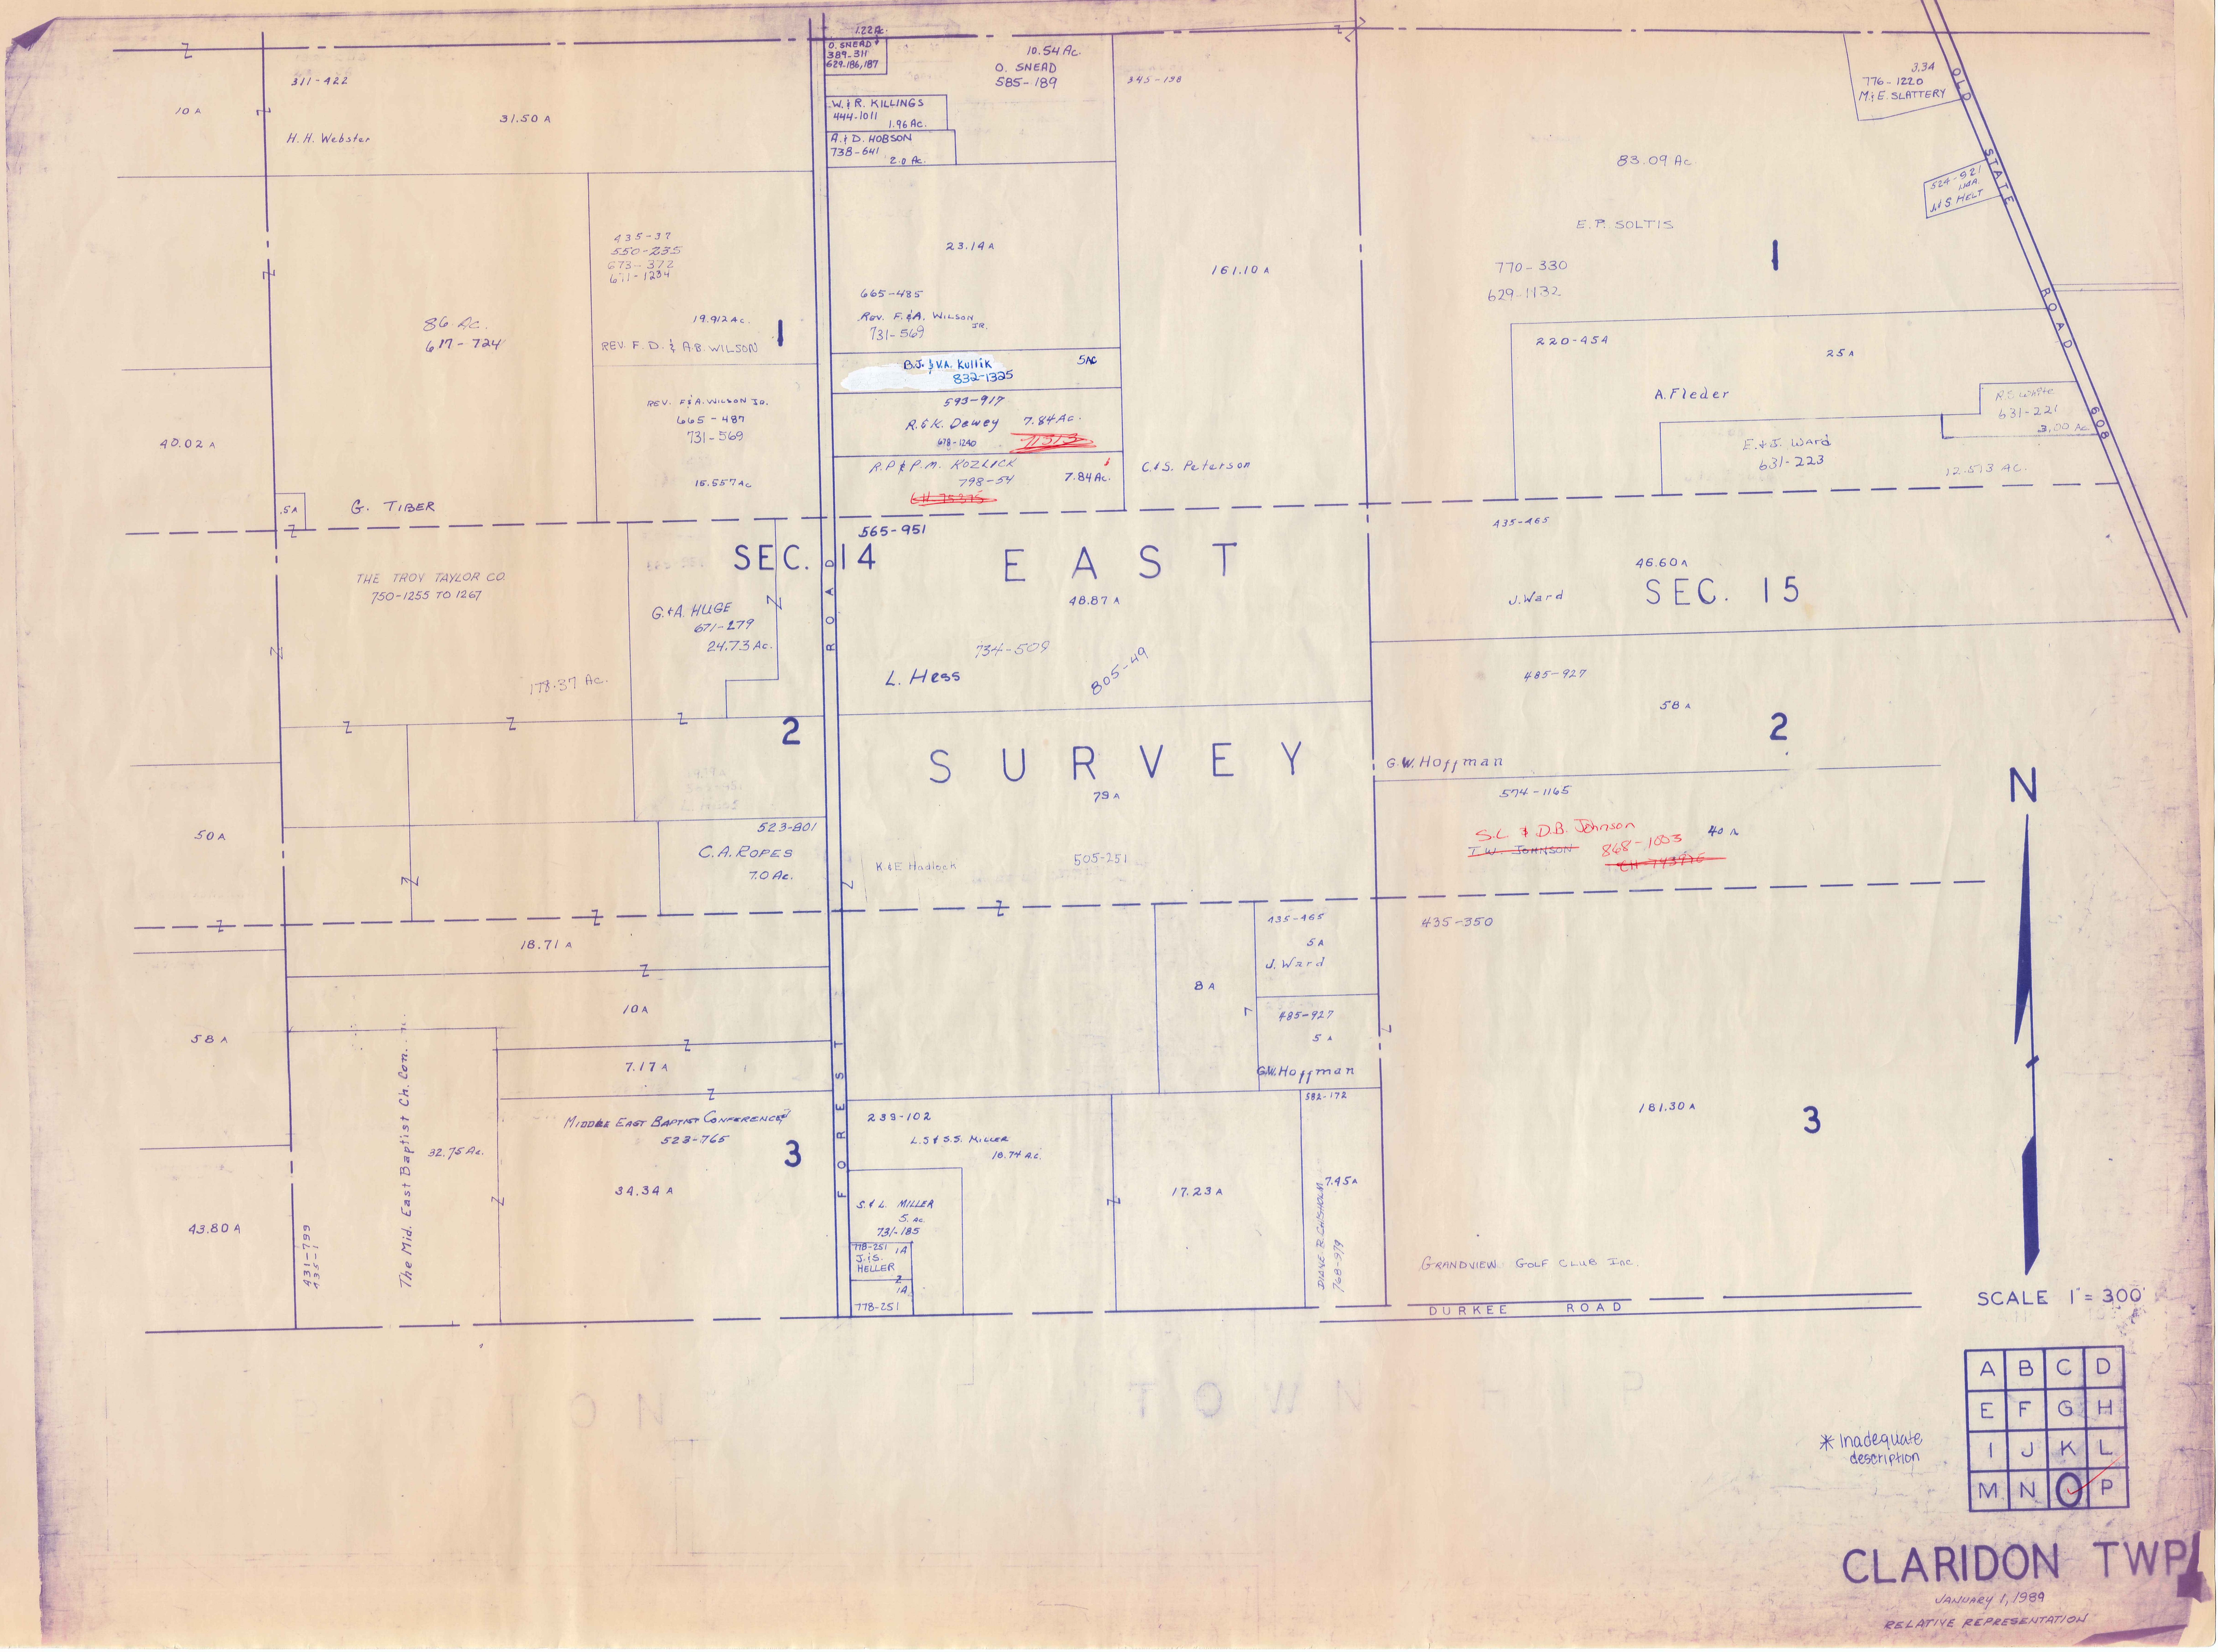
1.22 Ac
O. SNEAD
389-311
629-186,187
10.54 Ac.
O. SNEAD
585-189
345-138
311-422
10 A
31.50 A
H. H. Webster
W. & R. KILLINGS
444-1011
1.96 Ac.
A. & D. HOBSON
738-641
2.0 Ac.
776-1220
M. & E. SLATTERY
3.34
83.09 Ac
524-921
.48A
M.S. MELT
OLD STATE ROAD 608
E. P. SOLTIS
770-330
629-1132
1
435-37
550-235
673-372
671-1234
86 Ac.
6M-724
19.912 Ac.
REV. F. D. & A.B. WILSON
1
23.14 A
665-485
Rev. F. & A. Wilson Sr.
731-569
161.10 A
220-454
25 A
A. Fleder
B.J. & V.A. Kullik
832-1325
5Ac
593-917
R. & K. Dewey
678-1240
7.84 Ac.
~~71313~~
R.P. & P.M. Kozlick
798-54
~~6H 75345~~
7.84 Ac.
C. & S. Peterson
REV. F. & A. WILSON Jr.
665-487
731-569
15.557 Ac
40.02 A
.5A
G. TIBER
R.D. Waite
631-221
3.00 Ac.
E. & J. Ward
631-223
12.573 Ac.
565-951
SEC. 14
EAST
435-465
46.60 A
J. Ward
SEC. 15
THE TROY TAYLOR CO.
750-1255 TO 1267
G. & A. HUGE
671-279
24.73 Ac.
178.37 Ac.
48.87 A
734-509
805-49
L. Hess
FOREST ROAD
485-927
58 A
2
2
SURVEY
G.W. Hoffman
2
79 A
574-1165
50 A
523-801
C.A. Ropes
7.0 Ac.
K & E Hadlock
505-251
S.L. & D.B. Johnson
~~T.W. Johnson~~
868-1003
~~CH 74376~~
40 A
435-350
18.71 A
435-465
5 A
J. Ward
8 A
10 A
485-927
5 A
58 A
7.17 A
G.W. Hoffman
582-172
The Mid. East Baptist Ch. Con.
Middle East Baptist Conference
523-765
3
239-102
L.S. & S.S. Miller
18.74 Ac.
181.30 A
3
32.75 Ac.
34.34 A
17.23 A
7.45 A
S. & L. MILLER
5 Ac.
731-185
778-251
1A
J. & S. HELLER
1A
778-251
Dave R. Cashdollar
768-979
43.80 A
431-799
435-1
GRANDVIEW GOLF CLUB Inc.
DURKEE ROAD
N
SCALE 1" = 300'
A B C D
E F G H
I J K L
M N O P
* Inadequate description

CLARIDON TWP

JANUARY 1, 1989

RELATIVE REPRESENTATION

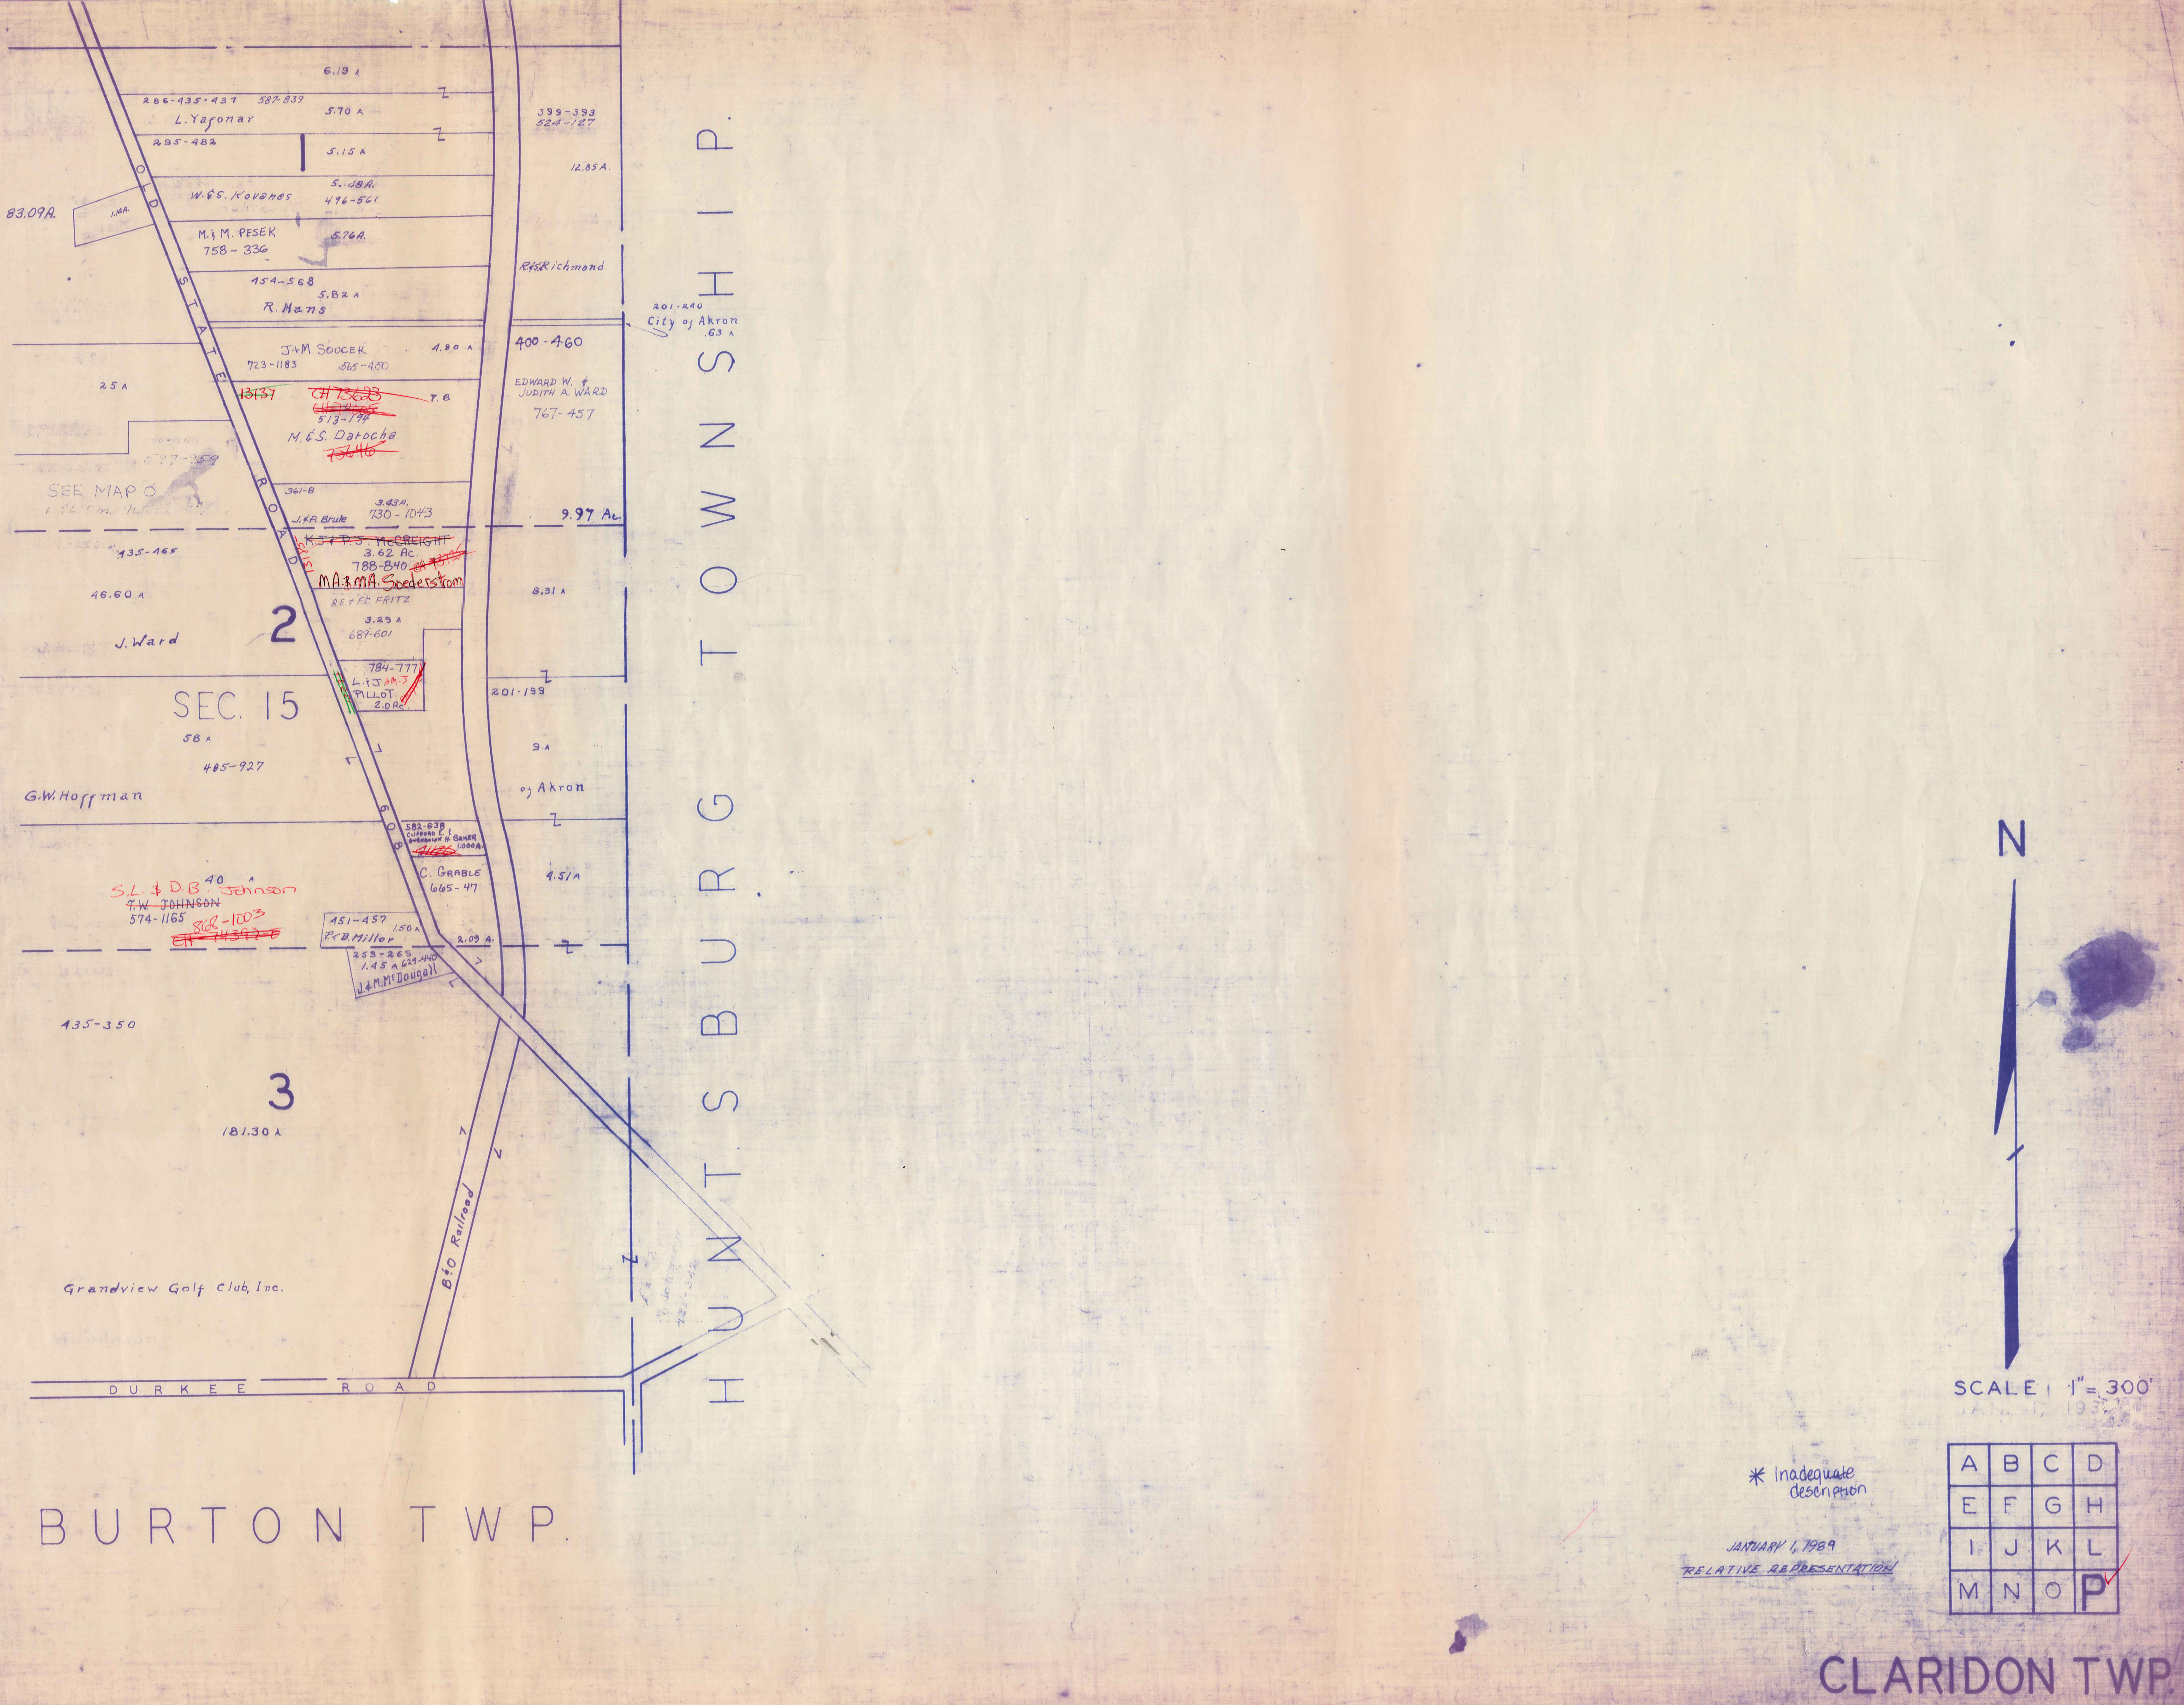
6.19 A
286-435-437
587-839
L. Yafonar
5.70 A
295-482
5.15 A
399-393
524-127
12.85 A.
W. & S. Kovanes
5.48A.
496-561
83.09A.
1.14A.
M. & M. PESEK
758-336
5.76A.
OLD STATE ROAD
R. & S. Richmond
454-568
5.82 A
R. Hans
201-240
City of Akron
.63 A
J+M SOUCEK
723-1183
565-450
4.80 A
400-460
25 A
~~13137~~
~~CH 73623~~
~~CH 74065~~
7.8
513-194
M. & S. Darocha
~~73646~~
EDWARD W. & JUDITH A. WARD
767-457
597-959
SEE MAP O
361-8
3.43A.
730-1043
J. & P. Brule
9.97 Ac.
~~K.J. & P.J. McCREIGHT~~
3.62 Ac.
788-840
~~CH 73775~~
13185
MA. & MA. Soederstrom
435-465
46.60 A
R.E. & F.C. FRITZ
3.29 A
689-601
8.31 A
2
J. Ward
784-777
L. & J. JM-J
PILLOT
2.0 Ac.
SEC. 15
201-199
58 A
485-927
9 A
of Akron
G.W. Hoffman
608
582-638
CLIFFORD E. & GWENDOLYN H. BAKER
1.000 A.
C. GRABLE
665-47
4.51 A
40 A
S.L. & D.B. Johnson
~~T.W. JOHNSON~~
574-1165
868-1003
~~CH 74397-E~~
451-457
1.50 A
P. & B. Miller
2.09 A.
253-265
1.45 A
629-440
J. & M. McDougall
435-350
3
181.30 A
B&O Railroad
Grandview Golf Club, Inc.
DURKEE ROAD
BURTON TWP.
HUNTSBURG TOWNSHIP
N
SCALE 1" = 300'
JAN. 1, 193
A B C D
E F G H
I J K L
M N O P

✱ Inadequate description

JANUARY 1, 1989

RELATIVE REPRESENTATION

CLARIDON TWP.

CLARIDON TP.

[CENTER]

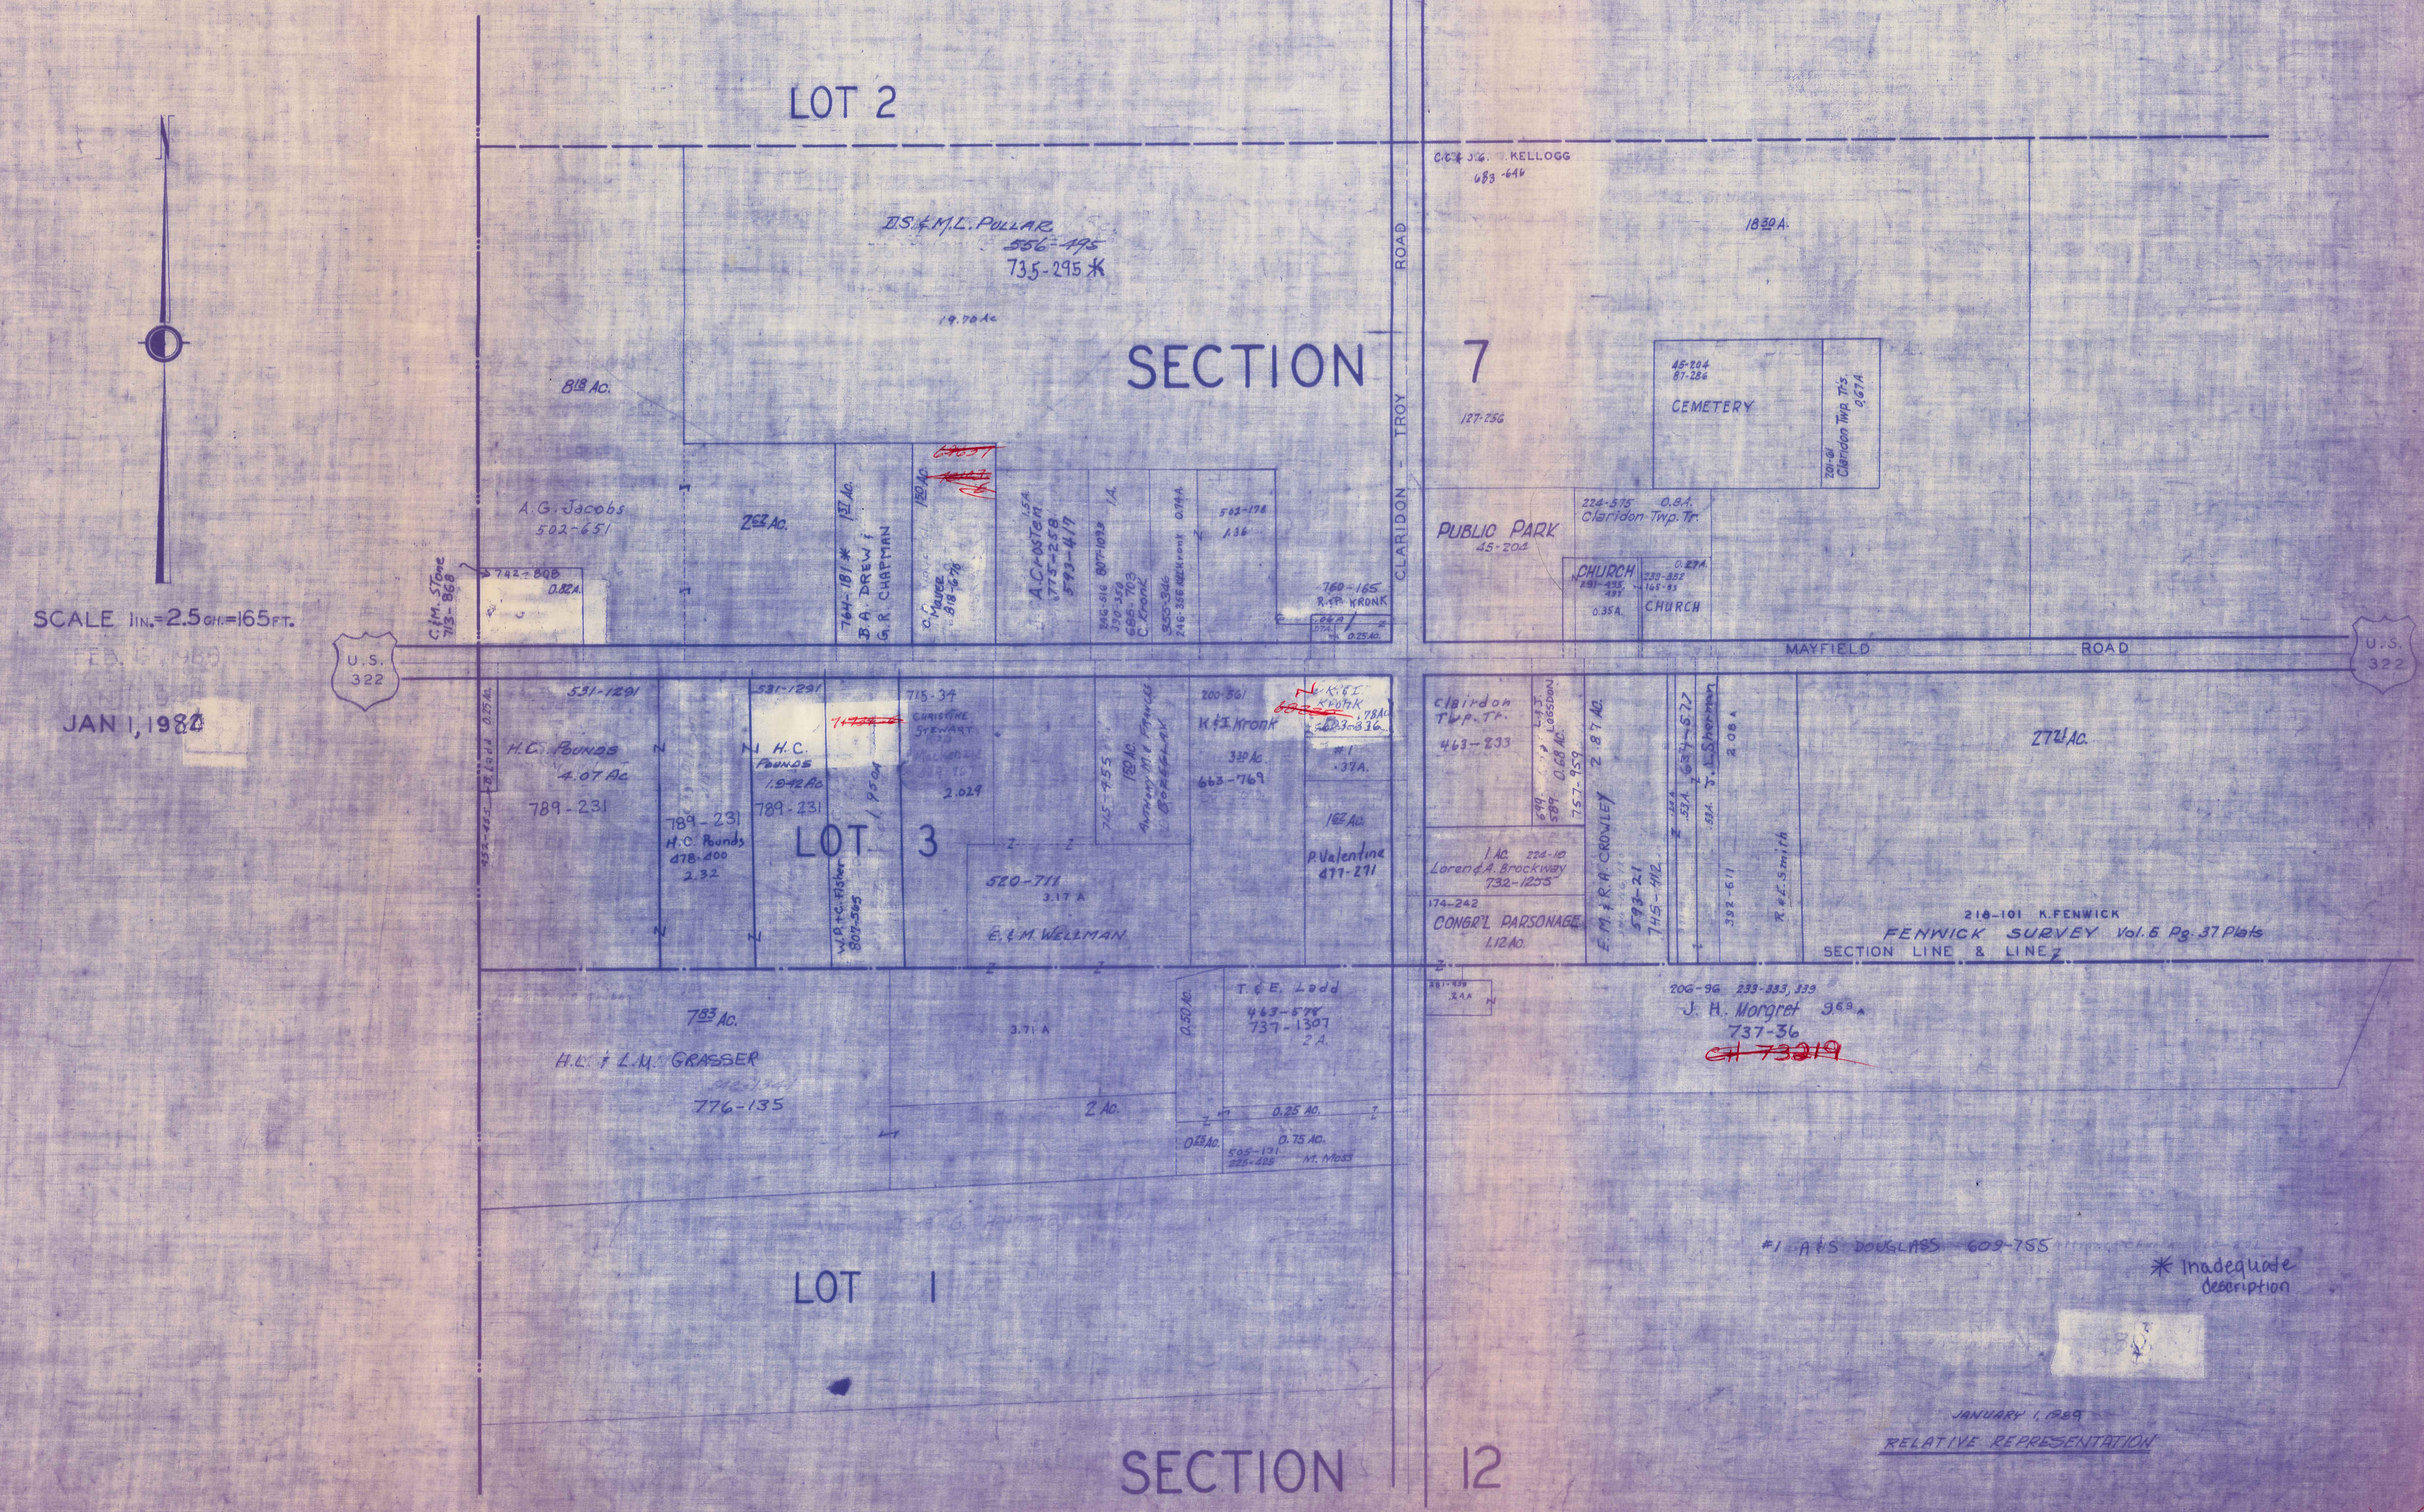
N
SCALE 1IN.=2.5CH.=165FT.
FEB. 6, 1969
JAN 1, 1984
LOT 2
D.S. & M.L. PULLAR
556-495
735-295 *
19.70 Ac.
8.18 Ac.
SECTION 7
A.G. Jacobs
502-651
C. & M. STone
713-868
742-808
0.82A.
2.62 Ac.
764-181 * 1.37 Ac.
B.A. DREW &
G.R. CHAPMAN
1.50 Ac.
C. Mauer
818-676
1.5A
A.C. Oster
775-258
593-417
246-516 807-1093 1A.
390-350
685-703
C. Kronk
355-346
246-356 K&I Kronk 0.74A.
502-178
1.36
760-165
R. & P. KRONK
.06A
.07A
0.25 AC.
CLARIDON - TROY ROAD
C.C. & J.G. KELLOGG
683-646
18.30 A.
127-256
45-204
87-286
CEMETERY
201-61
Claridon Twp. Trs.
0.67A
PUBLIC PARK
45-204
224-575 0.8A.
Claridon Twp. Tr.
CHURCH
291-435, 437
0.35A.
0.27A.
233-352
165-93
CHURCH
MAYFIELD ROAD
U.S. 322
U.S. 322
531-1291
H.C. POUNDS
4.07 Ac
789-231
452-455
B. Ladd 0.25 Ac.
531-1291
H.C.
POUNDS
1.942 Ac
789-231
789-231
H.C. Pounds
478-400
2.32
1.950 A
W.P. + C. Fisher
807-565
715-34
CHRISTINE
STEWART
2.029
LOT 3
715-455
1.50 Ac.
ANTHONY M. & FRANCES
BORSELAV
520-711
3.17 A
E. & M. WELLMAN
200-561
K & I Kronk
3.30 Ac.
663-769
K. & I.
KRONK
.78 Ac
663-336
#1
.37A.
1.62 Ac.
P. Valentine
477-271
Claridon
Twp. Tr.
463-233
L. & J.
LOGSDON
0.68 AC.
757-959
E.M. & R.A. CROWLEY 2.87 AC.
593-21
745-412
.53A. 634-577
J. L. Sherman
2.08 A
392-611
R. & E. Smith
27.21 AC.
1 AC. 224-10
Loren & A. Brockway
732-1255
174-242
CONGR'L PARSONAGE
1.12 AC.
218-101 K.FENWICK
FENWICK SURVEY Vol. 6 Pg. 37 Plats
SECTION LINE & LINE
281-439
.24A
206-96 233-333, 339
J. H. Morgret 9.69 A
737-36
~~GH 73219~~
7.83 AC.
H.L. & L.M. GRASSER
776-135
3.71 A
2 AC.
0.50 AC.
T. & E. Ladd
463-578
737-1307
2 A.
0.25 AC.
0.25 AC.
0.75 AC.
505-131
225-425
M. Moss
LOT 1
#1 A & S DOUGLASS 609-755
* Inadequate description
JANUARY 1, 1989
RELATIVE REPRESENTATION
SECTION 12

6-Q

EAST CLARIDON
AND VICINITY

CLARIDON TP.

EAST CLARIDON
AND VICINITY

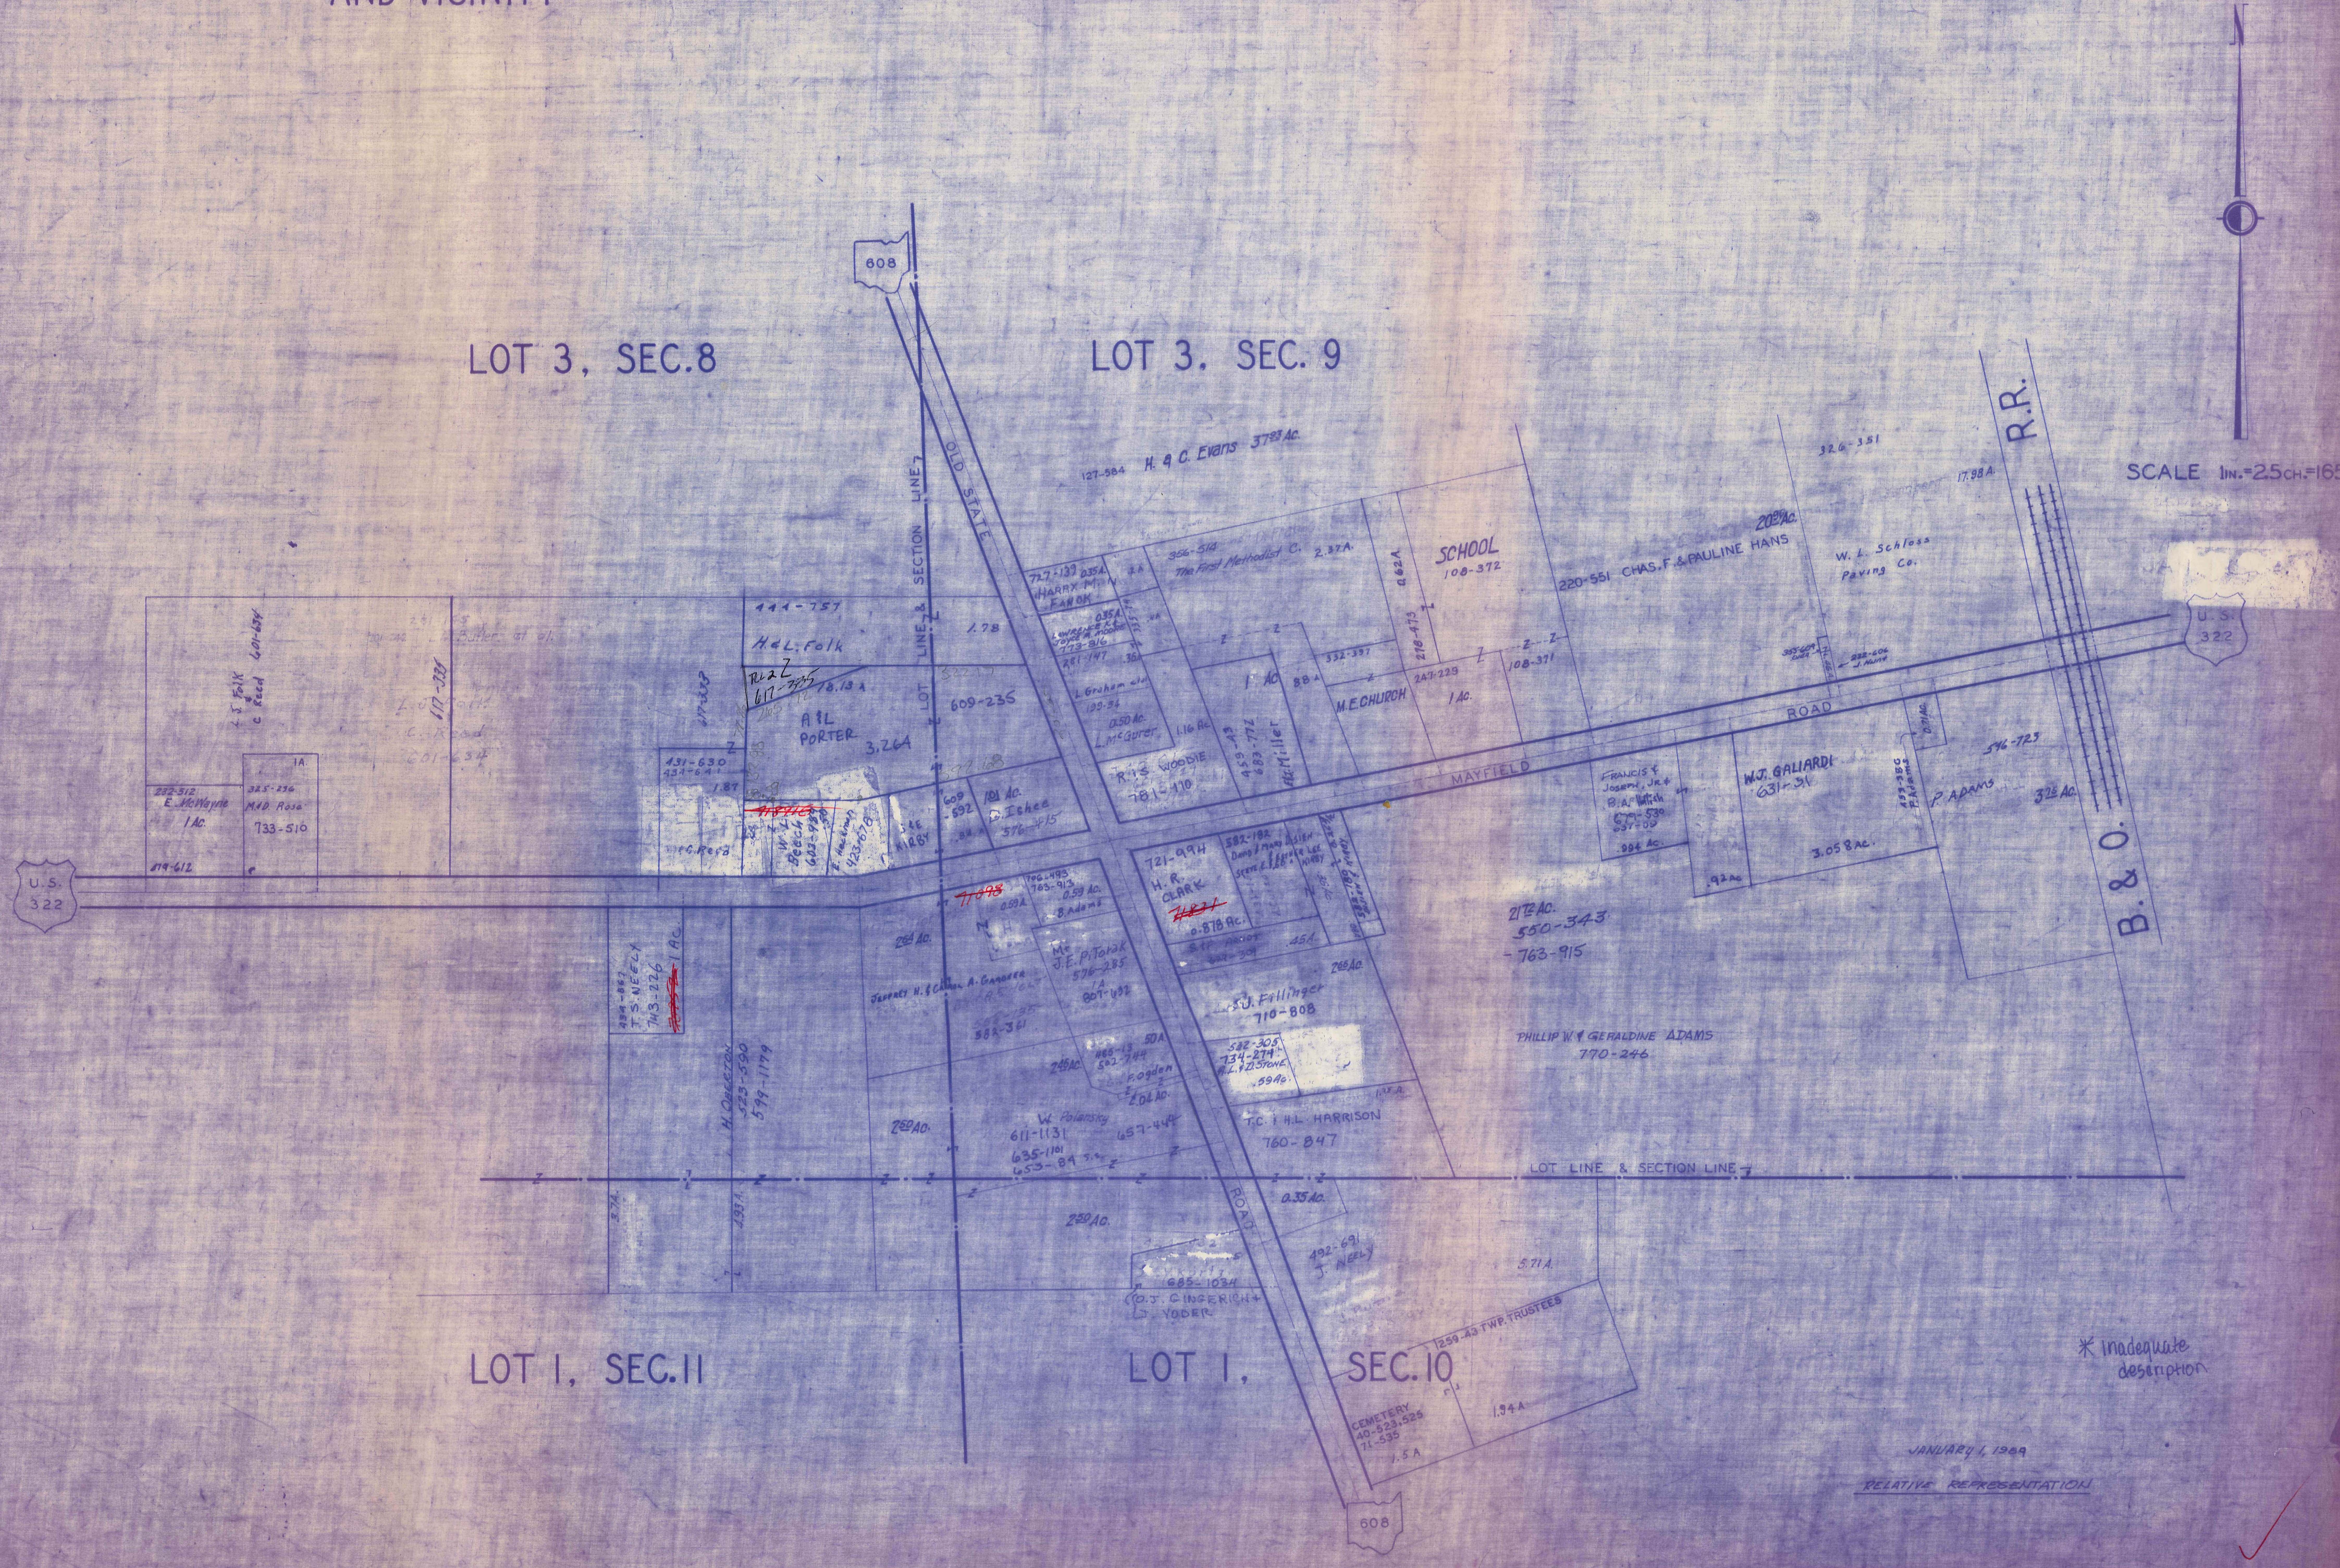
LOT 3, SEC. 8
LOT 3. SEC. 9
LOT 1, SEC. 11
LOT 1, SEC. 10
608
OLD STATE
ROAD
LOT LINE & SECTION LINE
LOT LINE & SECTION LINE
MAYFIELD
ROAD
U.S. 322
U.S. 322
R.R.
B. & O.
SCALE 1 IN.=2.5 CH.=165'
127-584 H. & C. Evans 37.83 Ac.
727-139 .035A. HARRY M. FANOK
356-514 The First Methodist C. 2.37 A.
.2A
.035A. LAWRENCE & JOYCE M. MOORE 773-816
335-74
281-147 .36A
L. Graham et al 199-34
0.50 Ac. L. McGurer
1.16 Ac.
R. & S. WOODIE 781-110
459-43 683-772
Fk. Miller
1 Ac
.88 A
332-397
M.E. CHURCH
247-229 1 Ac.
.62A
278-473
SCHOOL 108-372
108-371
220-551 CHAS. F. & PAULINE HANS 20.99 Ac.
326-351
W. L. Schloss Paving Co.
17.98 A.
355-609
222-606 J. Hunt
0.71 Ac.
FRANCIS & JOSEPH, JR. & B.A. Hittish 679-530 637-09 .994 Ac.
.92 Ac
W.J. GALIARDI 631-31
3.058 Ac.
453-386 P. Adams
P. ADAMS 546-723
3.75 Ac.
21.72 Ac. 550-343 763-915
PHILLIP W. & GERALDINE ADAMS 770-246
444-757
H. & L. Folk
617-335 78.13 A
A & L PORTER 3.26A
1.78
609-235
431-630 431-641 1.87
C. Reed
W. L. Beech 603-987
E. Hackman 423-678
S. & E. KIRBY
609-592 .84 A
1.01 Ac. D. Ishee 576-415
721-994 H.R. CLARK 0.878 Ac.
582-182 David & Mary Dsien
Steve C. & Esther Lee Kirby .66 A
.36 Ac
582-180 Bajuem & Handy
S & P Arnot 622-309
.45A.
706-493 763-913 0.59 Ac. B. Adams
0.59A.
2.64 Ac.
M & J.E. PiTorak 576-285
1A 807-632
JEFFREY H. & CAROL A. GARDNER
582-361
2.65 Ac.
J. Fillinger 710-808
.50A.
485-13 502-744
F. Ogden
2.04 Ac.
582-305 734-274 A.L. & D. STONE .59 Ac.
1.25 A.
2.46 Ac.
W. Polansky 611-1131 635-1101 653-84
657-444
T.C. & H.L. HARRISON 760-847
2.50 Ac.
2.50 Ac.
0.35 Ac.
685-1034
O.J. GINGERICH & J. YODER
492-691 J. NEELY
5.71 A.
259-43 TWP. TRUSTEES
CEMETERY 40-523, 525 71-535
1.5 A
1.94 A
232-512 E. McWayne 1 Ac.
279-612
325-296 M. & D. Rose 733-510
1A.
L. S. Folk & C. Reed 601-634
617-335
434-867 T.S. NEELY 743-226
1 AC.
H. OBERTON 523-590 599-1179
3.7A.
4.93A.

*inadequate description

JANUARY 1, 1969

RELATIVE REPRESENTATION

6-R

SCALE 1 IN.=30 FT.
COUNTY AQUILLA HOME ROAD
60'
TURNER DRIVE 40'
GOREDON DRIVE 40'
TURNER DRIVE
SEE 6-S-CTR.
486-851
284A
284 .179A.
283 .160 A.
282 .141 A.
G.V.&C.A. DUNLAP 746-881
281 .123A.
280 .115 A.
279 M. DORKA 635-1247 .133 A.
273A 454-12
274 .174A.
275 N.&W. Nickita
276
277 G.V.&C.A. DUNLAP 746-881
278 .103A.
.121A.
.133A.
818-388
451-768 N.&W. Nickita
.173A. 273
272A L.W.BAUMAN 226-360
.126A.
I.C. BAUMAN 701-969
272
271A R.&R. PRUSHA 709-1015
.111 A.
R.&R. PRUSHA 709-1021
271
270A .100A.
709-1017
270
269A .100 A.
Joe and Linda Nelson 729-338
269
268A .100 A.
558-751
268
267A .101 A.
513-254 C.&E. TOROK
267
266A .101 A.
266
265A .101 A.
320-560 R.N.&J.E. EGING 744-439
265
264A .101 A.
744-439
744-439
264
263A .102 A.
R.&V. EGING 689-698
263
262A .103 A.
Ronnie and Jeannine EGING 731-1145
262
261A .051 A.
.051 A.
261
260A .104 A.
735-206 T.L.&J.E. RAY 637-736
260
259A .104 A.
409-439 K.&M. Sweet
259
R&M Davis 629-1266
146 .107A.
145 .108A.
144 .100A.
147 .073A.
.073A.
D. Grossman 574-448
148 .077A.
.077A.
149 .082A.
.082A.
T.R.&V.L. NELSON 685-1193
150 .086A.
.086A.
151 .091 A.
.091 A.
553-919 F.T. PIETROCINI & C.B. ANDREW
152 .095 A.
.095 A.
692-611
153 .098 A.
.101 A.
P.T. YODER 692-611
154 .099 A.
.106 A.
F.&E. KATAI 688-721
155 .100 A.
.111 A.
156 .102A.
-.02907
0.07293A
.02907 Ac.
.114A.
157 208-537 W. HENDERSHOT 576-1025
.103 A.
.116 A.
158 199-625 576-1025
.105 A.
.117 A.
143
142
141
140
J+L. Grey
821-718
485-102
139
821-718
138
516-559 R.A.&E.B. GRANT
137
136 R.A. GRANT 688-723
135 J.L.&S.J. ABE 688-725
134 T.&C. SKUBE 592-397
133 J.L. ABE & S.J. FIELITZ 621-54
132 D. Hendershot 311-246 576-1025
7 423-951
6 D.&B. ROBERTS 784-954 .109 A.
5 .109 A.
4 F.J.&E. FILLA 721-773 .109 A.
3 721-773 .109 A.
2 665-1307 .109 A.
1 .109A.
8
D.&B. Roberts 509-372 784-956
9
10
11 721-773 .109A.
12 721-773 .109A.
13 .109 A.
14 .109 A.
589-106 GARY RICHARD & DIANA LYNN HILBERER
18 .143 A.
19 .125 A.
818-242
17 .099 A.
R+R Prosen 818-242
16 .103 A.
15 270-461 AQUILLA VILLAGE .107A.
208-312
818-242
20
21 .158 A.
RONALD W.&RAY M. SWARTZ 767-721
22 .074 A.
.074A.
23 .140A.
ED&MARY GRANT 678-119
24 .132 A.
R.E.&R. GRANT 671-220
25 .123 A.
26 .115 A.
L. PROVO, ET AL 196-6
27 .107 A.
553-1157 671-220 R.E.&R. GRANT
28 .101 A.
29 .097 A.
362-323 G.&M. Willcox
30 .094 A.
31 .091 A.

LAKE AQUILLA SUBDIVISION NO.1 & LAKE AQUILLA SUBDIVISION NO.1 ADDITION
VOL.1 PGS 50 & 51 REC OF PLATS VOL.4 PGS 23 & 24 REC OF PLATS

NOW AQUILLA VILLAGE VOL. 4 PAGES 26-27 REC. OF PLATS

JANUARY 1, 1989 RELATIVE REPRESENTATION

* Inadequate description

6-S WEST

For Lake Aquilla Addresses See p. 6-S west

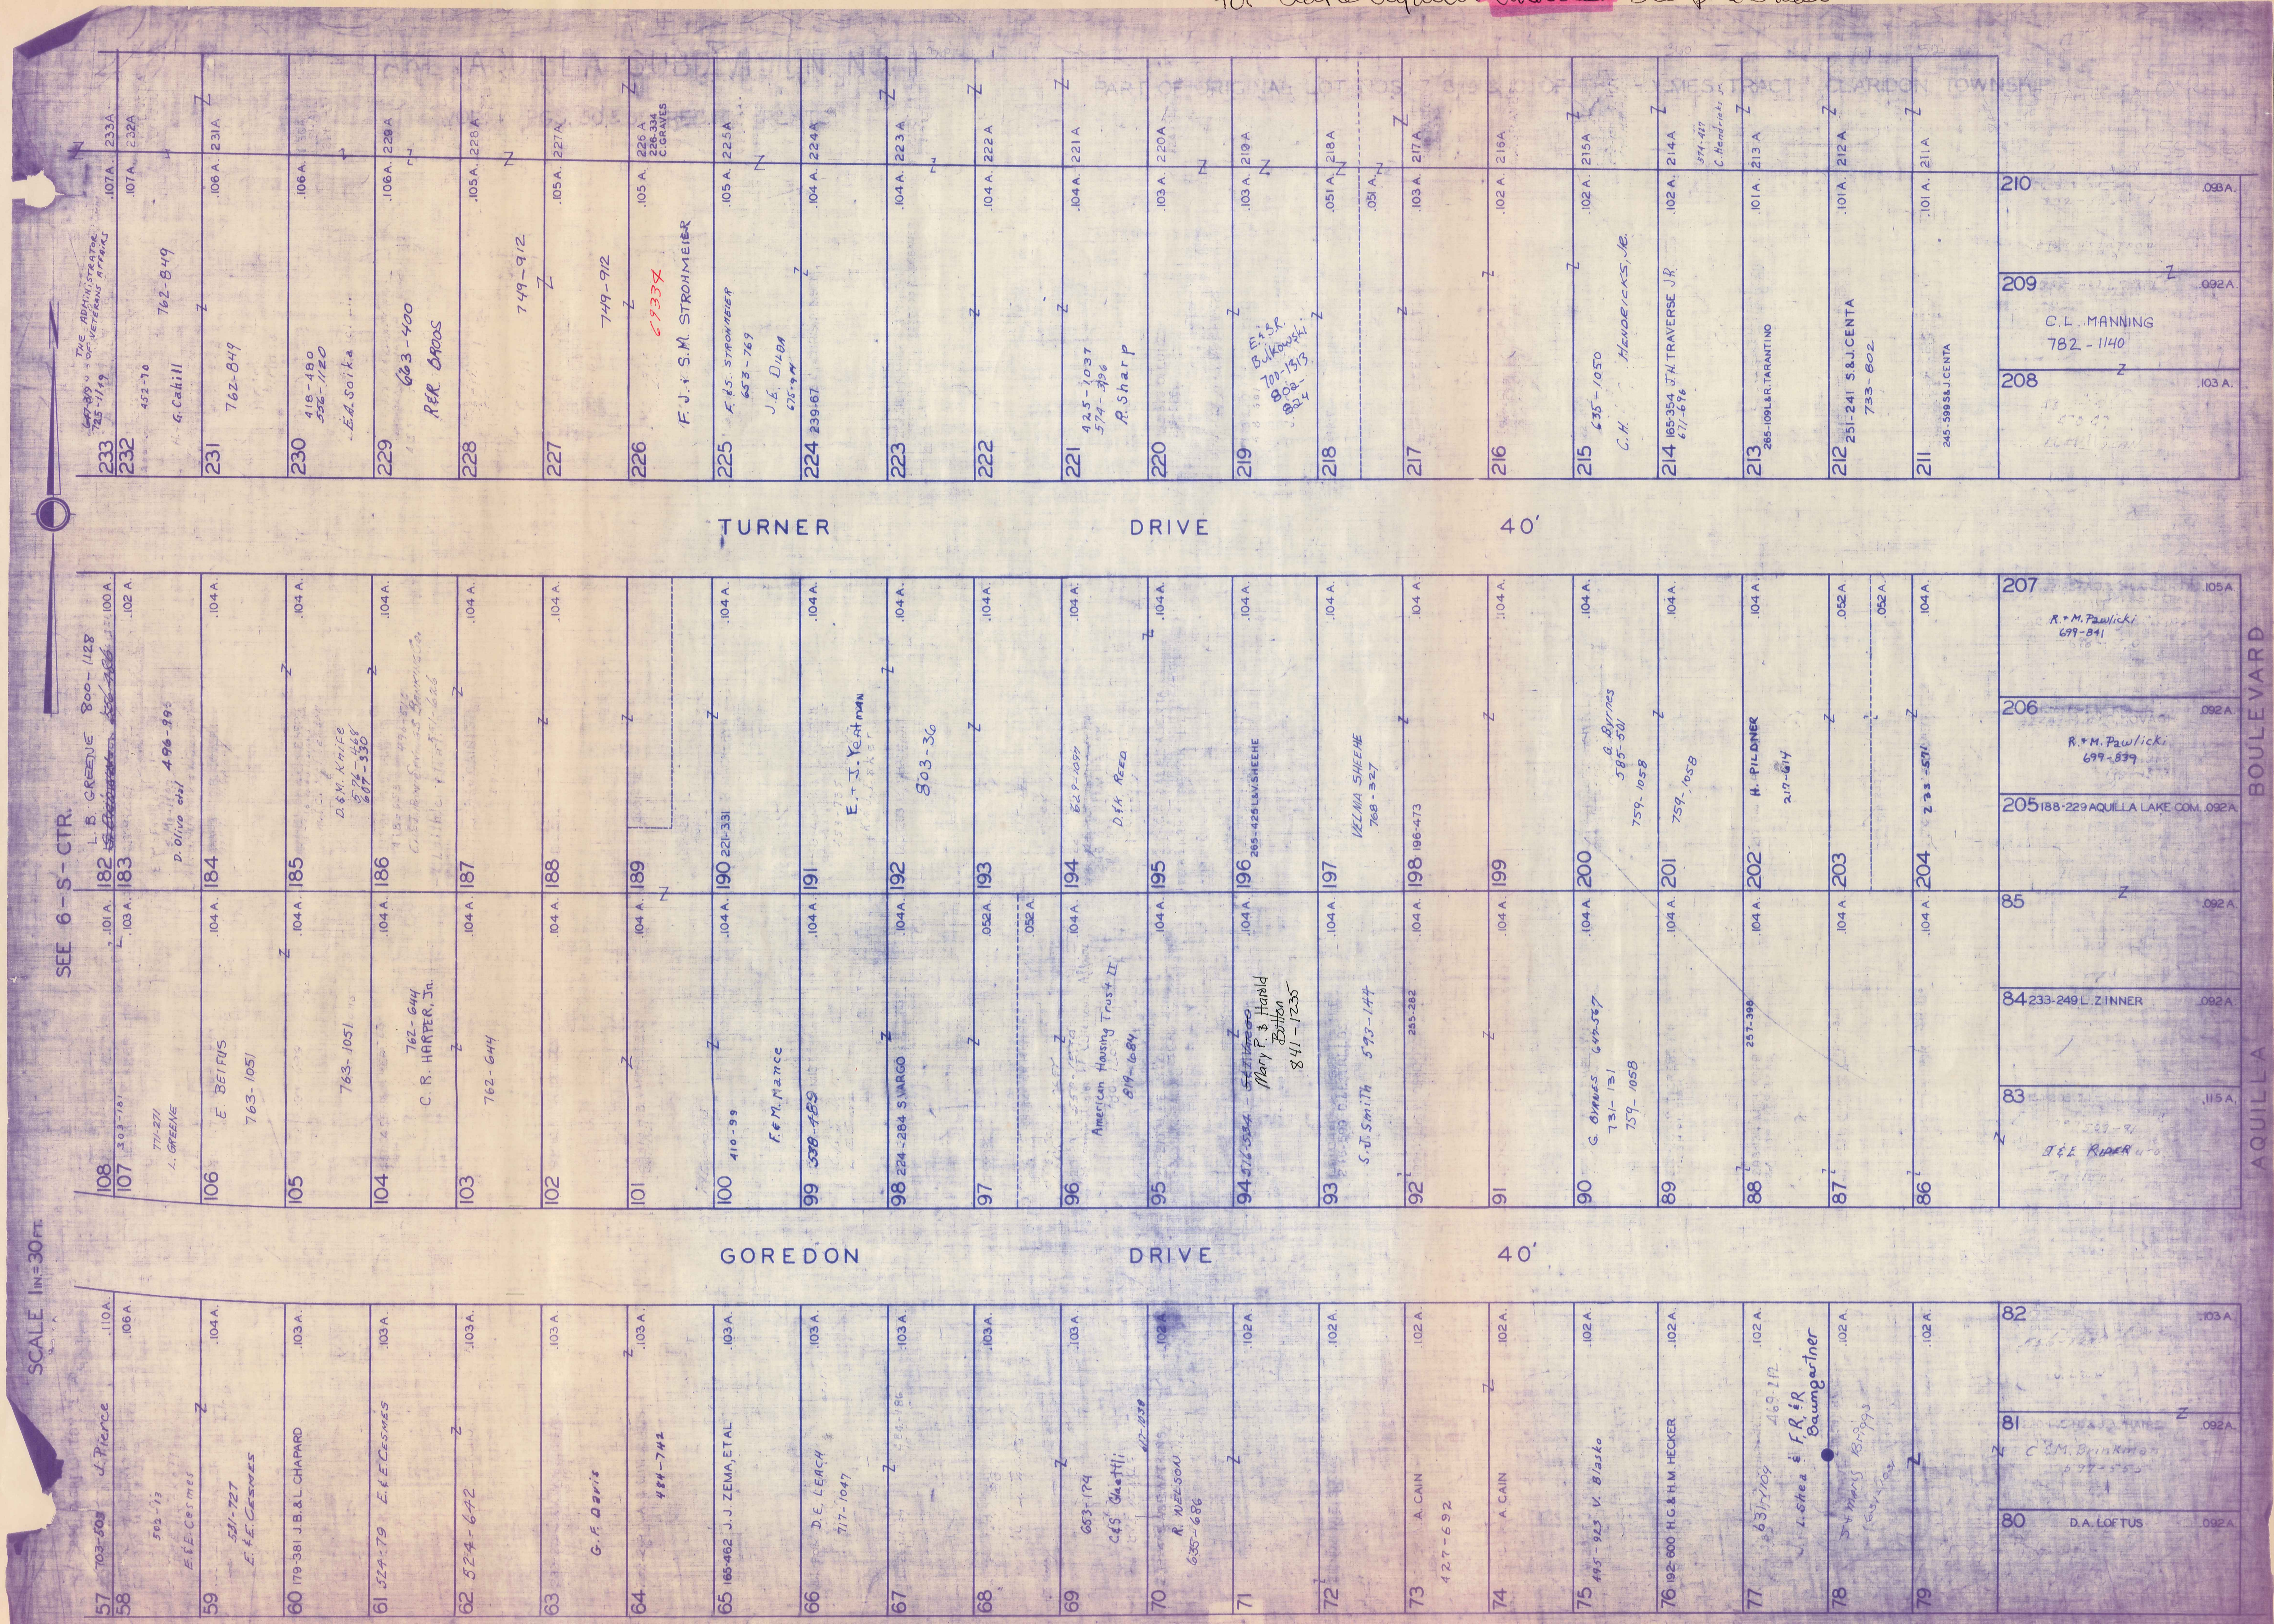

PART OF ORIGINAL LOT NOS. 7, 8, 9 & 10 OF THE HOLMES TRACT CLARIDON TOWNSHIP
TURNER DRIVE 40'
GOREDON DRIVE 40'
AQUILLA BOULEVARD
SEE 6-S-CTR.
SCALE 1 IN.=30 FT.
233 THE ADMINISTRATOR OF VETERANS AFFAIRS 725-1149
232 G. Cahill 762-849
231 762-849
230 E.A. Soika 418-480 556-1120
229 623-400 RER BROS
228 749-912
227 749-912
226 F.J. & S.M. STROHMEIER C7334
225 F & S. STROHMEIER 653-769
224 J.E. DUDA 675-94
221 R. Sharp 425-1037 574-396
219 E&B.R. Bulkowski 700-1513 802-824
215 C.H. HENDRICKS, Jr. 635-1050
214 J.H. TRAVERSE JR. 185-354 671-696
213 L. TARANTINO 285-1091
212 S.&J. CENTA 251-241 733-802
211 S.&J. CENTA 245-399
210 .093 A.
209 .092 A. C.L. MANNING 782-1140
208 .103 A.
207 .105 A. R.+M. Pawlicki 699-841
206 .092 A. R.+M. Pawlicki 699-839
205 188-229 AQUILLA LAKE COM. .092 A.
182 L.B. GREENE 800-1128
183 D. Olivo etal 496-990
185 D.&M. KNIFE 574-366 607-330
190 221-331
191 E.+J. YEATMAN
192 803-36
194 D.&K. REED
196 285-425 L.&V. SHEEHE
197 VELMA SHEEHE 768-327
198 196-473
200 G. Byrnes 585-521 759-1058
201 759-1058
202 H. PILDNER 217-614
204 223-591
85 .092 A.
84 233-249 L. ZINNER .092 A.
83 .115 A. J.&E. RIDER
107 L. GREENE 771-271
106 E. BEIFUS 763-1051
105 763-1051
104 C.R. HARPER, Jr. 762-644
103 762-644
100 F. & M. MANCE 410-99
99 338-489
98 224-284 S. VARGO
96 American Housing Trust II 814-684
94 Mary P. & Harold Bolton 841-1235
93 S.J. Smith 593-144
92 235-282
90 G. Byrnes 644-567 731-131 759-1058
88 257-398
82 .103 A.
81 .092 A. C.&M. Brinkman
80 D.A. LOFTUS .092 A.
57 J. Pierce 703-808
58 E.&E. Cesmes
59 E.&E. Cesmes 521-727
60 179-381 J.B.&L. CHAPARD
61 524-79 E.&E. Cesmes
62 524-642
63 G.F. Davis
64 484-742
65 165-462 J.J. ZEMA, ETAL
66 D.E. LEACH 717-1047
69 653-174 C.&S. Gastelli
70 R. NELSON 635-686
73 A. CAIN 427-692
74 A. CAIN
75 495-923 V. Blasko
76 192-600 H.C.&H.M. HECKER
77 831-109
78 F.R.&R. Baumgartner

LAKE AQUILLA SUBDIVISION NO. 1 & LAKE AQUILLA SUBDIVISION NO. 1 ADDITION
VOL. 1 PGS 50 & 51 REC OF PLATS VOL. 4 PGS 23 & 24 REC OF PLATS

NOW AQUILLA VILLAGE VOL. 4 PAGES 26-27 REC. OF PLATS

JAN 1, 1989 RELATIVE REPRESENTATION * Inadequate description

For addresses see 6-S west

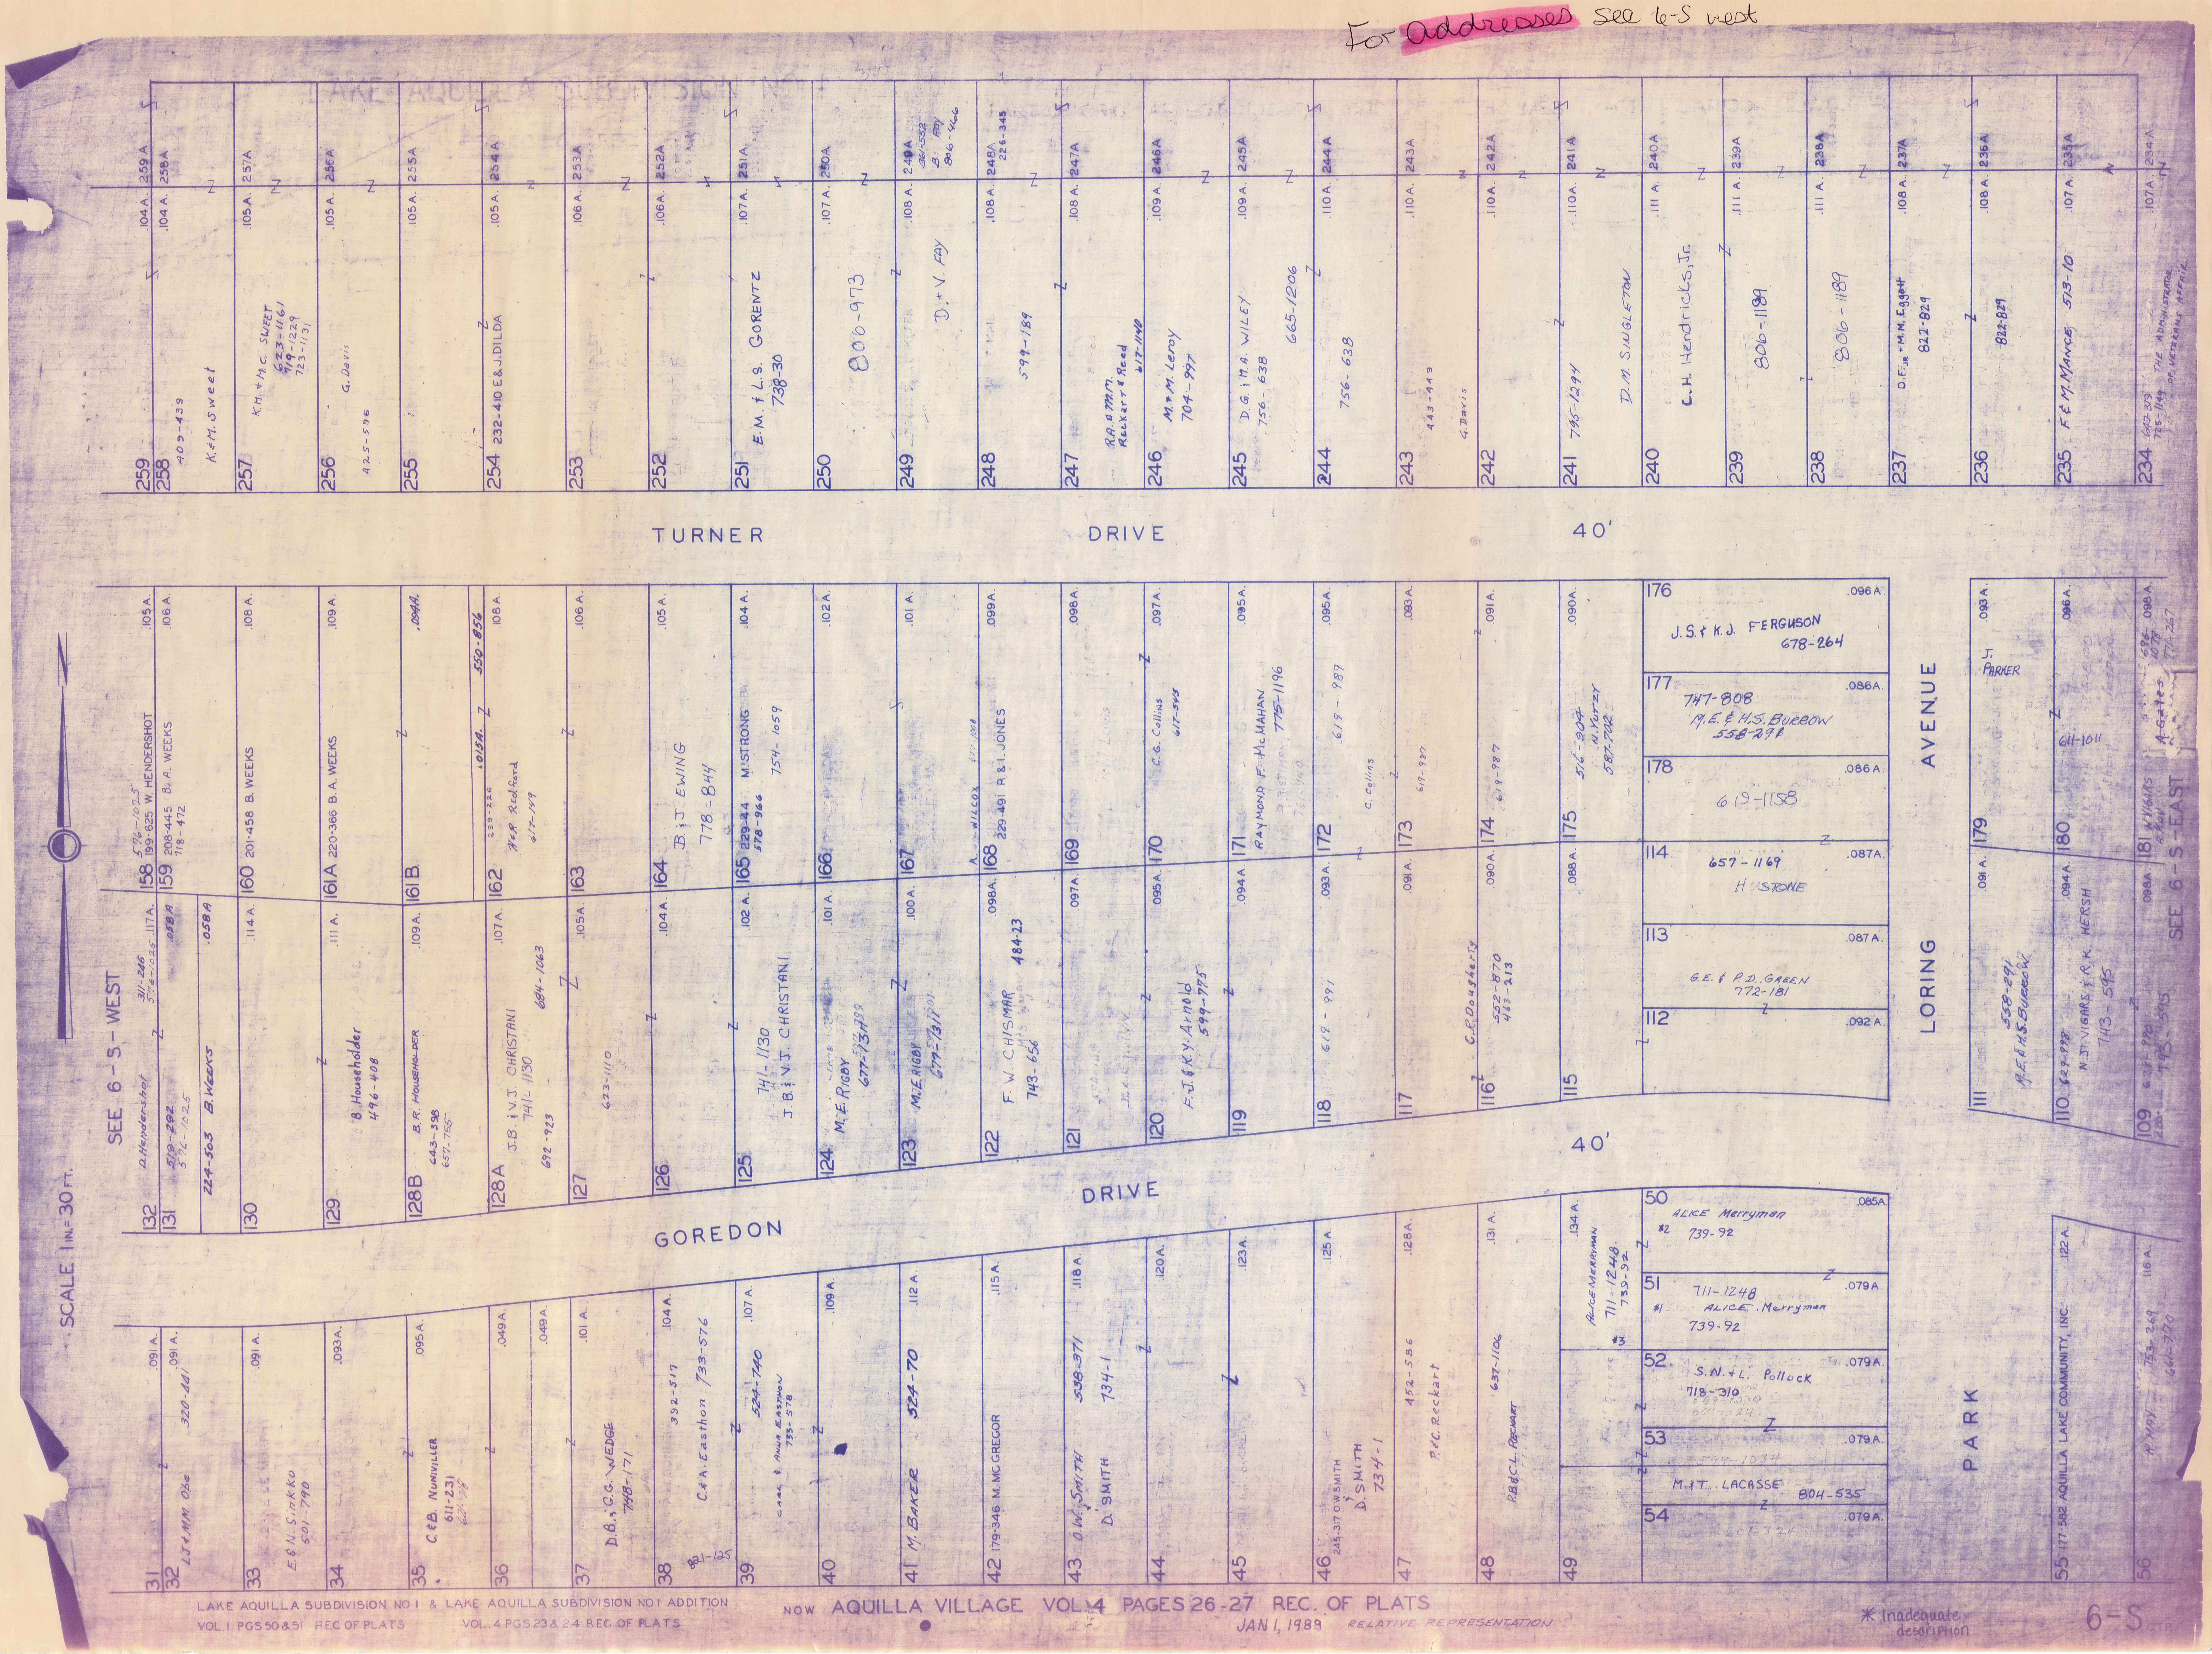
TURNER DRIVE
GOREDON DRIVE
LORING AVENUE
PARK
40'
40'
SEE 6-S-WEST
SEE 6-S-EAST
SCALE 1 IN.= 30 FT.
K.&M. Sweet
K.M. & M.C. SWEET
G. Davis
232-410 E.&J. DILDA
E.M. & L.S. GORENTZ 738-30
806-973
D. & V. Fay
R.A. & M.M. Reckart & Reed
M. & M. Leroy 704-997
D.G. & M.A. WILEY 756-638
665-1206
756-638
D.M. SINGLETON
C.H. Hendricks, Jr.
806-1189
806-1189
D.F. Jr. & M.M. Eggert 822-829
822-829
F. & M. Mance 573-10
J.S. & K.J. FERGUSON 678-264
M.E. & H.S. BURROW 558-296
619-1158
657-1169
G.E. & P.D. GREEN 772-181
J. PARKER
199-625 W. HENDERSHOT
208-445 B.A. WEEKS
201-458 B. WEEKS
220-366 B.A. WEEKS
B. & J. EWING 778-844
M. STRONG 754-1059
R. & I. JONES
C.G. Collins
RAYMOND F. McMAHAN 775-1196
C. Collins
N. YOTZY 587-742
D. Hendershot
224-503 B. WEEKS
B. Householder 496-408
B.R. Householder
J.B. & V.J. CHRISTIANI 741-1130
741-1130 J.B. & V.J. CHRISTIANI
M.E. RIGBY
F.W. CHISMAR 484-23 743-656
F.J. & K.Y. Arnold 599-775
C.E. Dougherty
M.E. & H.S. BURROW
N.J. VIGARS & R.K. HERSH 743-595
ALICE Merryman 739-92
711-1248
S.N. & L. Pollock 718-310
M. & T. LACASSE 804-535
L.J. & M.M. Obe 320-881
E.&N. Sinkko 521-790
C.&B. Nunviller 611-231
D.B. & G.G. WEDGE 748-171
C.&A. Easthon 733-576
M. BAKER 524-70
179-346 M. MC GREGOR
D.W. SMITH 538-371
D. SMITH 734-1
245-317 D.W. SMITH
P.&C. Reckart
R.B.&C.L. Reckart
177-582 AQUILLA LAKE COMMUNITY, INC.

LAKE AQUILLA SUBDIVISION NO I & LAKE AQUILLA SUBDIVISION NO I ADDITION
VOL. I PGS 50 & 51 REC OF PLATS   VOL. 4 PGS 23 & 24 REC OF PLATS

NOW AQUILLA VILLAGE VOL 4 PAGES 26-27 REC. OF PLATS
JAN 1, 1989   RELATIVE REPRESENTATION

* Inadequate description

6-S

AQUILLA VILLAGE VOL. 4, PAGES 26-27 REC. OF PLATS
FORMERLY
LAKE AQUILLA ESTATES COMPANY'S SUBDIVISION NO. 1

AND RESUBDIVISION OF BLOCKS I & J AND SUBLOTS
NOS. 125 TO 141 INCLUSIVE IN BLOCK D

VOL. 2 PAGES 6, 7, 8, 9, 10, 11, 12, 19 & 33 REC. OF PLATS

SCALE 1 INCH = 40 FEET

JAN. 1, 1989

RELATIVE REPRESENTATION

PART OF ORIGINAL LOT NOS. 9 & 10 OF THE HOLMES TRACT CLARIDON TOWNSHIP

For addresses see pg. 6-5 west

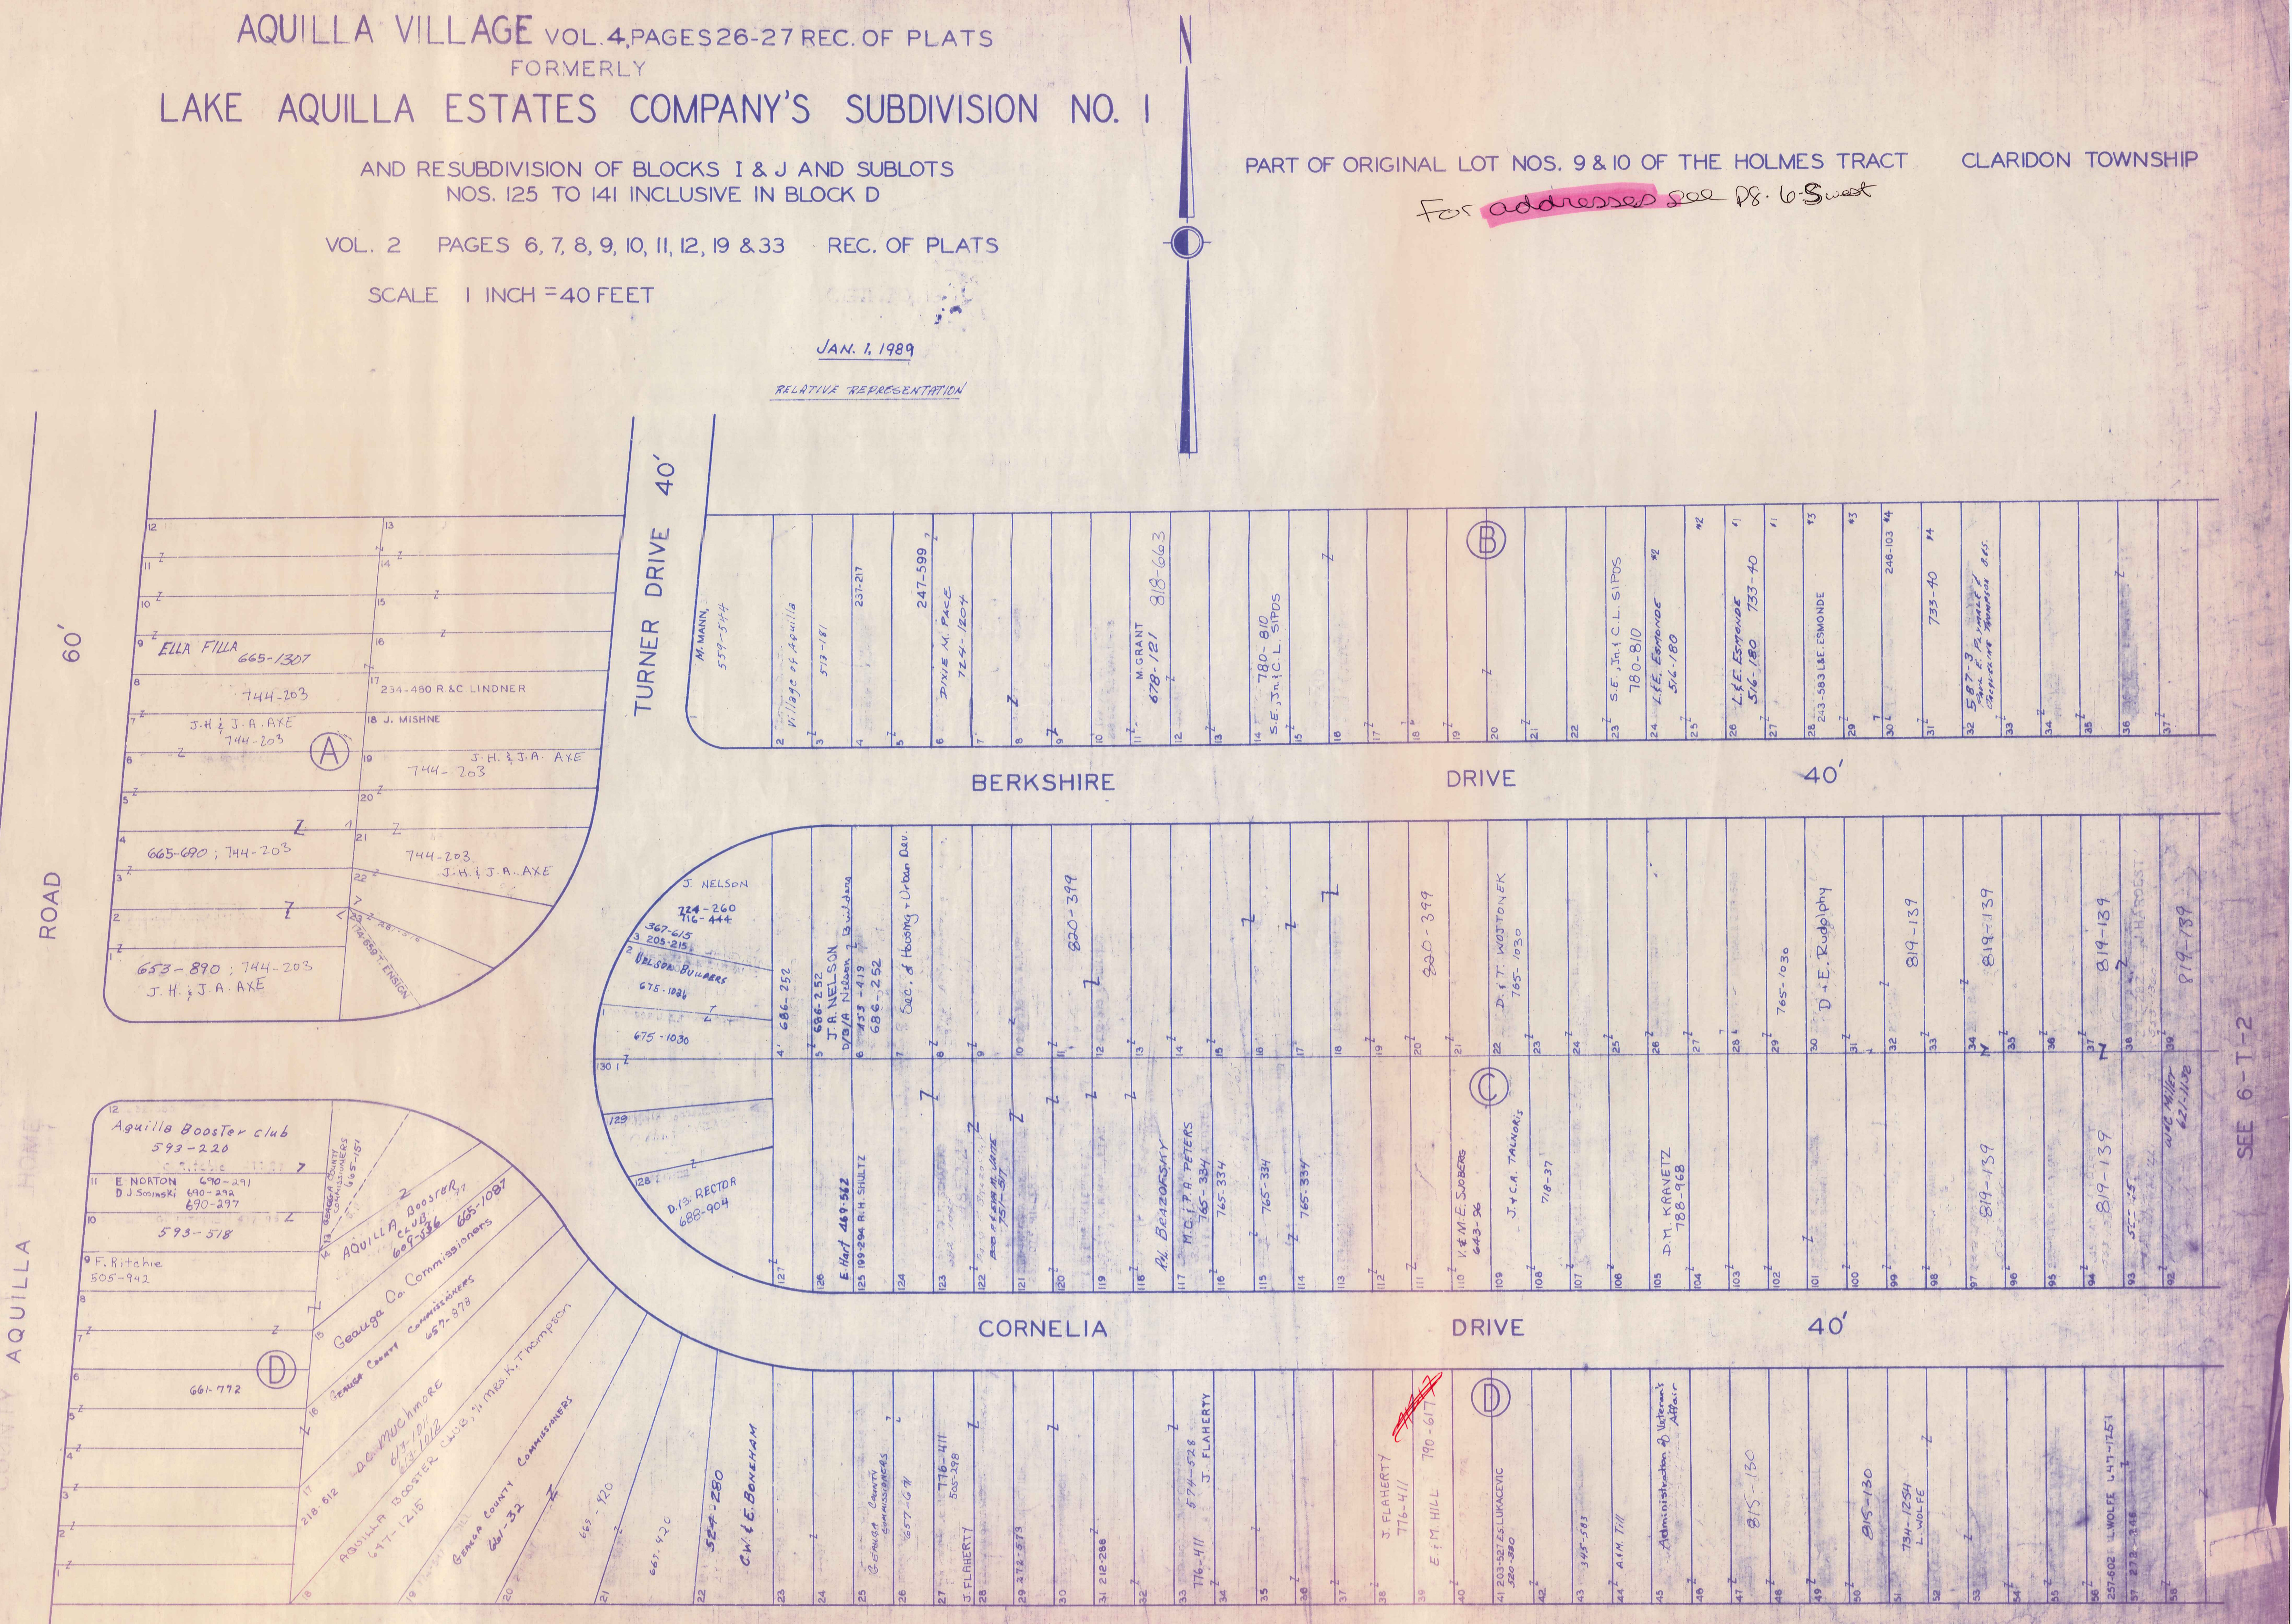
N
COUNTY HOME
AQUILLA ROAD
60'
TURNER DRIVE 40'
BERKSHIRE DRIVE 40'
CORNELIA DRIVE 40'
SEE 6-T-2
A
B
C
D
D
ELLA FILLA 665-1307
744-203
J.H. & J.A. AXE 744-203
665-690 ; 744-203
653-890 ; 744-203 J.H. & J.A. AXE
234-480 R.&C. LINDNER
18 J. MISHNE
J.H. & J.A. AXE 744-203
744-203 J.H. & J.A. AXE
287-516
174-659 T. ENSIGN
M. MANN, 559-544
Village of Aquilla
513-181
237-217
247-599
DIXIE M. PACE 724-1204
M. GRANT 678-121
818-663
780-810 S.E., Jr. & C.L. SIPOS
S.E., Jr. & C.L. SIPOS 780-810
L.&E. ESMONDE 516-180
L.&E. ESMONDE 516-180 733-40
243-583 L.&E. ESMONDE
246-103
733-40
587-3 Paul E. Plymale & Jacqueline Thompson
J. NELSON 724-260 716-444
367-615 205-215
NELSON BUILDERS 675-1026
675-1030
D.&B. RECTOR 688-904
686-252
686-252 J.A. NELSON D/B/A Nelson Builders
453-419 686-252
E. Hart 469-562
199-294 R.H. SHULTZ
Sec. of Housing + Urban Dev.
820-399
R.L. BRAZOFSKY
M.C. & P.A. PETERS 765-334
765-334
D. & T. WOJTONEK 765-1030
820-399
V. & M.E. SJOBERG 643-96
J. & C.A. TALNORIS
718-37
D.M. KRAVETZ 788-968
765-1030
D. & E. Rudolphy
819-139
J.H. FROST
W.&C. Miller 621-1150
Aquilla Booster club 593-220
E. NORTON 690-291
D.J. Sosinski 690-292 690-297
593-518
F. Ritchie 505-942
661-772
GEAUGA COUNTY COMMISSIONERS 665-151
AQUILLA BOOSTER CLUB 609-536
665-1087
Geauga Co. Commissioners
GEAUGA COUNTY COMMISSIONERS 657-878
D.C. MUCHMORE 613-1011 613-1012
218-612
AQUILLA BOOSTER CLUB, % MRS. K. THOMPSON 647-1215
GEAUGA COUNTY COMMISSIONERS 661-32
665-420
524-280
C.W. & E. BONEHAM
Geauga County Commissioners 657-671
776-411 505-298
J. FLAHERTY
272-573
212-288
574-528 J. FLAHERTY
776-411
J. FLAHERTY 776-411
E. & M. HILL 790-617
203-527 Z.S. LUKACEVIC 520-380
345-583
A.&M. Till
Administration of Veteran's Affair
815-130
734-1254 L. WOLFE
257-602 L. WOLFE 647-1251
273-246

* Inadequate description

AQUILLA VILLAGE VOL. 4, PAGES 26-27 REC. OF PLATS

FORMERLY

LAKE AQUILLA ESTATES COMPANY'S SUBDIVISION NO. 1

AND RESUBDIVISION OF BLOCKS I & J AND SUBLOTS
NOS. 125 TO 141 INCLUSIVE IN BLOCK D

VOL. 2 PAGES 6, 7, 8, 9, 10, 11, 12, 19 & 33 REC. OF PLATS

SCALE 1 INCH = 40 FEET

JAN. 1, 1989

RELATIVE REPRESENTATION

PART OF ORIGINAL LOT NOS. 9 & 10 OF THE HOLMES TRACT CLARIDON TOWNSHIP

For addresses see pg. 6-S west

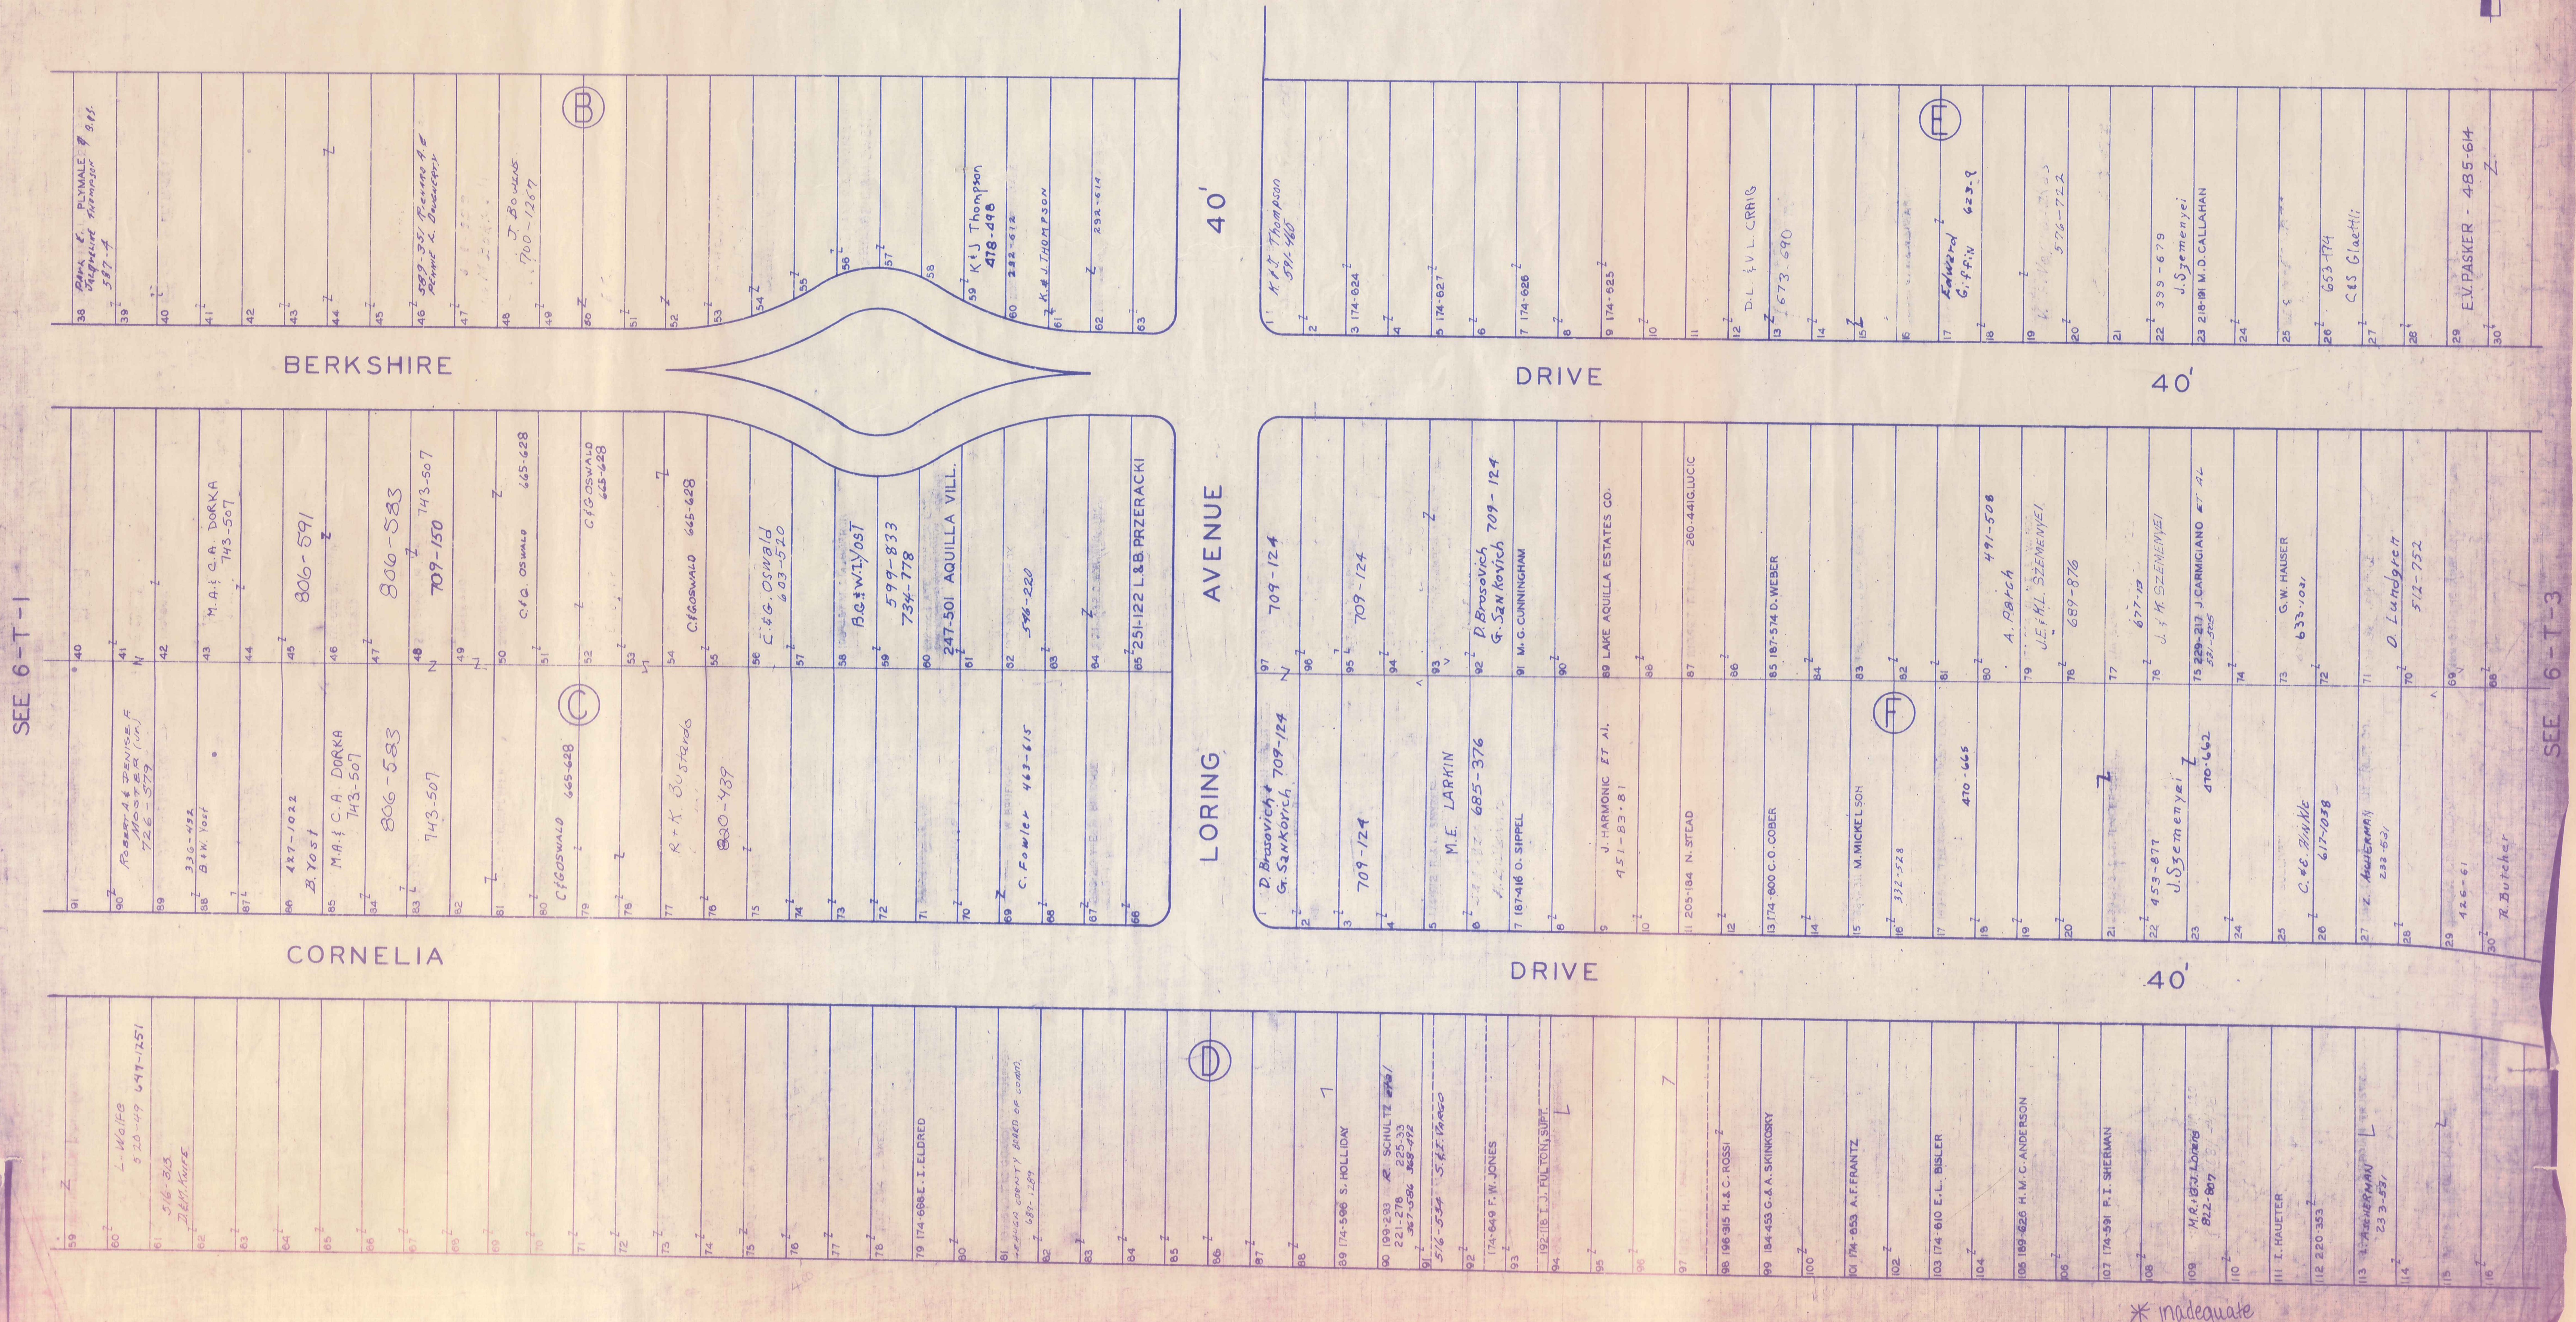
B
C
D
E
F
BERKSHIRE
DRIVE
40'
CORNELIA
DRIVE
40'
LORING AVENUE
40'
SEE 6-T-1
SEE 6-T-3
K. & J. Thompson 591-461
K. & J. Thompson 478-498
K. & J. THOMPSON
J. Bowers 700-1267
D.L. & V.L. CRAIG 673-690
Edward Griffin 623-8
J. Szemenyei
23 218-191 M.D. CALLAHAN
653-174 C&S Glaettli
E.V. PASKER 485-614
M.A. & C.A. DORKA 743-507
806-591
806-583
709-150
C & G OSWALD 665-628
C & G Oswald 603-520
B.C. & W.L. YOST 599-833 734-778
247-501 AQUILLA VILL.
576-220
251-122 L. & B. PRZERACKI
709-124
D. Brosovich G. Szankovich 709-124
M.G. CUNNINGHAM
LAKE AQUILLA ESTATES CO.
280-44 G. LUCIC
85 187-514 D. WEBER
A. Parch 491-508
J.E. & K.L. SZEMENYEI 689-876
J. & H. SZEMENYEI
J. CARMIGIANO ET AL
G.W. HAUSER 633-101
D. Lundgren 512-752
Robert A. & Denise F. Howe 726-579
B.&N. Yost
B. YOST
M.A. & C.A. DORKA 743-507
806-583
743-507
C & G OSWALD 665-628
R. & K. Bustardo
830-489
C. Fowler 463-615
M.E. LARKIN 685-376
187-416 O. SIPPEL
J. HARMONIC ET AL. 451-83-81
205-184 N. STEAD
174-600 C.O. COBER
M. MICKELSON
470-665
J. Szemenyei 453-877
C & E Winkle 617-1058
R. Butcher
L. Wolfe 530-49 649-1251
79 174-658 E. I. ELDRED
89 174-596 S. HOLLIDAY
R. SCHULTZ
S.A. Vargo
174-649 F.W. JONES
192-118 I.J. FOLTON, SUPT.
98 196-915 H. & C. ROSSI
99 184-433 G. & A. SKINKOSKY
101 174-653 A.F. FRANTZ
103 174-610 E.L. BISLER
105 189-626 H.M.C. ANDERSON
107 174-591 P.I. SHERMAN
M.R. & B.J. Lloyd 812-807
111 Z. HAUETER
112 220-353
Z. Auerman
Z

* inadequate description

6-T-2

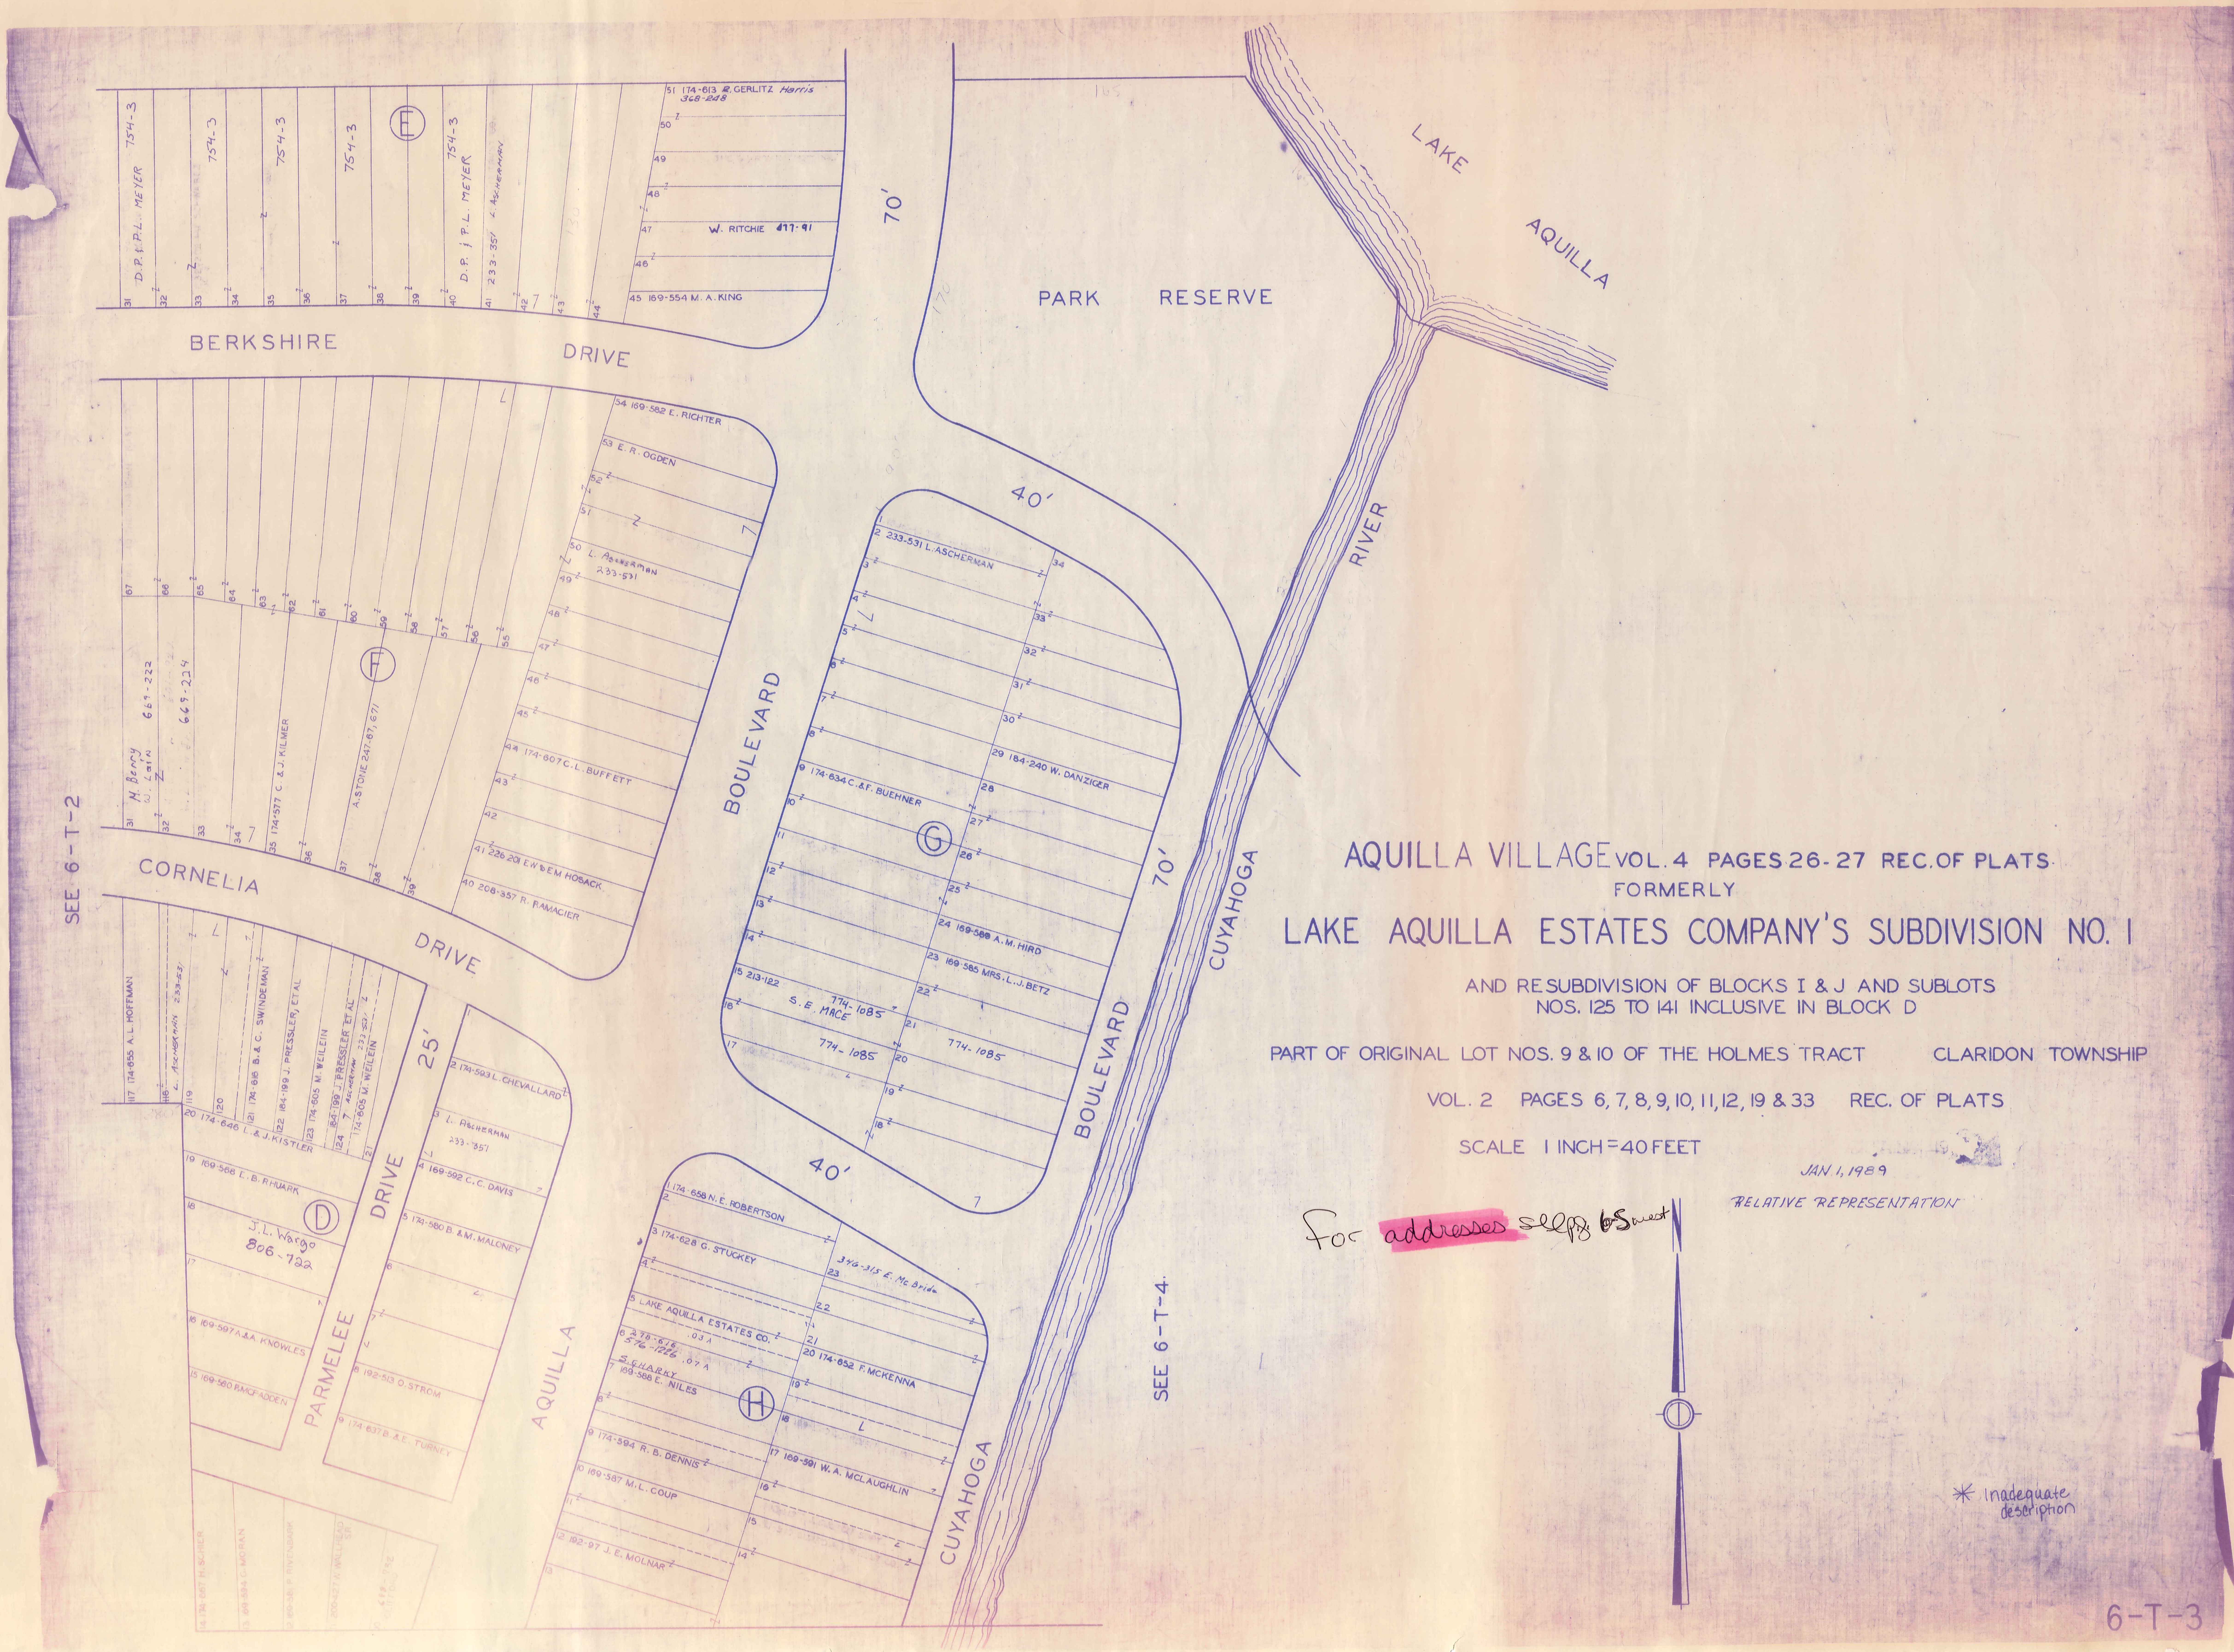

AQUILLA VILLAGE VOL. 4 PAGES 26-27 REC. OF PLATS

FORMERLY

LAKE AQUILLA ESTATES COMPANY'S SUBDIVISION NO. 1

AND RESUBDIVISION OF BLOCKS I & J AND SUBLOTS
NOS. 125 TO 141 INCLUSIVE IN BLOCK D

PART OF ORIGINAL LOT NOS. 9 & 10 OF THE HOLMES TRACT CLARIDON TOWNSHIP

VOL. 2 PAGES 6, 7, 8, 9, 10, 11, 12, 19 & 33 REC. OF PLATS

SCALE 1 INCH = 40 FEET

JAN. 1, 1989

RELATIVE REPRESENTATION

For addresses see pg. 6 South

* Inadequate description

BERKSHIRE DRIVE
CORNELIA DRIVE
PARMELEE DRIVE
AQUILLA
BOULEVARD
CUYAHOGA
CUYAHOGA RIVER
LAKE AQUILLA
PARK RESERVE
70'
40'
25'
SEE 6-T-2
SEE 6-T-4
E
F
G
D
H
D.P. & P.L. MEYER
754-3
51 174-613 R. GERLITZ Harris 368-248
W. RITCHIE 477-91
45 169-554 M.A. KING
54 169-582 E. RICHTER
53 E.R. OGDEN
50 L. Ascherman 233-531
44 174-607 C.L. BUFFETT
41 226-201 EW & EM HOBACK
40 208-357 R. RAMACIER
H. Berry
W. Lain
669-222
669-224
A. STONE 247-67, 671
174-577 C. & J. KILMER
117 174-656 A.L. HOFFMAN
B. & C. SWINDEMAN
J. PRESSLER, ETAL
M. WEILEIN
2 233-531 L. ASCHERMAN
9 174-634 C. & F. BUEHNER
29 184-240 W. DANZIGER
24 169-588 A.M. HIRD
23 169-585 MRS. L.J. BETZ
15 213-122
S.E. MACE
774-1085
2 174-593 L. CHEVALLARD
L. Ascherman 233-357
4 169-592 C.C. DAVIS
5 174-580 B. & M. MALONEY
20 174-646 L. & J. KISTLER
19 169-566 E.B. RHUARK
J.L. Wargo 806-722
16 169-597 A. & A. KNOWLES
15 169-580 BAKONSON
18 192-513 D. STROM
19 174-637 B.A.E. FURNEY
1 174-658 N.E. ROBERTSON
3 174-628 G. STUCKEY
346-315 E. McBride
5 LAKE AQUILLA ESTATES CO.
S. CHARNY
169-586 E. NILES
20 174-652 F. McKENNA
9 174-594 R.B. DENNIS
10 169-587 M.L. COUP
17 169-591 W.A. McLAUGHLIN
12 192-97 J.E. MOLNAR
6-T-3

AQUILLA VILLAGE VOL. 4 PAGES 26-27 REC. OF PLATS
FORMERLY
LAKE AQUILLA ESTATES COMPANY'S SUBDIVISION NO. 1

AND RESUBDIVISION OF BLOCKS I & J AND SUBLOTS
NOS. 125 TO 141 INCLUSIVE IN BLOCK D

PART OF ORIGINAL LOT NOS. 9 & 10 OF THE HOLMES TRACT
CLARIDON TOWNSHIP

VOL. 2 PAGES 6, 7, 8, 9, 10, 11, 12, 19, 33 REC. OF PLATS

for addresses see pg. 6-S west

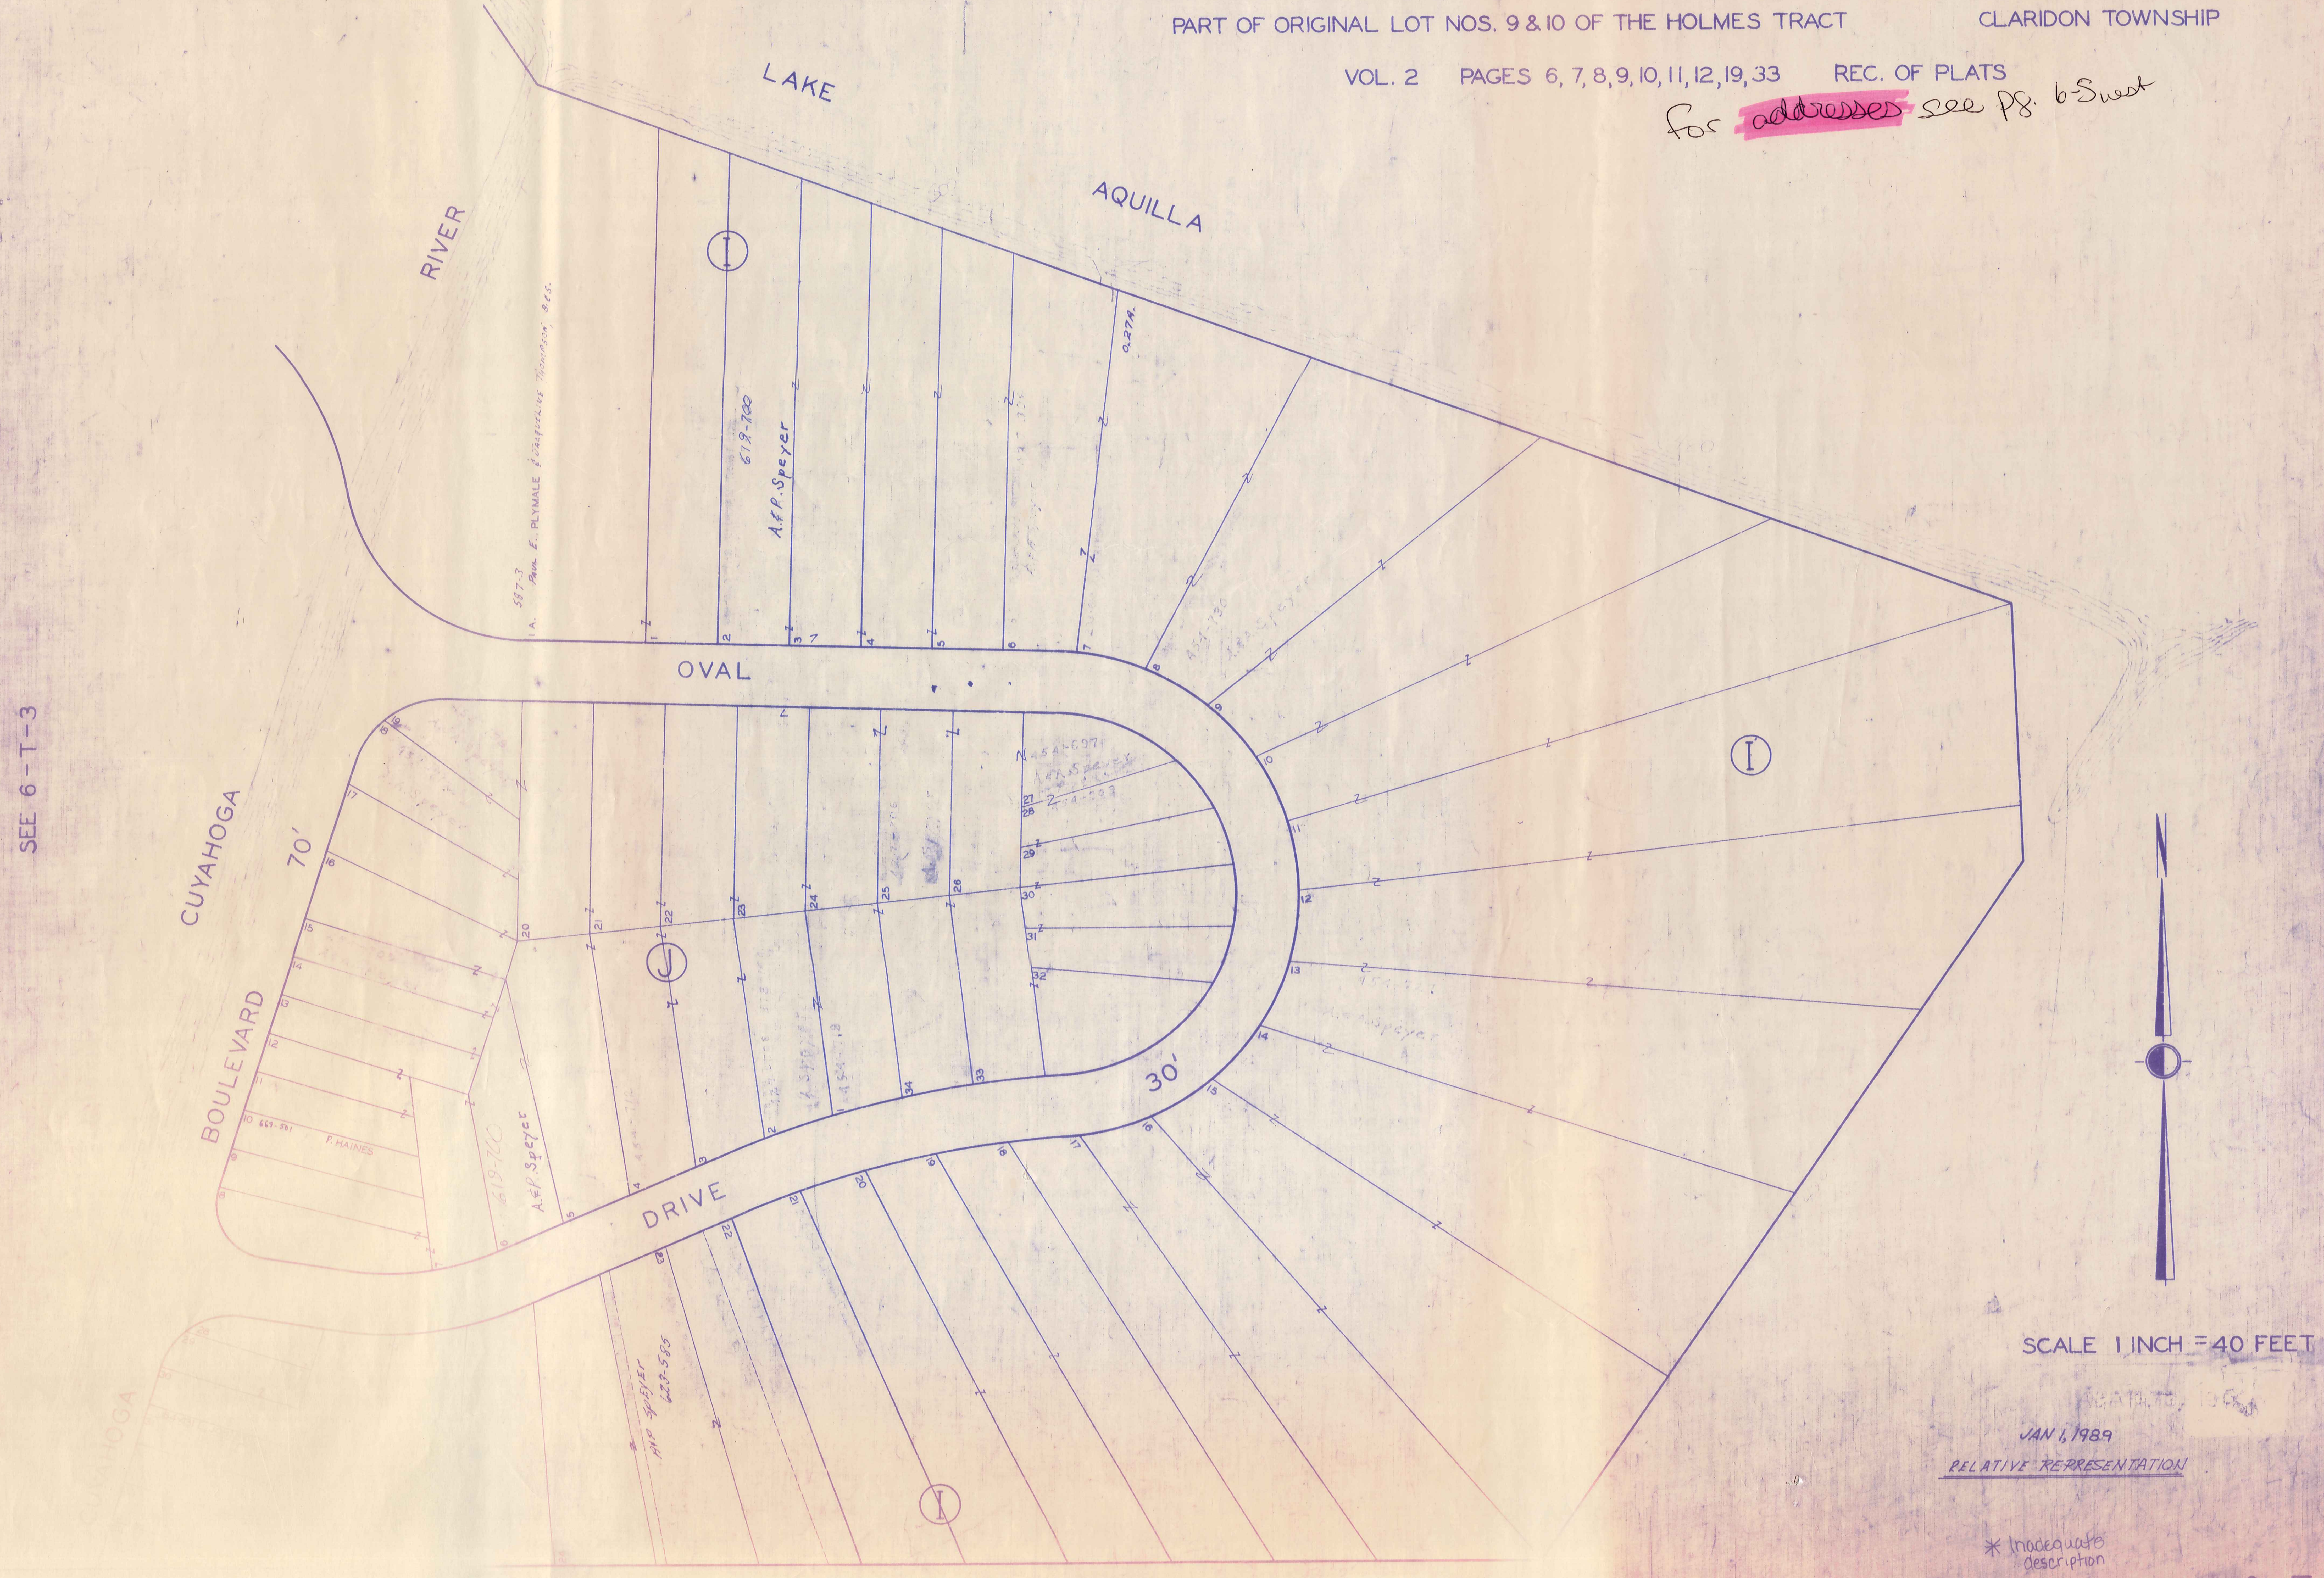
LAKE
AQUILLA
RIVER
CUYAHOGA
SEE 6-T-3
OVAL
DRIVE
BOULEVARD
70'
30'
I
J
I
I
A.&P. Speyer
619-700
A.&P. Speyer
619-700
F. HAINES
N

SCALE 1 INCH = 40 FEET

JAN 1, 1989

RELATIVE REPRESENTATION

* Inadequate description

6-T-4