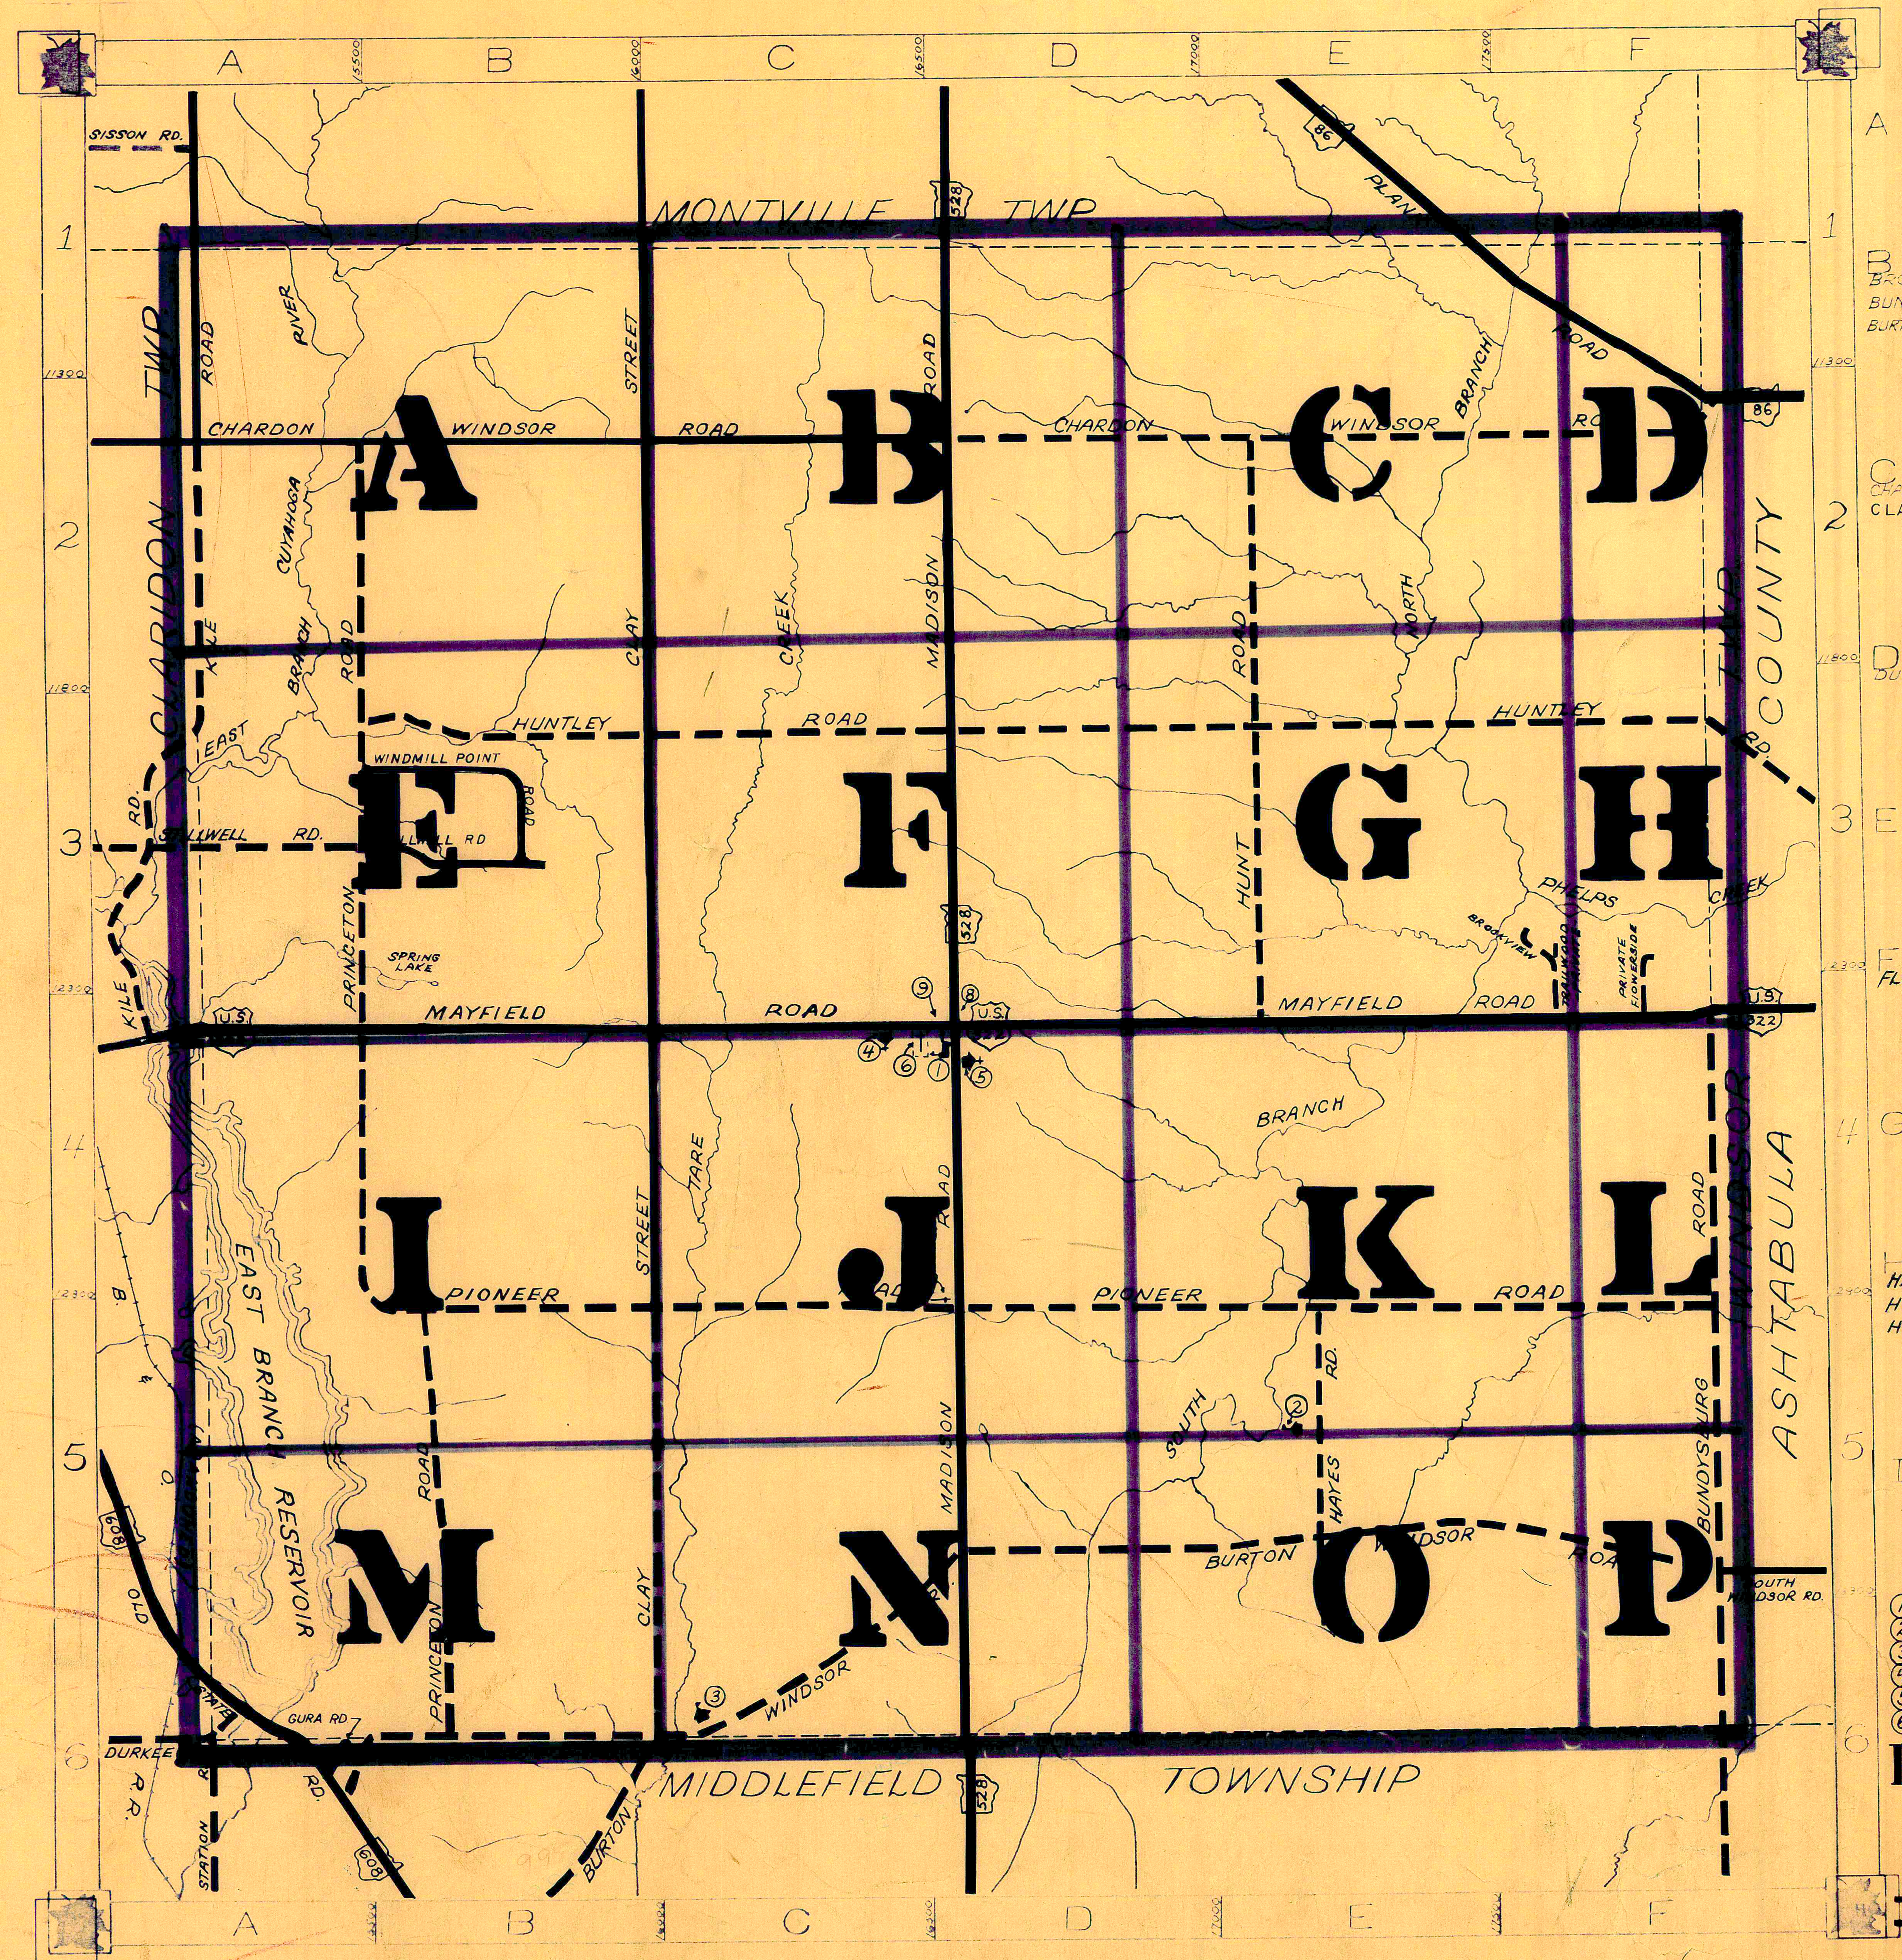
A
B
C
D
E
F
1
2
3
4
5
6
SISSON RD.
MONTVILLE TWP
528
86
PLANK ROAD
CHARDON TWP
KILE ROAD
CUYAHOGA RIVER
CHARDON WINDSOR ROAD
CLAY STREET
MADISON ROAD
NORTH BRANCH
EAST BRANCH
PRINCETON ROAD
CREEK
HUNTLEY ROAD
WINDMILL POINT
STILLWELL RD.
HUNT ROAD
PHELPS CREEK
BROOKVIEW
TRAILWOOD
PRIVATE FLOWERSIDE
SPRING LAKE
MAYFIELD ROAD
U.S. 322
WINDSOR TWP
ASHTABULA COUNTY
TARE CREEK
BRANCH
PIONEER ROAD
EAST BRANCH RESERVOIR
SOUTH BRANCH
HAYES RD.
BURTON WINDSOR ROAD
BUNDYSBURG ROAD
SOUTH WINDSOR RD.
608
OLD STATE
GURA RD.
DURKEE
B.&O. R.R.
MIDDLEFIELD TOWNSHIP
BURTON
WINDSOR
A
B
C
D
E
F
G
H
I
J
K
L
M
N
O
P
N

ROAD INDEX

A

B
BROOKVIEW RD. (PVT) F3
BUNDYSBURG RD F4-F6
BURTON WINDSOR RD C6-F5

C
CHARDON WINDSOR RD A2-F2
CLAY STREET B1-B6

D
DURKEE RD. A6-B6

E

F
FLOWERSIDE RD. (PVT) F4

G

H
HAYES RD. E5
HUNTLEY RD. B3-F3
HUNT RD E2-E4

I

J

K
KILE RD. A1-A4

L

M
MADISON RD. D1-D6
MAYFIELD RD. A4-F4

N

O
OLD STATE RD. A6

P
PIONEER RD. B5-F5
PLANK RD. E1-F2
PRINCETON RD. B2-B6

Q

R

S
STILLWELL RD A3

T
TRAILWOOD RD. (PVT) F4

U

V

W
WINDMILL POINT ROAD B3

X

Y

Z

① HUNTSBURG ELEM. SCHOOL
② AMISH SCHOOL
③ AMISH SCHOOL
④ HUNTSBURG BAPTIST CH.
⑤ HUNTSBURG CONGREGATIONAL CH.
⑥ HUNTSBURG CEMETERY
⑦ HUNTSBURG CEMETERY
⑧ UNITED STATES POST OFFICE
⑨ TOWN HALL
⑩

HUNTSBURG TOWNSHIP

0 5 10 15 20

SCALE : 1" = 2000'

ROBERT L. PHILLIPS,
GEAUGA COUNTY ENGINEER

UNPAVED ROADS
PAVED ROADS
TOWNSHIP LINE
COUNTY LINE

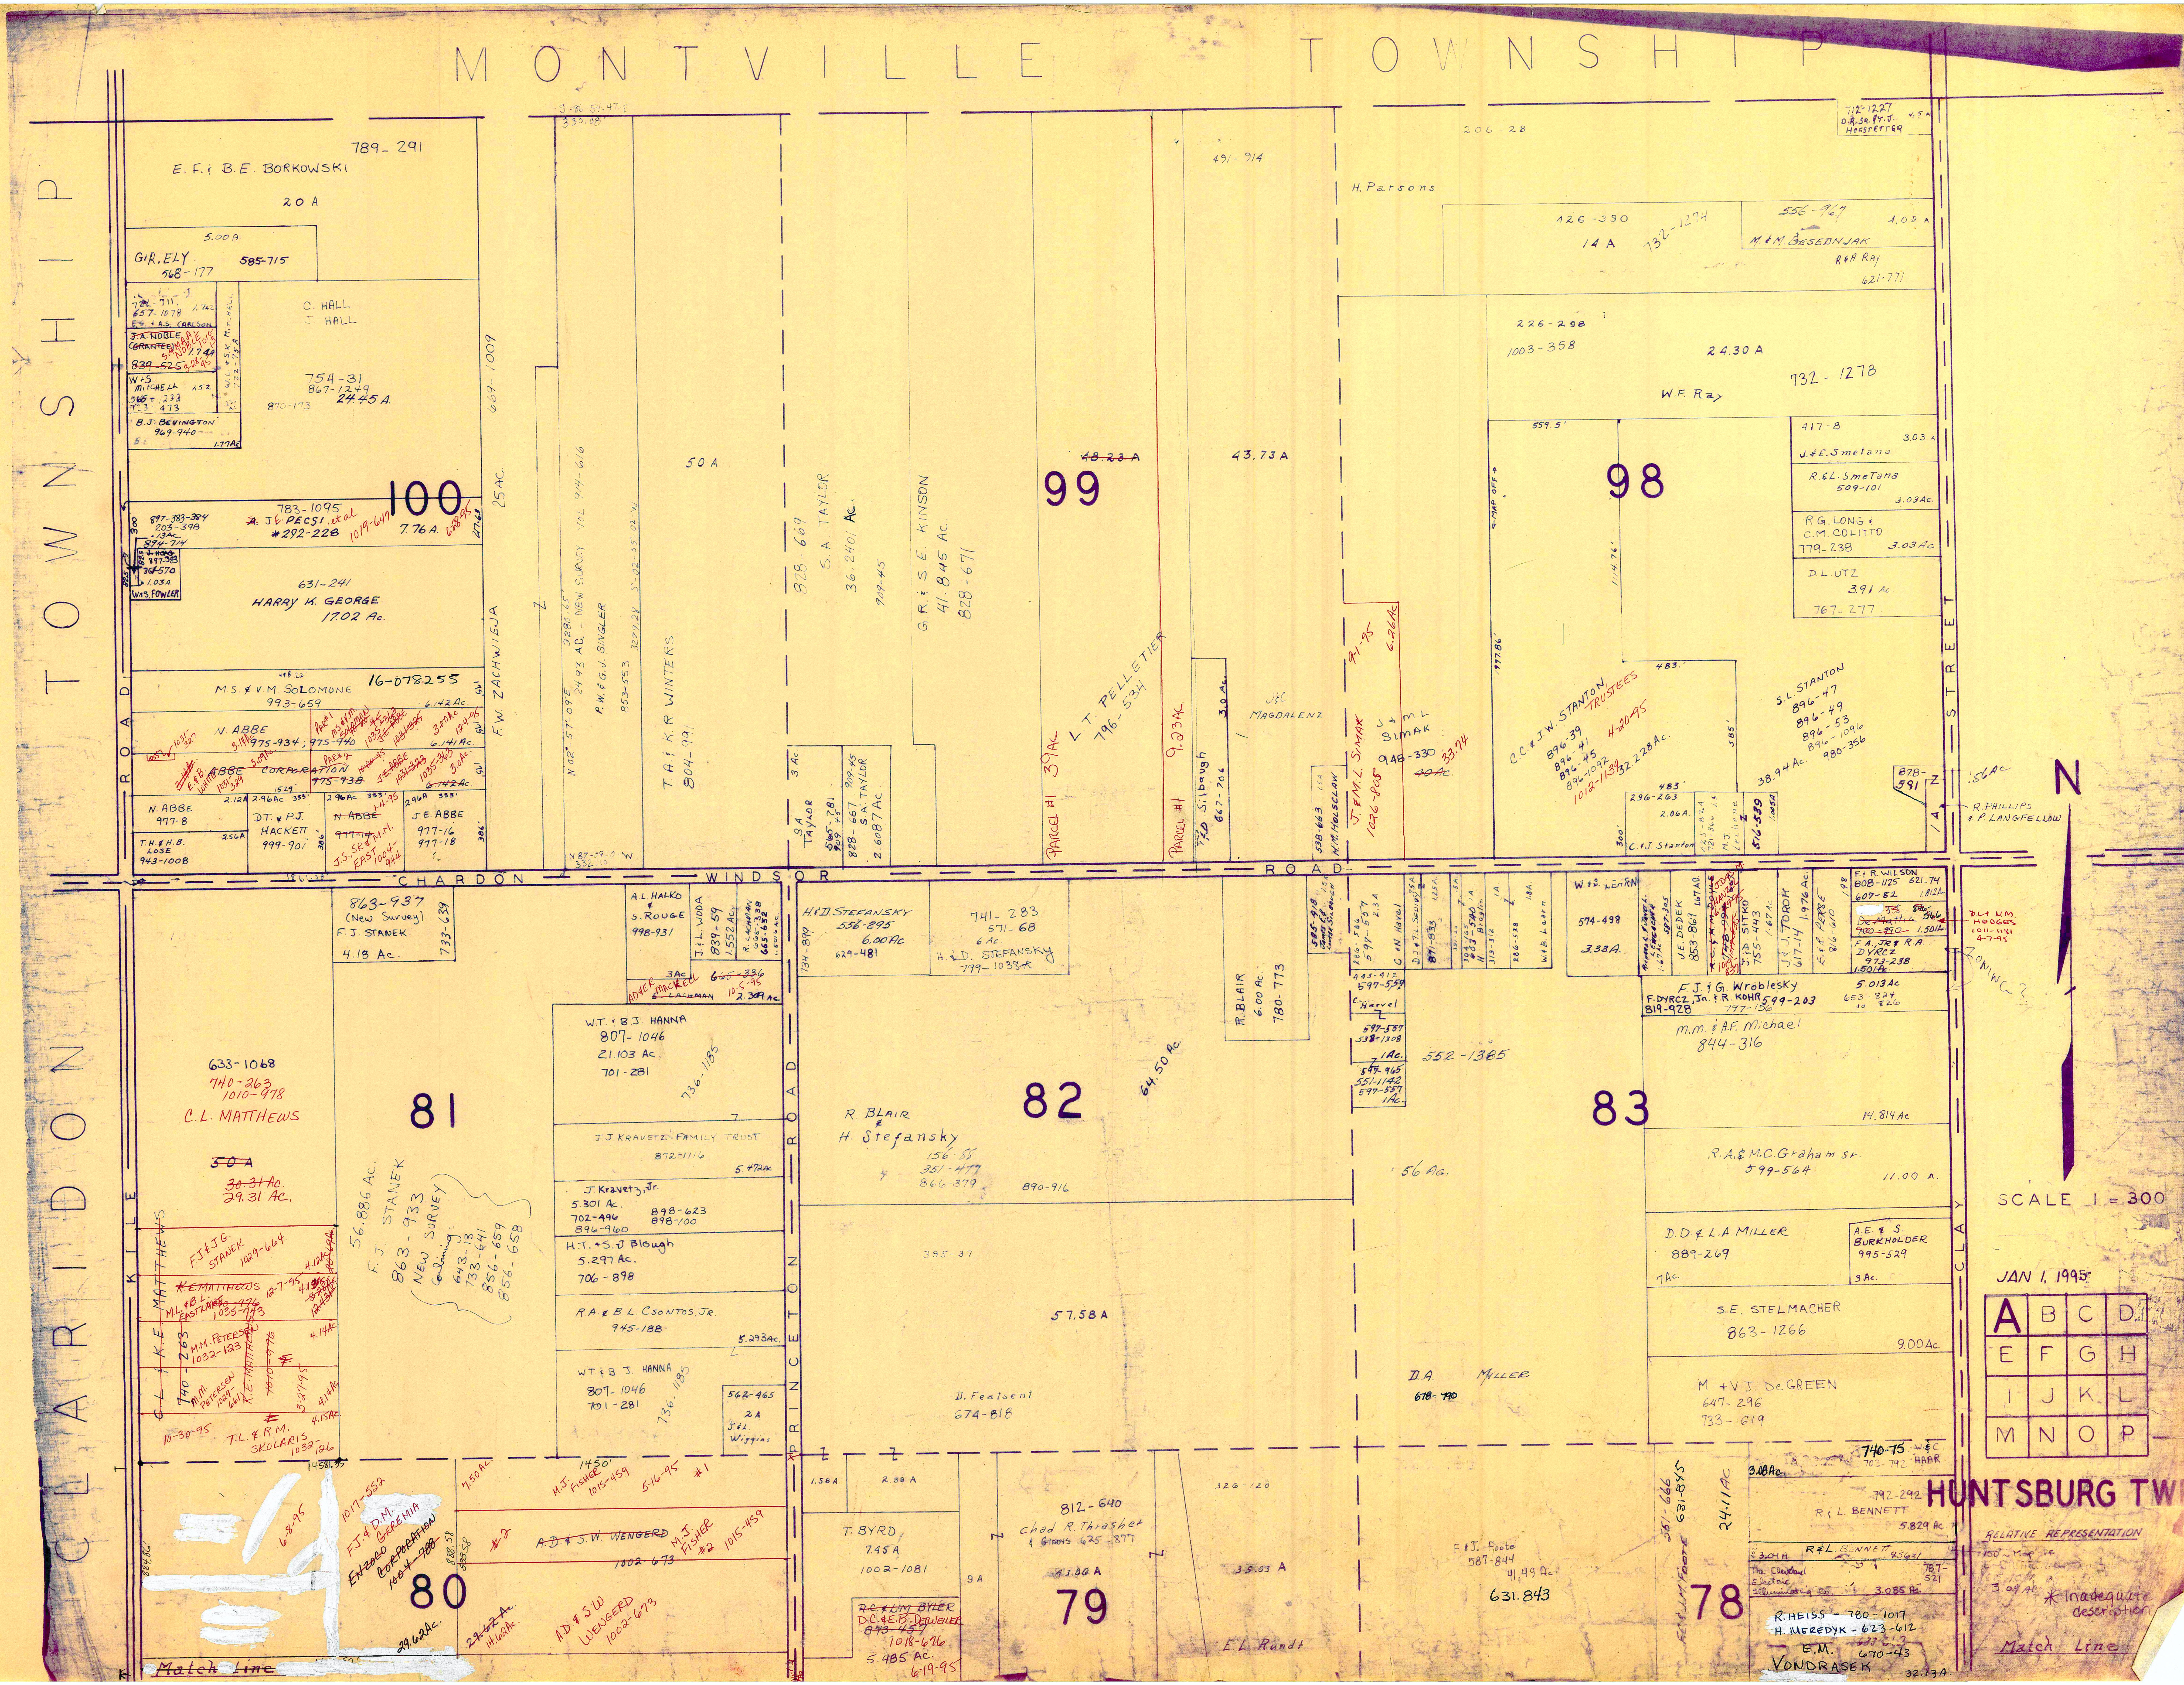
MONTVILLE TOWNSHIP
CLARIDON TOWNSHIP
HUNTSBURG TW
CHARDON WINDSOR ROAD
KILE ROAD
PRINCETON ROAD
CLAY STREET
N
SCALE 1 = 300
JAN 1, 1995
A B C D
E F G H
I J K L
M N O P
RELATIVE REPRESENTATION
150' ~ Map off
3.09 Ac
* Inadequate description
Match Line
100
99
98
81
82
83
80
79
78
E.F. & B.E. BORKOWSKI
789-291
20 A
5.00 A
G.R. ELY
568-177
585-715
C. HALL
J. HALL
754-31
867-1249
24.45 A.
870-173
669-1009
722-711
657-1078
1.742
E.S. & A.S. CARLSON
~~J.A. NOBLE (GRANTEE)~~
S. & M.A.A. NOBLE 1010-13 3-28-95
1.74A
~~839-525~~
W. & S. MITCHELL
565-233
T-3-473
1.52
W.L. & S.K. MITCHELL
722-758
B.J. BEVINGTON
969-940
1.77Ac
783-1095
~~A.~~ J.E. PECSI, etal
*292-228
1019-647
7.76 A.
6-28-95
897-383-384
203-398
.13Ac
894-714
897-383
364-570
1.03A.
W. & S. FOWLER
631-241
HARRY K. GEORGE
17.02 Ac.
F.W. ZACHWIEJA
25 AC.
M.S. & V.M. SOLOMONE
993-659
16-078255
6.142 Ac.
N. ABBE
975-934; 975-940
6.141 Ac.
Par#1 M.S. & V.M. SOLOMON 1035-363
3.00Ac. 1-24-95
N. ABBE CORPORATION
975-938
E. & B. WHITE 1031-329
3.09Ac
Par#2 10-20-95
~~J.E. ABBE~~
~~1031-323~~
1035-363
3.0Ac.
~~6.142~~ Ac.
N. ABBE
977-8
2.12A
2.96Ac. 333'
D.T. & P.J. HACKETT
999-901
~~N. ABBE~~
~~977-14~~
J.S. SR & M.M. EAST 1004-944
1-4-95
J.E. ABBE
977-16
977-18
2.96A 333'
386'
T.H. & H.B. LOSE
943-1008
2.56A
1861.38'
S 86 54-47 E
330.08'
N 02° 57' 09" E
3280.65'
24.93 AC. = NEW SURVEY VOL 914-616
P.W. & G.J. SINGLER
853-553
3279.28 S 02 55 02 W
N 87-09-0 W
332.10
50 A
T.A. & K.R. WINTERS
804-991
828-669
S.A. TAYLOR
36.2401 Ac.
909-45
S.A. TAYLOR
3 Ac.
565-281
909-45
828-667
S.A. TAYLOR
2.6087 Ac.
G.R. & S.E. KINSON
41.845 Ac.
828-671
~~48.23 A~~
L.T. PELLETIER
796-534
PARCEL #1 39AC
PARCEL #1 9.23AC
T. & D. Silbaugh
667-706
3.0Ac.
491-914
43.73 A
J. & C. MAGDALENZ
538-663
1.5A
H.M. HOLSCLAW
J. & M.L. SIMAK
1026-805
9-1-95
6.26Ac
J. & M.L. SIMAK
948-330
~~40Ac~~
33.74
H. Parsons
206-28
712-1227
D.R. SR. & Y.J. HOFSTETTER
1.5A
426-390
14 A
732-1274
556-967
1.09 A
M. & M. BESEDNJAK
R & A Ray
621-771
226-298
1003-358
24.30 A
732-1278
W.F. Ray
559.5'
MAP OFF
997.86'
1114.76'
417-8
3.03 A
J. & E. Smetana
R. & L. Smetana
509-101
3.03Ac.
R.G. LONG & C.M. COLITTO
779-238
3.03Ac
D.L. UTZ
3.91 Ac
767-277
483'
C.C. & J.W. STANTON, TRUSTEES
896-39
896-41
896-45
896-1092
4-20-95
1012-1139
32.228Ac.
585'
S.L. STANTON
896-47
896-49
896-53
896-1096
980-356
38.94 Ac.
483'
296-263
2.06A.
300'
C. & J. Stanton
425-824
721-366
1.5
M.J. Lechene
516-539
1.005A
878-591
.56Ac
R. PHILLIPS & P. LANGFELLOW
863-937 (New Survey)
F.J. STANEK
4.18 Ac.
733-639
A.L. HALKO & S. ROUGE
998-931
J. & L. WODA
839-59
1.552 Ac.
R. LACHMAN
665-338
665-632
1.5016 Ac.
3Ac
AD & ER MACKELL
~~E. LACHMAN~~
~~665-336~~
10-5-95
2.309 Ac.
633-1068
740-263
1010-978
C.L. MATTHEWS
~~50 A~~
~~30.31 Ac.~~
29.31 Ac.
56.886 Ac.
F.J. STANEK
863-933
NEW SURVEY
Combining
643-13
733-641
856-659
856-658
C.L. & K.E. MATTHEWS
740-263
F.J. & J.G. STANEK
1029-664
4.12Ac
~~K.E. MATTHEWS~~
12-7-95
M.L. & B.L. EASTLAKE
1035-743
4.13Ac
M.M. PETERSEN
1032-123
4.14Ac
M.M. PETERSEN 1029-661
K.E. MATTHEWS
3-27-95
4.14Ac
10-30-95
T.L. & R.M. SKOLARIS
1032-126
4.15Ac.
1458.35
W.T. & B.J. HANNA
807-1046
21.103 Ac.
701-281
736-1185
J.J. KRAVETZ FAMILY TRUST
872-1116
5.472Ac
J. Kravetz, Jr.
5.301 Ac.
702-496
896-960
898-623
898-100
H.T. & S.J. Blough
5.297 Ac.
706-898
R.A. & B.L. CSONTOS, JR.
945-188
5.293Ac.
WT & B.J. HANNA
807-1046
701-281
736-1185
562-465
2A
J. & L. Wiggins
884.86'
6-8-95
1017-552
F.J. & D.M. GEREMIA
~~ENZOCO CORPORATION~~
~~1004-708~~
888.58
29.62Ac.
7.50Ac.
1450'
M.J. FISHER
1015-459
5-16-95
#1
#2
~~A.D. & S.W. WENGERD~~
M.J. FISHER #2 1015-459
1002-673
~~29.62 Ac.~~
14.62Ac.
A.D. & S.W. WENGERD
1002-673
H. & D. STEFANSKY
556-295
6.00Ac
629-481
734-899
741-283
571-68
6 Ac.
H. & D. STEFANSKY
799-1038*
R. BLAIR
6.00 Ac.
780-773
64.50 Ac.
R. BLAIR & H. Stefansky
156-88
351-477
866-379
890-916
395-37
57.58 A
D. Featsent
674-818
585-418
James C.& Louise Silbaugh
1.5A
286-586
597-557
2.3A
C. & N. Havel
D.J. & T.L. Sedivy
.75A
871-833
1.25A
391-22
.5A
304-165
603-540
H. Broglin
1A
319-312
286-538
1.8A
W. & B. Laorn
443-412
597-559
C. Harvel
597-557
538-1308
1Ac.
597-965
551-1142
597-557
1Ac.
552-1385
56 Ac.
D.A. MILLER
678-790
W. & D. LEHRN
574-498
3.33A.
Richard & Janet L. Leweacher
587-305
1.67Ac.
J.E. DEDEK
853-869
1.67Ac.
J.D. & S.M. HANZEL
6-7-95
1019-837
J. & D. SITKO
755-443
1.67Ac
J. & J. TOROK
617-14
1.976 Ac.
E. & R. PERSE
816-610
F. & R. WILSON
808-1125
621-74
607-82
1.812A
~~De Mattia~~
~~900-990~~
846-366
1.501Ac
D.L. & U.M. HEDGES
1011-1181
4-7-95
F.A., JR. & R.A. DYRCZ
973-238
1.501Ac.
ZONING ?
F.J. & G. Wroblesky
F. DYRCZ, JR. & R. KOHR
819-928
599-203
797-156
5.013 Ac
653-824 to 826
M.M. & A.F. Michael
844-316
14.814 Ac
R.A. & M.C. Graham Sr.
599-564
11.00 A.
D.D. & L.A. MILLER
889-269
7Ac.
A.E. & S. BURKHOLDER
995-529
3 Ac.
S.E. STELMACHER
863-1266
9.00 Ac.
M + V.J. DeGREEN
647-296
733-619
1.58 A
2.88 A
T. BYRD
7.45 A
1002-1081
9A
~~R.C. & L.M. BYLER~~
D.C. & E.B. DETWEILER
~~843-457~~
1018-676
5.485 AC.
6-19-95
812-640
Chad R. Thrasher & Gladys 625-877
43.86 A
326-120
35.03 A
E.L. Rundt
F. & J. Foote
587-844
41.49 Ac.
631.843
561-666
631-845
F. & L.M. FOOTE
24.11AC
740-75
703-792
W. & C. HAAR
3.08Ac.
792-292
R. & L. BENNETT
5.829 Ac.
R. & L. BENNETT
956-1
3.01A
The Cleveland Electric Illuminating Co.
787-521
3.085 Ac.
R. HEISS - 780-1017
H. MEREDYK - 623-612
E.M. VONDRASEK
670-43
32.13A.

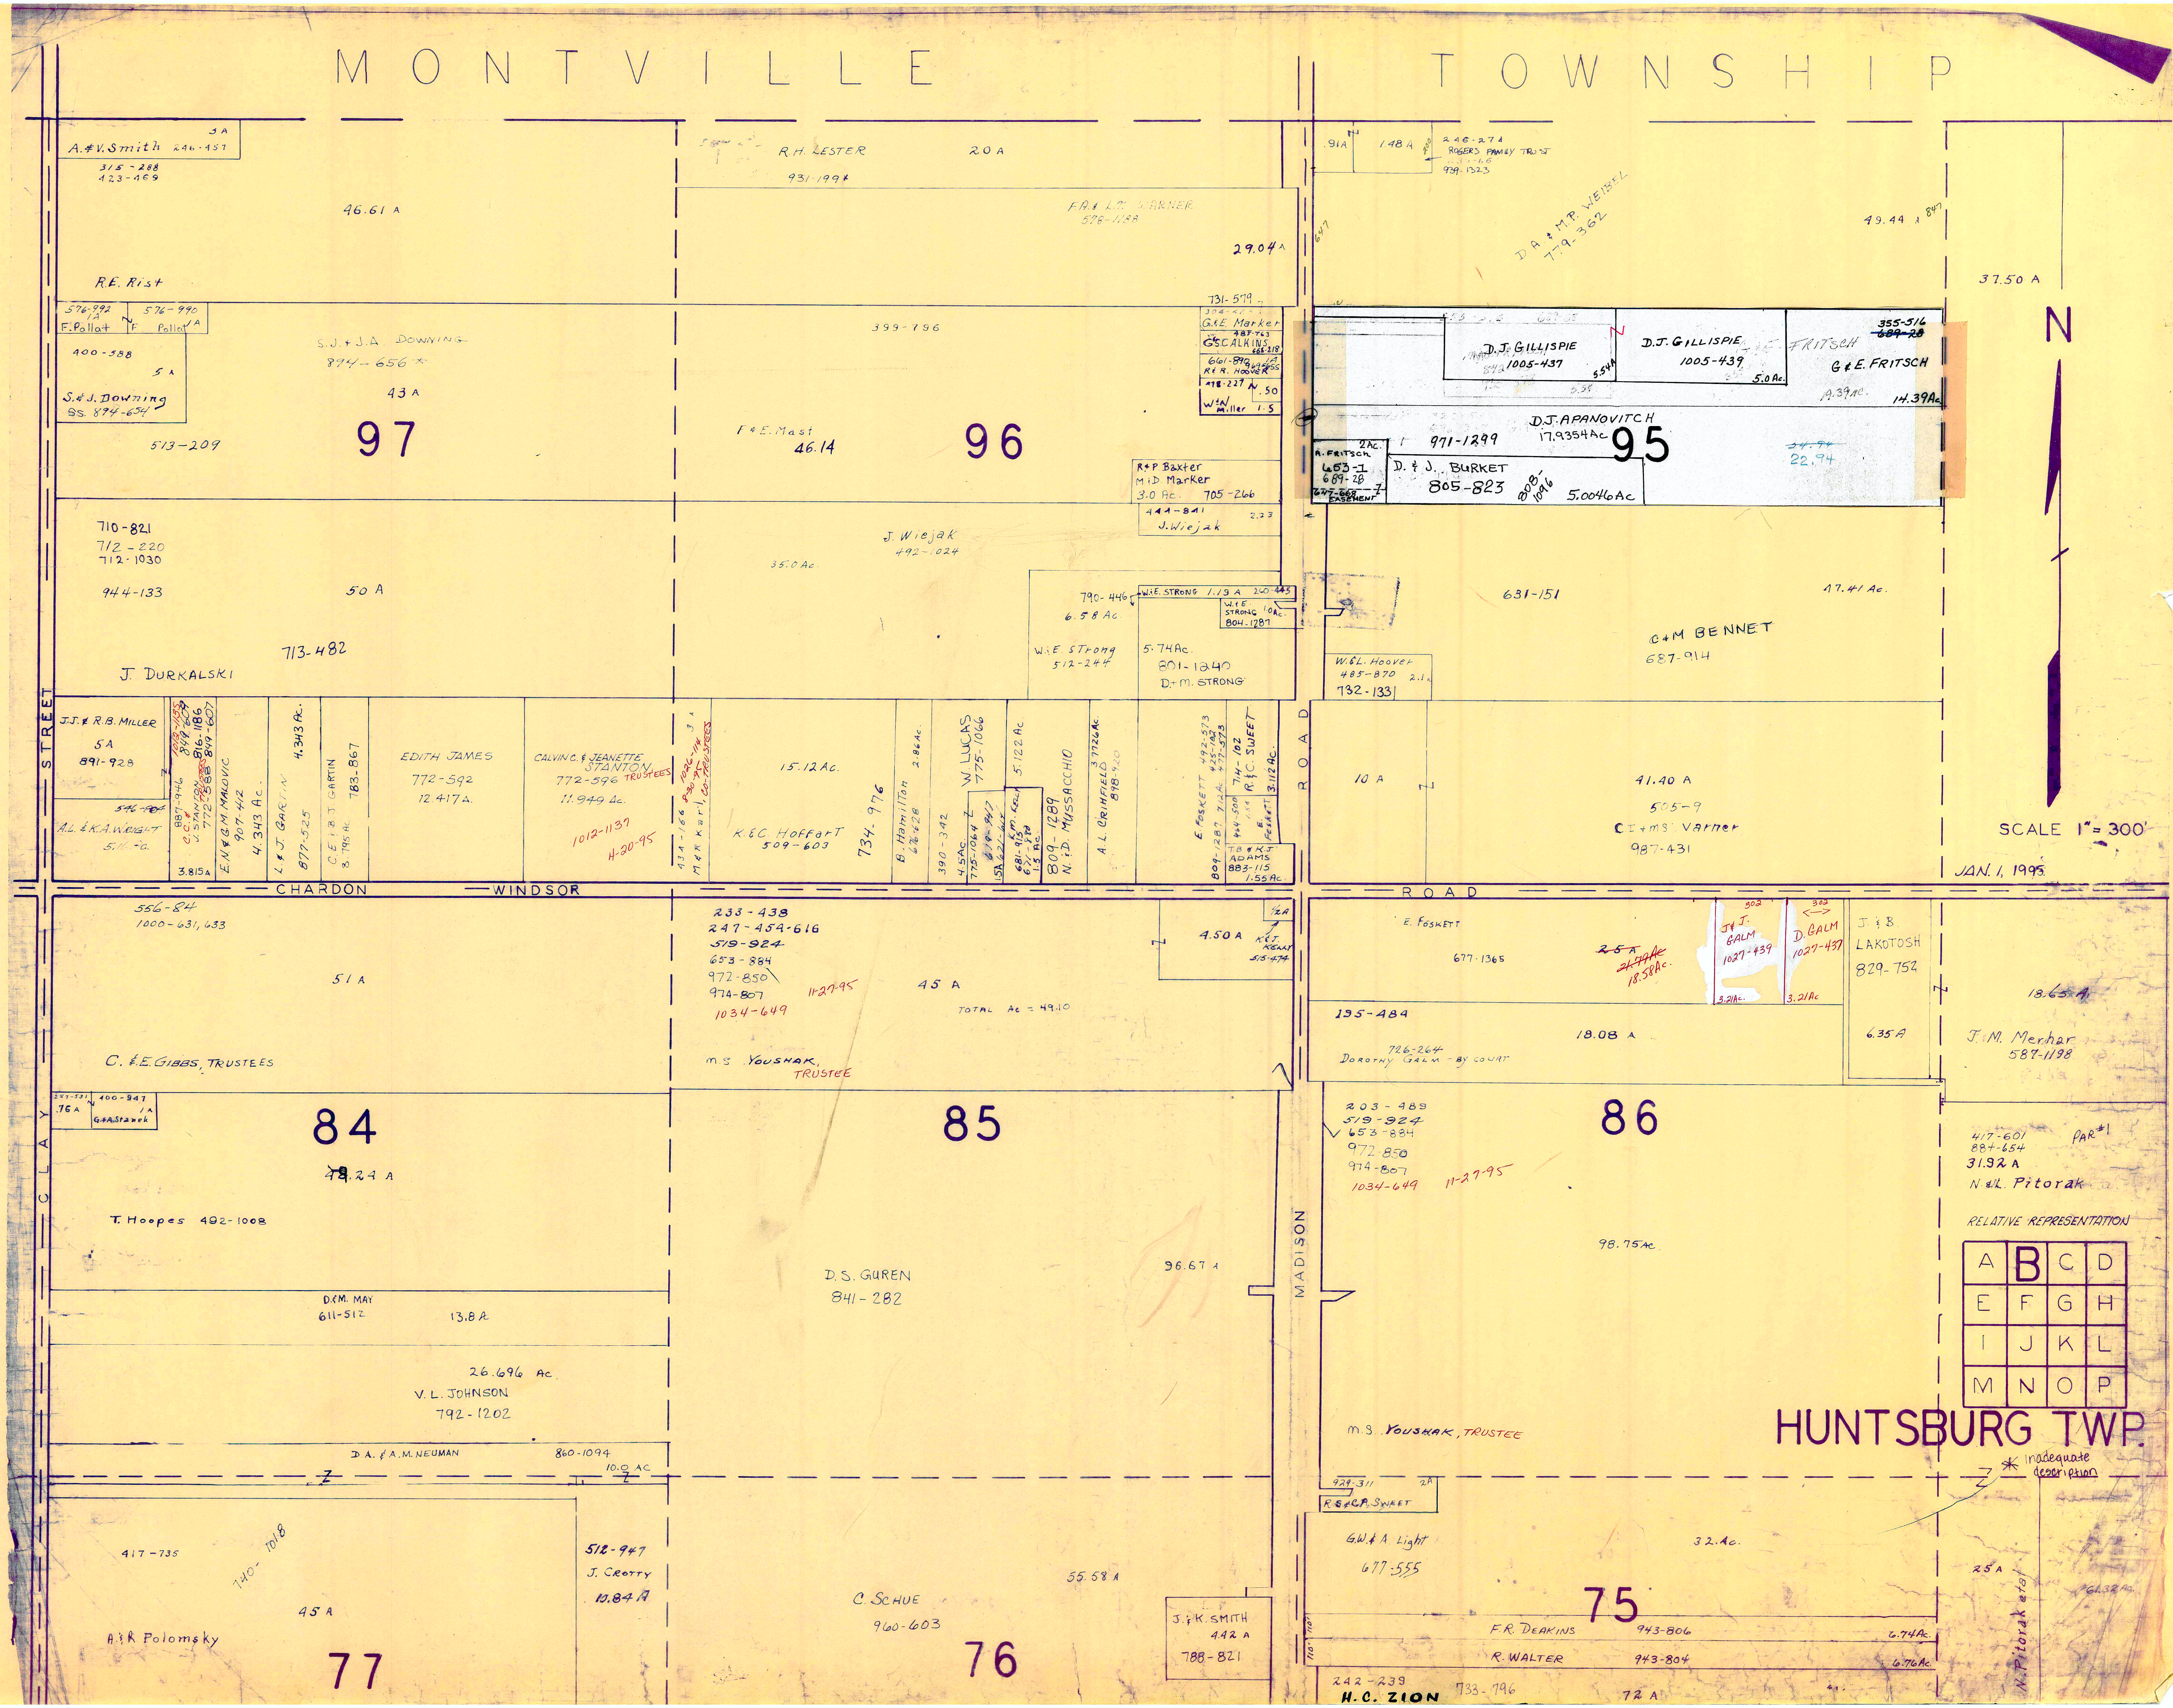
MONTVILLE TOWNSHIP
A.&V. Smith 246-457 3 A
315-288
423-469
46.61 A
R.E. Rist
R.H. LESTER 20 A
931-1997
F.R.& L.E. VARNER 576-1188
29.04 A
.91 A
1.48 A
246-274 ROGERS FAMILY TRUST
979-1323
D.A. & M.P. WEISEL 779-362
49.44 A
37.50 A
N
F. Pollat
400-588
5 A
S.&J. Downing 95. 874-654
513-209
S.J. & J.A. DOWNING 874-656
43 A
97
F.&E. Mast 46.14
399-196
96
731-579
G.&E. Marker
G.S. CALKINS
R.&R. Hoover
W.&N. Miller 1.5
R&P Baxter
M.D. Marker 3.0 Ac. 705-266
444-841 J. Wiejak
D.J. GILLISPIE 1005-437
D.J. GILLISPIE 1005-439 5.0 Ac.
G.&E. FRITSCH 355-516 ~~689-28~~
G.&E. FRITSCH 14.39 Ac.
D.J. APANOVITCH 971-1299 17.9354 Ac.
95
~~24.94~~ 22.94
A. FRITSCH 2 Ac. 653-1 689-28
EASEMENT
D. & J. BURKET 805-823 5.0046 Ac.
710-821
712-220
712-1030
944-133
50 A
713-482
J. DURKALSKI
J. Wiejak 492-1024
35.0 Ac
790-446 6.58 Ac
W.E. STRONG 1.19 A
W.E. STRONG 804-1287
W.&E. Strong 512-244
5.74 Ac. 801-1240
D.-M. STRONG
W.&L. Hoover 485-870 2.1
732-133
631-151
47.41 Ac.
C.&M. BENNET 687-914
J.J. & R.B. MILLER 5A 891-928
A.L. & K.A. WRIGHT
E.N. & B.M. MAJOVIC 907-412
4.343 Ac.
L.&J. GARTIN 877-525
C.E. & B.J. GARTIN 783-867
EDITH JAMES 772-592 12.417 A.
CALVIN C. & JEANETTE STANTON 772-596 TRUSTEES 11.949 Ac.
1012-1137 4-20-95
M.&R. Karl CO-TRUSTEES
15.12 Ac.
K.&C. Hoffart 509-603
734-976
B. Hamilton
W. LUCKS 775-1066
809-1289
N.D. MUSSACCHIO
A.L. CRINFIELD
E. FOSKETT
R.&C. SWEET
T.B.&K.J. ADAMS 883-115 1.55 Ac.
STREET
CLAY
ROAD
10 A
41.40 A
565-9
C.F.&M.S. Varner 987-431
SCALE 1" = 300'
JAN. 1, 1995
CHARDON WINDSOR ROAD
556-84
1000-631, 633
51 A
C.&E. GIBBS, TRUSTEES
G.&A. Stanek
233-438
247-454-616
519-924
653-884
972-850
974-807
1034-649
11-27-95
45 A
TOTAL Ac = 49.10
M.S. YOUSHAK, TRUSTEE
4.50 A
K.&T. KENNY 515-474
E. FOSKETT 677-1365
~~25 A~~ ~~21.79 Ac~~ 18.58 Ac.
J.&J. GALM 1027-439 3.21 Ac.
D. GALM 1027-437 3.21 Ac.
J.&B. LAKOTOSH 829-752
6.35 A
18.65 A
J.M. Merhar 587-1198
195-484
18.08 A
726-264 Dorothy Galm - by court
84
48.24 A
T. Hoopes 492-1008
85
D.S. GUREN 841-282
96.67 A
86
203-489
519-924
653-884
972-850
974-807
1034-649 11-27-95
98.75 Ac.
417-601
884-654
31.92 A
N.&L. Pitorak
PAR #1
RELATIVE REPRESENTATION
A B C D
E F G H
I J K L
M N O P
MADISON
D.&M. MAY 611-512 13.8 A
26.696 Ac
V.L. JOHNSON 792-1202
D.A. & A.M. NEUMAN 860-1094 10.0 AC
M.S. YOUSHAK, TRUSTEE
HUNTSBURG TWP.
* inadequate description
429-311 2A R.&C.P. SWEET
G.W.& A Light 677-555
32 Ac.
25 A
417-735
740-1018
45 A
A.&R. Polomsky
77
512-947 J. Crotty 10.84 A
C. Schue 960-603
55.58 A
76
J.&K. SMITH 442 A 788-821
75
F.R. DEAKINS 943-806 6.74 Ac.
R. WALTER 943-804 6.76 Ac.
242-239 H.C. ZION 733-796 72 A
N. Pitorak

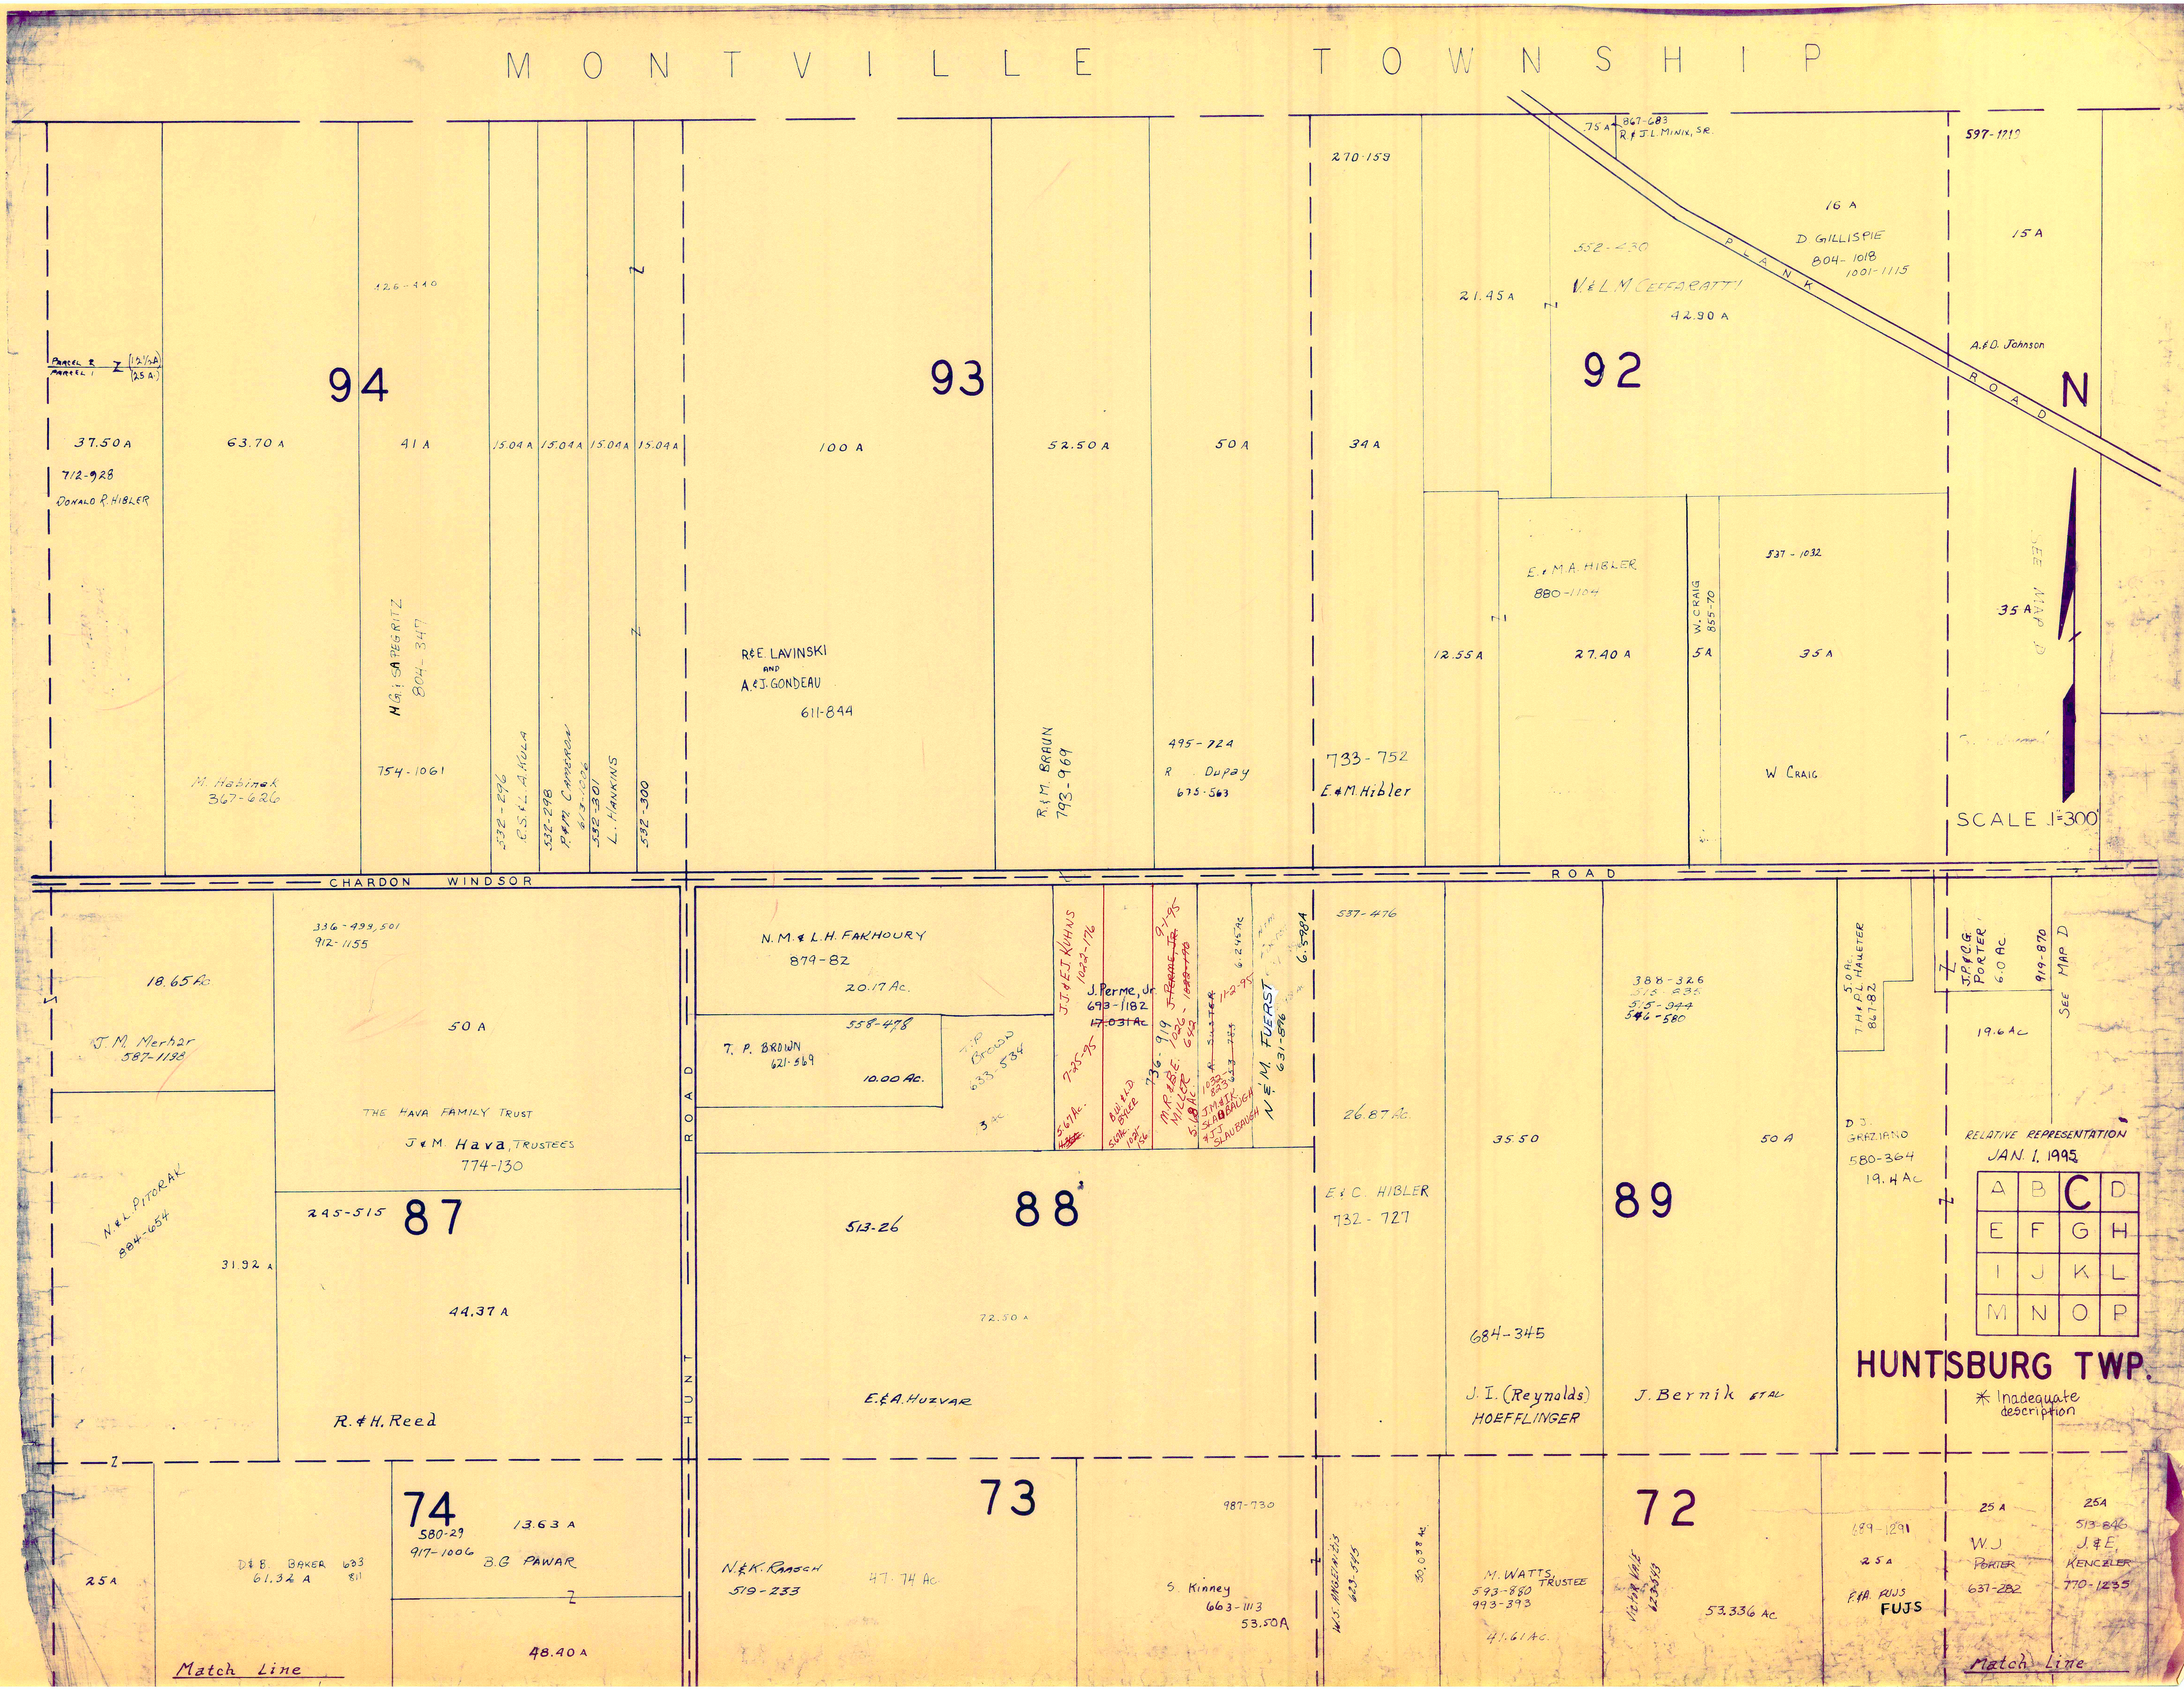
MONTVILLE TOWNSHIP
94
93
92
Parcel 2
Parcel 1
(12½A)
(25A)
37.50 A
712-928
DONALD R. HIBLER
63.70 A
M. Habinak
367-626
126-440
41 A
H.G. & SAPEGRITZ
804-347
754-1061
15.04 A
15.04 A
15.04 A
15.04 A
532-296
E.S. & L.A. KULA
532-298
P & M. CAMERON
613-1006
532-301
L. HANKINS
532-300
100 A
R & E. LAVINSKI
AND
A. & J. GONDEAU
611-844
52.50 A
R & M. BRAUN
793-969
50 A
495-724
R. Dupay
675-563
270-159
34 A
733-752
E & M. Hibler
.75 A
867-683
R. & J.L. MINIX, SR.
16 A
D. GILLISPIE
804-1018
1001-1115
552-430
V. & L.M. CEFFARATTI
21.45 A
42.90 A
PLANK ROAD
597-1219
15 A
A. & D. Johnson
N
E. & M.A. HIBLER
880-1104
12.55 A
27.40 A
W. CRAIG
855-70
5 A
537-1032
35 A
W. CRAIG
35 A
SEE MAP D
SCALE 1"=300'
CHARDON WINDSOR ROAD
HUNT ROAD
336-499, 501
912-1155
18.65 Ac.
J.M. Merhar
587-1193
50 A
THE HAVA FAMILY TRUST
J & M. Hava, TRUSTEES
774-130
N. & L. PITORAK
884-654
31.92 A
245-515
87
44.37 A
R. & H. Reed
N.M. & L.H. FAKHOURY
879-82
20.17 Ac.
558-478
T.P. BROWN
621-569
10.00 Ac.
T.P. BROWN
633-534
3 Ac.
J.J. & E.J. KUHNS
1022-176
7-25-95
5.67 Ac.
~~H.34Ac.~~
J. Perme, Jr
693-1182
~~17.031 Ac~~
B.W. & L.D. BYLER
5.67 Ac.
1021-156
9-1-95
~~J. PERME, JR.~~
~~1022-176~~
736-919
1026-642
M.R. & B.E. MILLER
5.68 Ac.
~~A. SUSTER~~
~~653-785~~
11-2-95
1032-823
J.M. & I.K. SLABAUGH
& J.J SLAUBAUGH
6.245 Ac
N. & M. FUERST
631-896
6.598 A
513-26
88
72.50 A
E. & A. HUZVAR
537-476
26.87 Ac.
E. & C. HIBLER
732-727
35.50
684-345
J.I. (Reynolds) HOEFFLINGER
388-326
515-635
515-944
546-580
50 A
89
J. Bernik ET AL
5.0 A.
T.H. & P.L. HAUETER
867-82
D.J. GRAZIANO
580-364
19.4 Ac
J.P. & C.G. PORTER
6.0 Ac
919-870
19.6 Ac
SEE MAP D
RELATIVE REPRESENTATION
JAN. 1, 1995
A B C D
E F G H
I J K L
M N O P
HUNTSBURG TWP.
* Inadequate description
25 A
74
580-29
917-1006
13.63 A
B.G. PAWAR
D. & B. BAKER 633-811
61.32 A
48.40 A
Match Line
73
N. & K. RAASCH
519-233
47.74 Ac.
987-730
S. Kinney
663-1113
53.50A
W.S. ANGELAITIS
623-545
30.038 Ac.
72
M. WATTS, TRUSTEE
593-880
993-393
41.61 Ac.
Victor Vale
623-543
53.336 Ac
689-1291
25 A
F. & A. FUJS
FUJS
25 A
W.J. PORTER
637-282
25A
513-846
J. & E. KENCZLER
770-1235
Match Line

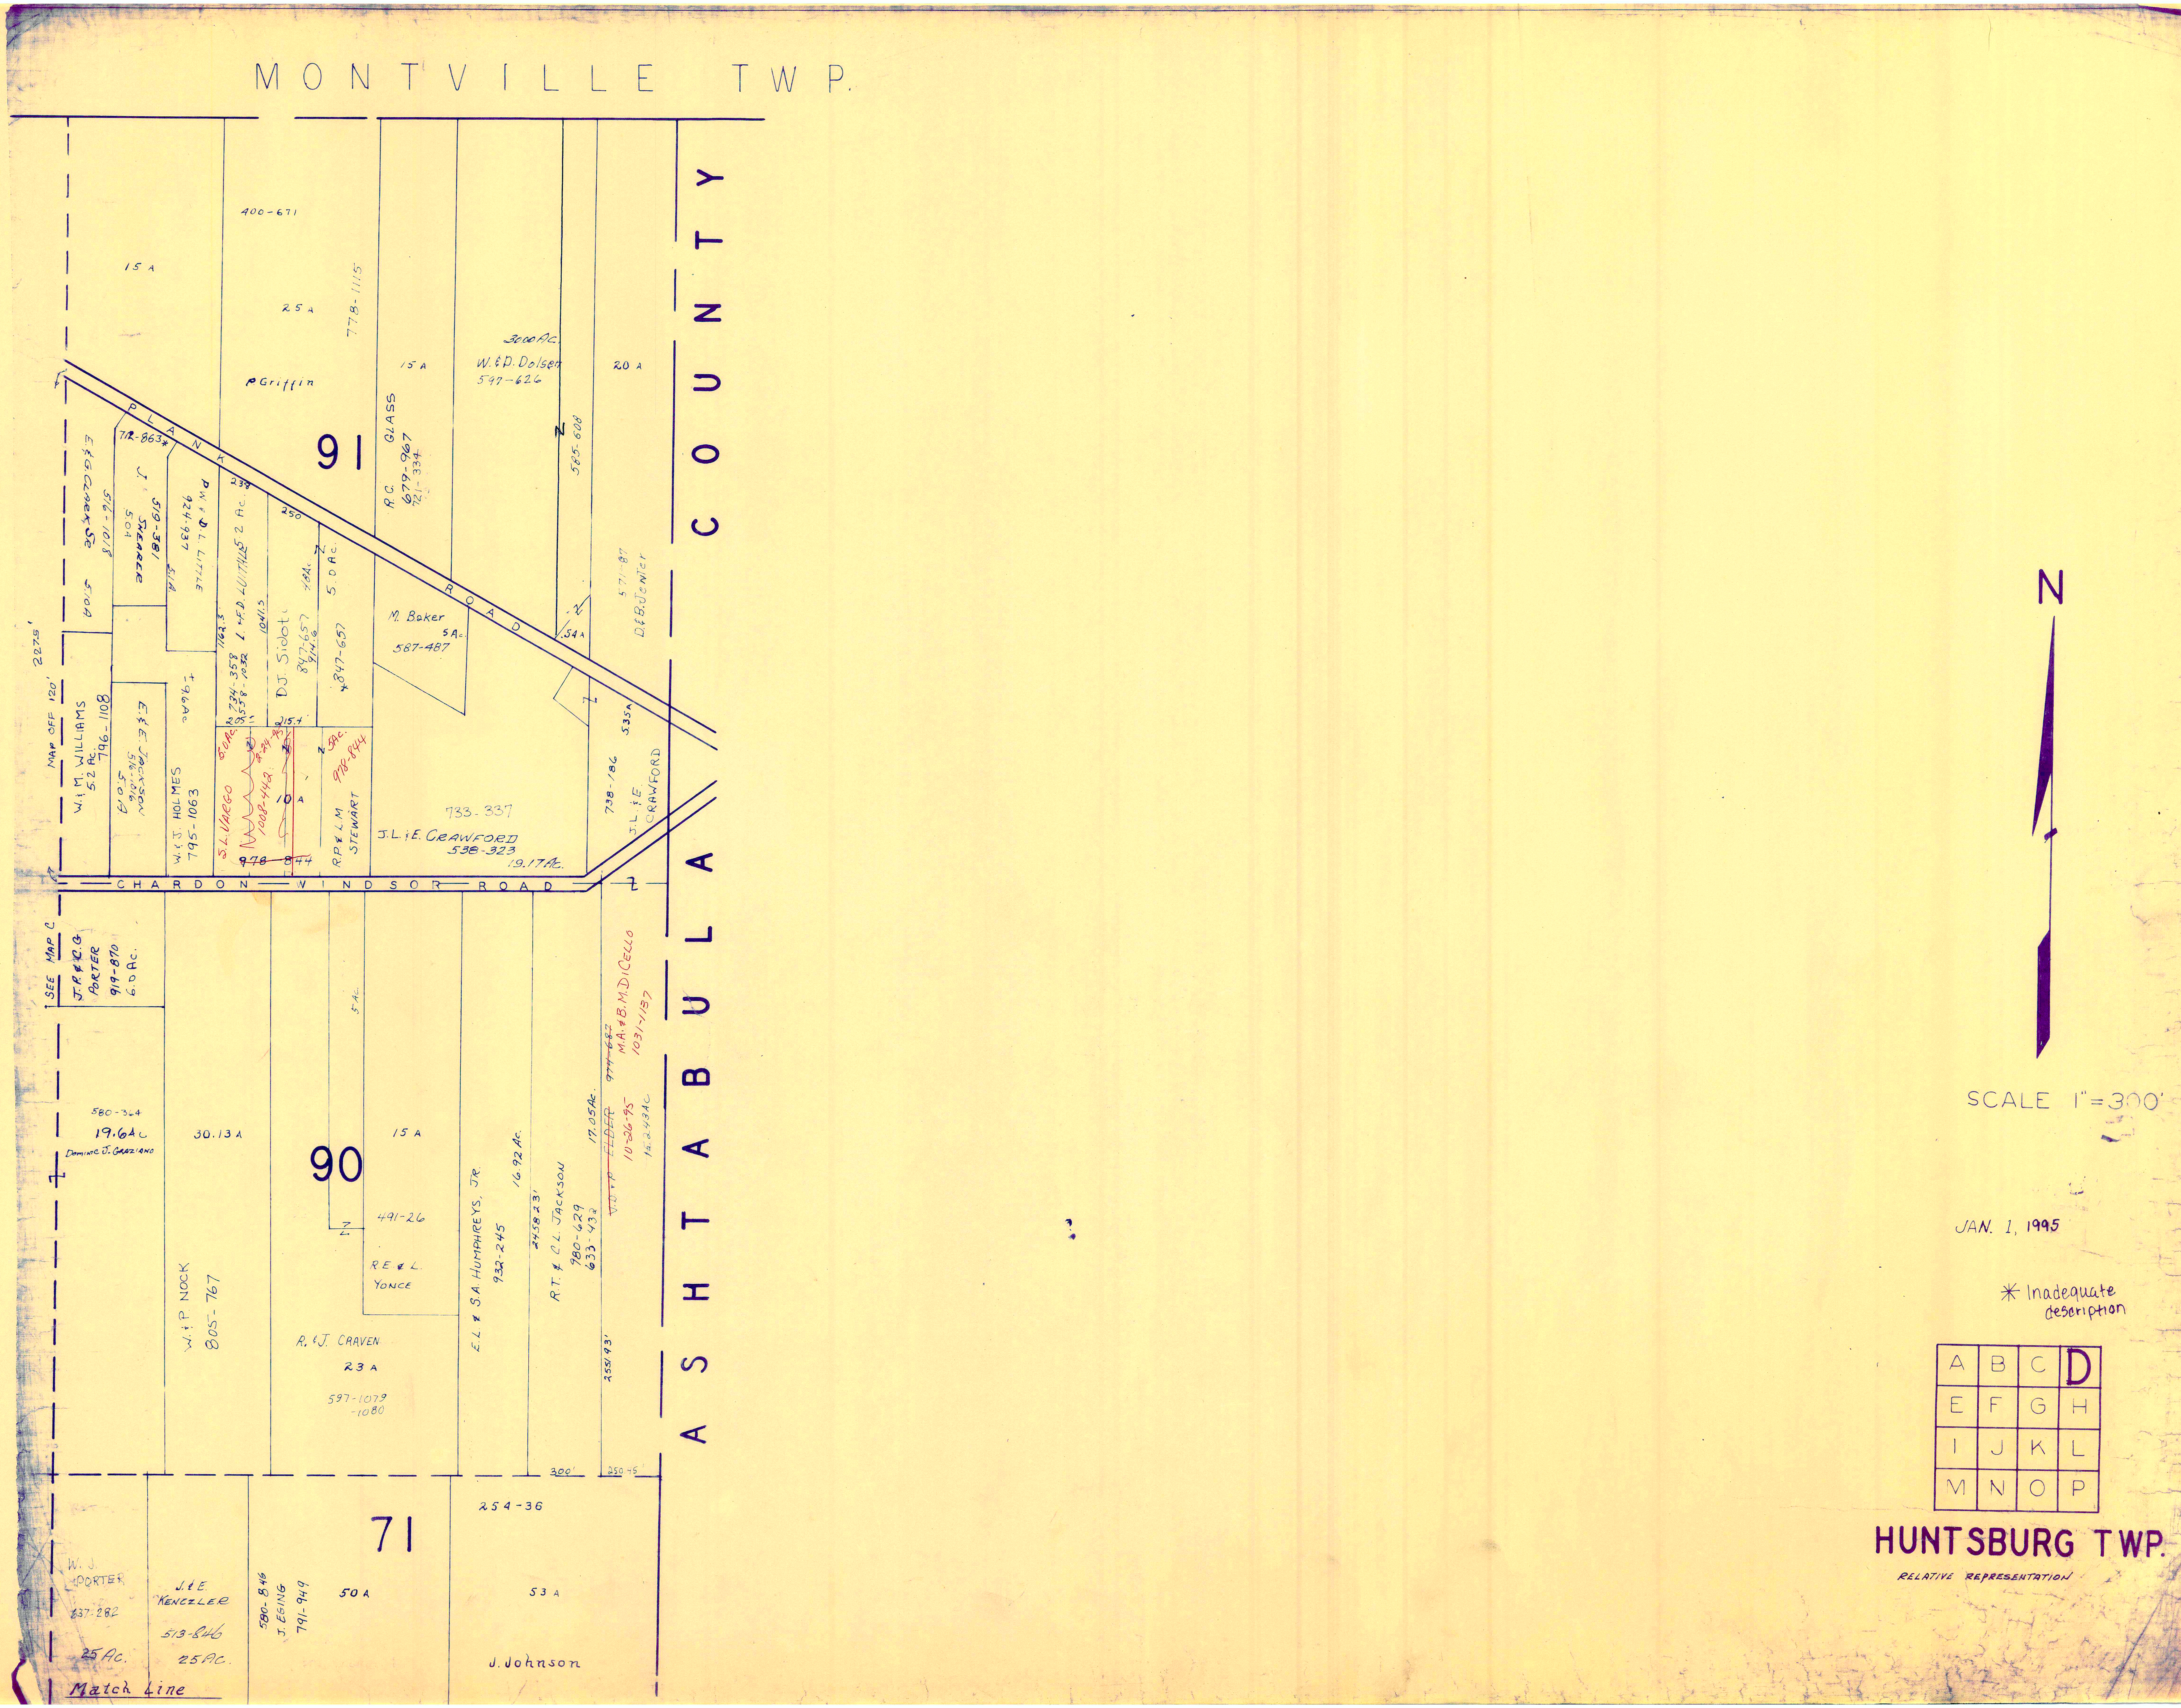
MONTVILLE TWP.
ASHTABULA COUNTY
PLANK ROAD
CHARDON WINDSOR ROAD
91
90
71
400-671
15 A
25 A
778-1115
P Griffin
15 A
R.C. GLASS
679-967
721-334
3000 Ac.
W.&D. Dolsen
597-626
585-608
20 A
571-87
D&B Jenter
E&G Clark Sr
516-1018
5.0 A
712-863*
J. Shearer
519-381
5.0 A
P.W.&D.L. Little
924-937
5.1 A
238
250
L.&F.D. Luithle 2 Ac.
1162.3
1041.5
734-358
558-1032
DJ. Sidoti
847-657
914-6
.78 Ac.
5.0 Ac.
847-657
M. Baker
5 Ac.
587-487
.54 A
5.35 A
2275'
MAP OFF 120'
W.&M. Williams
5.2 Ac.
796-1108
E.&E. Jackson
516-1016
5.0 A
W.&J. Holmes
795-1063
9.6 Ac.
205
215.4
S.L. Vargo
5.0 Ac.
2-24-95
1008-442
10 A
~~978-844~~
5 Ac.
978-844
R.P.&L.M. Stewart
733-337
J.L.&E. Crawford
538-323
19.17 Ac.
738-186
J.L.&E. Crawford
SEE MAP C
J.P.&C.G. Porter
919-870
6.0 Ac.
580-364
19.6 Ac
Dominic J. Graziano
30.13 A
5 Ac.
15 A
491-26
R.E.&L. Yonce
W.&P. Nock
805-767
R.&J. Craven
23 A
597-1079
-1080
E.L.&S.A. Humphreys, Jr.
932-245
16.92 Ac.
2458.23'
R.T.&C.L. Jackson
980-629
633-432
17.05 Ac.
~~V.D.&P. Elder~~
~~974-687~~
10-26-95
M.A.&B.M. DiCello
1031-1137
15.243 Ac
2551.93'
300'
250.45'
254-36
W.J. Porter
637-282
25 Ac.
J.&E. Kenczler
513-846
25 Ac.
580-846
J. Eging
791-949
50 A
53 A
J. Johnson
Match Line
N
A B C D
E F G H
I J K L
M N O P

SCALE 1"=300'

JAN. 1, 1995

* Inadequate description

HUNTSBURG TWP.

RELATIVE REPRESENTATION

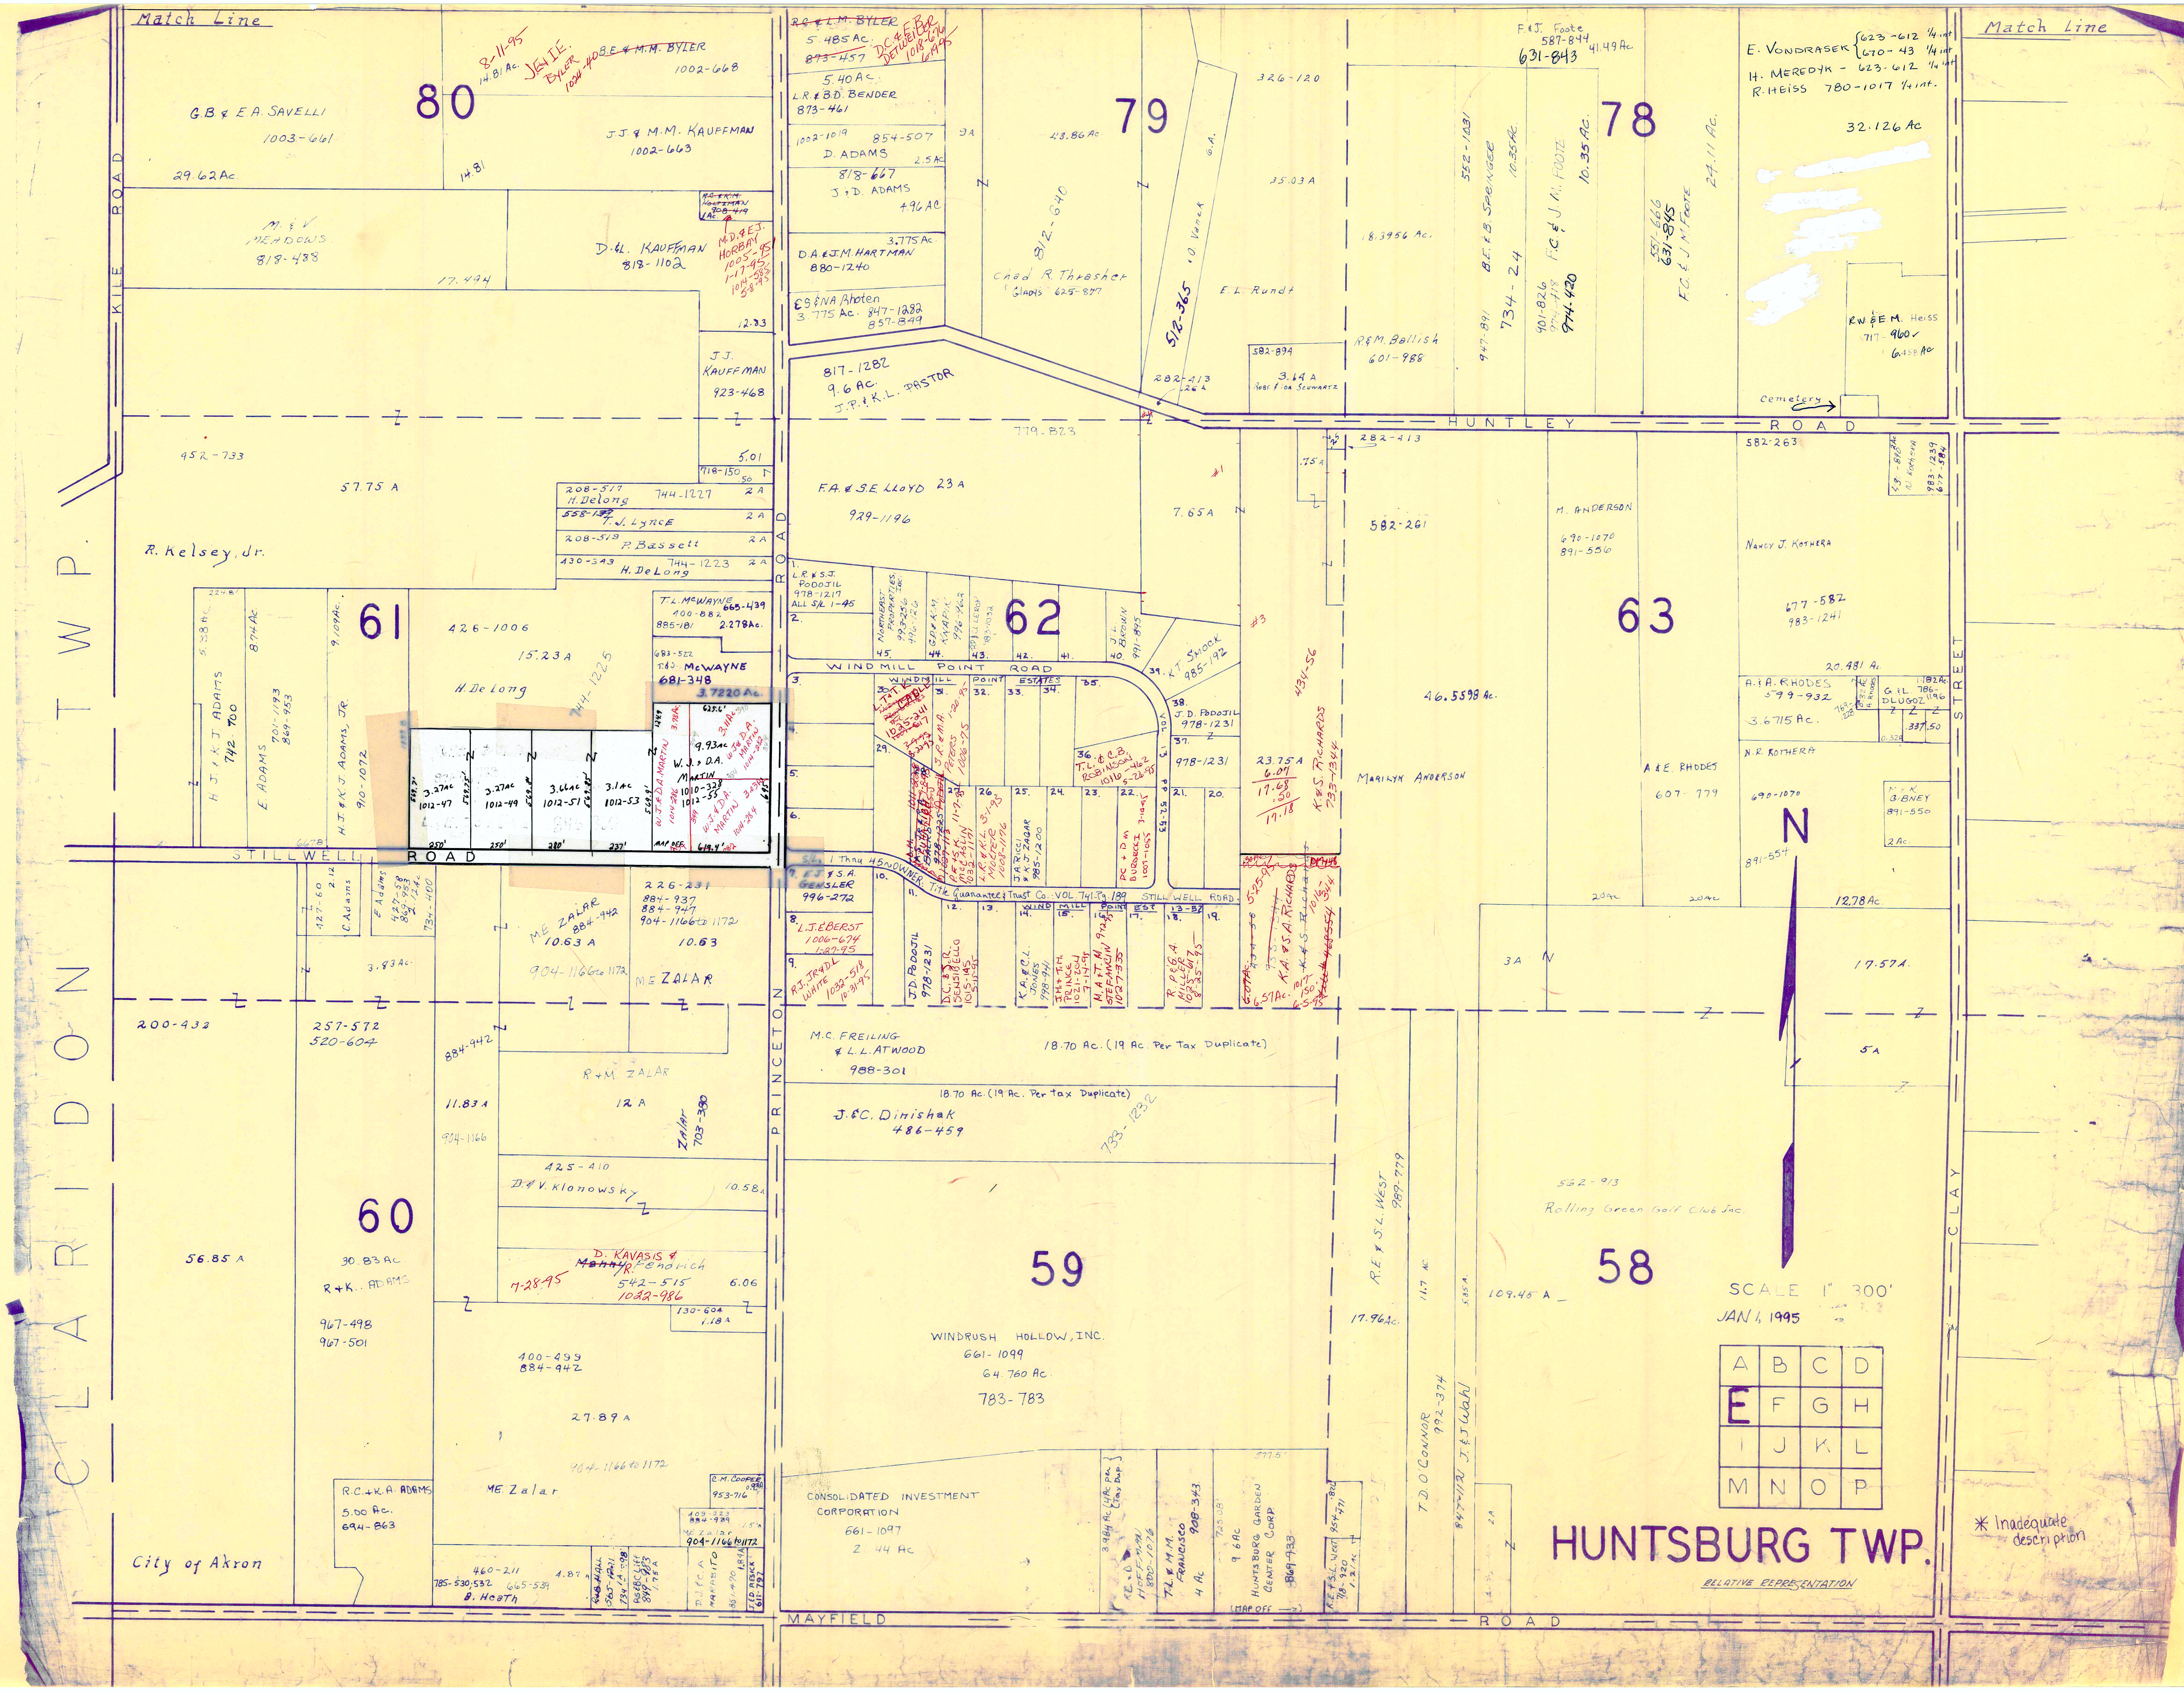

Match Line
Match Line
80
79
78
61
62
63
60
59
58
KILE ROAD
CLARIDON TWP.
PRINCETON ROAD
STILLWELL ROAD
HUNTLEY ROAD
WINDMILL POINT ROAD
CLAY STREET
MAYFIELD ROAD
G.B. & E.A. SAVELLI
1003-661
29.62 Ac.
8-11-95
14.81 Ac.
J.E. & I.E. BYLER
1024-408
~~B.E. & M.M. BYLER~~
1002-668
J.J. & M.M. KAUFFMAN
1002-663
14.81
M. & V. MEADOWS
818-488
17.494
D. & L. KAUFFMAN
818-1102
~~RC & K.M. HOLTZMAN 908-419~~
M.D. & E.J. HORBAY
1005-951
1-17-95
1014-585
5-8-95
12.83
J.J. KAUFFMAN
923-468
452-733
57.75 A
R. Kelsey, Jr.
5.01
718-150
208-517
H. DeLong
744-1227
2 A
558-139
T.J. Lynce
208-519
P. Bassett
430-343
744-1223
H. DeLong
T.L. McWAYNE
400-882
665-439
885-181
2.278 Ac.
683-522
T. & J. McWAYNE
681-348
3.7220 Ac.
426-1006
15.23 A
H. DeLong
744-1225
H.J. & K.J. ADAMS
742-700
5.38 Ac.
E. ADAMS
8.74 Ac.
701-1193
869-953
H.J. & K.J. ADAMS, JR.
9.109 Ac.
910-1072
3.27 Ac
1012-47
3.27 Ac
1012-49
3.66 Ac
1012-51
3.1 Ac
1012-53
W.J. & D.A. MARTIN
1010-328
1012-55
9.93 Ac
W.J. & D.A. MARTIN
1014-286
W.J. & D.A. MARTIN
1014-282
W.J. & D.A. MARTIN
1014-284
250'
250'
280'
237'
619.4'
625.6'
MAP OFF
~~R.C. & L.M. BYLER~~
5.485 Ac.
~~873-457~~
D.C. & E.B. DETWEILER
1018-676
6-19-95
5.40 Ac.
L.R. & B.D. BENDER
873-461
1002-1019
854-507
D. ADAMS
2.5 Ac
818-667
J. & D. ADAMS
4.96 Ac
D.A. & J.M. HARTMAN
880-1240
3.775 Ac
E.S. & N.A. Rhoten
3.775 Ac.
847-1282
857-849
817-1282
9.6 Ac.
J.P. & K.L. PASTOR
9A
23.86 Ac.
812-640
Chad R. Thrasher
Gladys 625-877
512-365
10 Vanek
6A.
326-120
35.03 A
E.L. Rundt
282-413
.26 A
582-894
3.14 A
Robt. & Ida Schwartz
F. & J. Foote
587-844
631-843
41.49 Ac
18.3956 Ac.
R. & M. Ballish
601-988
552-1031
B.E. & B. SPRINGER
947-891
734-24
10.35 Ac.
F.C. & J.M. FOOTE
401-826
974-418
974-420
10.35 Ac.
551-666
631-845
F.C. & J.M. FOOTE
24.11 Ac.
E. VONDRASEK 623-612 1/4 int.
670-43 1/4 int.
H. MEREDYK - 623-612 1/4 int.
R. HEISS 780-1017 1/4 int.
32.126 Ac
R.W. & E.M. Heiss
717-960
6.458 Ac
Cemetery
779-823
F.A. & S.E. LLOYD 23 A
929-1196
7.65 A
.75 A
282-413
582-261
46.5598 Ac.
L.R. & S.J. PODOJIL
978-1217
ALL S/L 1-45
NORTHEAST PROPERTIES, INC.
993-256
G.P. & K.M. KNAPIK
996-962
J.L. BROWN
991-895
K.T. SMOCK
985-192
J.D. PODOJIL
978-1231
978-1231
VOL 13 PP 52-53
T.L. & C.B. ROBINSON
1016-462
5-26-95
J.A. Ricci & K.J. Zagar
985-1200
P.C. & D.M. BURDECKI
1007-1055
L.R. & K.L. MOLTER
1008-1176
S.R. & M.A. PETERS
1006-75
R.E. & S.K. McCASLIN
1032-1171
S/L 1 Thru 45 OWNER: Title Guarantee & Trust Co. VOL. 741 Pg. 189 STILL WELL ROAD
E.J. & S.A. GENSLER
996-272
L.J. EBERST
1006-674
1-27-95
R.J. JR. & D.L. WHITE
1032-518
10-31-95
J.D. PODOJIL
978-1231
D.C. & S.R. SENSIBELLO
1015-145
K.A. & C.L. JONES
998-941
J.H. & T.M. PRINCE
1021-204
M.A. & T.M. STEFANCIN
1027-335
R. P. & G.A. MILLER
1025-617
8-25-95
WINDMILL POINT ESTATES
23.75 A
6.07
17.68
.50
17.18
K. & S. RICHARDS
733-1344
434-56
K.A. & S.A. RICHARDS
1016-344
6.57 Ac.
6.07 Ac.
5-25-95
M. ANDERSON
690-1070
891-556
Marilyn Anderson
A. & E. RHODES
607-779
582-263
Nancy J. Kothera
677-582
983-1241
20.481 Ac.
A. & A. RHODES
599-932
3.6715 Ac.
G. & L. DLUGOZ
786-1196
1.182 Ac.
N.R. KOTHERA
690-1070
891-554
M. & K. GIBNEY
891-550
2 Ac.
20 Ac
20 Ac
12.78 Ac.
3A
17.57A.
5A
N
427-60
2.12
C. Adams
E. Adams
427-58
869-953
2.12 Ac
734-400
3.83 Ac.
226-231
884-937
884-947
904-1166 to 1172
M.E. ZALAR
884-942
10.63 A
10.63
904-1166 to 1172
M.E. ZALAR
200-432
257-572
520-604
884-942
11.83 A
904-1166
R. & M. ZALAR
12 A
Zalar
703-380
425-410
D. & V. Klonowsky
10.58 A
D. KAVASIS & R. Fendrich
~~Manny~~
7-28-95
542-515
1022-986
6.06
130-604
1.18 A
56.85 A
30.83 Ac
R. & K. ADAMS
967-498
967-501
400-499
884-942
27.89 A
904-1166 to 1172
R.C. & K.A. ADAMS
5.00 Ac.
694-863
M.E. Zalar
C.M. COOPER
0.93 A
953-716
409-223
884-939
M.E. Zalar
1.5 A
904-1166 to 1172
City of Akron
460-211
4.87 A
785-530, 532
665-539
B. Heath
R. & B. HALL
565-1121
734-1398
R.S. & B.C. LIFF
849-983
1.75 A
D.J. & C.A. MARABITO
851-470
1.84 A
J. & D. RESICK
611-797
M.C. FREILING & L.L. ATWOOD
988-301
18.70 Ac. (19 Ac. Per Tax Duplicate)
18.70 Ac. (19 Ac. Per tax Duplicate)
J. & C. Dinishak
486-459
733-1232
WINDRUSH HOLLOW, INC.
661-1099
64.760 Ac.
783-783
CONSOLIDATED INVESTMENT CORPORATION
661-1097
2.44 Ac
3.984 Ac (4 Ac per Tax Dup.)
R.E. & D. HOFFMAN
809-1076
T.L. & M.M. FRANCISCO
908-343
4 Ac
9.6 Ac
HUNTSBURG GARDEN CENTER CORP
869-933
(MAP OFF →)
R.E. & S.L. West
954-471
718-920
1.21 Ac.
R.E. & S.L. WEST
989-779
17.96 Ac.
11.7 Ac.
T.D. O'CONNOR
992-374
847-1112 J. & J. Wahl
5.85 A.
2A
109.45 A
562-913
Rolling Green Golf Club Inc.
A B C D
E F G H
I J K L
M N O P

HUNTSBURG TWP.

RELATIVE REPRESENTATION

SCALE 1" 300'

JAN 1, 1995

* Inadequate description

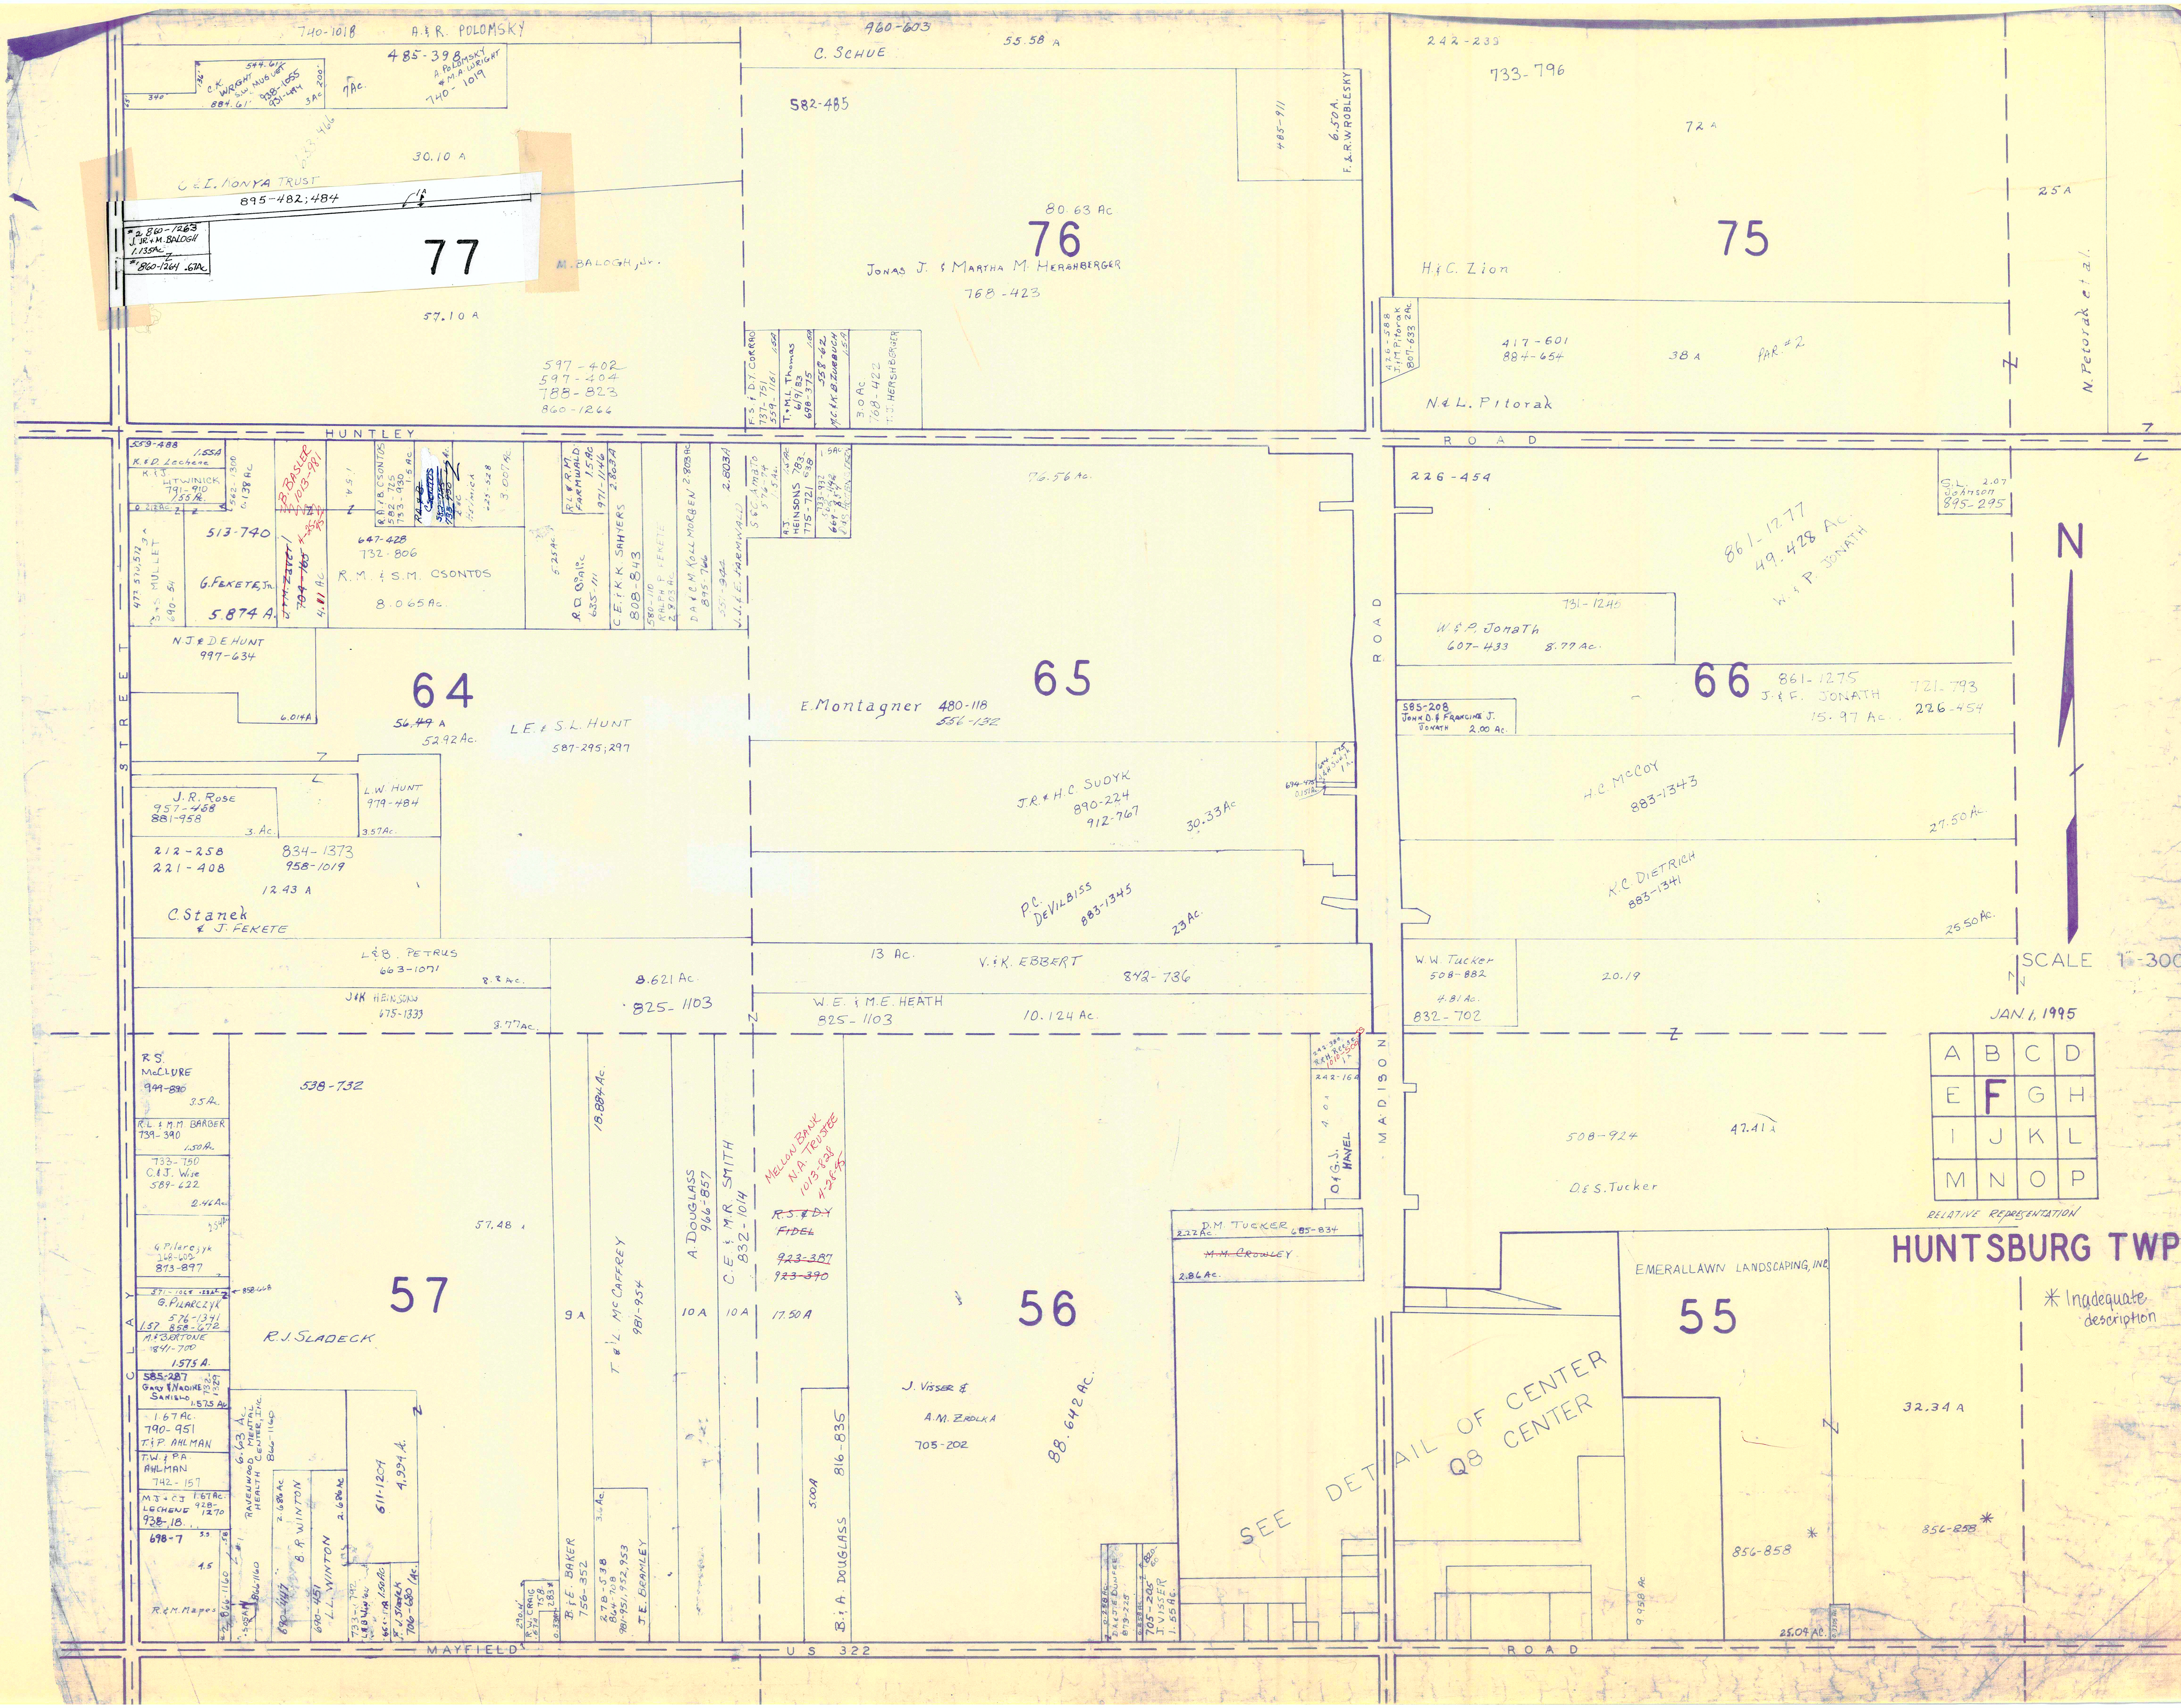

740-1018
A.&R. POLOMSKY
485-398
C.K. WRIGHT
884-61
7Ac.
30.10 A
C.&E. MONYA TRUST
895-482;484
77
M. BALOGH, Jr.
57.10 A
597-402
597-404
788-823
860-1263
960-603
C. SCHUE
55.58 A
582-485
485-911
6.50 A.
F.&R.W. ROBLESKY
80.63 Ac
76
JONAS J. & MARTHA M. HERSHBERGER
768-423
242-233
733-796
72 A
75
H&C. Zion
25 A
417-601
884-654
38 A
PAR #2
N&L. Pitorak
N. Pitorak et al.
HUNTLEY
ROAD
CLAY STREET
MADISON ROAD
559-488
K.&D. Lechene
LITWINICK
791-910
513-740
G. FEKETE, Jr.
5.874 A.
R.M. & S.M. CSONTOS
647-428
732-806
8.065 Ac.
NJ & DE HUNT
997-634
6.014 A
64
56.49 A
52.92 Ac.
L.E. & S.L. HUNT
587-295;297
L.W. HUNT
979-484
J.R. Rose
957-468
881-958
212-258
221-408
834-1373
958-1019
12.43 A
C. Stanek
& J. FEKETE
L.&B. PETRUS
663-1071
J&K HEINSOHN
675-1339
8.621 Ac.
825-1103
E. Montagner
480-118
556-132
65
J.R. & H.C. SUDYK
890-224
912-767
30.33 Ac
P.C. DeVILBISS
883-1345
23 Ac.
13 Ac.
V.&K. EBBERT
842-736
W.E. & M.E. HEATH
825-1103
10.124 Ac.
226-454
861-1277
49.428 Ac.
W.&P. JONATH
S.L. Johnson
895-295
731-1245
W.&P. Jonath
607-433
8.77 Ac.
66
861-1275
J.&F. JONATH
15.97 Ac.
721-793
226-454
585-208
John D. & Francine J. Jonath
2.00 Ac.
H.C. McCOY
883-1343
27.50 A
K.C. DIETRICH
883-1341
25.50 A
W.W. Tucker
508-882
4.81 Ac.
832-702
20.19
N
SCALE 1"=300'
JAN 1, 1995
A B C D
E F G H
I J K L
M N O P
RELATIVE REPRESENTATION
HUNTSBURG TWP
* Inadequate description
R.S. McCLURE
949-890
R.L. & M.M. BARBER
739-390
C.&J. Wise
589-622
538-732
57.48
57
R.J. SLADECK
G. PILARCZYK
576-1341
T&P AHLMAN
790-951
R.&M. Mapes
18.884 Ac.
T.&L. McCAFFREY
981-954
A. DOUGLASS
966-857
C.E. & M.R. SMITH
832-1014
MELLON BANK N.A. TRUSTEE 1013-828 4-28-95
~~R.S. & D.Y. FIDEL~~
~~923-387~~
~~923-390~~
17.50 A
9 A
10 A
10 A
B.&E. BAKER
756-352
J.E. BEAMLEY
B.&A. DOUGLASS
816-835
J. VISSER &
A.M. ZROLKA
705-202
56
88.642 Ac.
O.&G.J. HANEL
D.M. TUCKER
685-834
~~M.M. CROWLEY~~
SEE DETAIL OF CENTER Q8 CENTER
508-924
47.41
D.&S. Tucker
EMERALLAWN LANDSCAPING, INC.
55
32.34 A
856-858 *
856-858
25.09 Ac.
MAYFIELD
US 322
ROAD

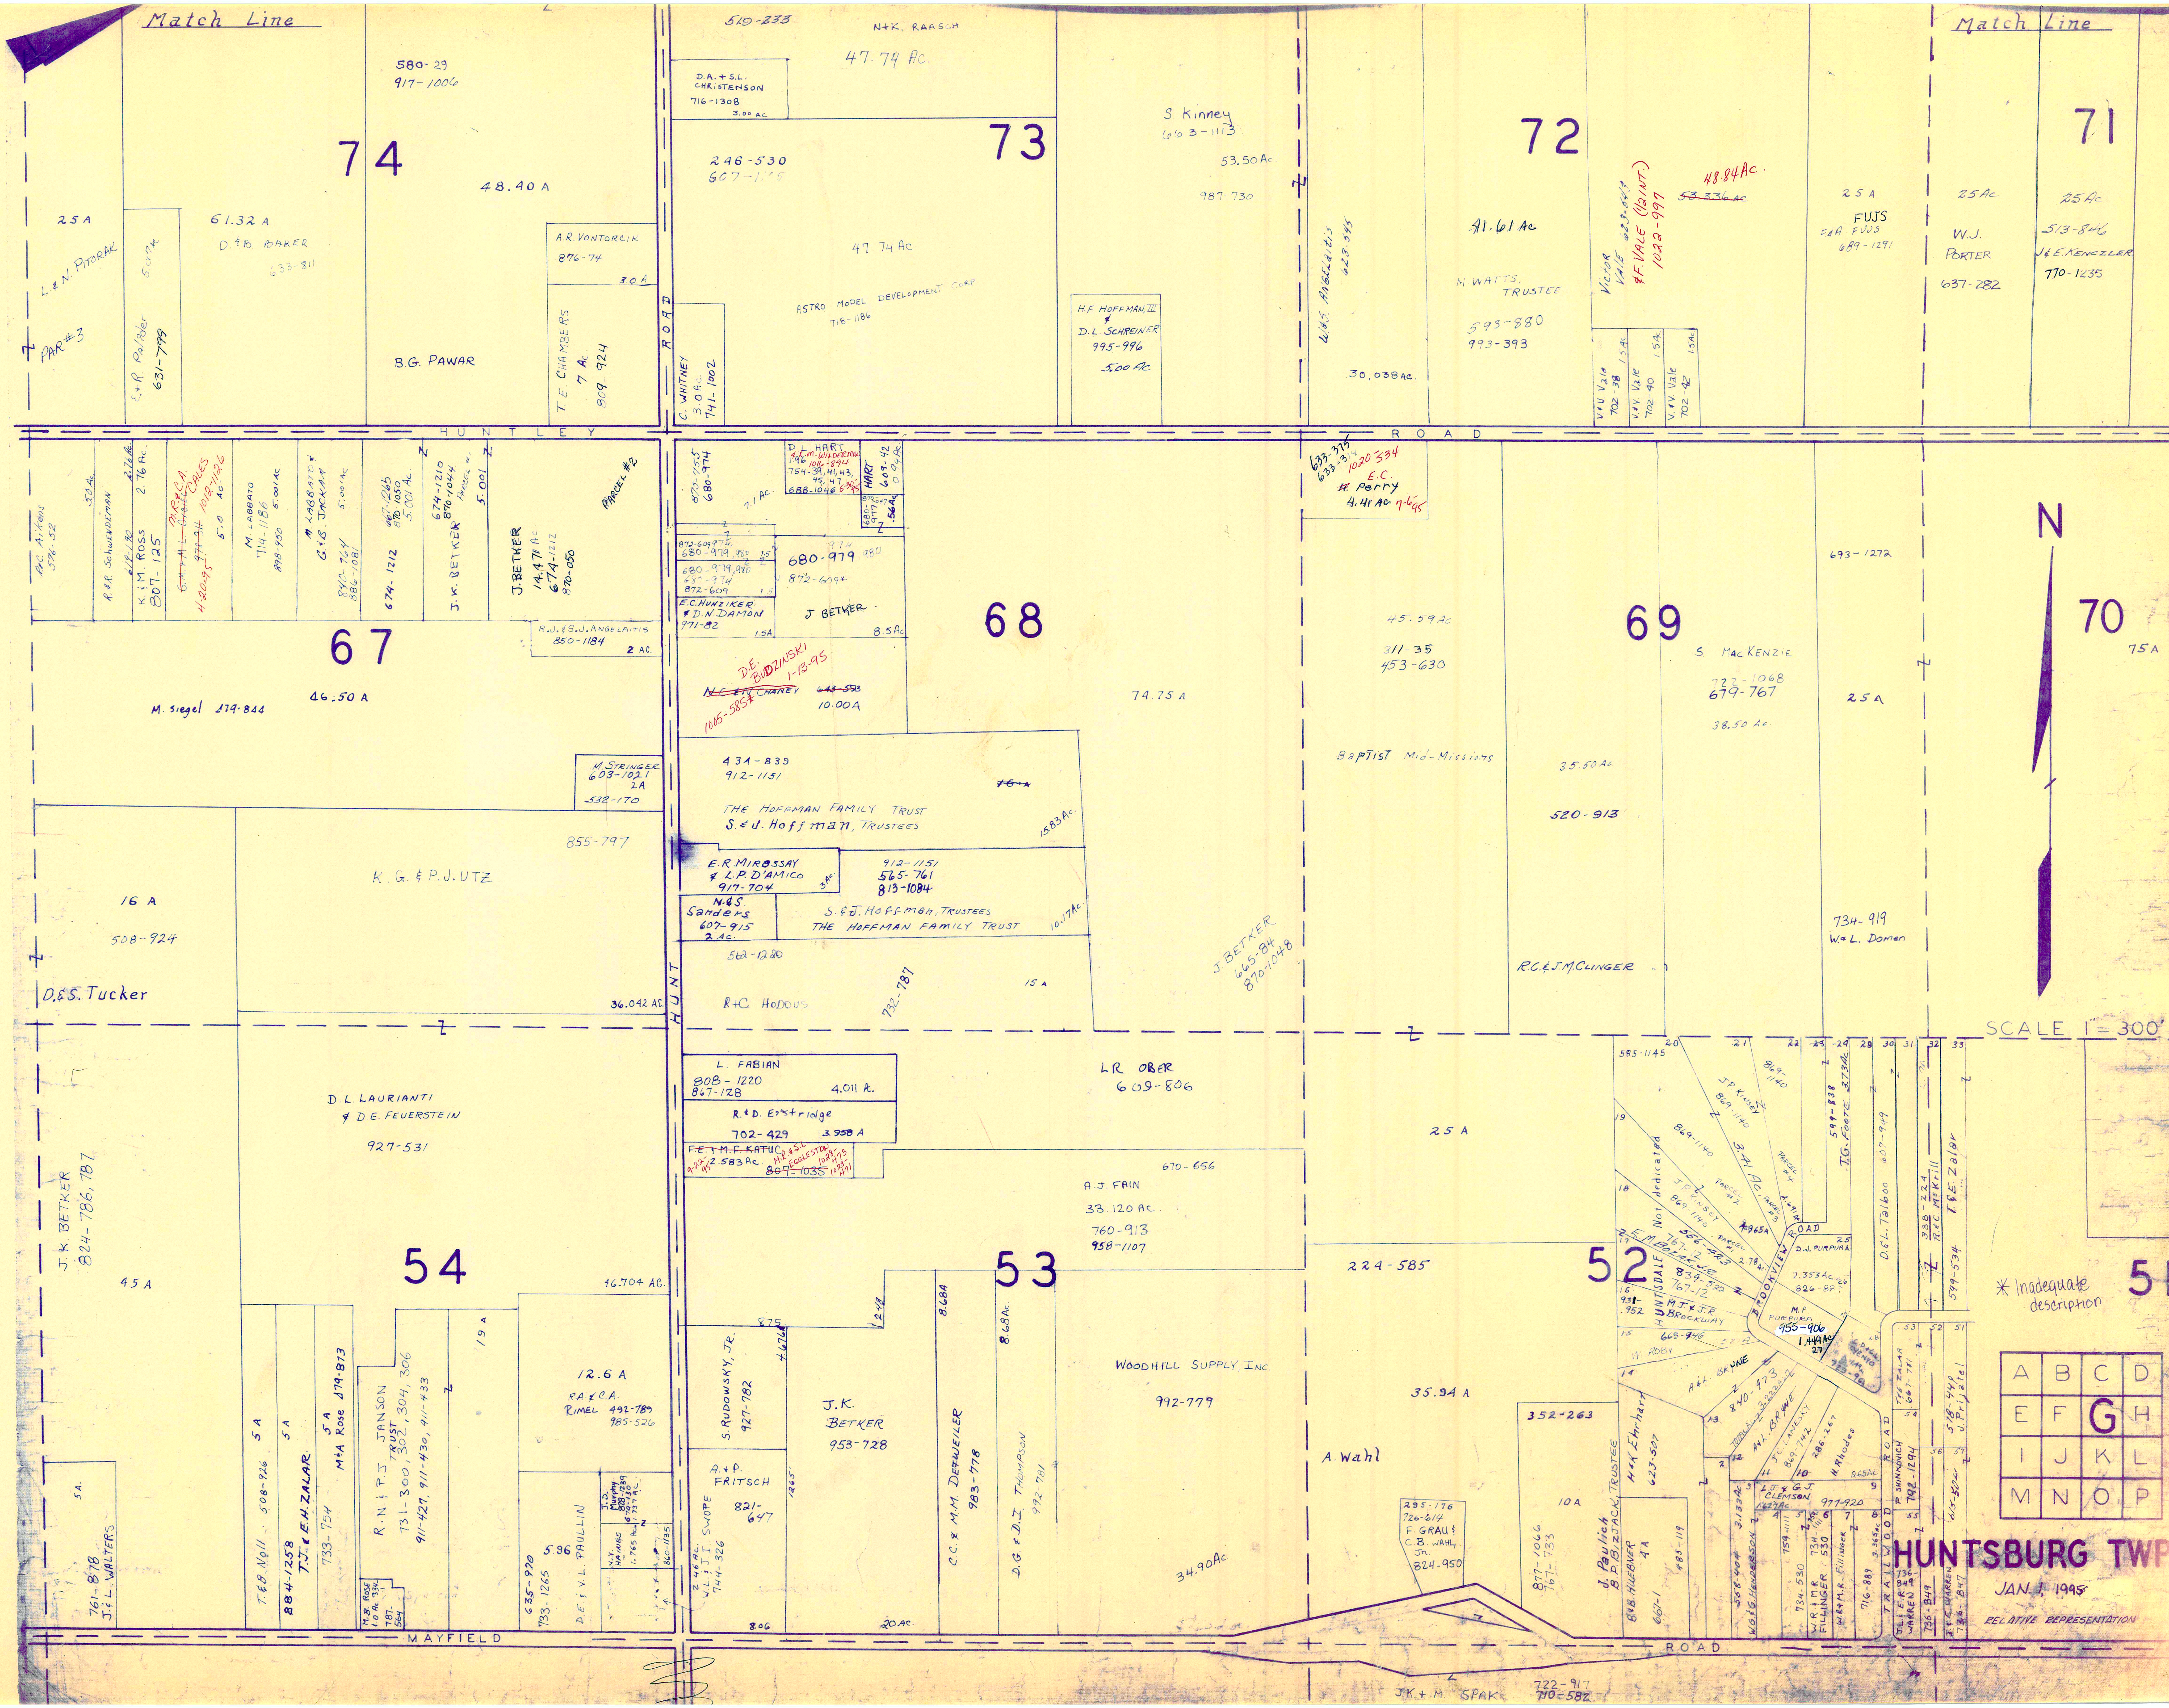

Match Line
Match Line
74
73
72
71
67
68
69
70
54
53
52
N
SCALE 1" = 300'
HUNTLEY ROAD
HUNT ROAD
MAYFIELD ROAD
580-29
917-1006
48.40 A
61.32 A
D & B BAKER
25 A
L & N PITORAK
PAR #3
S & R Poindexter
631-799
B.G. PAWAR
A.R. VONTORCIK
876-74
3.0 A
T.E. CHAMBERS
7 A
909-924
C. WHITNEY
3.0 Ac
741-1002
519-233
N & K RAASCH
47.74 Ac
D.A. & S.L. CHRISTENSON
716-1308
3.00 Ac
246-530
47.74 Ac
ASTRO MODEL DEVELOPMENT CORP
718-1186
H.F. HOFFMAN III & D.L. SCHREINER
995-996
5.00 Ac
S Kinney
53.50 Ac
987-730
30.038 Ac
41.61 Ac
M. WATTS TRUSTEE
593-880
993-393
Victor Vale
F. VALE (Joint)
1022-997
48.84 Ac
~~53.336 Ac~~
25 A
FUJS
F & A FUJS
689-1291
25 Ac
W.J. PORTER
637-282
25 Ac
513-846
J & E KENEZLER
770-1235
M. Siegel 479-844
46.50 A
R.J. & S.J. ANGELAITIS
850-1184
2 AC
J. BETKER
14.471 Ac
674-1212
870-050
PARCEL #2
M. STRINGER
603-1021
1 A
532-170
K. G. & P.J. UTZ
855-797
16 A
508-924
D. & S. Tucker
36.042 AC
D.L. HART
680-979
872-609
E. HUNZIKER & D.N. DAMON
971-82
1.5 A
J BETKER
8.5 Ac
D.E. BUDZINSKI 1-13-95
~~N.C. & H~~ CHANEY
10.00 A
1065-585
434-839
912-1151
THE HOFFMAN FAMILY TRUST
S & J. Hoffman, Trustees
15.83 Ac
E.R. MIROSSAY & L.P. D'AMICO
917-704
912-1151
565-761
813-1084
N. & S. Sanders
607-915
2 Ac
S & J. Hoffman, Trustees
THE HOFFMAN FAMILY TRUST
10.17 Ac
562-1280
R & C Hodous
782-787
15 A
74.75 A
E.C. Perry
4.41 Ac
1020-534
45.59 Ac
311-35
453-630
Baptist Mid-Missions
J. BETKER
665-94
870-1048
35.50 Ac
520-913
R.C. & J.M. CLINGER
S MacKENZIE
679-767
38.50 Ac
693-1272
25 A
734-919
W. & L. Domen
75 A
D.L. LAURIANTI & D.E. FEUERSTEIN
927-531
J.K. BETKER
824-786, 787
45 A
46.704 AC
5 A
J. & L. WALTERS
761-878
T. & B. Noll
508-926
884-1258
T.J. & E.H. ZALAR
733-754
M & A Rose 479-873
R.N. & P.J. JANSON TRUST
731-300, 302, 304, 306
911-427, 911-430, 911-433
19 A
12.6 A
R.A. & C.A. RIMEL
492-789
985-526
635-970
733-1265
5.96
D.E. & V.L. PAULLIN
L. FABIAN
808-1220
867-128
4.011 A
R. & D. Eastridge
702-429
3.958 A
F.E. & M.F. KATUC
2.583 Ac
807-1035
S. RUDOWSKY, JR.
927-782
A & P FRITSCH
821-647
J.L. & J.I. SWOPE
744-326
J.K. BETKER
953-728
C.C. & M.M. DETWEILER
983-778
8.68 A
D.G. & D.I. THOMPSON
992-781
L.R. OBER
609-806
670-656
A.J. FAIN
33.120 Ac
760-913
958-1107
WOODHILL SUPPLY, Inc
992-779
34.90 Ac
25 A
224-585
35.94 A
A. Wahl
295-176
720-614
F. GRAU & C.B. WAHL
824-950
352-263
10 A
877-1066
J. Paulick
TRUSTEE
BROOKVIEW ROAD
TRAILWOOD ROAD
HUNTSDALE
Not dedicated
585-1145
D.J. PURPURA
M.F. PURPURA
955-906
1.449 Ac
L.J. & G.J. CLEMSON
977-920
J.P. Kinney
T.G. Foote
D. & L. Tibbon
J.K. & M. SPAK
722-917
710-582
* Inadequate description
A B C D
E F G H
I J K L
M N O P

HUNTSBURG TWP

JAN. 1, 1995

RELATIVE REPRESENTATION

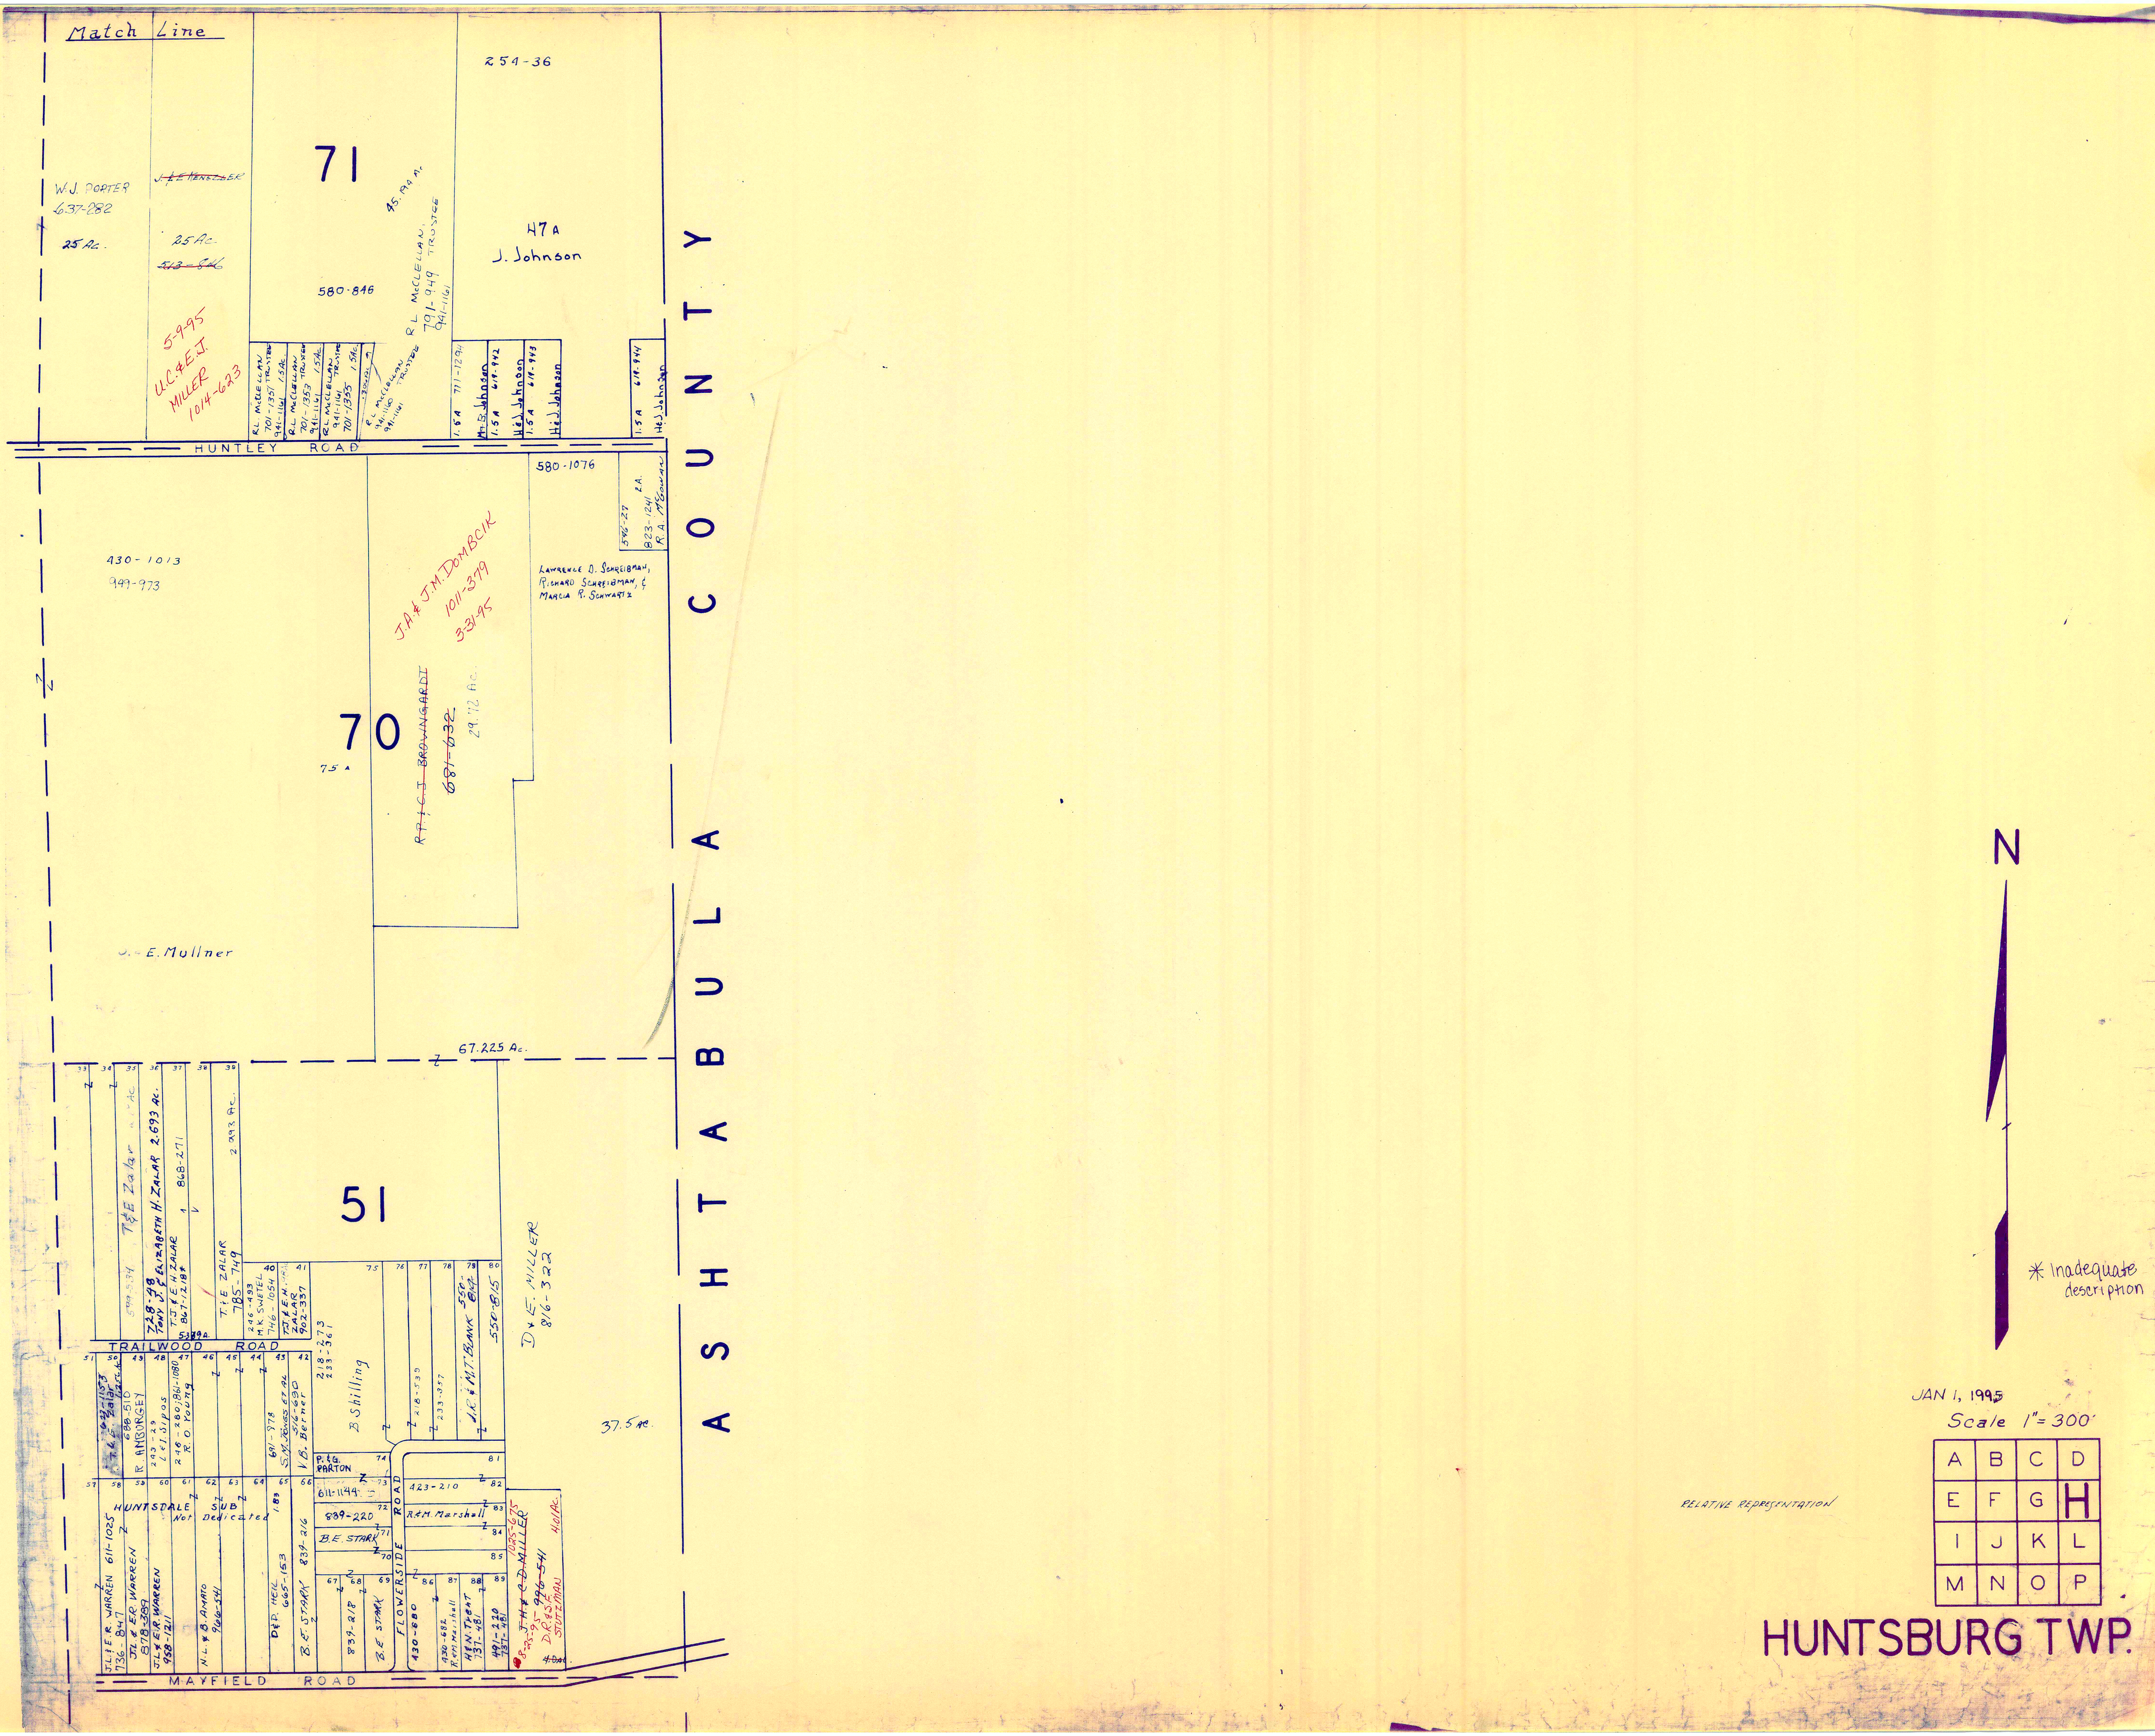
Match Line
254-36
71
W.J. PORTER
637-882
25 Ac.
~~J.E. HENSLER~~
25 Ac.
~~513-846~~
5-9-95
U.C.& E.J.
MILLER
1014-623
45.90 Ac.
580-846
R L McCLELLAN TRUSTEE
791-949
941-1161
47 A
J. Johnson
R.L. McCLELLAN TRUSTEE 701-1351 941-1161 1.5 Ac.
R.L McCLELLAN TRUSTEE 701-1353 941-1161 1.5 Ac.
R.L. McCLELLAN TRUSTEE 941-1161 701-1355 1.5 Ac.
.306 Ac
R.L McCLELLAN TRUSTEE 941-1160 941-1161
1.5 A 771-1294 M.&B. Johnson
1.5 A 619-942 H.&J. Johnson
1.5 A 619-943 H.&J. Johnson
1.5 A 619-944 H.&J. Johnson
HUNTLEY ROAD
580-1076
546-27 2 A. 823-1241 R.A. McGOWAN
430-1013
999-973
LAWRENCE D. SCHREIBMAN, RICHARD SCHREIBMAN, & MARCIA R. SCHWARTZ
J.A.& J.M. DOMBCIK
1011-379
3-31-95
~~R.P. & C.J. BRAUNGARDT~~
~~681-632~~
29.72 Ac.
70
75 A
E. Mollner
67.225 Ac.
33 34 35 36 37 38 39
T&E Zalar
599-534
728-98
TONY J. & ELIZABETH H. ZALAR 2.693 Ac.
T.J. & E.H. ZALAR 867-1218*
868-271
5.389 A.
T.&E. ZALAR 785-749
2.993 Ac.
51
40 246-493 M.K. SWETEL 746-1054
41 T.J. & E.H. ZALAR 902-337
218-273
233-361
75 76 77 78 79 80
B. Shilling
218-539
233-357
J.R. & M.T. BLANK 550-814
550-815
D & E. MILLER
816-322
37.5 Ac.
TRAILWOOD ROAD
51 50 49 48 47 46 45 44 43 42
T.&E. Zalar 622-1153 1.256 Ac.
R. AMBORGEY 688-510
293-29 L.&I. Sipos
246-280; 861-1080 R.O. YOUNG
691-978 S.M. JONGS ET AL
516-690 V.B. Berner
P.&G. PARTON 74
611-1144 73
839-220 72
B.E. STARK 71
70
81
423-210 82
R.&M. Marshall 83
84
85
57 58 59 60 61 62 63 64 65 66
HUNTSDALE SUB Not Dedicated
J.L.&E.R. WARREN 611-1025 736-847
J.L.&E.R. WARREN 878-389
J.L.&E.R. WARREN 958-1211
N.L.&B. AMATO 966-541
1.83
D.&P. HEIL 665-153
B.E. STARK 839-216
67 68 69
839-218
B.E. STARK
FLOWERSIDE ROAD
86 430-680
87 430-682 R.&M. Marshall
88 H.&N. Tront 737-481
89 491-220 737-481
~~J.H. & C.D. MILLER~~
1025-675
8-25-95 ~~996-541~~
D.R.&S.F. STUTZMAN
4.01 Ac.
~~4.0 Ac.~~
MAYFIELD ROAD
ASHTABULA COUNTY
N
* Inadequate description
RELATIVE REPRESENTATION
A B C D
E F G H
I J K L
M N O P

JAN 1, 1995

Scale 1" = 300'

HUNTSBURG TWP.

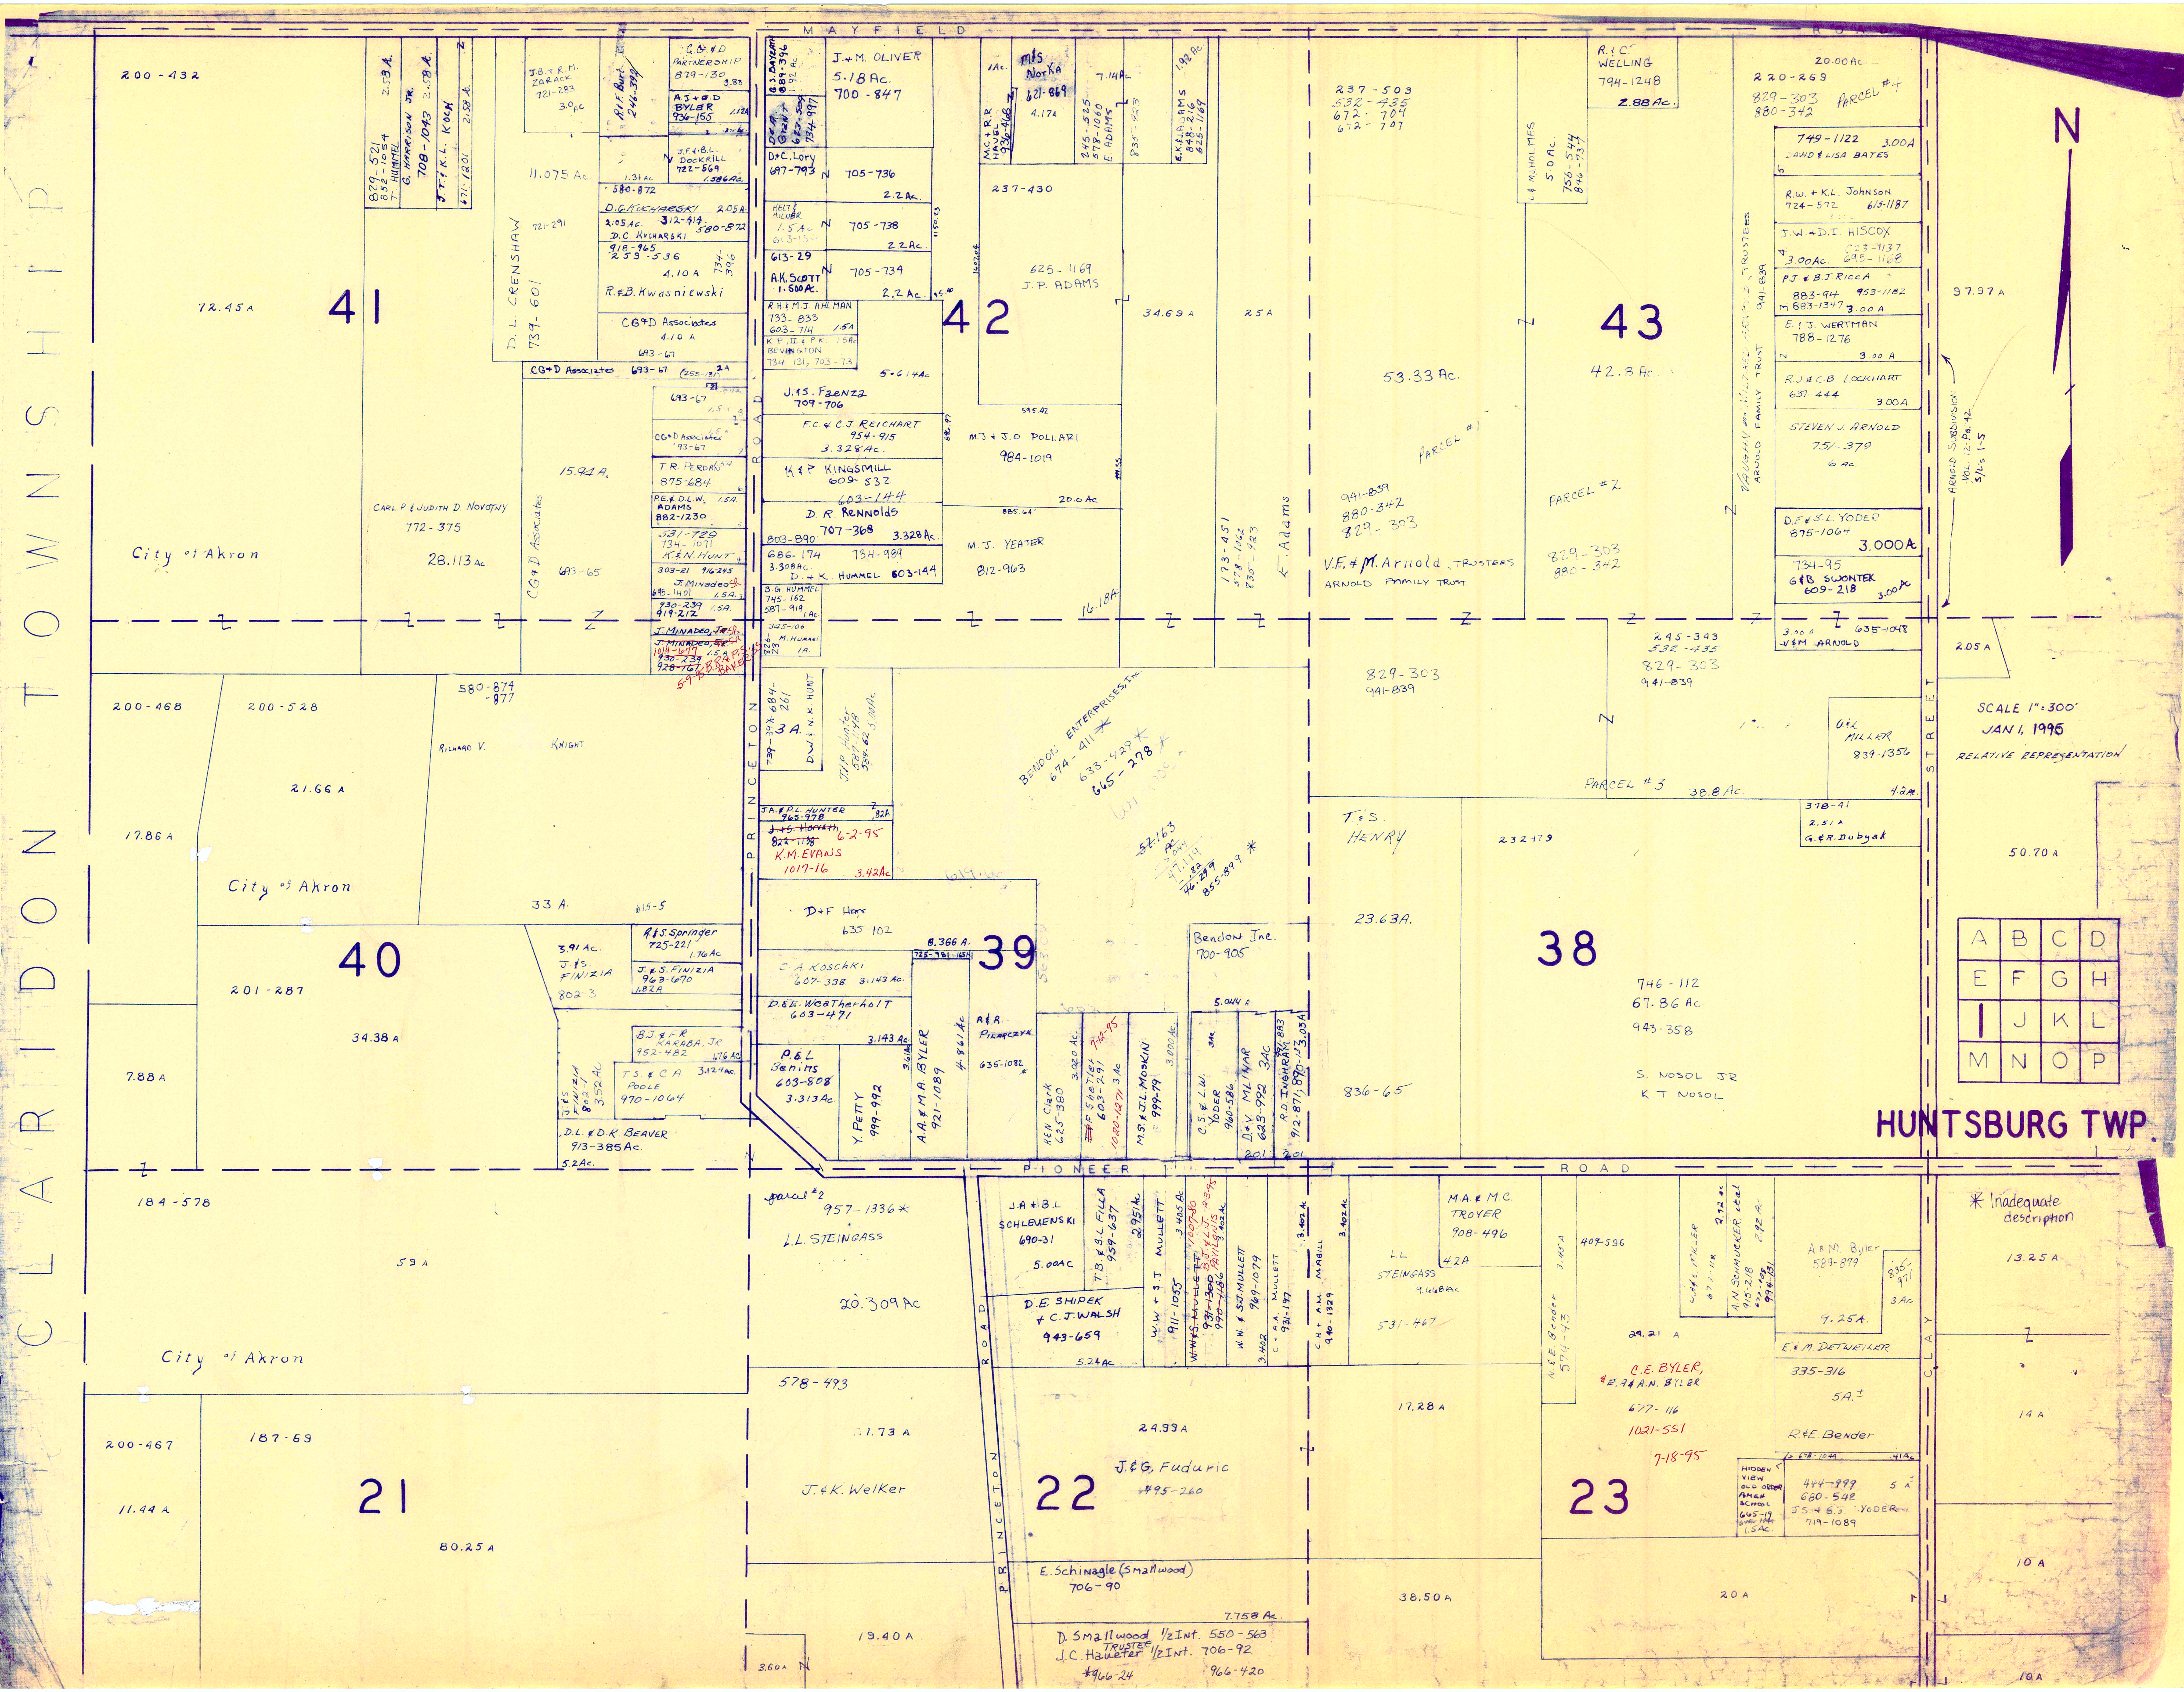
MAYFIELD ROAD
CLARIDON TOWNSHIP
HUNTSBURG TWP.
PRINCETON ROAD
PIONEER ROAD
CLAY STREET
N
SCALE 1"=300'
JAN 1, 1995
RELATIVE REPRESENTATION
* Inadequate description
A B C D
E F G H
I J K L
M N O P
41
42
43
40
39
38
21
22
23
200-432
72.45 A
City of Akron
829-521
852-1054
T. HUMMEL
G. HARRISON JR.
708-1043
J.F.&K.L. KOCH
471-1201
11.075 Ac
J.B.&R.M. ZARACK
721-283
D.L. CRENSHAW
734-601
CG&D PARTNERSHIP
879-130
A.J.&B.D. BYLER
934-155
D.G.KUCHARSKI
D.C. KUCHARSKI
918-965
259-536
4.10 A
R.&B. Kwasniewski
CG&D Associates
4.10 A
693-67
CG&D Associates
15.94 A
CARL P. & JUDITH D. NOVOTNY
772-375
28.113 Ac
CG&D Associates
693-65
T.R. PERDUE
875-684
P.E.&D.L.W. ADAMS
882-1230
K.&N. HUNT
J. Minadeo
J. MINADEO, JR.
J.&M. OLIVER
5.18 Ac.
700-847
D.&C. Lory
697-793
705-736
705-738
613-29
A.K. SCOTT
1.500 A.
705-734
R.H.&M.J. AHLMAN
733-833
603-714
K.P.II & P.K. BEVINGTON
J.&S. FRENZ
709-706
F.C.&C.J. REICHART
954-915
3.328 Ac.
K.&P. KINGSMILL
609-532
D.R. Rennolds
707-368
3.328 Ac.
686-174
734-989
D.&K. HUMMEL
603-144
B.G. HUMMEL
M. HUMMEL
m/s Norka
M.C.&R.R. HAUSER
245-535
579-1060
E. ADAMS
E.K.&R.M. ADAMS
237-430
625-1169
J.P. ADAMS
34.69 A
25 A
M.J.&J.O. POLLARI
984-1019
20.0 Ac
M.J. YEATER
812-963
16.18 A
E. Adams
237-503
532-435
672-709
612-707
53.33 Ac.
PARCEL #1
941-839
880-342
829-303
V.F.&M. Arnold, TRUSTEES
ARNOLD FAMILY TRUST
R.&C. WELLING
794-1248
2.88 Ac.
42.3 Ac
PARCEL #2
829-303
880-342
20.00 Ac
220-263
829-303
880-342
PARCEL #4
749-1122
3.00 A
DAVID & LISA BATES
R.W.&K.L. Johnson
724-572
615-1187
J.W.&D.T. HISCOX
PJ & BJ RICCA
883-94
E.&J. WERTMAN
788-1276
R.J.&C.B. LOCKHART
651-444
STEVEN J. ARNOLD
751-379
6 Ac
D.E.&S.L. YODER
875-1064
3.000 A
734-95
G.&B. SWONTEK
609-218
V.&M. ARNOLD
635-1098
ARNOLD FAMILY TRUST
ARNOLD SUBDIVISION VOL. 12 PG. 42 S/L's 1-5
97.97 A
2.05 A
200-468
17.86 A
200-528
21.66 A
City of Akron
580-874 -877
RICHARD V. KNIGHT
33 A.
R.&S. Springer
725-221
J.&S. FINIZIA
963-670
201-287
34.38 A
7.88 A
B.J.&R. KARABA, JR
952-482
T.S.&C.A. POOLE
970-1064
D.L.&D.K. BEAVER
913-385 Ac.
D.W.&N.K. HUNT
J.&A.P.L. HUNTER
965-978
J.&S. Horvath
K.M. EVANS
1017-16
6-2-95
D.&F. Hoor
635-102
C.A. KOSCHKI
607-338
D.E. Weatherholt
603-471
P.&L. Semins
603-808
3.313 Ac
Y. PETTY
999-992
A.A.&M.A. BYLER
721-1089
R.&R. Pikarczyk
635-1082
BENDON ENTERPRISES, INC
674-411 *
633-427 *
665-278 *
Bendon Inc.
700-905
KEN CLARK
625-380
M.S.&J.L. MOSKIN
999-79
C.S.&L.W. YODER
960-586
D.&V. MILNAR
623-992
R.D. INGHRAM
829-303
941-839
PARCEL #3
38.8 Ac
G.&L. MILLER
839-1356
G.&R. Dubyak
T.&S. HENRY
23.63A.
836-65
746-112
67.36 Ac
943-358
S. NOSOL JR
K.T. NOSOL
50.70 A
184-578
59 A
City of Akron
200-467
11.44 A
187-69
80.25 A
Parcel #2
957-1336 *
L.L. STEINGASS
20.309 Ac
578-493
21.73 A
J.&K. Welker
19.40 A
3.60 A
J.A.&B.L. SCHLEVENSKI
690-31
5.00 Ac
T.B.&S.L. FILLA
959-637
D.E. SHIPEK & C.J. WALSH
943-659
MULLETT
W.W.&J.T. MULLETT
J.&G. Fudurie
24.99 A
795-260
E. Schinagle (Smallwood)
706-90
D. Smallwood 1/2 Int. 550-563
J.C. Hauser TRUSTEE 1/2 Int. 706-92
966-24
966-420
7.758 Ac
MABILL
M.A.&M.C. TROYER
908-496
L.L. STEINGASS
531-467
17.28 A
38.50 A
N.&E. Bender
574-43
409-596
C.E. BYLER
E.&A.N. BYLER
677-116
1021-551
7-18-95
A.N. SCHMUCKER et al
A.&M. Byler
589-879
9.25 A
E.&M. DETWEILER
335-316
5 A
R.&E. Bender
HIDDEN VIEW OLD ORDER AMISH SCHOOL
444-999
680-548
J.S.&E.S. YODER
719-1089
20 A
13.25 A
14 A
10 A
10 A

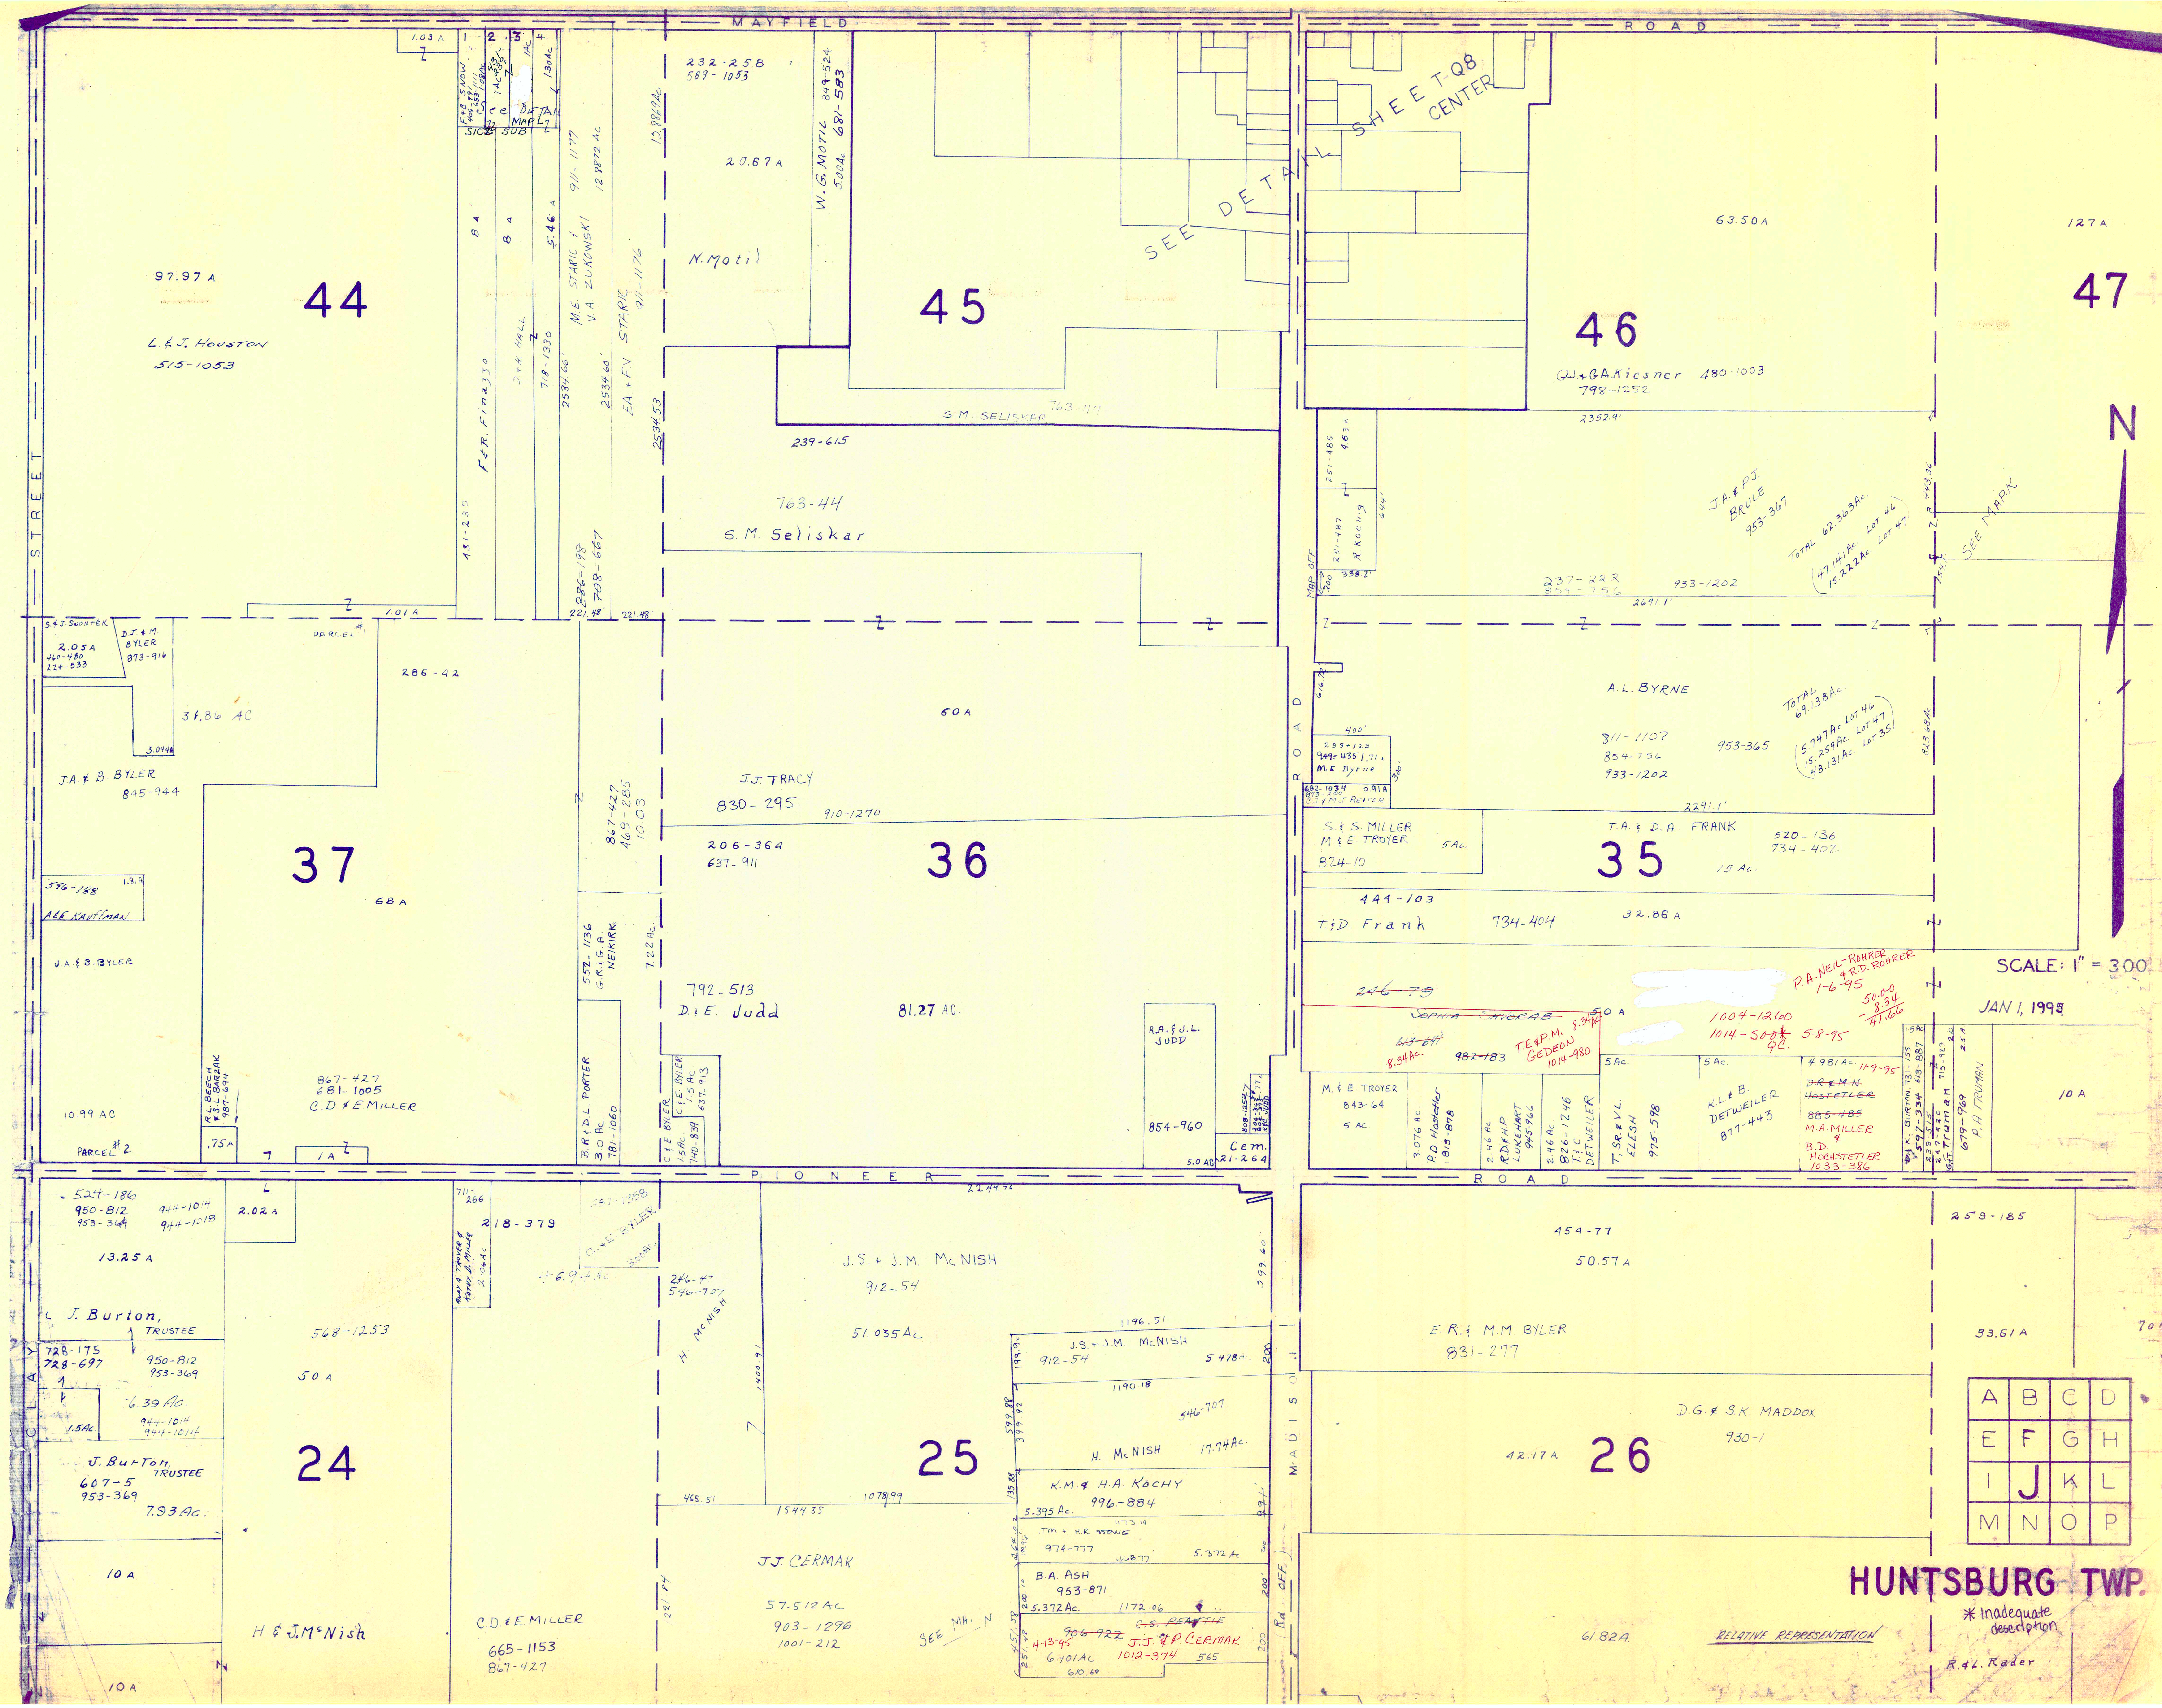

HUNTSBURG TWP.

SCALE: 1" = 300'

JAN 1, 1995

* Inadequate description

RELATIVE REPRESENTATION

R.&L. Rader

MAYFIELD ROAD
PIONEER ROAD
CLAY STREET
MADISON ROAD
SEE DETAIL SHEET T-Q8 CENTER
44
45
46
47
37
36
35
24
25
26
N
97.97 A
L & J. Houston
515-1053
1.03 A
SICE SUB
SEE DETAIL MAP
F & R. Finazzo
131-239
8 A
24 HALL
718-1330
5.46 A
M.E. STARIC & V.A. ZUKOWSKI
911-1177
12.872 AC
2534 60
EA & FV STARIC
911-1176
12.98 / 2 AC
2534 53
286-198
708-667
232-258
589-1053
20.67 A
N. Moti
W.G. MOTIL
849-524
681-583
5.00 AC
S.M. SELISKAR
763-44
239-615
S.M. Seliskar
63.50 A
G.L. & G.A. Kiesner
480-1003
798-1252
2352.9'
127 A
251-486
46.3 A
251-482
R. Kochy
J.A. & P.J. SPRULE
953-367
TOTAL 62.363 AC
47.141 AC LOT 46
15.222 AC LOT 47
237-228
933-1202
2691.1'
SEE MARK
1.01 A
S.A.J. SWONTEK
2.05 A
D.J. & M. BYLER
873-916
PARCEL 4
286-42
34.86 AC
3.04 A
J.A. & B. BYLER
845-944
68 A
596-188
A & E KAUFFMAN
1.31 A
J.A. & B. BYLER
10.99 AC
PARCEL 2
R.L. BEECH & S.L. BARZAK
.75 A
1 A
867-427
681-1005
C.D. & E. MILLER
867-427
469-285
1003
552-1136
G.R. & G.A. NEIKIRK
7.22 AC
B.R. & D.L. PORTER
30 AC
781-1060
C.E. BYLER
15 AC
740-839
60 A
J.J. TRACY
830-295
910-1270
206-364
637-911
792-513
D. & E. Judd
81.27 AC.
R.A. & J.L. JUDD
854-960
Cem.
5.0 AC
A.L. BYRNE
811-1107
854-756
933-1202
953-365
TOTAL 69.138 AC
5.747 AC LOT 46
15.259 AC LOT 47
48.131 AC LOT 35
400'
239-130
M.E. Byrne
M.J. Reiter
0.91 A
2291.1'
S. & S. MILLER
M. & E. TROYER
5 AC.
824-10
T.A. & D.A. FRANK
520-136
734-407
15 AC.
441-103
T. & D. Frank
734-404
32.86 A
~~246-79~~
~~Sophia Morab~~
~~613-64~~
8.34 Ac.
982-183
T.E. & P.M. GEDEON
1014-980
8.34
P.A. NEIL-ROHRER & R.D. ROHRER
1-6-95
1004-1260
1014-500
5-8-95
50.00
- 8.34
41.66
4.981 AC
11-9-95
M. & E. TROYER
843-64
5 AC
P.D. Hostetler
813-898
R.D. & H.P. LUKEHART
2.46 AC
826-1246
DETWEILER
T.S. & V.L. FLESH
975-598
K.L. & B. DETWEILER
877-443
~~D.R. & M.N. HOSTETLER~~
885-485
M.A. MILLER
B.D. HOCHSTETLER
1033-386
R.A. TRUMAN
10 A
524-186
950-812
953-369
944-1014
944-1018
2.02 A
13.25 A
J. Burton, TRUSTEE
728-175
728-697
950-812
953-369
6.39 Ac.
1.5 Ac.
J. Burton, TRUSTEE
607-5
953-369
7.93 Ac.
10 A
10 A
H & J. McNish
568-1253
50 A
218-379
C.D. & E. MILLER
665-1153
867-427
246-4
546-707
H. McNish
J.S. & J.M. McNISH
912-54
51.035 Ac
J.S. & J.M. McNISH
912-54
5.478 A
546-707
H. McNish
17.74 Ac.
K.M. & H.A. KOCHY
996-884
5.395 Ac.
974-777
5.372 Ac.
B.A. ASH
953-871
5.372 Ac.
~~G.S. PERETTE~~
J.J. & P. CERMAK
1012-374
4-13-95
6.101 Ac
J.J. CERMAK
57.512 Ac
903-1296
1001-212
SEE MAP N
454-77
50.57 A
E.R. & M.M. BYLER
831-277
258-185
33.61 A
70 A
D.G. & S.K. MADDOX
930-1
42.17 A
61.82 A
A B C D
E F G H
I J K L
M N O P

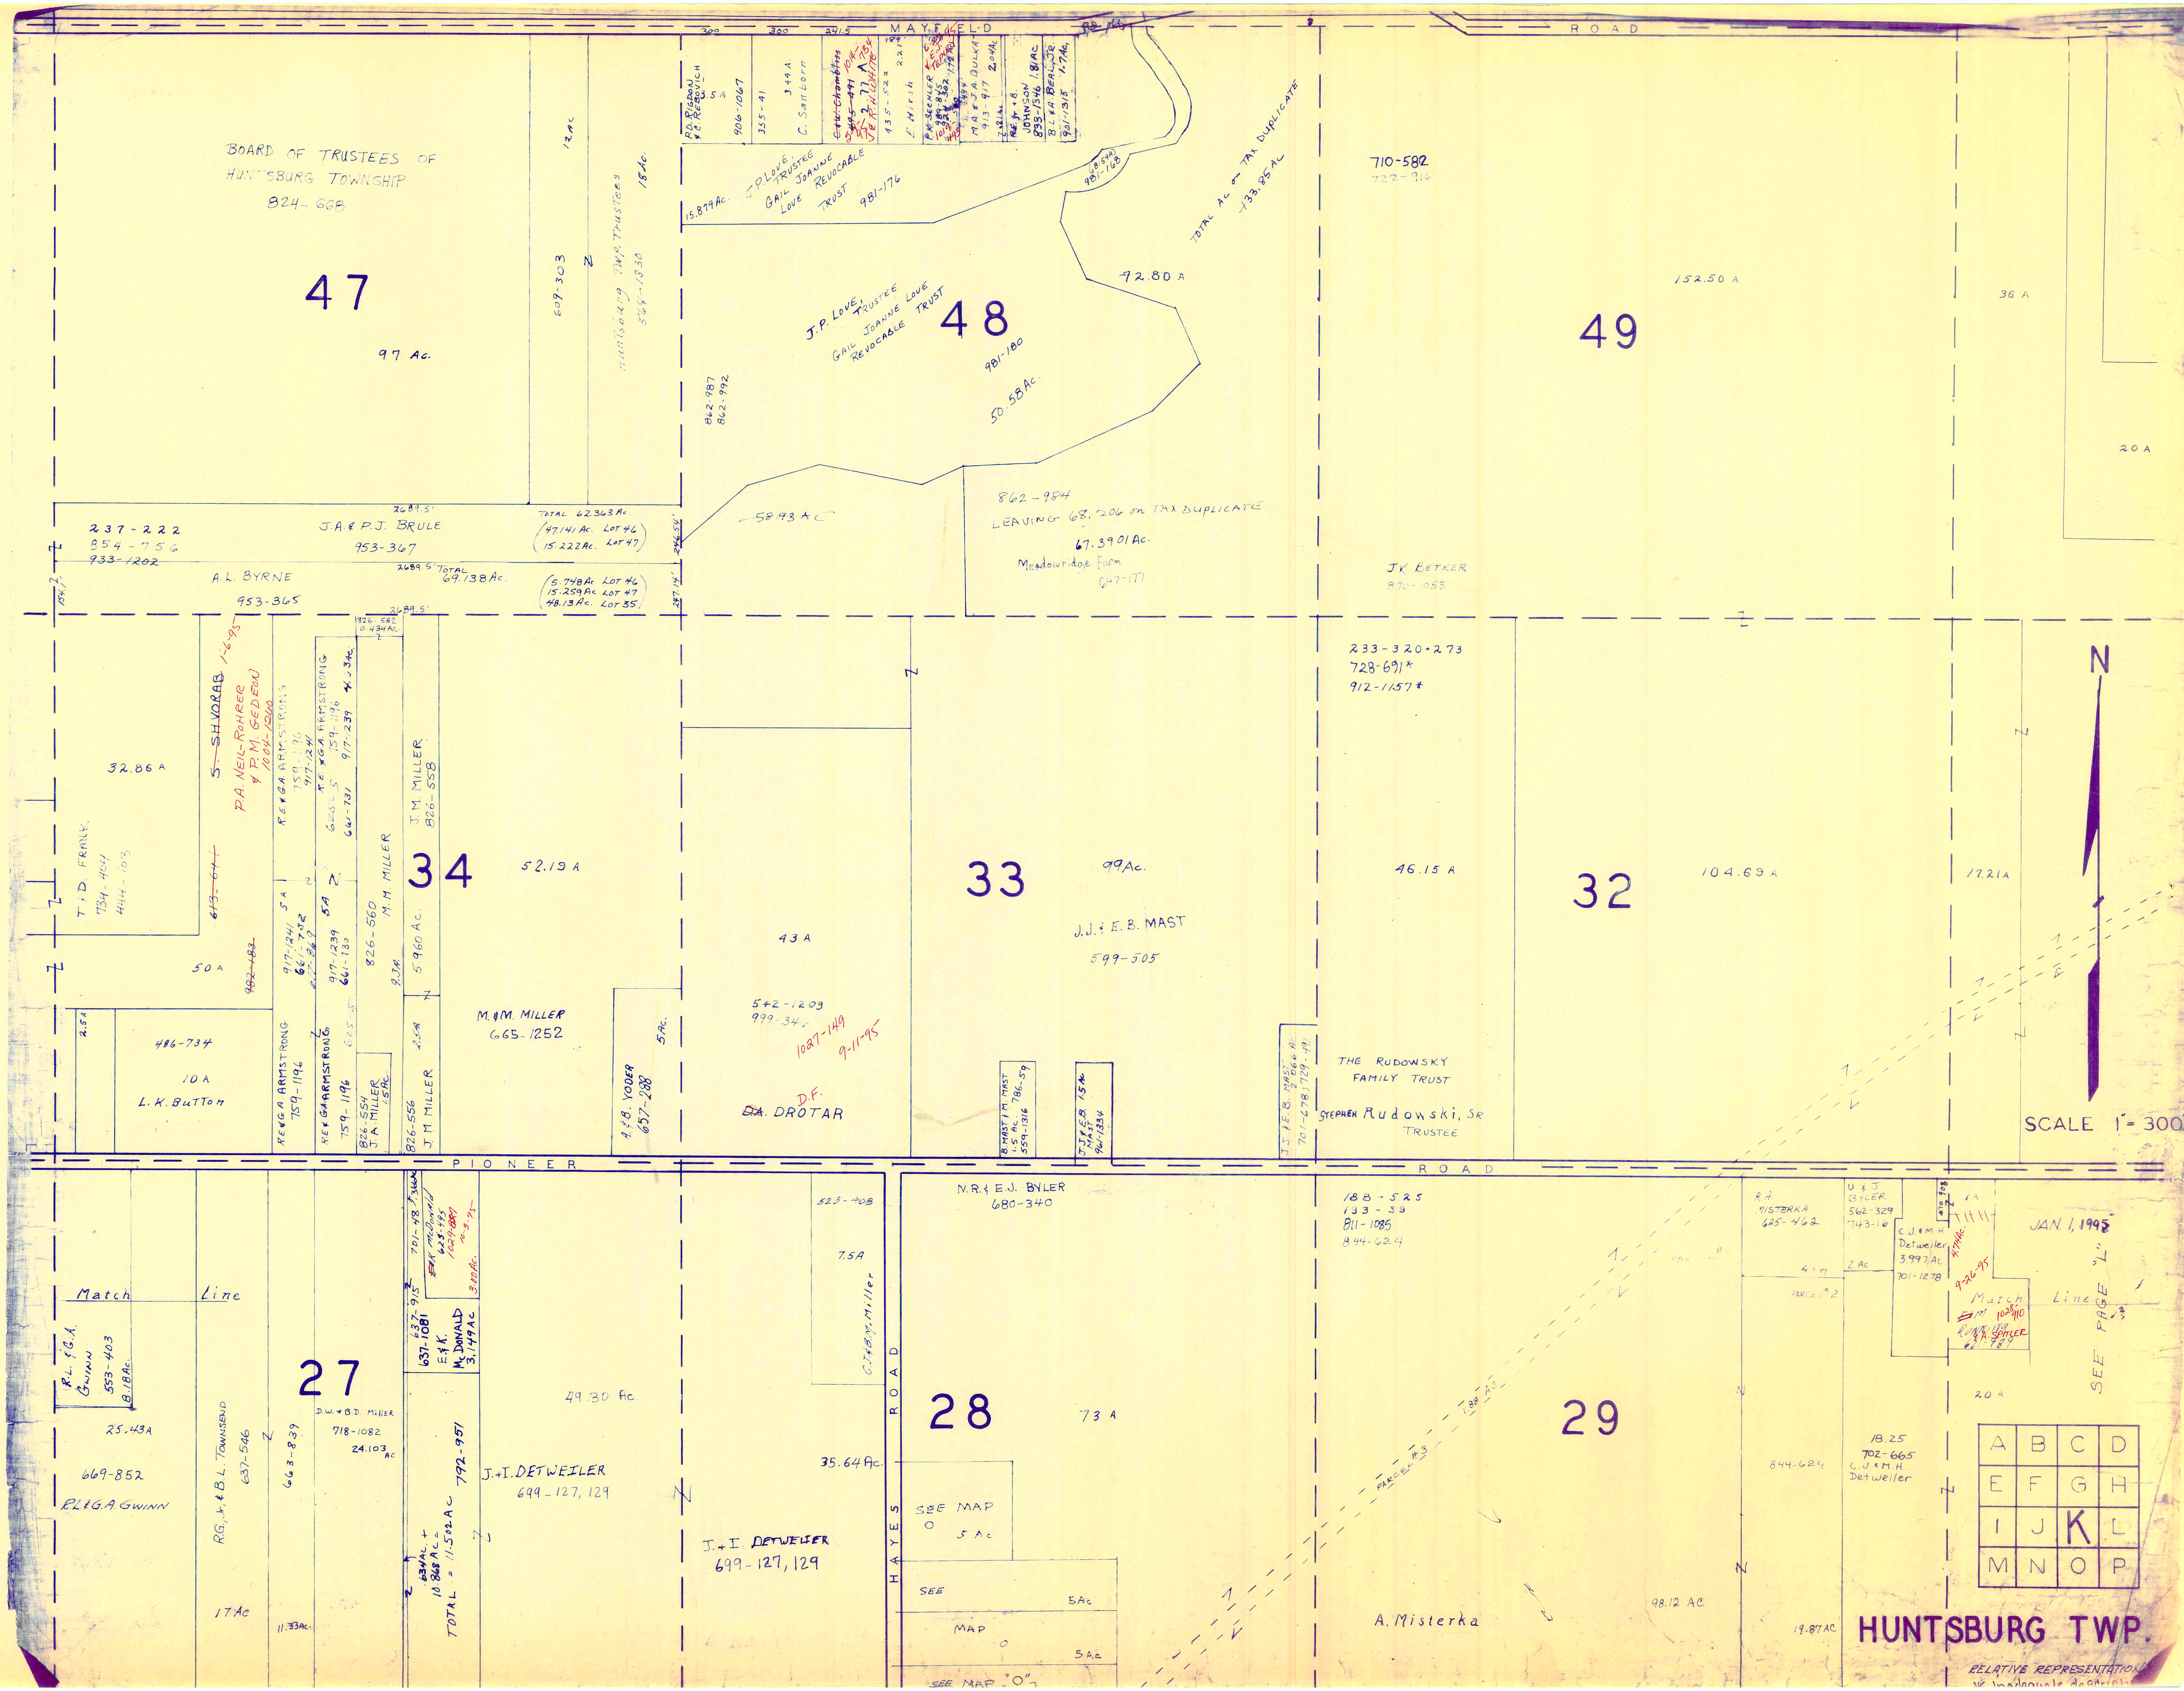
MAYFIELD ROAD
PIONEER ROAD
HAYES ROAD
300
300
241.5
P.D. RIGDON & C. REBOVICH
3.5 A
906-1067
355-41
3.44 A
C. Sanborn
~~C.&W. Chambliss~~
~~495-471~~
2.77 A
1014-734
5-9-95
J & R.H. WHITE
435-522
2.21
E. Hirsh
189
P.K. SECHLER
989-845
974-302
1.72 Ac
E.J. TEPLEY
6-23-95
1019-493
494
M.A. & J.A. DULKA
913-917
2.04 Ac
2.21 Ac
R.E. Jr. & B. JOHNSON
833-1346
1.81 AC
B.L. & A. BEAL, JR.
901-1315
1.7 Ac.
15.879 Ac.
J.P. LOVE, TRUSTEE GAIL JOANNE LOVE REVOCABLE TRUST
981-176
(.8159 A)
981-168
BOARD OF TRUSTEES OF HUNTSBURG TOWNSHIP
824-668
47
97 Ac.
12 Ac
609-303
Huntsburg Twp. Trustees
568-1330
18 Ac.
J.P. LOVE, TRUSTEE GAIL JOANNE LOVE REVOCABLE TRUST
48
981-180
50.58 Ac
72.80 A
TOTAL AC on TAX DUPLICATE 133.85 AC
862-987
862-992
58.93 AC
862-984
LEAVING 68.206 on TAX DUPLICATE
67.3901 Ac.
Meadowridge Farm
647-171
237-222
854-756
933-1202
J.A. & P.J. BRULE
953-367
2689.5
TOTAL 62.363 Ac.
(47.141 Ac. LOT 46
15.222 Ac. LOT 47)
A.L. BYRNE
953-365
2689.5
TOTAL 69.138 Ac.
(5.748 Ac LOT 46
15.259 Ac LOT 47
48.13 Ac. LOT 35)
2689.5
826-562
0.434 Ac
710-582
732-916
49
152.50 A
36 A
20 A
J.K. BETKER
870-053
32.86 A
~~S. SHVORAB 1-6-95~~
P.A. NEIL-ROHRER & P.M. GEDEON
1026-1260
T.D. FRANK
734-404
444-103
~~613-64~~
50 A
~~982-183~~
R.S. & G.A. ARMSTRONG
759-1196
917-1241
R.E. & G.A. ARMSTRONG
759-1196
917-1239
4.03 Ac
625-5
661-731
917-1241
661-732
917-1239
661-730
5A
M.M. MILLER
826-560
J.M. MILLER
826-558
5.960 Ac
34
52.19 A
M.&M. MILLER
665-1252
2.5 A
486-734
10 A
L.K. BUTTON
R.E. & G.A. ARMSTRONG
759-1196
R.E. & G.A. ARMSTRONG
759-1196
826-554
J.A. MILLER
826-556
J.M. MILLER
A. & B. YODER
657-288
5 Ac.
33
99 Ac.
43 A
J.J. & E.B. MAST
599-505
542-1209
999-34
1027-149
9-11-95
D.F. ~~D.A.~~ DROTAR
B. MAST & M. MAST
786-59
559-1316
J.J. & E.B.
961-1334
233-320-273
728-691
912-1157
46.15 A
32
104.69 A
17.21 A
THE RUDOWSKY FAMILY TRUST
STEPHEN Rudowski, Sr TRUSTEE
J.J. & E.B. MAST
701-278
N
SCALE 1" = 300
Match Line
R.L. & G.A. GWINN
553-403
8.18 Ac.
25.43 A
669-852
R.L. & G.A. GWINN
R.G., J. & B.L. TOWNSEND
637-546
663-839
17 Ac
11.33 Ac.
27
D.W. & B.D. MILLER
718-1082
24.103 Ac
701-48
E.&K. McDonald
623-495
1029-684
5-9-95
3.00 Ac.
637-915
637-1081
E. & K. McDONALD
3.149 AC
.634 Ac + 10.868 Ac = TOTAL = 11.502 AC
792-951
49.30 Ac.
J.&I. DETWEILER
699-127, 129
J.&I. DETWEILER
699-127, 129
523-408
7.5 A
C.J. & M.M. Miller
35.64 Ac.
28
73 A
N.R. & E.J. BYLER
680-340
SEE MAP O
5 Ac
SEE MAP
5 Ac
5 Ac
SEE MAP "O"
188-525
133-39
811-1085
844-624
PARCEL #3
PARCEL #2
29
A. Misterka
98.12 AC
R.A. MISTERKA
625-462
U & J BYLER
562-329
743-16
C.J. & M.H. Detweiler
3.997 Ac
701-1278
2 Ac
4.1 Ac
9-26-95
Match Line
SEE PAGE "L"
JAN. 1, 1995
RUNNING & A. SPITLER
621-989
20 A
844-624
18.25
702-665
C.J. & M.H. Detweiler
19.87 AC
A B C D
E F G H
I J K L
M N O P
HUNTSBURG TWP.
RELATIVE REPRESENTATION
* Inadequate description

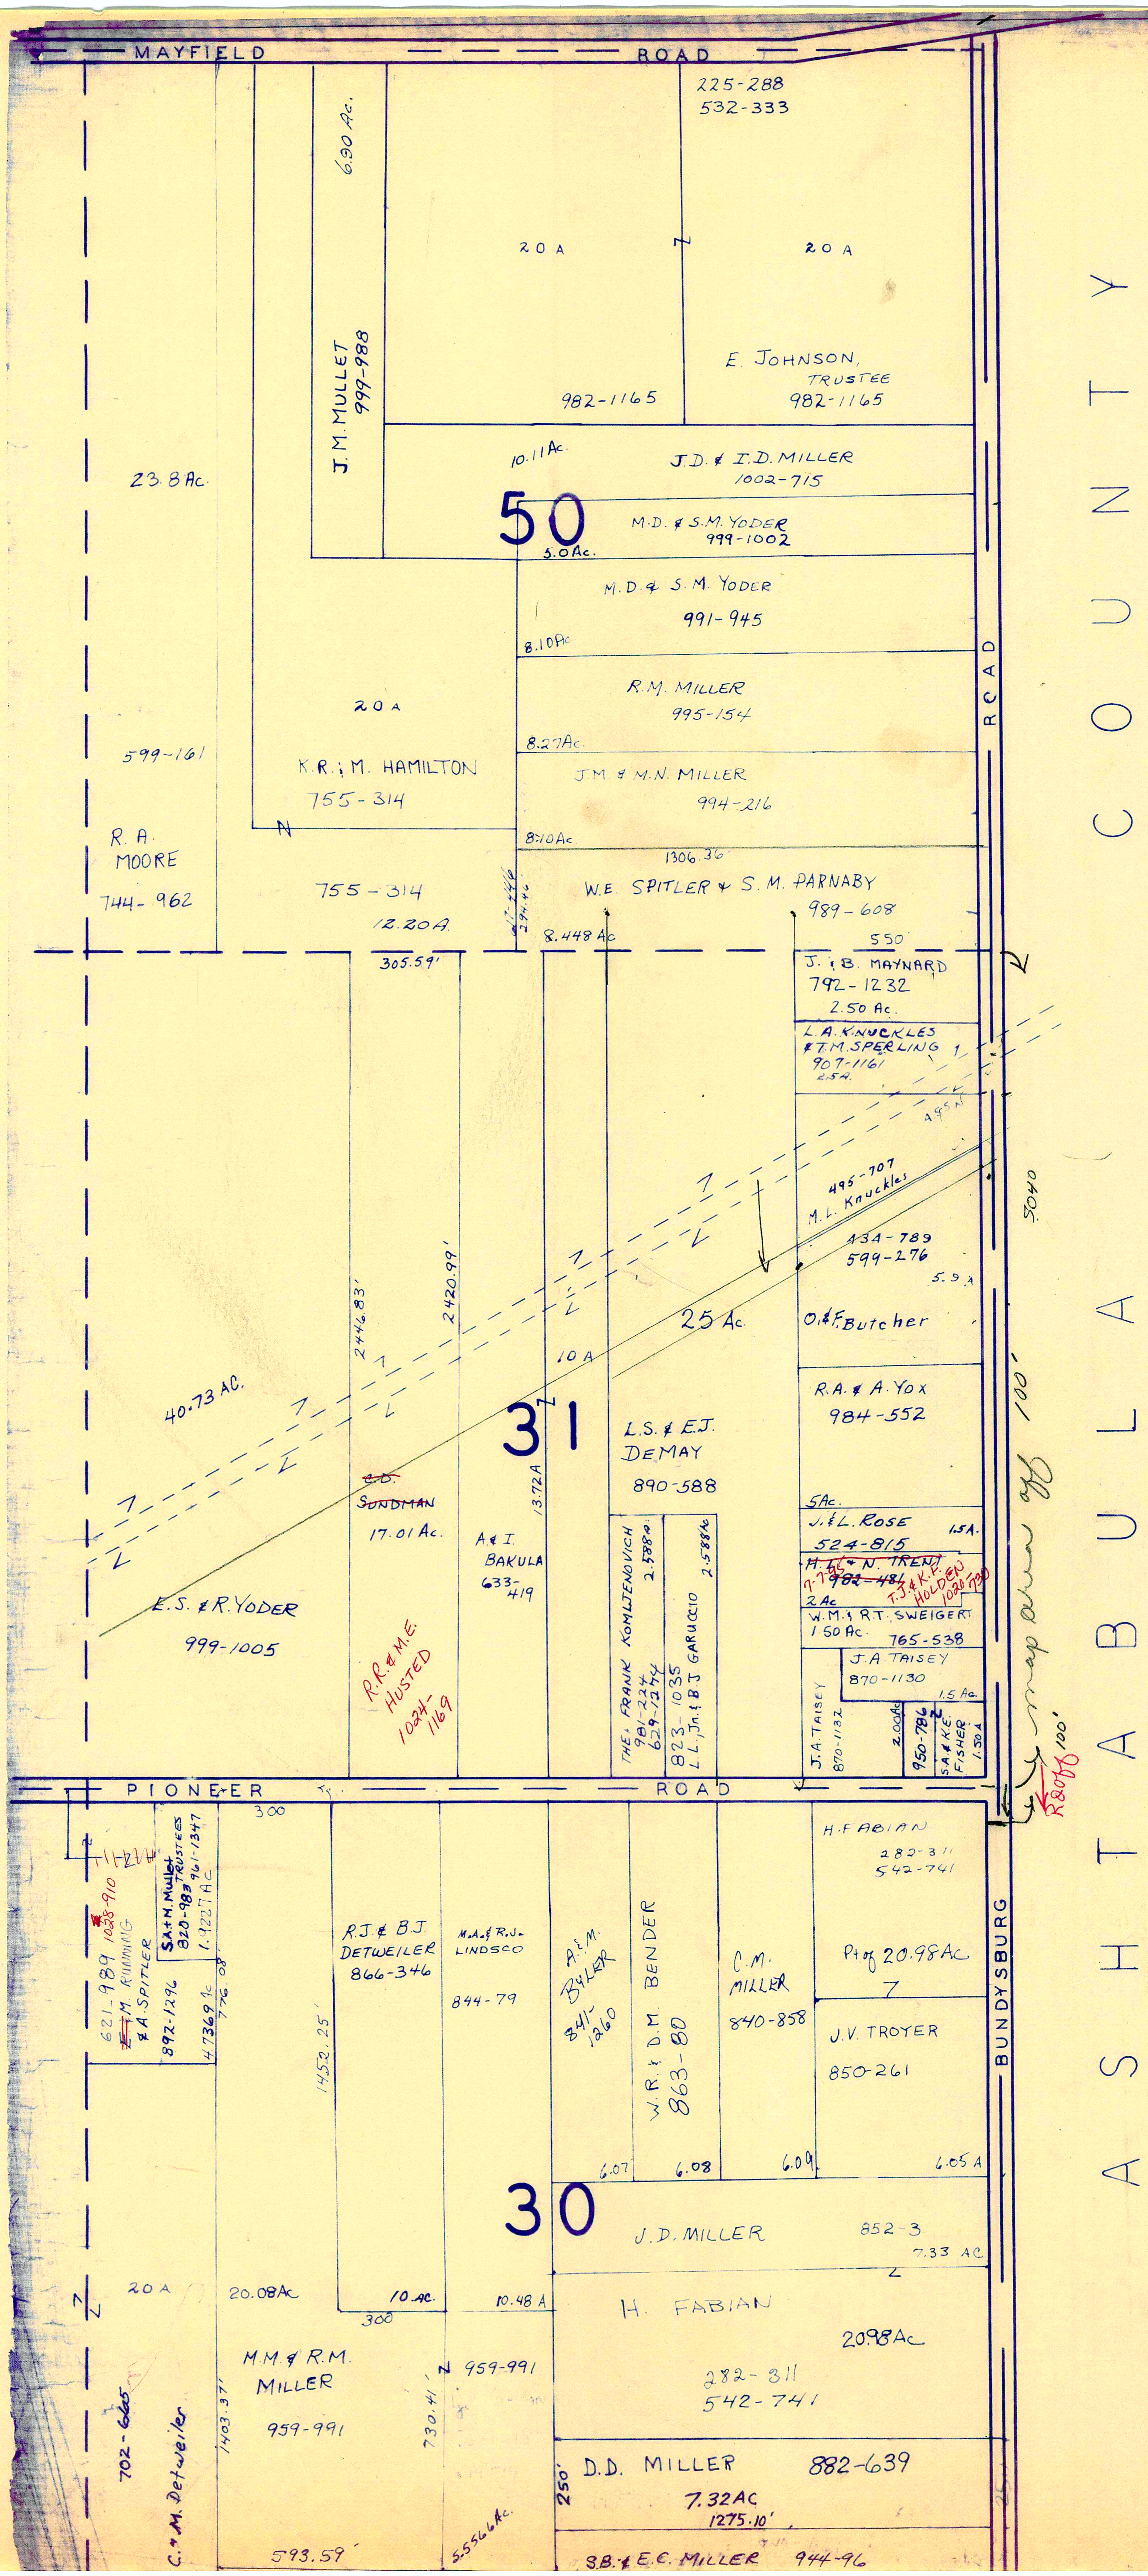
MAYFIELD ROAD
225-288
532-333
6.90 Ac.
20 A
20 A
J. M. MULLET 999-988
E. JOHNSON TRUSTEE 982-1165
982-1165
23.8 Ac.
10.11 Ac.
J.D. & I.D. MILLER 1002-715
50
M.D. & S.M. YODER 999-1002
3.0 Ac.
M.D. & S.M. YODER 991-945
8.10 Ac.
R.M. MILLER 995-154
8.27 Ac.
J.M. & M.N. MILLER 994-216
8.10 Ac.
20 A
599-161
K.R. & M. HAMILTON 755-314
R.A. MOORE 744-962
755-314
12.20 A
1306.36
W.E. SPITLER & S.M. PARNABY 989-608
8.448 Ac.
550
305.59'
J. & B. MAYNARD 792-1232
2.50 Ac.
L.A. KNUCKLES & T.M. SPERLING 907-1161
495-707 4. L. Knuckles
434-789
599-276
0.&F. Butcher
25 Ac.
10 A
2446.83'
2420.99'
40.73 AC.
31
L.S. & E.J. DeMAY 890-588
R.A. & A. YOX 984-552
~~E.D. SONDMAN~~
17.01 Ac.
A & I BAKULA 633-419
13.72 A
5 Ac.
J. & L. ROSE 524-815
1.5 A.
H. C. & N. IRENE 982-484
T.J. & K.E. HOLDEN
E.S. & R. YODER 999-1005
R.R. & M.E. HUSTED 1034-1169
THS. FRANK KOMLENOVICH 726-244 624-1242
2.588 A
823-1035 L.L. Jr. & B.J. GARUCCIO
2.588 A
W.M. & R.T. SWEIGERT 765-538
1.50 Ac.
J.A. TAISEY 870-1130
J.A. TAISEY 870-1132
950-784
S.A. & K.E. FISHER
1.5 Ac.
1.50 A
ROAD
5040
map area off 100'
PIONEER ROAD
300
BUNDYSBURG
ASHTABULA COUNTY
R.J. & B.J. DETWEILER 866-346
M.A. & R.W. LINDSCO 844-79
A.L.M. BYLER 341-1260
W.R. & D.M. BENDER 863-80
C.M. MILLER 840-858
H. FABIAN 282-311 542-741
Pt of 20.98 Ac.
J.V. TROYER 850-261
621-989
J.M. KUMMING & A. SPITLER 892-1296
S.A. & H. Mullet Trustees 820-988 961-1347 1.122 AC.
4.7369 Ac.
1452.25'
6.07
6.08
6.09
6.05 A
30
J.D. MILLER 852-3
7.33 AC.
20 A
20.08 Ac.
10 Ac.
10.48 A
300
H. FABIAN 282-311 542-741
20.98 Ac.
M.M. & R.M. MILLER 959-991
959-991
730.41'
1493.37'
702-665
C. & M. Detweiler
D.D. MILLER 882-639
7.32 AC
1275.10'
250
593.59'
3.558 Ac.
S.B. & E.C. MILLER 944-96

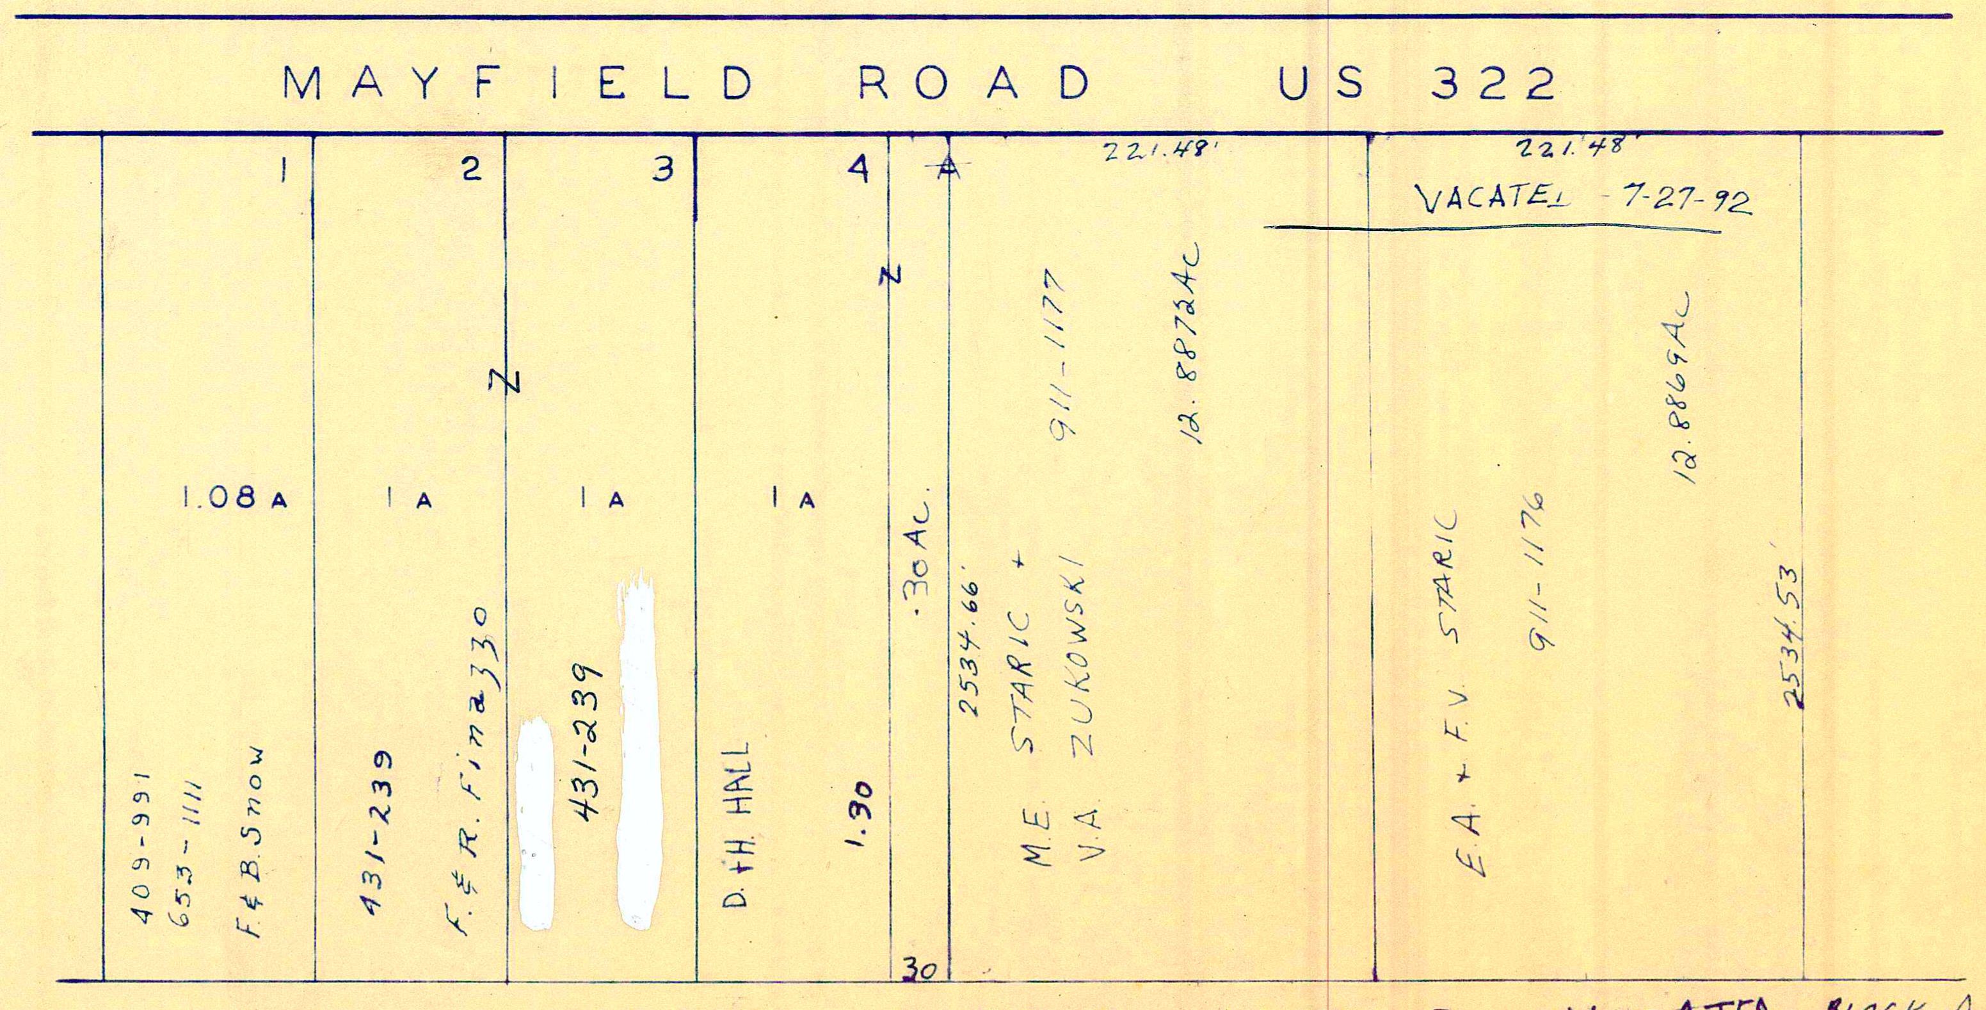
MAYFIELD ROAD US 322
1
2
3
4
A
221.48'
221.48'
VACATED 7-27-92
1.08 A
1 A
1 A
1 A
.30 Ac.
12.8872 Ac.
12.8872 Ac.
409-331 653-1111 F. & B. SNOW
431-239
F. & R. FINZ 330
431-239
D. & H. HALL
1.90
2534.66'
M.E. STARIC & V.A. ZUKOWSKI 911-1177
E.A. & F.V. STARIC 911-1176
2534.53'
30

SICZ SUBDIVISION VACATED = BLOCK A, 7-27-92 S/L 5-6-7-8

VOL. 6 - PG. 87

LOT 44

SCALE 1" 100'

N

SCALE 1" 300'

JAN 1, 1995

* Inadequate description

RELATIVE REPRESENTATION

A	B	C	D
E	F	G	H
I	J	K	**L**
M	N	O	P

HUNTSBURG TWP.

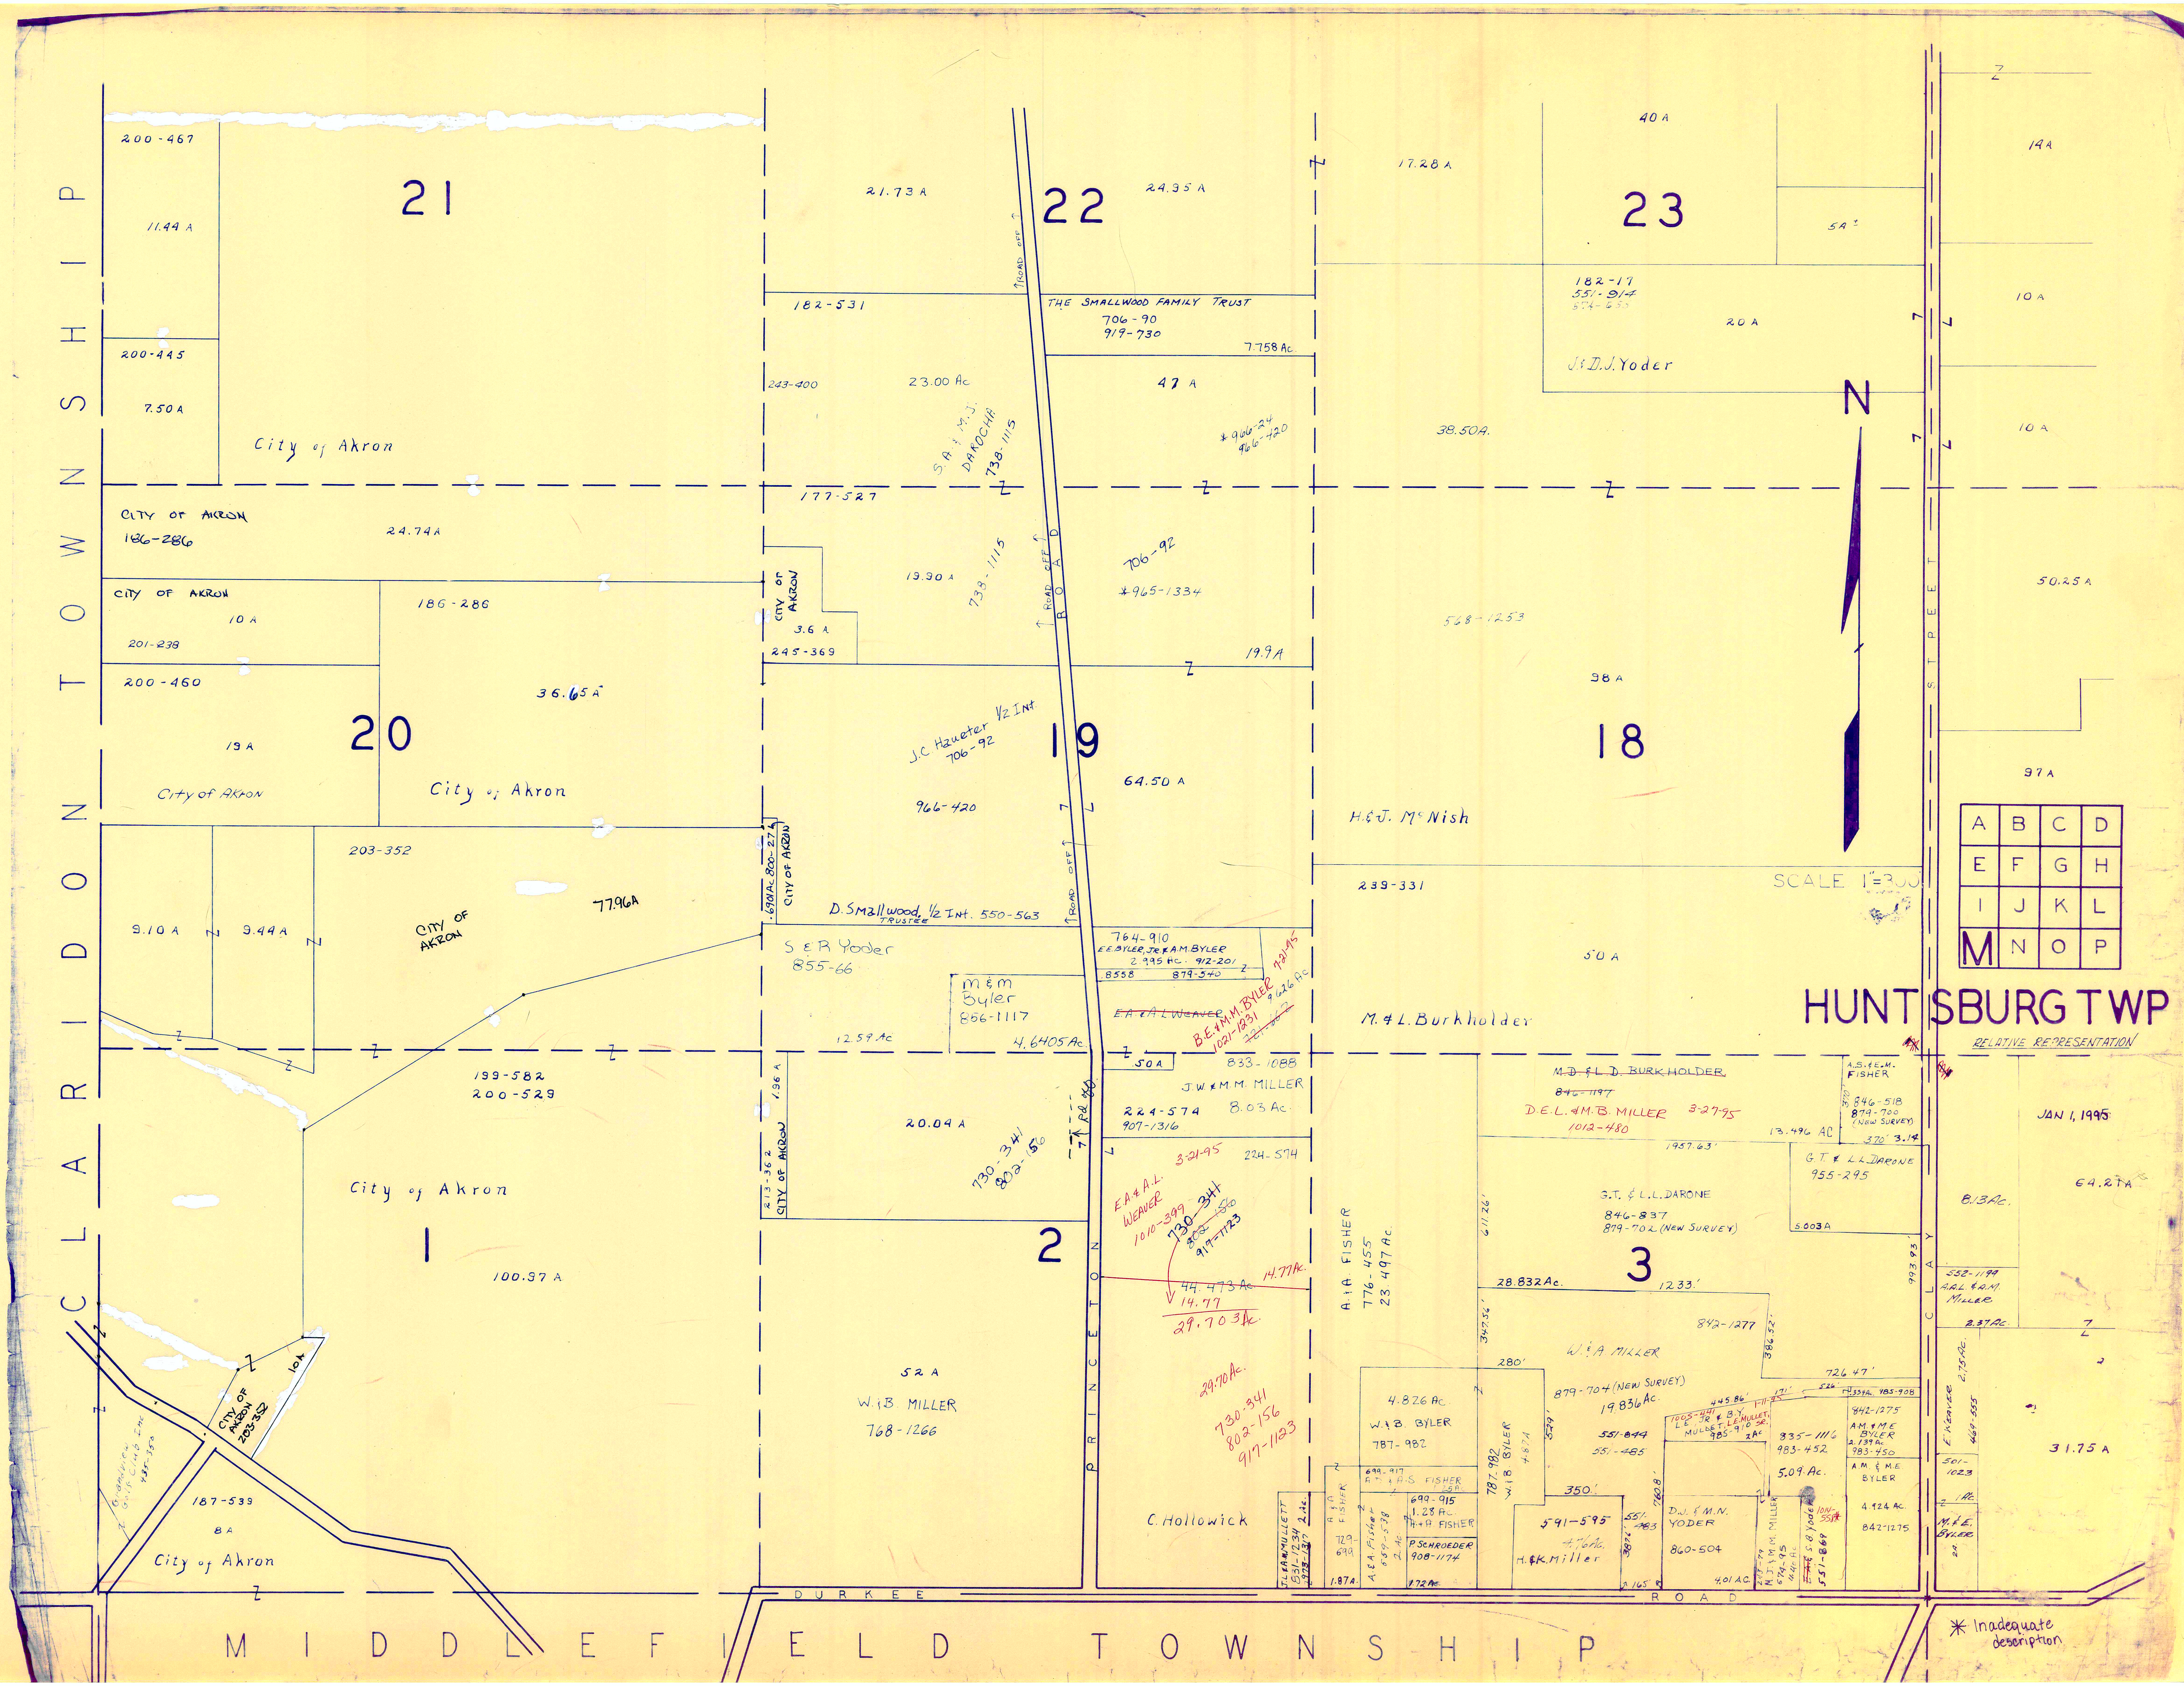
CLARIDON TOWNSHIP
MIDDLEFIELD TOWNSHIP
HUNTSBURG TWP
RELATIVE REPRESENTATION
JAN 1, 1995
SCALE 1"=300'
N
A B C D
E F G H
I J K L
M N O P
* Inadequate description
PRINCETON ROAD
DURKEE ROAD
CLAY STREET
21
22
23
20
19
18
1
2
3
200-467
11.44 A
200-445
7.50 A
City of Akron
CITY OF AKRON 186-286
24.74 A
CITY OF AKRON 10 A
201-238
186-286
200-460
36.65 A
19 A
City of Akron
City of Akron
203-352
9.10 A
9.44 A
CITY OF AKRON
77.96 A
199-582
200-529
City of Akron
100.97 A
CITY OF AKRON 203-352
10 A
187-539
8 A
City of Akron
21.73 A
182-531
243-400
23.00 Ac
S.A. & M.J. DAKOCHA 738-1115
177-527
CITY OF AKRON 3.6 A
245-369
19.90 A
738-1115
J.C. Haueter 1/2 Int. 706-92
966-420
.690 Ac 800-274
CITY OF AKRON
D. Smallwood, 1/2 Int. 550-563 TRUSTEE
S & R Yoder 855-66
M&M Byler 856-1117
4.6405 Ac
12.59 Ac
1.96 A
CITY OF AKRON
20.04 A
730-341 802-156
213-362
CITY OF AKRON
52 A
W.&B. MILLER 768-1266
24.35 A
THE SMALLWOOD FAMILY TRUST 706-90 919-730
7.758 Ac
47 A
* 966-24 966-420
706-92
* 965-1334
19.9 A
64.50 A
764-910
E.E. BYLER, J.E. & A.M. BYLER 2.995 Ac 912-201
855.8
879-540
9.626 Ac
~~E.A. & A.L. WEAVER~~
B.E. & M.M. BYLER 9-21-95 1021-1331
5.0 A
833-1088
J.W. & M.M. MILLER 8.03 Ac
224-574
907-1316
E.A. & A.L. WEAVER 1010-399
3-21-95
224-574
730-341
917-1123
44.473 Ac
14.77
14.77 Ac
29.703 Ac
29.70 Ac
730-341 802-156 917-1123
C. Hollowick
J.L. & A.M. MULLETT 831-1234 1.87 Ac
A. & A. FISHER
A.&A. Fisher 1.87 A
699-917 A. & A.S. FISHER
699-915 1.28 Ac A.&A. FISHER
P. SCHROEDER 908-1174
1.72 Ac
17.28 A
40 A
182-17 551-914
20 A
J. & D.J. Yoder
5 A
14 A
10 A
10 A
38.50 A
568-1253
38 A
50.25 A
H. & J. McNish
239-331
50 A
97 A
M. & L. Burkholder
M.D. & L.D. BURKHOLDER 846-1197
D.E.L. & M.B. MILLER 3-27-95 1012-480
A.S. & E.M. FISHER 846-518 879-700 (NEW SURVEY)
13.496 AC
G.T. & L.L. DARONE 955-295
5.003 A
G.T. & L.L. DARONE 846-837 879-702 (NEW SURVEY)
1957.63'
A. & A. FISHER 776-455 23.497 Ac
28.832 Ac
1233'
842-1277
W. & A. MILLER
879-704 (NEW SURVEY) 19.836 Ac
551-844
551-485
4.826 Ac
W. & B. BYLER 787-982
787-982 W.&B. BYLER 4.87 A
280'
350'
591-595 H. & K. Miller
D.J. & M.N. YODER 860-504
4.01 AC
335-1116 983-452
5.09 Ac
N.J. & M.M. MILLER 674-95
E. & S. Yoder 551-861
726.47'
842-1275
A.M. & M.E. BYLER 2.139 Ac 983-450
A.M. & M.E. BYLER
4.424 Ac
842-1275
552-1199 A.R.L. & A.M. MILLER
8.13 Ac
64.27 A
2.37 Ac
E. Weaver 2.75 Ac 664-555
501-1023
M. & E. BYLER
31.75 A

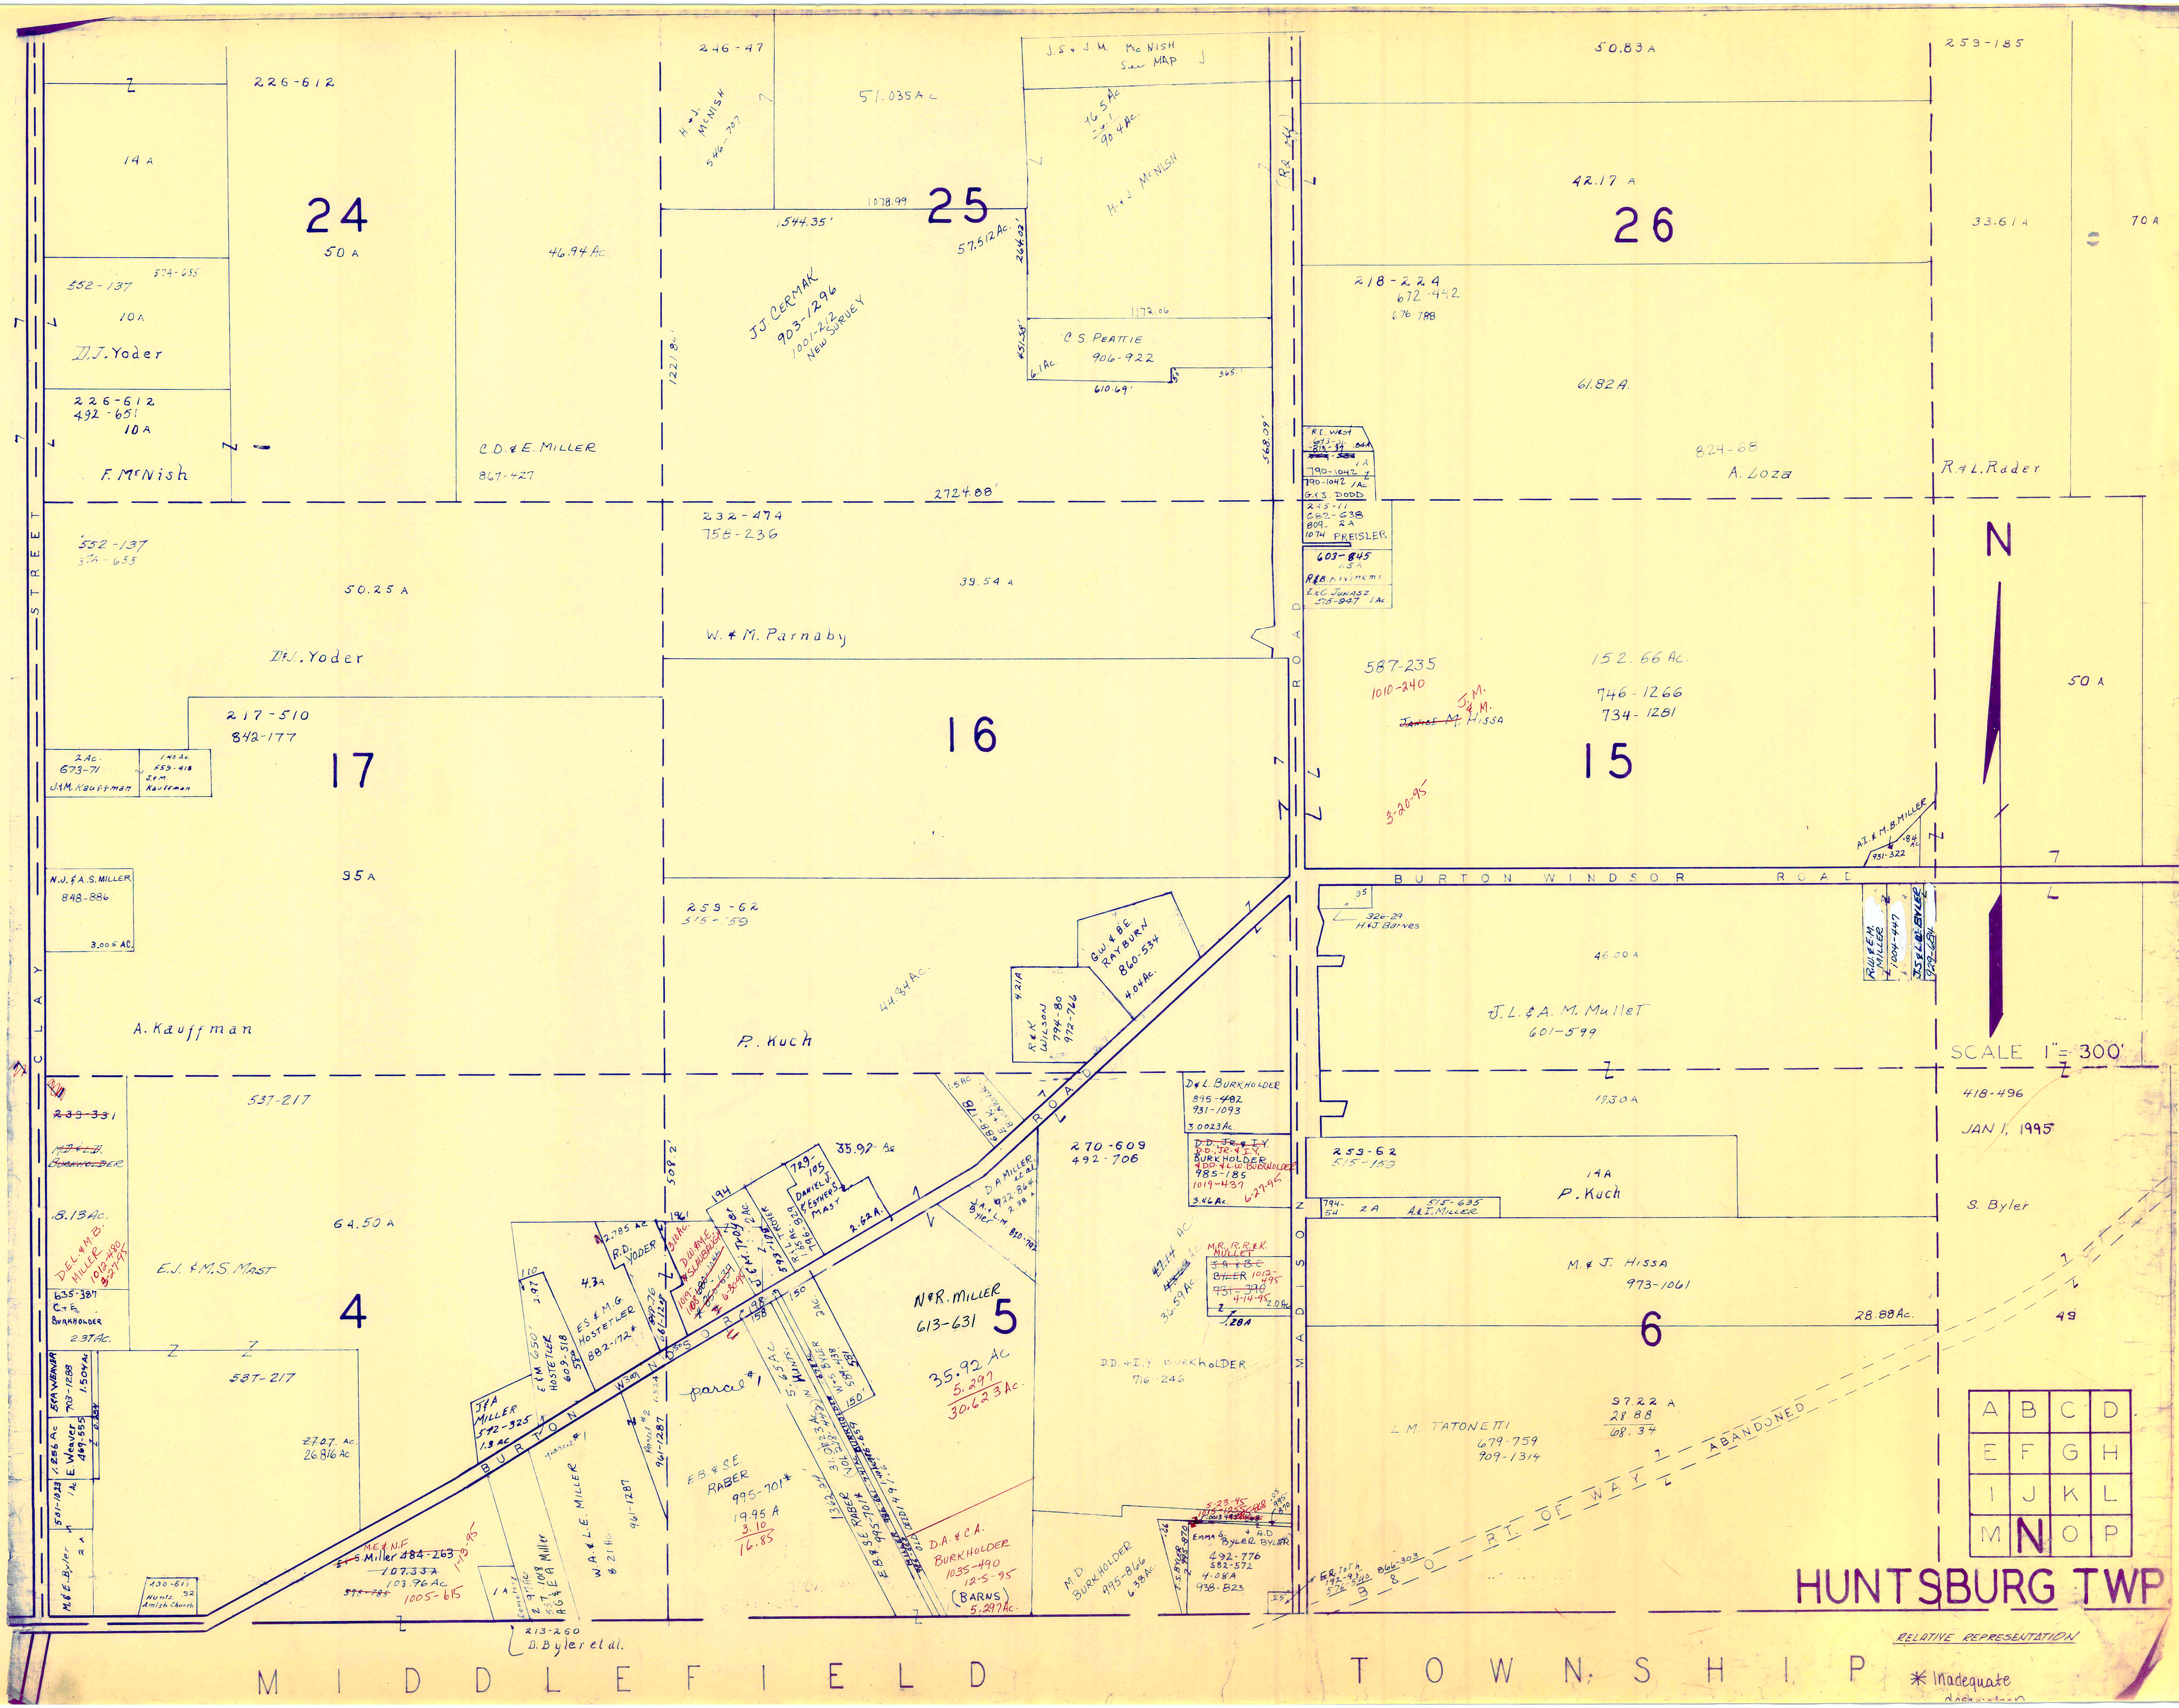
24
25
26
17
16
15
4
5
6
CLAY STREET
MADISON ROAD
BURTON WINDSOR ROAD
BURTON WINDSOR ROAD
MIDDLEFIELD TOWNSHIP
B & O RIGHT OF WAY ABANDONED
N
SCALE 1" = 300'
JAN 1, 1995
226-612
14 A
50 A
46.94 Ac.
552-137
524-655
10 A
D.J. Yoder
226-612
492-651
10 A
F. McNish
C.D. & E. MILLER
867-427
246-47
H & J. McNISH
546-707
51.035 Ac
J.S. & J.M. McNISH
See MAP
46.5 Ac
90.4 Ac
H & J. McNISH
1544.35'
1078.99
57.512 Ac.
J.J. CERMAK
903-1296
1001-212
New Survey
C.S. PEATTIE
906-922
6.1 Ac
610.69'
2724.88'
50.83 A
42.17 A
218-224
672-442
676-788
61.82 A
824-68
A. Loza
R & L. Rader
253-185
33.61 A
70 A
790-1042
803 DODD
1074 PREISLER
603-845
L & C Juhasz
575-947
552-137
524-655
50.25 A
D.J. Yoder
232-474
758-236
39.54 A
W. & M. Parnaby
587-235
1010-240
J.M. & M. Hissa
~~James M.~~
152.66 Ac.
746-1266
734-1281
3-20-95
50 A
217-510
842-177
2 Ac
673-71
J & M. Kauffman
1.40 Ac
553-418
Sem. Kauffman
N.J. & A.S. MILLER
848-886
3.005 AC
95 A
A. Kauffman
259-62
515-59
44.44 Ac.
P. Kuch
R & K. WILSON
794-80
972-746
G.W. & B.E. RAYBURN
860-534
4.04 Ac.
A.I. & M.B. MILLER
931-322
35
326-29
H & J Barnes
46.00 A
J.L. & A.M. Mullet
601-599
R.W. & E.M. MILLER
1004-447
J.S. & L.B. BYLER
~~233-331~~
~~Burkholder~~
537-217
8.13 Ac.
DEL & M.B. MILLER
1012-480
3-24-95
635-387
C & E Burkholder
2.37 Ac.
64.50 A
E.J. & M.S. MAST
587-217
27.07 Ac
26.816 Ac
E & A WEAVER
703-1288
E. Weaver
469-555
1.504 AC
501-1023
M & E. Byler
430-615
Hunts. 32 Amish Church
M.E. & N.F. S. Miller 484-263
107.337
103.96 Ac.
1005-615
213-260
D. Byler et al.
W.A. & L.E. MILLER
961-1287
E.S. & M.G. HOSTETLER
882-172
R.D. YODER
parcel #1
E.B. & S.E. RABER
995-701
19.95 A
3.10
16.85
35.92 Ac
DANIEL & ESTHER E. MAST
2.62 A
D.A. MILLER
N & R. MILLER
613-631
35.92 Ac
5.297
30.623 Ac.
D.A. & C.A. BURKHOLDER
1035-490
12-5-95
(BARNS) 5.297 Ac.
270-609
492-706
D. & L. BURKHOLDER
895-482
931-1093
3.0023 Ac
D.D. JR. & I.Y. BURKHOLDER
985-185
1019-439
6-27-95
3.46 Ac
D.D. & I.Y. BURKHOLDER
716-246
M.D. BURKHOLDER
995-866
6.38 Ac
MR. R.R. & K. MULLET
~~S.A. & S.E. BYLER~~
931-398
4-14-95
.28 A
J.S. BYLER
Emma & A.D. BYLER
492-776
582-572
4.08 A
938-823
19.30 A
253-62
515-159
14 A
P. Kuch
794-54
2 A
515-635
A & I. MILLER
M. & J. HISSA
973-1061
28.88 Ac.
L.M. TATONETTI
679-759
909-1314
97.22 A
28.88
68.34
418-496
S. Byler
49
A B C D
E F G H
I J K L
M N O P

HUNTSBURG TWP

RELATIVE REPRESENTATION

* Inadequate

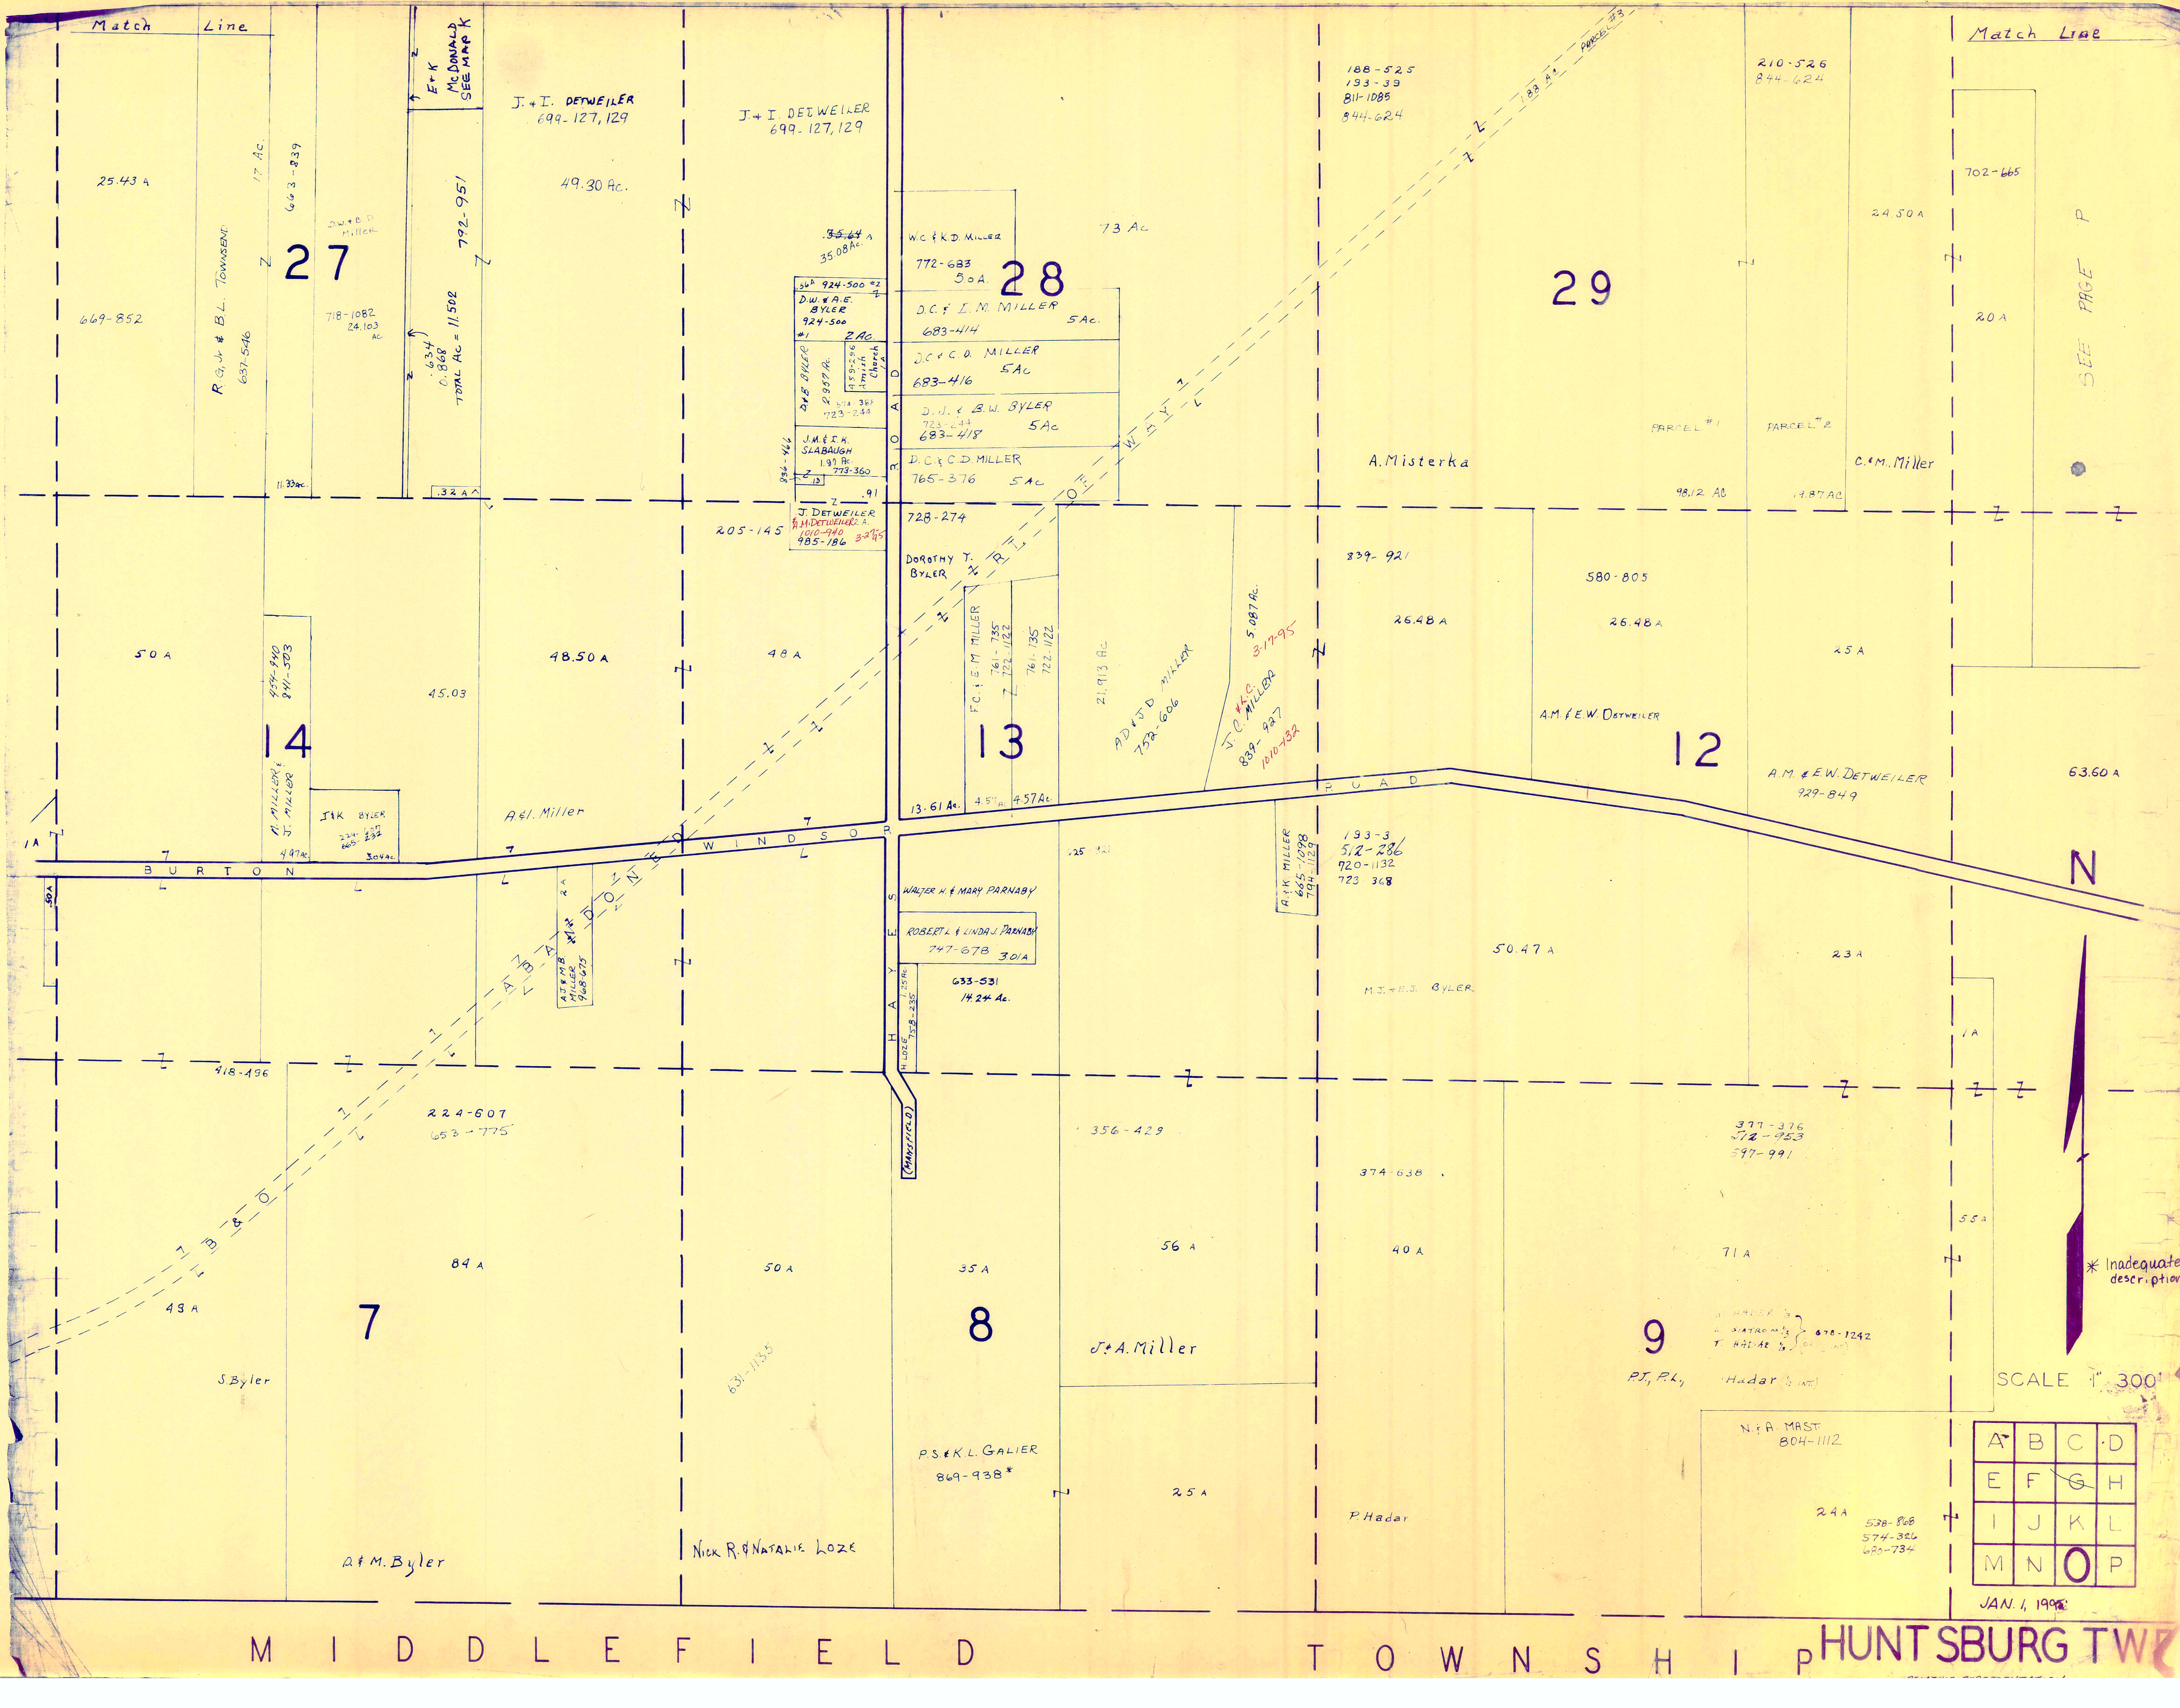
Match Line
Match Line
E + K McDONALD SEE MAP K
J. + I. DETWEILER 699-127,129
J. + I. DETWEILER 699-127,129
49.30 Ac.
25.43 A
669-852
R.G. Jr & B.L. TOWNSEND 637-546
17 Ac.
663-839
D.W. + B.D. Miller
718-1082 24.103 Ac
27
792-951
634 0.868 TOTAL Ac = 11.502
11.33 Ac
.32 A
~~35.64~~ A 35.08 Ac.
.56 A 924-500 #2
D.W. & A.E. BYLER 924-500 #1 2 Ac.
D. & B. BYLER 2.957 Ac. 574-388 723-244
459-296 Amish Church 1 A
J.M. & I.K. SLABAUGH 1.97 Ac. 773-360
836-466
.13
.91
J. DETWEILER A.M. DETWEILER 2 A. 1010-940 985-186 3-27-95
205-145
ROAD
W.C. & K.D. MILLER 772-683 5.0 A.
28
73 Ac
D.C. & I.M. MILLER 683-414 5 Ac.
D.C. & C.D. MILLER 5 Ac 683-416
D.J. & B.W. BYLER 723-244 683-418 5 Ac
D.C. & C.D. MILLER 765-376 5 Ac
728-274
DOROTHY T. BYLER
RT. OF WAY
188-525 193-39 811-1085 844-624
88 A PARCEL #3
210-526 844-624
29
24.50 A
702-665
20 A
SEE PAGE P
PARCEL #1
PARCEL #2
A. Misterka
98.12 Ac
4.87 Ac
C. & M. Miller
50 A
459-940 241-503
14
45.03
48.50 A
48 A
A. MILLER & J. MILLER
4.97 Ac.
J & K BYLER 224-662 665-232 3.04 Ac.
A. & I. Miller
1 A
50 A
BURTON
WINDSOR ROAD
F.C. & E.M. MILLER 761-735 722-1122
761-735 722-1122
13
21.913 Ac
A.D. & J.D. MILLER 752-606
5.087 Ac. 3-17-95
J.C. & L.C. MILLER 839-927 1010-732
13.61 Ac.
4.57 Ac
4.57 Ac
839-921
26.48 A
580-805
26.48 A
25 A
A.M. & E.W. DETWEILER
12
A.M. & E.W. DETWEILER 929-849
63.60 A
N
A.K. MILLER 665-1098 724-1129
193-3 512-286 720-1132 723-368
WALTER H. & MARY PARNABY
ROBERT L. & LINDA J. PARNABY 747-678 3.01 A
633-531 14.24 Ac.
HAYES ROAD
H. LOZE 758-235 1.25 Ac.
A.J. & M.B. MILLER 968-615
50.47 A
M.J. & H.S. BYLER
23 A
1 A
418-496
224-607 653-775
(MARSHFIELD)
356-429
374-638
377-376 572-953 597-991
84 A
50 A
35 A
56 A
40 A
71 A
55 A
48 A
7
8
9
S. Byler
631-1135
J. & A. Miller
P.J., P.L., Hadar
P.S. & K.L. GALIER 869-938*
25 A
P. Hadar
N. & A. MAST 804-1112
24 A
538-868 574-326 680-734
A & M. Byler
Nick R. & Natalie Loze
NYC RR
SCALE 1" 300'
A B C D
E F G H
I J K L
M N O P
* Inadequate description
JAN. 1, 1995
MIDDLEFIELD TOWNSHIP
HUNTSBURG TWP

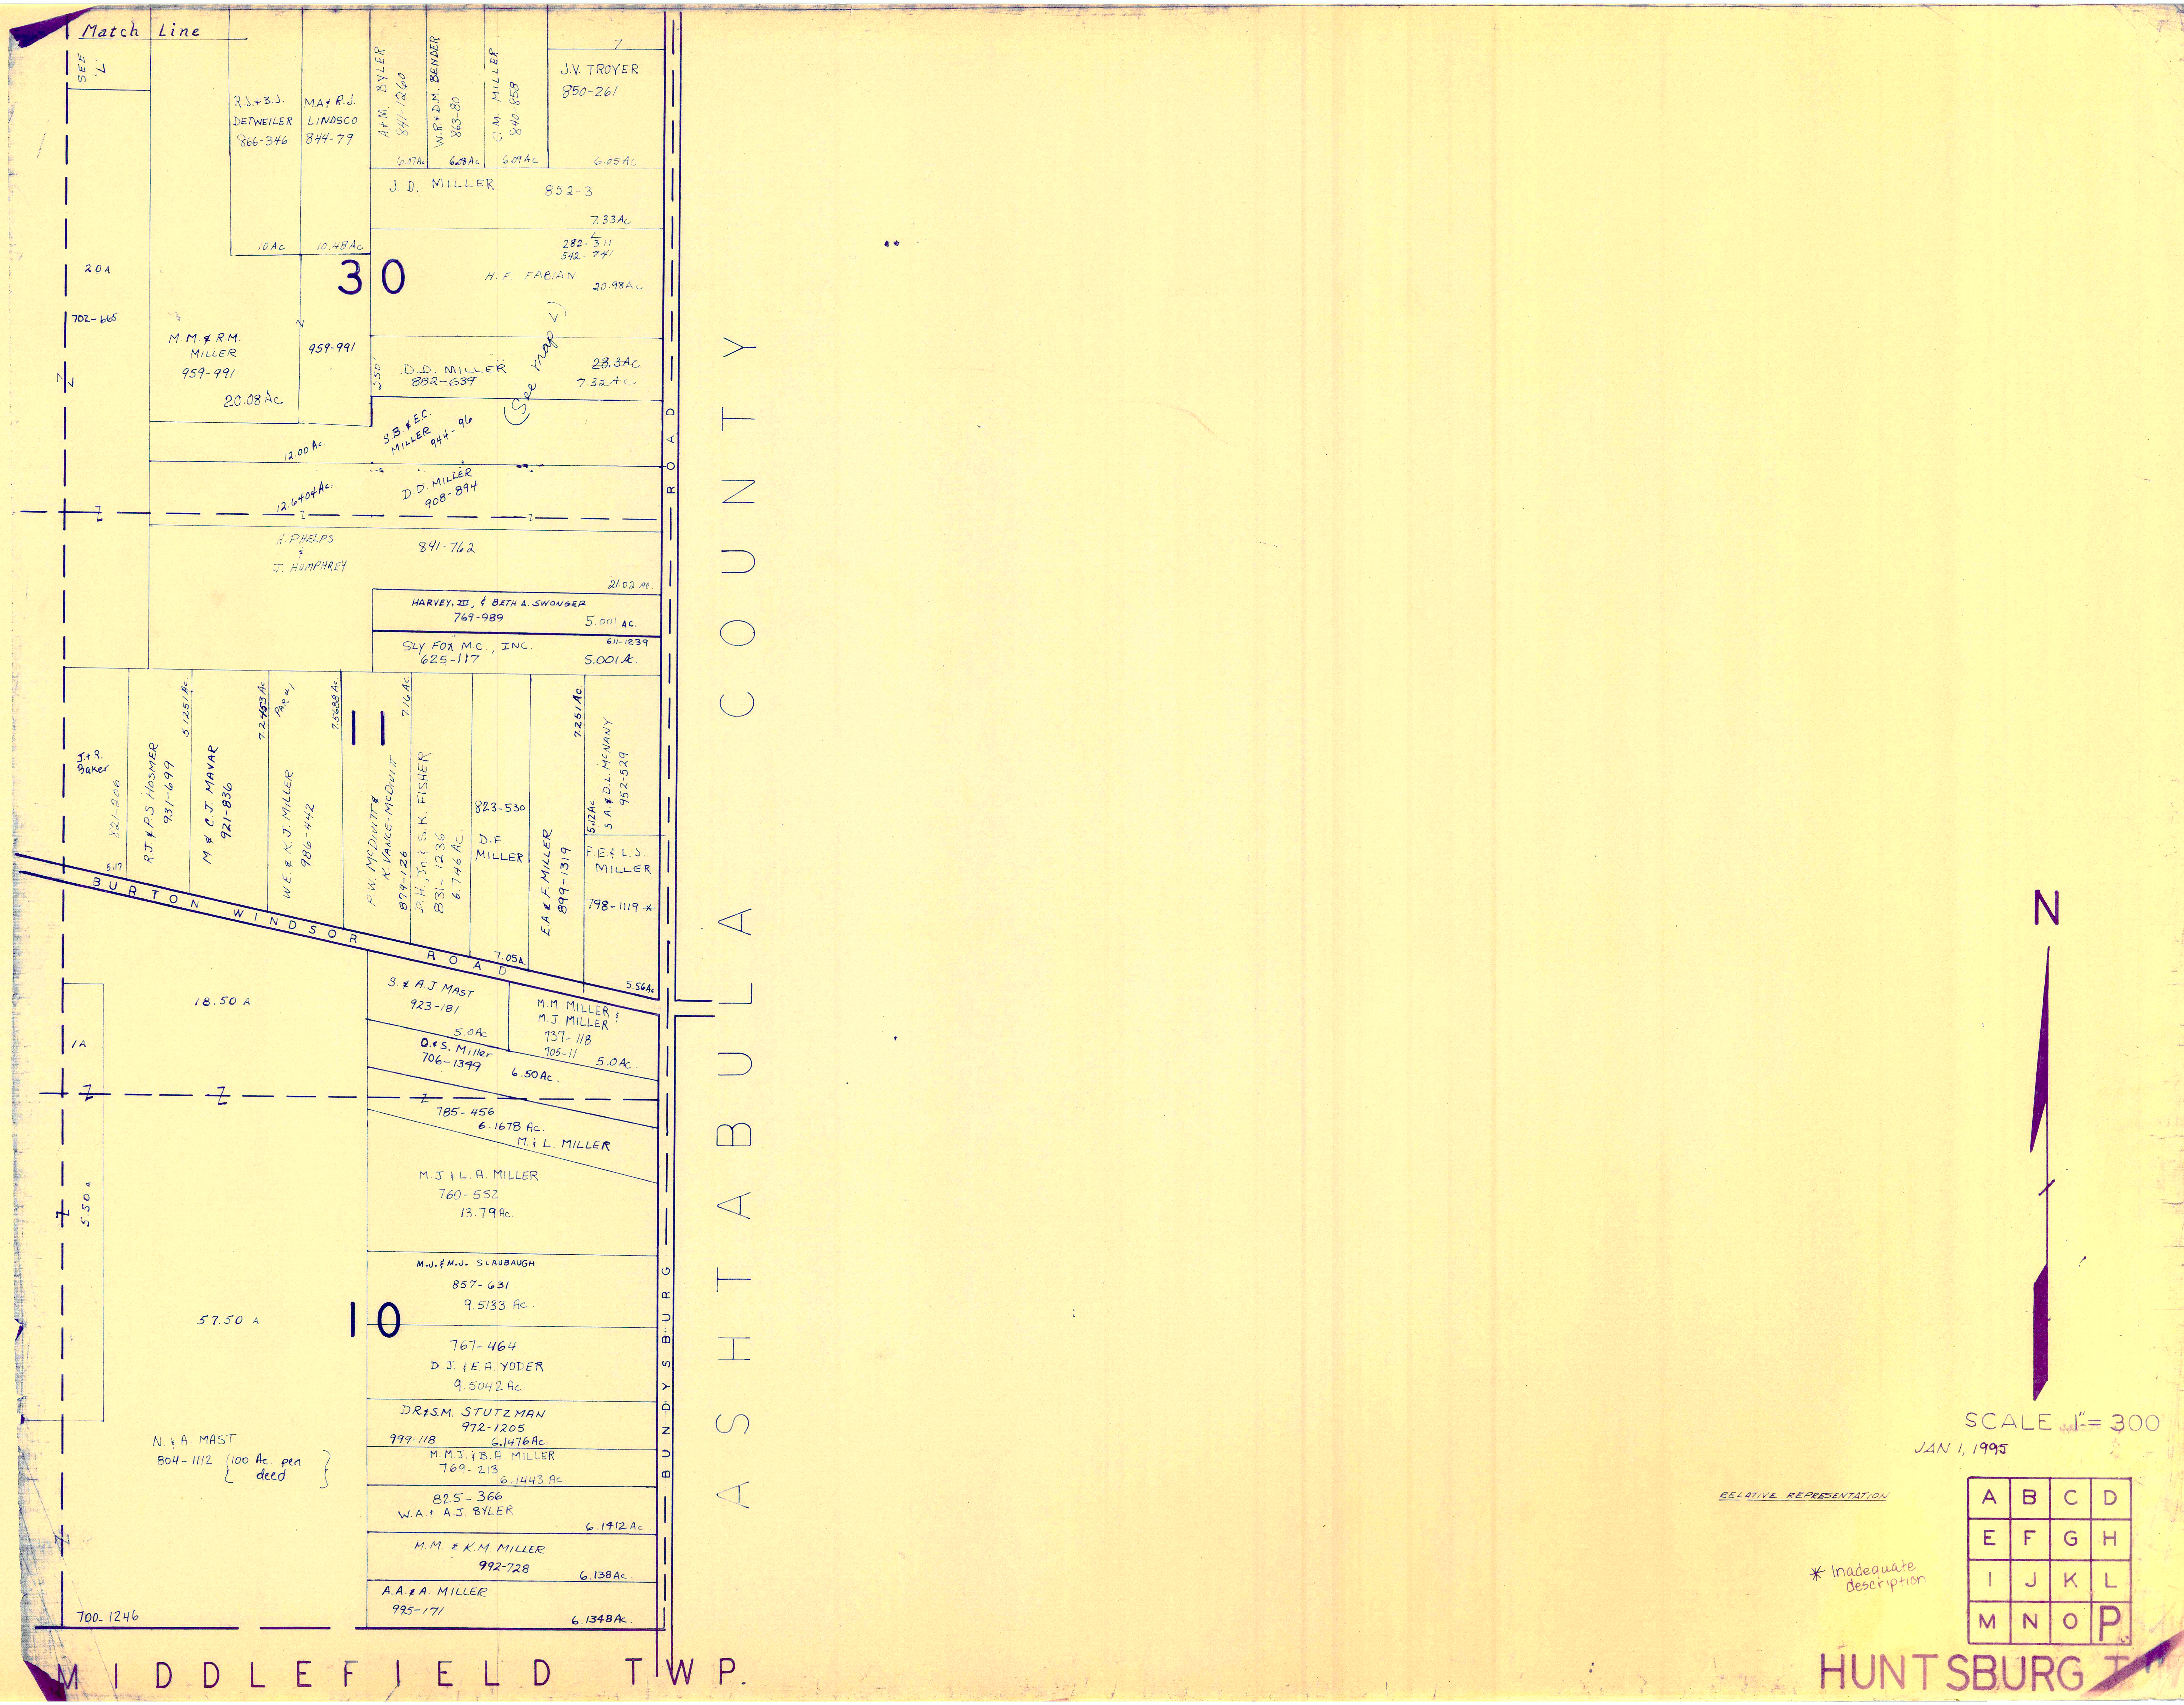Match Line
SEE 'L'
R.J. + B.J. DETWEILER 866-346
10 Ac
M.A. + R.J. LINDSCO 844-79
10.48 Ac
A. + M. BYLER 841-1260
6.07 Ac
W.R. + D.M. BENDER 863-80
6.08 Ac
C.M. MILLER 840-858
6.09 Ac
J.V. TROYER 850-261
6.05 Ac
J. D. MILLER 852-3
7.33 Ac
282-311
542-741
H. F. FABIAN
20.98 Ac
30
20 A
702-665
M.M. & R.M. MILLER 959-991
20.08 Ac
959-991
250'
D.D. MILLER 882-639
~~28.3 Ac~~
7.32 Ac
(See map V)
S.B. & E.C. MILLER 944-96
12.00 Ac.
D.D. MILLER 908-894
12.6404 Ac.
H. PHELPS & J. HUMPHREY
841-762
21.02 Ac.
HARVEY, III, & BETH A. SWONGER
769-989
5.001 Ac.
SLY FOX M.C., INC.
625-117
611-1239
5.001 Ac.
11
J. + R. Baker
821-206
5.17
R.J. & P.S. HOSMER 931-699
5.1251 Ac.
M. & C.J. MAVAR 921-836
7.2453 Ac.
PAR #1
W.E. & K.J. MILLER 986-442
7.5688 Ac.
F.W. McDIVITT & K. VANCE-McDIVITT 879-126
7.16 Ac.
D.H., Jr. & S.K. FISHER 831-1236 6.746 Ac.
823-530
D.F. MILLER
7.05 A.
E.A. & F. MILLER 899-1319
7.251 Ac.
S.A. & D.L. McNANY 952-529
5.12 Ac.
F.E. & L.S. MILLER
798-1119 *
5.56 Ac.
BURTON WINDSOR ROAD
18.50 A
1 A
S. & A.J. MAST
923-181
5.0 Ac.
M.M. MILLER & M.J. MILLER
737-118
705-11
5.0 Ac.
O. & S. Miller
706-1349
6.50 Ac.
785-456
6.1678 Ac.
M. & L. MILLER
M.J. & L.A. MILLER
760-552
13.79 Ac.
5.50 A
M.J. & M.J. SLAUBAUGH
857-631
9.5133 Ac.
10
57.50 A
767-464
D.J. & E.A. YODER
9.5042 Ac.
DR & S.M. STUTZMAN
972-1205
999-118
6.1476 Ac.
N. & A. MAST
804-1112 {100 Ac. per deed}
M.M.J. & B.A. MILLER
769-213
6.1443 Ac.
825-366
W.A. & A.J. BYLER
6.1412 Ac.
M.M. & K.M. MILLER
992-728
6.138 Ac.
A.A. & A. MILLER
995-171
6.1348 Ac.
700-1246
BUNDYSBURG ROAD
ASHTABULA COUNTY
MIDDLEFIELD TWP.
N
SCALE 1" = 300
JAN 1, 1995
RELATIVE REPRESENTATION
* Inadequate description
A B C D
E F G H
I J K L
M N O P
HUNTSBURG T

HUNTSBURG TP.
CENTER

INDEX TO PROPERTIES HAVING #NO.'S

#1	719-18	J.L.+K.M. WHITE	.61 A.
#2	~~550-1003~~; 1004-839; 1008-1292 3-2-95	~~P.~~ T.P.&S.M. Thurling ~~Jr.~~ Q.C. 1-3-95	.63 A.
#3	971-1198	J.P. BRUENING	.60 A.
#4	491-321	Township of Huntsburg	.35 A.
#5	122-499, 130-169	Township of Huntsburg	
#6	880-627;629	T.P. THURLING	.13 Ac.
#7	943-920	D. HUTCHINSON	.25 A.
#8	776-840	K. MILLER	.50 A.
#9	890-1113	E.C. & D.S. PLICKERT	.50 A.
#10	747-676	KAREN EDITH PHILLIPS	.50 A.
#11	878-802*	J.A. BRUNER	.08 A.
#12	805-477	A.J. OWENS	.27 A.
#13	878-802*	J.A. BRUNER	.49 A.
#14	758-550	T.T.J. TRUST	.05 A.
#15	1004-560	L.R. CHURA & T.L. SHAFFER	.1726
#16	599-27	S.E. RHODES	.87 A.
#17	695-1038	J. & R.&G. Sykora & S. Cook	.22 A. 1/4 int
#18	585-671	F. HALL	.33 A.
#19	865-259	T.A. Loze & D. Perko	.50 A.
#20	469-239	K. Motil	

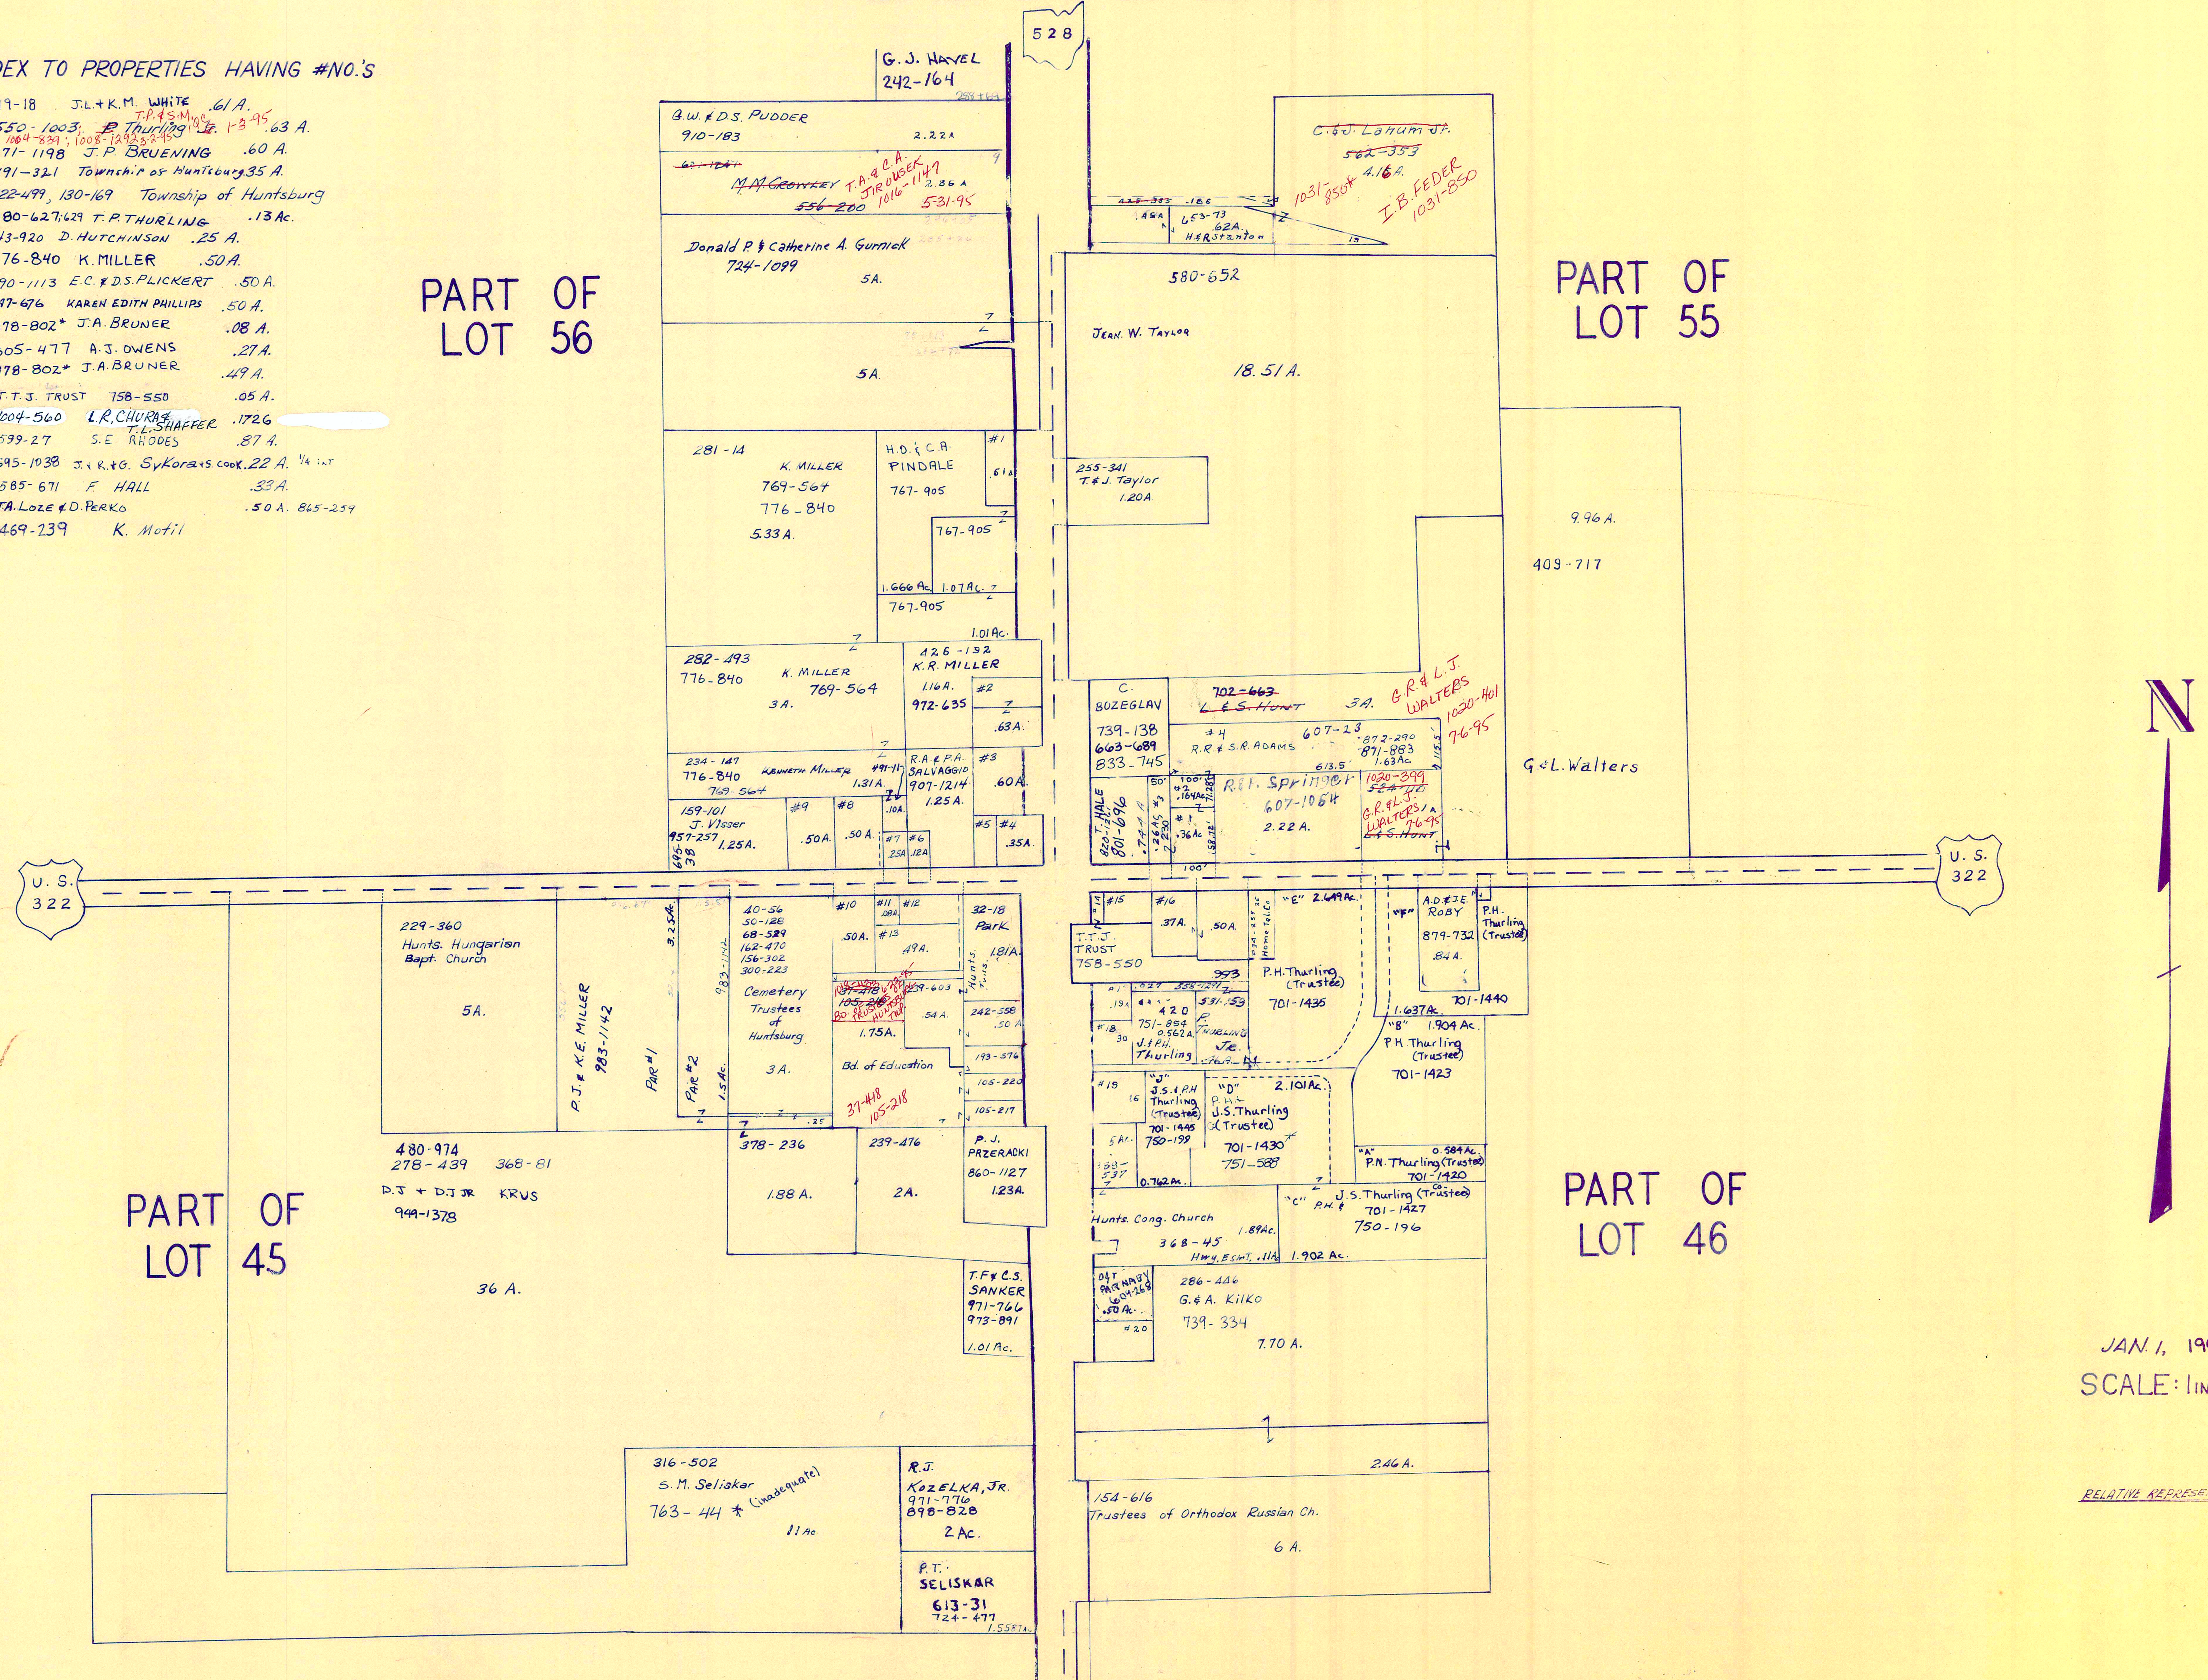
528
G.J. HAVEL 242-164
G.W. & D.S. PUDDER 910-183 2.22 A
~~M.M. Crowley~~ ~~556-200~~ T.A. & C.A. JIROUSEK 1016-1147 5-31-95 2.86 A
Donald P. & Catherine A. Gurnick 724-1099 5A.
5A.
~~C.&J. Lahum Jr.~~ ~~562-353~~ 4.16 A. I.B. FEDER 1031-850
1031-850*
653-73 .62A. H.E. Stanton
.45A
580-652 Jean W. Taylor 18.51 A.
255-341 T.&J. Taylor 1.20A.
PART OF LOT 56
PART OF LOT 55
9.96 A. 409-717
G.&L. Walters
281-14 K. MILLER 769-564 776-840 5.33 A.
H.D. & C.A. PINDALE 767-905
#1 .61 A
767-905
1.666 Ac. 1.07 Ac.
767-905 1.01 Ac.
282-493 776-840 K. MILLER 769-564 3A.
426-192 K.R. MILLER 1.16A. 972-635
#2 .63A.
234-147 776-840 Kenneth Miller 769-564 491-11 1.31A.
R.A. & P.A. SALVAGGIO 907-1214 1.25A.
#3 .60A.
159-101 J. Visser 957-257 1.25A. 695-38
#9 .50A.
#8 .50A.
.10A.
#7 .25A
#6 .12A
#5
#4 .35A.
C. BOZEGLAV 739-138 663-689 833-745
~~702-663~~ ~~L.&S. Hunt~~ 3A. G.R. & L.J. WALTERS 1020-401 7-6-95
#4 R.R. & S.R. ADAMS 607-23 872-290 871-883 1.63 Ac.
T. HALE 820-1211 801-696 .744 A
#3 .26 Ac 2230
#2 .164 Ac
#1 .36 Ac
R.&I. Springer 607-1064 2.22 A.
1020-399 ~~524-110~~ G.R.&L.J. WALTERS 7-6-95 ~~L.&S. Hunt~~
U.S. 322
229-360 Hunts. Hungarian Bapt. Church 5A.
P.J. & K.E. MILLER 983-1142
PAR #1
PAR #2 1.5 Ac.
3.25 Ac.
983-1142
40-56 50-128 68-529 162-470 156-302 300-223
Cemetery Trustees of Huntsburg 3A.
#10 .50A.
#11 .08A.
#12
#13 .49A.
1018-1133 ~~37-418~~ ~~105-218~~ BD. OF ED. TO TRUSTEES OF HUNTSBURG TWP. 6-23-95
239-603 .54 A.
1.75A.
Bd. of Education
37-418 105-218
32-18 Park 1.81A.
Hunts. Twp.
242-558 .50 A.
193-576
105-220
105-217
480-974 278-439 368-81
D.J. + D.J. JR KRUS 949-1378
PART OF LOT 45
36 A.
378-236 1.88 A.
239-476 2A.
P.J. PRZERACKI 860-1127 1.23A.
T.F. & C.S. SANKER 971-766 973-891 1.01 Ac.
316-502 S.M. Seliskar 763-44 * (inadequate) 11 Ac
R.J. KOZELKA, JR. 971-776 898-828 2 Ac.
P.T. SELISKAR 613-31 724-477 1.5587 Ac.
#14
#15
#16 .37A.
.50A.
T.T.J. TRUST 758-550
Home Tel. Co
"E" 2.649 Ac.
P.H. Thurling (Trustee) 701-1435
"F"
A.D. & J.E. ROBY 879-732 .84A.
P.H. Thurling (Trustee) 701-1440
1.637 Ac.
#17 .19A
420 751-854 0.562 A. J. & P.H. Thurling
558-1291
531-559 P. THURLING JR.
#18
"B" 1.904 Ac. P.H. Thurling (Trustee) 701-1423
#19
"J" J.S. & P.H. Thurling (Trustee) 701-1445 750-199
"D" 2.101 Ac. P.H. & J.S. Thurling (Trustee) 701-1430* 751-588
5 Ac.
388-537
0.762 Ac.
"A" 0.584 Ac. P.N. Thurling (Trustee) 701-1420
"C" P.H. & J.S. Thurling Co-(Trustee) 701-1427 750-196
1.902 Ac.
Hunts. Cong. Church 1.89 Ac. 368-45 Hwy. Esmt. .11A
D.&T. PARTNABY 609-268 .50 Ac.
#20
286-446 G.& A. Kilko 739-334 7.70 A.
2.46 A.
154-616 Trustees of Orthodox Russian Ch. 6 A.
PART OF LOT 46
N

JAN. 1, 1995
SCALE: 1 IN. = 200'

RELATIVE REPRESENTATION

* Inadequate description

Q8 CENTER