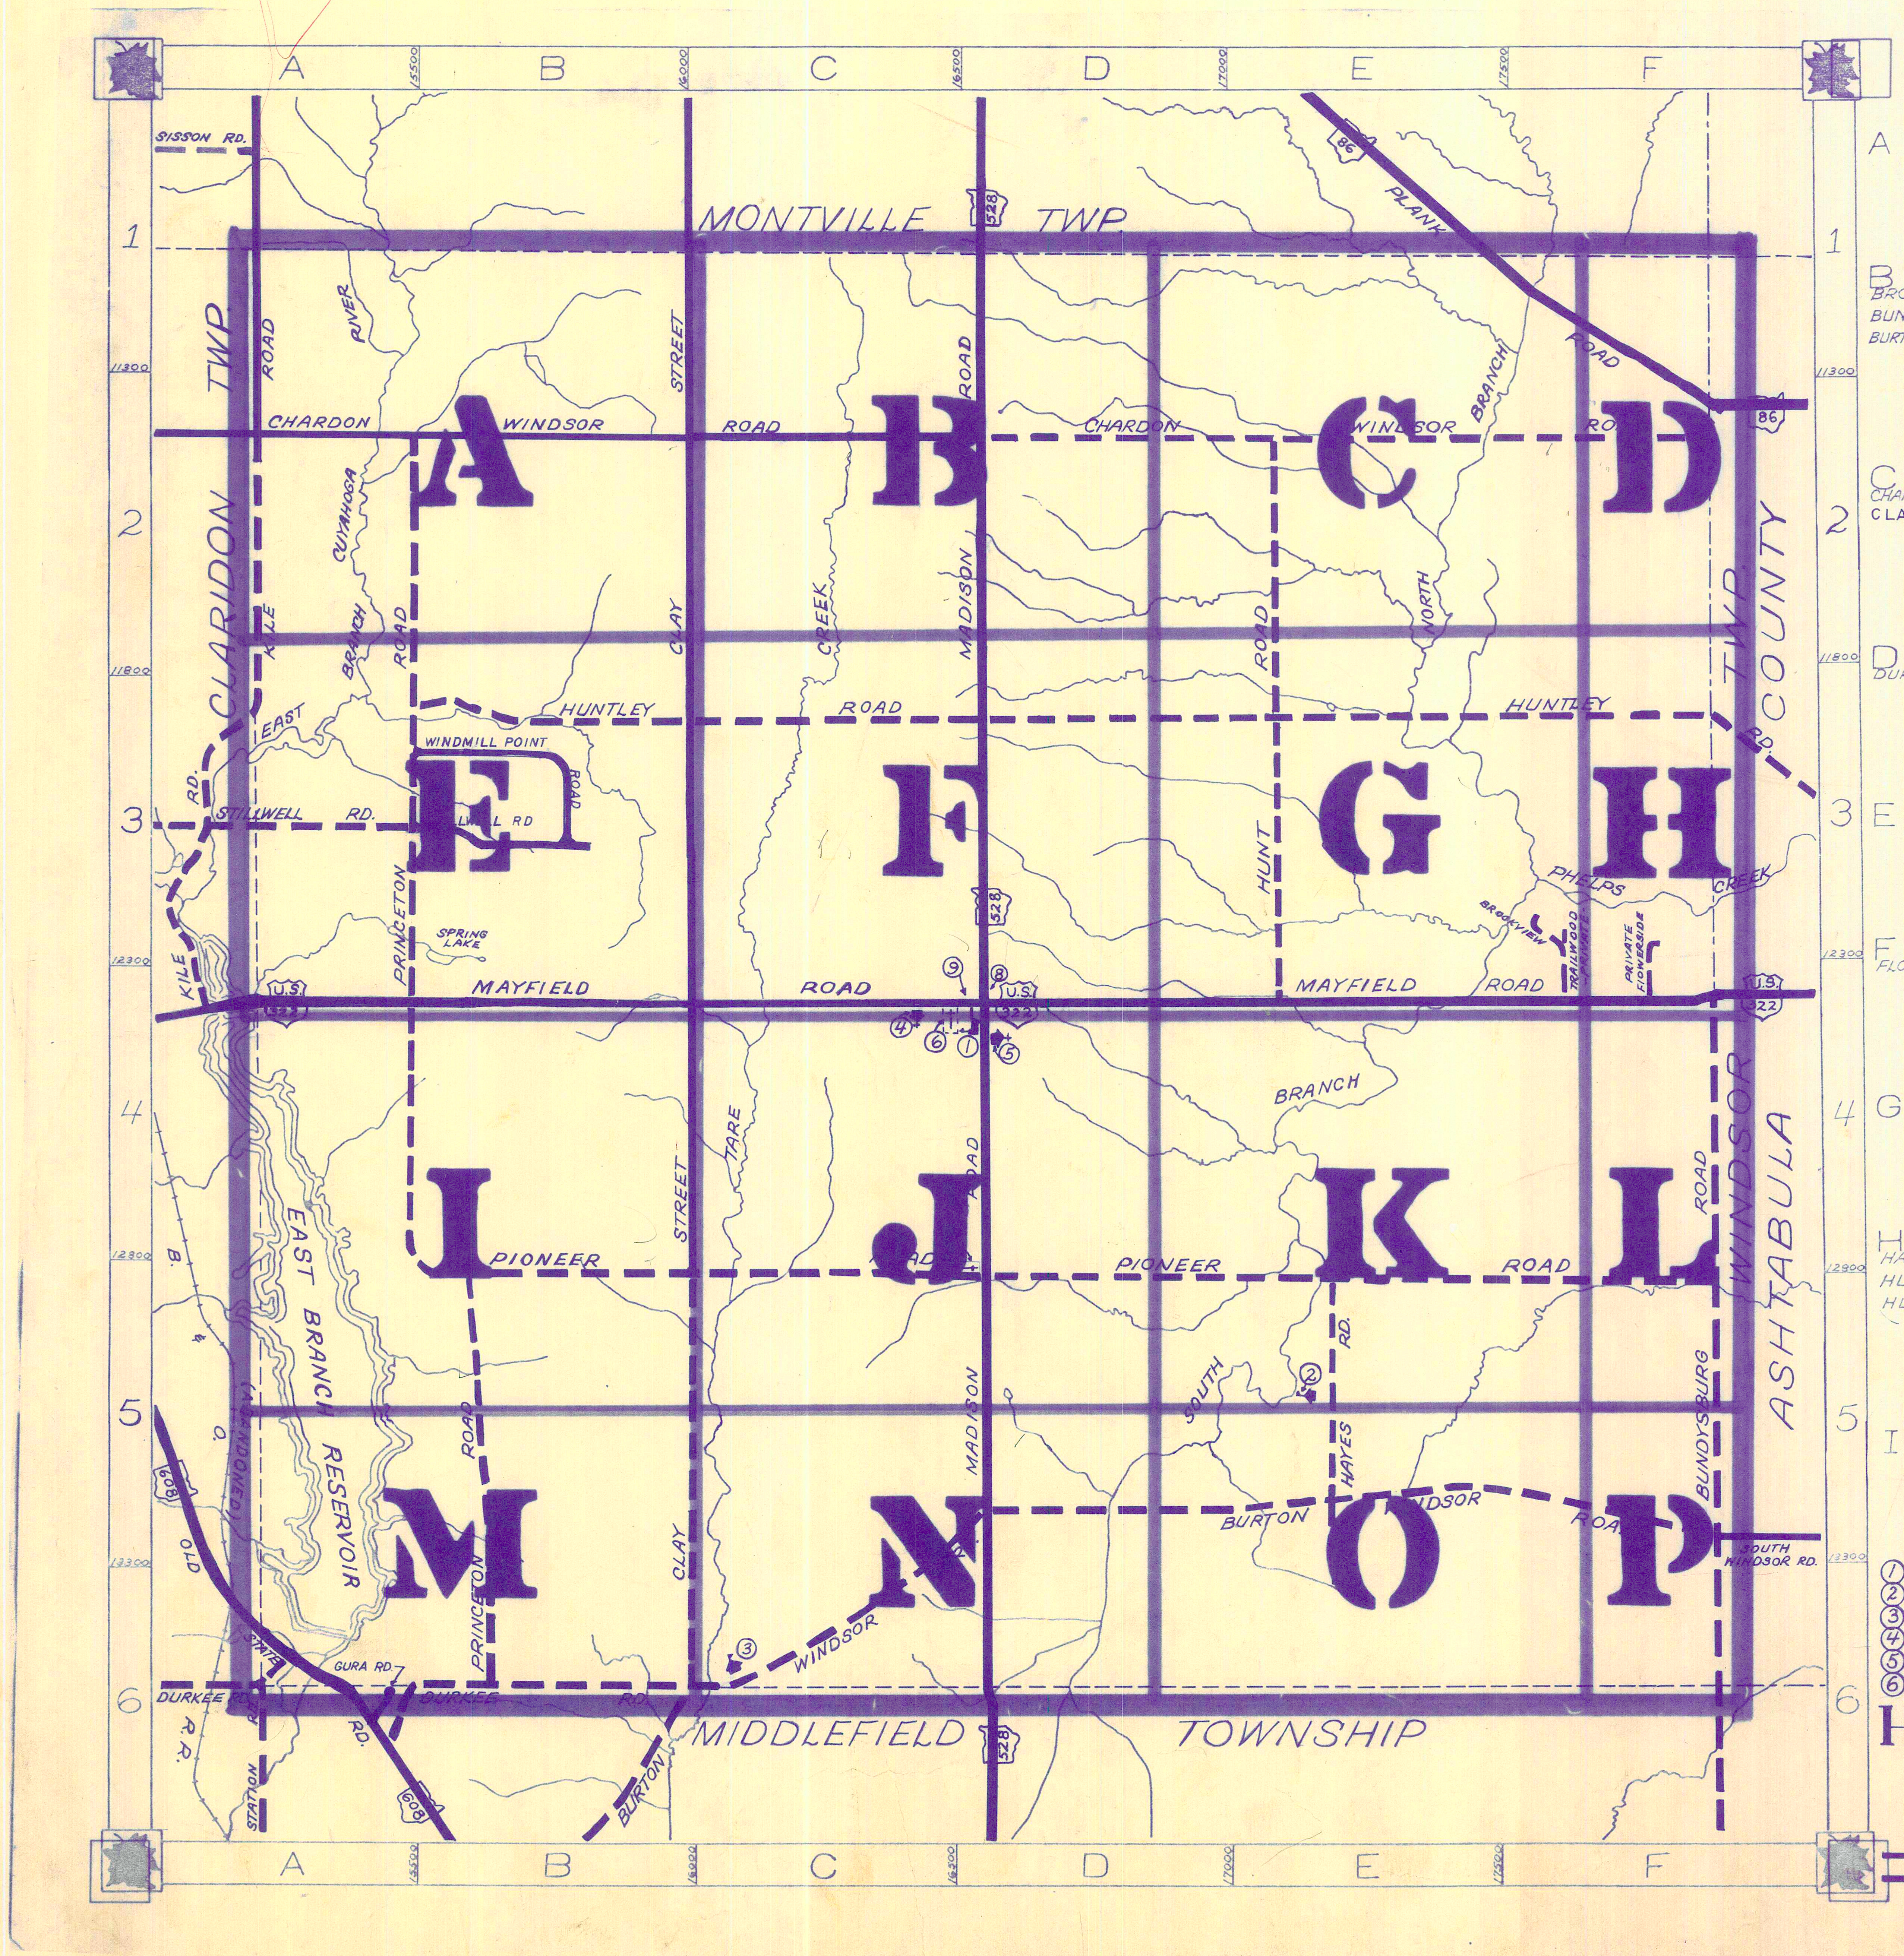
A
B
C
D
E
F
1
2
3
4
5
6
SISSON RD.
MONTVILLE TWP
528
86
PLANK ROAD
CLARIDON TWP
KILE ROAD
CUYAHOGA RIVER
CHARDON WINDSOR ROAD
CLAY STREET
CREEK
MADISON ROAD
NORTH BRANCH
HUNTLEY ROAD
WINDMILL POINT RD
STILLWELL RD.
EAST BRANCH
PRINCETON RD
SPRING LAKE
HUNT RD
PHELPS CREEK
BROOKVIEW
TRAILWOOD
PRIVATE FLOWERSIDE
MAYFIELD ROAD
US 322
BRANCH
TARE
PIONEER ROAD
SOUTH
HAYES RD.
BURTON WINDSOR ROAD
BUNDYSBURG ROAD
SOUTH WINDSOR RD.
WINDSOR TWP
ASHTABULA COUNTY
EAST BRANCH RESERVOIR
OLD STATE RD.
608
GURA RD.
DURKEE RD.
R.R.
STATION RD.
BURTON
MIDDLEFIELD TOWNSHIP
A
B
C
D
E
F
G
H
I
J
K
L
M
N
O
P
11300
11800
12300
12800
13300

ROAD INDEX

A

B
BROOKVIEW RD. (PVT) F3
BUNDYSBURG RD. F4-F6
BURTON WINDSOR RD. C6-F5

C
CHARDON WINDSOR RD. A2-F2
CLAY STREET B1-B6

D
DURKEE RD. A6-B6

E

F
FLOWERSIDE RD. (PVT) F4

G

H
HAYES RD. E5
HUNTLEY RD. B3-F3
HUNT RD. E2-E4

I

J

K
KILE RD. A1-A4

L

M
MADISON RD. D1-D6
MAYFIELD RD. A4-F4

N

O
OLD STATE RD. A6

P
PIONEER RD. B5-F5
PLANK RD. E1-F2
PRINCETON RD. B2-B6

Q

R

S
STILLWELL RD. A3

T
TRAILWOOD RD. (PVT) F4

U

V

W
WINDMILL POINT ROAD B3

X

Y

Z

N

① HUNTSBURG ELEM. SCHOOL
② AMISH SCHOOL
③ AMISH SCHOOL
④ HUNTSBURG BAPTIST CH.
⑤ HUNTSBURG CONGREGATIONAL CH.
⑥ HUNTSBURG CEMETERY
⑦ HUNTSBURG CEMETERY
⑧ UNITED STATES POST OFFICE
⑨ TOWN HALL
⑩

HUNTSBURG TOWNSHIP

0 5 10 15 20
SCALE : 1" = 2000'

ROBERT L. PHILLIPS,
GEAUGA COUNTY ENGINEER

- - - - UNPAVED ROADS
—— PAVED ROADS
- - - - TOWNSHIP LINE
— - — COUNTY LINE

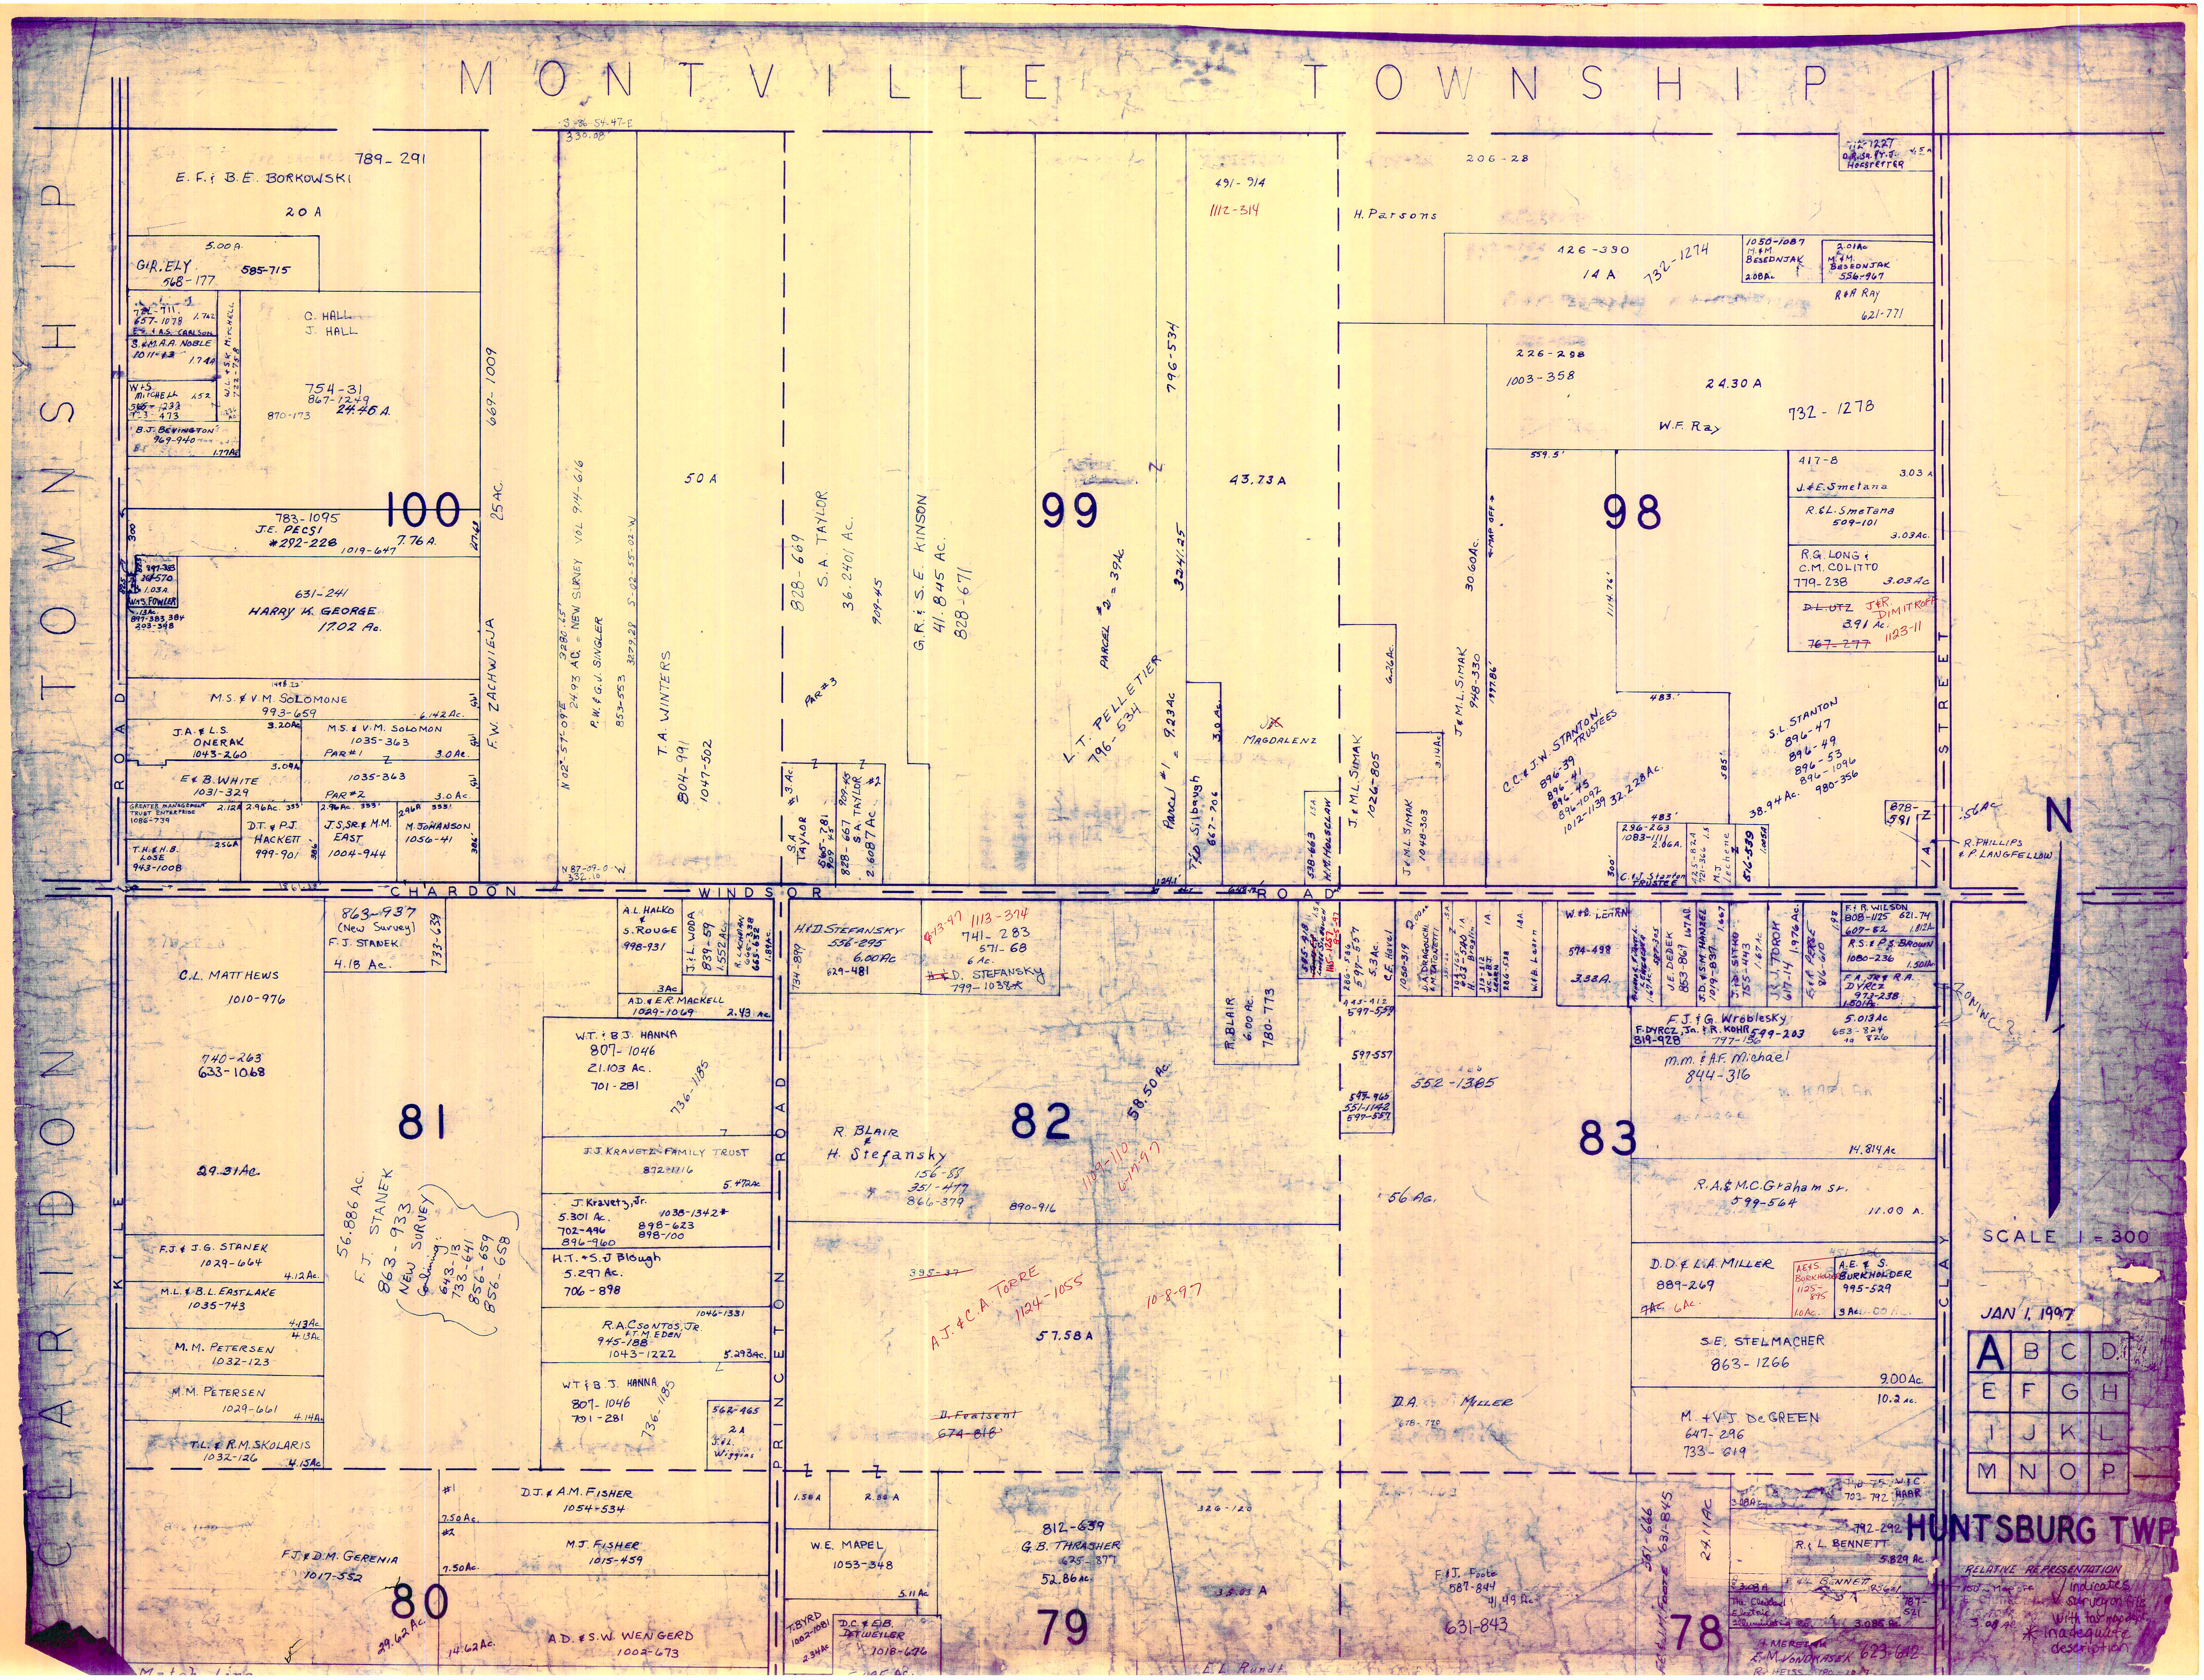
MONTVILLE TOWNSHIP
CLARIDON TOWNSHIP
KILE ROAD
CHARDON WINDSOR ROAD
PRINCETON ROAD
CLAY STREET
100
99
98
81
82
83
80
79
78
N
S-86-54-47-E 330.08
789-291
E.F. & B.E. BORKOWSKI
20 A
5.00 A.
G.R. ELY 568-177
585-715
722-711 657-1078 1.742
E.S. & A.S. CARLSON
S. & M.A.A. NOBLE 1011-63 1.74A
W. & S. MITCHELL 565-1232 723-473 1.52
W.L. & S.K. MITCHELL 722-758 1.236 Ac
B.J. BEVINGTON 969-940 1.77Ac
C. HALL
J. HALL
754-31
867-1249
24.46 A.
870-173
669-1009
25 AC.
783-1095
J.E. PECSI
*292-228
7.76 A.
1019-647
300
897-383 361-570 1.03A.
W. & S. FOWLER
.13Ac. 897-383 384 203-398
631-241
HARRY K. GEORGE
17.02 Ac.
F.W. ZACHWIEJA
1498.22'
M.S. & V.M. SOLOMONE 993-659
6.142 Ac.
J.A. & L.S. ONERAK 1043-260
3.20Ac
M.S. & V.M. SOLOMON 1035-363 PAR #1 3.0 Ac.
3.09Ac
E & B. WHITE 1031-329
1035-363 PAR #2 3.0 Ac.
GREATER MANAGEMENT TRUST ENTERPRISE 1086-739
2.12A
2.96Ac. 333'
T.H. & H.B. LOSE 943-1008
2.56A
D.T. & P.J. HACKETT 999-901
386'
J.S. SR. & M.M. EAST 1004-944
M. JOHANSON 1056-41
1861.38'
N 02-57-09 E 3280.65'
24.93 AC. = NEW SURVEY VOL 914-616
P.W. & G.J. SINGLER
853-553
3279.28 S-02-55-02-W
N 87-09-0-W 332.10
50 A
T.A. WINTERS
804-991
1047-502
828-669
S.A. TAYLOR
36.2401 Ac.
909-45
PAR #3
S.A. TAYLOR #1 3. Ac.
565-781 909-45
828-667 909-45
S.A. TAYLOR #2 2.6087 Ac.
G.R. & S.E. KINSON
41.845 Ac.
828-671
PARCEL #2 = 39Ac
L.T. PELLETIER 796-534
PARCEL #1 = 9.23Ac
796-534
3241.25
124.1'
491-914
1112-314
43.73 A
T. & D. Silbaugh 667-706
3.0 Ac.
MAGDALENZ
648.12'
538-663 H.M. HOLSCLAW 1.5A.
J. & M.L. SIMAK 1026-805
6.26Ac.
J. & M.L. SIMAK 1048-303
3.14Ac.
J. & M.L. SIMAK 948-330
30.60Ac.
1997.86'
← MAP OFF →
206-28
H. Parsons
426-390
14 A
732-1274
1050-1087 M. & M. BESEDNJAK 2.08Ac.
2.01Ac M. & M. BESEDNJAK 556-967
R & A Ray 621-771
712-1227 D.R. SR. & T.J. HOFSTETTER V.5 A
226-298
1003-358
24.30 A
732-1278
W.F. Ray
559.5'
1114.76'
483.'
C.C. & J.W. STANTON TRUSTEES
896-39
896-41
896-45
896-1092
1012-1139
32.228 Ac.
585'
S.L. STANTON
896-47
896-49
896-53
896-1096
980-356
38.94 Ac.
483'
296-263 1083-1111 2.06A.
300'
C. & J. Stanton TRUSTEE
425-824 721-366 1.5
M.J. Lechene
516-539 1.005A
417-8 3.03 A J. & E. Smetana
R. & L. Smetana 509-101 3.03Ac.
R.G. LONG & C.M. COLITTO 779-238 3.03 Ac
~~D.L. UTZ~~ J & R. DIMITROFF 3.91 Ac. ~~767-277~~ 1123-11
878-591
.56Ac
1A
R. PHILLIPS & P. LANGFELLOW
863-937 (New Survey)
F.J. STANEK
4.18 Ac.
733-639
C.L. MATTHEWS
1010-976
740-263
633-1068
29.31Ac.
F.J. & J.G. STANEK 1029-664 4.12Ac.
M.L. & B.L. EASTLAKE 1035-743 4.13Ac.
4.13Ac.
M.M. PETERSEN 1032-123
M.M. PETERSEN 1029-661 4.14Ac
T.L. & R.M. SKOLARIS 1032-126 4.15Ac
56.886 Ac.
F.J. STANEK
863-933
NEW SURVEY
(combining: 643-13 733-641 856-659 856-658)
A.L. HALKO & S. ROUGE 998-931
3Ac
J. & L. WODA 839-59 1.552 Ac.
R. LACHMAN 665-338 665-632 1.89Ac.
A.D. & E.R. MACKELL 1029-1069 2.43 Ac.
W.T. & B.J. HANNA 807-1046 21.103 Ac. 701-281
736-1185
J.J. KRAVETZ FAMILY TRUST 872-1116 5.472Ac
J. Kravetz, Jr. 5.301 Ac. 702-496 896-960
1038-1342* 898-623 898-100
H.T. & S.J Blough 5.297 Ac. 706-898
1046-1331
R.A. CSONTOS, JR. & T.M. EDEN 945-188 1043-1222 5.293Ac.
W.T. & B.J. HANNA 807-1046 701-281
736-1185
562-465 2A J. & L. Wiggins
#1 D.J. & A.M. FISHER 1054-534 7.50 Ac.
#2 M.J. FISHER 1015-459 7.50Ac.
F.J. & D.M. GERENIA 1017-552
29.62 Ac.
14.62Ac.
A.D. & S.W. WENGERD 1002-673
T. BYRD 1002-1081 2.34Ac
734-899
H. & D. STEFANSKY 556-295 6.00Ac 629-481
~~6-13-97~~ 1113-374
741-283 571-68 6 Ac.
~~H &~~ D. STEFANSKY 799-1038*
R. BLAIR 6.00 Ac. 780-773
585-418 1.5A
1115-1257 8-5-97
286-586 597-557 5.3Ac.
C.E. Havel
1050-319
2.00Ac D.A. DRAGOLICH & M. TATONETTI
.5A
303-165 633-540 H. Broglin 1A
319-312 W.C. & B.T. LEARN 1A
286-538
1.8A.
W. & B. Learn
W. & B. LEARN 574-498 3.33A.
1.67Ac.
587-305
J.E. DEDEK 853-869 1.67 AC.
J.D. & S.M. HANZEL 1019-837 1.667
755-443 1.67 Ac
J.J. TOROK 617-14 1.976 Ac.
E & R PERBE 816-610
1.98
F. & R. WILSON 808-1125 621-74 607-82 1.812A
R.S. & P.S. BROWN 1080-236 1.501Ac
F.A. JR. & R.A. DYRCZ 973-238 1.501Ac.
ZONING?
443-412 597-557
597-557
597-965 551-1142 597-557
R. BLAIR & H. Stefansky
156-88
351-477
866-379
890-916
58.50 Ac.
1109-110 6-11-97
~~395-37~~
A.J. & C.A. TORRE 1124-1055
10-8-97
57.58 A
~~D. Fealsent~~
~~674-818~~
552-1385
56 Ac.
D.A. MILLER 678-770
F.J. & G. Wroblesky 599-203
F. DYRCZ, Jr. & R. KOHR 819-928 797-156
5.013Ac 653-824 to 826
M.M. & A.F. Michael 844-316
14.814 Ac
R.A. & M.C. Graham Sr. 599-564
11.00 A.
D.D. & L.A. MILLER 889-269
~~7Ac.~~ 6Ac.
A.E. & S. BURKHOLDER 1125-895 1.0Ac.
A.E. & S. BURKHOLDER 995-529 3 Ac.
S.E. STELMACHER 863-1266
9.00Ac.
10.2 Ac.
M. & V.J. DeGREEN 647-296 733-619
1.58 A
2.88 A
W.E. MAPEL 1053-348
5.11 Ac
D.C. & E.B. DETWEILER 1018-676
812-639
G.B. THRASHER
625-877
52.86Ac.
326-120
35.03 A
E.L. Rundt
F. & J. Foote 587-844 41.49 Ac.
631-843
351-666
631-845
F.E. & L.M. FOOTE
24.11 AC
W. & C. HAAR 703-792
3.08Ac.
792-292
R. & L. BENNETT
5.829 Ac.
R. & L. BENNETT
3.08 A
The Cleveland Electric Illuminating Co.
787-521
3.085 Ac.
MERECIK
E.M. VONDRASEK 623-612
R. HEISS
SCALE 1 = 300
JAN 1, 1997
A B C D
E F G H
I J K L
M N O P
HUNTSBURG TWP
RELATIVE REPRESENTATION
✓ indicates survey on file with tax map dept.
* inadequate description

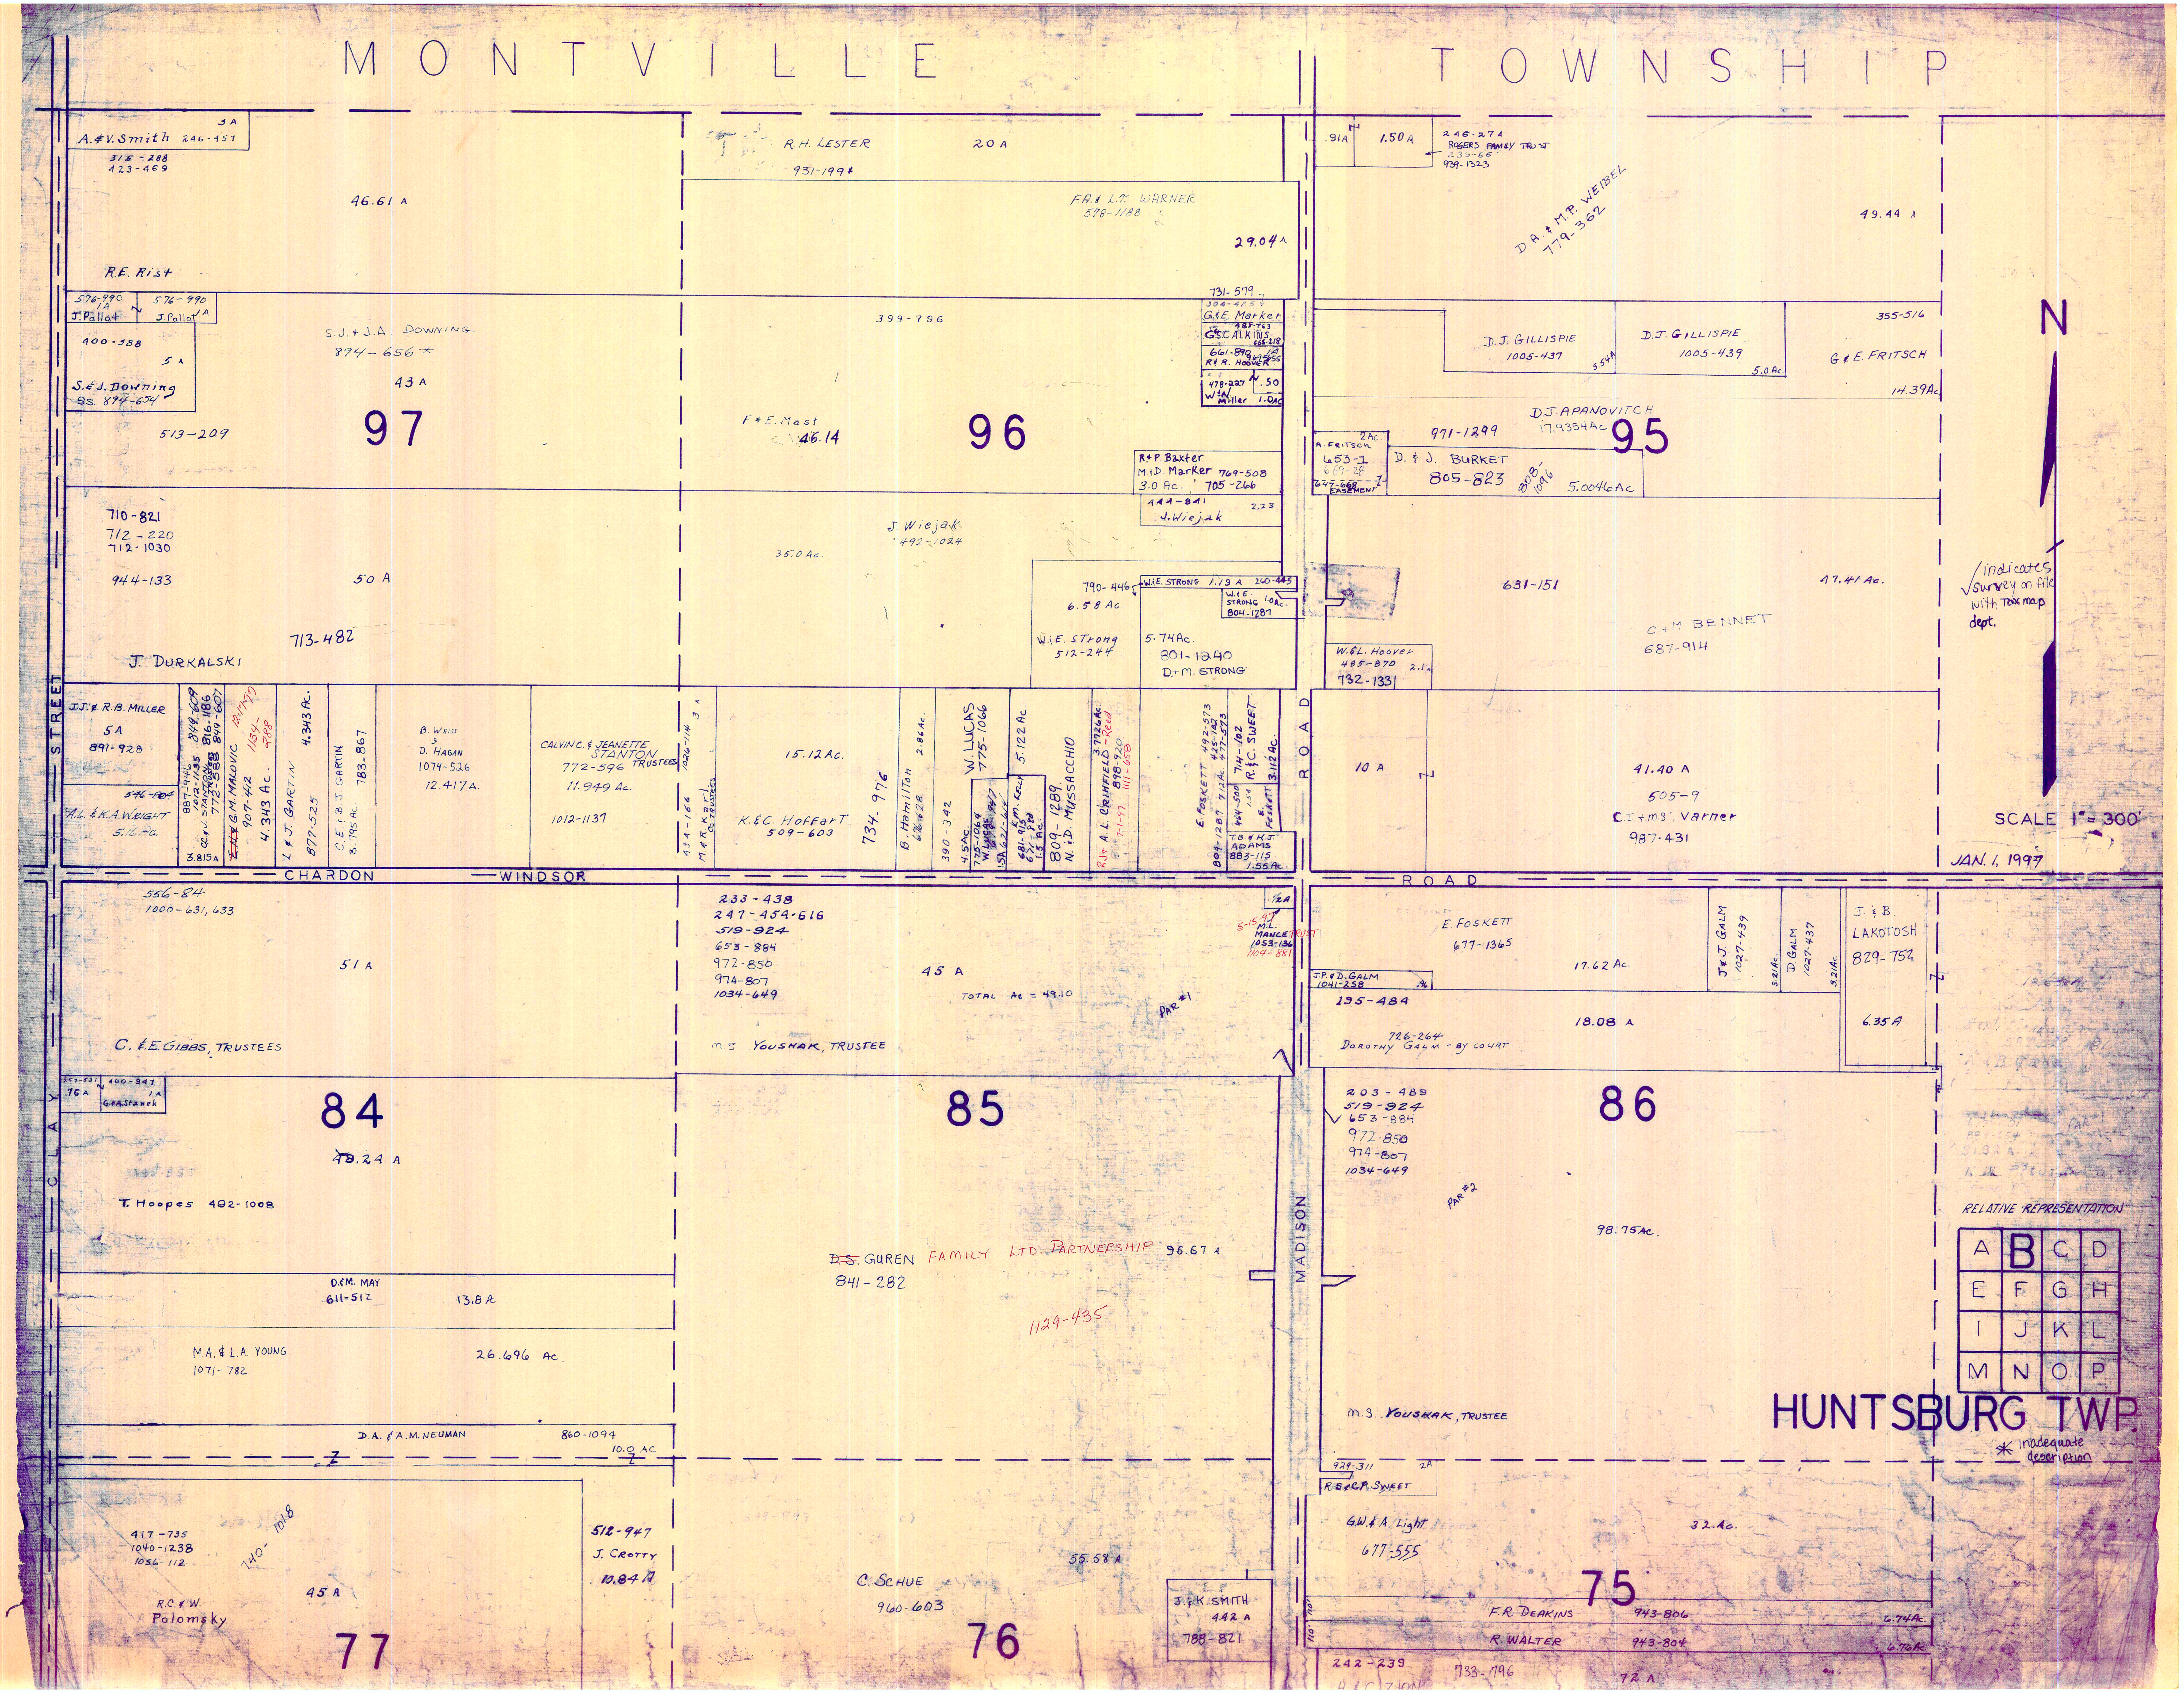MONTVILLE TOWNSHIP
HUNTSBURG TWP.
SCALE 1" = 300'
JAN. 1, 1997
N
* inadequate description
√ indicates survey on file with Tax map dept.
RELATIVE REPRESENTATION
A B C D
E F G H
I J K L
M N O P
CLAY STREET
CHARDON WINDSOR ROAD
MADISON ROAD
97
96
95
84
85
86
77
76
75
A. & V. Smith 246-457
3A
315-288
423-469
46.61 A
R.E. Rist
576-990 1A J. Pallat
576-990 1A J. Pallat
400-388
5A
S. & J. Downing 894-654
S.J. & J.A. Downing 894-656 *
43 A
513-209
710-821
712-220
712-1030
944-133
50 A
713-482
J. Durkalski
R.H. Lester 20 A
931-1998
F.R. & L.T. Warner 598-1188
29.04 A
399-796
F & E Mast 46.14
731-579
G & E Marker
G.S. Calkins
R & R. Hoover
W & N Miller
R & P. Baxter
M.D. Marker 769-508
3.0 Ac. 705-266
444-841
J. Wiejak
J. Wiejak 492-1024
35.0 Ac.
790-446
6.58 Ac.
W. & E. Strong 1.19 A
W. & E. Strong 804-1287
W. & E. Strong 512-244
5.74 Ac.
801-1240
D. & M. Strong
.91 A
1.50 A
246-271
Rogers Family Trust
979-1323
D.A. & M.P. Weibel 779-362
49.44 A
D.J. Gillispie 1005-437
5.54 A
D.J. Gillispie 1005-439
5.0 Ac.
355-516
G & E. Fritsch
14.39 Ac.
D.J. Apanovitch
17.9354 Ac.
971-1299
R. Fritsch
2 Ac.
653-1
D. & J. Burket 805-823
5.0046 Ac.
Easement
631-151
47.41 Ac.
C. + M. Bennet 687-914
W. & L. Hoover 485-870
2.1 A
782-133
J.J. & R.B. Miller
5A
891-928
A.L. & K.A. Wright
5.16 Ac.
3.815 A
G.M. Malovic
907-412
4.343 Ac.
L. & J. Gartin 877-525
4.343 Ac.
C.E. & B.J. Gartin
3.795 Ac.
783-867
B. Weiss & D. Hagan 1074-526
12.417 A.
Calvin C. & Jeanette Stanton Trustees 772-596
11.949 Ac.
1012-1137
M & R Karl
15.12 Ac.
K. & C. Hoffort 509-603
734-976
B. Hamilton
2.86 Ac.
W. Lucas 775-1066
5.122 Ac.
809-1289
N. & D. Mussacchio
A.L. Crihfield
E. Foskett 492-373
R. & C. Sweet
3.112 Ac.
T. & K. Adams 883-115
1.55 Ac.
10 A
41.40 A
505-9
C.T. + M.S. Varner
987-431
556-84
1000-631, 633
51 A
C. & E. Gibbs, Trustees
G. & A. Stanek
.76 A
400-947
1A
78.24 A
T. Hoopes 492-1008
D. & M. May 611-512
13.8 A
M.A. & L.A. Young 1071-782
26.696 Ac.
D.A. & A.M. Neuman 860-1094
10.0 Ac.
233-438
247-454-616
519-924
653-884
972-850
974-807
1034-649
45 A
Total Ac = 49.10
Par #1
M.S. Youshak, Trustee
~~D.S.~~ Guren Family Ltd. Partnership 96.67 A
841-282
1129-435
M.L. Mance Trust
1053-136
1104-881
E. Foskett 677-1365
17.62 Ac.
J.P. & D. Galm 1041-238
135-484
18.08 A
726-264
Dorothy Galm - by court
J & J. Galm 1027-439
D. Galm 1027-437
J. & B. Lakotosh 829-752
6.35 A
203-489
519-924
653-884
972-850
974-807
1034-649
Par #2
98.75 Ac.
M.S. Youshak, Trustee
417-735
1040-1238
1036-112
740-1018
R.C. & W. Polomsky
45 A
512-947
J. Crotty
10.84 A
C. Schue 960-603
55.58 A
J. & K. Smith
4.42 A
788-821
929-311
2A
R.S. & C.P. Sweet
G.W. & A. Light 677-555
32 Ac.
F.R. Deakins 943-806
R. Walter 943-804
6.74 Ac.
6.70 Ac.
242-239
733-796
72 A

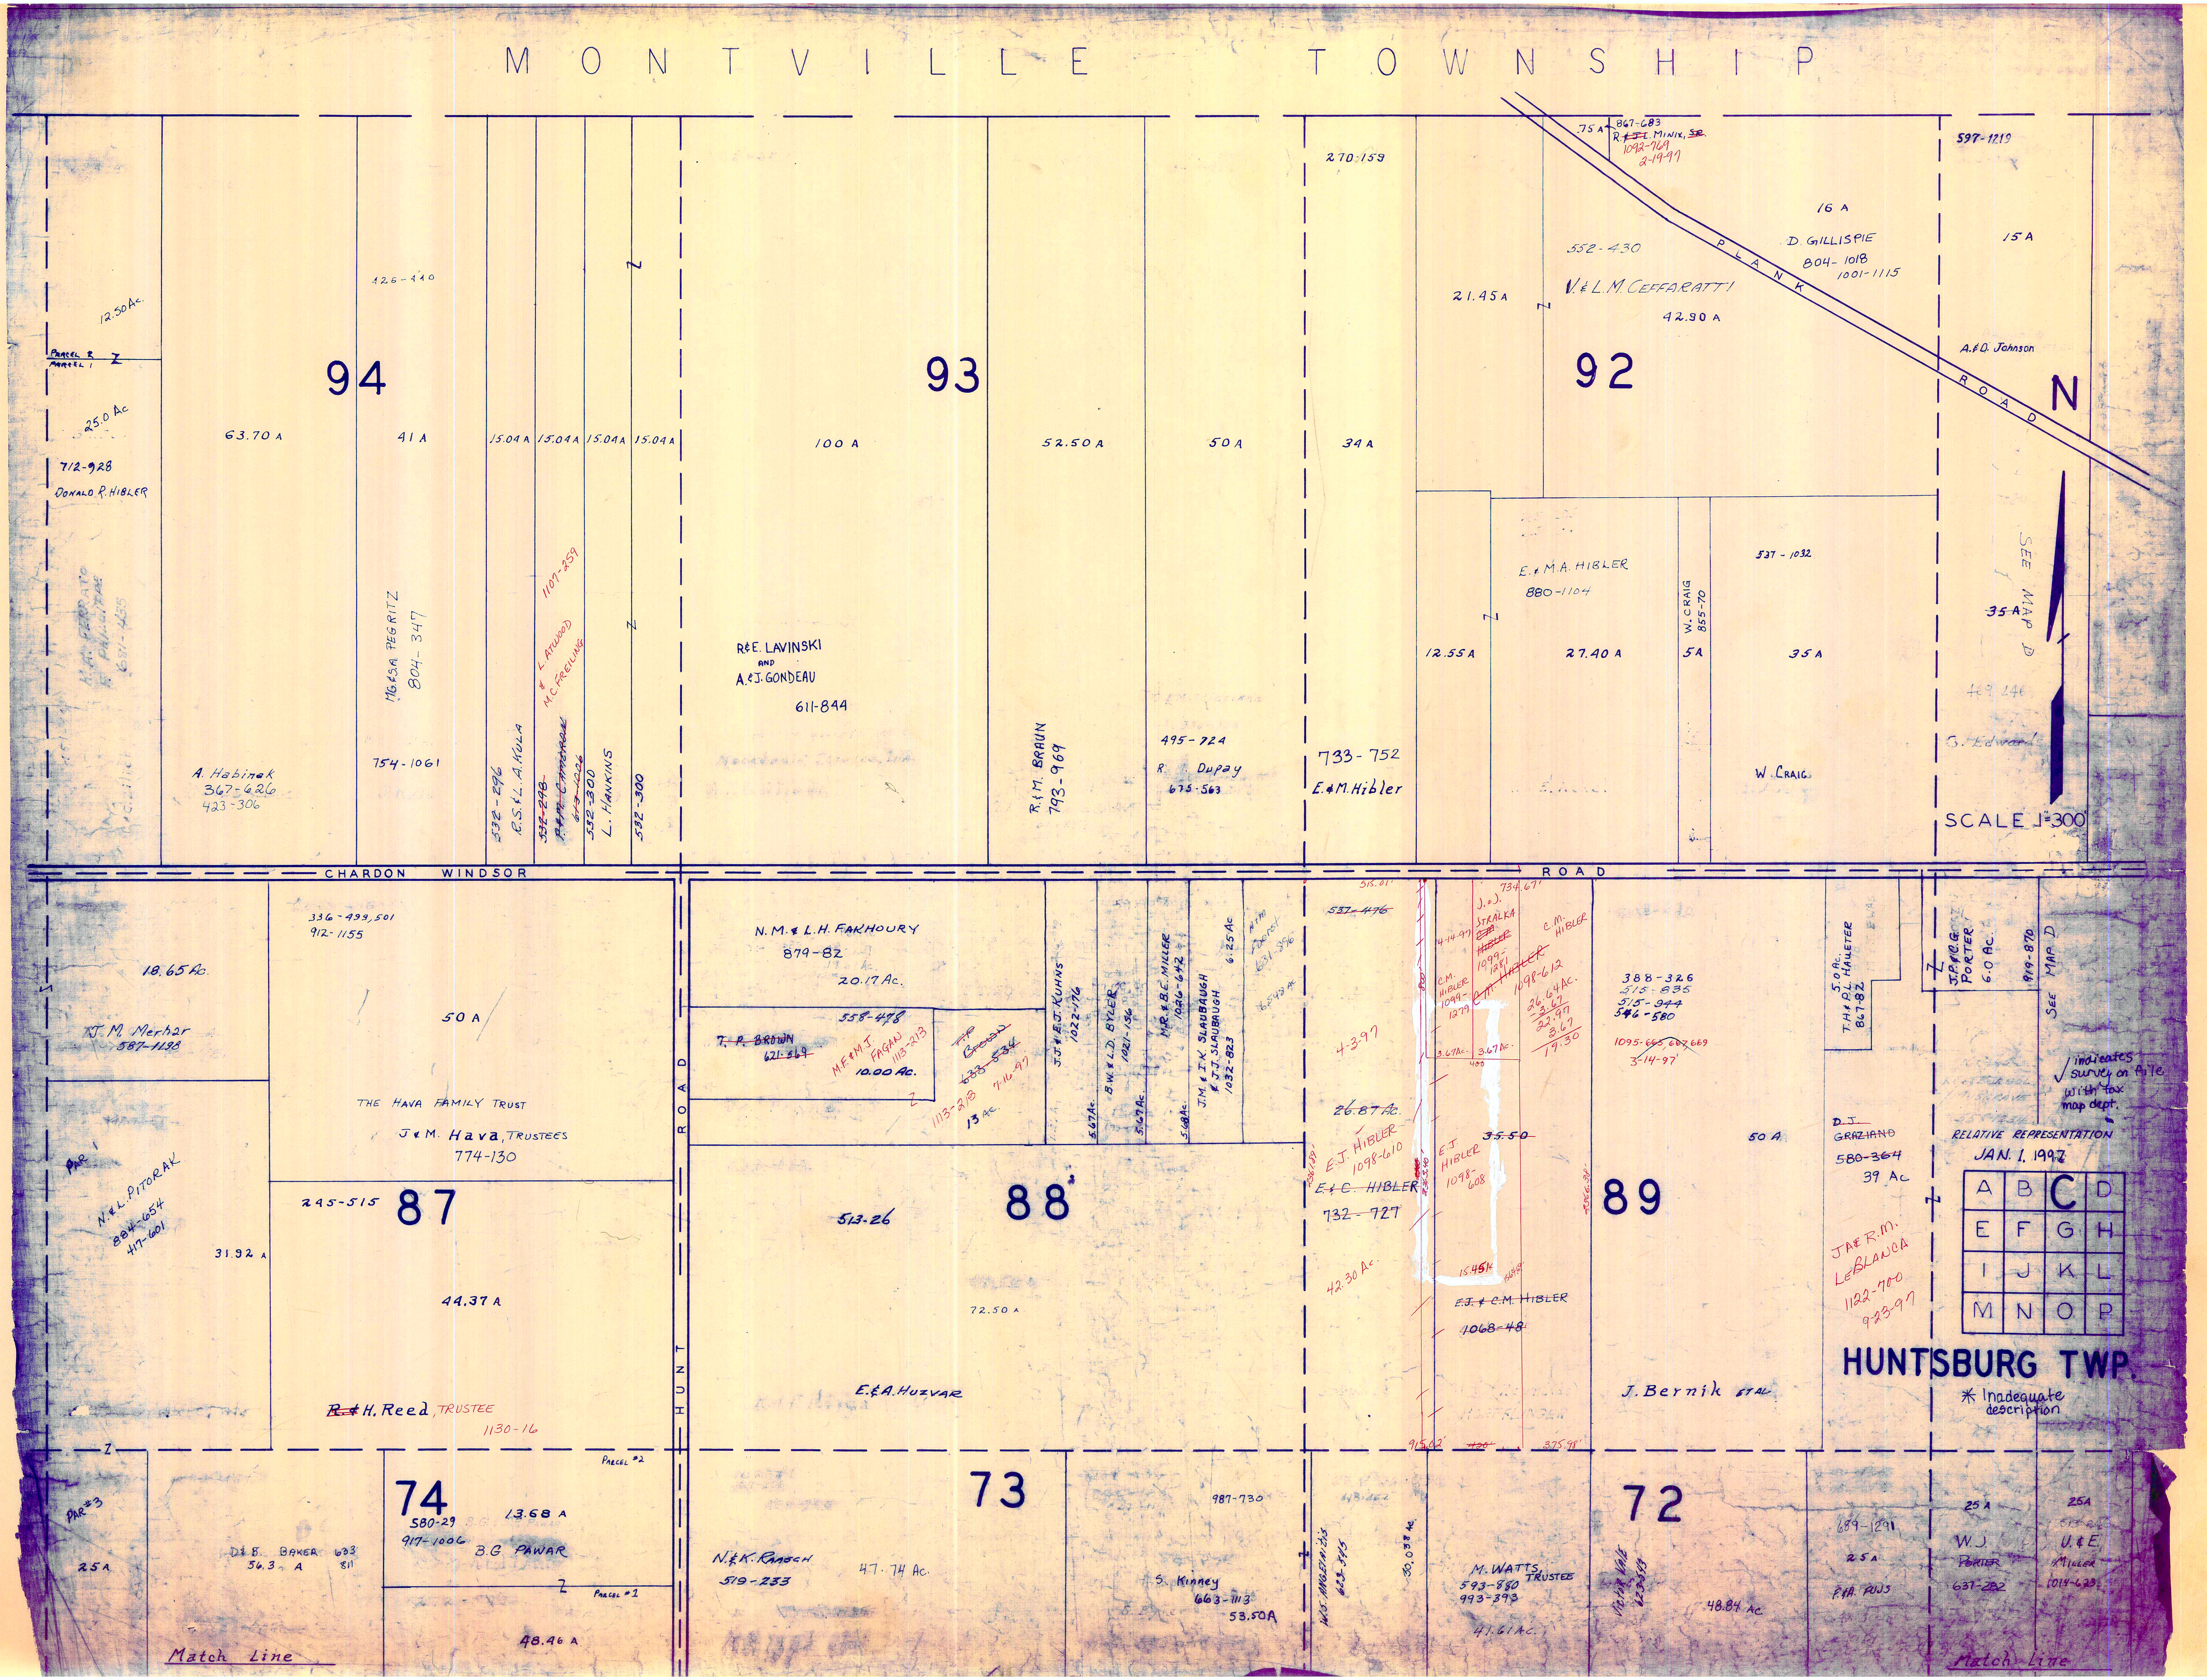

MONTVILLE TOWNSHIP
94
93
92
87
88
89
74
73
72
N
PLANK ROAD
CHARDON WINDSOR ROAD
HUNT ROAD
SCALE 1"=300'
SEE MAP D
12.50 Ac.
25.0 Ac.
712-928
DONALD R. HIBLER
63.70 A
A. Habinak
367-626
423-306
125-440
41 A
M.G.&S.A. PEGRITZ
804-347
754-1061
15.04 A
15.04 A
15.04 A
15.04 A
1107-259
L. ATWOOD & M.C. GREILING
532-296
R.S.& L.A. KULA
532-298
613-1026
532-300
L. HANKINS
532-300
100 A
R.&E. LAVINSKI
AND
A.&J. GONDEAU
611-844
52.50 A
R.&M. BRAUN
793-969
50 A
495-724
R. Dupay
675-563
270-159
34 A
733-752
E.&M. Hibler
.75 A
867-683
R.&J.L. MINIX
1092-769
2-19-97
16 A
D. GILLISPIE
804-1018
1001-1115
552-430
21.45 A
V.&L.M. CEFFARATTI
42.90 A
597-1219
15 A
A.&D. Johnson
E.&M.A. HIBLER
880-1104
12.55 A
27.40 A
W. CRAIG
855-70
5 A
537-1032
35 A
W. Craig
35 A
18.65 Ac.
J.M. Merhar
587-1123
336-499, 501
912-1155
50 A
THE HAVA FAMILY TRUST
J.&M. Hava, TRUSTEES
774-130
PAR 1
N.&L. PITORAK
804-654
417-601
31.92 A
245-515
44.37 A
R.&H. Reed, TRUSTEE
1130-16
N.M.&L.H. FAKHOURY
879-82
20.17 Ac.
558-498
T.P. BROWN
621-369
M.F.&M.J. FAGAN
1113-213
10.00 Ac.
T.P. BROWN
633-534
1113-218
7-16-97
13 Ac.
J.J.&E.J. KUHNS
1022-176
B.W.&L.D. BYLER
1021-136
M.R.&B.E. MILLER
1026-642
J.M.&I.K. SLAUBAUGH
& J.J. SLAUBAUGH
1032-823
6.25 Ac.
5.67 Ac.
5.67 Ac.
5.68 Ac.
513-26
72.50 A
E.&A. Huzvar
537-476
4-397
26.87 Ac.
E.J. HIBLER
1098-610
E.&C. HIBLER
732-727
42.30 Ac.
J.&J. STRALKA
C.M. HIBLER
1099-1279
26.64 Ac.
35.50
E.J. HIBLER
1098-608
E.J.&C.M. HIBLER
1068-48
388-326
515-835
515-944
546-580
1095-665, 667, 669
3-14-97
50 A
J. Bernik ET AL
5.0 Ac.
T.H.&D.L. HALTER
867-82
D.J. GRAZIANO
580-364
39 Ac
J.A.&R.M. LeBLANCA
1122-700
9-23-97
J.P.&R.G. PORTER
6.0 Ac.
919-870
✓ indicates survey on file with tax map dept.
RELATIVE REPRESENTATION
JAN. 1, 1997
A B C D
E F G H
I J K L
M N O P
HUNTSBURG TWP.
* Inadequate description
PAR #3
25 A
D.&B. BAKER
36.3 A
633
811
580-29
917-1006
13.68 A
B.G. PAWAR
PARCEL #2
PARCEL #1
48.46 A
N.&K. Rasch
519-233
47.74 Ac.
987-730
S. Kinney
663-1113
53.50 A
623-345
30.03 Ac.
M. WATTS TRUSTEE
593-880
993-393
41.61 Ac.
623-319
48.84 Ac
689-1291
25 A
F.H.A. RNS
25 A
W.J. PORTER
637-282
25 A
U.&E. Miller
1014-623
Match Line
Match Line

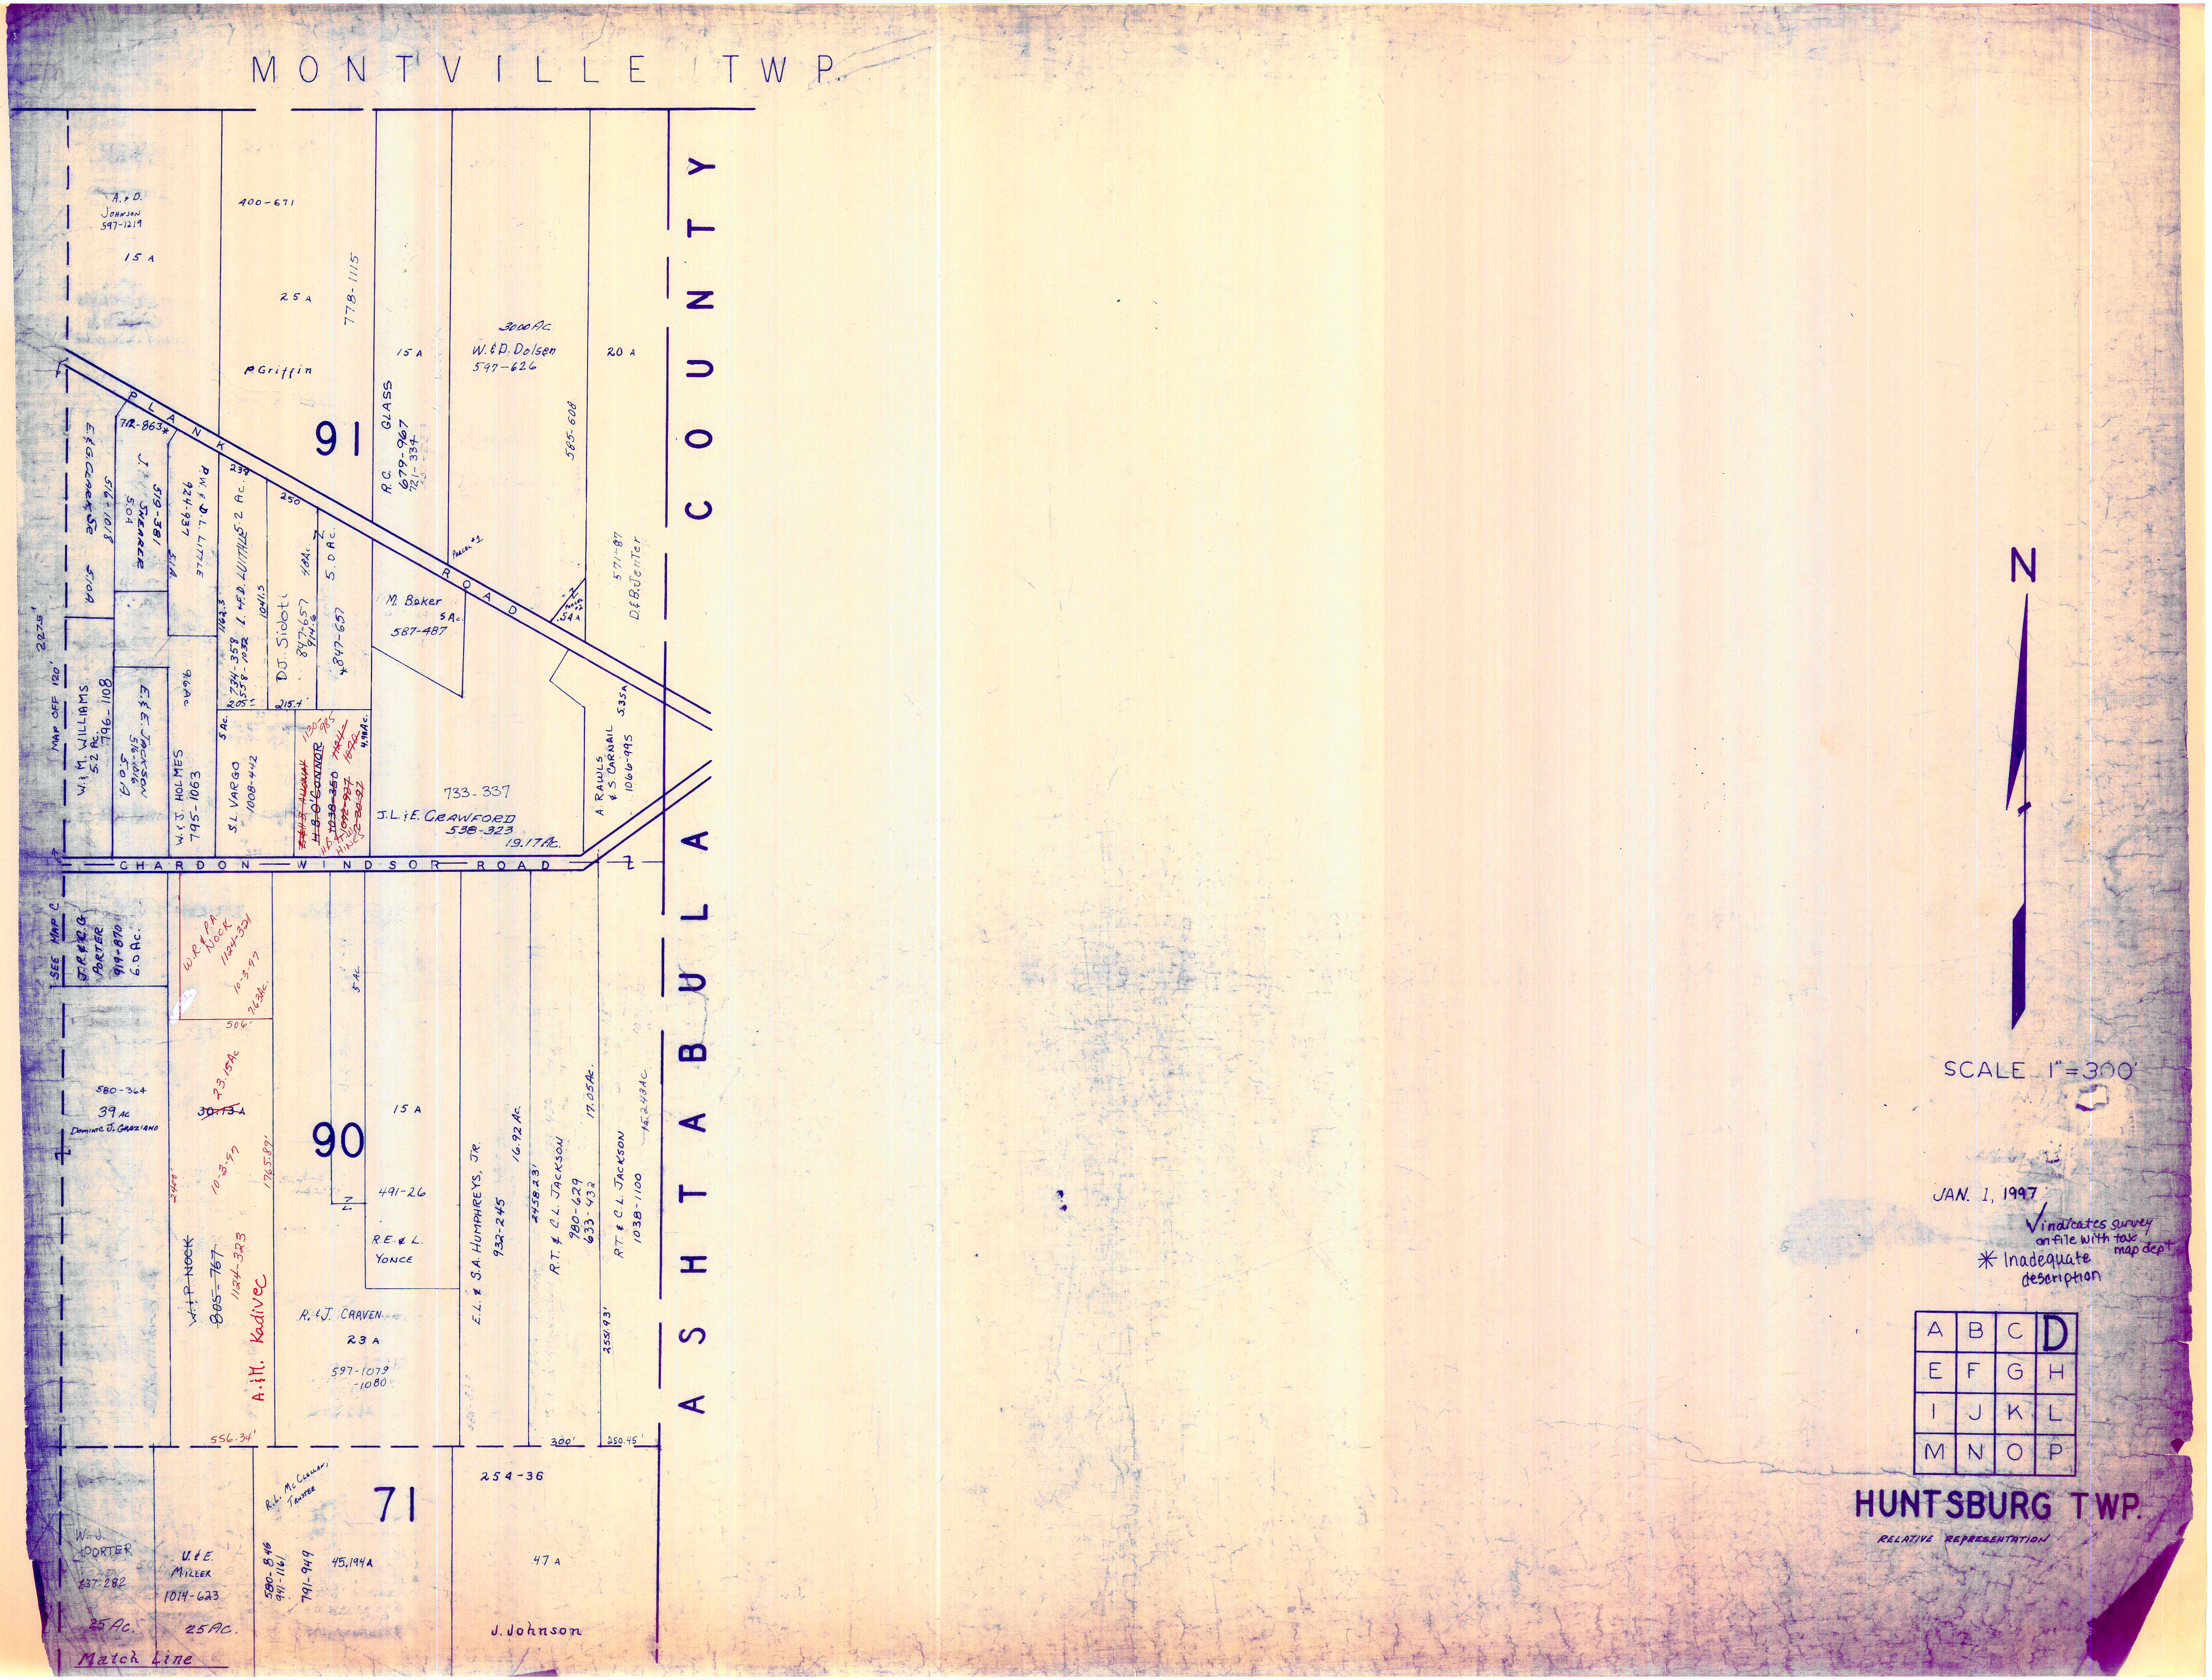

MONTVILLE TWP.
ASHTABULA COUNTY
PLANK ROAD
CHARDON WINDSOR ROAD
91
90
71
A. & D. Johnson 597-1219 15 A
400-671
25 A
778-1115
P. Griffin
15 A
R.C. Glass 679-967 721-334
30.00 Ac. W. & D. Dolsen 597-626
20 A
585-608
712-863*
E. & G. Clarke 516-1018 5.0 A
J. Shearer 519-381 5.0 A
P.W. & D.L. Little 924-937 5.1 A
239
L. & F.D. Luithle 5.2 Ac.
250
1162.3
1041.5
D.J. Sidoti 847-657 914.6 4.8 Ac.
5.0 Ac. *847-657
Parcel #1
Parcel #2 .54 A
571-87 D. & B. Jenter
M. Baker 5 Ac. 587-487
227.5'
Map off 120'
W. & M. Williams 5.2 Ac. 796-1108
E. & E. Jackson 516-1016 5.0 A
9.6 Ac.
W. & J. Holmes 795-1063
5 Ac.
734-358 558-1032
205'
215.4'
S.L. Vargo 1008-442
~~E. & H.B. Alloway~~ ~~H.B. O'Connor~~ ~~1038-350~~ 1130-985 ~~1124-~~ ~~1070-~~ H.B. & ~~1092-927~~ ~~W.~~ ~~10-30-97~~ Hines
4.98 Ac.
733-337
J.L. & E. Crawford 538-323 19.17 Ac.
A. Rawls & S. Carnail 1066-995 5.35 A
See Map C
J.R. & C.G. Porter 919-870 6.0 Ac.
W.R. & P.A. Nock 1124-321 10-3-97 7.63 Ac.
506'
580-364 39 Ac Dominic J. Graziano
~~30.13 A~~ 23.15 Ac
240'
10-3-97
1765.89'
~~W. & P. Nock~~ ~~805-767~~ 1124-323
A. & M. Kadivec
5 Ac.
15 A
491-26
R.E. & L. Yonce
R. & J. Craven 23 A 597-1079 -1080
E.L. & S.A. Humphreys, Jr. 932-245
16.92 Ac.
2458.23'
R.T. & C.L. Jackson 980-629 633-432
17.05 Ac.
R.T. & C.L. Jackson 1038-1100
15.243 Ac
2551.93'
556.34'
300'
250.45'
W.J. Porter 837-282 25 Ac.
U. & E. Miller 1014-623 25 Ac.
R.L. McClellan, Trustee
580-846 941-1161
791-949
45.194 A
254-36
47 A
J. Johnson
Match Line
N
A | B | C | D
E | F | G | H
I | J | K | L
M | N | O | P

SCALE 1" = 300'

JAN. 1, 1997

✓ indicates survey on file with tax map dep't

* Inadequate description

HUNTSBURG TWP.

RELATIVE REPRESENTATION

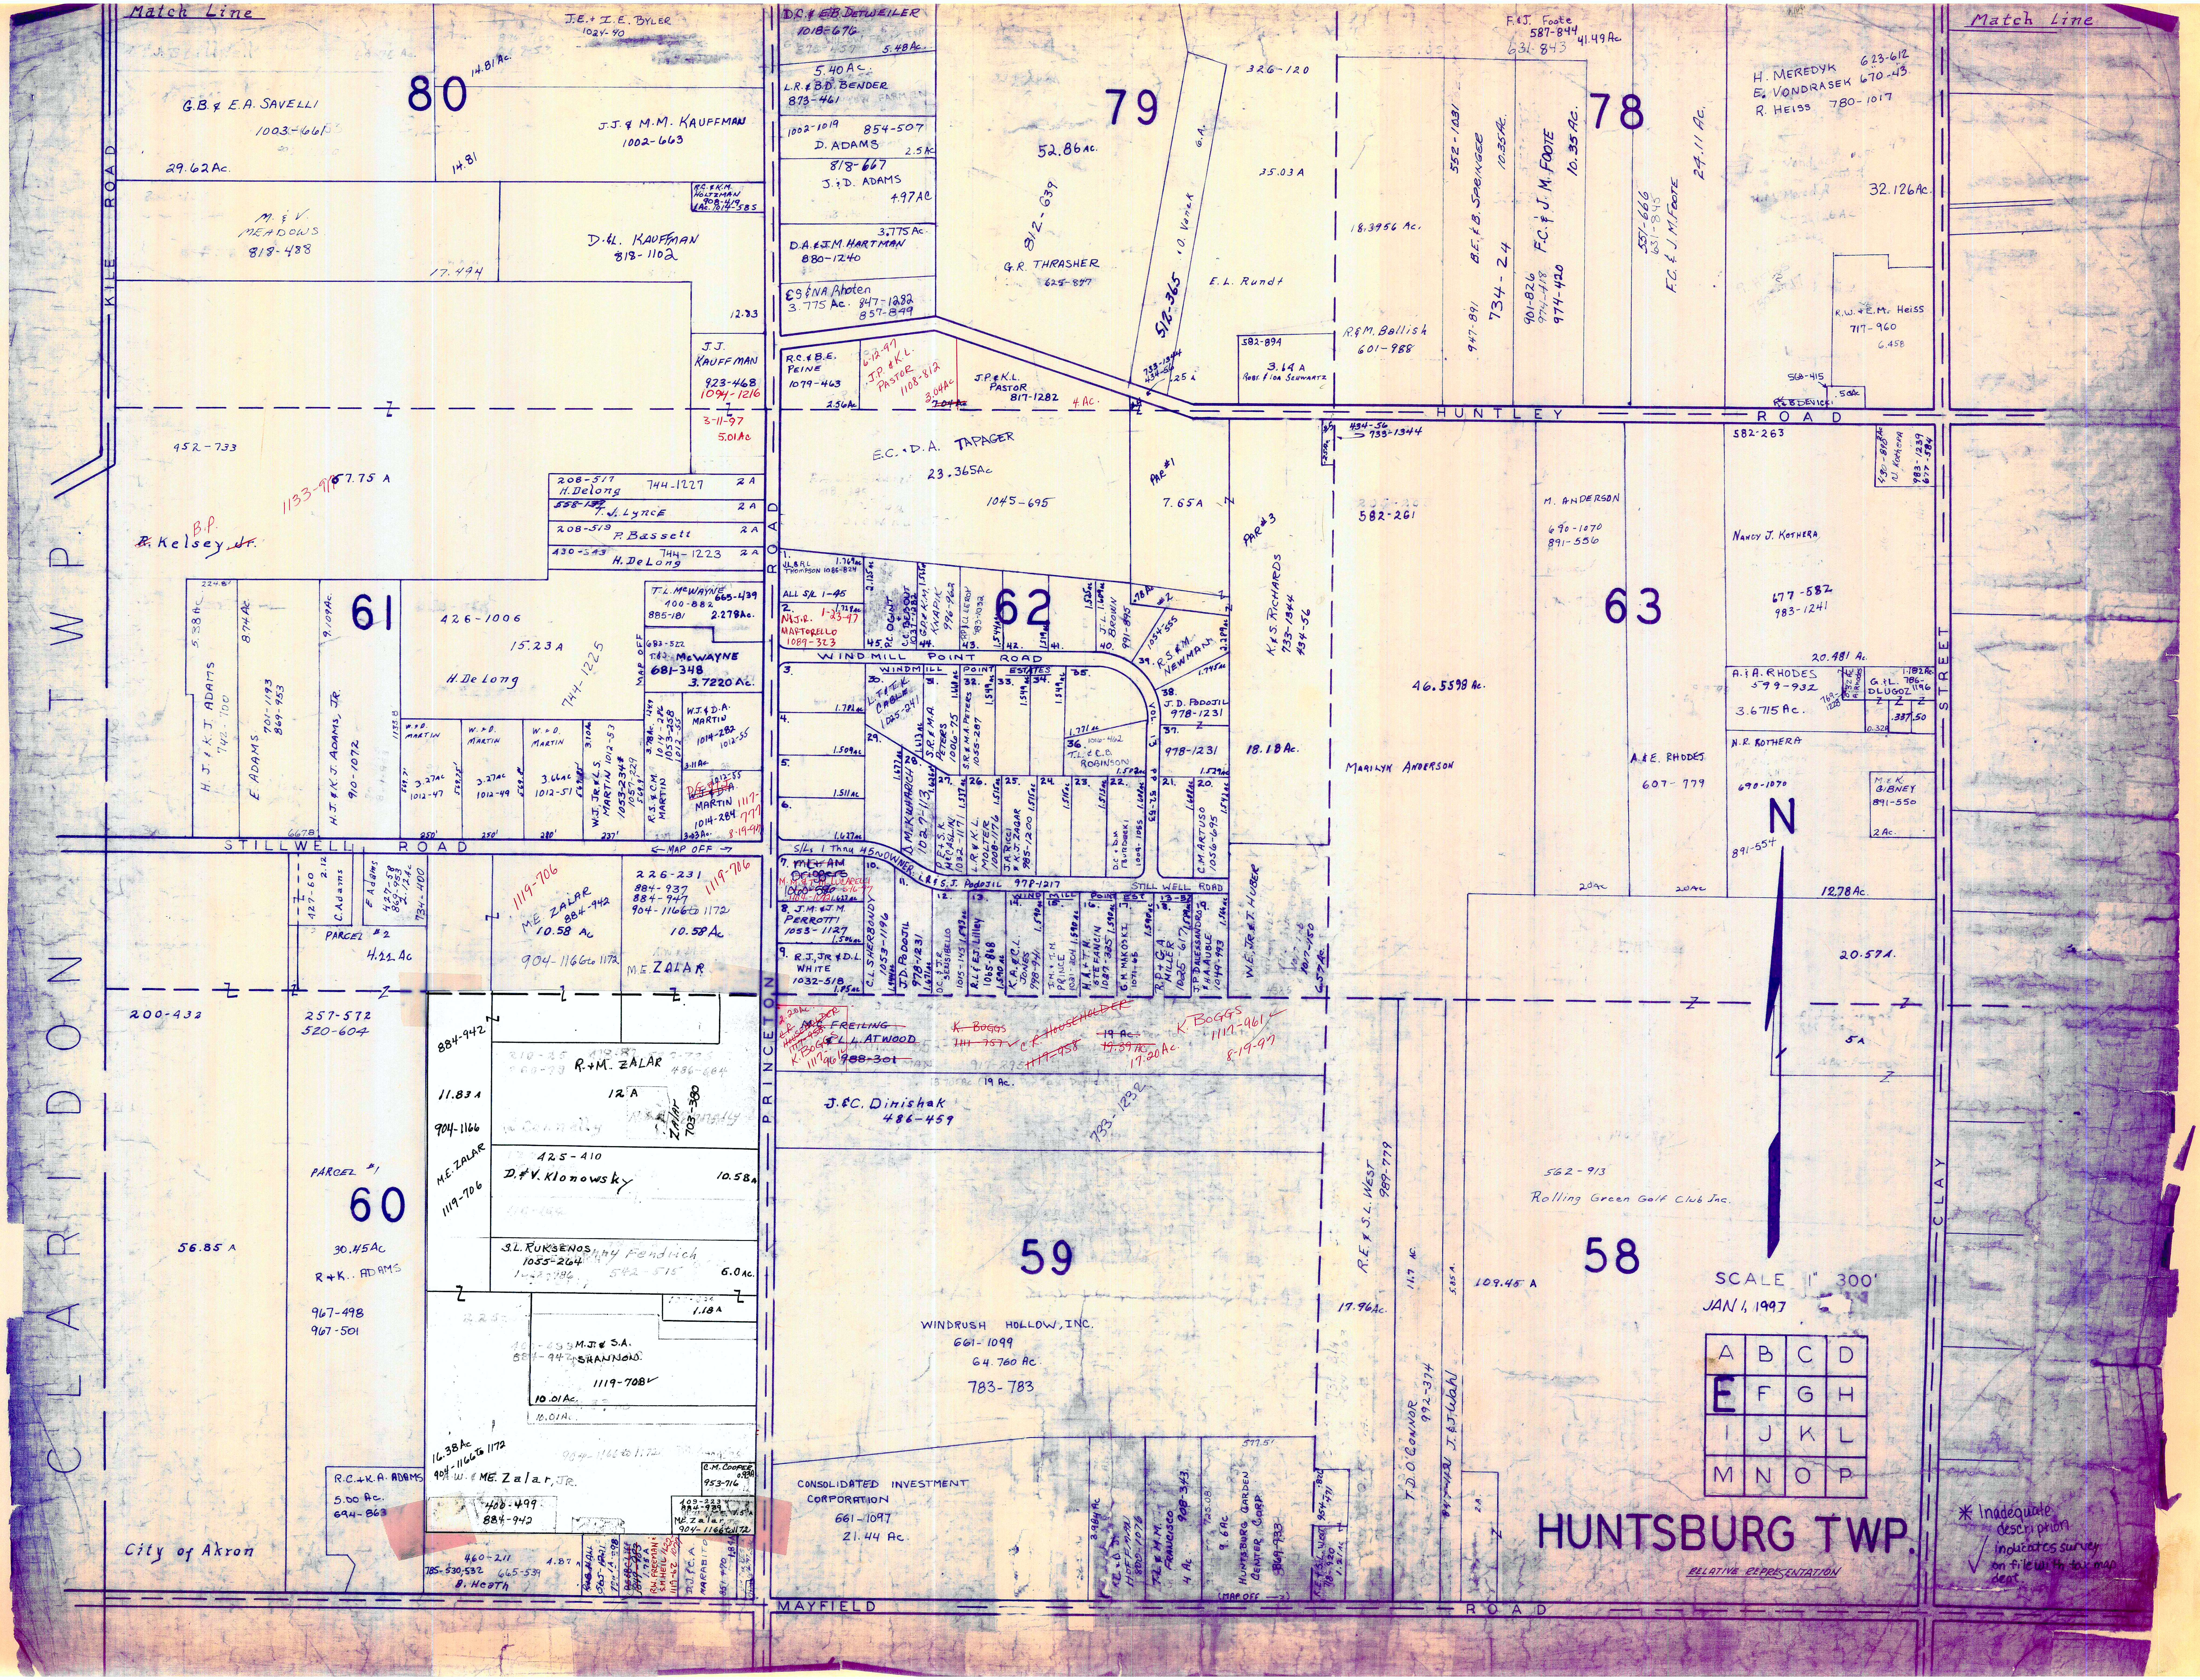
Match Line
Match Line
80
79
78
61
62
63
60
59
58
J.E. + I.E. Byler
1024-40
D.C. & E.B. Detweiler
1018-676
F. & J. Foote
587-844
631-843
41.49 Ac.
G.B. & E.A. Savelli
1003-661
29.62 Ac.
14.81 Ac.
J.J. & M.M. Kauffman
1002-663
5.40 Ac.
L.R. & B.D. Bender
873-461
854-507
D. Adams
818-667
J. & D. Adams
4.97 Ac.
52.86 Ac.
G.R. Thrasher
625-877
812-639
512-365
E.L. Rundt
35.03 A
326-120
18.3956 Ac.
B.E. & B. Springer
734-24
F.C. & J.M. Foote
10.35 Ac.
F.C. & J.M. Foote
24.11 Ac.
H. Meredyk 623-612
E. Vondrasek 670-43
R. Heiss 780-1017
32.126 Ac.
M. & V. Meadows
818-488
D. & L. Kauffman
818-1102
17.444
D.A. & J.M. Hartman
880-1240
3.775 Ac.
E.S. & N.A. Ahoten
3.775 Ac.
847-1282
857-849
R. & M. Ballish
601-988
3.14 A
582-894
K.W. + E.M. Heiss
717-960
6.458
Kile Road
J.J. Kauffman
923-468
1094-1216
3-11-97
5.01 Ac.
R.C. & B.E. Feine
1079-463
J.P. & K.L. Pastor
1108-812
6-12-97
J.P. & K.L. Pastor
817-1282
4 Ac.
Huntley Road
452-733
1133-916
57.75 A
B.P. Kelsey Jr.
208-517 H. DeLong
744-1227
T.J. Lynce
208-519 P. Bassett
430-543 H. DeLong
744-1223
E.C. + D.A. Tapager
23.365 Ac.
1045-695
Par. #1
7.65 A
Par. #3
K. & S. Richards
733-1344
434-56
582-263
582-261
M. Anderson
690-1070
891-556
Nancy J. Kothera
677-582
983-1241
426-1006
15.23 A
H. DeLong
744-1225
H.J. & K.J. Adams
E. Adams
701-1193
869-953
H.J. & K.J. Adams, Jr.
910-1072
T.L. McWayne
400-882
885-181
2.278 Ac.
McWayne
681-348
3.7220 Ac.
W. + D. Martin
Martin
1014-284
Windmill Point Road
Windmill Point Estates
N.J.R. 1-23-97
Martorello
1089-323
J.D. Podojil
978-1231
T.L. & C.B. Robinson
R.S. & M. Newman
18.18 Ac.
46.5598 Ac.
Marilyn Anderson
A. & E. Rhodes
607-779
20.481 Ac.
A. + A. Rhodes
599-932
3.6715 Ac.
G. & L. Dlugoz
N.R. Kothera
690-1070
M. & K. Gibney
891-550
N
Stillwell Road
Stillwell Road
Map off
C. Adams
E. Adams
734-400
Parcel #2
4.11 Ac.
1119-706
M.E. Zalar
884-942
10.58 Ac.
904-1166 to 1172
226-231
884-937
10.58 Ac.
M.E. Zalar
R.J. Jr. & D.L. White
1032-518
J.M. & T.M. Perrotti
1053-1127
C.I. Sherbondy
W.E. Jr. & T. Huber
891-554
12.78 Ac.
20.57 A
200-432
257-572
520-604
884-942
R. + M. Zalar
11.83 A
904-1166
M.E. Zalar
1119-706
12 A
Zalar
703-380
486-664
K. Boggs
C.L. Atwood
788-301
K. Boggs
C.K. Householder
K. Boggs
1117-961
8-19-97
17.20 Ac.
J. & C. Dinishak
486-459
733-1232
Princeton Road
Parcel #1
56.85 A
30.45 Ac.
R. + K. Adams
967-498
967-501
425-410
D. & V. Klonowsky
10.58 Ac.
S.L. Ruksenos
1055-264
6.0 Ac.
1.18 A
M.J. & S.A. Shannon
1119-708
10.01 Ac.
16.38 Ac.
904-1166 to 1172
W. & M.E. Zalar, Jr.
406-499
884-942
R.C. + K.A. Adams
5.00 Ac.
694-863
C.M. Cooper
953-716
M.E. Zalar
904-1166 to 1172
City of Akron
460-211
665-539
B. Heath
Windrush Hollow, Inc.
661-1099
64.760 Ac.
783-783
R.E. & S.L. West
989-779
17.96 Ac.
562-913
Rolling Green Golf Club Inc.
109.45 A
Consolidated Investment Corporation
661-1097
21.44 Ac.
Huntsburg Garden Center Corp.
T.D. O'Connor
992-374
J. Bjurlah
Mayfield Road
Clay Street
Claridon Twp.
Scale 1" 300'
Jan 1, 1997
A B C D
E F G H
I J K L
M N O P
HUNTSBURG TWP.
Relative representation
* Inadequate description
✓ Indicates survey on file with tax map dept.

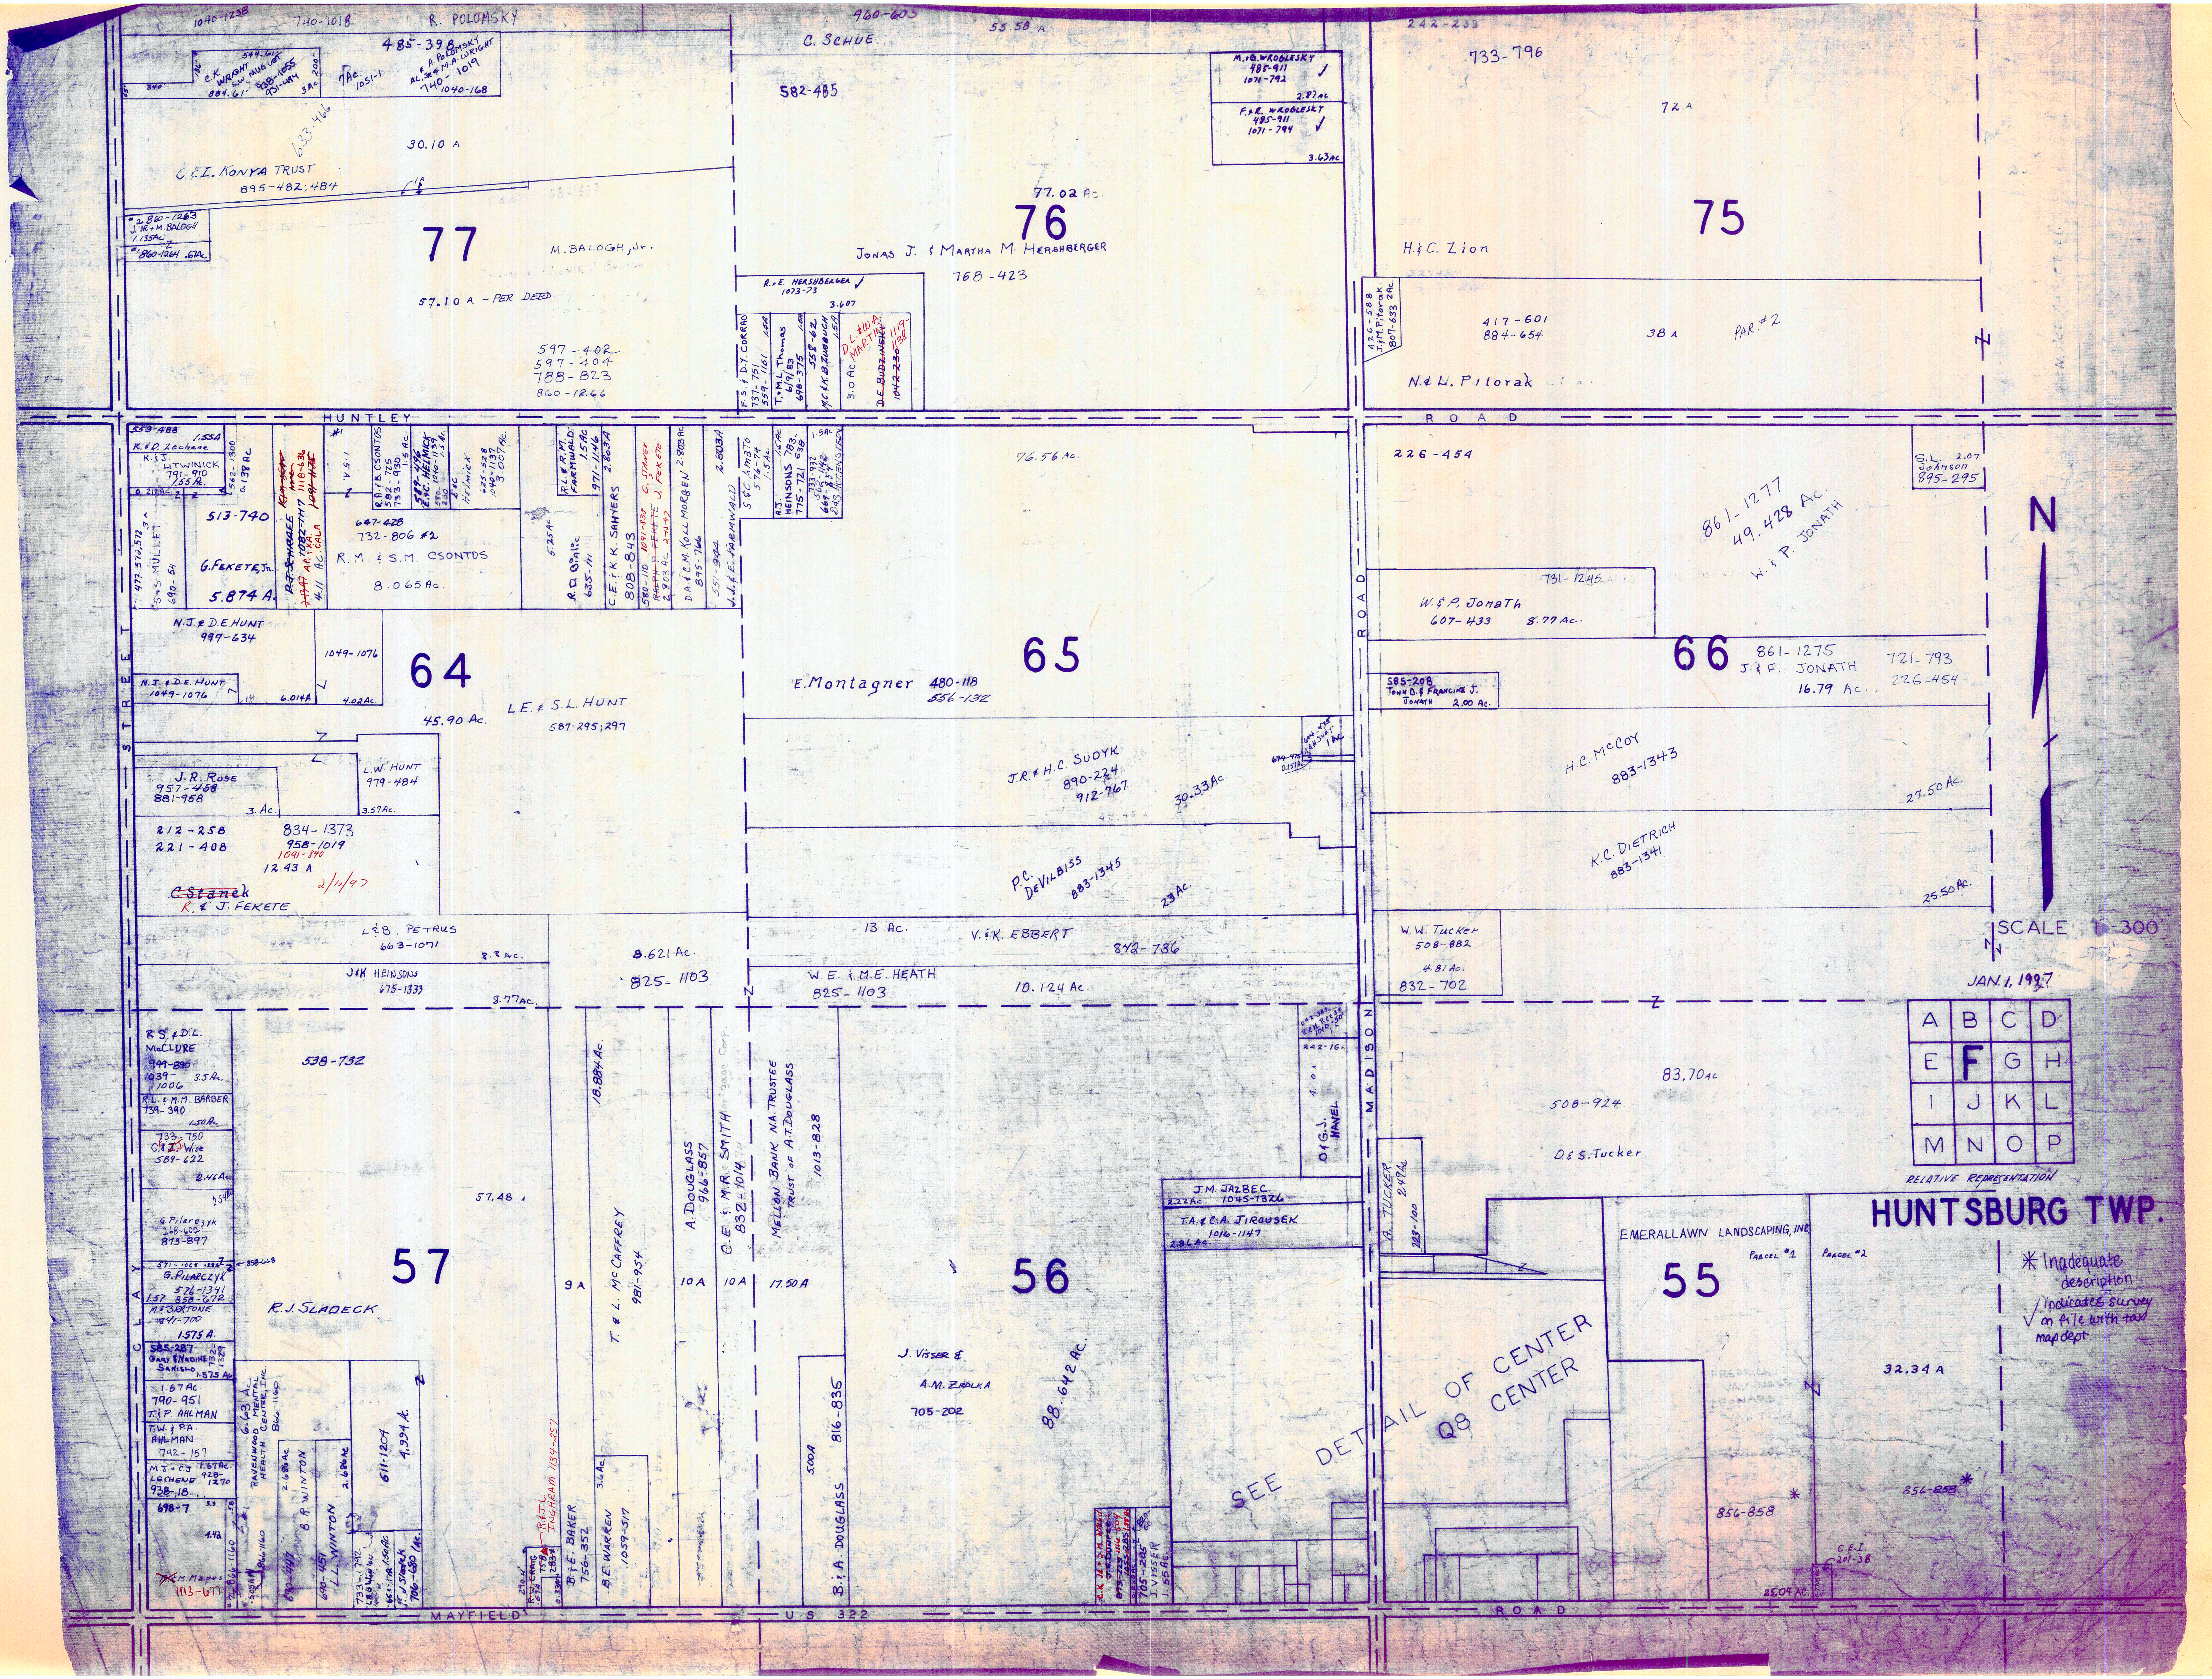
HUNTLEY ROAD
CLAY STREET
MADISON ROAD
MAYFIELD US 322 ROAD
77
76
75
64
65
66
57
56
55
R. POLOMSKY
485-398
740-1018
1040-1238
C.K. WRIGHT
A. POLOMSKY
AL. & M.A. WRIGHT
740-1019
1040-168
C&L KONYA TRUST
895-482; 484
30.10 A
M. BALOGH Jr.
57.10 A - PER DEED
597-402
597-404
788-823
860-1266
C. SCHUE
960-603
582-485
M. & B. WROBLESKY
485-911
1071-792
F. & R. WROBLESKY
485-911
1071-794
3.63 Ac.
77.02 Ac.
Jonas J. & Martha M. Hershberger
768-423
R.&E. HERSHBERGER
1073-73
242-233
733-796
72 A
H.&C. Zion
417-601
884-654
38 A
PAR. #2
N.&L. Pitorak
226-454
76.56 Ac.
G. Fekete, Jr.
513-740
5.874 A.
R.M. & S.M. CSONTOS
732-806 #2
8.065 Ac.
N.J. & D.E. HUNT
997-634
L.E. & S.L. HUNT
587-295; 297
45.90 Ac.
J.R. Rose
957-458
881-958
L.W. HUNT
979-484
212-258
221-408
834-1373
958-1019
12.43 A
~~C. Stanek~~
R. & J. FEKETE
2/11/97
E. Montagner 480-118
556-132
J.R. & H.C. SUDYK
890-224
912-767
30.33 Ac.
P.C. DeVILBISS
883-1345
23 Ac.
L.&B. PETRUS
663-1071
J&K HEINSONS
675-1339
8.621 Ac.
825-1103
13 Ac.
V. & K. EBBERT
842-736
W.E. & M.E. HEATH
825-1103
10.124 Ac.
S.L. Johnson
895-295
861-1277
49.428 Ac.
W. & P. JONATH
731-1246
W.&P. Jonath
607-433
8.77 Ac.
861-1275
J.&F. JONATH
16.79 Ac.
721-793
226-454
585-208
John D. & Francine J. Jonath
2.00 Ac.
H.C. McCOY
883-1343
27.50 Ac.
K.C. DIETRICH
883-1341
25.50 Ac.
W.W. Tucker
508-882
4.81 Ac.
832-702
N
SCALE 1"=300'
JAN. 1, 1997
A B C D
E F G H
I J K L
M N O P
RELATIVE REPRESENTATION
538-732
57.48
R.J. SLADECK
T. & L. McCAFFREY
981-954
A. DOUGLASS
966-857
C.E. & M.R. SMITH
832-1014
MELLON BANK N.A. TRUSTEE TRUST of A.T. DOUGLASS
1013-828
17.50 A
B. & A. DOUGLASS
816-836
J. Visser &
A.M. Zbolka
705-202
88.642 Ac.
J.M. JAZBEC
1045-1326
T.A. & C.A. JIROUSEK
1016-1147
SEE DETAIL OF CENTER
Q8 CENTER
83.70 Ac.
508-924
D.&S. Tucker
EMERALLAWN LANDSCAPING, INC.
Parcel #1
Parcel #2
856-858
32.34 A
856-858
C.E.I.
25.04 Ac.
B.&E. BAKER
756-352
B.E. WARREN
1059-517
L.L. WINTON
B.R. WINTON
R.J. SLADECK
1.67 Ac.
790-951
T.&P. AHLMAN
742-157
938-18
698-7

HUNTSBURG TWP.

* Inadequate description

✓ indicates survey on file with tax map dept.

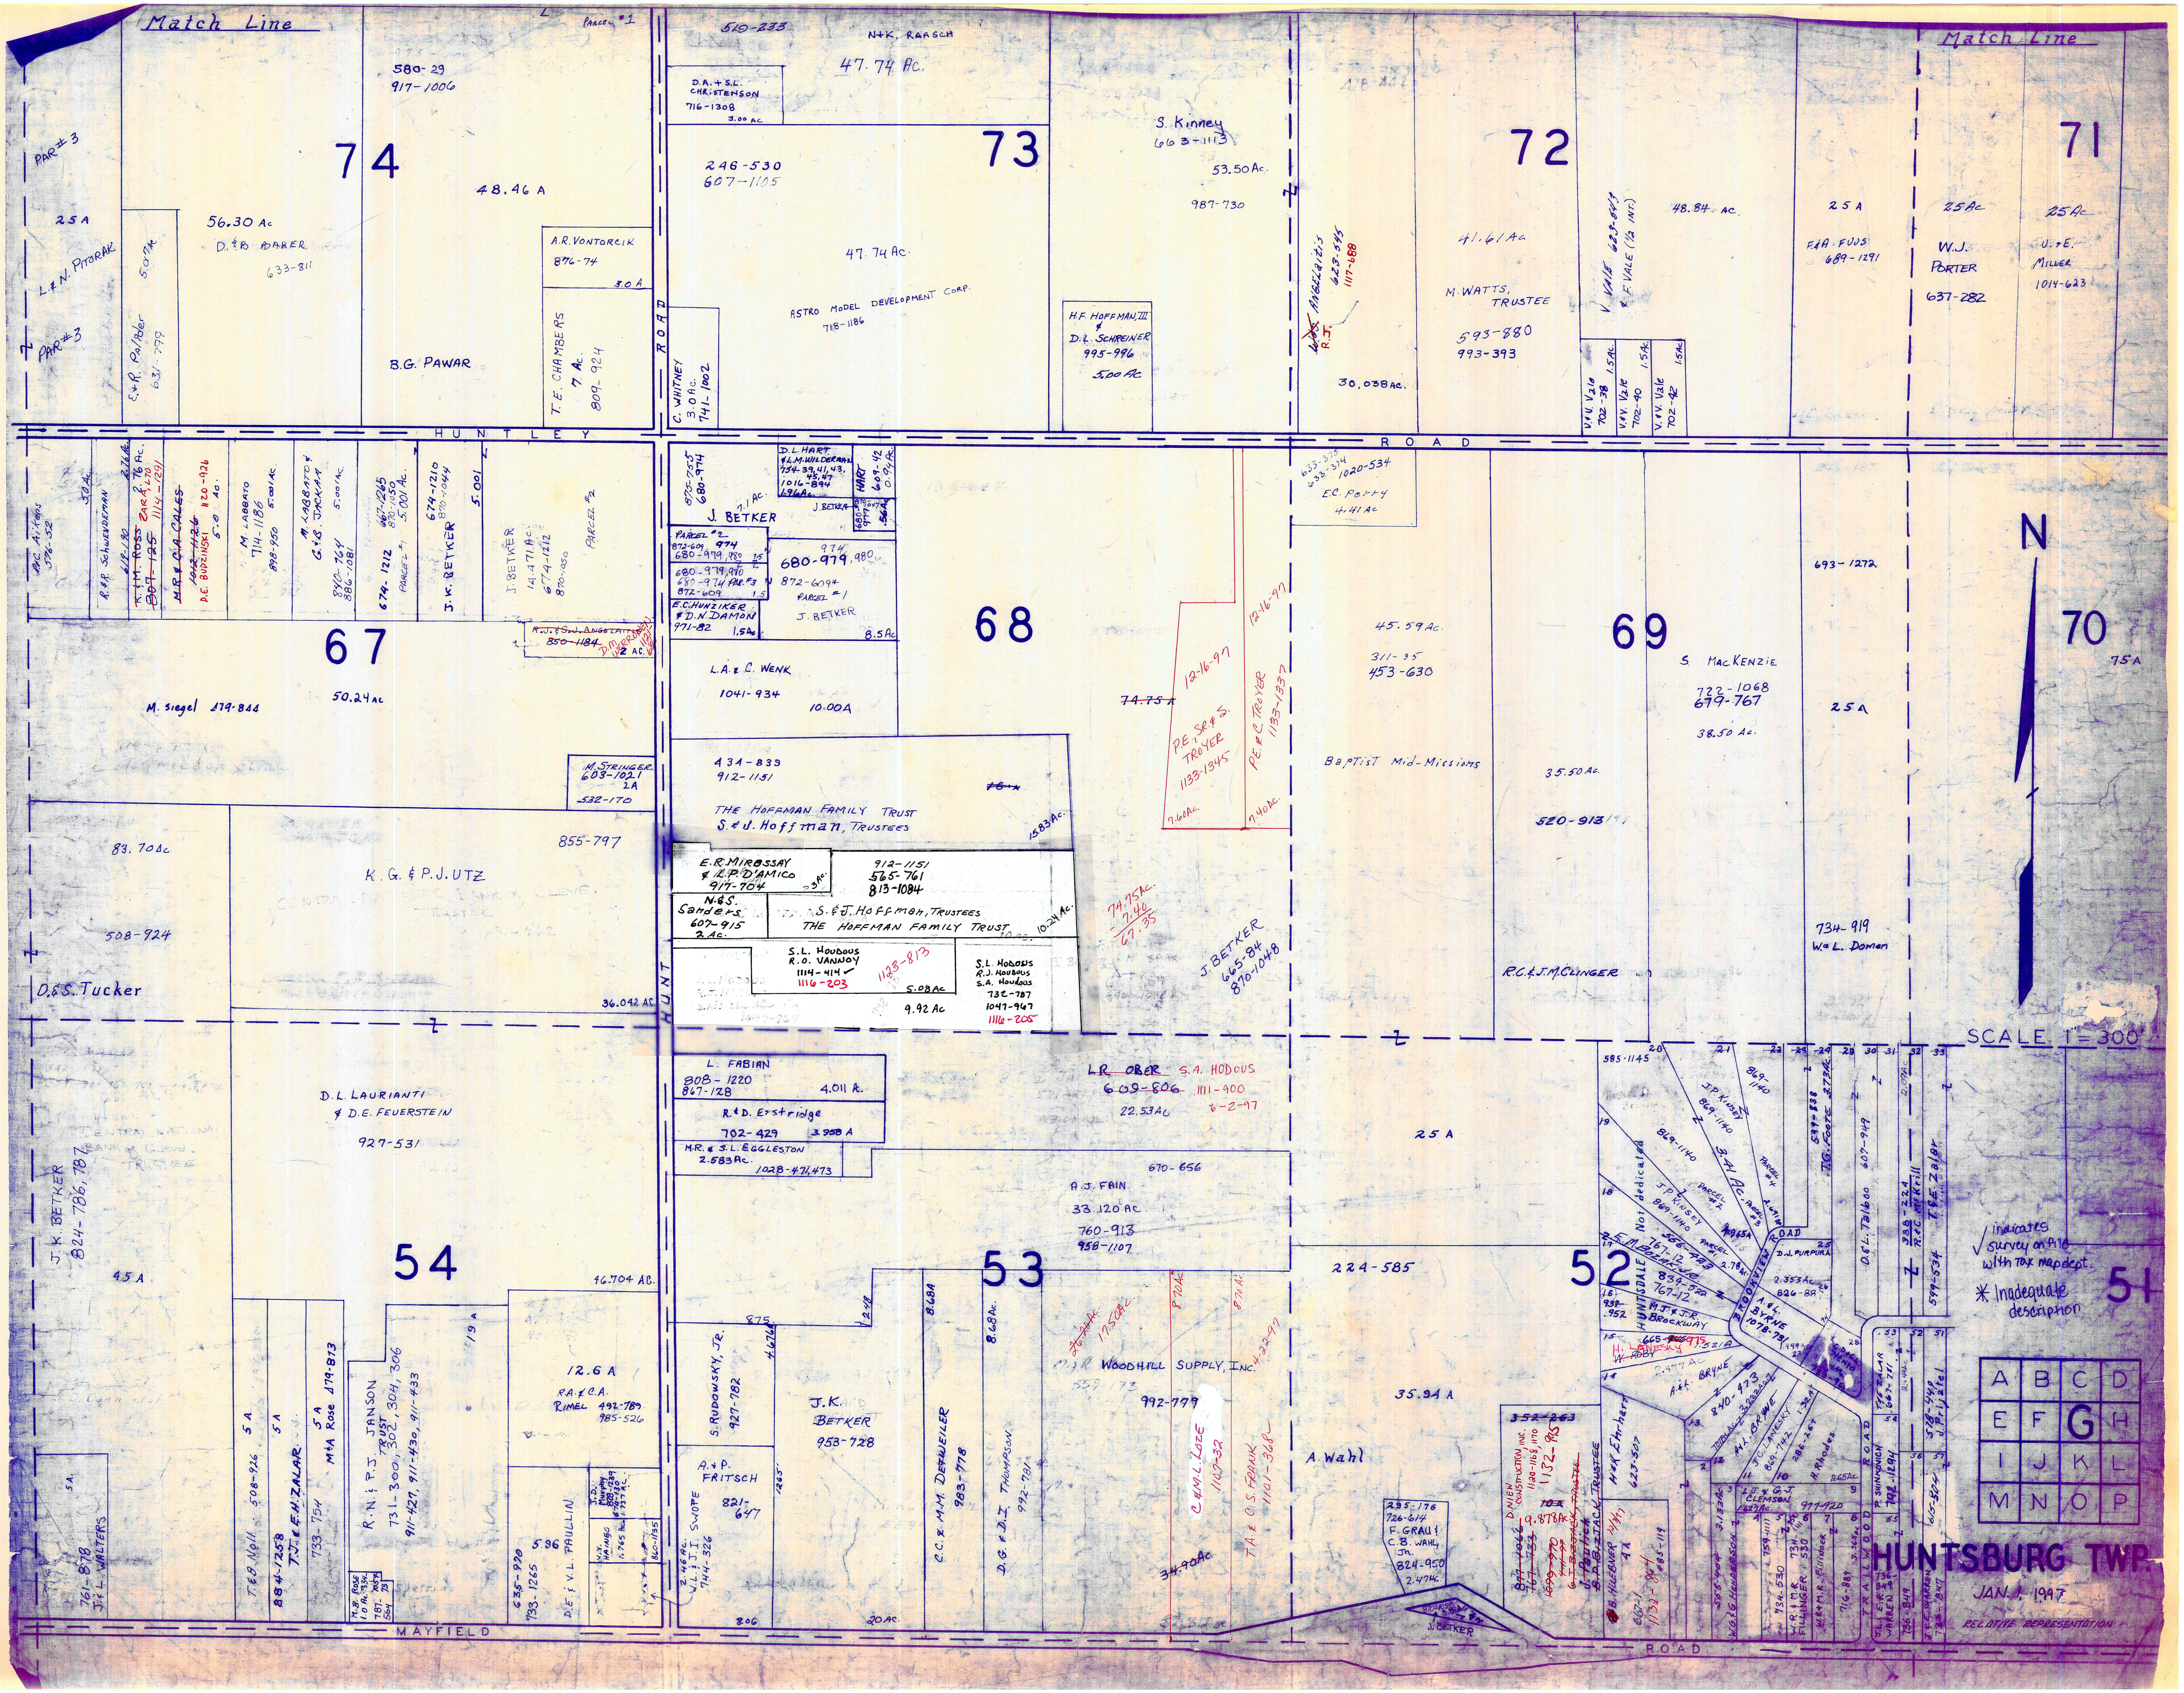

Match Line
Match Line
74
73
72
71
67
68
69
70
54
53
52
51
HUNTLEY ROAD
HUNT ROAD
MAYFIELD ROAD
N
SCALE 1"=300'
N & K. RAASCH 47.74 Ac.
D.A. & S.L. CHRISTENSON 716-1308
ASTRO MODEL DEVELOPMENT CORP. 718-1186 47.74 Ac.
246-530 607-1105
S. Kinney 663-1113 53.50 Ac. 987-730
H.F. HOFFMAN, III & D.L. SCHREINER 995-996 5.00 Ac
30,038 Ac.
41.61 Ac M. WATTS, TRUSTEE 593-880 993-393
V. VALE 623-849 & F. VALE (1/2 INT.)
48.84 Ac.
F & A FUJS 689-1291
W.J. PORTER 637-282 25 Ac
U. & E. MILLER 1014-623 25 Ac.
580-29 917-1006 48.46 A
56.30 Ac D. & B. BAKER 633-811
A.R. VONTORCIK 876-74
T.E. CHAMBERS 7 Ac. 809-924
B.G. PAWAR
C. WHITNEY 3.0 Ac. 741-1002
L & N. PITORAK 25 A
J. BETKER
M. Siegel 279-844 50.24 Ac
M. STRINGER 603-1021 2 A 532-170
83.70 Ac
K.G. & P.J. UTZ 855-797
508-924
D. & S. Tucker
36.042 Ac.
L.A. & E.C. WENK 1041-934 10.00 A
434-839 912-1151
THE HOFFMAN FAMILY TRUST S. & J. Hoffman, TRUSTEES
E.R. MIRBSSAY & L.P. D'AMICO 917-704
N. & S. Sanders 607-915
912-1151 565-761 813-1084
S. & J. Hoffman, TRUSTEES THE HOFFMAN FAMILY TRUST
S.L. HOUDOUS R.O. VANNOY 1114-414 1116-203
S.L. HOUDOUS R.J. HOUDOUS S.A. HOUDOUS 732-787 1047-947 1116-205
9.92 Ac
J. BETKER 665-84 870-1048
P.E., Sr. & S. TROYER 1133-1345 12-16-97
P.E. & C. TROYER 1133-1337 12-16-97
E.C. Perry
45.59 Ac. 311-35 453-630
Baptist Mid-Missions
S. MacKENZIE 722-1068 679-767 38.50 Ac.
35.50 Ac. 520-913
R.C. & J.M. CLINGER
693-1272
734-919 W. & L. Doman
L. FABIAN 808-1220 867-128 4.011 A.
R. & D. Erstridge 702-429
M.R. & S.L. EGGLESTON 2.583 Ac. 1028-471,473
L.R. OBER 609-806 22.53 Ac
S.A. HODOUS 1111-900 8-2-97
A.J. FAIN 670-656 33.120 Ac 760-913 958-1107
D.L. LAURIANTI & D.E. FEUERSTEIN 927-531
J.K. BETKER 824-786,787
45 A
46.704 AC.
12.6 A R.A. & C.A. RIMEL 492-789 985-526
S. RUDOWSKY, Jr. 927-782
A. & P. FRITSCH 821-647
J.K. BETKER 953-728
C.C. & M.M. DERWEILER
D.G. & D.I. THOMPSON
WOODHILL SUPPLY, INC.
T.A. & C.S. FRANK 1101-368
25 A
224-585
35.94 A
A. Wahl
J.P. KLOSKY
E.M. BEAL
BROOKVIEW ROAD
HUNTSDALE
J.W. & J.R. BROCKWAY
A. & L. BYRNE 1078-73
F. GRAU C.B. WAHL 824-950
J. BETKER
J.C. WALTERS
J.F. & J. JANSON
M. & A Rose 279-873
TRAILWOOD ROAD
√ indicates survey on file with tax map dept.
* Inadequate description
A B C D
E F G H
I J K L
M N O P
HUNTSBURG TWP.
JAN 1 1997
RELATIVE REPRESENTATION

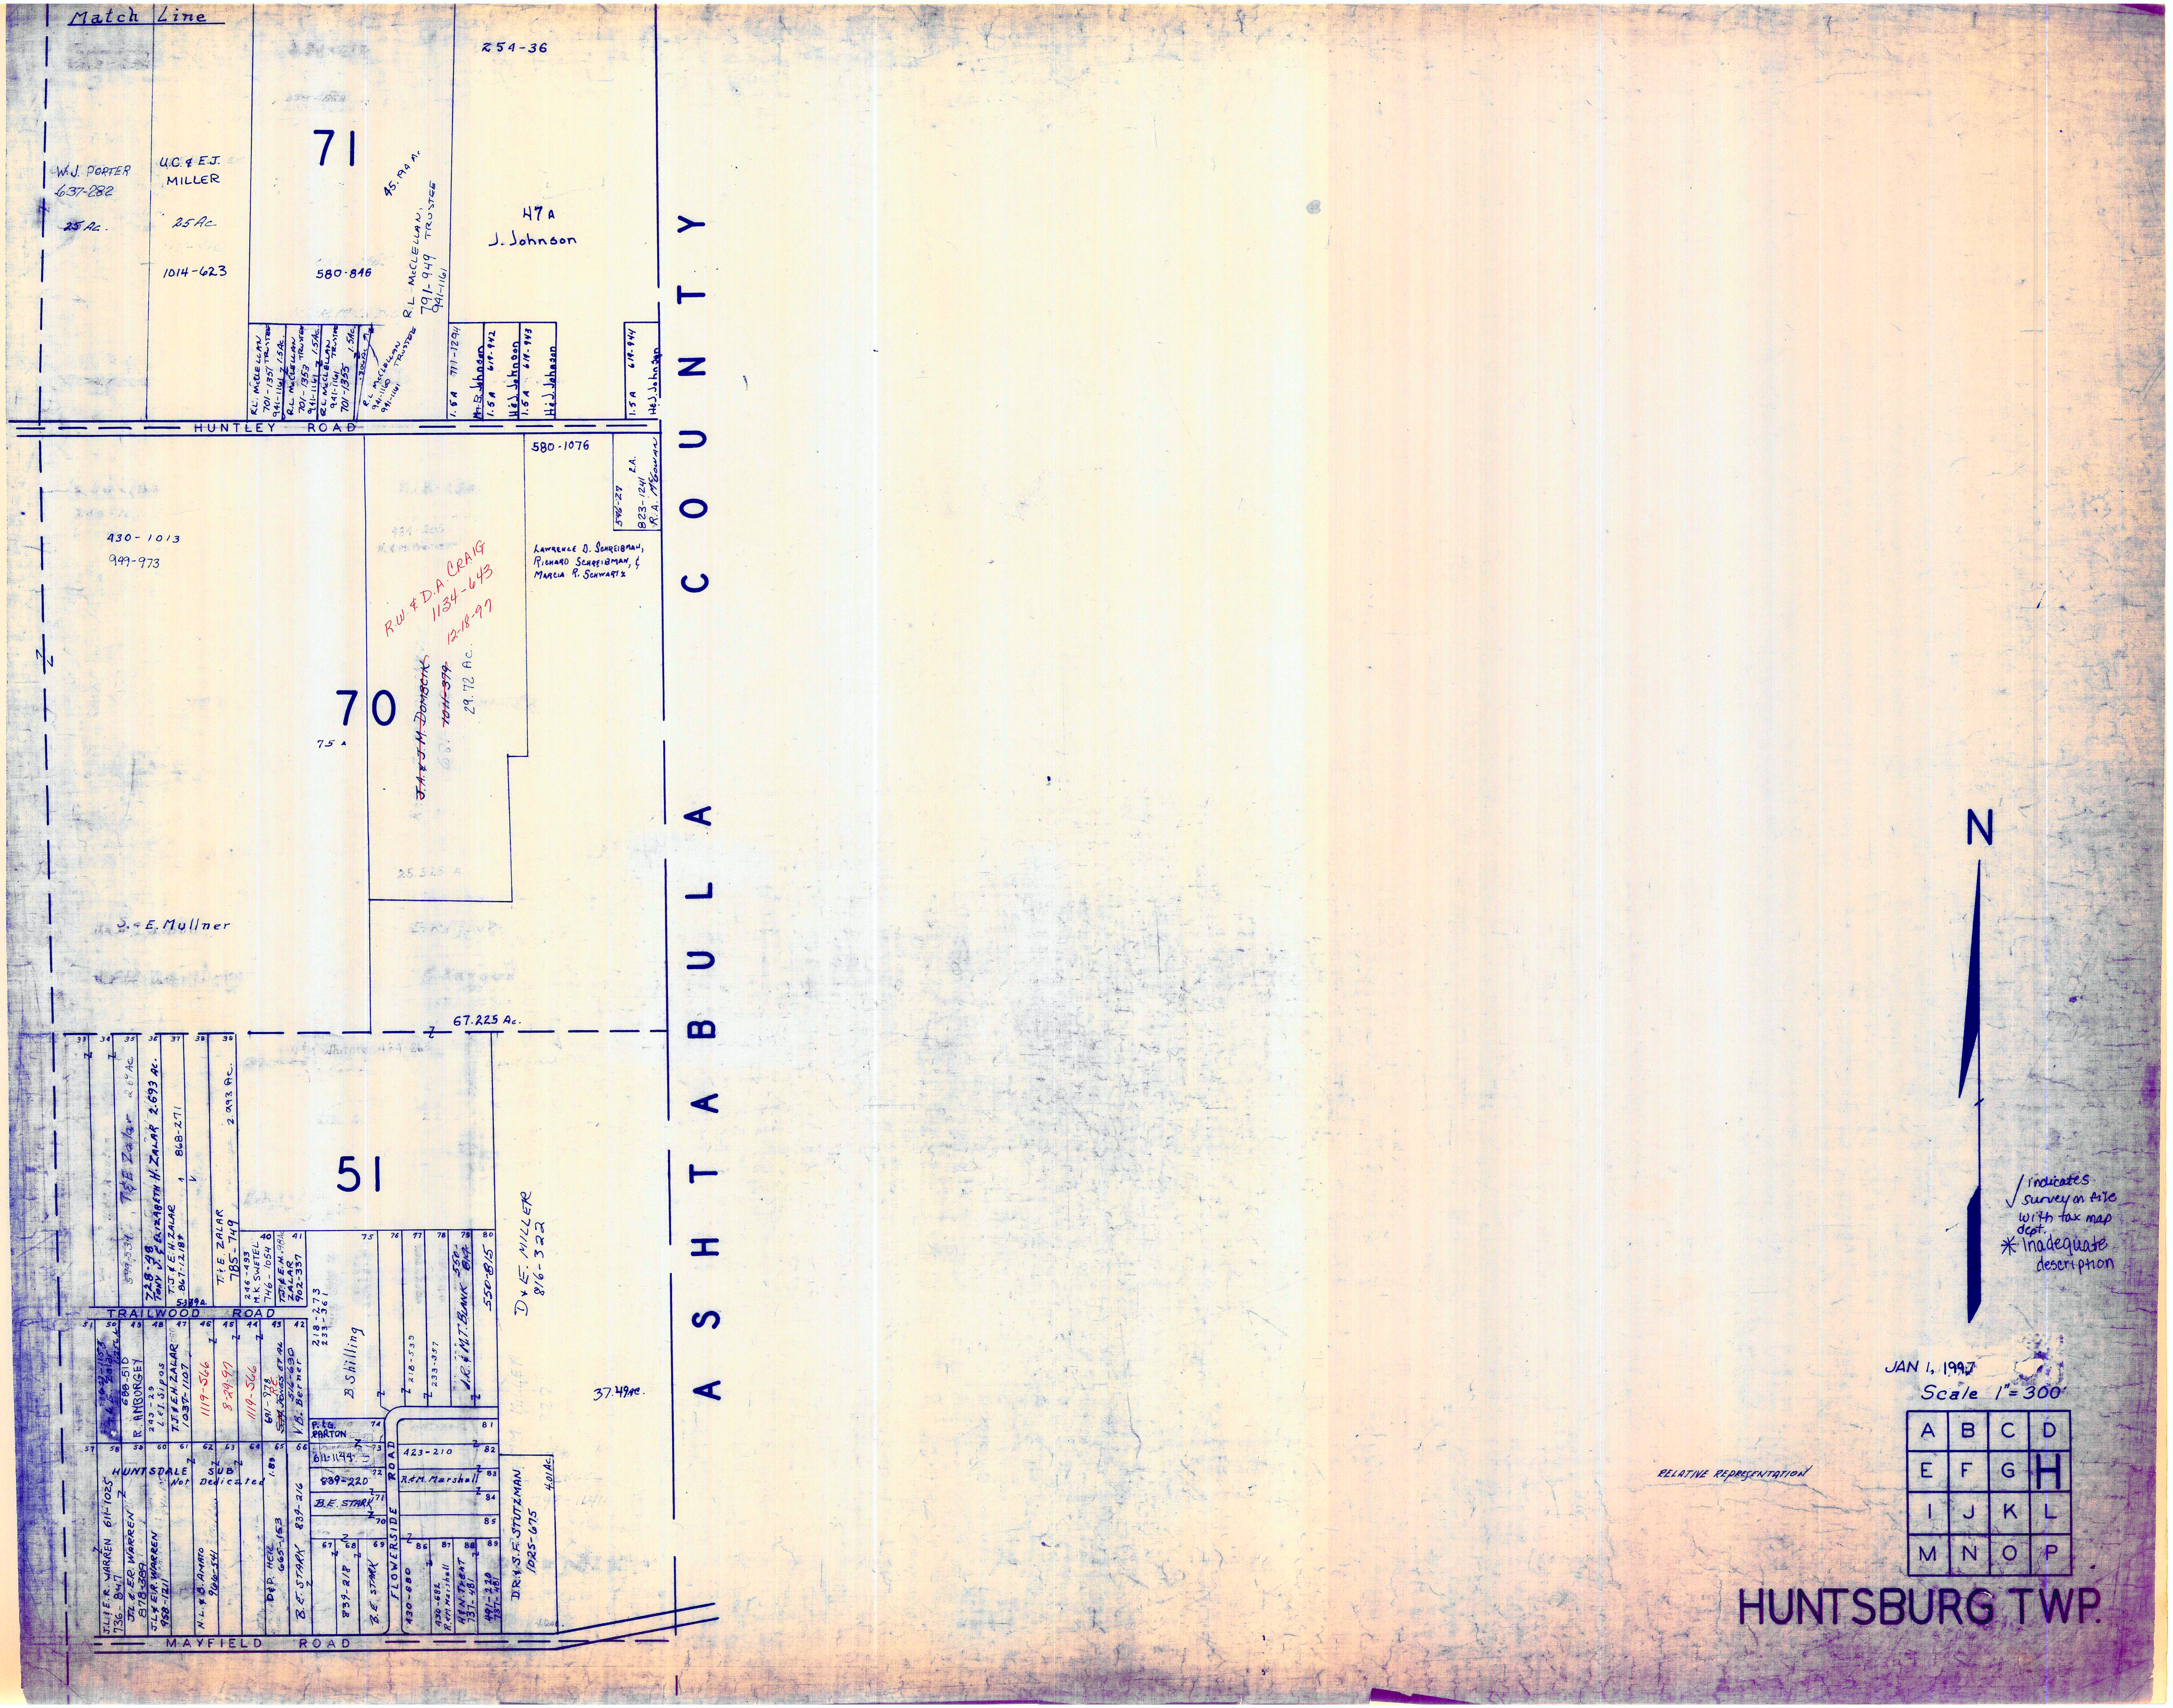
Match Line
71
W.J. PORTER
637-282
25 Ac.
U.C. & E.J.
MILLER
25 Ac
1014-623
580-846
45.194 Ac
R.L McCLELLAN, TRUSTEE
791-949
941-1161
254-36
47 A
J. Johnson
R.L. McCLELLAN 701-1351 TRUSTEE 941-1161 1.5 Ac.
R.L McCLELLAN TRUSTEE 701-1353 941-1161 1.5 Ac.
R.L McCLELLAN TRUSTEE 941-1161 701-1355 1.5 Ac.
.306 Ac
R.L McCLELLAN TRUSTEE 941-1160 941-1161
1.5 A 711-1294 M.B. Johnson
1.5 A 619-942 H&J. Johnson
1.5 A 619-943 H&J. Johnson
1.5 A 619-944 H&J. Johnson
HUNTLEY ROAD
580-1076
546-27 2 A. 823-1241 R.A. McGOWAN
430-1013
949-973
~~J.A. & J.M. DOMBCIK~~ ~~1011-379~~
R.W. & D.A. CRAIG
1134-643
12-18-97
29.72 Ac.
70
75 A
Lawrence D. Schreibman, Richard Schreibman, & Marcia R. Schwartz
S. & E. Mullner
67.225 Ac.
ASHTABULA COUNTY
51
33 34 35 36 37 38 39
T&E Zalar 2.69 Ac.
599-534
728-98 Tony J. & Elizabeth H. Zalar 2.693 Ac.
T.J. & E.H. Zalar 867-1218* 868-271
T. & E. Zalar 785-749 2.993 Ac.
5.339 A.
40 246-493 M.K. Swetel 746-1054
41 T.J. & E.H. Zalar .98 Ac 902-337
218-273 233-361
B Shilling
75 76 77 78 79 80
218-539
233-357
J.R. & M.T. Blank 550-814
550-815
D & E. Miller 816-322
TRAILWOOD ROAD
51 50 49 48 47 46 45 44 43 42
T.&E. Zalar 1022-1153 2.56 Ac.
688-510 R. Amburgey
293-29 L.&I. Sipos
T.J. & E.H. Zalar 1037-1107
1119-566
8-29-97
1119-566
691-978 RE Jones et al
516-690 V.B. Berner
P.&G. Parton
74 73 72 71 70
611-1144
839-220
B.E. Stark
81 82 83 84 85
423-210
R.&M. Marshall
57 58 59 60 61 62 63 64 65 66
HUNTSDALE SUB
Not Dedicated
J.L. & E.R. Warren 611-1025 736-847
J.L. & E.R. Warren 878-389
J.L. & E.R. Warren 958-1211
N.L. & B. Amato 966-541
D.&P. Heil 665-153
1.83
B.E. Stark 839-216
67 68 69
839-218
B.E. Stark
FLOWERSIDE ROAD
86 87 88 89
430-680
430-682 R.&M. Marshall
H.&N. Thrat 737-481
491-220 737-481
D.R. & S.F. Stutzman 1025-675
4.01 Ac.
37.49 Ac.
MAYFIELD ROAD
N
RELATIVE REPRESENTATION

√ indicates survey on file with tax map dept.
* Inadequate description

JAN 1, 1997

Scale 1" = 300'

A	B	C	D
E	F	G	**H**
I	J	K	L
M	N	O	P

HUNTSBURG TWP.

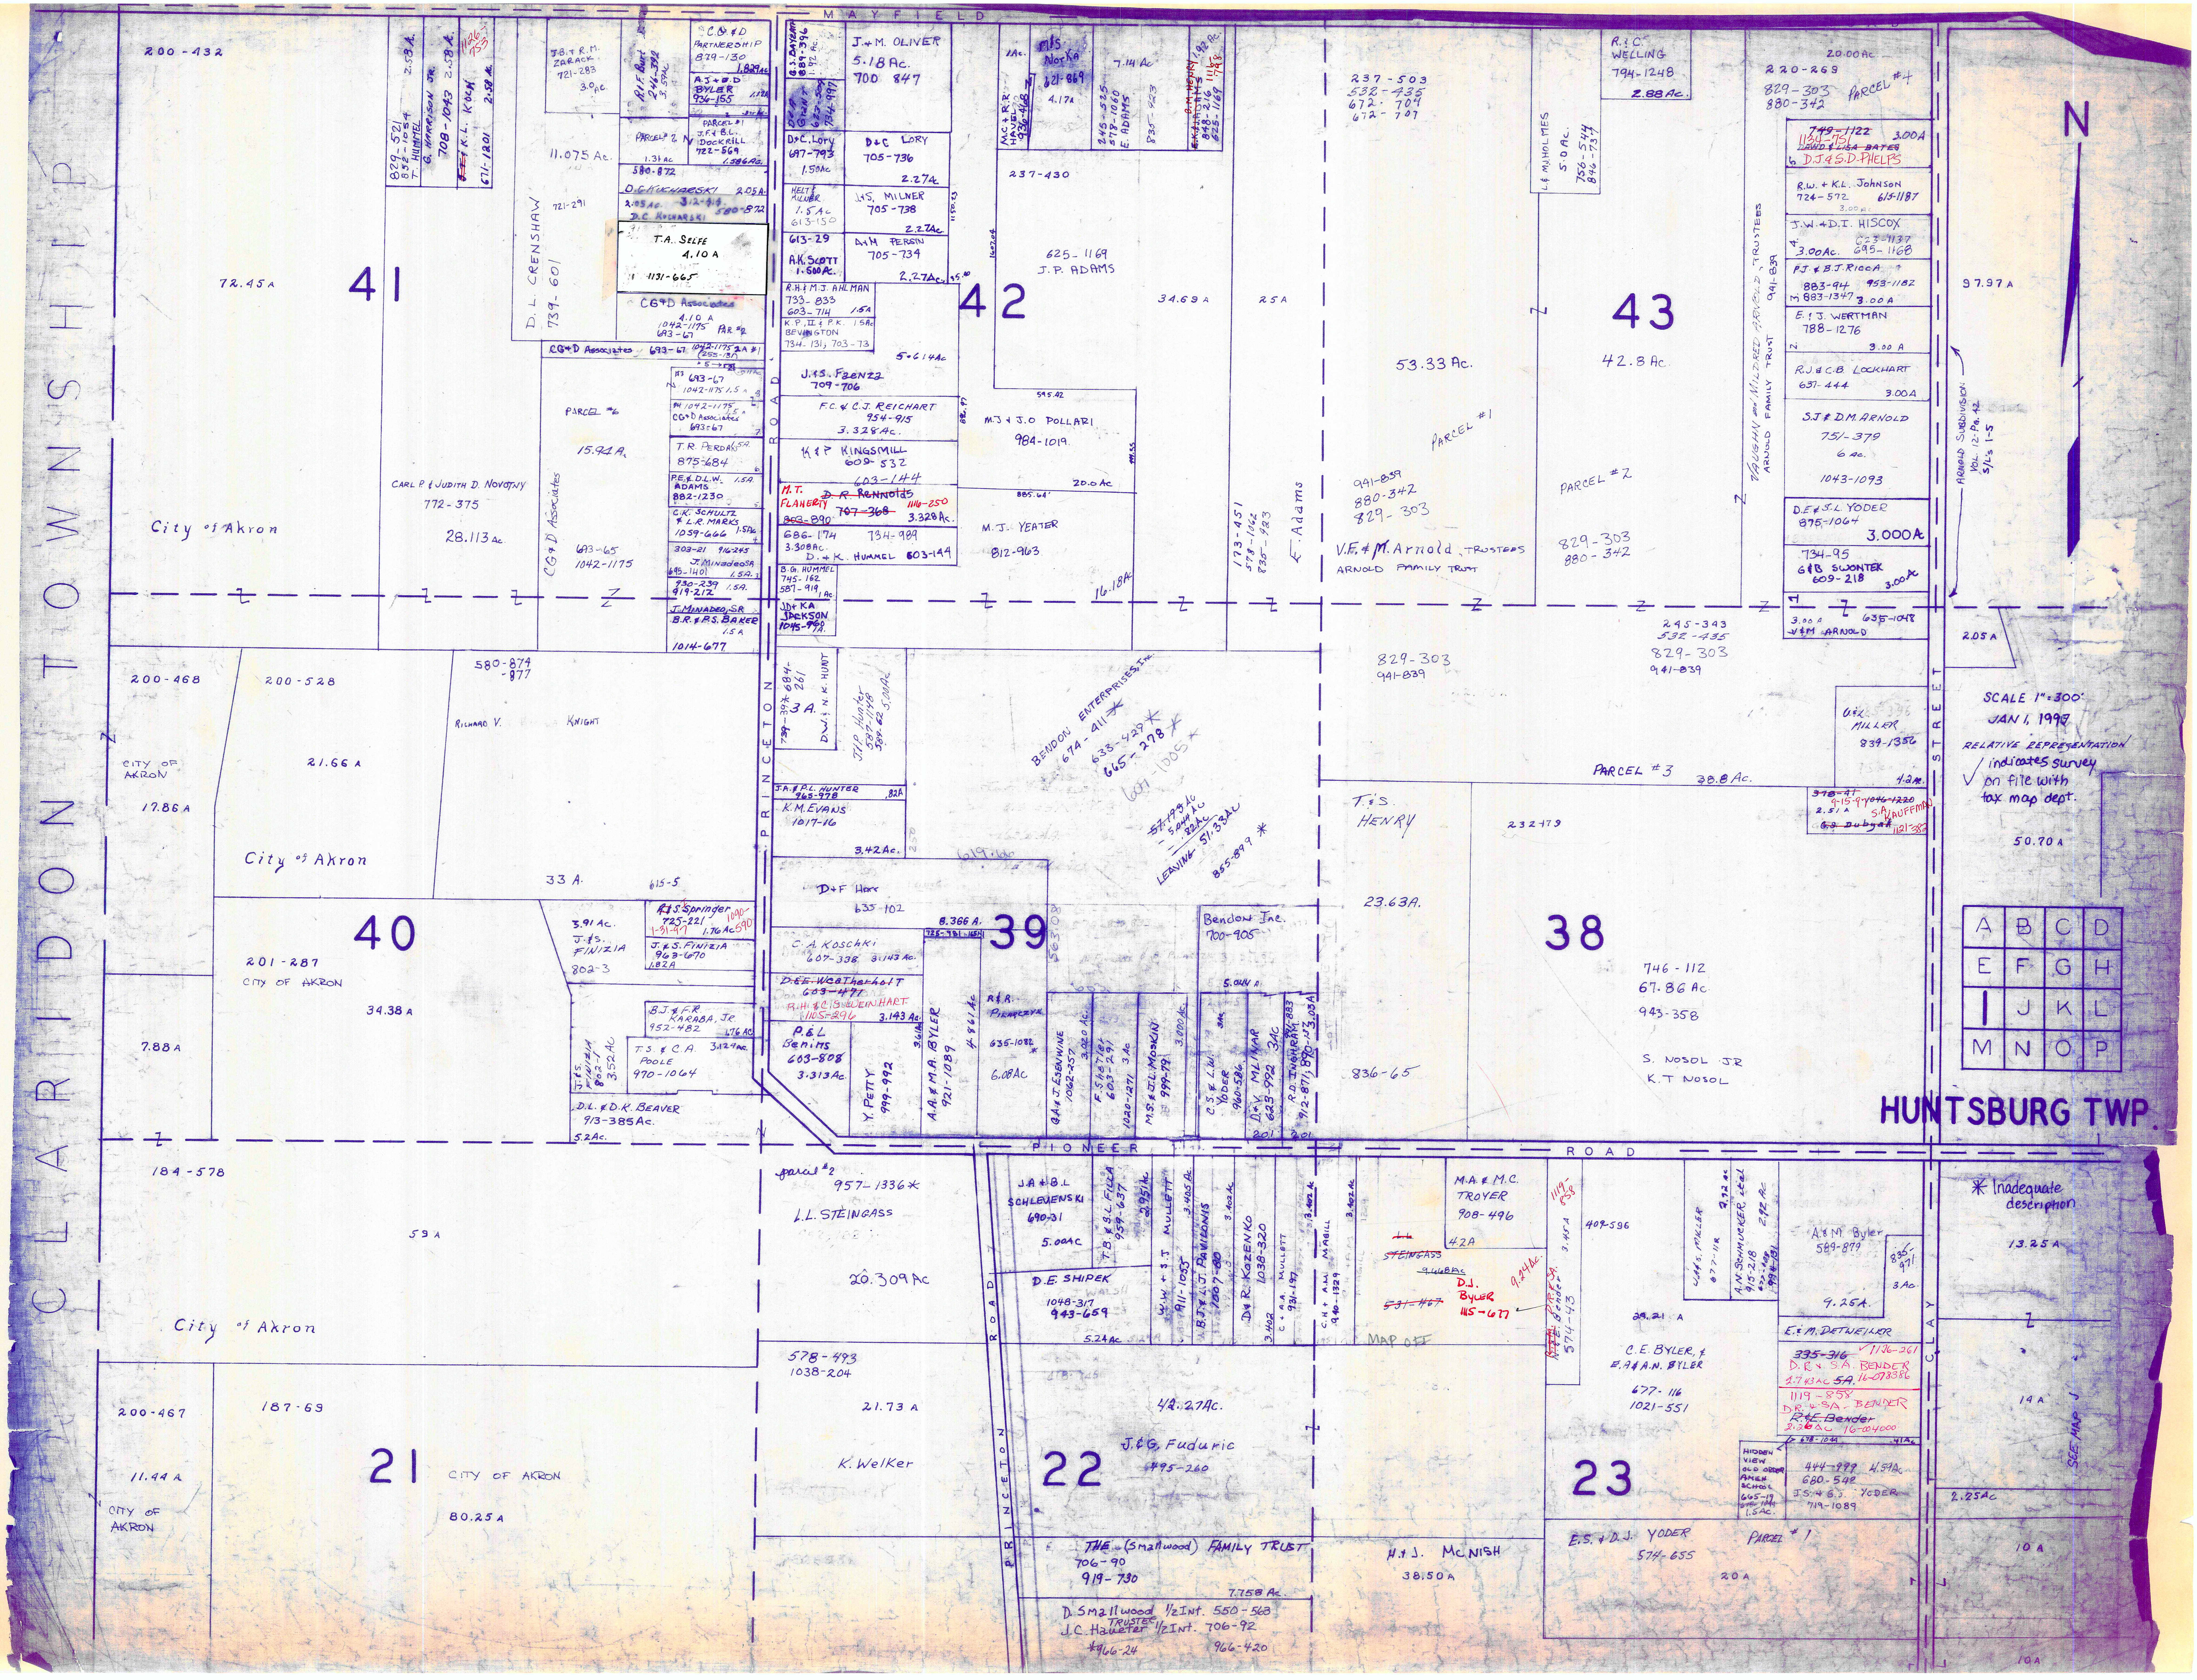MAYFIELD
CLARIDON TOWNSHIP
HUNTSBURG TWP.
PIONEER ROAD
PRINCETON ROAD
CLAY STREET
N
41
42
43
40
39
38
21
22
23
SCALE 1" = 300'
JAN 1, 1997
RELATIVE REPRESENTATION
✓ indicates survey on file with tax map dept.
* Inadequate description
A B C D
E F G H
I J K L
M N O P
200-432
72.45 A
City of Akron
829-521
G. HARRISON JR.
708-1043
K.L. KOCK
671-1201
11.075 Ac.
D.L. CRENSHAW
739-601
J.B. & R.M. ZARACK
721-283
3.0 Ac
CG&D PARTNERSHIP
879-130
A.J. & B.D. BYLER
934-155
PARCEL #2
J.F. & B.L. DOCKRILL
722-569
D.G. KOLHARSKI
T.A. SELFE
4.10 A
1131-665
CG&D Associates
4.10 A
1042-1175
CG&D Associates 693-67
PARCEL #6
15.94 A.
CARL P. & JUDITH D. NOVOTNY
772-375
28.113 Ac
CG&D Associates
693-65
1042-1175
T.R. PERDAN
875-684
P.E. & D.L.W. ADAMS
882-1230
C.K. SCHULTZ & L.R. MARKS
1039-666
J. MINADEO
J. MINADEO SR
B.R. & P.S. BAKER
1014-677
J.&M. OLIVER
5.18 Ac.
700 847
D & C LORY
687-793
705-736
2.27Ac
J.&S. MILNER
705-738
A.K. SCOTT
A & M FERRIN
705-734
R.H. & M.J. AHLMAN
733-833
603-714
K.P. II & P.K. BEVINGTON
734-131, 703-73
5.614Ac
J.&S. FRENZ
709-706
F.C. & C.J. REICHART
954-915
3.328 Ac.
K & P KINGSMILL
609-532
603-144
M.T. FLAHERTY
~~D.R. Reynolds~~
1116-250
~~707-368~~
~~363-890~~
3.328Ac
686-174
734-989
D.& K. HUMMEL 603-144
B.G. HUMMEL
745-162
J.D. & K.A. JACKSON
1045-994
M/S NORKO
621-869
7.14 A.
245-325
E. ADAMS
237-430
625-1169
J.P. ADAMS
34.69 A
25 A
M.J. & J.O. POLLARI
984-1019
20.0 Ac
M.J. YEATER
812-963
16.18A
E. Adams
173-451
237-503
532-435
672-709
672-707
R.C. WELLING
794-1248
2.88 Ac.
L & M. HOLMES
5.0 Ac.
756-544
53.33 Ac.
42.8 Ac.
PARCEL #1
PARCEL #2
941-839
880-342
829-303
V.F. & M. Arnold, TRUSTEES
ARNOLD FAMILY TRUST
829-303
880-342
VAUGHN and MILDRED ARNOLD TRUSTEES ARNOLD FAMILY TRUST
941-839
20.00 Ac.
220-269
829-303
880-342
PARCEL #4
749-1122
3.00 A
D.J. & S.D. PHELPS
R.W. & K.L. JOHNSON
724-572
615-1187
J.W. & D.I. HISCOX
3.00Ac.
695-1168
P.J. & B.J. RICCA
883-94
953-1182
E.J. WERTMAN
788-1276
3.00 A
R.J. & C.B. LOCKHART
651-444
3.00 A
S.J. & D.M. ARNOLD
751-379
6 Ac.
1043-1093
D.E. & J.L. YODER
875-1064
3.000A
734-95
G & B SWONTEK
609-218
3.00 A
V & M ARNOLD
635-1048
ARNOLD SUBDIVISION VOL. 12 PG. 42 S/Ls 1-5
97.97 A
2.05 A
245-343
532-435
829-303
941-839
829-303
941-839
PARCEL #3
38.8 Ac.
G & L MILLER
839-1356
4.2 A
S.A. HUFFMAN
1121-38
G.J. Dubyak
50.70 A
200-468
200-528
21.66 A
580-874
-877
RICHARD V. KNIGHT
CITY OF AKRON
17.86 A
City of Akron
33 A.
615-5
3.91 Ac.
J. & S. FINIZIA
802-3
R.J. & S. Springer
725-221
J. & S. FINIZIA
963-670
201-287
CITY OF AKRON
34.38 A
7.88 A
B.J. & F.R. KARABA, JR.
952-482
T.S. & C.A. POOLE
970-1064
3.52Ac
D.L. & D.K. BEAVER
913-385Ac.
5.2Ac.
D.W. & K.K. HUNT
3 A.
J.P. Hunter
J.A. & P.L. HUNTER
965-978
K.M. EVANS
1017-16
3.42 Ac.
D & F Herr
635-102
C.A. KOSCHKI
607-336
8.366 A
D.E. Weatherholt
603-471
R.H. & C.S. LEINHART
1105-296
3.143 Ac
P & L Bennins
603-808
3.313Ac.
Y. PETTY
999-992
A.A. & M.A. BYLER
921-1089
R & R Pinkerton
635-1082
6.08Ac
BENDON ENTERPRISES INC.
674-411 *
633-429 *
665-278 *
LEAVING 51.33Ac.
855-897 *
Bendon Inc.
700-905
5.00 A
T & S HENRY
232-179
23.63A.
836-65
746-112
67.86 Ac
943-358
S. NOSOL JR
K.T. NOSOL
184-578
59 A
City of Akron
parcel #2
957-1336 *
L.L. STEINGASS
20.309 Ac
578-493
1038-204
21.73 A
K. Welker
200-467
187-69
11.44 A
CITY OF AKRON
80.25 A
CITY OF AKRON
J.A. & B.L. SCHLEVENSKI
690-31
5.00AC
D.E. SHIPEK
1048-317
943-659
5.24 Ac
MULLETT
B.J. & L.J. PAWLOWSKI
D & R KOZENKO
1038-320
MABILL
M.A. & M.C. TROYER
908-496
4.2A
~~STEINGASS~~
~~531-427~~
D.J. BYLER
1115-677
MAP OFF
574-43
409-596
29.21 A
C.E. BYLER & E.A. & A.N. BYLER
677-116
1021-551
A.N. SCHMUCKER
A & M Byler
589-879
9.25A.
13.25 A
E & M DETWEILER
~~335-316~~
D.E. & S.A. BENDER
1119-858
R & E Bender
444-999
680-548
J.S. & G.J. YODER
719-1089
HIDDEN VIEW OLD ORDER AMISH SCHOOL
14 A
2.25Ac
10 A
SEE MAP J
42.27Ac.
J & G Fudurie
495-260
THE (Smallwood) FAMILY TRUST
706-90
919-730
7.758 Ac.
D. Smallwood 1/2 Int. 550-568
J.C. Haueter TRUSTEE 1/2 Int. 706-92
966-24
966-420
H & J. McNISH
38.50 A
E.S. & D.J. YODER
574-655
PARCEL #1
20 A

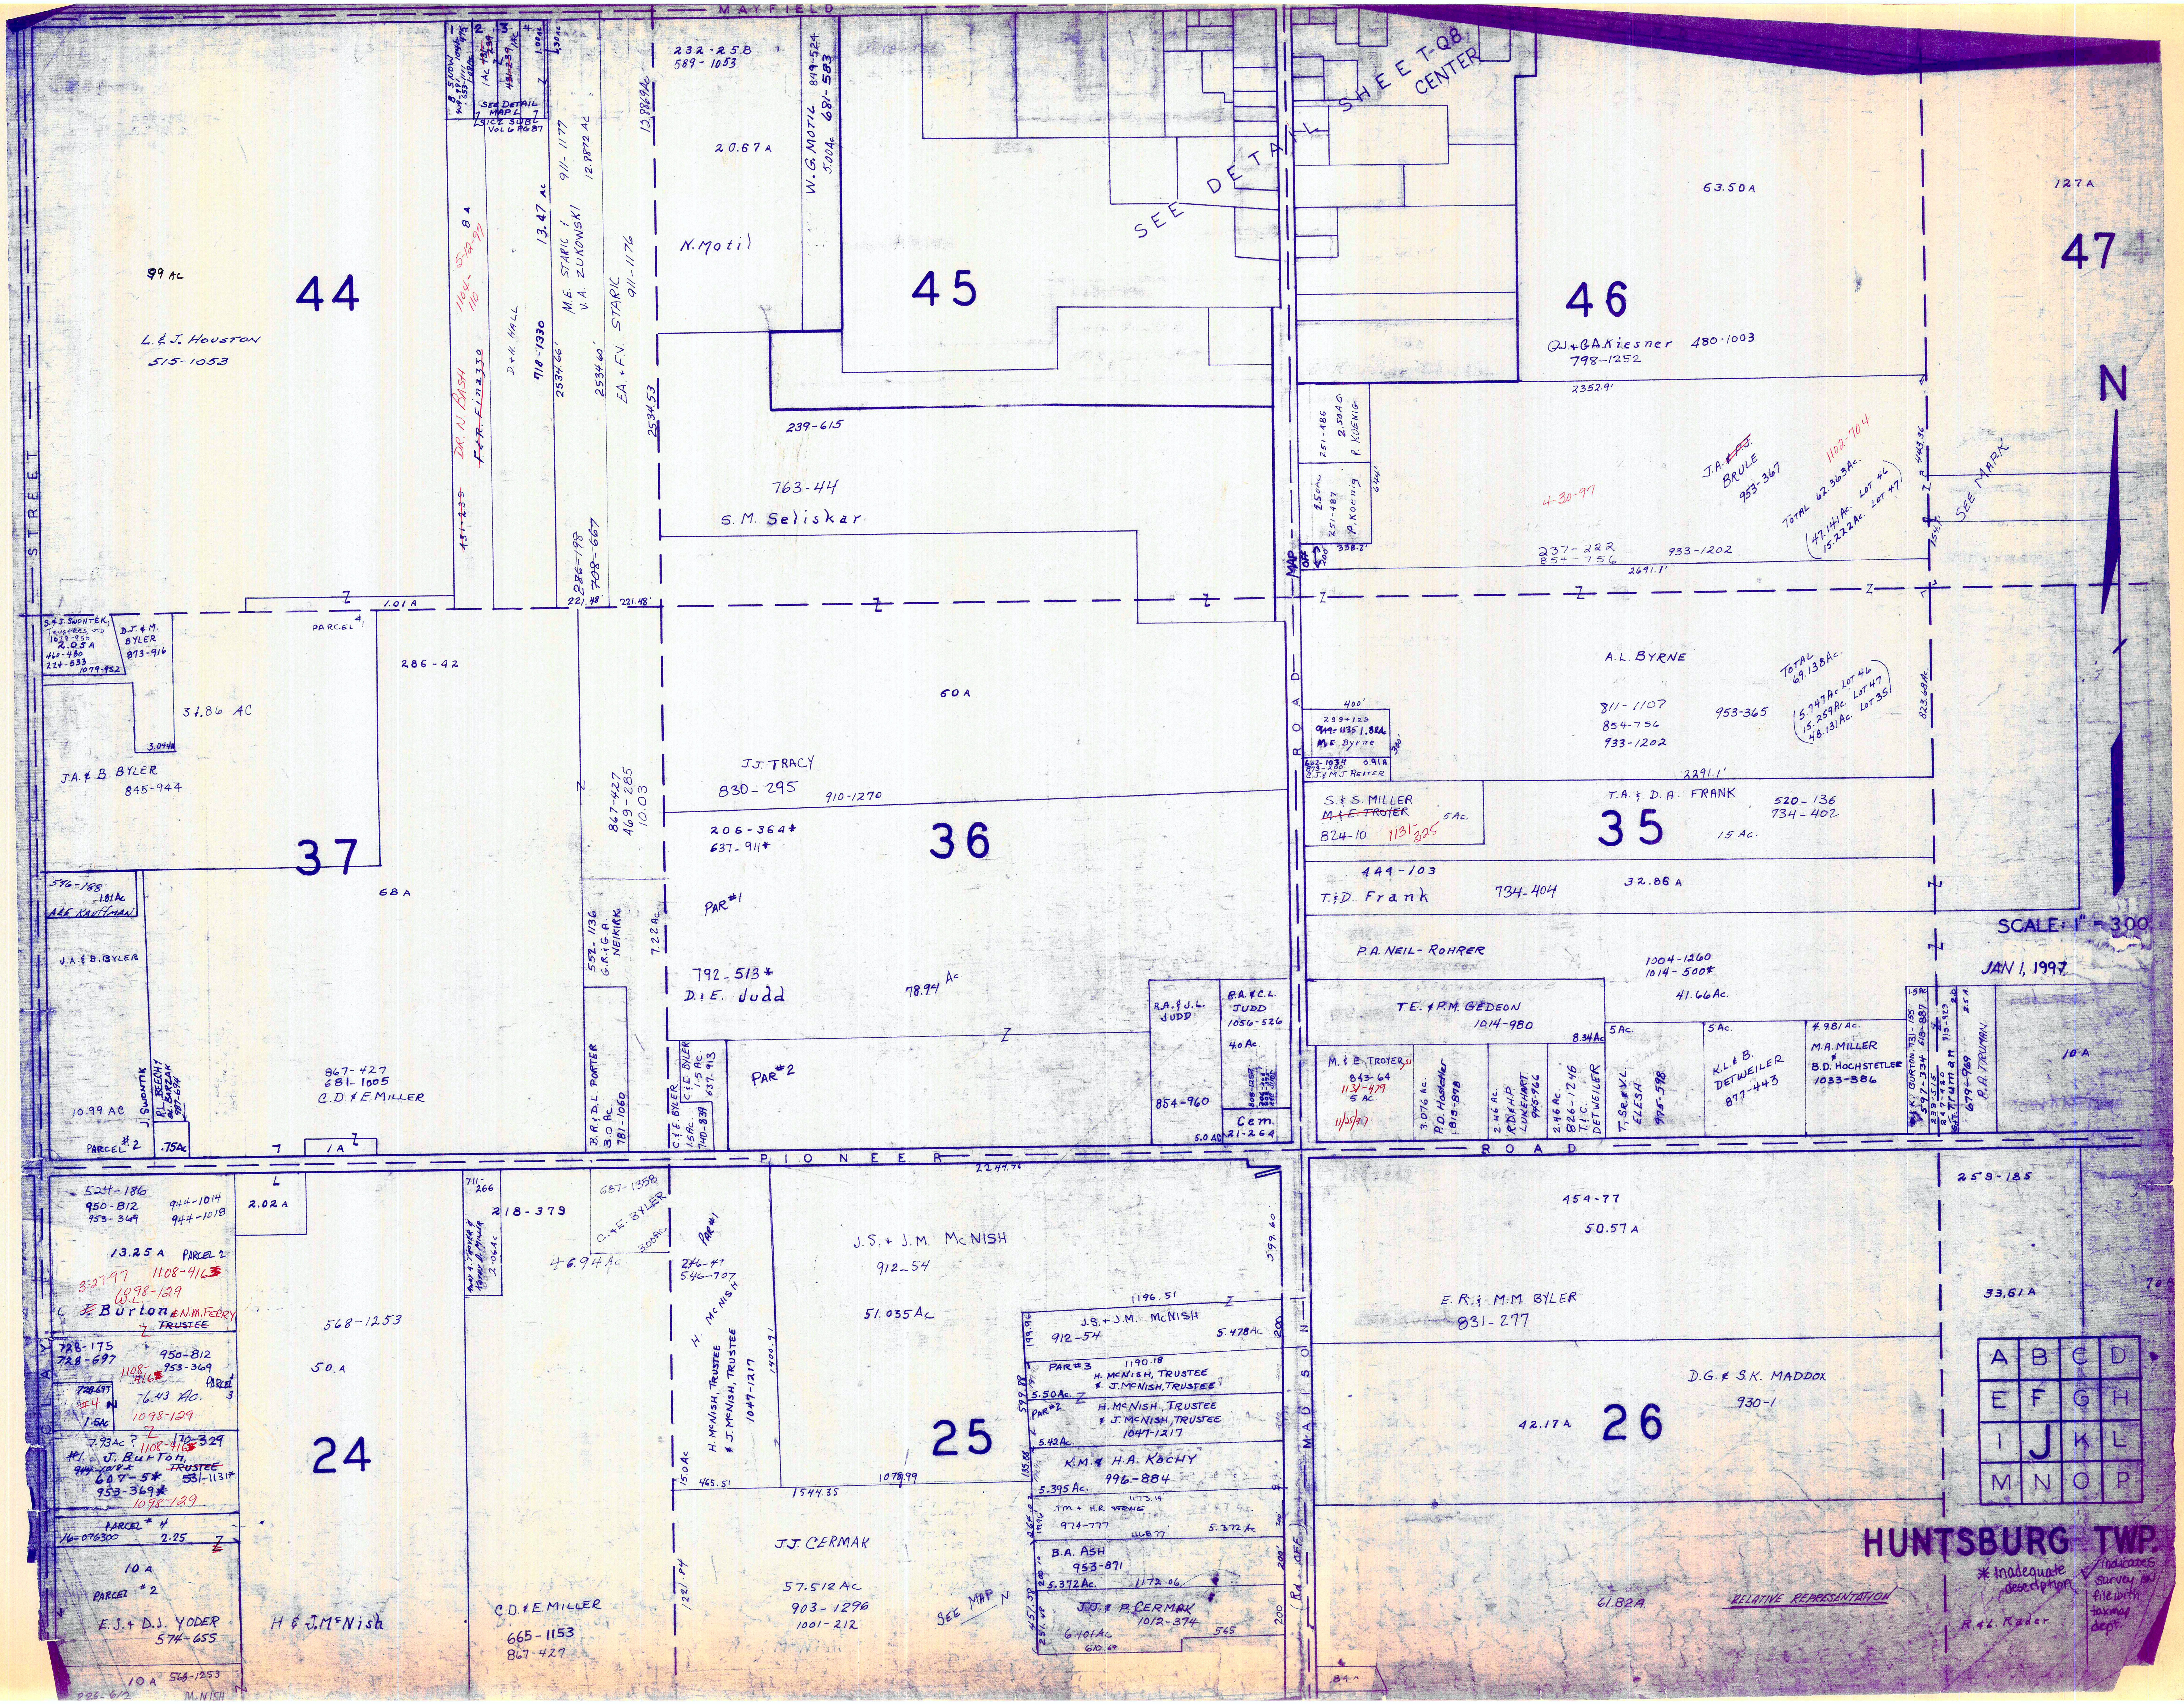
MAYFIELD
STREET
PIONEER ROAD
MADISON ROAD
SEE DETAIL SHEET T-QB CENTER
44
45
46
47
37
36
35
24
25
26
L.&J. HOUSTON
515-1053
99 Ac
N. Motil
20.67 A
232-258
589-1053
W.G. MOTIL 849-524
5.00Ac 681-583
DR. N. BASH
1164-110
5-12-97
D.&H. HALL
918-1930
13.47 Ac
M.E. STARIC & V.A. ZUKOWSKI
911-1177
12.8872 Ac
EA. & F.V. STARIC
911-1176
239-615
763-44
S.M. Seliskar
63.50 A
127 A
Q.J. & G.A. Kiesner 480-1003
798-1252
2352.9'
J.A. BRULE
953-367
1162-704
4-30-97
TOTAL 62.363Ac.
47.141Ac. LOT 46
15.222Ac. LOT 47
237-222
854-756
933-1202
2691.1'
P. KOENIG
SEE MAP
S.&J. SWONTEK
D.J.&M. BYLER
873-916
2.05A
286-42
1.01A
PARCEL 1
37.86 AC
J.A.&B. BYLER
845-944
68 A
60 A
J.J. TRACY
830-295
910-1270
206-364*
637-911*
PAR#1
792-513*
D.&E. Judd
78.94 Ac
PAR#2
867-427
469-285
10.03
592-1136
G.R.&G.A. NEIKIRK
7.22 Ac
A.L. BYRNE
TOTAL 69.138Ac.
5.747Ac. LOT 46
15.259Ac. LOT 47
48.131Ac. LOT 35
811-1107
854-756
933-1202
953-365
M.E. Byrne
2291.1'
S.&S. MILLER
~~M.&E. TROYER~~
824-10
1131-825
5Ac.
T.A.&D.A. FRANK
520-136
734-402
15 Ac.
444-103
T.&D. Frank
734-404
32.86 A
SCALE: 1" = 300'
JAN 1, 1997
P.A. NEIL-ROHRER
1004-1260
1014-500*
41.66Ac.
T.E.&P.M. GEDEON
1014-980
R.A.&J.L. JUDD
854-960
R.A.&C.L. JUDD
1056-526
4.0 Ac.
Cem.
M.&E. TROYER
843-64
1131-479
5 Ac.
11/25/97
P.D. Hostetler
R.D.&H.P. LUKEHART
T.I.C. DETWEILER
T. SR.&V.L. ELESH
K.L.&B. DETWEILER
877-443
M.A. MILLER
B.D. HOCHSTETLER
1033-386
R.A. TRUMAN
10 A
J. SWONTEK
R.I. BEECHY
10.99 AC
PARCEL #2
.75Ac
1 A
867-427
681-1005
C.D.&E. MILLER
A&E KAUFFMAN
J.A.&B. BYLER
B.R.&D.L. PORTER
781-1060
C.&E. BYLER
524-186
950-812
953-369
944-1014
944-1018
2.02 A
13.25 A
PARCEL 2
3-27-97 1108-416
1098-129
W.L. Burton & N.M. FERRY TRUSTEE
728-175
728-697
950-812
953-369
16.43 Ac.
PARCEL 3
1098-129
#4
#1 J. Burton, TRUSTEE
607-5*
953-369*
581-1131*
1098-129
PARCEL #4
2.25
10 A
PARCEL #2
E.J.&D.J. YODER
574-655
10 A 568-1253
M. NISH
568-1253
50 A
H & J. McNish
C.D.&E. MILLER
665-1153
867-427
218-379
46.94 Ac.
C.&E. BYLER
PAR#1
276-47
546-707
H. McNISH, TRUSTEE & J. McNISH, TRUSTEE
1047-1217
J.S.&J.M. McNISH
912-54
51.035 Ac
J.S.&J.M. McNISH
912-54
5.478Ac
PAR#3
H. McNISH, TRUSTEE & J. McNISH, TRUSTEE
5.50Ac
PAR#2
H. McNISH, TRUSTEE & J. McNISH, TRUSTEE
1047-1217
K.M.&H.A. KOCHY
996-884
5.395 Ac.
974-777
B.A. ASH
953-871
5.372Ac.
J.J.&P. CERMAK
1012-374
6.401Ac
J.J. CERMAK
57.512 Ac
903-1296
1001-212
SEE MAP N
454-77
50.57 A
E.R.&M.M. BYLER
831-277
D.G.&S.K. MADDOX
930-1
42.17 A
61.82A
259-185
33.61 A
A B C D
E F G H
I J K L
M N O P
HUNTSBURG TWP.
* inadequate description
✓ indicates survey on file with tax map dept.
RELATIVE REPRESENTATION
R.&L. Reder

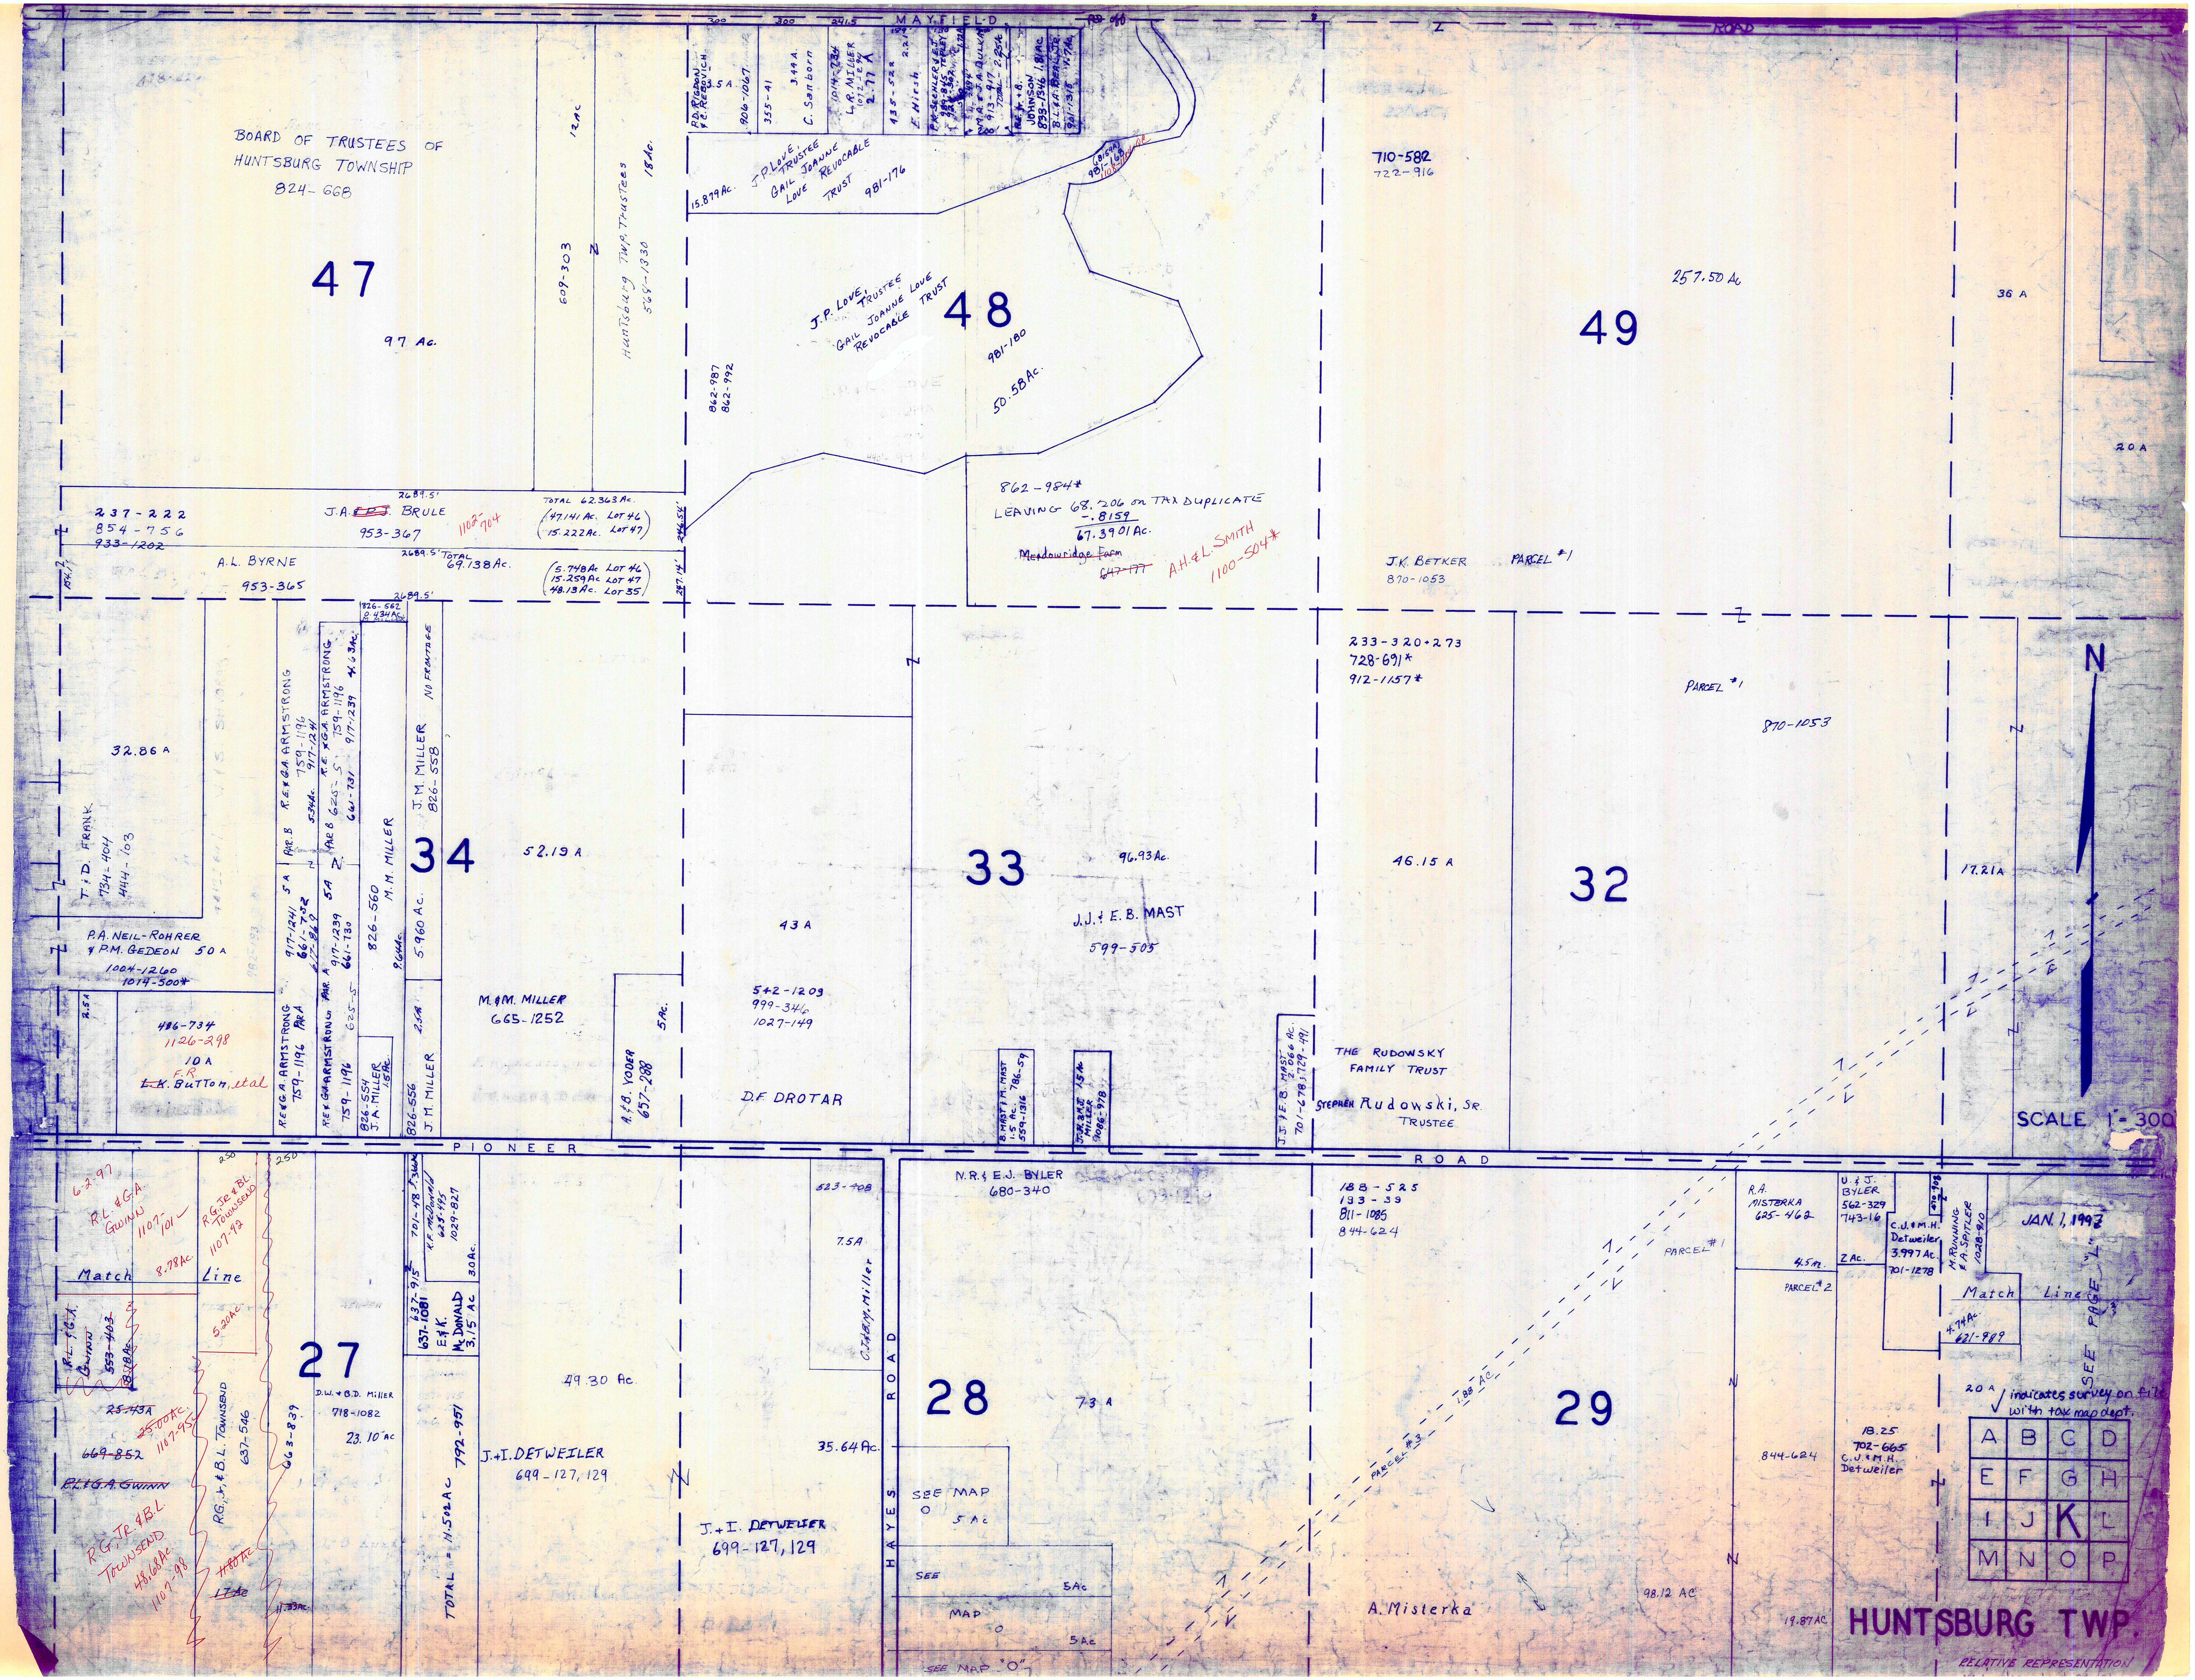
MAYFIELD RD
300
300
241.5
P.D. RIGDON & C. REBOVICH 3.5 A 906-1067
355-41 3.44 A. C. Sanborn
1014-734 L.R. MILLER 1072-294 2.77 A
435-522 2.21 E. Hirsh
P.K. SECHLER & E.J. TEPLEY 989-845
M.A. & J.A. DULKA 913-917 TOTAL - 2.25 A
R.E. Jr. & B. JOHNSON 833-1346 1.81 AC
B.L. & A. BEAL JR. 901-1315 4.7 AC
15.879 AC. J.P. LOVE, TRUSTEE GAIL JOANNE LOVE REVOCABLE TRUST 981-176
(.8159 A) 981-168
1108-1184
BOARD OF TRUSTEES OF HUNTSBURG TOWNSHIP 824-668
47
97 AC.
12 AC.
609-303
18 AC.
HUNTSBURG TWP. TRUSTEES 569-1830
J.P. LOVE, TRUSTEE GAIL JOANNE LOVE REVOCABLE TRUST
48
981-180
50.58 AC.
862-987
862-992
862-984*
LEAVING 68.206 ON TAX DUPLICATE -.8159 67.3901 AC.
Meadowridge Farm
~~647-177~~ A.H. & L. SMITH 1100-504*
710-582
722-916
257.50 AC
49
36 A
20 A
J.K. BETKER PARCEL #1 870-1053
237-222
854-756
933-1202
J.A. BRULE 953-367
1102-704
2689.5'
TOTAL 62.363 AC (47.141 AC. LOT 46) (15.222 AC. LOT 47)
A.L. BYRNE 953-365
2689.5' TOTAL 69.138 AC. (5.748 AC LOT 46) (15.259 AC. LOT 47) (48.13 AC. LOT 35)
32.86 A
T.D. FRANK 734-404 444-103
R.E. & G.A. ARMSTRONG 759-1196 917-1241
R.E. & G.A. ARMSTRONG 759-1196 917-1239
826-562 8.434 AC.
J.M. MILLER 826-558
NO FRONTAGE
M.M. MILLER 826-560
5.960 AC.
34
52.19 A
P.A. NEIL-ROHRER & P.M. GEDEON 50 A 1004-1260 1014-500*
486-734 1126-298 10 A
~~L.K.~~ F.R. BUTTON, etal
M. & M. MILLER 665-1252
R.E. & G.A. ARMSTRONG 759-1196 PAR A
J.A. MILLER 826-554
J.M. MILLER 826-556
A. & B. YODER 657-288
5 AC.
43 A
542-1203
999-346
1027-149
D.F. DROTAR
33
96.93 AC.
J.J. & E.B. MAST 599-505
J.J. & E.B. MAST 786-59 559-1316
MILLER 1006-978
J.J. & E.B. MAST 701-678 729-191
233-320-273
728-691*
912-1157*
46.15 A
32
PARCEL #1 870-1053
17.21 A
THE RUDOWSKY FAMILY TRUST STEPHEN RUDOWSKI, SR. TRUSTEE
N
SCALE 1" = 300'
PIONEER ROAD
6-2-97
R.L. & G.A. GWINN 1107-101
R.G. Jr. & B.L. TOWNSEND 1107-97
8.78 AC
Match Line
5.20 AC
R.L. & G.A. GWINN 559-403
25.43 A
25.00 AC 1107-95
669-852
R.L. & G.A. GWINN
R.G. Jr. & B.L. TOWNSEND 637-546
R.G. Jr. & B.L. TOWNSEND 48.63 AC. 1107-98
663-839
27
D.W. & B.D. Miller 718-1082 23.10 AC
701-48
1029-827
3.0 AC.
637-915
637-1081
E. & K. McDONALD 3.15 AC
TOTAL = 11.50 AC 792-951
49.30 AC.
J. & I. DETWEILER 699-127, 129
J. & I. DETWEILER 699-127, 129
523-408
7.5 A
C.J. & M. Miller
35.64 AC.
HAYES ROAD
N.R. & E.J. BYLER 680-340
28
73 A
SEE MAP O 5 AC
SEE MAP O 5 AC
SEE MAP "O"
188-525
133-39
811-1085
844-624
PARCEL #1
PARCEL #3
188 AC
29
A. Misterka
98.12 AC
R.A. MISTERKA 625-462
4.5 AC.
PARCEL #2
U. & J. BYLER 562-329 743-16
2 AC.
C.J. & M.H. Detweiler 3.997 AC. 701-1278
470-908
M. RUNNING & A. SPITLER 1028-910
JAN. 1, 1997
Match Line
4.74 AC. 621-989
SEE PAGE "L"
20 A
✓ indicates survey on file with tax map dept.
844-624
19.87 AC
18.25 702-665 C.J. & M.H. Detweiler
A B C D
E F G H
I J K L
M N O P
HUNTSBURG TWP.
RELATIVE REPRESENTATION

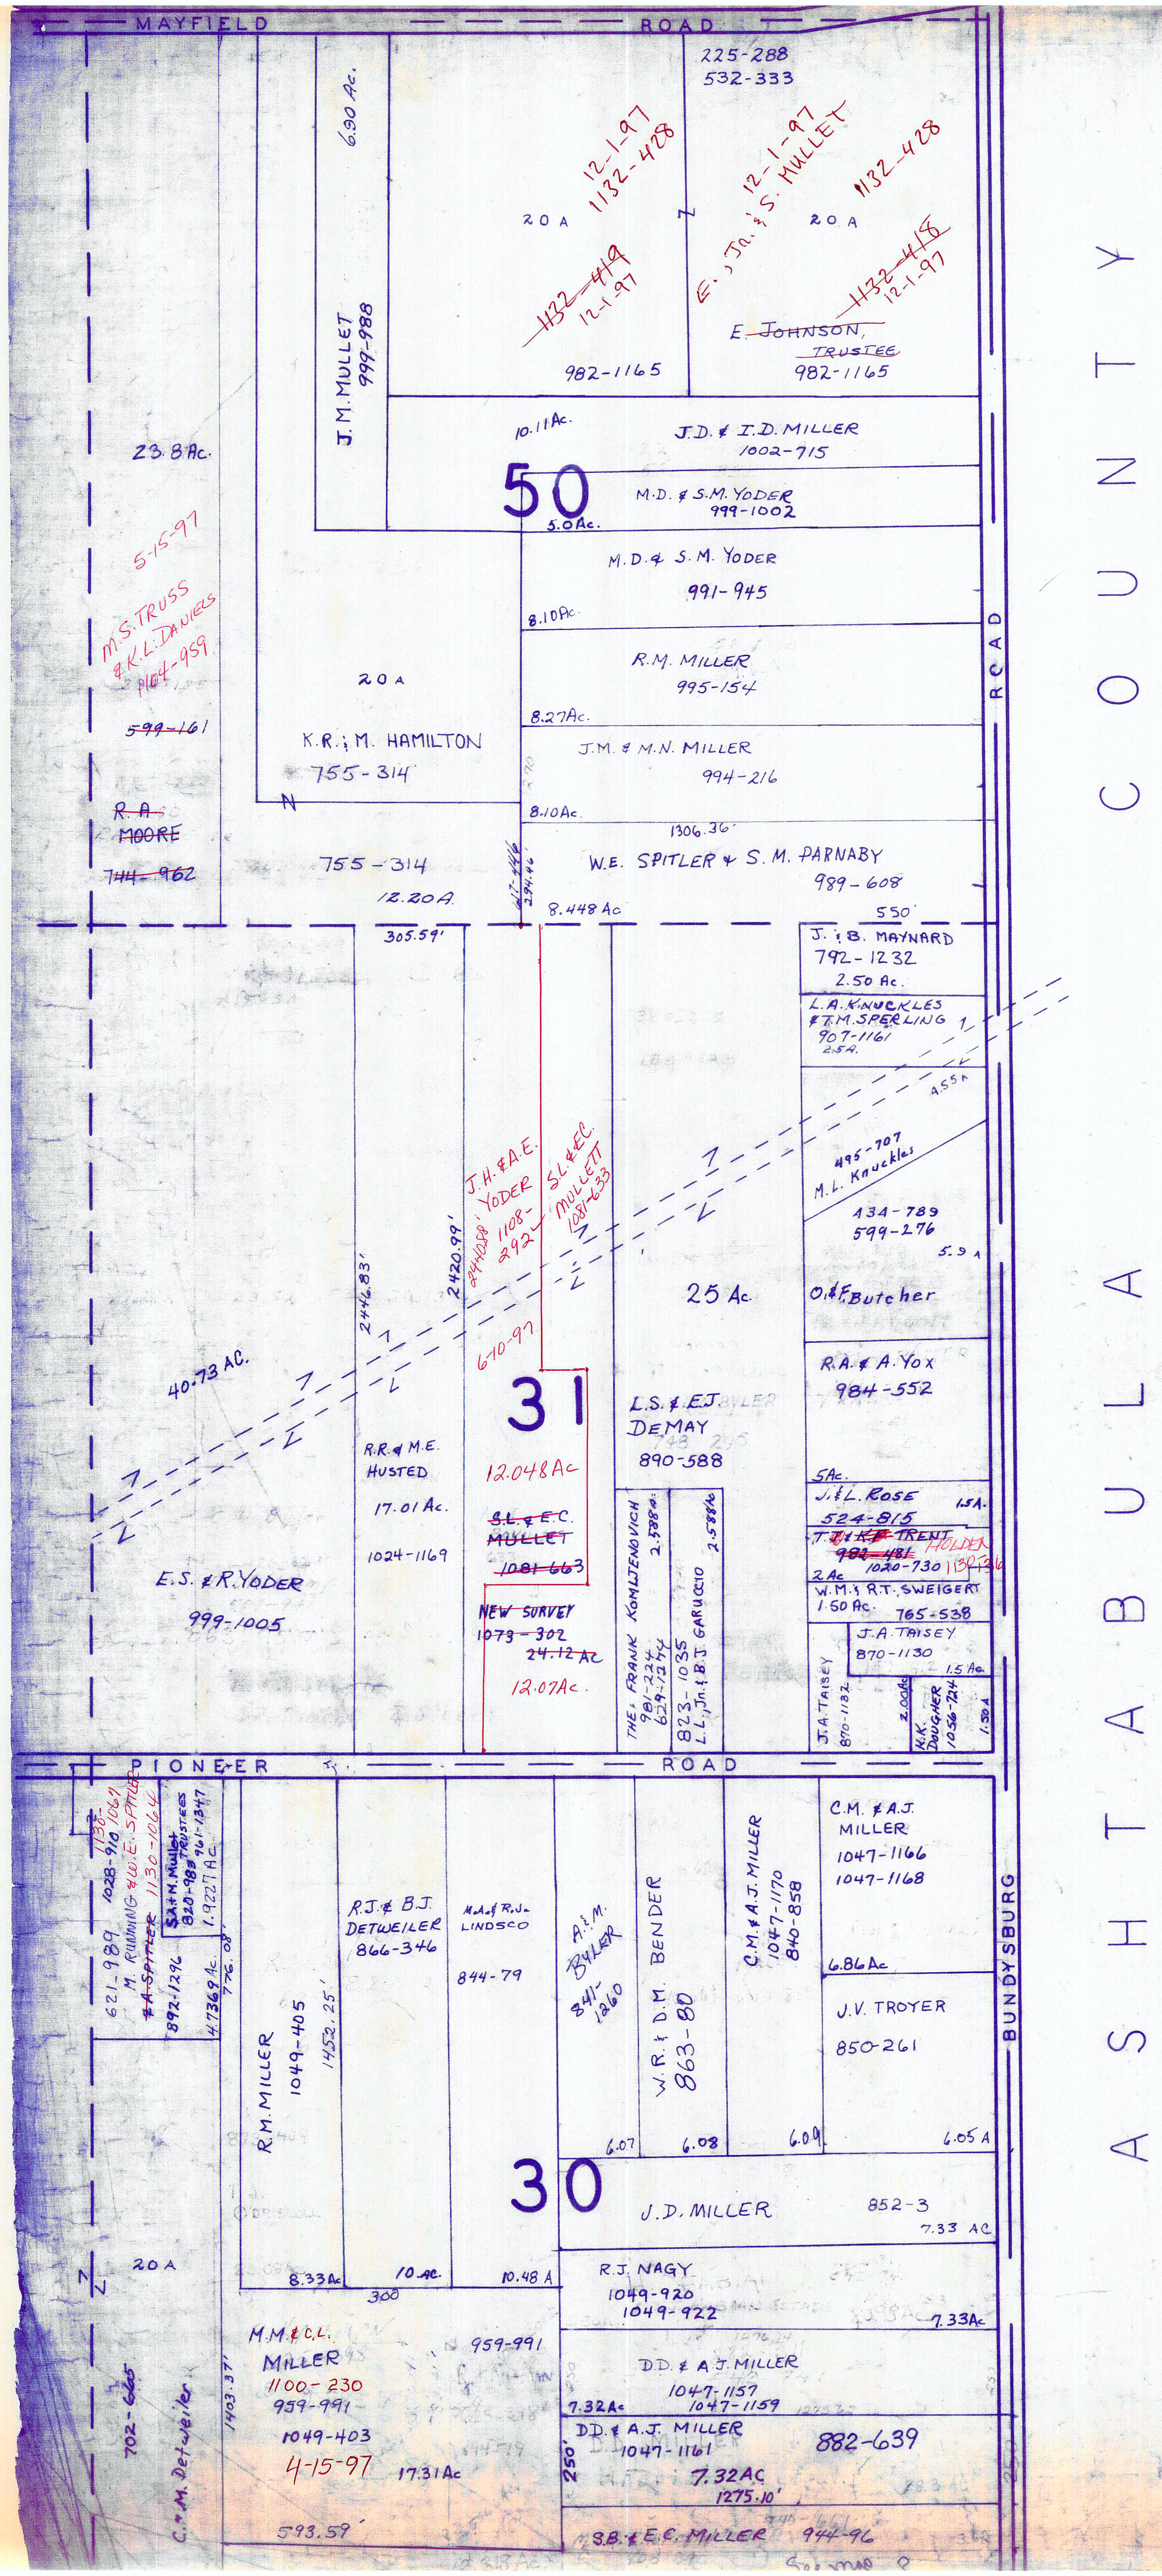
MAYFIELD ROAD
225-288
532-333
6.90 Ac.
J.M. MULLET
999-988
20 A
12-1-97
1132-428
~~1132-419~~
12-1-97
982-1165
12-1-97
E., Jr. & S. MULLET
1132-428
20 A
~~1132-418~~
12-1-97
E. ~~JOHNSON,~~
~~TRUSTEE~~
982-1165
23.8 Ac.
5-15-97
M.S. TRUSS
& K.L. DANIELS
1104-959
~~599-161~~
~~R.A.~~
~~MOORE~~
~~744-962~~
10.11 Ac.
J.D. & I.D. MILLER
1002-715
50
M.D. & S.M. YODER
999-1002
5.0 Ac.
M.D. & S.M. YODER
991-945
8.10 Ac.
R.M. MILLER
995-154
20 A
8.27 Ac.
K.R. & M. HAMILTON
755-314
J.M. & M.N. MILLER
994-216
8.10 Ac.
1306.36'
W.E. SPITLER & S.M. PARNABY
989-608
755-314
12.20 A.
1117-446
294.46'
8.448 Ac
550'
ROAD
305.59'
J. & B. MAYNARD
792-1232
2.50 Ac.
L.A. KNUCKLES
& T.M. SPERLING
907-1161
2.5 A.
4.55 A
495-707
M.L. Knuckles
434-789
599-276
5.9 A
J.H. & A.E.
YODER
1108-
292
2440.88'
S.L. & E.C.
MULLETT
1081-633
6-10-97
2420.99'
2446.83'
25 Ac.
O. & F. Butcher
R.A. & A. Yox
984-552
40.73 AC.
31
L.S. & E.J.
DeMAY
890-588
R.R. & M.E.
HUSTED
17.01 Ac.
1024-1169
12.048 Ac
~~S.L. & E.C.~~
~~MULLET~~
~~1081-663~~
5 Ac.
J. & L. ROSE
524-815
1.5 A.
~~T.J. & K.F. TRENT~~
~~982-481~~
HOLDEN
1020-730
1130-736
2 Ac
W.M. & R.T. SWEIGERT
1.50 Ac.
765-538
J.A. TAISEY
870-1130
1.5 Ac.
E.S. & R. YODER
999-1005
NEW SURVEY
1073-302
~~24.12 Ac~~
12.07 Ac.
THE. FRANK KOMLJENOVICH
981-224
629-1244
2.588 Ac
823-1035
L.L., Jr. & B.J. GARUCCIO
2.588 Ac
J.A. TAISEY
870-1132
2.00 Ac
K.K. DOUGHER
1056-724
1.50 A
PIONEER ROAD
1136-
1028-910 1061
621-989
M. RUNNING & W.E. SPITLER
1130-1064
~~& A. SPITLER~~
892-1296
S.A. & M. Mullet
TRUSTEES
820-983
961-1347
1.922 Ac
4.7369 Ac.
776.08'
R.J. & B.J.
DETWEILER
866-346
M.A. & R.J.
LINDSCO
844-79
A. & M.
BYLER
841-
1260
C.M. & A.J. MILLER
1047-1170
840-858
C.M. & A.J.
MILLER
1047-1166
1047-1168
6.86 Ac
J.V. TROYER
850-261
R.M. MILLER
1049-405
1452.25'
W.R. & D.M. BENDER
863-80
6.07
6.08
6.09
6.05 A
30
J.D. MILLER
852-3
7.33 AC
20 A
8.33 Ac
10 Ac.
10.48 A
300
R.J. NAGY
1049-920
1049-922
7.33 Ac
M.M. & C.L.
MILLER
1100-230
959-991
1049-403
4-15-97
959-991
17.31 Ac
D.D. & A.J. MILLER
1047-1157
1047-1159
7.32 Ac
D.D. & A.J. MILLER
1047-1161
882-639
7.32 AC
1275.10'
250'
1403.37'
702-665
C. & M. Detweiler
593.59'
S.B. & E.C. MILLER
944-96
BUNDYSBURG ROAD
ASHTABULA COUNTY

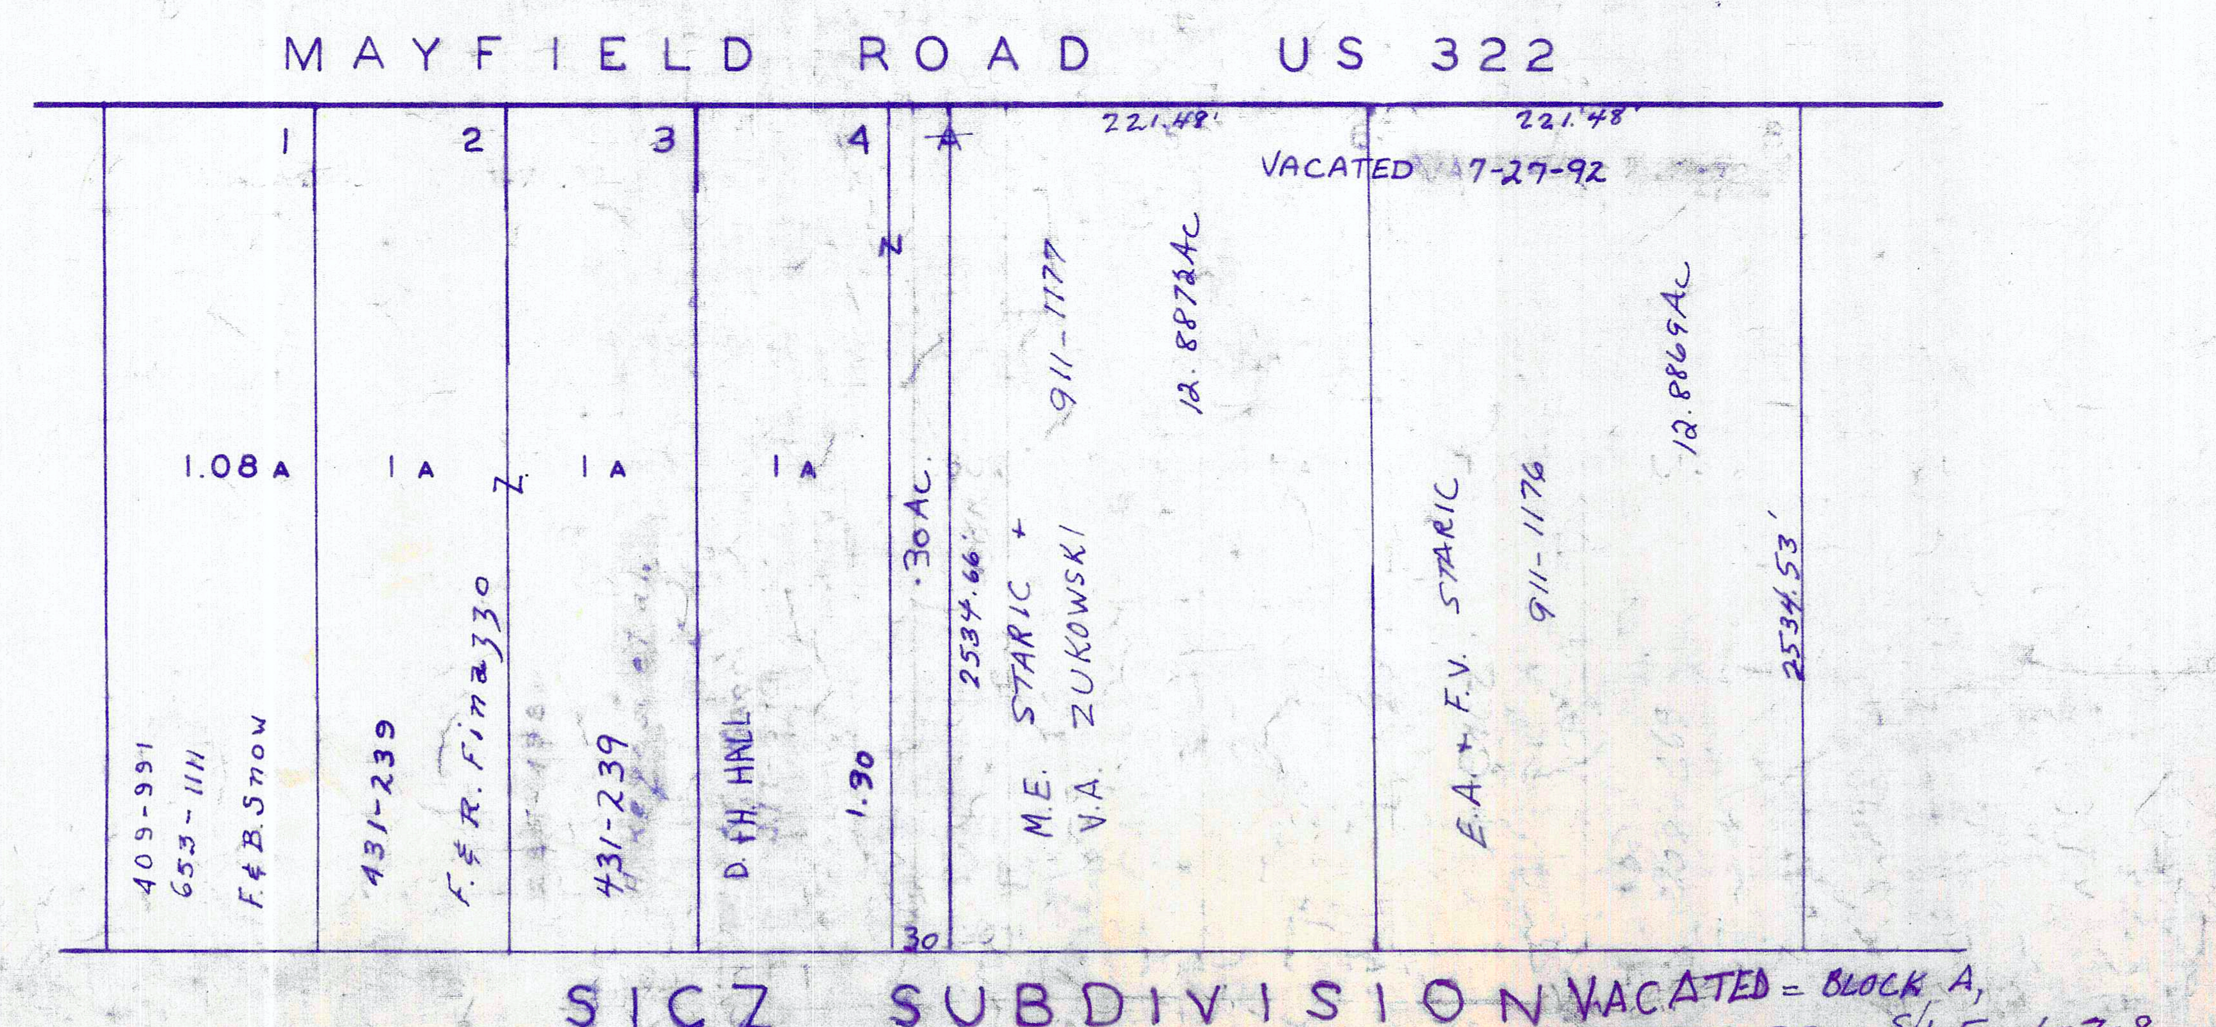
MAYFIELD ROAD US 322
1
2
3
4
A
221.48'
221.48'
VACATED 7-27-92
1.08 A
1 A
1 A
1 A
409-991
653-1111
F. & B. Snow
431-239
F. & R. Fina 330
431-239
D. & H. HALL
1.90
.30 Ac.
30
2534.66'
M.E. STARIC +
V.A. ZUKOWSKI
911-1177
12.8872 Ac
E.A. + F.V. STARIC
911-1176
12.8869 Ac
2534.53'

SICZ SUBDIVISION VACATED = BLOCK A, 7-27-92 S/L 5-6-7-8

VOL-6-PG. 87

LOT 44

SCALE 1" 100'

N

√ indicates survey on file with tax map dept.

SCALE 1" 300'

JAN 1, 1997

* Inadequate description

RELATIVE REPRESENTATION

A	B	C	D
E	F	G	H
I	J	K	**L**
M	N	O	P

HUNTSBURG TWP.

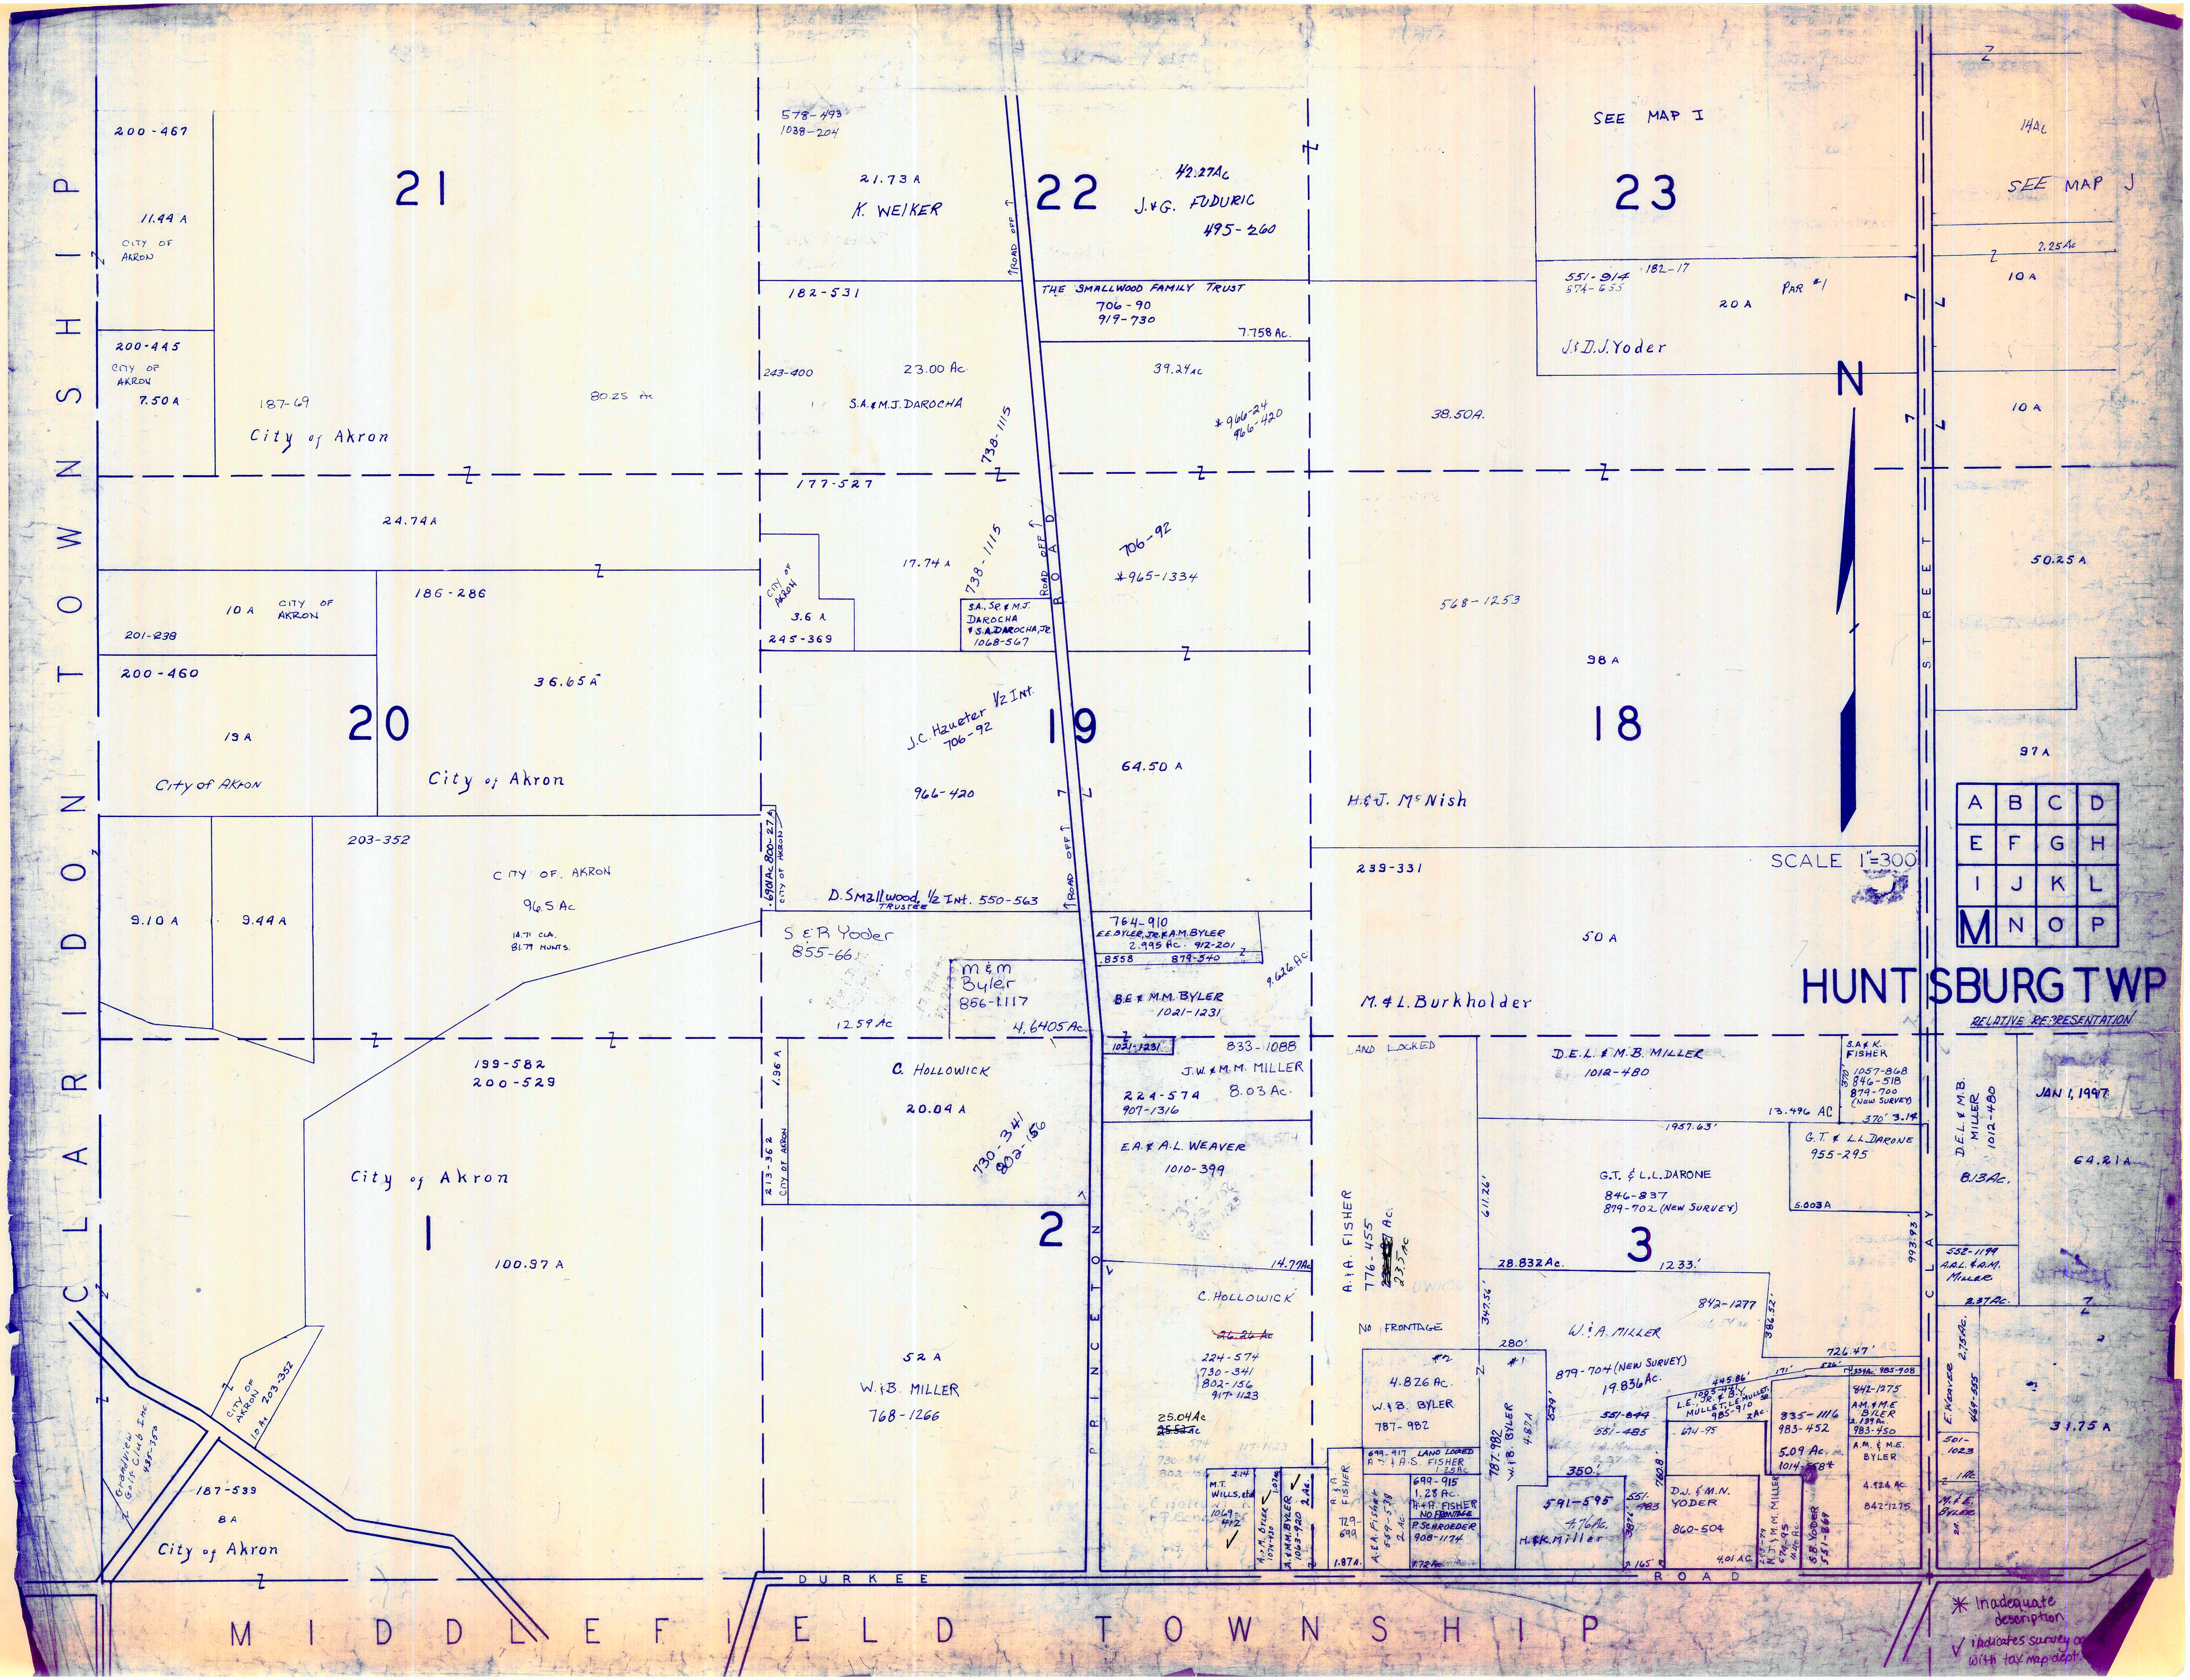
HUNTSBURG TWP
RELATIVE REPRESENTATION
SCALE 1"=300'
JAN 1, 1997
N
A B C D
E F G H
I J K L
M N O P
SEE MAP I
SEE MAP J
CLARIDON TOWNSHIP
MIDDLEFIELD TOWNSHIP
PRINCETON ROAD
DURKEE ROAD
CLAY STREET
ROAD OFF
21
22
23
20
19
18
1
2
3
200-467
11.44 A
CITY OF AKRON
200-445
CITY OF AKRON
7.50 A
187-69
80.25 Ac
City of Akron
578-493
1038-204
21.73 A
K. WEIKER
42.27 Ac
J.&G. FUDURIC
495-260
182-531
THE SMALLWOOD FAMILY TRUST
706-90
919-730
7.758 Ac.
243-400
23.00 Ac
S.A.&M.J. DAROCHA
39.24 Ac
*966-24
966-420
738-1115
551-914
574-655
182-17
20 A
PAR #1
J.&D.J. Yoder
14 Ac
2.25 Ac
10 A
10 A
38.50 A.
177-527
24.74 A
17.74 A
CITY OF AKRON
3.6 A
245-369
S.A. Sr & M.J. DAROCHA
& S.A. DAROCHA, JR
1068-567
738-1115
706-92
*965-1334
568-1253
50.25 A
10 A
CITY OF AKRON
201-238
186-286
200-460
36.65 A
19 A
City of Akron
City of Akron
J.C. Hzueter 1/2 Int.
706-92
966-420
64.50 A
98 A
97 A
H.&J. McNish
203-352
CITY OF AKRON
96.5 Ac
14.71 CLA.
81.79 MUNTS.
.690 A 800-27
CITY OF AKRON
D. Smallwood, 1/2 Int. 550-563
TRUSTEE
9.10 A
9.44 A
S.&R. Yoder
855-66
M&M Byler
856-1117
12.59 Ac
4.6405 Ac.
764-910
E.E. BYLER, JR. & A.M. BYLER
2.995 Ac. 912-201
.8558 879-540
9.626 Ac.
B.E.&M.M. BYLER
1021-1231
1021-1231
239-331
50 A
M.&L. Burkholder
199-582
200-529
1.96 A
C. HOLLOWICK
20.04 A
730-341
802-156
833-1088
J.W.&M.M. MILLER
8.03 Ac.
224-574
907-1316
LAND LOCKED
D.E.L.&M.B. MILLER
1012-480
S.A.&K. FISHER
1057-868
846-518
879-700
(NEW SURVEY)
370'
370' 3.14
13.496 AC
1957.63'
G.T.&L.L. DARONE
955-295
5.003 A
D.E.L.&M.B. MILLER
1012-480
8.13 Ac.
64.21 A
213-362
CITY OF AKRON
E.A.&A.L. WEAVER
1010-399
City of Akron
100.97 A
A.&A. FISHER
776-455
23.5 Ac
611.26'
G.T.&L.L. DARONE
846-837
879-702 (NEW SURVEY)
993.93'
14.77 Ac
28.832 Ac.
1233.'
552-1199
A.A.L.&A.M. MILLER
2.37 Ac.
C. HOLLOWICK
~~26.26 Ac~~
224-574
730-341
802-156
917-1123
NO FRONTAGE
347.56'
842-1277
386.52'
W.&A. MILLER
280'
726.47'
#2
4.826 Ac.
W.&B. BYLER
787-982
#1
879-704 (NEW SURVEY)
19.836 Ac.
52 A
W.&B. MILLER
768-1266
25.04 Ac
~~25.52 Ac~~
787-982
W.&B. BYLER
4.87 A
529'
551-844
551-485
445.86'
L.E., Jr. & B.Y. MULLET, L.E. MULLET, SR.
1095-441
985-910
2 Ac.
171'
526'
.334 Ac. 985-908
842-1275
A.M.&M.E. BYLER
2.139 Ac.
983-450
E. WEAVER
2.75 Ac.
469-555
31.75 A
614-95
835-1116
983-452
5.09 Ac.
1014-558*
A.M.&M.E. BYLER
4.924 Ac.
842-1275
501-1023
1 Ac.
M.&E. BYLER
2 A
699-917 LAND LOCKED
A.J.&A.S. FISHER
1.25 Ac.
699-915
1.28 Ac.
A.&A. FISHER
NO FRONTAGE
P. SCHROEDER
908-1174
.72 Ac
A.&A. FISHER
729-699
1.87 A.
A.&A. Fisher
689-538
2 Ac.
M.T. WILLS, etal
2.14
1069-412
✓
A.&M. BYLER
1.07 Ac
1074-930
✓
A.&M.M. BYLER
1063-920
2 Ac.
350'
591-595
4.76 Ac.
H.&K. Miller
551-483
382'
760.8'
165'
D.J.&M.N. YODER
860-504
4.01 AC.
213-79
N.J.&M.M. MILLER
674-95
4.40 Ac.
S.B. YODER
551-869
Grandview Golf Club Inc.
CITY OF AKRON
10 Ac. 203-352
187-539
8 A
City of Akron
* Inadequate description
✓ indicates survey on file with tax map dept.

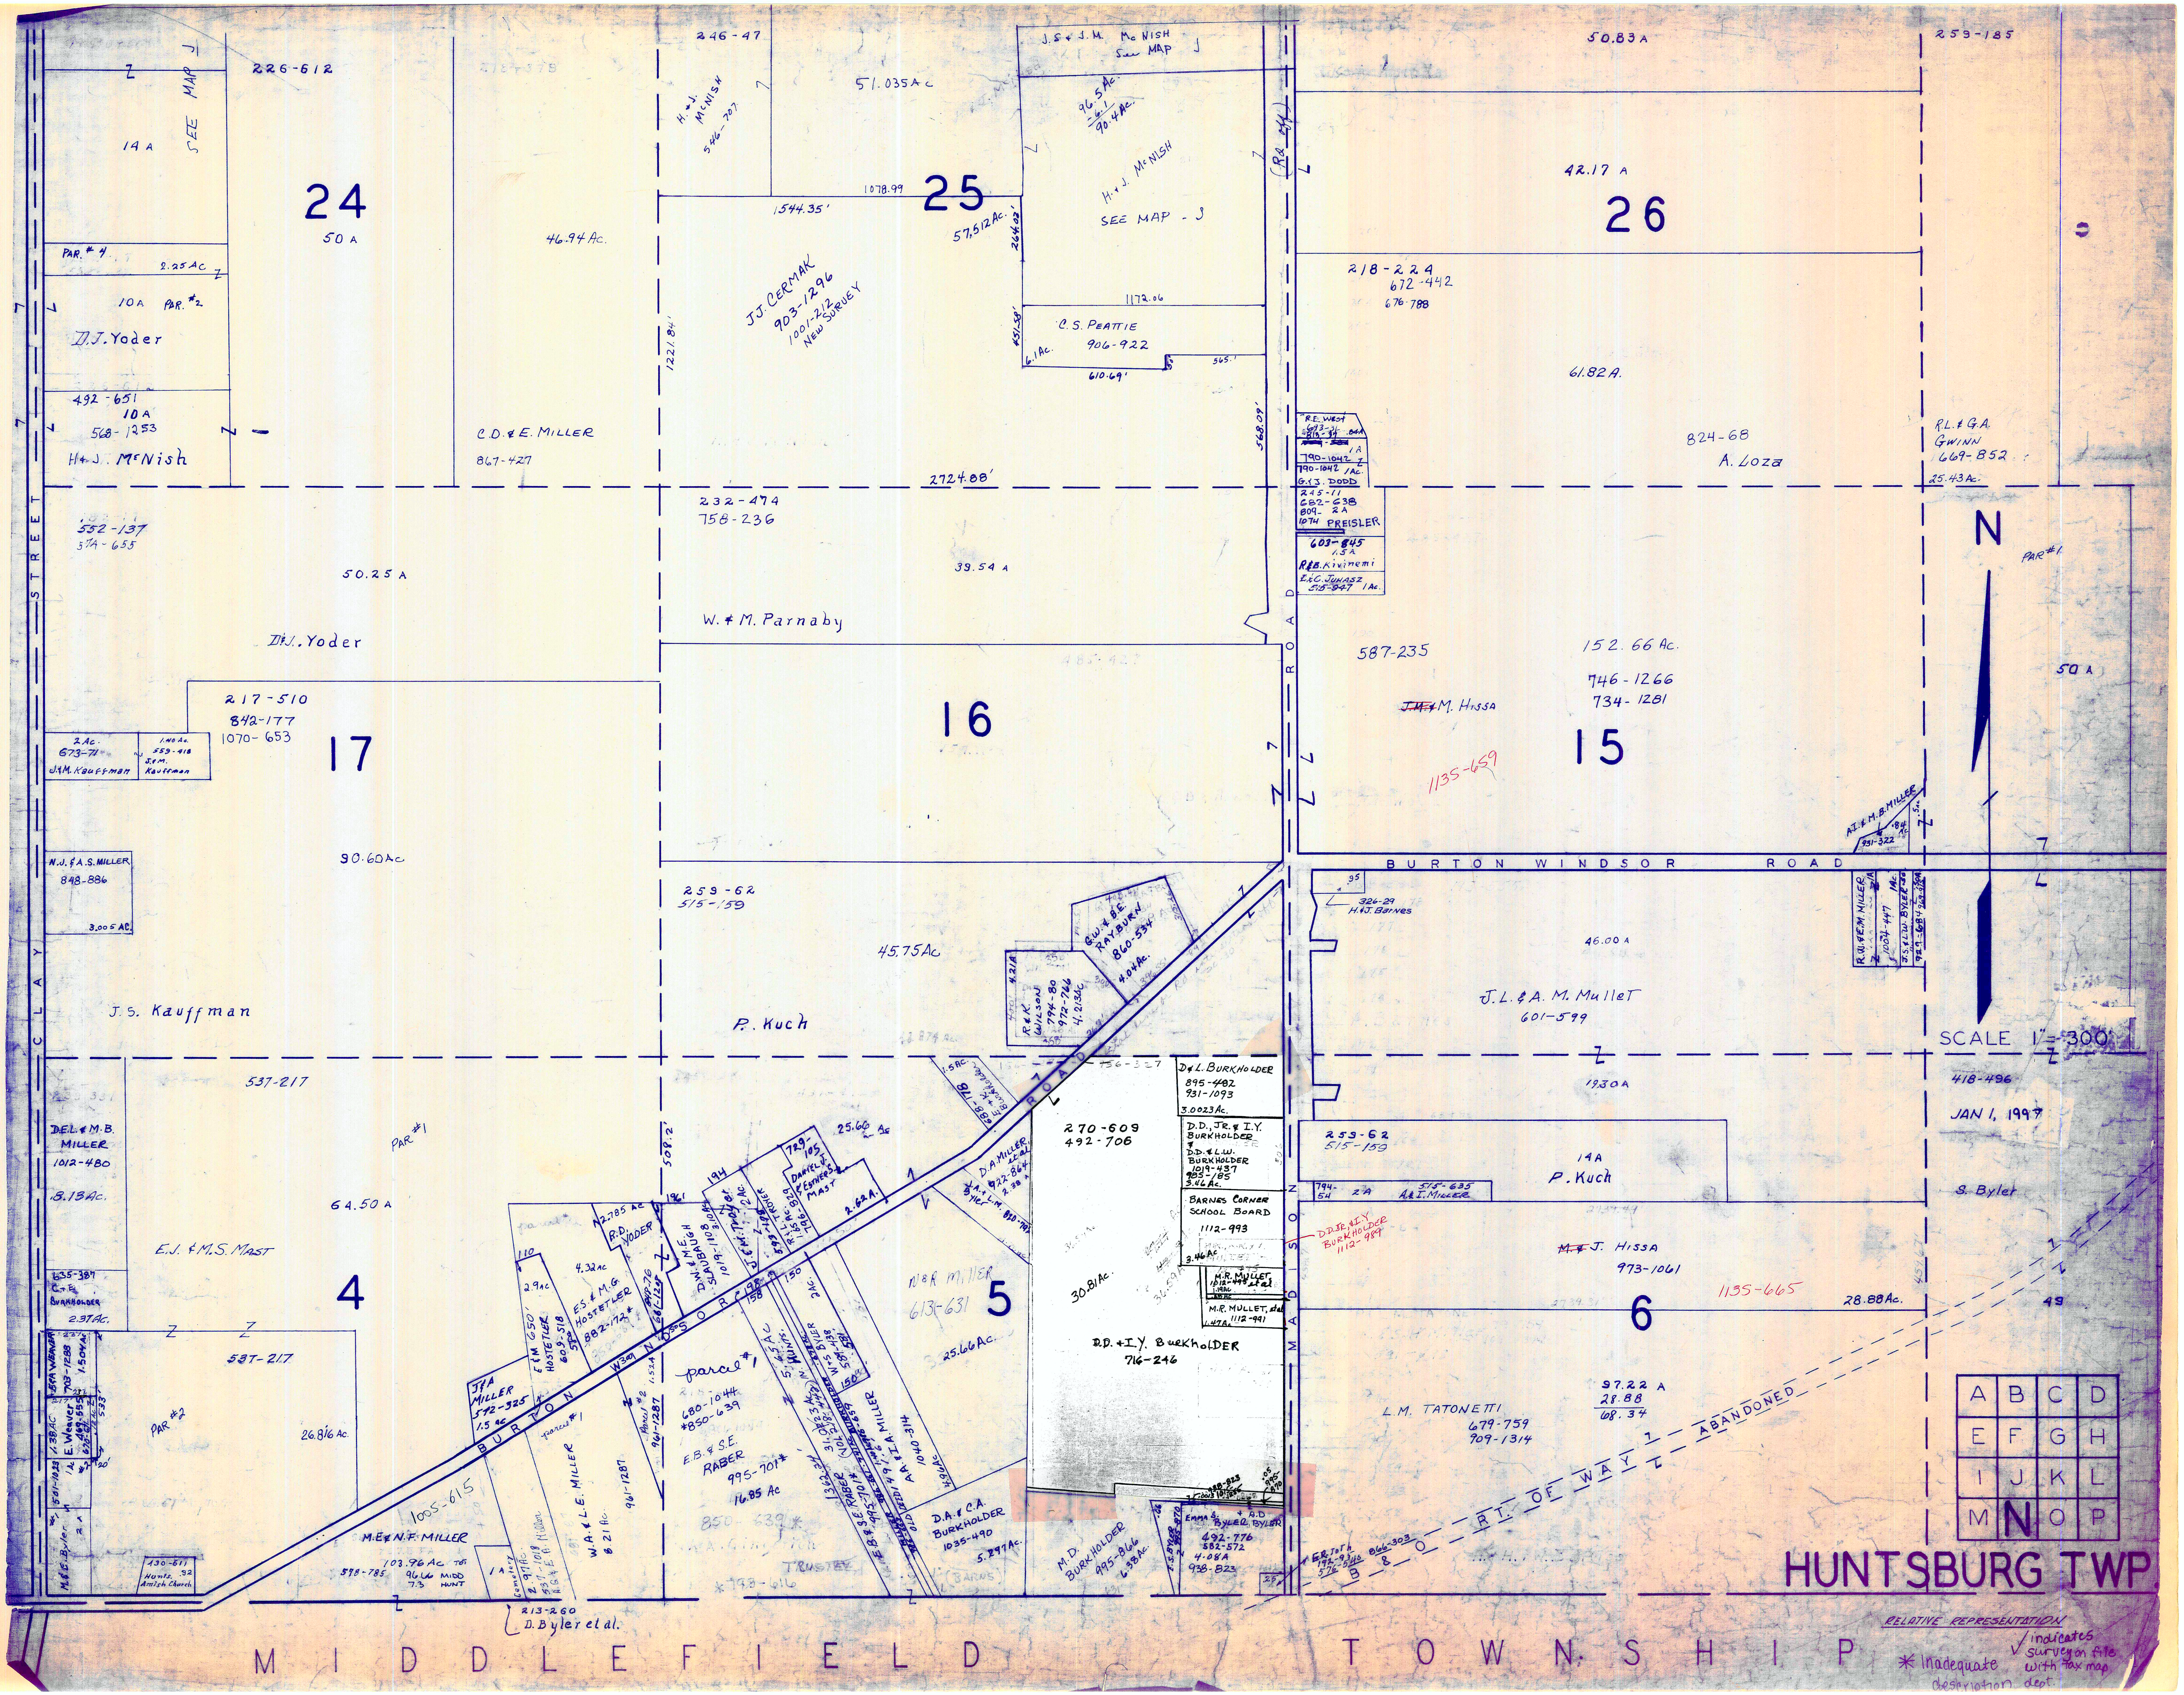
HUNTSBURG TWP.
RELATIVE REPRESENTATION
√ indicates survey on file with tax map
* Inadequate description deed
SCALE 1" = 300'
418-496
JAN 1, 1997
N
A B C D
E F G H
I J K L
M N O P
MIDDLEFIELD TOWNSHIP
CLAY STREET
MADISON ROAD
BURTON WINDSOR ROAD
BURTON WINDSOR ROAD
B & O RT. OF WAY ABANDONED
24
25
26
17
16
15
4
5
6
226-612
SEE MAP J
14 A
50 A
46.94 Ac.
PAR. #4
2.25 Ac
10 A
PAR. #2
D.J. Yoder
492-651
10 A
568-1253
H & J. McNish
C.D. & E. MILLER
867-427
246-47
H & J. McNISH
546-707
J.S. & J.M. McNISH
See MAP J
51.035 Ac
96.5 Ac.
-6.1
90.4 Ac.
H & J. McNISH
SEE MAP - J
1078.99
1544.35'
57.512 Ac.
264.02
J.J. CERMAK
903-1296
1001-212
NEW SURVEY
1221.84'
1172.06
C.S. PEATTIE
906-922
6.1 Ac.
451.58'
610.69'
565.
568.09'
50.83 A
259-185
42.17 A
218-224
672-442
676-788
61.82 A.
R.E. West
790-1042
G.I.S. DODD
682-638
PREISLER
603-845
R & B. Kivinemi
E & C. Juhasz
515-847
824-68
A. Loza
R.L. & G.A. GWINN
669-852
25.43 Ac.
2724.88'
552-137
50.25 A
D & J. Yoder
232-474
758-236
39.54 A
W. & M. Parnaby
587-235
152.66 Ac.
746-1266
734-1281
~~J.M.~~ & M. Hissa
1135-659
PAR. #1
50 A
217-510
842-177
1070-653
2 Ac.
673-71
J & M. Kauffman
D. & M. Kauffman
90.60 Ac
N.J. & A.S. MILLER
848-886
3.005 Ac.
J.S. Kauffman
259-62
515-159
45.75 Ac
P. Kuch
R & K WILSON
794-80
G.W. & B.E. RAYBURN
860-534
326-29
H & J. Barnes
46.00 A
J.L. & A.M. Mullet
601-599
R.W. & E.M. MILLER
A.J. & H.B. MILLER
931-322
J.S. & L.W. BYLER
537-217
DEL & M.B. MILLER
1012-480
8.13 Ac.
PAR #1
64.50 A
E.J. & M.S. MAST
635-387
C.E. BURKHOLDER
2.37 Ac.
537-217
PAR #2
26.816 Ac.
130-611
Hunts. Amish Church
M.E. & N.F. MILLER
598-785
103.96 Ac.
96.66 MIDD
7.3 HUNT
1005-615
1 A
213-260
D. Byler et al.
J.F. & A MILLER
592-325
E & M. HOSTETLER
609-518
E.S. & M.G. HOSTETLER
882-172*
R.D. YODER
D.W. & M.E. SLAUBAUGH
DANIEL & ESTHER MAST
W.A. & L.E. MILLER
8.21 Ac.
961-1287
parcel #1
680-1044
*850-639
E.B. & S.E. RABER
995-701*
16.85 Ac
A.A. & I.A. MILLER
1040-314
TRUSTEE
25.66 Ac
2.62 A
D.A. MILLER
N & R MILLER
613-631
25.66 Ac.
270-609
492-706
30.81 Ac.
D.D. & I.Y. BURKHOLDER
716-246
D & L. BURKHOLDER
895-492
931-1093
3.0023 Ac.
D.D., JR. & I.Y. BURKHOLDER
D. & L.W. BURKHOLDER
1019-437
BARNES CORNER SCHOOL BOARD
1112-993
M.R. MULLET
M.R. MULLET, et al
1112-991
D.D. & I.Y. BURKHOLDER
1112-989
D.A. & C.A. BURKHOLDER
1035-490
5.277 Ac.
M.D. BURKHOLDER
995-866
A.D. BYLER
492-776
582-572
4.08 A
938-823
1230 A
259-62
515-159
14 A
P. Kuch
S. Byler
~~M.~~ & J. HISSA
973-1061
1135-665
28.88 Ac.
L.M. TATONETTI
679-759
909-1314
97.22 A
28.88
68.34
49

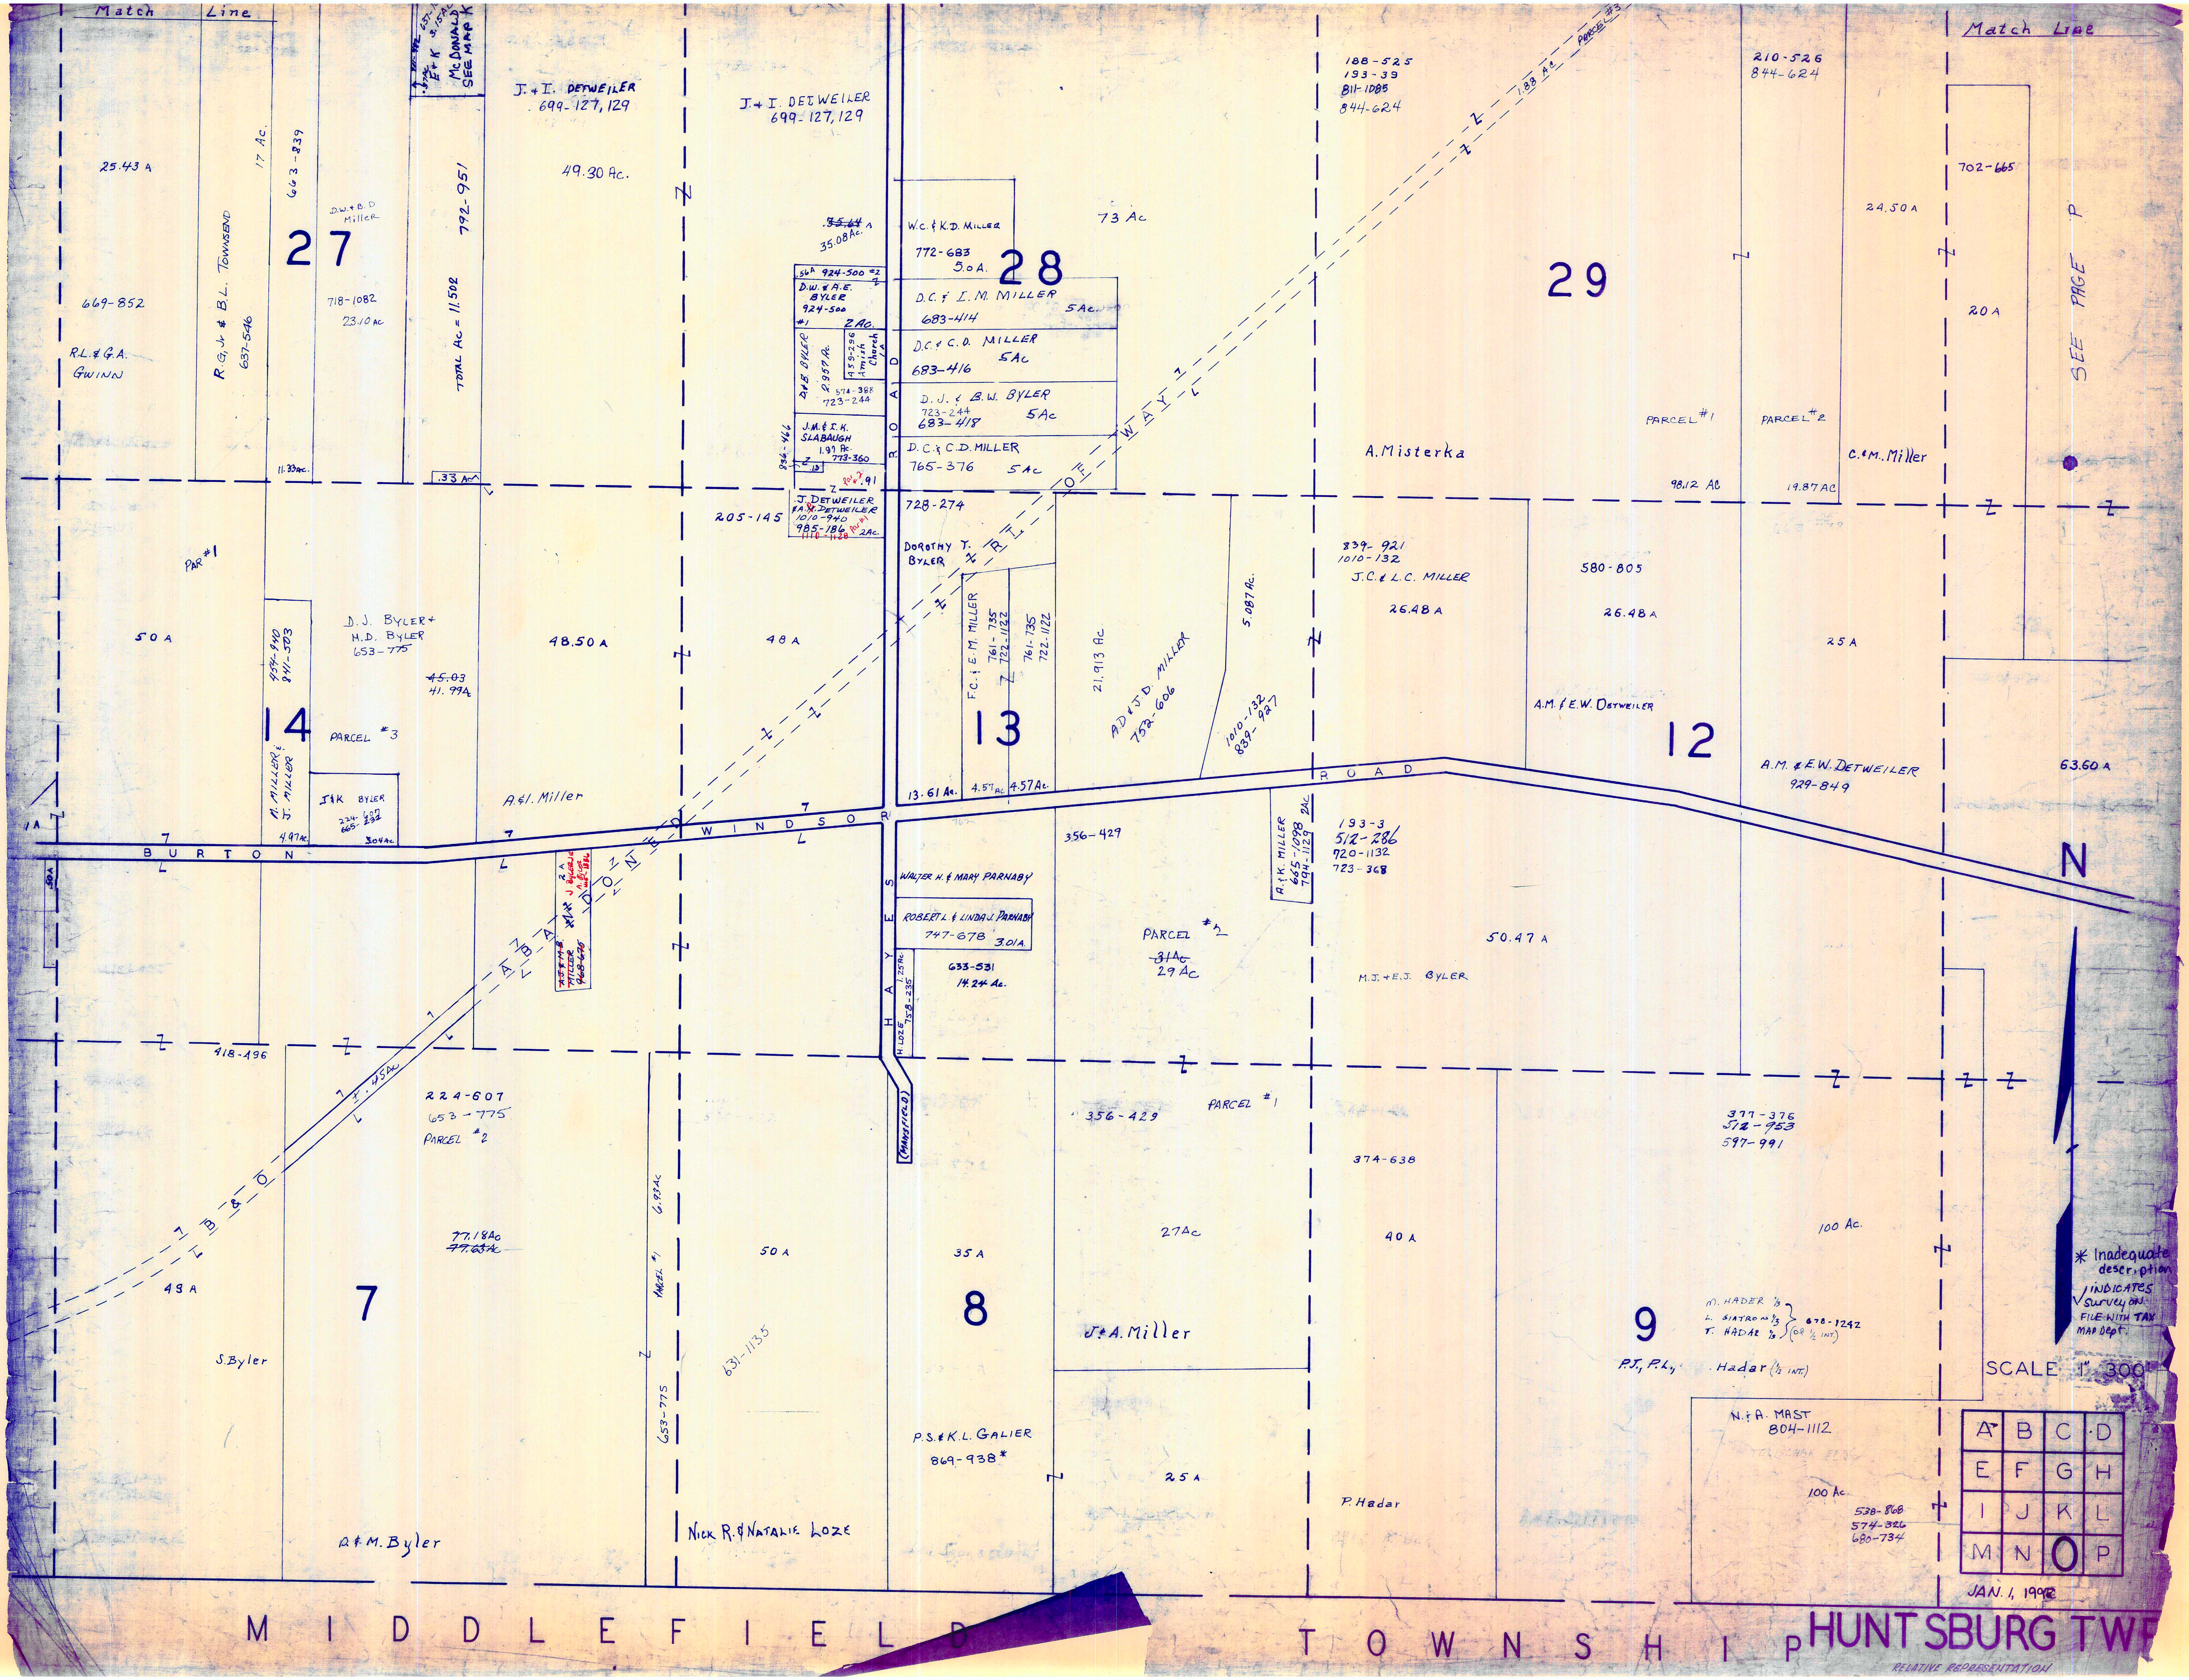
Match Line
25.43 A
669-852
R.L. & G.A. GWINN
R.G., Jr & B.L. TOWNSEND
637-546
17 Ac.
663-839
27
D.W. + B.D Miller
718-1082
23.10 Ac
11.33 Ac.
.37 Ac 571-872 E+K 3.15 Ac McDONALD SEE MAP K
TOTAL Ac = 11.502
792-951
.33 Ac
J. + I. DETWEILER
699-127,129
49.30 Ac.
J. + I. DETWEILER
699-127,129
~~35.64~~ A
35.08 Ac.
.56A 924-500 #2
D.W. & A.E. BYLER
924-500
#1
2 Ac.
D & B. BYLER
2.957 Ac.
574-388
723-244
459-296 Amish Church 1 A
J.M. & I.K. SLABAUGH
1.97 Ac.
773-360
836-466
.13
Par #2
.91
J. DETWEILER & A.K. DETWEILER
1010-940
985-186
1110-1128
Par #1
2 Ac.
205-145
W.C. & K.D. MILLER
772-683
5.0 A.
28
73 Ac
D.C. & I.M. MILLER
683-414
5 Ac.
D.C. & C.D. MILLER
683-416
5 Ac
D.J. & B.W. BYLER
723-244
683-418
5 Ac
D.C. & C.D. MILLER
765-376
5 Ac
ROAD
728-274
RIGHT OF WAY
188-525
193-39
811-1085
844-624
1.88 Ac
PARCEL #3
29
A. Misterka
PARCEL #1
98.12 AC
210-526
844-624
PARCEL #2
19.87 AC
24.50 A
C. & M. Miller
702-665
20 A
SEE PAGE P
Match Line
PAR #1
50 A
454-940
841-503
D.J. BYLER + H.D. BYLER
653-775
~~45.03~~
41.99 Ac
14
PARCEL #3
A. MILLER & J. MILLER
4.97 Ac.
J & K BYLER
224-607
665-232
3.04 Ac.
48.50 A
A. & I. Miller
48 A
DOROTHY Y. BYLER
F.C. & E.M. MILLER
761-735
722-1122
761-735
722-1122
13
13.61 Ac.
4.57 Ac
4.57 Ac.
21.913 Ac
A.D. & J.D. MILLER
752-606
5.087 Ac.
1010-132
839-927
839-921
1010-132
J.C. & L.C. MILLER
26.48 A
580-805
26.48 A
A.M. & E.W. DETWEILER
12
A.M. & E.W. DETWEILER
929-849
25 A
63.60 A
1 A
50 A
BURTON
WINDSOR
ROAD
ABANDONED
A.J. & M.B. MILLER
768-675
2 A
J. BYLER Jr
A. BYLER
1115-1356
HAYES
WALTER H. & MARY PARNABY
ROBERT L. & LINDA J. PARNABY
747-678
3.01 A.
633-531
14.24 Ac.
H. LOZE
758-235
1.25 Ac.
(MANSFIELD)
356-429
PARCEL #2
~~31 Ac~~
29 Ac
A. & K. MILLER
665-1098
794-1129
2 Ac
193-3
512-286
720-1132
723-368
50.47 A
M.J. + E.J. BYLER
N
418-496
224-607
653-775
PARCEL #2
.45 Ac
B & O
49 A
S. Byler
7
77.18 Ac
~~77.63 Ac~~
PARCEL #1
6.93 Ac
653-775
631-1135
50 A
Q. & M. Byler
Nick R. & Natalie Loze
35 A
8
P.S. & K.L. GALIER
869-938*
356-429
PARCEL #1
27 Ac
J. & A. Miller
25 A
374-638
40 A
P. Hadar
377-376
512-953
597-991
100 Ac.
9
M. HADER 1/3
L. GIATRON 1/3
T. HADAR 1/3
678-1242
(of 1/2 INT.)
P.J., P.L., Hadar (1/2 INT.)
N. & A. MAST
804-1112
100 Ac.
538-868
574-326
680-734
* Inadequate description
√ INDICATES survey ON FILE WITH TAX MAP Dept.
SCALE 1" 300
A B C D
E F G H
I J K L
M N O P
JAN. 1, 1998
MIDDLEFIELD TOWNSHIP
HUNTSBURG TWP
RELATIVE REPRESENTATION

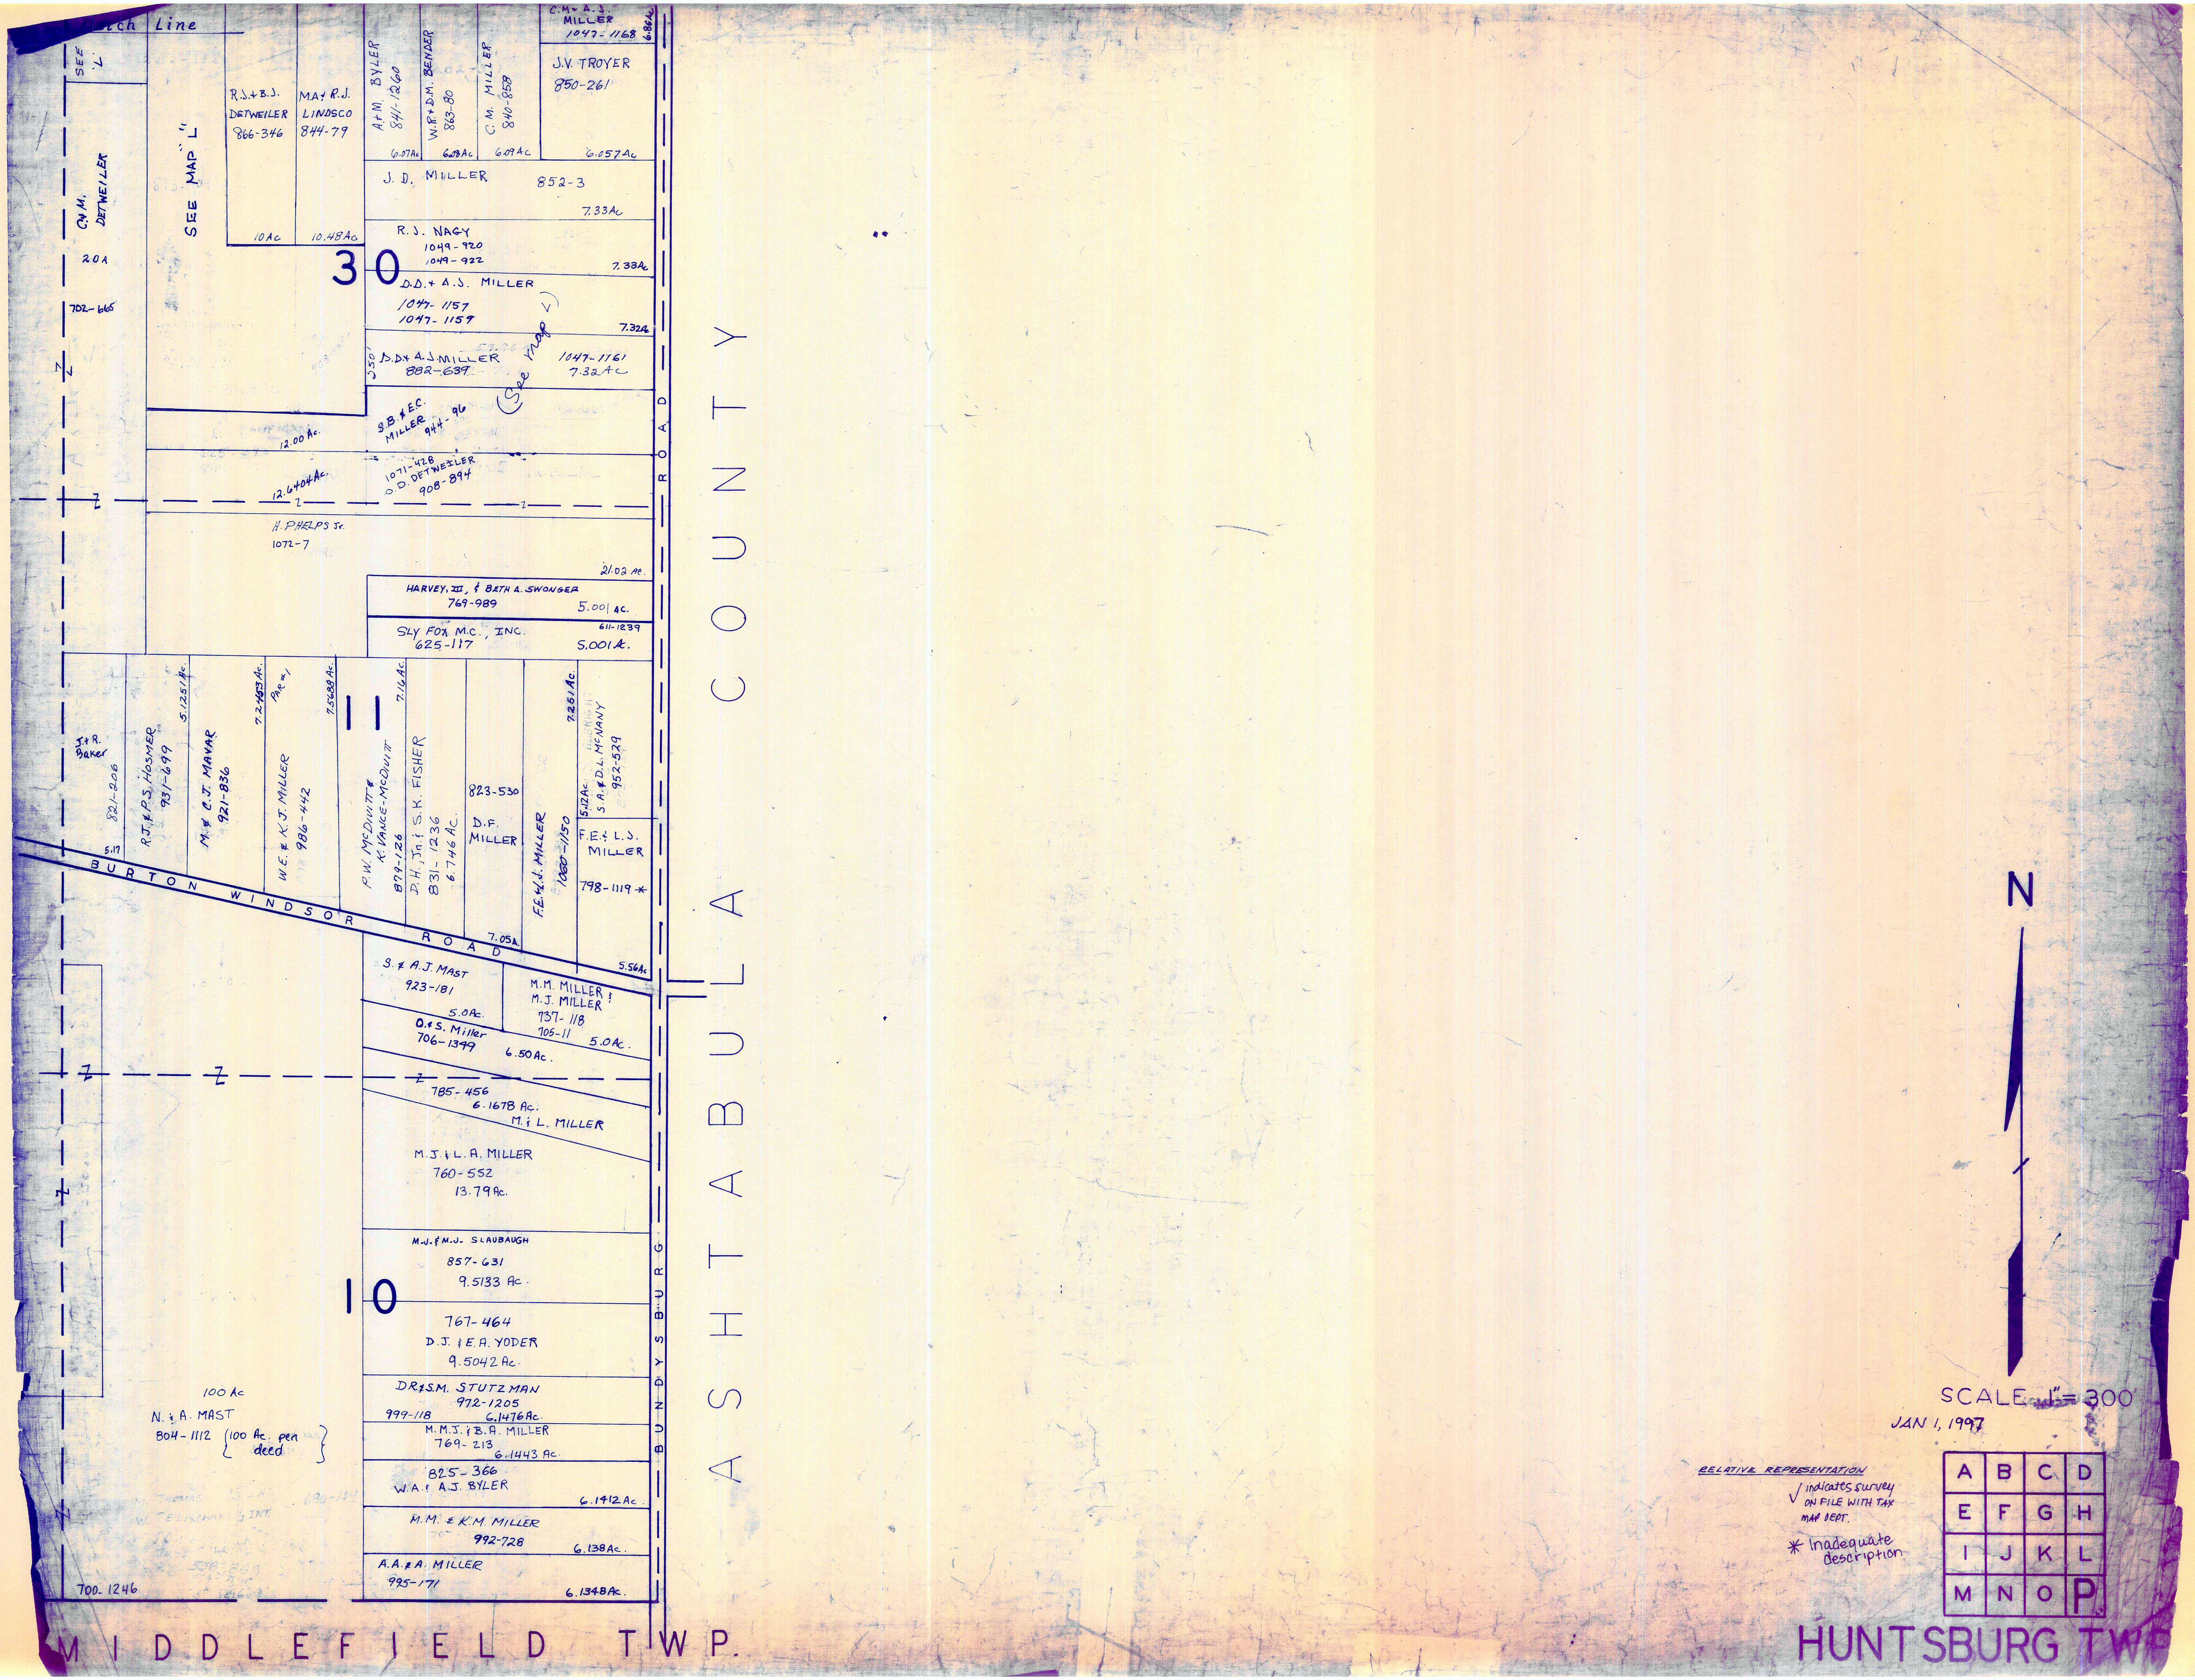
Match Line
SEE 'L'
SEE MAP "L"
C.+M. DETWEILER
20A
702-665
R.J.+B.J. DETWEILER 866-346
10Ac
M.A.+R.J. LINDSCO 844-79
10.48Ac
A.+M. BYLER 841-1260
6.07Ac
W.R.+D.M. BENDER 863-80
6.08Ac
C.M. MILLER 840-858
6.09Ac
C.M.+A.J. MILLER 1047-1168
6.86Ac
J.V. TROYER 850-261
6.057Ac
J.D. MILLER 852-3
7.33Ac
R.J. NAGY 1049-920 1049-922
7.33Ac
30
D.D.+A.J. MILLER 1047-1157 1047-1159
7.32Ac
(See map L)
350'
D.D.+A.J. MILLER 882-639
1047-1161 7.32Ac
S.B.+E.C. MILLER 944-96
12.00Ac.
1071-428
O.D. DETWEILER 908-894
12.6404Ac.
H. PHELPS Jr. 1072-7
21.02Ac.
HARVEY, III, & BETH A. SWONGER 769-989
5.001Ac.
SLY FOX M.C., INC. 625-117
611-1239
5.001Ac.
J.+R. Baker 821-206
5.17
R.J.+P.S. HOSMER 931-699
5.1251Ac.
M.+C.J. MAVAR 921-836
7.2453Ac.
PAR #1
W.E.+K.J. MILLER 986-442
7.5688Ac.
11
P.W. McDIVITT & K. VANCE-McDIVITT 879-126
7.16Ac.
D.H. Jr. & S.K. FISHER 831-1236 6.746Ac.
823-530
D.F. MILLER
7.05A.
F.E.+L.J. MILLER 1060-1150
7.251Ac.
5.12Ac.
S.A.+D.L. McNANY 952-529
F.E.+L.J. MILLER
798-1119 *
5.56Ac.
BURTON WINDSOR ROAD
S.+A.J. MAST 923-181
5.0Ac.
M.M. MILLER & M.J. MILLER 737-118
705-11
5.0Ac.
O.+S. Miller 706-1349
6.50Ac.
785-456
6.1678Ac.
M.+L. MILLER
M.J.+L.A. MILLER 760-552
13.79Ac.
M.J.+M.J. SLAUBAUGH 857-631
9.5133Ac.
10
767-464
D.J.+E.A. YODER
9.5042Ac.
DR+S.M. STUTZMAN 972-1205
999-118
6.1476Ac.
M.M.J.+B.A. MILLER 769-213
6.1443Ac.
825-366
W.A.+A.J. BYLER
6.1412Ac.
M.M.+K.M. MILLER 992-728
6.138Ac.
A.A.+A. MILLER 995-171
6.1348Ac.
100 Ac
N.+A. MAST 804-1112
(100 Ac. per deed)
700-1246
Z
BUNDYSBURG ROAD
ASHTABULA COUNTY
MIDDLEFIELD TWP.
N
SCALE 1" = 300'
JAN 1, 1997
RELATIVE REPRESENTATION
√ indicates survey ON FILE WITH TAX MAP DEPT.
* Inadequate description
A B C D
E F G H
I J K L
M N O P
HUNTSBURG TWP

HUNTSBURG TP.

CENTER

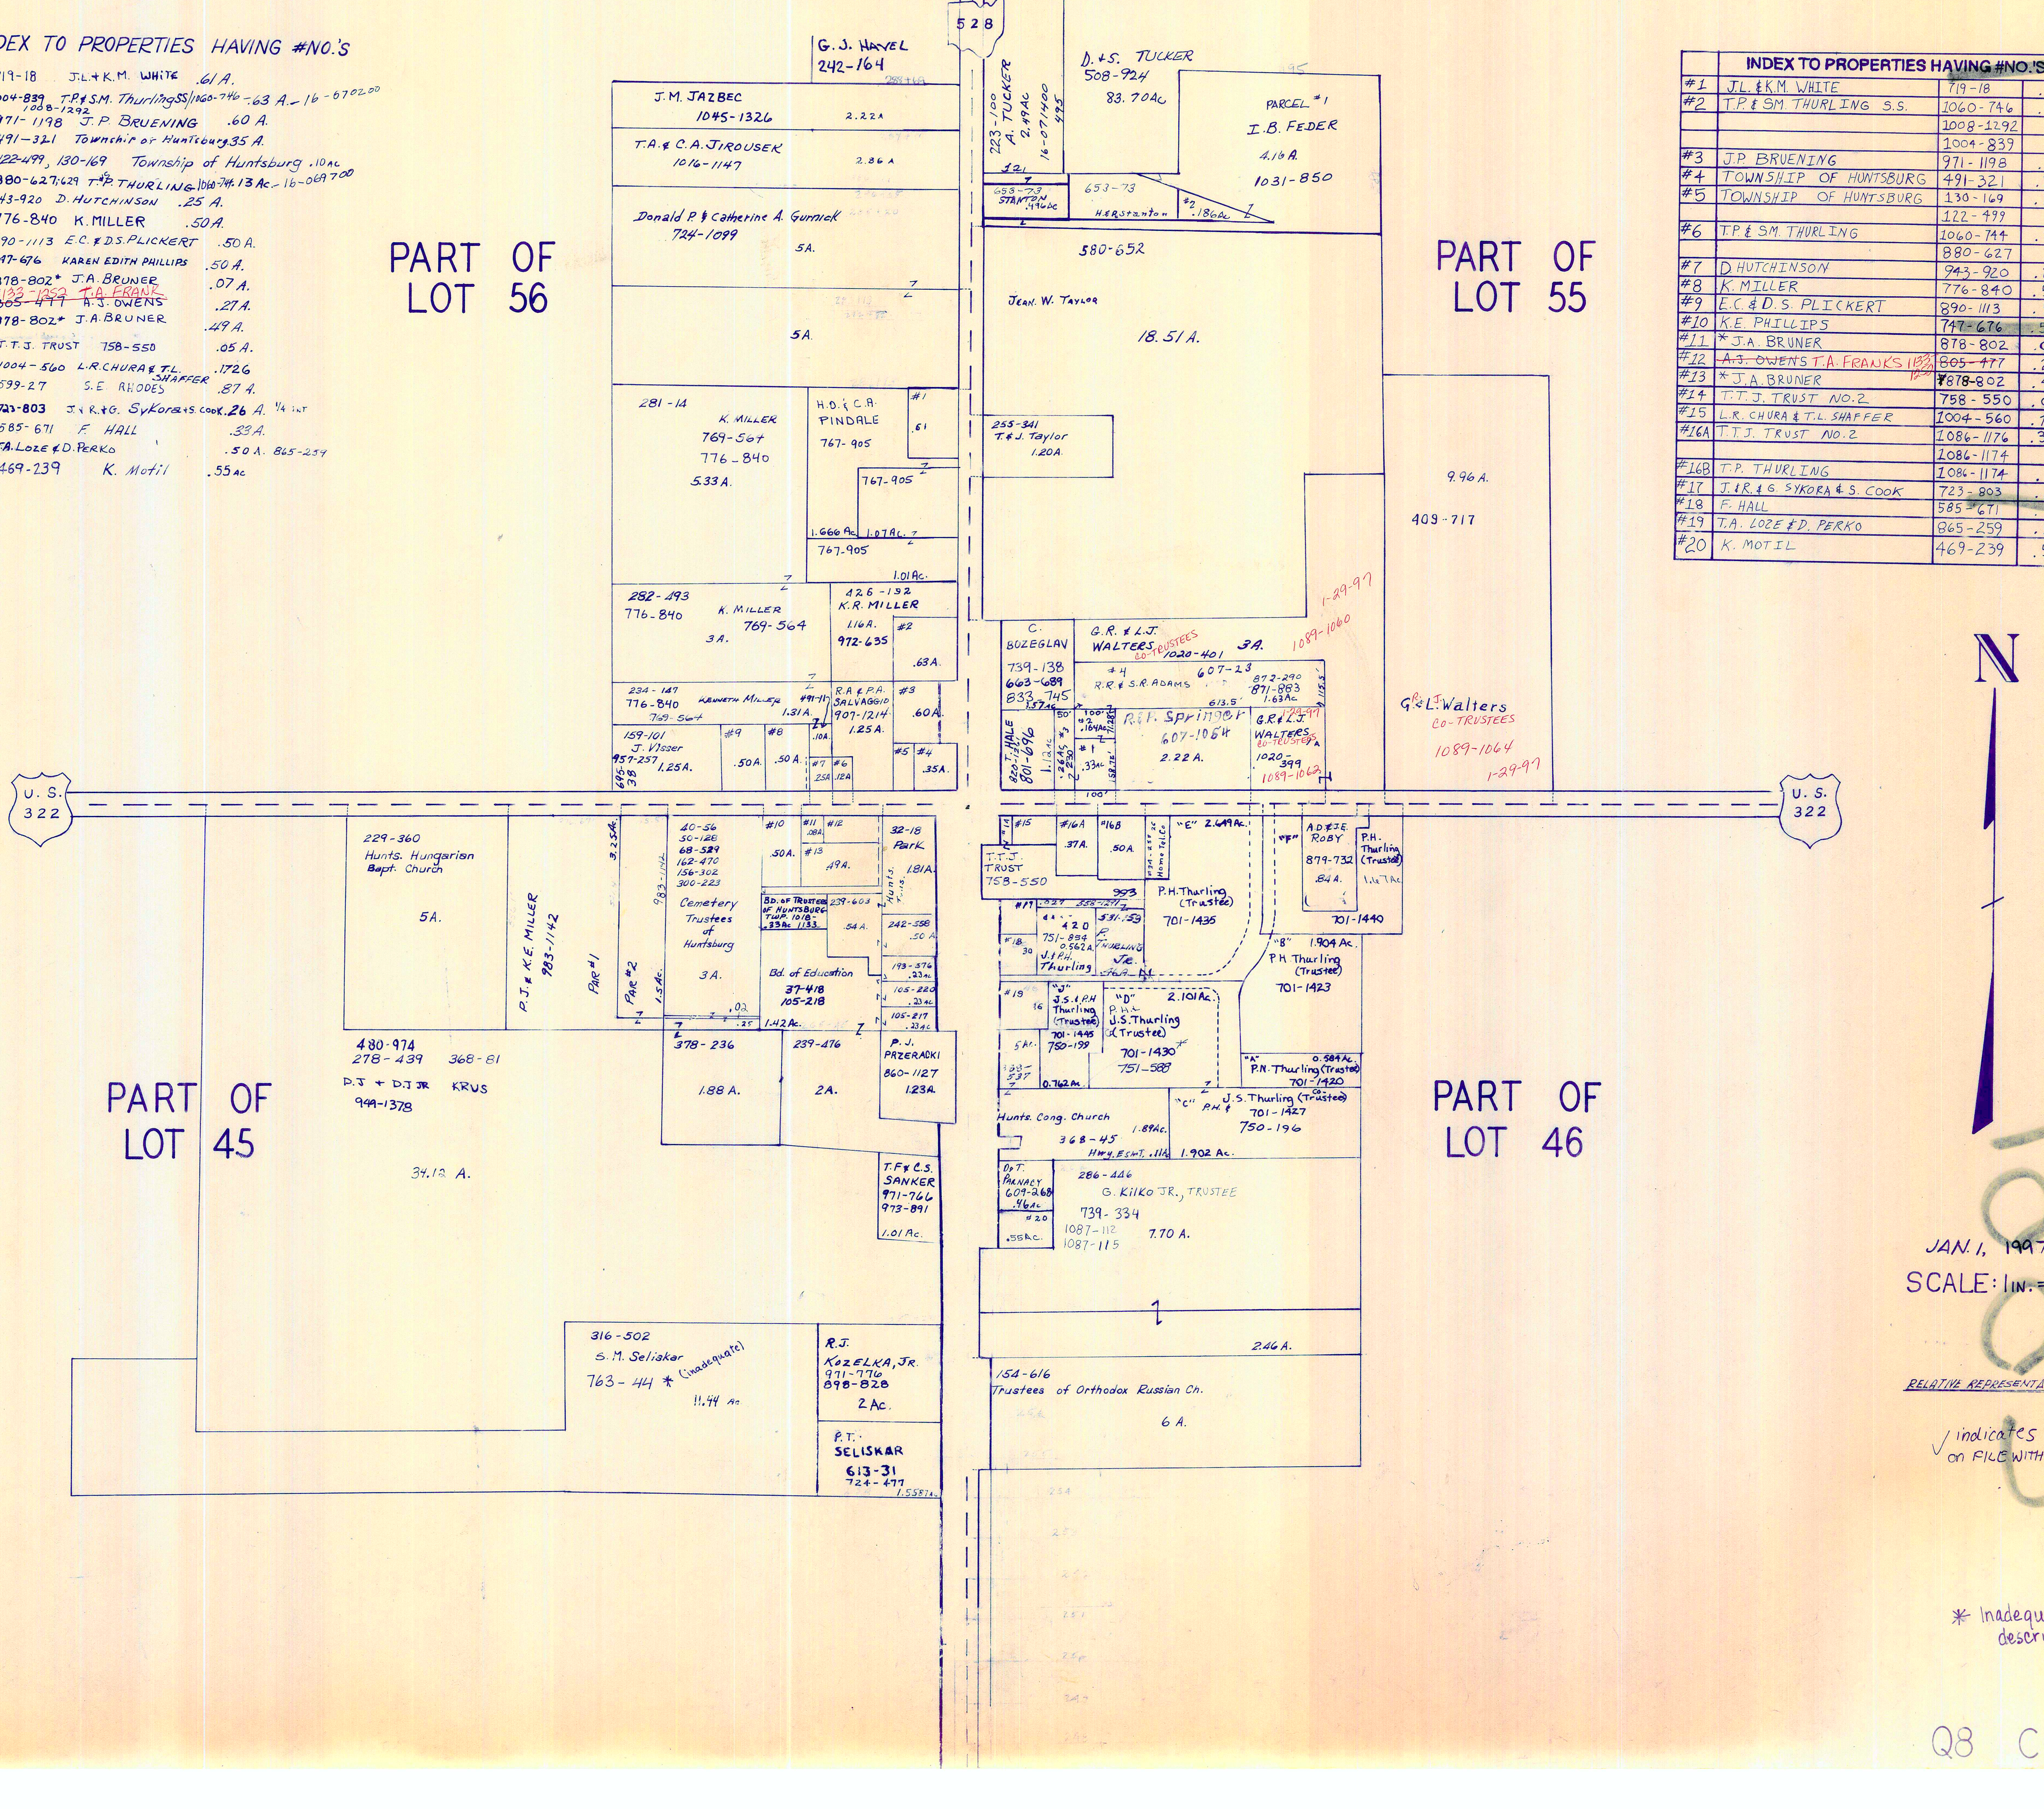

528
G. J. HAVEL 242-164
J.M. JAZBEC 1045-1326 2.22A
T.A.& C.A. JIROUSEK 1016-1147 2.86A
Donald P & Catherine A. Gurnick 724-1099 5A.
5A.
PART OF LOT 56
PART OF LOT 55
PART OF LOT 45
PART OF LOT 46
223-100 A. TUCKER 2.49AC 16-071400 495
D.+S. TUCKER 508-924 83.70AC
PARCEL #1 I.B. FEDER 4.16A. 1031-850
653-73 H.ERSTANTON #2 .186AC
580-652
Jean W. Taylor 18.51A.
255-341 T.& J. Taylor 1.20A
9.96A. 409-717
281-14 K. MILLER 769-564 776-840 5.33A.
H.O. & C.A. PINDALE 767-905
767-905
1.666AC 1.07AC
1.01AC
282-193 776-840 K. MILLER 769-564 3A.
426-192 K.R. MILLER 1.16A. 972-635
234-147 776-840 Kenneth Miller 769-564
159-101 J. Visser 957-257 1.25A.
R.A & P.A. SALVAGGIO 907-1214 1.25A.
C. BOZEGLAV 739-138 663-689 833-745
G.R. & L.J. WALTERS CO-TRUSTEES 1020-401 3A. 1089-1060 1-29-97
R.R. & S.R. ADAMS 607-23
R.&I. Springer 607-1064 2.22A.
G.R. & L.J. WALTERS CO-TRUSTEES 1020-399 1089-1062
872-290 871-883 1.63AC
T. HALE 801-696
G&L Walters CO-TRUSTEES 1089-1064 1-29-97
U.S. 322
U.S. 322
229-360 Hunts. Hungarian Bapt. Church 5A.
P.J. & K.E. MILLER 983-1142
Par #1
Par #2
Cemetery Trustees of Huntsburg 3A.
Bd. of Trustees of Huntsburg Twp.
Bd. of Education 37-418 105-218 1.42AC.
32-18 Park 1.81A.
480-974 278-439 368-81 D.J. + D.J. JR KRUS 999-1378
34.12 A.
378-236 1.88 A.
239-476 2A.
P.J. PRZERACKI 860-1127 1.23A.
T.F. & C.S. SANKER 971-766 973-891 1.01AC.
316-502 S.M. Seliskar 763-44 * (inadequate) 11.44 AC
R.J. KOZELKA, JR. 971-776 898-828 2AC.
P.T. SELISKAR 613-31 724-477
T.T.J. TRUST 758-550
ADE & JE ROBY 879-732
P.H. Thurling (Trustee) 701-1435
P.H. Thurling (Trustee) 701-1440
"B" 1.904AC P.H. Thurling (Trustee) 701-1423
"E" 2.649AC
"D" 2.101AC P.H. J.S. Thurling (Trustee) 701-1430 751-588
J.S. & P.H. Thurling (Trustee) 701-1445 750-199
"A" P.N. Thurling (Trustee) 701-1420
"C" J.S. Thurling (Trustee) 701-1427 750-196
Hunts. Cong. Church 368-45 1.89AC.
1.902 AC.
286-446 G. Kilko JR., TRUSTEE 739-334 1087-112 1087-115 7.70 A.
2.46 A.
154-616 Trustees of Orthodox Russian Ch. 6 A.
N

INDEX TO PROPERTIES HAVING #NO.'S

- #1 719-18 J.L.+K.M. WHITE .61 A.
- #2 1004-839 1008-1292 T.P.& S.M. Thurling SS/1060-746 .63 A. – 16-670200
- #3 971-1198 J.P. BRUENING .60 A.
- #4 491-321 Township of Huntsburg .35 A.
- #5 122-499, 130-169 Township of Huntsburg .10 AC
- #6 880-627;629 T.P.& S. THURLING 1060-744 .13 Ac. – 16-069700
- #7 943-920 D. HUTCHINSON .25 A.
- #8 776-840 K. MILLER .50 A.
- #9 890-1113 E.C. & D.S. PLICKERT .50 A.
- #10 747-676 KAREN EDITH PHILLIPS .50 A.
- #11 878-802* J.A. BRUNER .07 A.
- #12 ~~805-477 A.J. OWENS~~ 1133-1252 T.A. FRANK .27 A.
- #13 878-802* J.A. BRUNER .49 A.
- #14 T.T.J. TRUST 758-550 .05 A.
- #15 1004-560 L.R. CHURA & T.L. SHAFFER .1726
- #16 599-27 S.E. RHODES .87 A.
- #17 723-803 J. & R. & G. Sykora & S. Cook .26 A. 1/4 INT
- #18 585-671 F. HALL .33 A.
- #19 T.A. Loze & D. Perko .50 A. 865-259
- #20 469-239 K. Motil .55 AC

	INDEX TO PROPERTIES HAVING #NO.'S		
#1	J.L. & K.M. WHITE	719-18	.61ac
#2	T.P. & S.M. THURLING S.S.	1060-746	.63ac
		1008-1292	
		1004-839	
#3	J.P. BRUENING	971-1198	.60ac
#4	TOWNSHIP OF HUNTSBURG	491-321	.35ac
#5	TOWNSHIP OF HUNTSBURG	130-169	.10ac
		122-499	
#6	T.P. & S.M. THURLING	1060-744	.13ac
		880-627	
#7	D. HUTCHINSON	943-920	.25ac
#8	K. MILLER	776-840	.50ac
#9	E.C. & D.S. PLICKERT	890-1113	.50ac
#10	K.E. PHILLIPS	747-676	.50ac
#11	*J.A. BRUNER	878-802	.07ac
#12	~~A.J. OWENS~~ T.A. FRANKS 1133-1250	~~805-477~~	.27ac
#13	*J.A. BRUNER	*878-802	.49ac
#14	T.T.J. TRUST NO.2	758-550	.05ac
#15	L.R. CHURA & T.L. SHAFFER	1004-560	.17ac
#16A	T.T.J. TRUST NO.2	1086-1176	.37ac
		1086-1174	
#16B	T.P. THURLING	1086-1174	.50ac
#17	J. & R. & G. SYKORA & S. COOK	723-803	.26ac
#18	F. HALL	585-671	.33ac
#19	T.A. LOZE & D. PERKO	865-259	.50ac
#20	K. MOTIL	469-239	.55ac

JAN. 1, 1997

SCALE: 1 IN. = 200'

RELATIVE REPRESENTATION

√ indicates survey on FILE WITH TAX MAP Dept.

* Inadequate description

Q8 CENTER