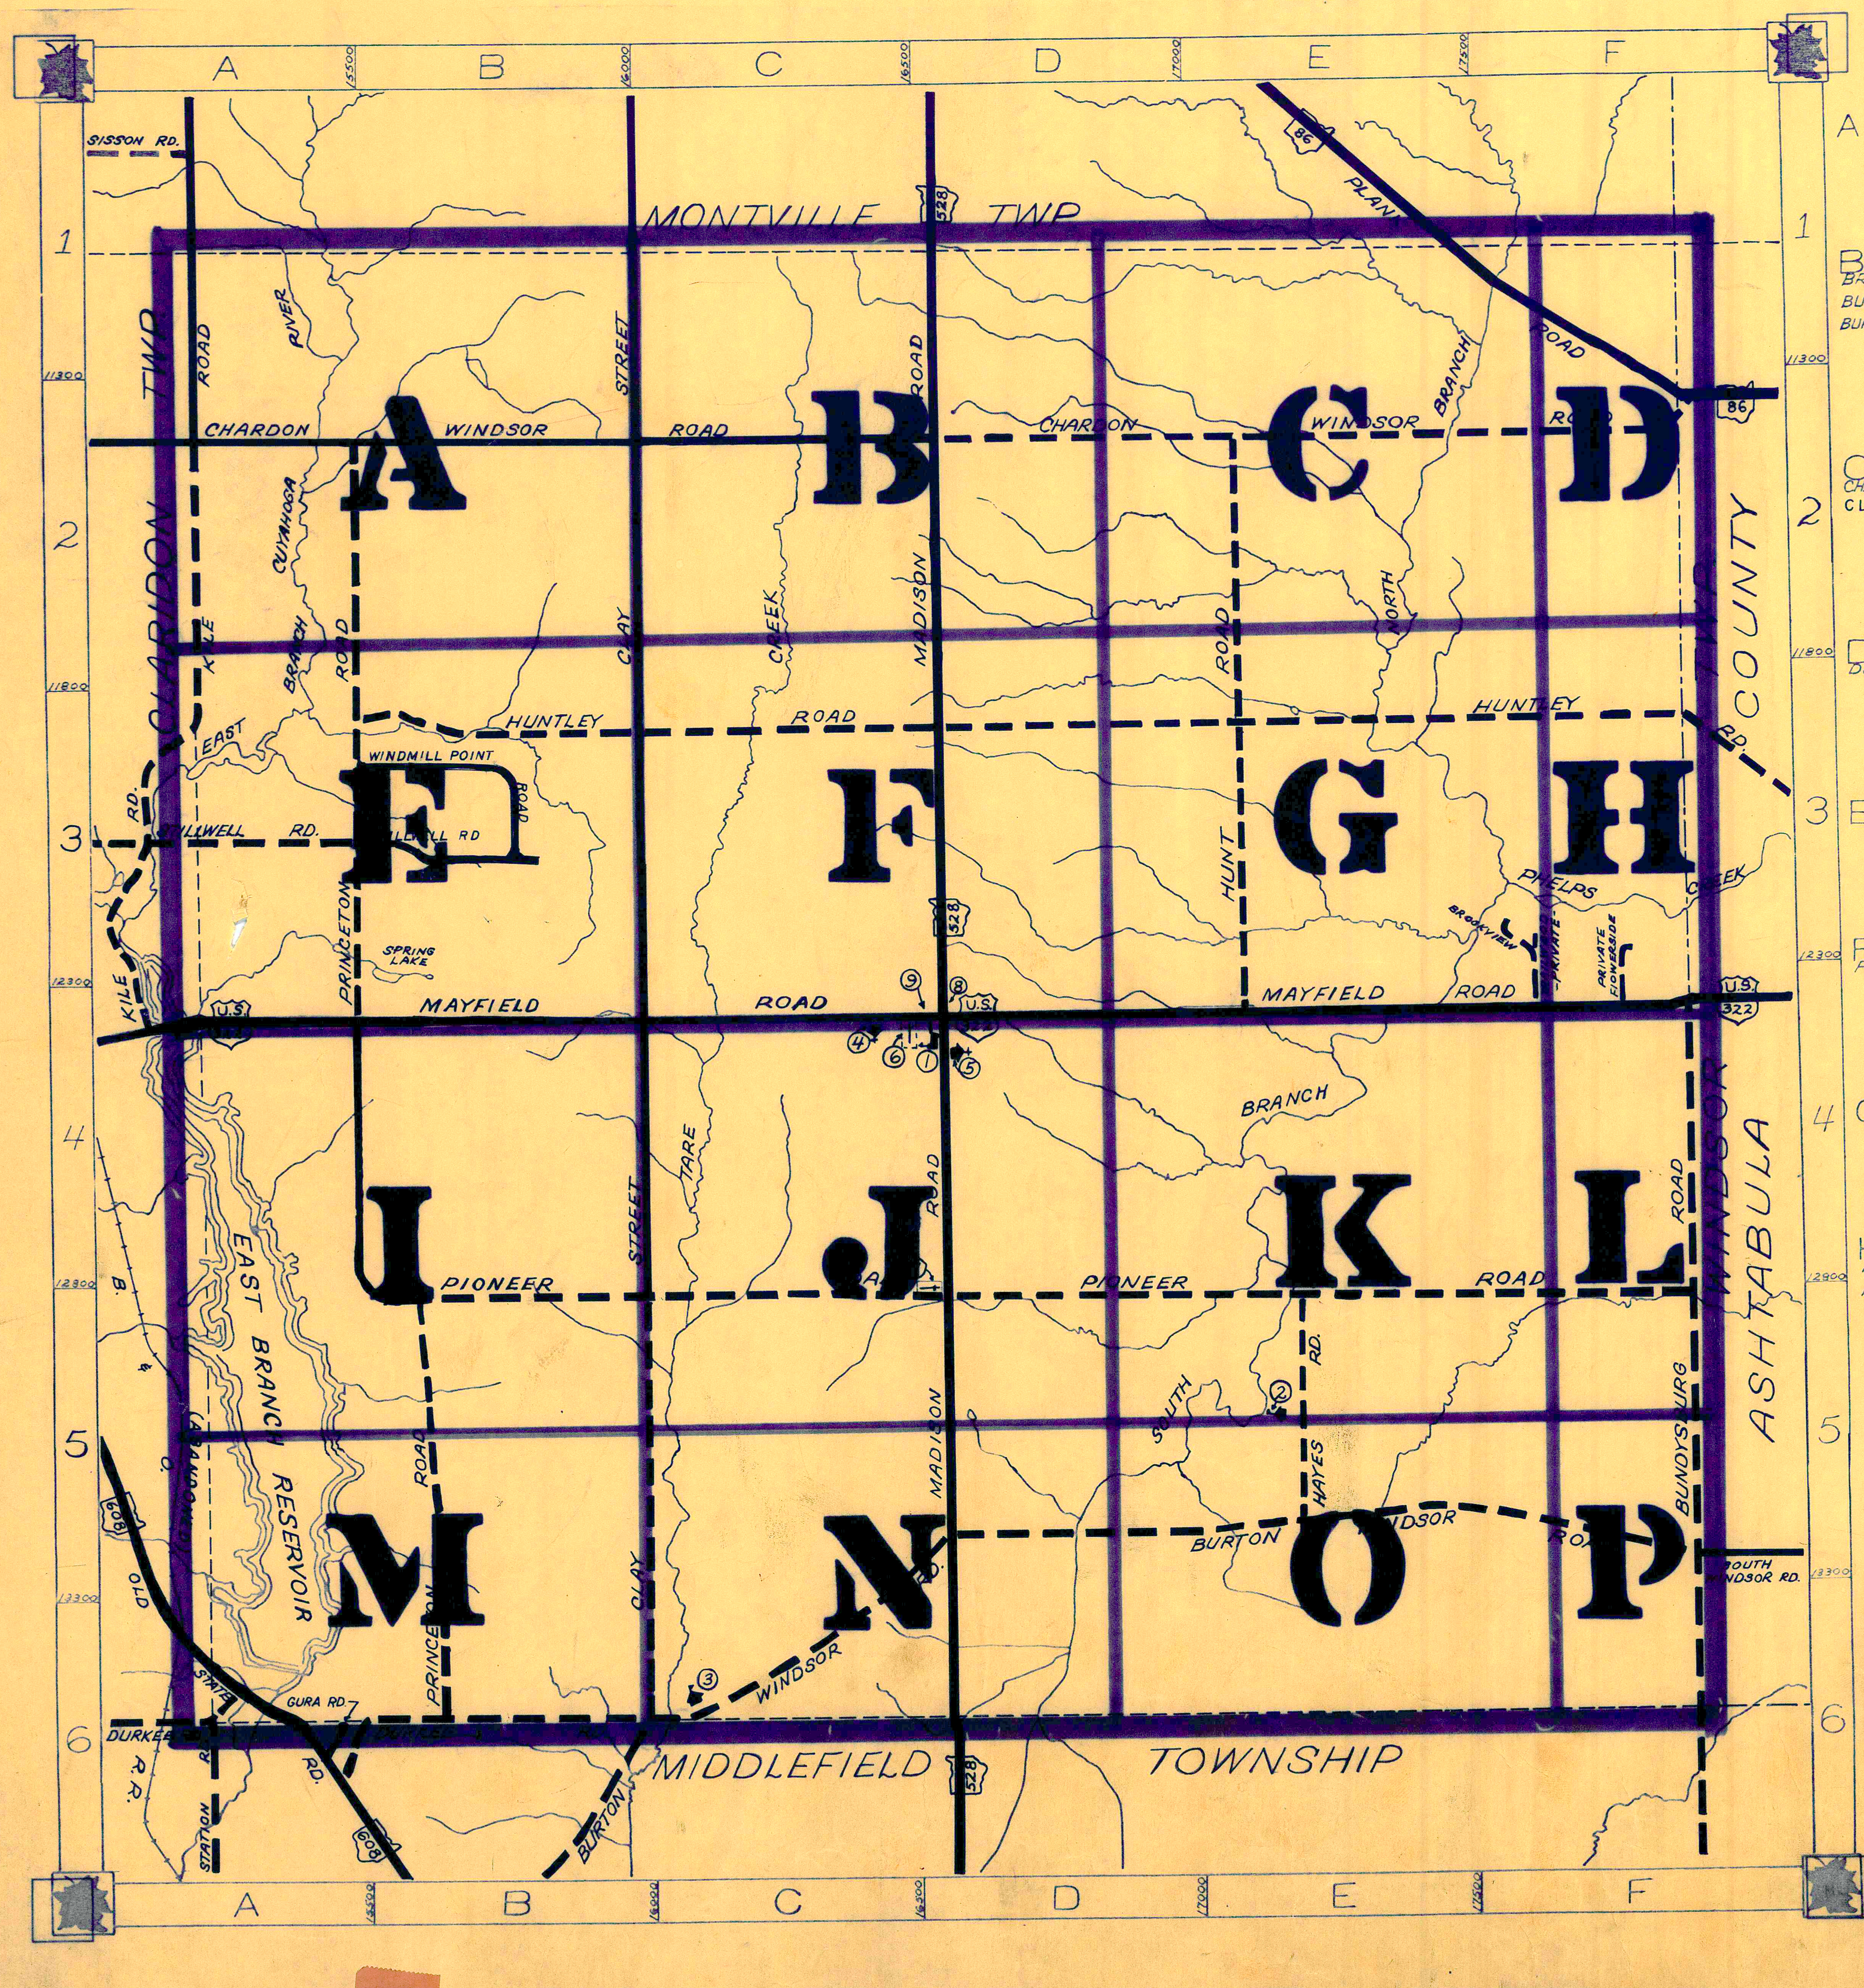
A
B
C
D
E
F
G
H
I
J
K
L
M
N
O
P
1
2
3
4
5
6
MONTVILLE TWP.
MIDDLEFIELD TOWNSHIP
CHARDON TWP.
ASHTABULA COUNTY
SISSON RD.
PLANK ROAD
CHARDON WINDSOR ROAD
HUNTLEY ROAD
WINDMILL POINT
STILLWELL RD.
MAYFIELD ROAD
PIONEER ROAD
BURTON WINDSOR ROAD
SOUTH WINDSOR RD.
KILE ROAD
PRINCETON ROAD
CLAY STREET
MADISON ROAD
HUNT ROAD
HAYES RD.
BUNDYSBURG ROAD
PHELPS CREEK
SPRING LAKE
EAST BRANCH RESERVOIR
CUYAHOGA RIVER
EAST BRANCH
TARE CREEK
NORTH BRANCH
SOUTH BRANCH
BROOKVIEW
PRIVATE
GURA RD.
DURKEE
OLD STATE RD.
B. & O. R.R.
STATION
BURTON
86
528
322
608
11300
11800
12300
12800
13300

ROAD INDEX

A

B
BROOKVIEW RD. (PVT) F3
BUNDYSBURG RD. F4-F6
BURTON WINDSOR RD. C6-F5

C
CHARDON WINDSOR RD. A2-F2
CLAY STREET B1-B6

D
DURKEE RD. A6-B6

E

F
FLOWERSIDE RD. (PVT) F4

G

H
HAYES RD. E5
HUNTLEY RD. B3-F3
HUNT RD. E2-E4

I

J

K
KILE RD. A1-A4

L

M
MADISON RD. D1-D6
MAYFIELD RD. A4-F4

N

O
OLD STATE RD. A6

P
PIONEER RD. B5-F5
PLANK RD. E1-F2
PRINCETON RD. B2-B6

Q

R

S
STILLWELL RD. A3

T
TRAILWOOD RD. (PVT) F4

U

V

W
WINDMILL POINT ROAD B3

X

Y

Z

① HUNTSBURG ELEM. SCHOOL
② AMISH SCHOOL
③ AMISH SCHOOL
④ HUNTSBURG BAPTIST CH.
⑤ HUNTSBURG CONGREGATIONAL CH.
⑥ HUNTSBURG CEMETERY
⑦ HUNTSBURG CEMETERY
⑧ UNITED STATES POST OFFICE
⑨ TOWN HALL
⑩

N

HUNTSBURG TOWNSHIP

0 5 10 15 20

SCALE : 1" = 2000'

ROBERT L. PHILLIPS,
GEAUGA COUNTY ENGINEER

UNPAVED ROADS
PAVED ROADS
TOWNSHIP LINE
COUNTY LINE

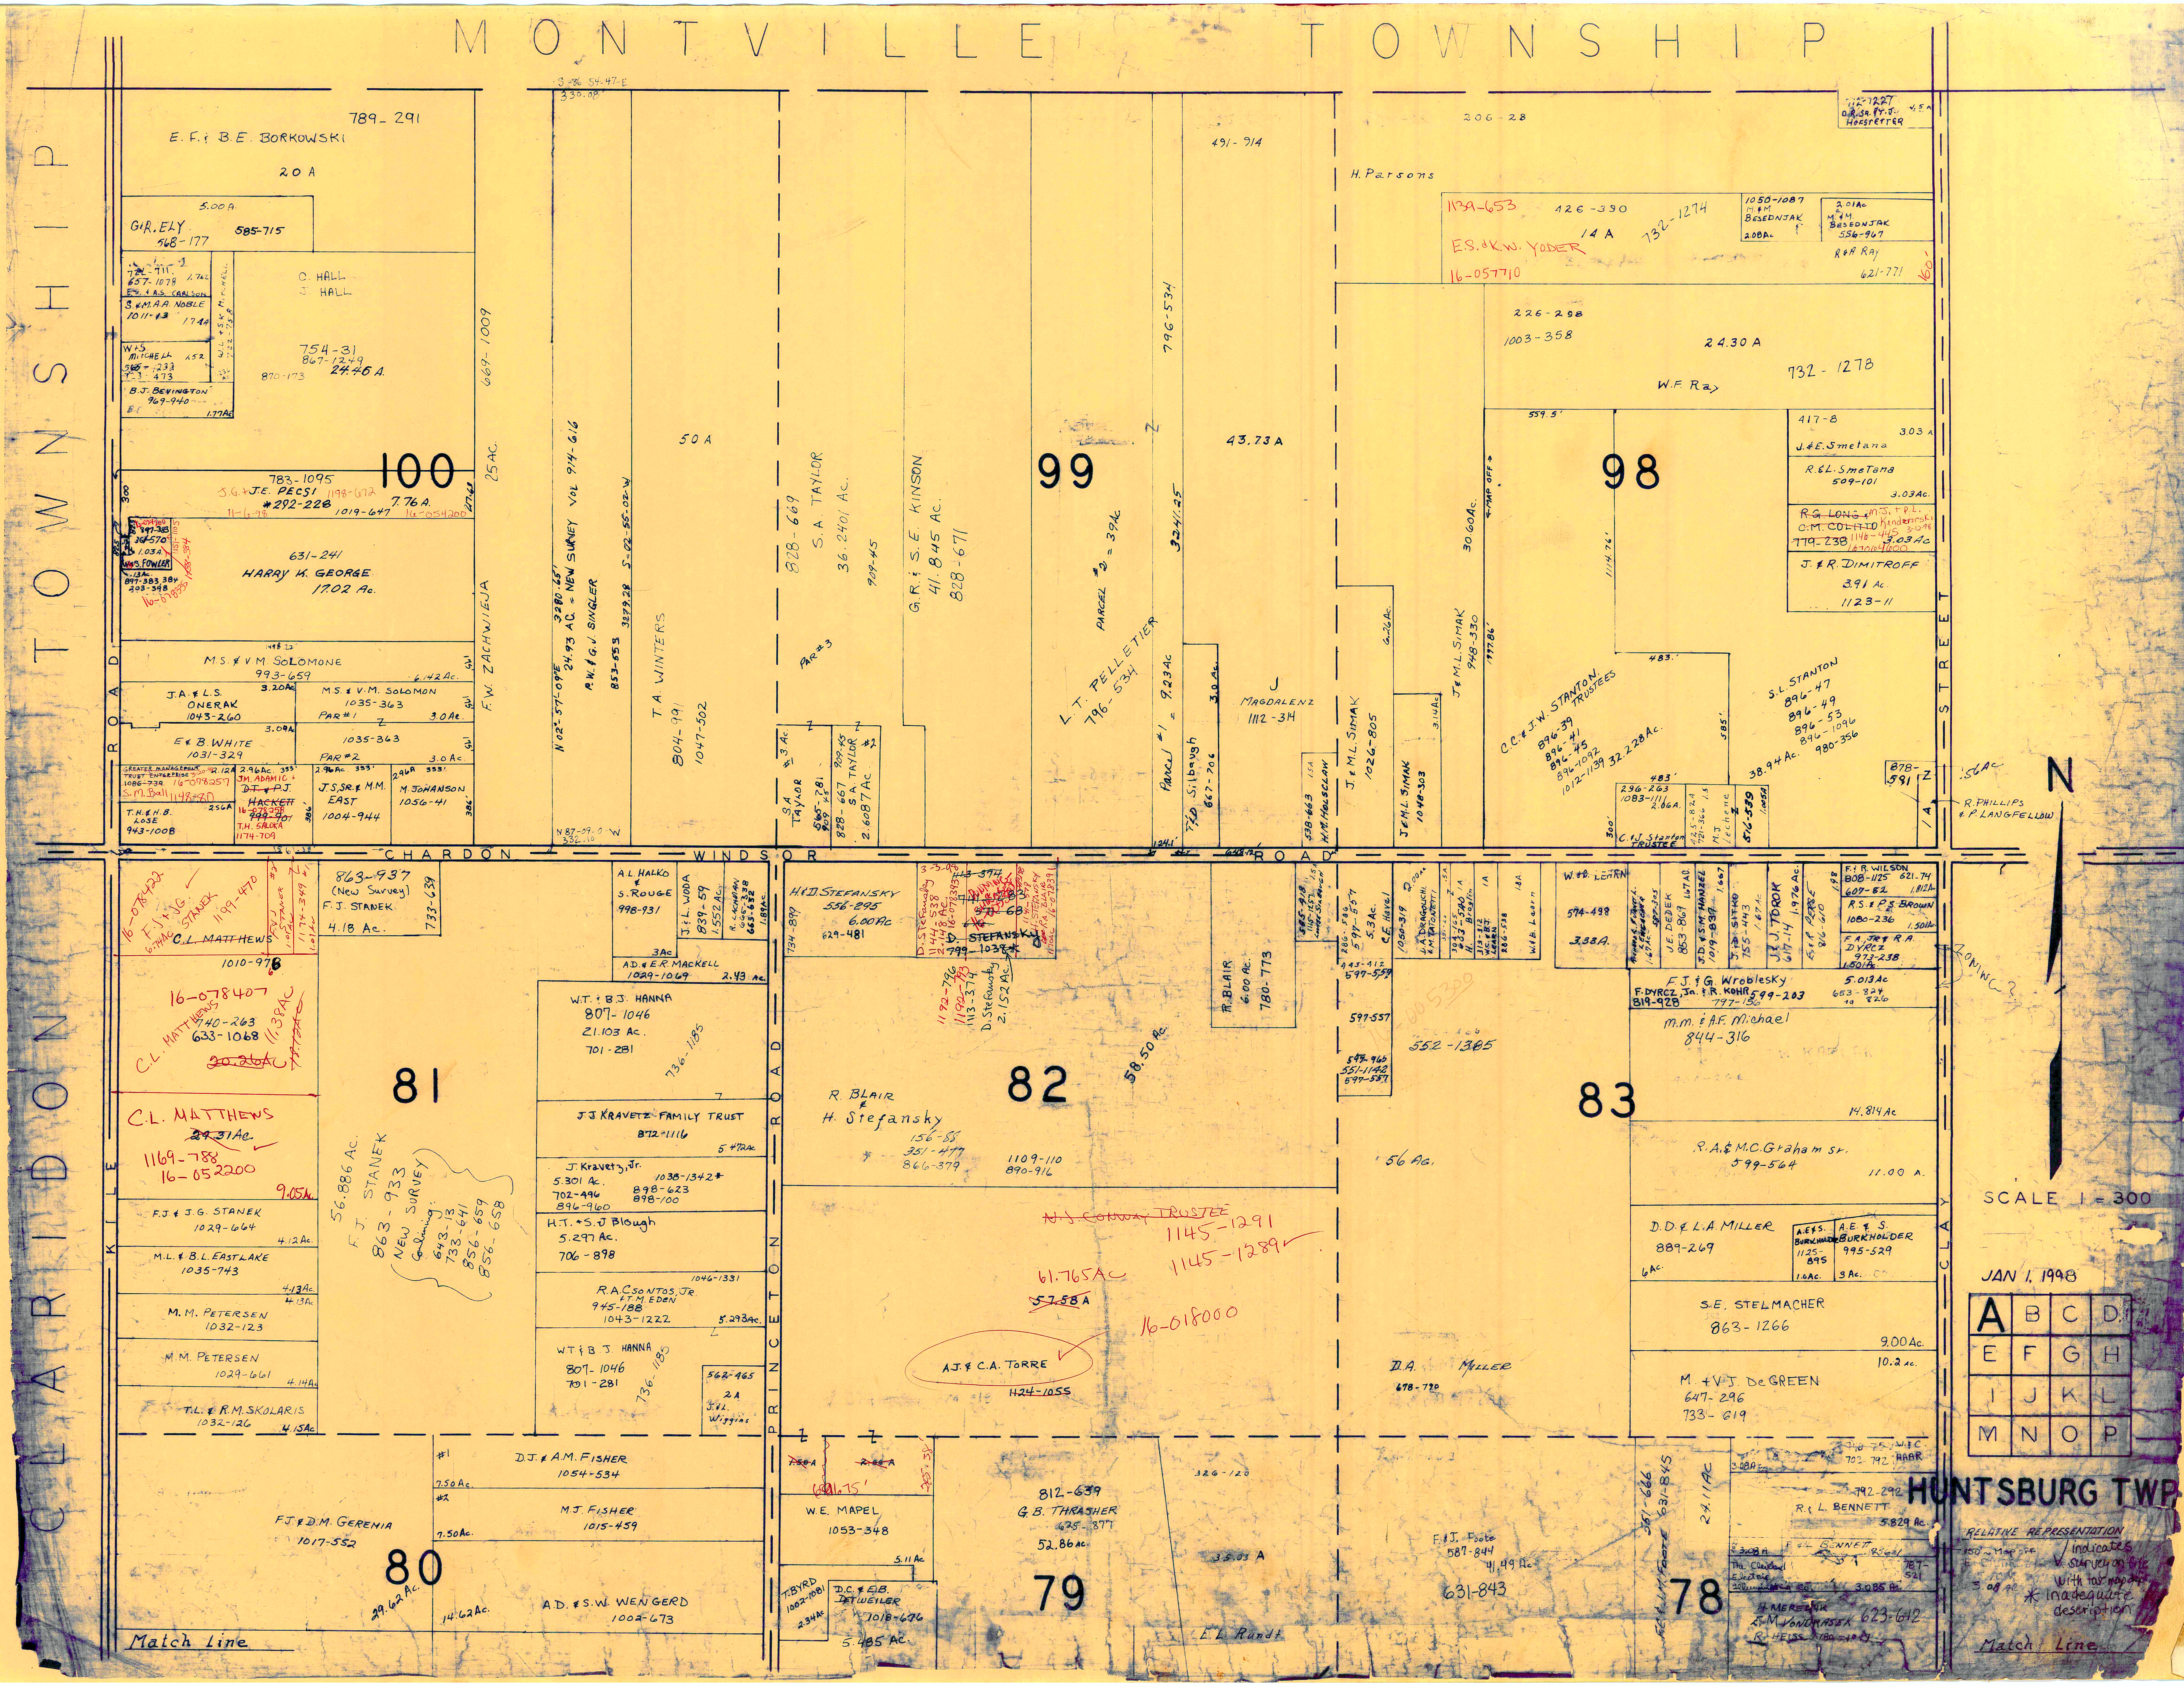

MONTVILLE TOWNSHIP
CLARIDON TOWNSHIP
HUNTSBURG TWP.
CHARDON WINDSOR ROAD
KILE ROAD
PRINCETON ROAD
CLAY STREET
N
SCALE 1 = 300
JAN 1, 1998
A B C D
E F G H
I J K L
M N O P
RELATIVE REPRESENTATION
✓ indicates survey on file with tax map office
* inadequate description
Match Line
Match Line
100
99
98
81
82
83
80
79
78
E.F. & B.E. BORKOWSKI
789-291
20 A
G.R. ELY
568-177
585-715
5.00 A.
C. HALL
S. HALL
754-31
867-1249
24.46 A.
870-173
S. & M.A.A. NOBLE
1011-83
W. & S. MITCHELL
B.J. BEVINGTON
969-940
783-1095
J.G. & J.E. PECSI
#292-228
7.76 A.
1019-647
HARRY K. GEORGE
631-241
17.02 Ac.
M.S. & V.M. SOLOMONE
993-659
M.S. & V.M. SOLOMON
1035-363
PAR #1
PAR #2
1035-363
J.A. & L.S. ONERAK
1043-260
E. & B. WHITE
1031-329
J.S.Sr. & M.M. EAST
1004-944
M. JOHANSON
1056-41
T.H. & H.B. LOSE
943-1008
HACKETT
F.W. ZACHWIEJA
669-1009
25 AC.
R.W. & G.V. SINGLER
24.93 AC = NEW SURVEY VOL 914-616
853-553
T.A. WINTERS
50 A
804-191
1047-562
S.A. TAYLOR
36.2401 Ac.
828-669
909-45
G.R. & S.E. KINSON
41.845 Ac.
828-671
PAR #3
S.A. TAYLOR
2.6087 Ac
L.T. PELLETIER
796-534
PARCEL #2 = 39 Ac
PARCEL #1 = 9.23 Ac
324.125
S. Silbaugh
667-706
491-914
43.73 A
J. MAGDALENZ
1112-34
H. Parsons
206-28
1139-653
E.S. & K.W. YODER
16-057710
426-390
14 A
732-1274
M. & M. BESEDNJAK
556-967
R. & A. Ray
621-771
226-258
1003-358
24.30 A
W.F. Ray
732-1278
J. & E. Smetana
417-8
3.03 A
R. & L. Smetana
509-101
3.03 Ac.
R.G. LONG
C.M. COLITTO
779-238
3.03 Ac
J. & R. DIMITROFF
3.91 Ac
1123-11
J. & M.L. SIMAK
1026-805
J. & M.L. SIMAK
1048-303
J. & M.L. SIMAK
948-330
30.60 Ac.
C.C. & J.W. STANTON TRUSTEES
896-39
896-41
896-45
32.228 Ac.
S.L. STANTON
896-47
896-49
896-53
896-1096
980-356
38.94 Ac.
R. PHILLIPS & P. LANGFELLOW
863-937 (New Survey)
F.J. STANEK
4.18 Ac.
733-639
16-078422
F.J. & J.G. STANEK
1199-470
C.L. MATTHEWS
1010-976
16-078407
C.L. MATTHEWS
740-263
633-1068
~~20.20 AC~~
11.38 AC
C.L. MATTHEWS
~~29.31 Ac~~
1169-788
16-052200
9.05 Ac
F.J. & J.G. STANEK
1029-664
4.12 Ac.
M.L. & B.L. EASTLAKE
1035-743
4.13 Ac.
M.M. PETERSEN
1032-123
M.M. PETERSEN
1029-661
4.14 Ac.
T.L. & R.M. SKOLARIS
1032-126
4.15 Ac.
F.J. STANEK
56.886 Ac.
863-933
NEW SURVEY
643-13
733-641
856-659
856-658
A.L. HALKO & S. ROUGE
998-931
J. & L. WODA
839-59
A.D. & E.R. MACKELL
1029-1069
2.43 Ac.
W.T. & B.J. HANNA
807-1046
21.103 Ac.
701-281
736-1185
J.J. KRAVETZ FAMILY TRUST
872-1116
J. Kravetz, Jr.
5.301 Ac.
702-496
896-960
1038-1342
898-623
898-100
H.T. & S.J. Blough
5.297 Ac.
706-898
R.A. Csontos, Jr. & M. EDEN
945-188
1043-1222
5.293 Ac.
W.T. & B.J. HANNA
807-1046
701-281
736-1185
562-465
2 A
J. & L. Wiggins
H. & D. STEFANSKY
556-295
6.00 Ac.
629-481
D. STEFANSKY
799-1038
D. Stefansky
2.152 Ac.
R. BLAIR
6.00 Ac.
780-773
R. BLAIR & H. Stefansky
156-88
351-477
866-379
1109-110
890-916
58.50 Ac.
~~N.J. CONWAY TRUSTEE~~
1145-1291
1145-1289
61.765 AC
~~57.58 A~~
16-018000
A.J. & C.A. TORRE
1124-1055
552-1385
56 Ac.
W. & B. LEARN
3.38 A.
J.E. DEDEK
853-869
J.J. TOROK
F.R. WILSON
808-1125
621-74
607-82
R.S. & P.S. BROWN
1080-236
A. DYRCZ
F.J. & G. Wroblesky
F. DYRCZ, Jr. & R. KOHR
819-928
599-203
5.01 Ac.
M.M. & A.F. Michael
844-316
14.814 Ac
R.A. & M.C. Graham Sr.
599-564
11.00 A
D.D. & L.A. MILLER
889-269
A.E. & S. BURKHOLDER
995-529
S.E. STELMACHER
863-1266
9.00 Ac.
D.A. MILLER
678-770
M. & V.J. DeGREEN
647-296
733-619
10.2 Ac.
D.J. & A.M. FISHER
1054-534
7.50 Ac.
M.J. FISHER
1015-459
7.50 Ac.
F.J. & D.M. GERENIA
1017-552
29.62 Ac.
14.62 Ac.
A.D. & S.W. WENGERD
1002-673
W.E. MAPEL
1053-348
T. BYRD
D.C. & E.B. DETWEILER
5.485 Ac.
812-639
G.B. THRASHER
52.86 Ac.
326-120
35.03 A
E.L. Randt
F. & J. Foote
587-844
41.49 Ac
631-843
24.11 Ac
R. & L. BENNETT
5.829 Ac
3.085 Ac
Z.M. VONDRASEK
623-612
R. HEISS
ZONING ?

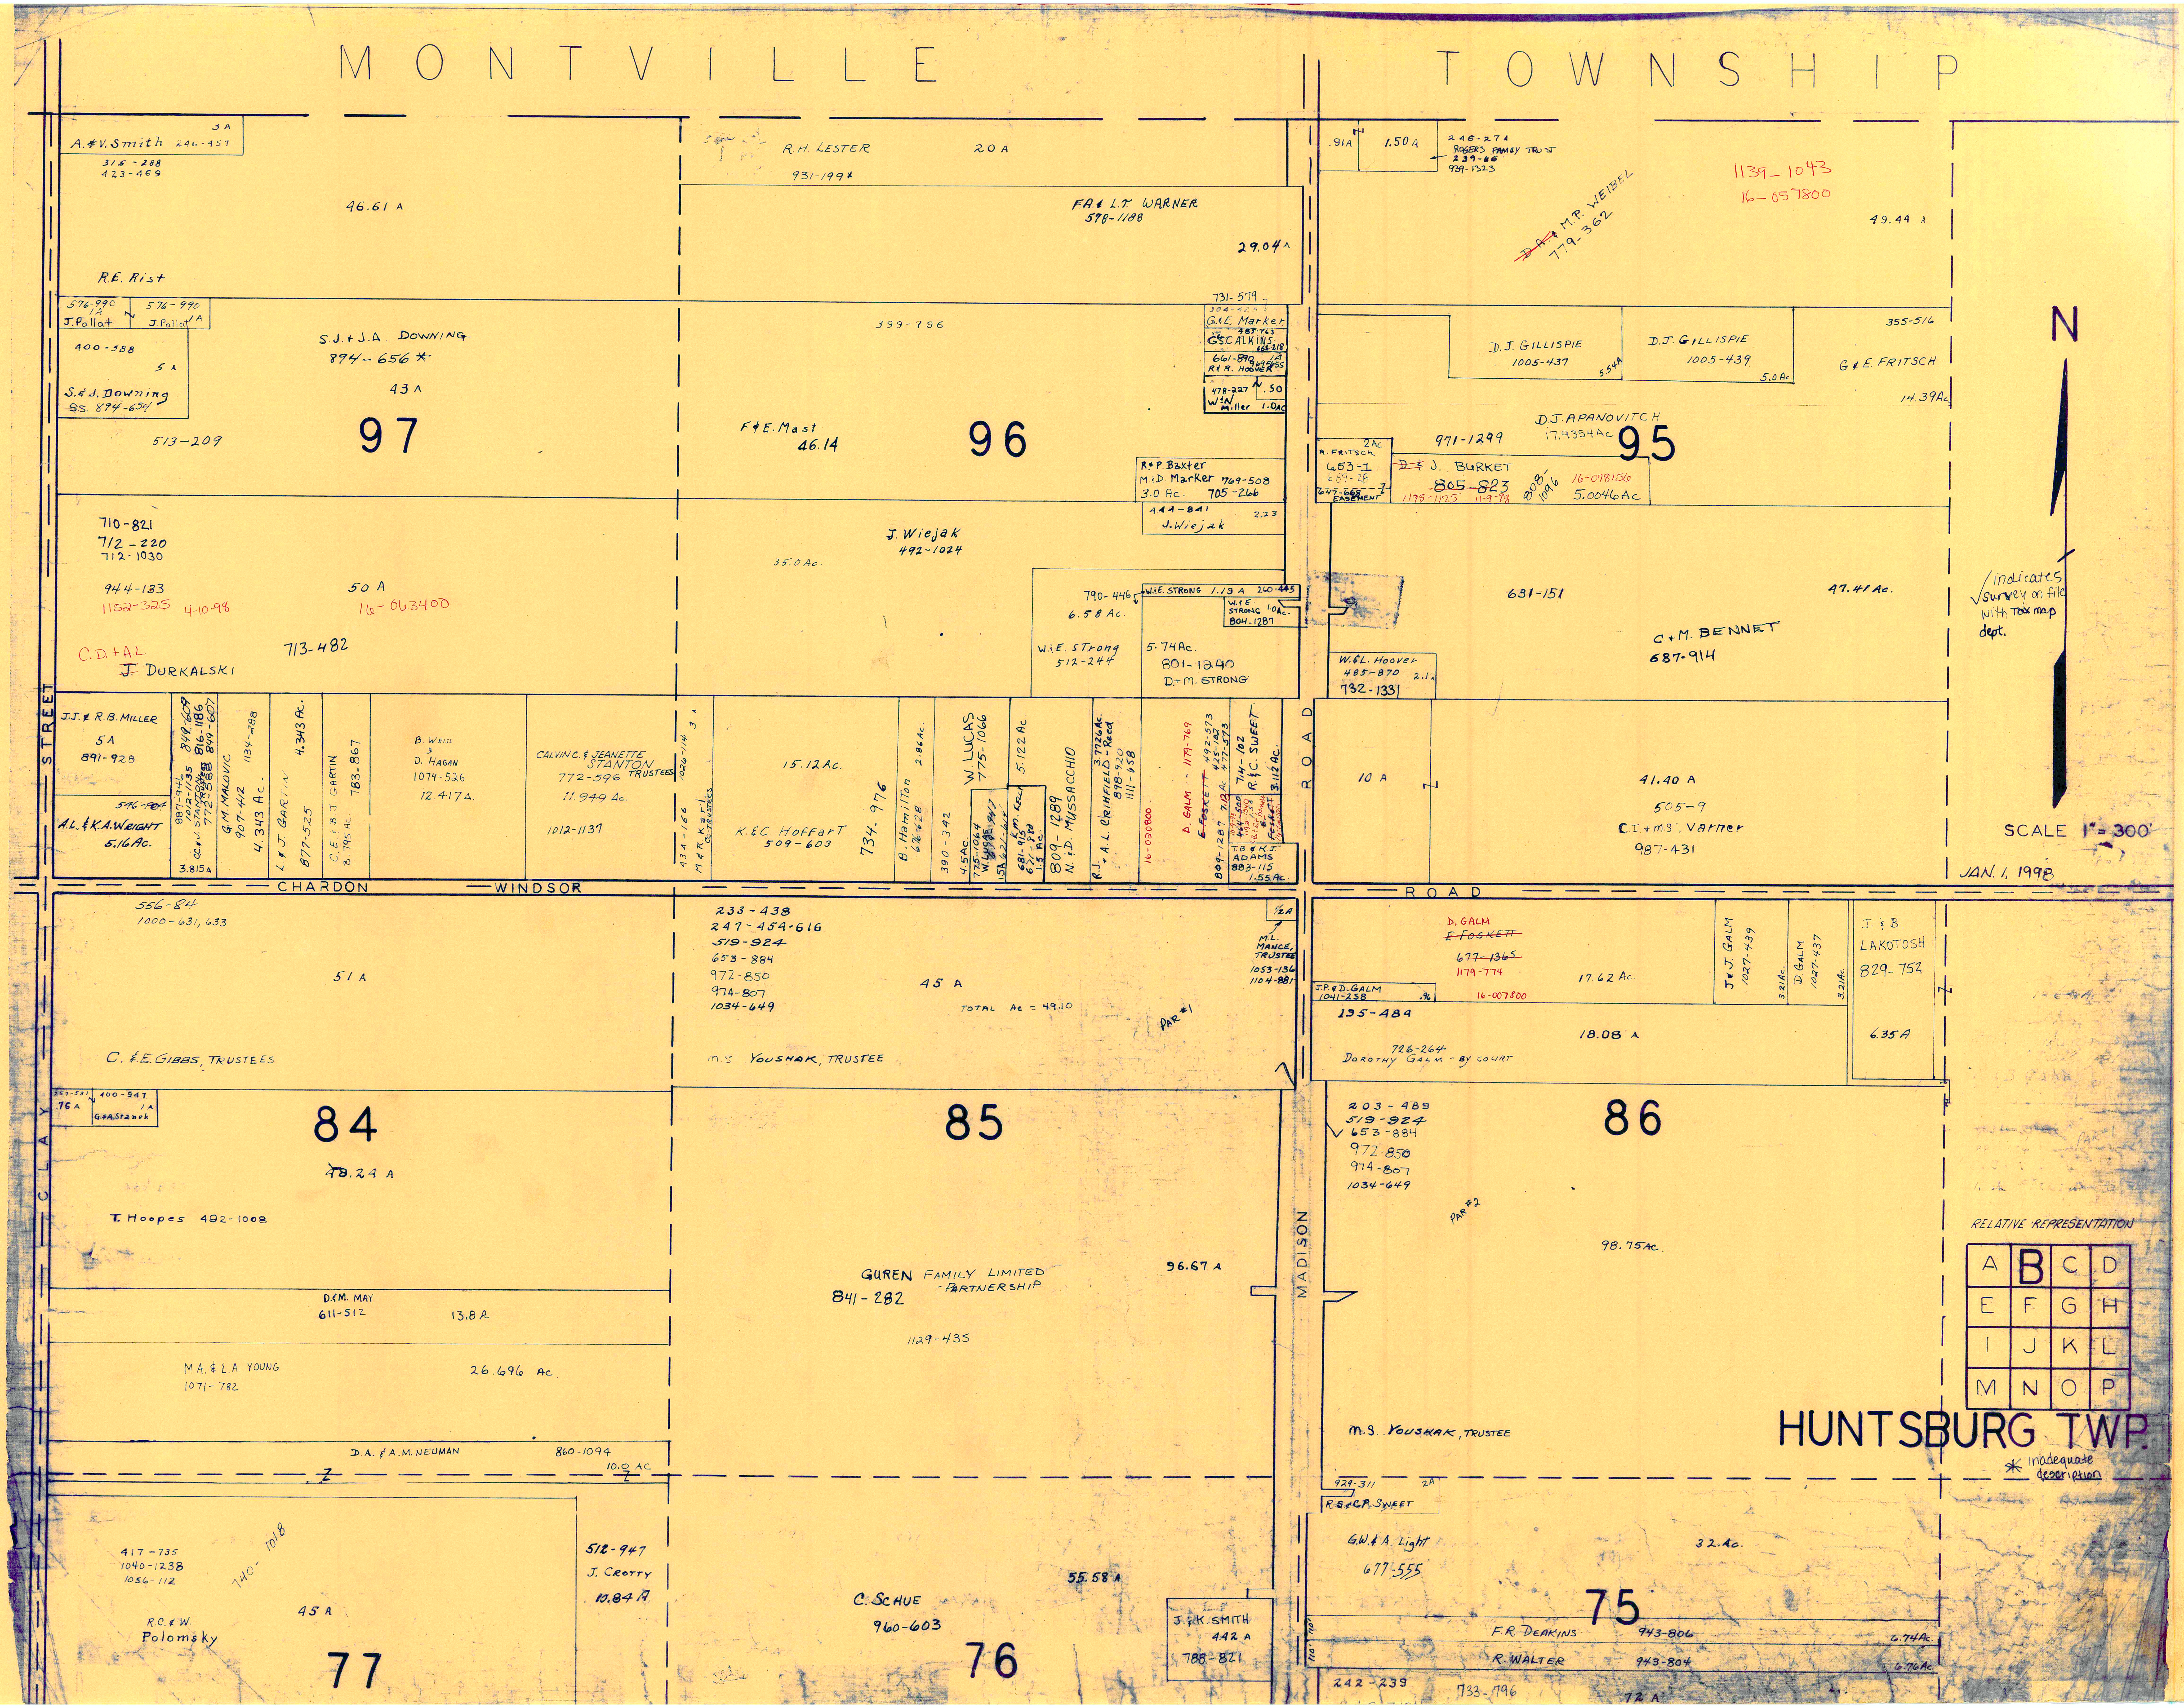MONTVILLE TOWNSHIP
A.&V. Smith 246-457
3 A
315-288
423-469
46.61 A
R.E. Rist
576-990 J. Pollat
576-990 J. Pollat 1 A
400-388
5 A
S.&J. Downing S.S. 874-654
513-209
S.J.&J.A. Downing 894-656 *
43 A
97
R.H. Lester
931-199*
20 A
FA & L.T. Warner 578-1188
29.04 A
731-579
G.&E. Marker
G.S. Calkins
R&R. Hoover
W.&N. Miller 1.0 Ac
F&E. Mast 46.14
399-196
96
R&P Baxter
M.D. Marker 769-508
3.0 Ac. 705-266
444-841 J. Wiejak
2.23
.91 A
1.50 A
246-271
Rogers Family Trust
239-46
939-1323
1139-1043
16-057800
~~D.A.J.~~ M.P. Weibel 779-362
49.44 A
D.J. Gillispie 1005-437
5.54 A
D.J. Gillispie 1005-439
5.0 Ac
355-516
G&E Fritsch
14.39 Ac
N
D.J. Apanovitch 17.9354 Ac
971-1299
95
A. Fritsch 2 Ac
653-1
~~D.&~~ J. Burket 805-823
16-078156
5.0046 Ac
1198-1175
Easement
710-821
712-220
712-1030
944-183
1152-325 4-10-98
50 A
16-063400
C.D.+A.L.
J. Durkalski
713-482
35.0 Ac.
J. Wiejak 492-1024
790-446
6.58 Ac.
W.E. Strong 512-244
W.E. Strong 1.19 A
W.E. Strong 804-1287
5.74 Ac.
801-1240
D.+M. Strong
631-151
47.41 Ac.
C.+M. Bennet 687-914
W.&L. Hoover 485-870 2.1 A
732-1331
indicates survey on file with tax map dept.
J.J.& R.B. Miller 5 A 891-928
A.L.&K.A. Wright 5.16 Ac.
3.815 A
G.M. Malovic 907-412
4.343 Ac.
L.&J. Garin 877-525
4.343 Ac.
C.E.& B.J. Gartin 3.795 Ac
783-867
B. Weiss & D. Hagan 1074-526 12.417 A
Calvin C.& Jeanette Stanton Trustees 772-596
11.949 Ac.
1012-1137
15.12 Ac.
K&C Hoffart 509-603
734-976
B. Hamilton 2.86 Ac.
W. Lucas 775-1066
5.122 Ac.
809-1289
N.D. Mussacchio
A.L. Crihfield 3.726 Ac.
16-030800
D. Galm 1179-769
~~E. Foskett~~
R.&C. Sweet
3.112 Ac
TB&KJ Adams 883-115 1.55 Ac
10 A
41.40 A
505-9
C.I.+M.S. Varner 987-431
SCALE 1"=300'
JAN. 1, 1998
STREET
CHARDON
WINDSOR
ROAD
556-84
1000-631, 633
51 A
C.&E. Gibbs, Trustees
.76 A
400-847 1 A G.&A. Stanek
84
~~48~~.24 A
T. Hoopes 492-1008
D.&M. May 611-512
13.8 A
M.A.&L.A. Young 1071-782
26.696 Ac
D.A.&A.M. Neuman
860-1094
10.0 Ac
CLAY
233-438
247-454-616
519-924
653-884
972-850
974-807
1034-649
45 A
Total Ac = 49.10
Par #1
M.S. Youshak, Trustee
M.L. Mance, Trustee 1053-136 1104-881
1/2 A
85
Guren Family Limited Partnership 841-282
96.67 A
1129-435
MADISON
D. Galm
~~E. Foskett~~
~~677-1365~~
1179-774
16-007800
J.P.&D. Galm 1041-258
17.62 Ac
J.&J. Galm 1027-439
3.21 Ac
D. Galm 1027-437
3.21 Ac
J.&B. Lakotosh 829-752
6.35 A
195-484
726-264
Dorothy Galm - by court
18.08 A
203-489
519-924
653-884
972-850
974-807
1034-649
86
Par #2
98.75 Ac
M.S. Youshak, Trustee
RELATIVE REPRESENTATION
A B C D
E F G H
I J K L
M N O P
HUNTSBURG TWP.
* inadequate description
417-735
1040-1238
1056-112
1140-1018
R.C.&W. Polomsky
45 A
77
512-947
J. Crotty
10.84 A
C. Schue 960-603
55.58 A
76
J.&K. Smith 442 A
788-821
929-311
2 A
R.S.&C.P. Sweet
G.W.&A. Light 677-555
32 Ac.
75
F.R. Deakins 943-806
6.74 Ac
R. Walter 943-804
6.74 Ac
242-239
733-796
72 A

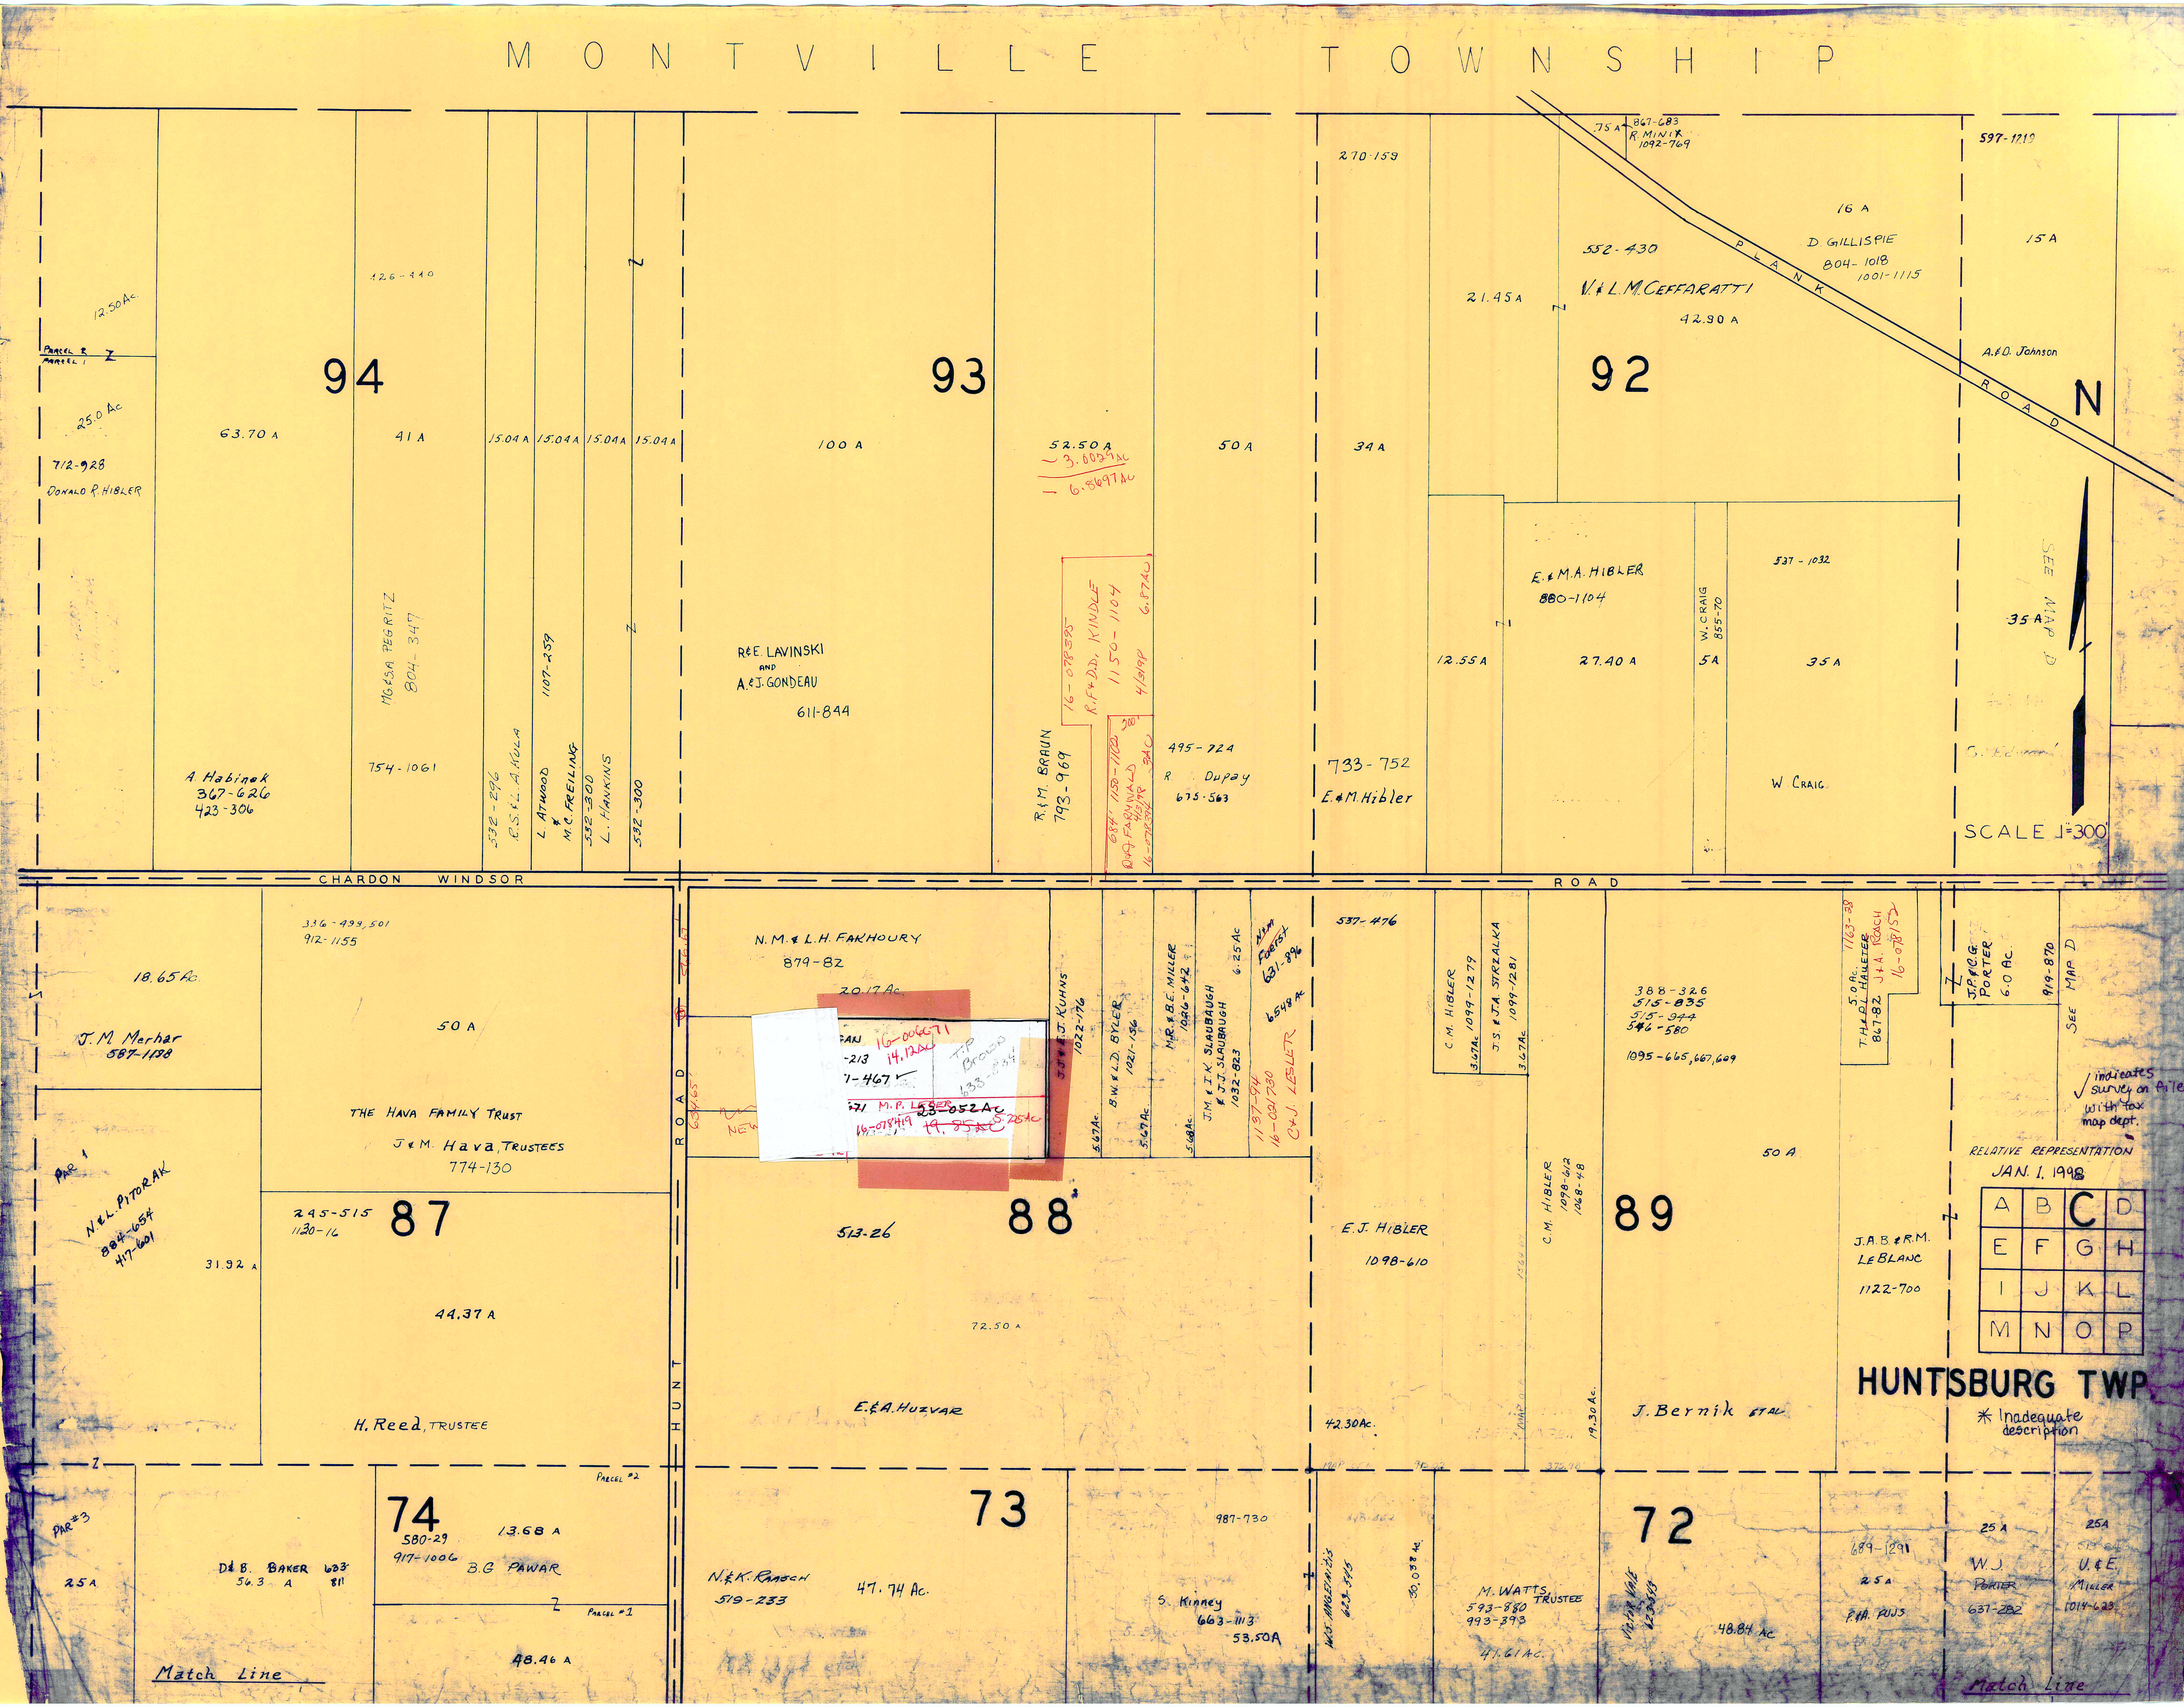
MONTVILLE TOWNSHIP
94
93
92
12.50 Ac
PARCEL 2
PARCEL 1
25.0 Ac
712-928
DONALD R. HIBLER
63.70 A
A. Habinak
367-626
423-306
126-110
41 A
MG.&S.A PEGRITZ
804-347
754-1061
15.04 A
15.04 A
15.04 A
15.04 A
532-296
R.S.&L.A. KULA
1107-259
L. ATWOOD
&
M.C. FREILING
532-300
L. HANKINS
532-300
100 A
R&E. LAVINSKI
AND
A.&J. GONDEAU
611-844
R.&M. BRAUN
793-969
52.50 A
3.0029 Ac
6.8697 Ac
16-078395
R.F.& D.D. KINDLE
1150-1104
4/3/98
6.87 Ac
684' 1150-1102
D.&J. FARNWALD
4/3/98
16-078394
3 Ac
200'
50 A
495-724
R. Dupay
675-563
270-159
34 A
733-752
E.&M. Hibler
75 A
867-683
R. MINIX
1092-769
21.45 A
552-430
V.&L.M. CEFFARATTI
42.90 A
16 A
D. GILLISPIE
804-1018
1001-1115
PLANK ROAD
E.&M.A. HIBLER
880-1104
12.55 A
27.40 A
W. CRAIG
855-70
5 A
537-1032
35 A
W. CRAIG
597-1219
15 A
A.&D. Johnson
35 A
SEE MAP D
N
SCALE 1"=300'
CHARDON WINDSOR ROAD
336-499, 501
912-1155
18.65 Ac
J.M. Merhar
587-1178
50 A
THE HAVA FAMILY TRUST
J & M. Hava, TRUSTEES
774-130
PAR 1
N.&L. PITORAK
884-654
417-601
31.92 A
245-515
1130-16
87
44.37 A
H. Reed, TRUSTEE
HUNT ROAD
526.67
634.65'
NEW
N.M. & L.H. FAKHOURY
879-82
20.17 Ac.
FAN
16-006671
14.12 Ac
-213
-467 ✓
T.P. Brown
633-834
671
M.P. LESER
23.052 Ac
16-078419
~~19.85 Ac~~
5.225 Ac
J.J. & E.J. KUHNS
1022-176
5.67 Ac.
B.W. & L.D. BYLER
1021-156
5.67 Ac.
M.R. & B.E. MILLER
1026-642
5.68 Ac.
J.M. & I.K. SLAUBAUGH
& J.J. SLAUBAUGH
1032-823
6.25 Ac
~~N&M~~ Faerst
631-896
6.548 Ac
1137-94
16-021730
C+J. LESLER
513-26
88
72.50 A
E.&A. HUZVAR
537-476
E.J. HIBLER
1098-610
42.30 Ac.
C.M. HIBLER
1099-1279
3.67 Ac
J.S. & J.A. STRZALKA
1099-1281
3.67 Ac
C.M. HIBLER
1098-612
1068-48
19.30 Ac.
388-326
515-835
515-944
546-580
1095-665, 667, 609
50 A
89
J. Bernik ET AL
5.0 Ac.
T.H.&P.L. HAUETER
867-82
1163-38
J+A. ROACH
16-078152
J.A.B. & R.M.
LEBLANC
1122-700
J.P. & C.G.
PORTER
6.0 Ac.
919-870
SEE MAP D
✓ indicates survey on file with tax map dept.
RELATIVE REPRESENTATION
JAN. 1, 1998
A B C D
E F G H
I J K L
M N O P
HUNTSBURG TWP.
✳ Inadequate description
PAR #3
25 A
D.& B. BAKER 633-811
56.3 A
74
580-29
917-1006
13.68 A
B.G PAWAR
PARCEL #2
PARCEL #1
48.46 A
Match Line
73
N.& K. RAASCH
519-233
47.74 Ac.
987-730
S. Kinney
663-1113
53.50A
W.S. ANGELINI
623-345
30.038 Ac.
M. WATTS, TRUSTEE
593-880
993-393
41.61 Ac.
72
623-343
48.84 Ac
689-1291
25 A
P.&A. FUJS
25 A
W.J. PORTER
637-282
25A
U.&E. MILLER
1014-623
Match Line

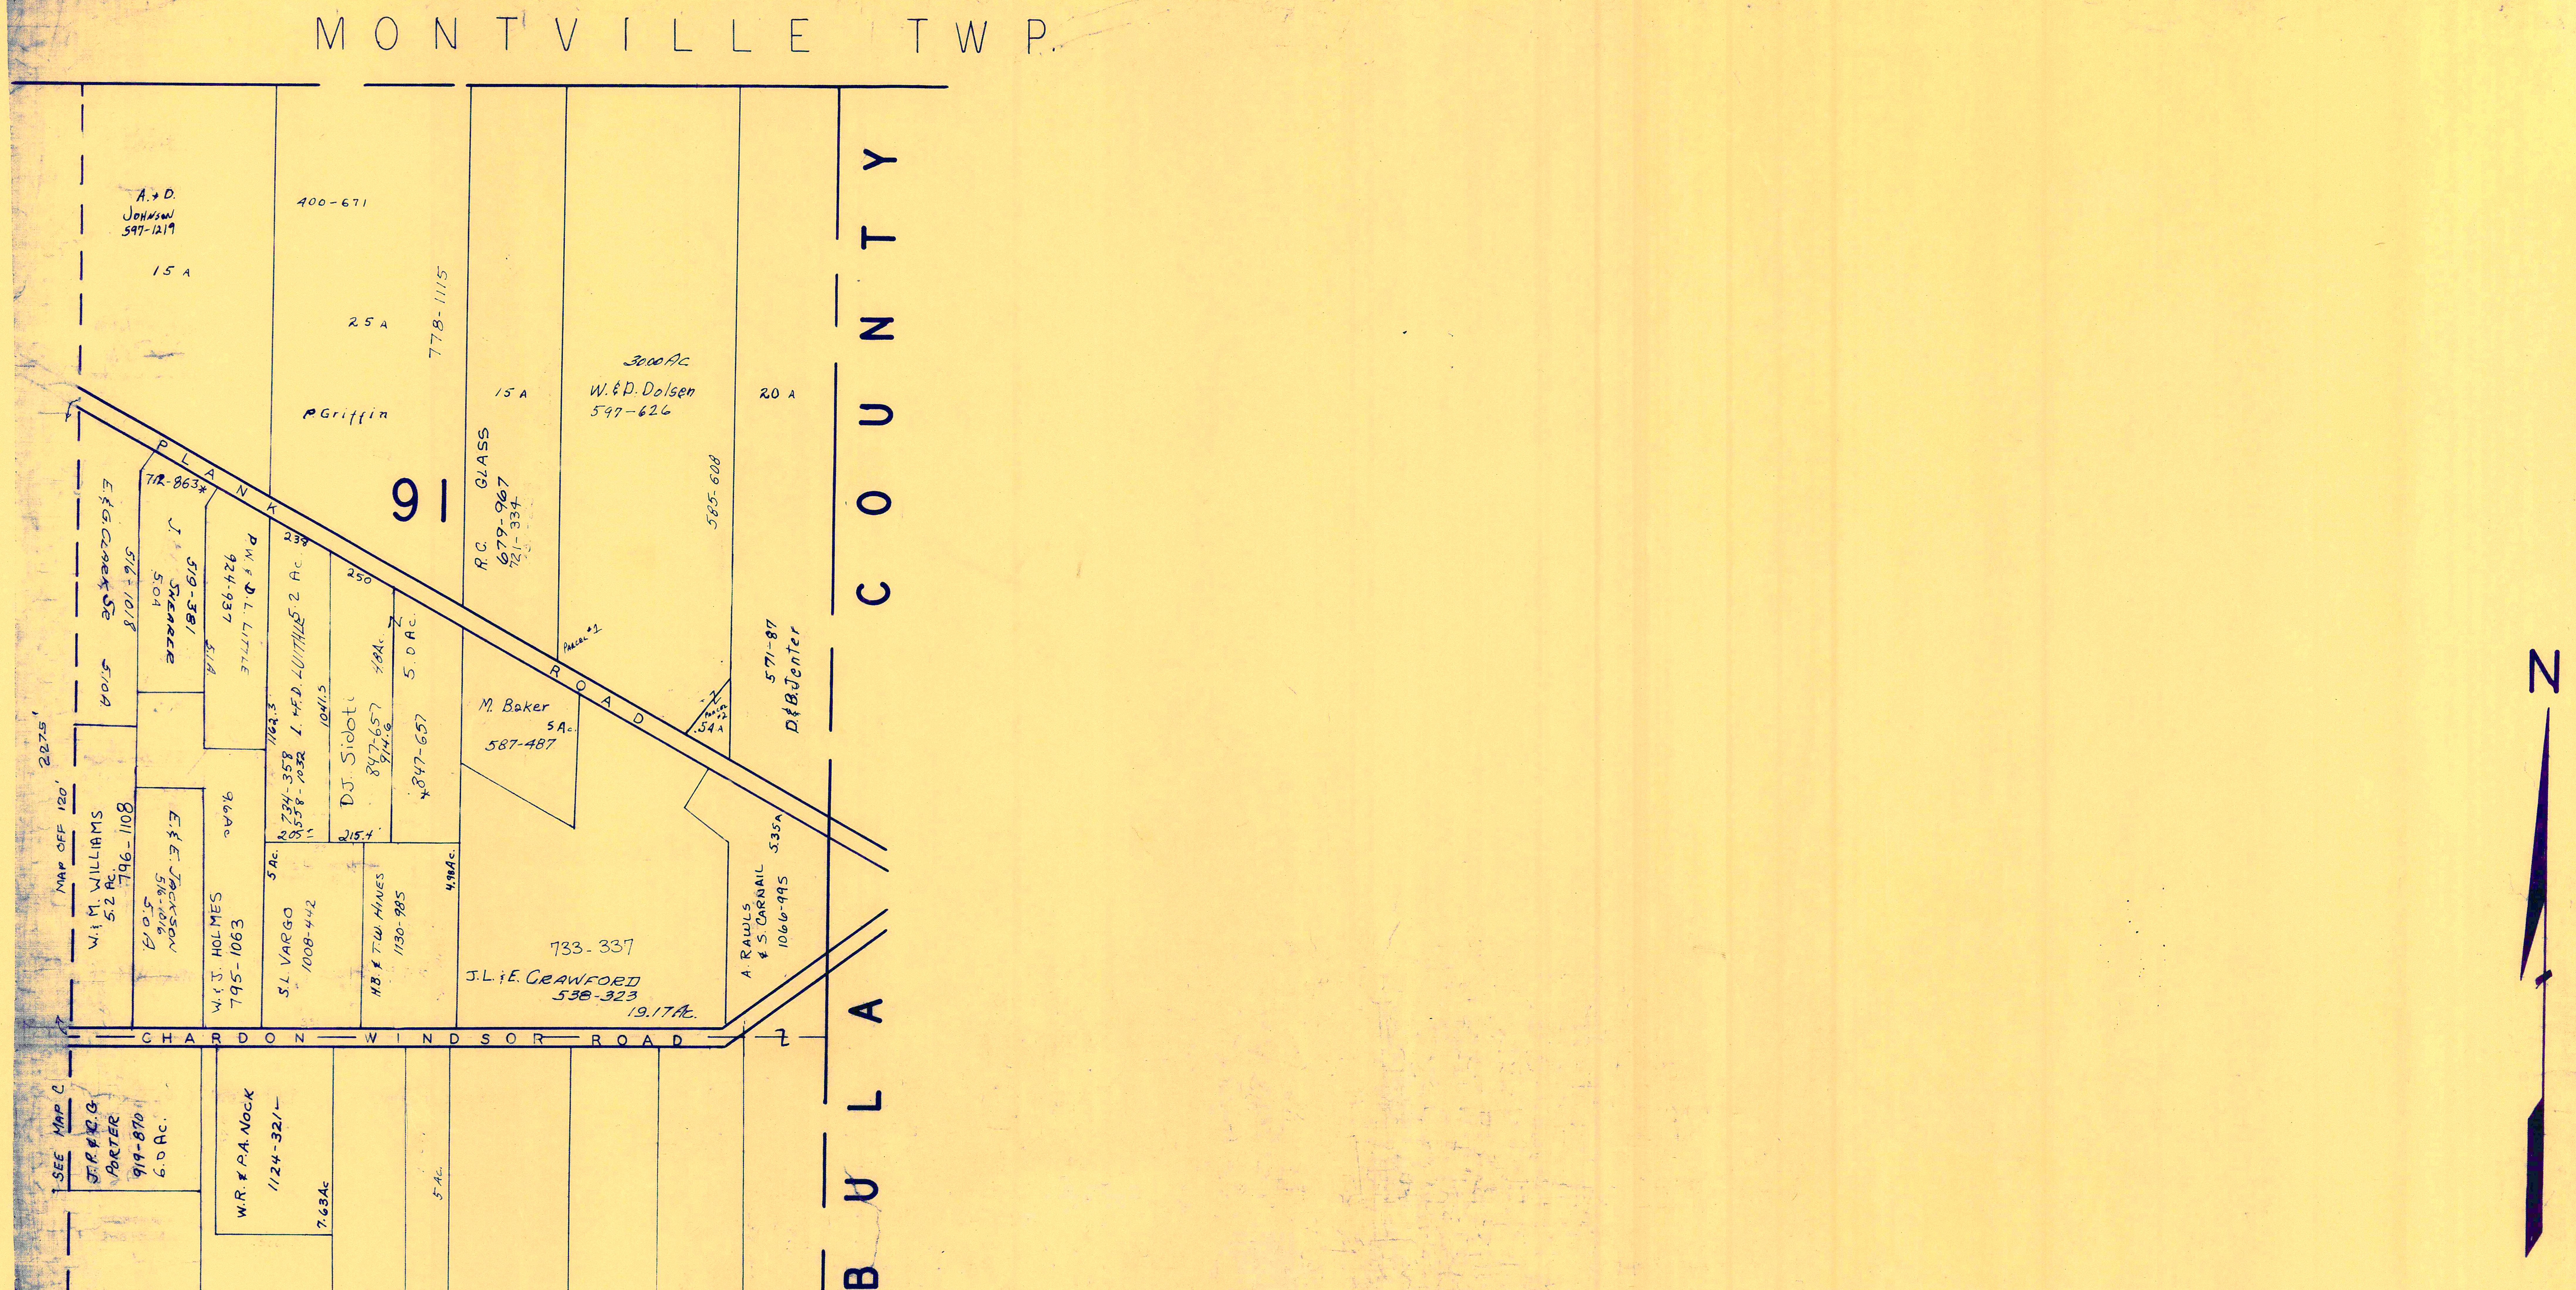
MONTVILLE TWP.
ASHTABULA COUNTY
N
91
90
71
PLANK ROAD
CHARDON WINDSOR ROAD
A. & D. JOHNSON 597-1219
15 A
400-671
25 A
778-1115
P. Griffin
15 A
R.C. GLASS 679-967 721-334
30.00 Ac.
W. & D. Dolsen 597-626
585-608
20 A
571-87
D & B Jenter
Parcel #1
Parcel #2
.54 A
M. Baker 5 Ac. 587-487
712-863*
E & G Clark Sr. 516-1018 5.10 A
J. Shearer 519-381 5.0 A
P.W. & D.L. Little 924-937 5.1 A
238
250
L. & F.D. Luithle 5.2 Ac. 734-358 558-1032
1162.3
1041.5
DJ Sidoti 847-657 914-6 4.8 Ac.
5.0 Ac. *847-657
205
215.4
2275'
MAP OFF 120'
W. & M. WILLIAMS 5.2 Ac. 796-1108
E. & E. JACKSON 516-1016 5.0 A
9.6 Ac.
W. & J. HOLMES 795-1063
5 Ac.
S.L. VARGO 1008-442
H.B. & T.W. HINES 1130-985
4.98 Ac.
733-337
J.L. & E. CRAWFORD 538-323
19.17 Ac.
5.35 A
A. RAWLS & S. CARNAIL 1066-995
SEE MAP C
J.R. & R.G. PORTER 919-870 6.0 Ac.
W.R. & P.A. NOCK 1124-321
7.63 Ac.
580-364
39 Ac.
Dominic J. Graziano
LEBLANC 1122-700
23.15 Ac.
A. & M. KADIVEC 1124-323
5 Ac.
15 A
491-26
R.E. & L. YONCE
R. & J. CRAVEN 23 A 597-1079 -1080
E.L. & S.A. HUMPHREYS, JR. 932-245
16.92 Ac.
2458.23'
R.T. & C.L. JACKSON 980-629 633-432
17.05 Ac.
R.T. & C.L. JACKSON 1038-1100
15.243 Ac.
251.93'
300'
250.45'
R.L. McClellan, Trustee
254-36
W. J. PORTER 637-282 25 Ac.
V. & E. MILLER 1014-623 25 Ac.
580-846 941-1161
791-949
45.194 A
47 A
J. Johnson
Match Line

SCALE 1" = 300'

JAN. 1, 1998

√ indicates survey on file with tax map dep.

* Inadequate description

A	B	C	**D**
E	F	G	H
I	J	K	L
M	N	O	P

HUNTSBURG TWP.

RELATIVE REPRESENTATION

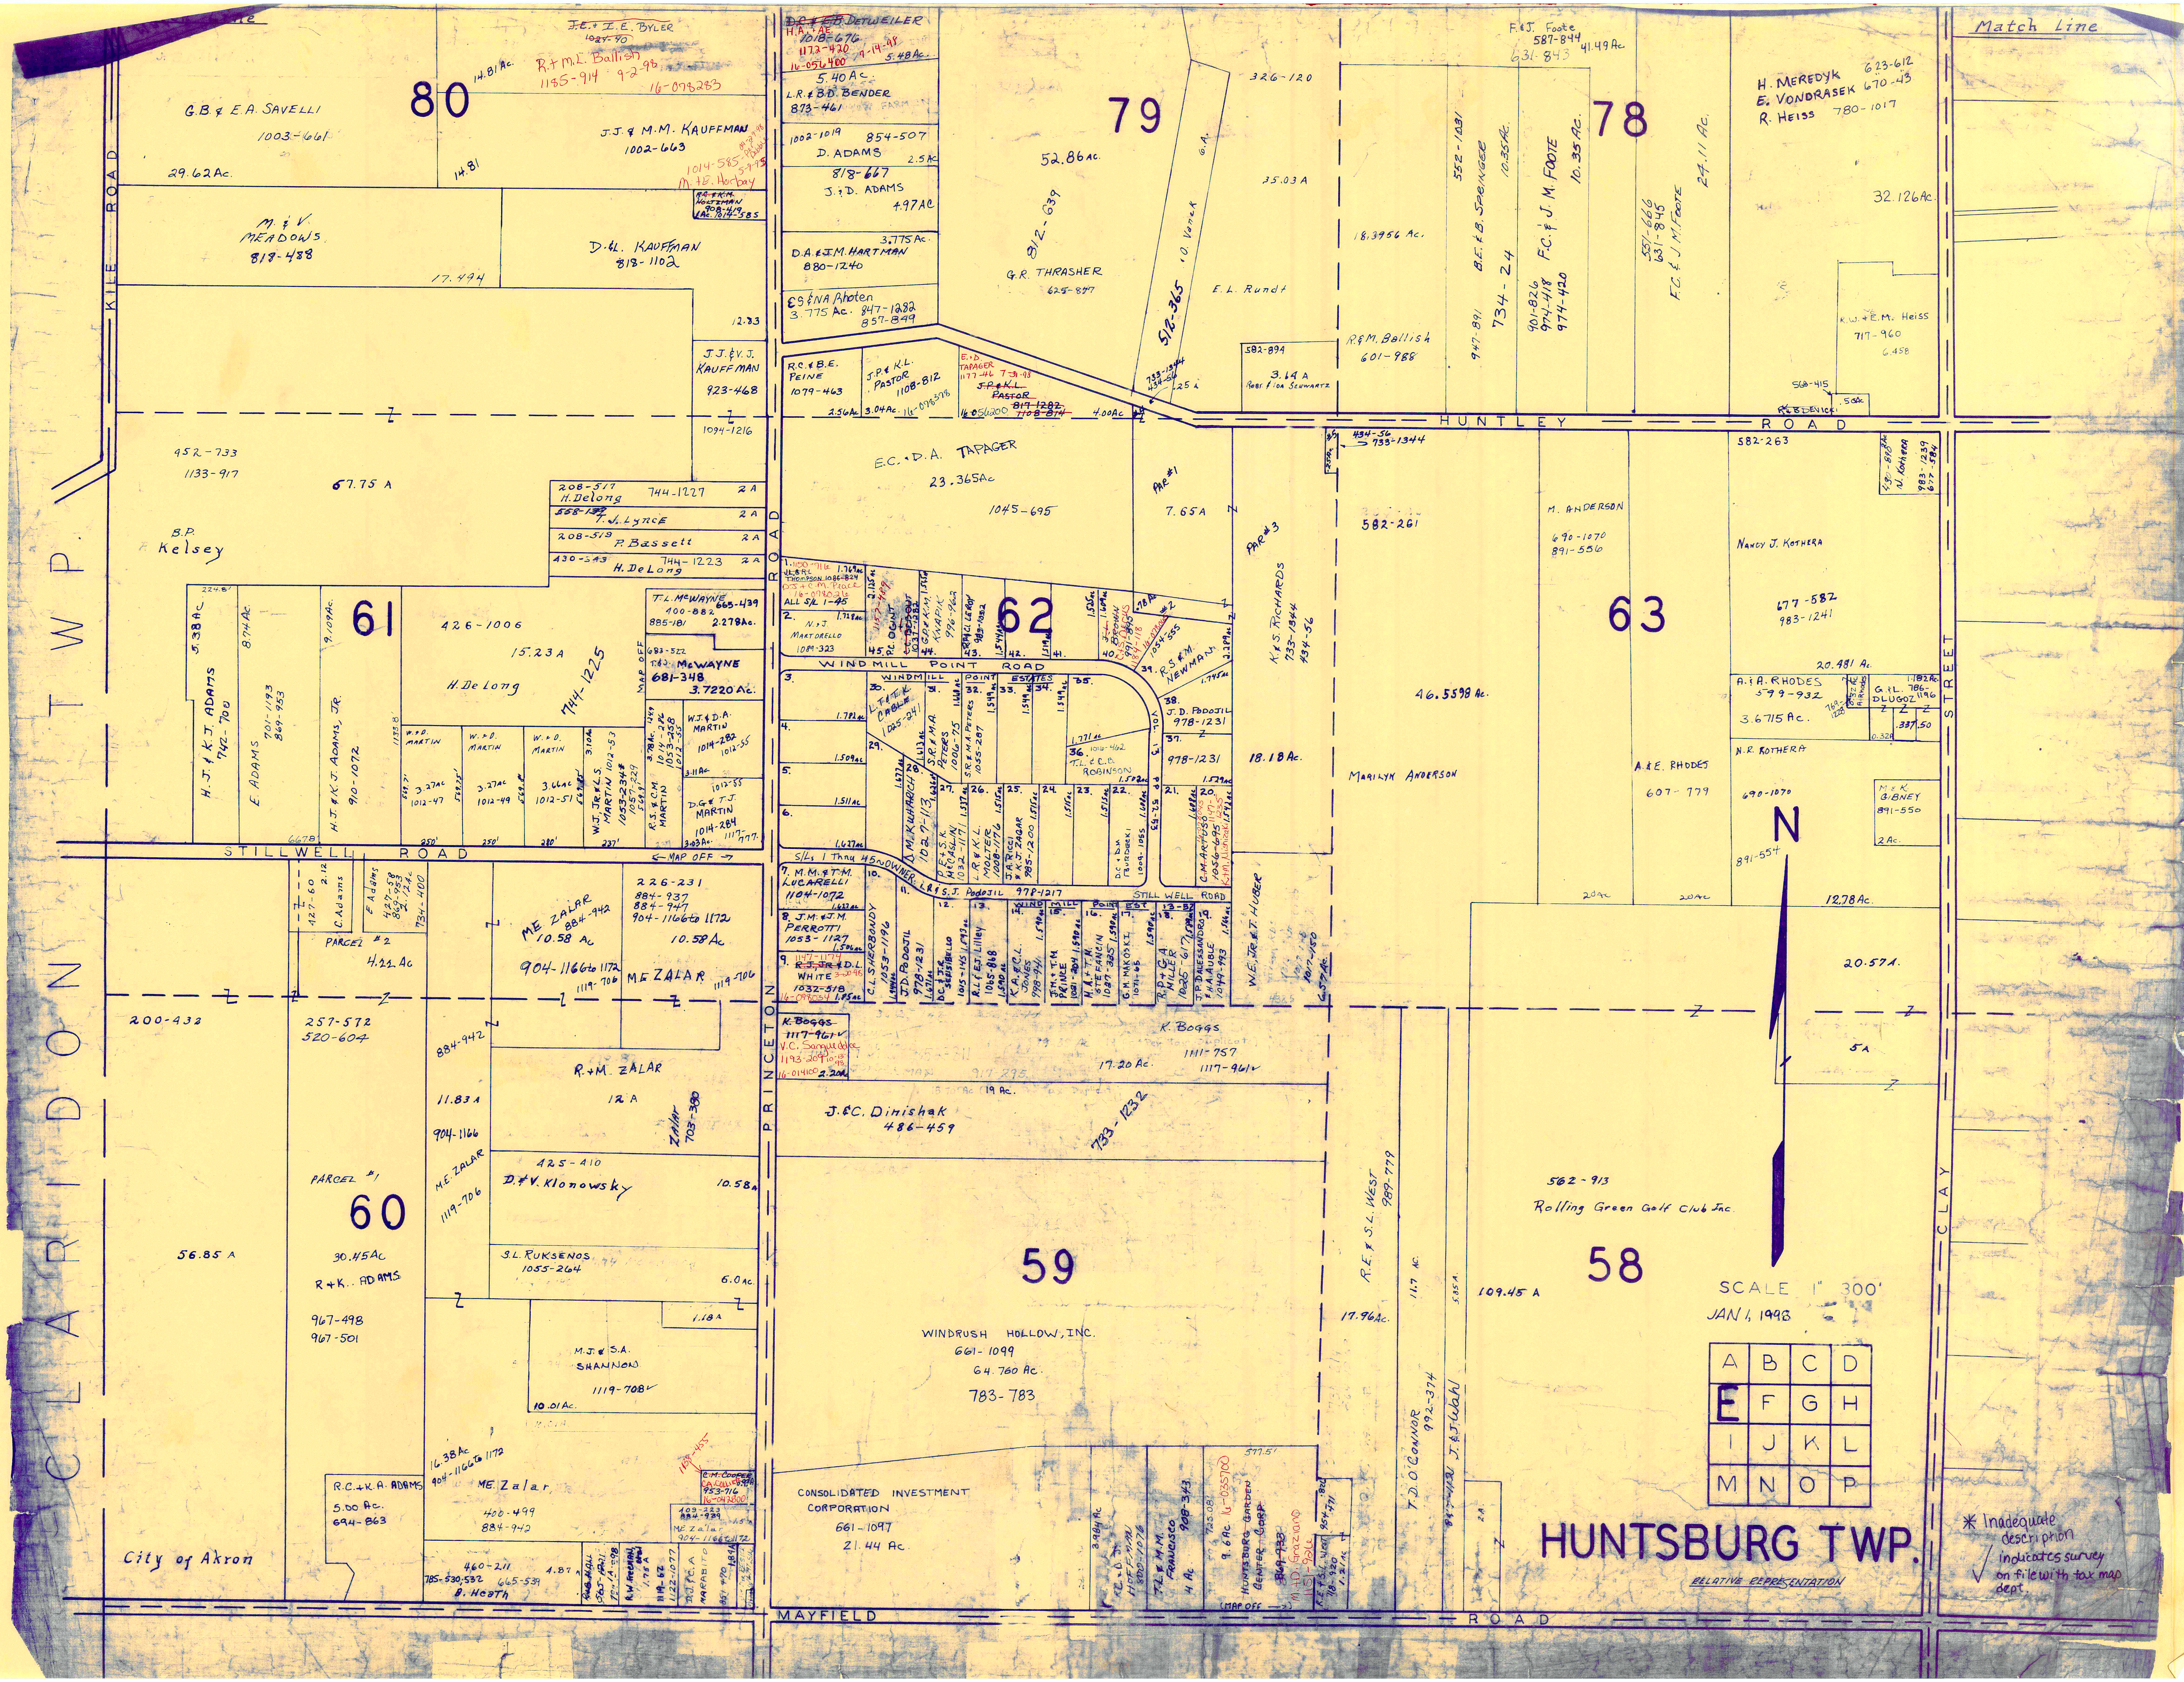
Match Line
80
79
78
61
62
63
60
59
58
KILE ROAD
CLARIDON TWP.
PRINCETON ROAD
HUNTLEY ROAD
STILLWELL ROAD
WINDMILL POINT ROAD
WINDMILL POINT ESTATES
MAYFIELD ROAD
CLAY STREET
MAP OFF
G.B. & E.A. SAVELLI 1003-661 29.62 Ac.
J.E. + I.E. BYLER 1024-90
R + M.L. Ballish 1135-914 9-2-98 16-078283
14.81 Ac.
J.J. & M.M. KAUFFMAN 1002-663
M. & V. MEADOWS 818-488
D. & L. KAUFFMAN 818-1102
17.494
J.J. & V.J. KAUFFMAN 923-468
1094-1216
452-733 1133-917
67.75 A
B.P. Kelsey
208-517 H. DeLong 744-1227 2 A
T.J. Lynce 2 A
208-513 P. Bassett 2 A
430-343 H. DeLong 744-1223 2 A
H.J. & K.J. ADAMS 742-700
E. ADAMS 701-1193 869-953
H.J. & K.J. ADAMS, JR. 910-1072
5.38 Ac
8.74 Ac
9.109 Ac
426-1006
15.23 A
H. De Long
744-1225
T.L. McWAYNE 665-439 400-882 885-181 2.278 Ac.
T.L. McWAYNE 681-348 3.7220 Ac.
W. + D. MARTIN
W.J. & V.L.S. MARTIN
W.J. & D.A. MARTIN 1014-282
D.G. & T.J. MARTIN 1014-284
R.S. & M. MARTIN
D.E. & E.B. DETWEILER
H.A. & A.E. 1018-676 1173-470 16-056400 9-14-98
5.40 Ac. 5.48 Ac.
L.R. & B.D. BENDER 873-461
1002-1019 854-507
D. ADAMS 818-667
J. & D. ADAMS 4.97 Ac
D.A. & J.M. HARTMAN 880-1240 3.775 Ac
E.S. & N.A. Rhoten 3.775 Ac. 847-1282 857-849
R.C. & B.E. PEINE 1079-463 2.56 Ac.
J.P. & K.L. PASTOR 1108-812 3.04 Ac.
E.D. TAPAGER 1177-46 7-31-98 16-056200
J.P. & K.L. PASTOR 817-1282 1108-814 4.00 Ac.
E.C. + D.A. TAPAGER 23.365 Ac 1045-695
52.86 Ac.
812-639
G.R. THRASHER 625-847
512-365
E.L. Rundt
326-120
35.03 A
7.65 A
PAR. #1
PAR. #3
K. & S. RICHARDS 733-1344 434-56
18.18 Ac.
F. & J. Foote 587-844 631-843 41.49 Ac.
18.3956 Ac.
B.E. & B. SPRINGER 552-1231 10.35 Ac.
F.C. & J.M. FOOTE 734-24 10.35 Ac.
901-826 974-418 974-420
R. & M. Ballish 601-988
F.C. & J.M. FOOTE 551-666 631-845 24.11 Ac.
582-894 3.14 A
H. MEREDYK 623-612
E. VONDRASEK 670-43
R. HEISS 780-1017
32.126 Ac.
K.W. & E.M. Heiss 717-960 6.458
568-415
582-261
582-263
M. ANDERSON 690-1070 891-556
46.5598 Ac.
Marilyn Anderson
Nancy J. Kothera 677-582 983-1241
20.481 Ac.
A. & A. RHODES 599-932 3.6715 Ac.
G.L. DLUGOZ
N.R. KOTHERA 690-1070
A. & E. RHODES 607-779
891-554
G.BNEY 891-550 2 Ac.
12.78 Ac.
20.57 A.
5 A
N
N.J. MARTORELLO 1011-323
L.F. & E.K. OBBLE 1025-241
R.S. & M. NEWMAN
J.D. Podojil 978-1231
T.L. & C.R. ROBINSON
C.M. ARTUSO
W.E. Jr. & E.T. HUBER
S/Ls 1 thru 45 OWNER: L.R. & S.J. Podojil 978-1217
T.M.M. & T.M. LUCARELLI 1104-1072
J.M. & J.M. PERROTTI 1053-1127
R.J. Jr. & D.L. WHITE 1032-518
C.L. SHERBONDY
J.D. Podojil 978-1231
K. Boggs 1117-961
V.C. Sangiuliano 1193-269 10-12-98 16-014100
K. BOGGS 1111-757 1117-961
17.20 Ac.
19 Ac.
J. & C. Dinishak 486-459
733-1232
226-231 884-937 884-947 904-1166 to 1172
M.E. ZALAR 884-942 10.58 Ac.
904-1166 to 1172 1119-706
M.E. ZALAR 10.58 Ac.
PARCEL #2 4.22 Ac.
427-60 C. Adams
F. Adams 427-58
734-400
200-432
257-572 520-604
884-942 11.83 A 904-1166
M.E. ZALAR 1119-706
R. + M. ZALAR 12 A
Zalar 703-380
425-410 D. & V. Klonowsky 10.58 Ac
S.L. RUKSENOS 1055-264 6.0 Ac
1.18 A
PARCEL #1
56.85 A
30.45 Ac R. + K. ADAMS 967-498 967-501
M.J. & S.A. SHANNON 1119-708
10.01 Ac.
16.38 Ac 904-1166 to 1172
M.E. Zalar 400-499 884-942
R.C. + K.A. ADAMS 5.00 Ac. 694-863
C.M. Cooper 983-716 16-047800
City of Akron
460-211 785-530, 582 665-539 B. Heath 4.87
WINDRUSH HOLLOW, INC. 661-1099 64.760 Ac. 783-783
CONSOLIDATED INVESTMENT CORPORATION 661-1097 21.44 Ac.
HUNTSBURG GARDEN CENTER CORP.
R.E. & S.L. WEST 989-779
17.96 Ac.
T.D. O'CONNOR 992-374
J. & E.J. Wahl
562-913 Rolling Green Golf Club Inc.
109.45 A
SCALE 1" 300'
JAN 1, 1998
A B C D
E F G H
I J K L
M N O P
HUNTSBURG TWP.
RELATIVE REPRESENTATION
* Inadequate description
✓ indicates survey on file with tax map dept.

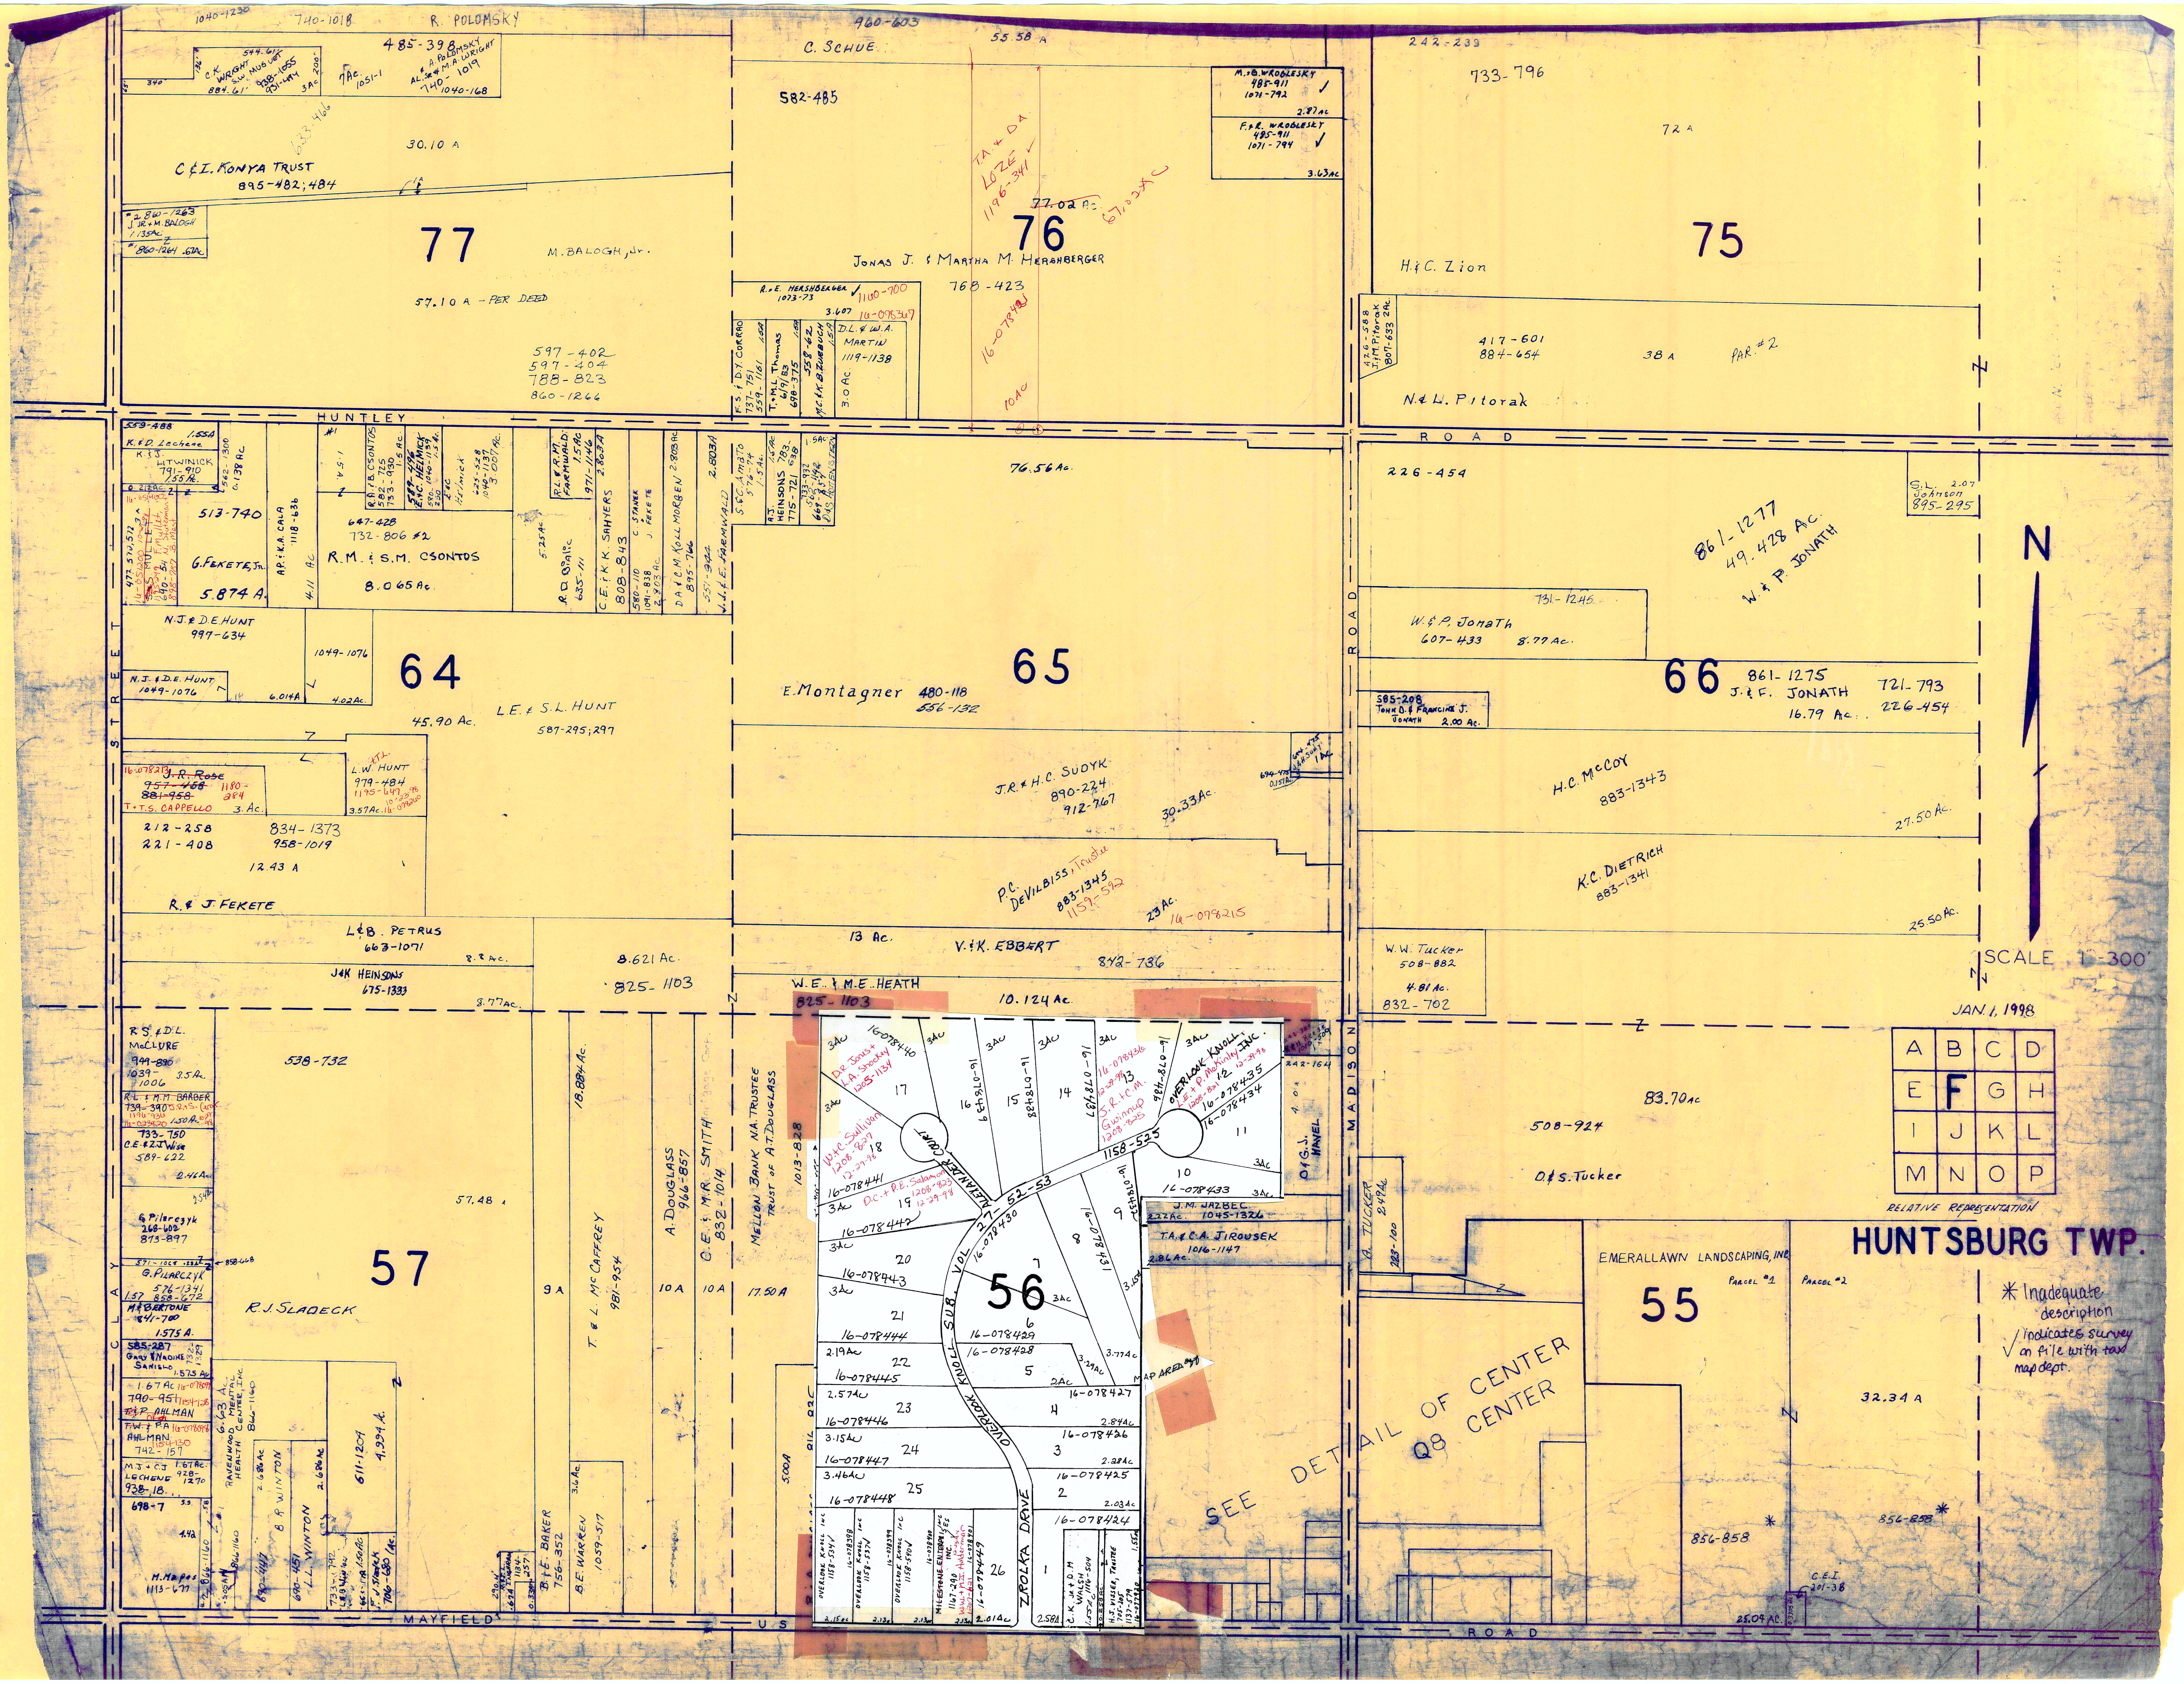
HUNTSBURG TWP.
JAN. 1, 1998
SCALE 1"-300'
N
A B C D
E F G H
I J K L
M N O P
RELATIVE REPRESENTATION
* Inadequate description
✓ indicates survey on file with tax map dept.
HUNTLEY ROAD
MADISON ROAD
CLAY STREET
MAYFIELD ROAD
US
77
76
75
64
65
66
57
56
55
R. POLOMSKY
740-1018
1040-1230
485-398
A. POLOMSKY AL. SR. & M.A. WRIGHT
740-1019
1040-168
C.K. WRIGHT
S.W. MUGUET
884.61'
938-1055
931-494
3 Ac
7 Ac.
1051-1
633-466
30.10 A
C & I. KONYA TRUST
895-482; 484
J. JR. & M. BALOGH
1.135 Ac
860-1263
860-1264 .67 Ac
M. BALOGH, Jr.
57.10 A - PER DEED
597-402
597-404
788-823
860-1266
C. SCHUE
960-603
55.58 A
582-485
M. & B. WROBLESKY
485-911
1071-792
2.87 Ac
F. & R. WROBLESKY
485-911
1071-794
3.63 Ac
T.A. & D.A. LOZE
1196-341
~~77.02 Ac.~~
67.02 Ac
Jonas J. & Martha M. Hershberger
768-423
16-078431
10 Ac
R. & E. HERSHBERGER
1073-73
1160-700
16-078347
3.607
D.L. & W.A. MARTIN
1119-1138
3.0 Ac.
F.S. & D.Y. CORRAO
737-751
559-1161
T. & M.L. Thomas
6/9/83
698-375
558-62
M.C. & K.B. ZURBUCH
242-239
733-796
72 A
H. & C. Zion
426-588
J. & M. Pitorak
807-633 2 Ac.
417-601
884-654
38 A
PAR. #2
N. & L. Pitorak
559-488
1.55 A
K. & D. Lechene
K. & J. LITWINICK
791-910
1.55 Ac.
562-1300
0.138 Ac
0.212 Ac.
513-740
G. FEKETE, Jr.
5.874 A
R.A. & B. CSONTOS
582-725
733-930
589-496
E. & C. HELMICK
1040-1139
3.007 Ac.
647-428
732-806 #2
R.M. & S.M. CSONTOS
8.065 Ac.
R.L. & R.M. FARMWALD
1.5 Ac
971-1146
2.803 A
C.E. & K.K. SAHYERS
808-843
S. & C. Amato
576-74
A.J. HEINSONS
783-
775-721
76.56 Ac.
N.J. & D.E. HUNT
997-634
1049-1076
6.014 A
4.02 Ac.
45.90 Ac.
L.E. & S.L. HUNT
587-295; 297
J. R. Rose
~~957-468~~
~~881-958~~
1180-284
T. & T.S. CAPPELLO
3 Ac.
16-078219
L.W. HUNT
979-484
3.57 Ac.
212-258
221-408
834-1373
958-1019
12.43 A
R. & J. FEKETE
L & B. PETRUS
663-1071
J & K HEINSONS
675-1333
8.77 Ac.
8.621 Ac.
825-1103
E. Montagner
480-118
556-132
J.R. & H.C. SUDYK
890-224
912-767
30.33 Ac.
P.C. DEVILBISS, Trustee
883-1345
1159-542
23 Ac.
14-078215
13 Ac.
V. & K. EBBERT
842-736
W.E. & M.E. HEATH
10.124 Ac.
226-454
S.L. Johnson
2.07
895-295
861-1277
49.428 Ac.
W. & P. JONATH
731-1245
W. & P. Jonath
607-433
8.77 Ac.
585-208
John G. & Francine J. Jonath
2.00 Ac.
861-1275
J. & F. JONATH
16.79 Ac.
721-793
226-454
H.C. McCOY
883-1343
27.50 Ac.
K.C. DIETRICH
883-1341
25.50 Ac.
W.W. Tucker
508-882
4.81 Ac.
832-702
R.S. & D.L. McCLURE
538-732
57.48
R.J. SLADECK
G. Pilarczyk
GAVENWOOD MENTAL HEALTH CENTER, INC
B.R. WINTON
L.L. WINTON
611-1271
4.394 Ac
T & L McCAFFREY
981-954
B. & E. BAKER
756-352
B.E. WARREN
1059-517
18.884 Ac.
9 A
A. DOUGLASS
966-857
10 A
C.E. & M.R. SMITH
832-1014
MELLON BANK NA TRUSTEE TRUST of A.T. DOUGLASS
1013-828
17.50 A
M.J. & C.J. LECHENE
OVERLOOK KNOLL SUB. VOL. 27 PG. 52-53
OVERLOOK KNOLL, INC.
ALEXANDER COURT
ZROLKA DRIVE
1158-525
MAP AREA
16-078440
16-078441
16-078442
16-078443
16-078444
16-078445
16-078446
16-078447
16-078448
16-078449
16-078424
16-078425
16-078426
16-078427
16-078428
16-078429
16-078430
16-078433
16-078434
16-078435
16-078436
J.M. JAZBEC
1045-1326
T.A. & C.A. JIROUSEK
1016-1147
D. & G.J. HAVEL
242-164
SEE DETAIL OF CENTER
Q8 CENTER
508-924
83.70 Ac
D. & S. Tucker
A. TUCKER
2.49 Ac
223-100
EMERALLAWN LANDSCAPING, INC
Parcel #1
Parcel #2
32.34 A
856-858
C.E.I.
201-38
25.04 Ac.

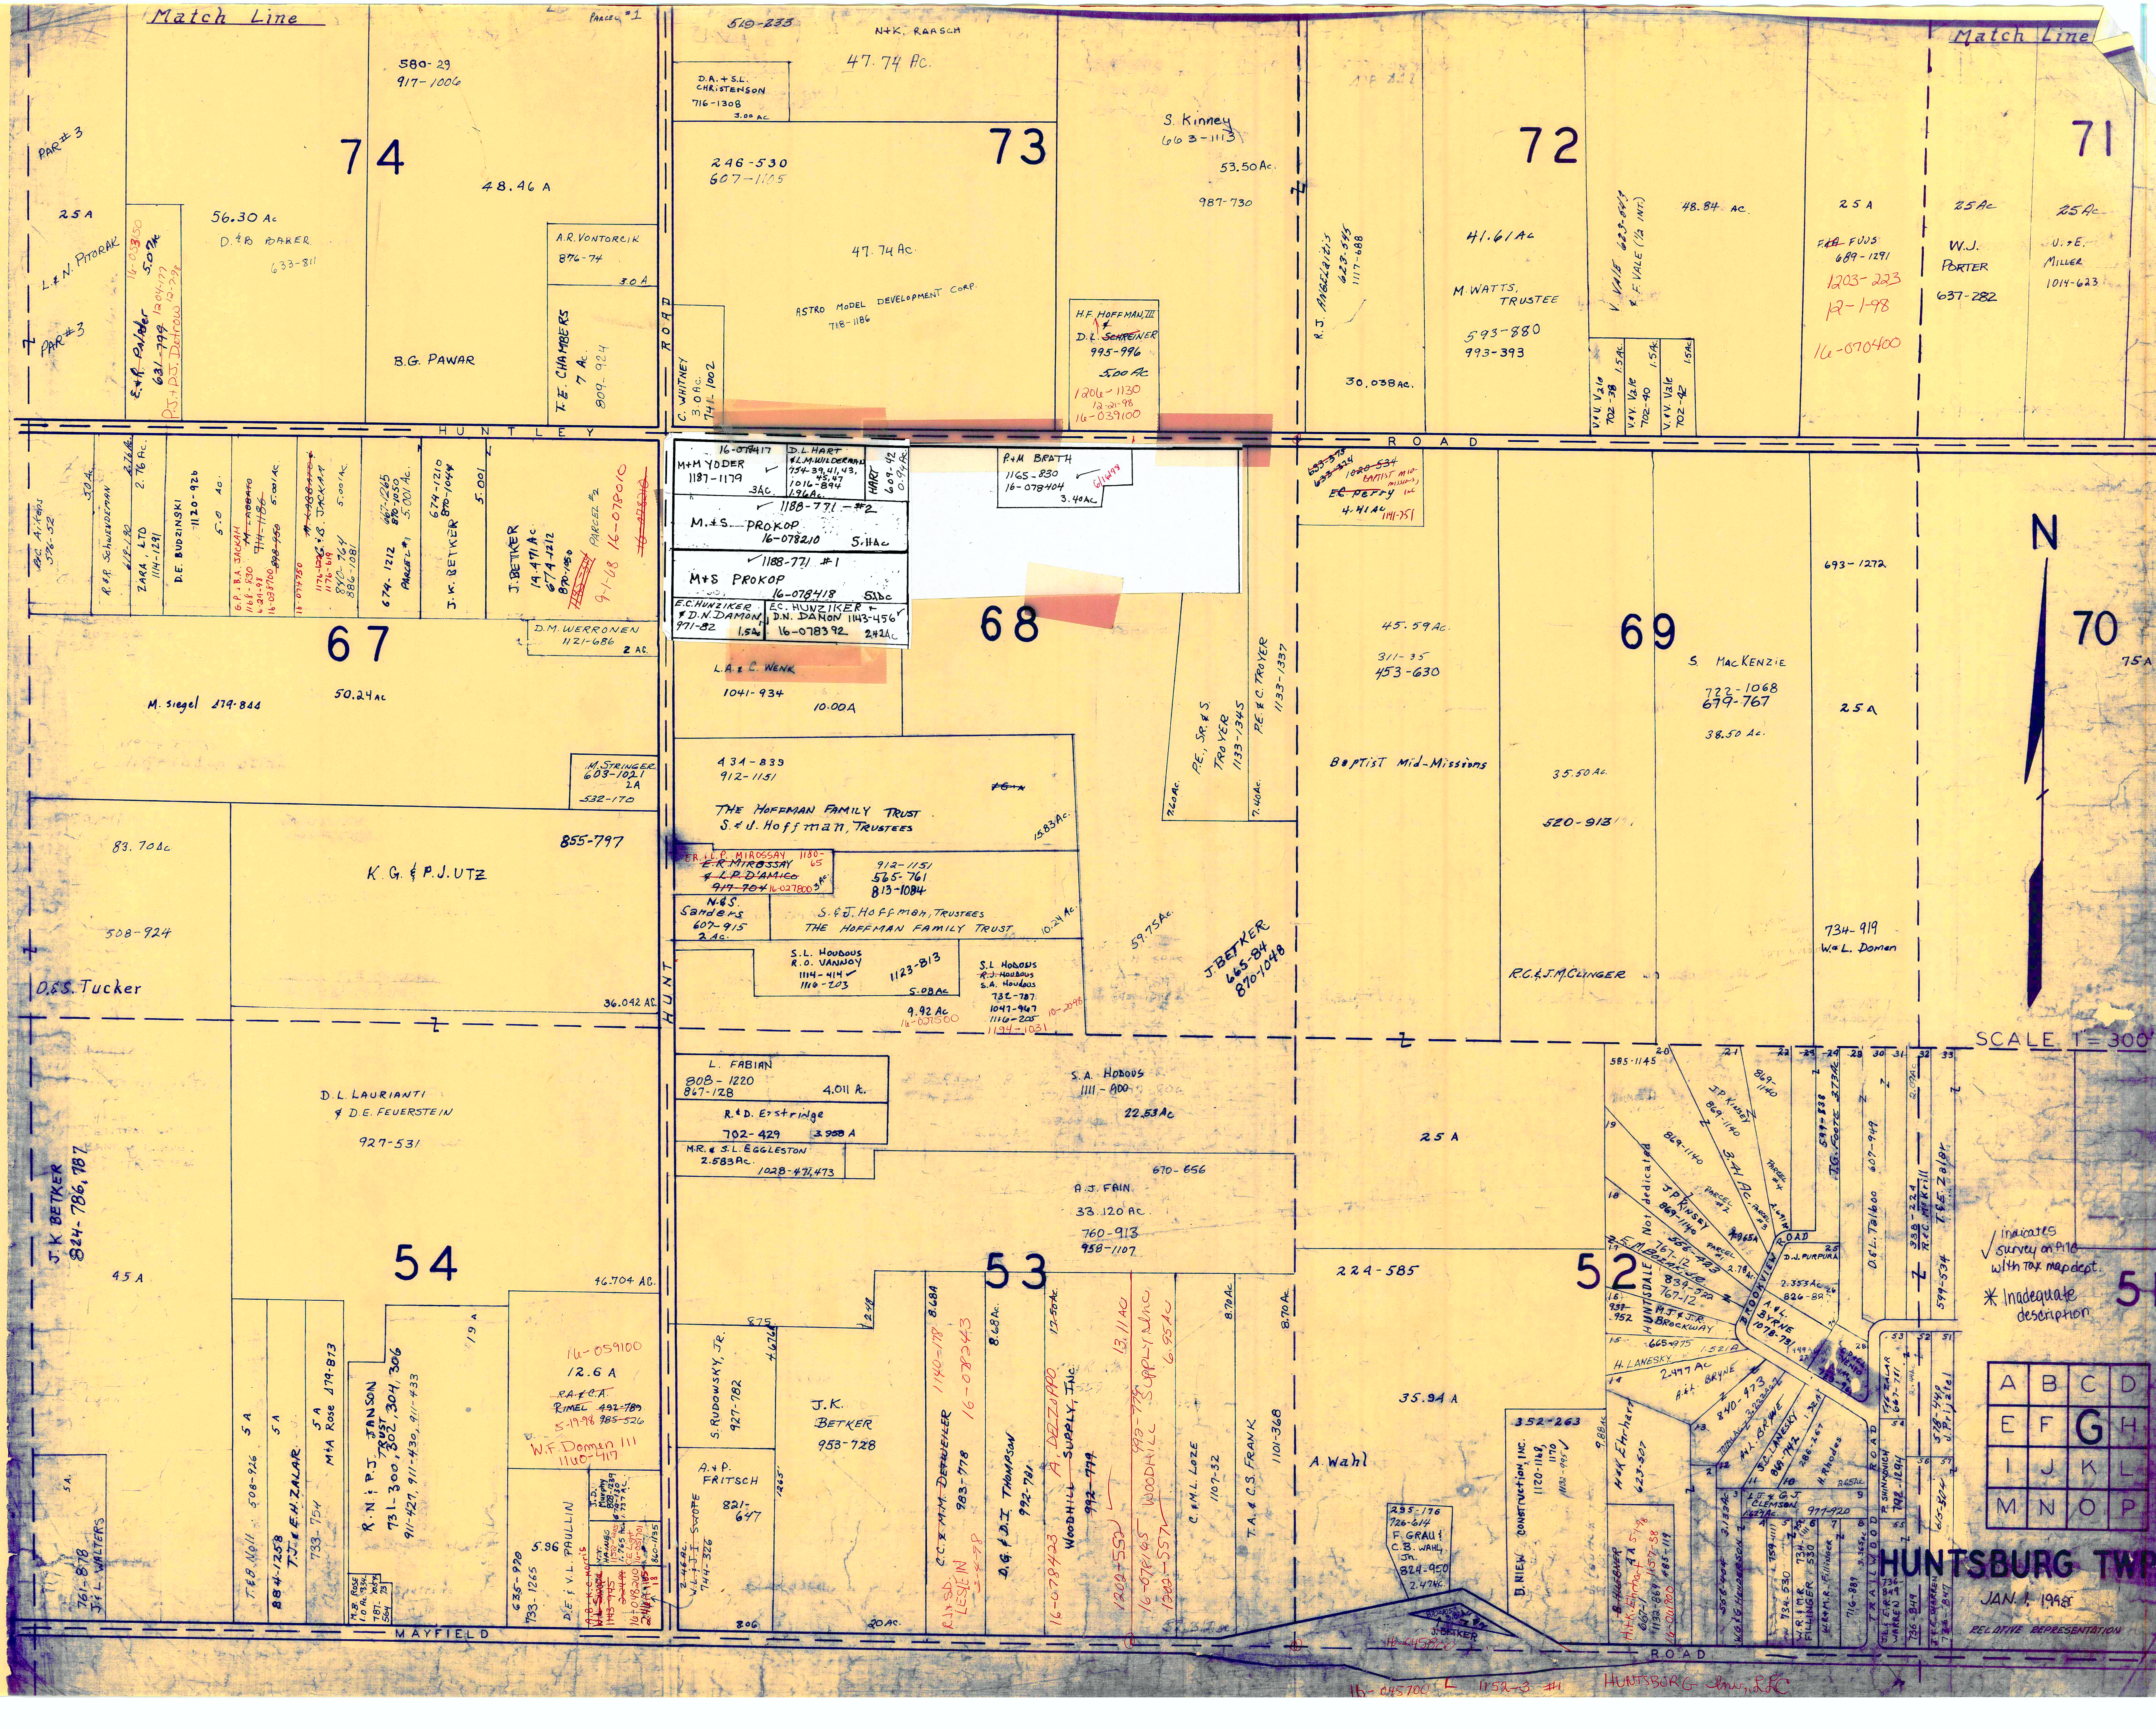
Match Line
Match Line
74
73
72
71
67
68
69
70
54
53
52
HUNTLEY ROAD
HUNT ROAD
MAYFIELD ROAD
BROOKVIEW ROAD
TRAILWOOD ROAD
N
SCALE 1"=300'
√ indicates survey on file with tax map dept.
* Inadequate description
A B C D
E F G H
I J K L
M N O P
HUNTSBURG TWP
JAN. 1, 1995
RELATIVE REPRESENTATION
PAR # 3
25 A
L. & N. PITORAK
56.30 Ac
D. & B. BAKER
633-811
580-29
917-1006
48.46 A
A.R. VONTORCIK
876-74
3.0 A
T.E. CHAMBERS
7 Ac.
809-924
B.G. PAWAR
C. WHITNEY
3.0 Ac.
741-1002
610-233
N+K. RAASCH
47.74 Ac.
D.A. + S.L. CHRISTENSON
716-1308
3.00 AC
246-530
607-1105
47.74 Ac
ASTRO MODEL DEVELOPMENT CORP.
718-1186
S. Kinney
663-1113
53.50 Ac.
987-730
H.F. HOFFMAN, III
D.L. SCHREINER
995-996
5.00 Ac
1206-1130
12-21-98
16-039100
R.J. ANGELIDIS
623-545
1117-688
30.038 Ac.
41.61 Ac
M. WATTS, TRUSTEE
593-880
993-393
V. VALE
F. VALE (1/2 INT.)
48.84 Ac.
25 A
F.E. FUJS
689-1291
1203-223
12-1-98
16-070400
25 Ac
W.J. PORTER
637-282
25 Ac.
U. + E. MILLER
1014-623
D.E. BUDZINSKI
1120-926
ZARA, LTD
114-1291
J.K. BETKER
674-1212
J. BETKER
14.471 Ac
674-1212
PARCEL #2
9-1-98 16-078010
M+M YODER
1187-1179
D.L. HART
1188-771 #2
M.+S. PROKOP
16-078210
5.11 Ac
1188-771 #1
M+S PROKOP
16-078418
5.11 Ac
E.C. HUNZIKER + D.N. DAMON
971-82
E.C. HUNZIKER + D.N. DAMON
1143-456
16-078392
2.42 Ac
P+M BRATH
1165-830
16-078404
3.40 Ac.
E.C. PERRY
4.41 Ac.
D.M. WERRONEN
1121-686
2 AC
50.24 Ac
M. Siegel 279-844
L.A. + C. WENK
1041-934
10.00 A
434-839
912-1151
THE HOFFMAN FAMILY TRUST
S. + J. Hoffman, TRUSTEES
P.E., SR. + S. TROYER
1133-1345
P.E. + C. TROYER
1133-1337
45.59 Ac.
311-35
453-630
Baptist Mid-Missions
35.50 Ac.
520-913
S. MacKENZIE
722-1068
679-767
38.50 Ac.
25 A
693-1272
75 A
M. STRINGER
603-1021
2 A
532-170
83.70 Ac
K.G. & P.J. UTZ
855-797
508-924
D.&S. Tucker
36.042 AC
E.R. MIROSSAY + L.P. D'AMICO
16-027800
N.&S. Sanders
607-915
2 Ac.
912-1151
565-761
813-1084
S.+J. Hoffman, TRUSTEES
THE HOFFMAN FAMILY TRUST
10.24 Ac
S.L. Houdous
R.O. VANNOY
1114-414
1110-203
1123-813
5.08 Ac
9.92 Ac
S.L. Hodous
S.A. Houdous
732-787
1047-967
1116-205
1194-1031
59.75 Ac.
J. BETKER
665-84
870-1048
734-919
W.+L. Doman
R.C. + J.M. CLINGER
L. FABIAN
808-1220
867-128
4.011 A.
R.+D. Erstringer
702-429
3.958 A
M.R. + S.L. EGGLESTON
2.583 Ac.
1028-471,473
S.A. HODOUS
1111-800
22.53 Ac
A.J. FAIN
670-656
33.120 Ac.
760-913
958-1107
25 A
224-585
35.94 A
A. Wahl
D.L. LAURIANTI & D.E. FEUERSTEIN
927-531
J.K. BETKER
824-786, 787
45 A
46.704 AC.
16-059100
12.6 A
RIMEL 492-789
985-526
W.F. Doman III
1140-417
19 A
R.N. + P.J. JANSON
731-300, 302, 304, 306
911-421, 911-430, 911-433
M+A Rose 279-873
T.J. & E.H. ZALAR
884-1258
733-754
T.&B. Noll
508-926
J+L WALTERS
761-878
5 A
D.E. + V.L. PAULLIN
735-970
733-1265
5.96
S. RUDOWSKY, Jr.
927-782
A. + P. FRITSCH
821-647
J.K. BETKER
958-728
C.C. + M.M. DETWEILER
983-778
16-078443
D.G. + D.J. THOMPSON
992-791
WOODHILL SUPPLY, INC.
992-779
13.11 Ac
6.95 Ac
C. + M.L. LOZE
1107-32
T.A. + C.S. FRANK
1101-368
8.70 Ac
352-263
B. NIEW CONSTRUCTION, INC.
1120-1168
C.B. WAHL, Jr.
824-950
H+K Ehrhard
623-827
J.P. KINSEY
869-1140
HUNTSDALE
M.J. + J.R. BROCKWAY
H. LANESKY
A.L. BYRNE
D.L. Talbot
607-949
J.G. FOOTE
T.E. Zalar
16-048700
HUNTSBURG

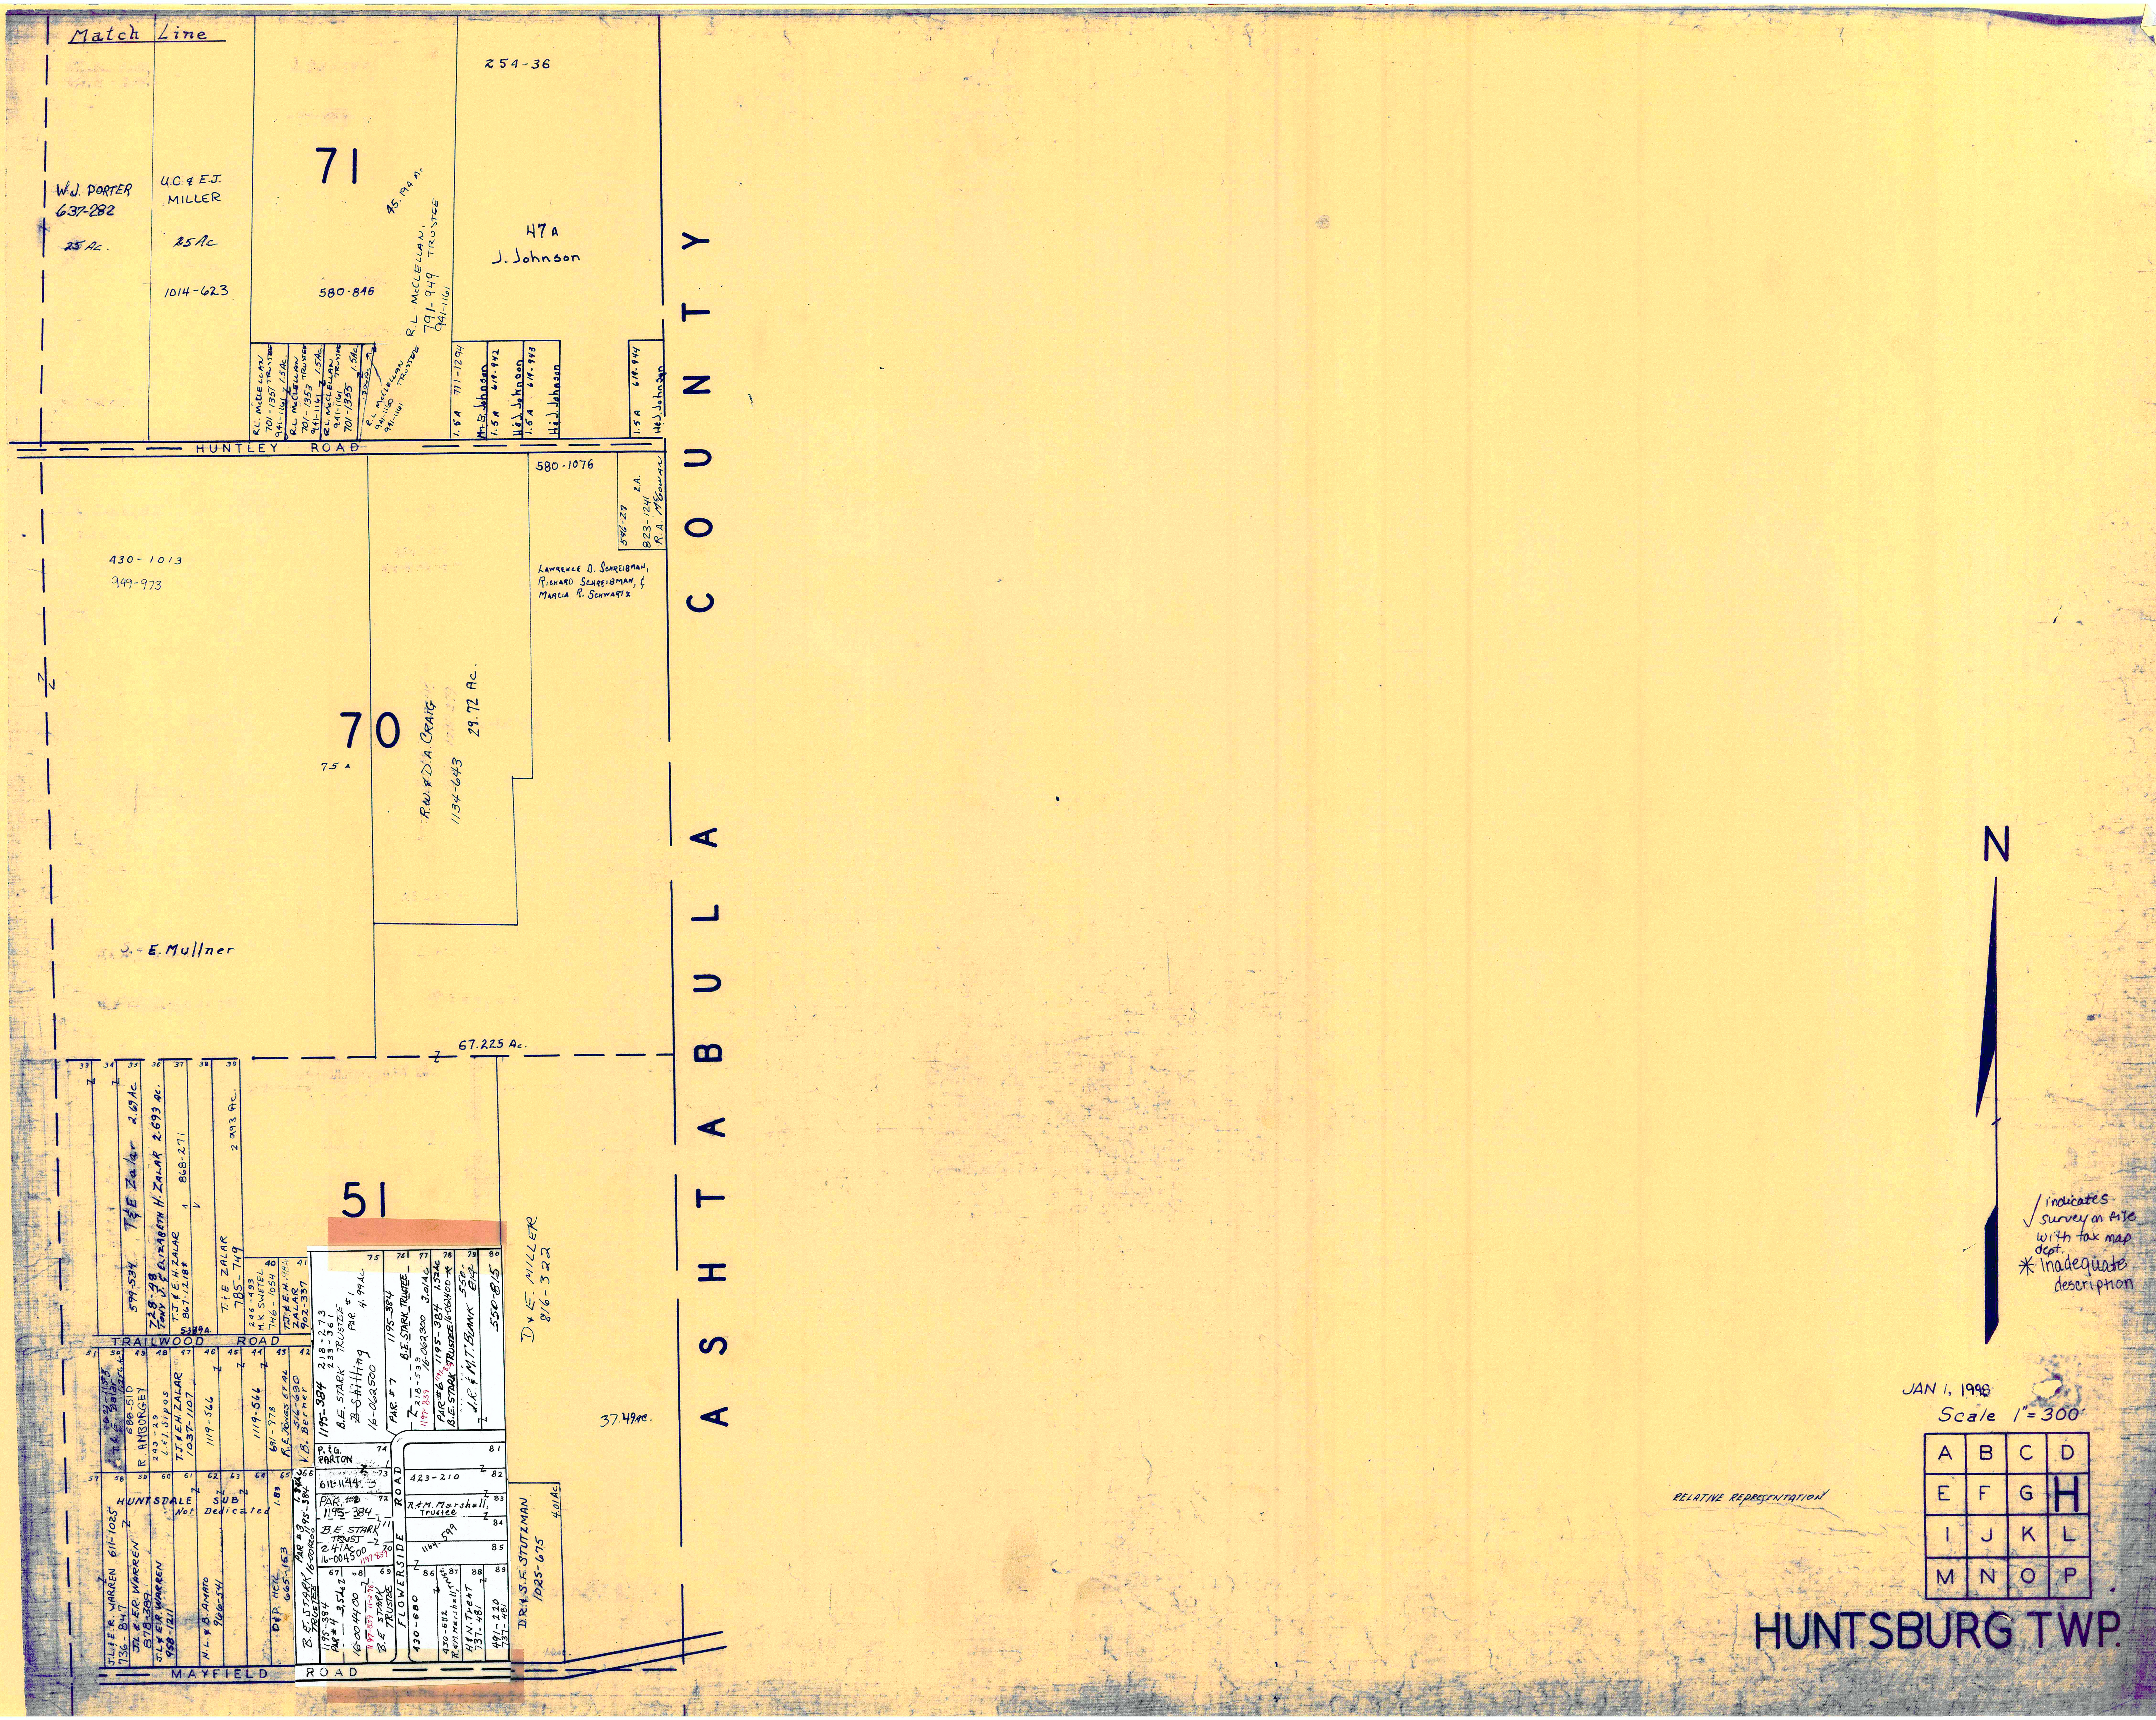
Match Line
W.J. PORTER
637-282
25 Ac.
U.C. & E.J. MILLER
25 Ac.
1014-623
71
580-846
45.94 Ac.
R.L. McCLELLAN TRUSTEE
791-949
941-1161
254-36
47 A
J. Johnson
R.L. McCLELLAN TRUSTEE 701-1351 941-1161 1.5 Ac.
R.L. McCLELLAN TRUSTEE 701-1353 941-1161 1.5 Ac.
R.L. McCLELLAN TRUSTEE 941-1161 701-1355 1.5 Ac.
.30 Ac.
R.L. McCLELLAN TRUSTEE 941-1160 941-1161
1.5 A 711-1294 M+B Johnson
1.5 A 619-942 H&J Johnson
1.5 A 619-943 H&J Johnson
1.5 A 619-944 H&J Johnson
HUNTLEY ROAD
580-1076
596-27
823-1241
2 A.
R.A. McGowan
430-1013
999-973
Lawrence D. Schreibman, Richard Schreibman, & Marcia R. Schwartz
70
75 A
R.W. & D.A. CRAIG
1134-643
29.72 Ac.
E. Mullner
67.225 Ac.
ASHTABULA COUNTY
33
34
35
36
37
38
39
T&E Zalar 2.69 Ac
599-534
728-98
TONY J. & ELIZABETH H. ZALAR 2.693 Ac.
T.J. & E.H. ZALAR 867-1218*
868-271
T. & E. ZALAR 785-749
2.993 Ac.
5.389 A.
40
246-493 M.K. SWETEL 746-1054
41
T.J. & E.H. ZALAR 902-337
.98 Ac.
TRAILWOOD ROAD
51
50
49
48
47
46
45
44
43
42
T.&E. Zalar 622-1153 1.256 Ac.
688-510 R. ANBURGEY
293-29 L.&I. Sipos
T.J. & E.H. ZALAR 1037-1107
1119-566
1119-566
691-978 R.E. JONES ET AL
516-690 V.B. Berner
51
75
76
77
78
79
80
1195-384
218-273
233-361
B.E. STARK TRUSTEE
PAR. #1 4.99 AC
~~B. Shilling~~
16-062500
PAR. #7
1195-384
B.E. STARK TRUSTEE
218-539
1197-839
16-062300
3.01 AC
PAR. #6
1195-384
1197-839
B.E. STARK TRUSTEE
16-062400 *
1.52 AC
550-814
J.R. & M.T. BLANK
550-815
D. & E. MILLER
816-322
P. & G. PARTON
74
73
611-1144
PAR. #2
1195-384
72
71
B.E. STARK TRUST
2.41 AC
16-004500
1197-839
70
FLOWERSIDE ROAD
81
423-210
82
83
R. & M. Marshall, Trustee
84
1164-599
85
86
430-680
87
430-682 R. & M. Marshall, Trust.
88
H. & N. Trent 737-481
89
491-220 737-481
37.49 Ac.
57
58
59
60
61
62
63
64
65
66
HUNTSDALE SUB Not Dedicated
J.L. & E.R. WARREN 611-1025 736-847
J.L. & E.R. WARREN 878-389
J.L. & E.R. WARREN 958-1211
N.L. & B. AMATO 966-541
1.83
D. & P. HEIL 665-153
1.84 AC
PAR #3 1195-384 16-004200
B.E. STARK TRUSTEE
1195-384 PAR #4 3.54 AC
16-004400
67
68
69
1197-839 11-2-98
B.E. STARK TRUSTEE
DR. & S.F. STUTZMAN 1025-675
4.01 Ac.
MAYFIELD ROAD
N
√ indicates survey on file with tax map dept.
* Inadequate description
RELATIVE REPRESENTATION
JAN 1, 1998
Scale 1" = 300'
A B C D
E F G H
I J K L
M N O P
HUNTSBURG TWP.

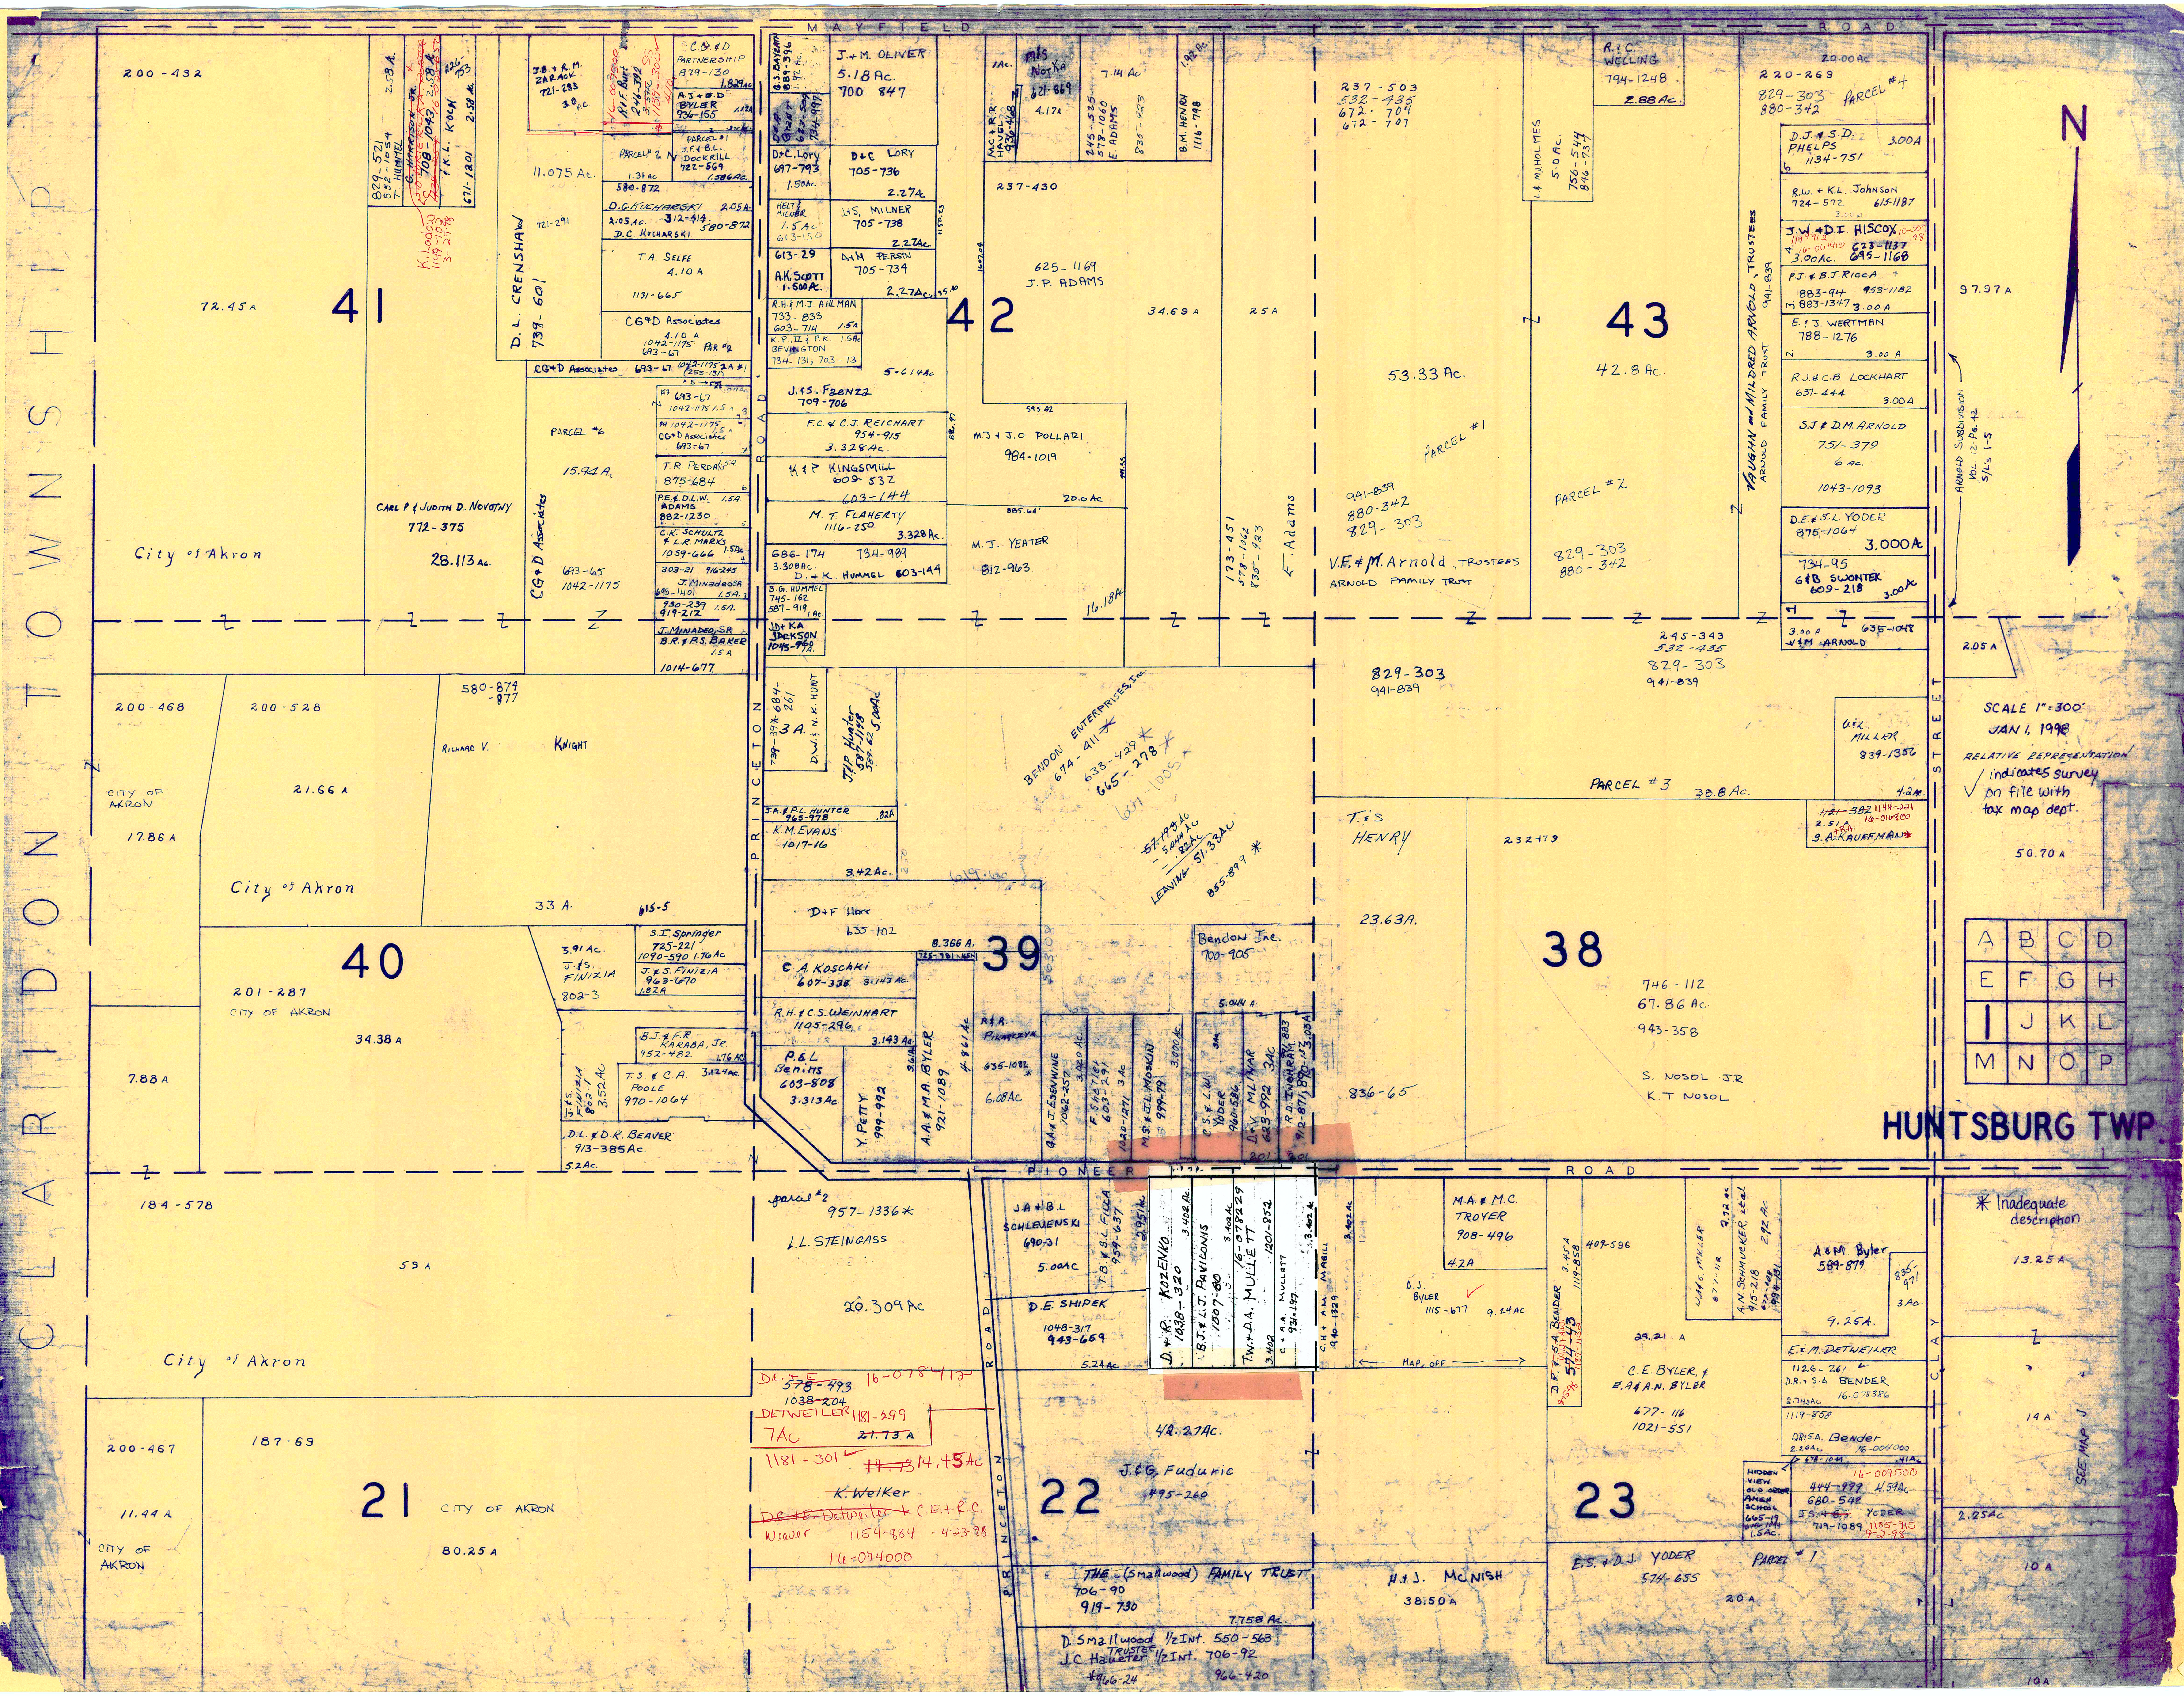
MAYFIELD ROAD
CLARIDON TOWNSHIP
HUNTSBURG TWP.
PRINCETON ROAD
PIONEER ROAD
CLAY STREET
N
SCALE 1" = 300'
JAN 1, 1998
RELATIVE REPRESENTATION
✓ indicates survey on file with tax map dept.
* Inadequate description
A B C D
E F G H
I J K L
M N O P
SEE MAP J
41
200-432
72.45 A
City of Akron
829-521 852-1054 T. HUMMEL 2.58 A.
G. HARRISON JR. 708-1043 2.58 A.
K. Ladow 1149-103 3-27-98
F.K.L. KOCH 671-1201 2.58 A.
1126-753
J.B. & R.M. ZARACK 721-283 3.0 AC.
16-007500 R.F. Burt 246-392 3.59 AC 1139-300 4/10
C.G. & D PARTNERSHIP 879-130 1.829 AC
A.J. & E.D BYLER 936-155 1.12 A
PARCEL #1 J.F. & B.L. DOCKRILL 722-569 1.586 AC.
PARCEL #2 N 1.31 AC
11.075 Ac.
580-872
D.G. KUCHARSKI 2.05 A.
2.05 AC. 312-414 580-872 D.C. KUCHARSKI
721-291
D. L. CRENSHAW 739-601
T.A. SELFE 4.10 A 1131-665
CG & D Associates 4.10 A 1042-1175 693-67 PAR. #2
CG & D Associates 693-67 1042-1175 2A #1 (255-131)
#3 693-67 1042-1175 1.5 A
#4 1042-1175 CG & D Associates 693-67 1.5 A
PARCEL #6 15.94 A.
CARL P. & JUDITH D. NOVOTNY 772-375 28.113 Ac.
CG & D Associates 693-65 1042-1175
T.R. PERDAN 875-684 1.5 A.
P.E. & D.L.W. ADAMS 882-1230 1.5 A.
C.K. SCHULTZ & L.R. MARKS 1059-666 1.5 Ac
303-21 916-245 J. Minadeo SR 695-1401 1.5 A.
930-239 919-212 1.5 A.
J. MINADEO, SR B.R. & P.S. BAKER 1.5 A 1014-677
42
G.S. DAYZATH 889-396 1.92 Ac.
D & P GRANT 623-509 734-997
J. & M. OLIVER 5.18 Ac. 700 847
D & C. Lory 697-793 1.50 Ac
D & C LORY 705-736 2.27 A
HELT & MILNER 1.5 Ac 613-150
J. & S. MILNER 705-738 2.27 Ac.
613-29 A.K. SCOTT 1.500 Ac.
A & M PERSIN 705-734 2.27 Ac.
R.H. & M.J. AHLMAN 733-833 603-714 1.5 A
K.P. II & P.K. BEVINGTON 734-131; 703-73 1.5 Ac
5.614 Ac
J. & S. FRENZA 709-706
F.C. & C.J. REICHART 954-915 3.328 Ac.
K & P KINGSMILL 609-532 603-144
M. T. FLAHERTY 1116-250 3.328 Ac.
686-174 3.308 Ac. 734-989 D. & K. HUMMEL 603-144
B.G. HUMMEL 745-162 587-919 1 Ac.
JD & KA JACKSON 1045-960 1 A.
M.C. & R.R. HAVEL 936-468
M/S NORKA 621-869 4.17 A 1 Ac.
7.14 Ac 245-525 578-1060 E. ADAMS 835-923
B.M. HENRY 1116-798 1.92 Ac.
237-430
625-1169 J.P. ADAMS
34.69 A
25 A
M.J. & J.O POLLARI 984-1019 20.0 Ac
M.J. YEATER 812-963 16.18 Ac
173-451 578-1062 835-923 E. Adams
43
237-503 532-435 672-704 672-707
53.33 Ac.
PARCEL #1
941-839 880-342 829-303
V.F. & M. Arnold, TRUSTEES ARNOLD FAMILY TRUST
L. & M.J. HOLMES 5.0 Ac. 756-544 846-737
R. & C. WELLING 794-1248 2.88 Ac.
42.8 Ac.
PARCEL #2 829-303 880-342
VAUGHN and MILDRED ARNOLD, TRUSTEES ARNOLD FAMILY TRUST 941-839
20.00 Ac 220-269 829-303 880-342 PARCEL #4
D.J. & S.D. PHELPS 1134-751 3.00 A
R.W. & K.L. Johnson 724-572 615-1187 3.00 A
J.W. & D.I. HISCOX 1194-912 16-061910 10-20-98 623-1137 695-1168 3.00 Ac.
P.J. & B.J. RICCA 883-94 953-1182 883-1347 3.00 A
E. & J. WERTMAN 788-1276 3.00 A
R.J. & C.B. LOCKHART 637-444 3.00 A
S.J & D.M. ARNOLD 751-379 6 Ac. 1043-1093
D.E. & S.L. YODER 875-1064 3.000 Ac
734-95 G & B SWONTEK 609-218 3.00 Ac
3.00 A 635-1048 V & M ARNOLD
ARNOLD SUBDIVISION VOL. 12-Pg. 42 S/L's 1-5
97.97 A
2.05 A
40
200-468
CITY OF AKRON 17.86 A
200-528 21.66 A City of Akron
580-874 -877 RICHARD V. KNIGHT 33 A.
615-5
7.88 A
201-287 CITY OF AKRON 34.38 A
3.91 Ac. J. & S. FINIZIA 802-3
S.I. Springer 725-221 1090-590 1.76 Ac
J. & S. FINIZIA 963-670 1.82 A
B.J. & F.R. KARABA, JR. 952-482 1.76 AC
T.S. & C.A. POOLE 970-1064 3.124 Ac.
J. & S. FINIZIA 802-1 3.52 AC
D.L. & D.K. BEAVER 913-385 Ac. 5.2 Ac.
39
739-39* 684-261 3 A. D.W. & N.K. HUNT
J. & P Hunter 587-1198 589-62 5.00 Ac
J.A. & P.L. HUNTER 965-978 .82 A
K.M. EVANS 1017-16 3.42 Ac.
BENDON ENTERPRISES, Inc. 674-411* 633-429* 665-278* 601-1005*
57.193 Ac - 5.044 Ac - .82 Ac LEAVING 51.33 Ac 855-899*
619.66
D & F Harr 635-102 8.366 A.
725-981 .165 A
C.A. KOSCHKI 607-338 3.143 Ac.
R.H. & C.S. WEINHART 1105-296 3.143 Ac.
P. & L Benims 603-808 3.313 Ac.
Y. PETTY 999-992
A.A. & M.A. BYLER 921-1089 3.61 A
4.861 Ac
R & R. PIKARCZYK 635-1082* 6.08 Ac
G.A. & J. ESENWINE 1062-257 3.020 Ac.
F. Shetler 603-291 1020-1271 3 Ac
M.S. & J.L. MOSKIN 999-79 3.000 Ac.
Bendon Inc. 700-905 5.044 A
C.S. & L.W. YODER 960-586 3 Ac
D. & V. MLINAR 623-992 3 Ac 201
R.D. INGHRAM 912-871, 890-137 991-883 3.03 A 201
38
829-303 941-839
245-343 532-435 829-303 941-839
PARCEL #3 38.8 Ac.
U. & L. MILLER 839-1356 4.2 Ac.
1121-382 1144-221 16-016800 2.51 A + R.A. S.A. KAUFFMAN*
T. & S. HENRY 23.63 A.
232-179
836-65
746-112 67.86 Ac. 943-358
S. NOSOL JR K.T. NOSOL
50.70 A
21
184-578
59 A
City of Akron
200-467 11.44 A CITY OF AKRON
187-69 CITY OF AKRON 80.25 A
22
parcel #2 957-1336*
L.L. STEINGASS 20.309 Ac
D.L. & E. 578-493 1038-204 16-078412
DETWEILER 7 Ac 1181-299 21.73 A
1181-301 14.73 14.45 Ac
K. Welker
D.C. & E. Detweiler & C.E. & R.C. Weaver 1154-884 4-23-98
16-074000
J.A. & B.L. SCHLEVENSKI 690-31 5.00 AC
T.B. & S.L. FILLA 959-637 2.951 Ac
D.E. SHIPEK 1048-317 943-659 5.24 Ac
D. & R. KOZENKO 1038-320 3.402 Ac.
B.J. & L.J. PAVILONIS 1007-80 3.402 Ac
T.W. & D.A. MULLETT 16-078229 1201-852 3.402
C & A.A. MULLETT 931-197 3.402 Ac
C.H. & A.M. MABILL 940-1329 3.402 Ac
42.27 Ac.
J. & G. Fuduric 495-260
THE (Smallwood) FAMILY TRUST 706-90 919-730 7.758 Ac.
D. Smallwood 1/2 Int. 550-563
J.C. Haueter TRUSTEE 1/2 Int. 706-92
*966-24 966-420
23
M.A. & M.C. TROYER 908-496 4.2 A
D.J. BYLER 1115-677 9.24 AC ✓
MAP OFF
D.R. & S.A. BENDER 3.45 A 1119-858 574-43 W.H. & A.W. 1187-1152 9-15-98
409-596
29.21 A
C.E. BYLER, & E.A. & A.N. BYLER 677-116 1021-551
W.A. & S. MILLER 677-112 2.92 Ac
A.N. SCHMUCKER, etal 915-218 677-108 994-131 2.92 Ac
A & M Byler 589-879 9.25 A.
835-971 3 Ac.
E. & M. DETWEILER
1126-261 D.R. & S.A. BENDER 16-078386 2.743 Ac
1119-858 D.R. & S.A. Bender 2.26 Ac 16-004000
678-1044 .41 Ac
HIDDEN VIEW OLD ORDER AMISH SCHOOL 665-19 678-1044 1.5 Ac.
16-009500 444-999 4.59 Ac 680-542
J.S. & S.J. YODER 719-1089 1185-915 9-2-98
E.S. & D.J. YODER 574-655 PARCEL #1 20 A
H. & J. McNISH 38.50 A
13.25 A
14 A
2.25 Ac
10 A
10 A

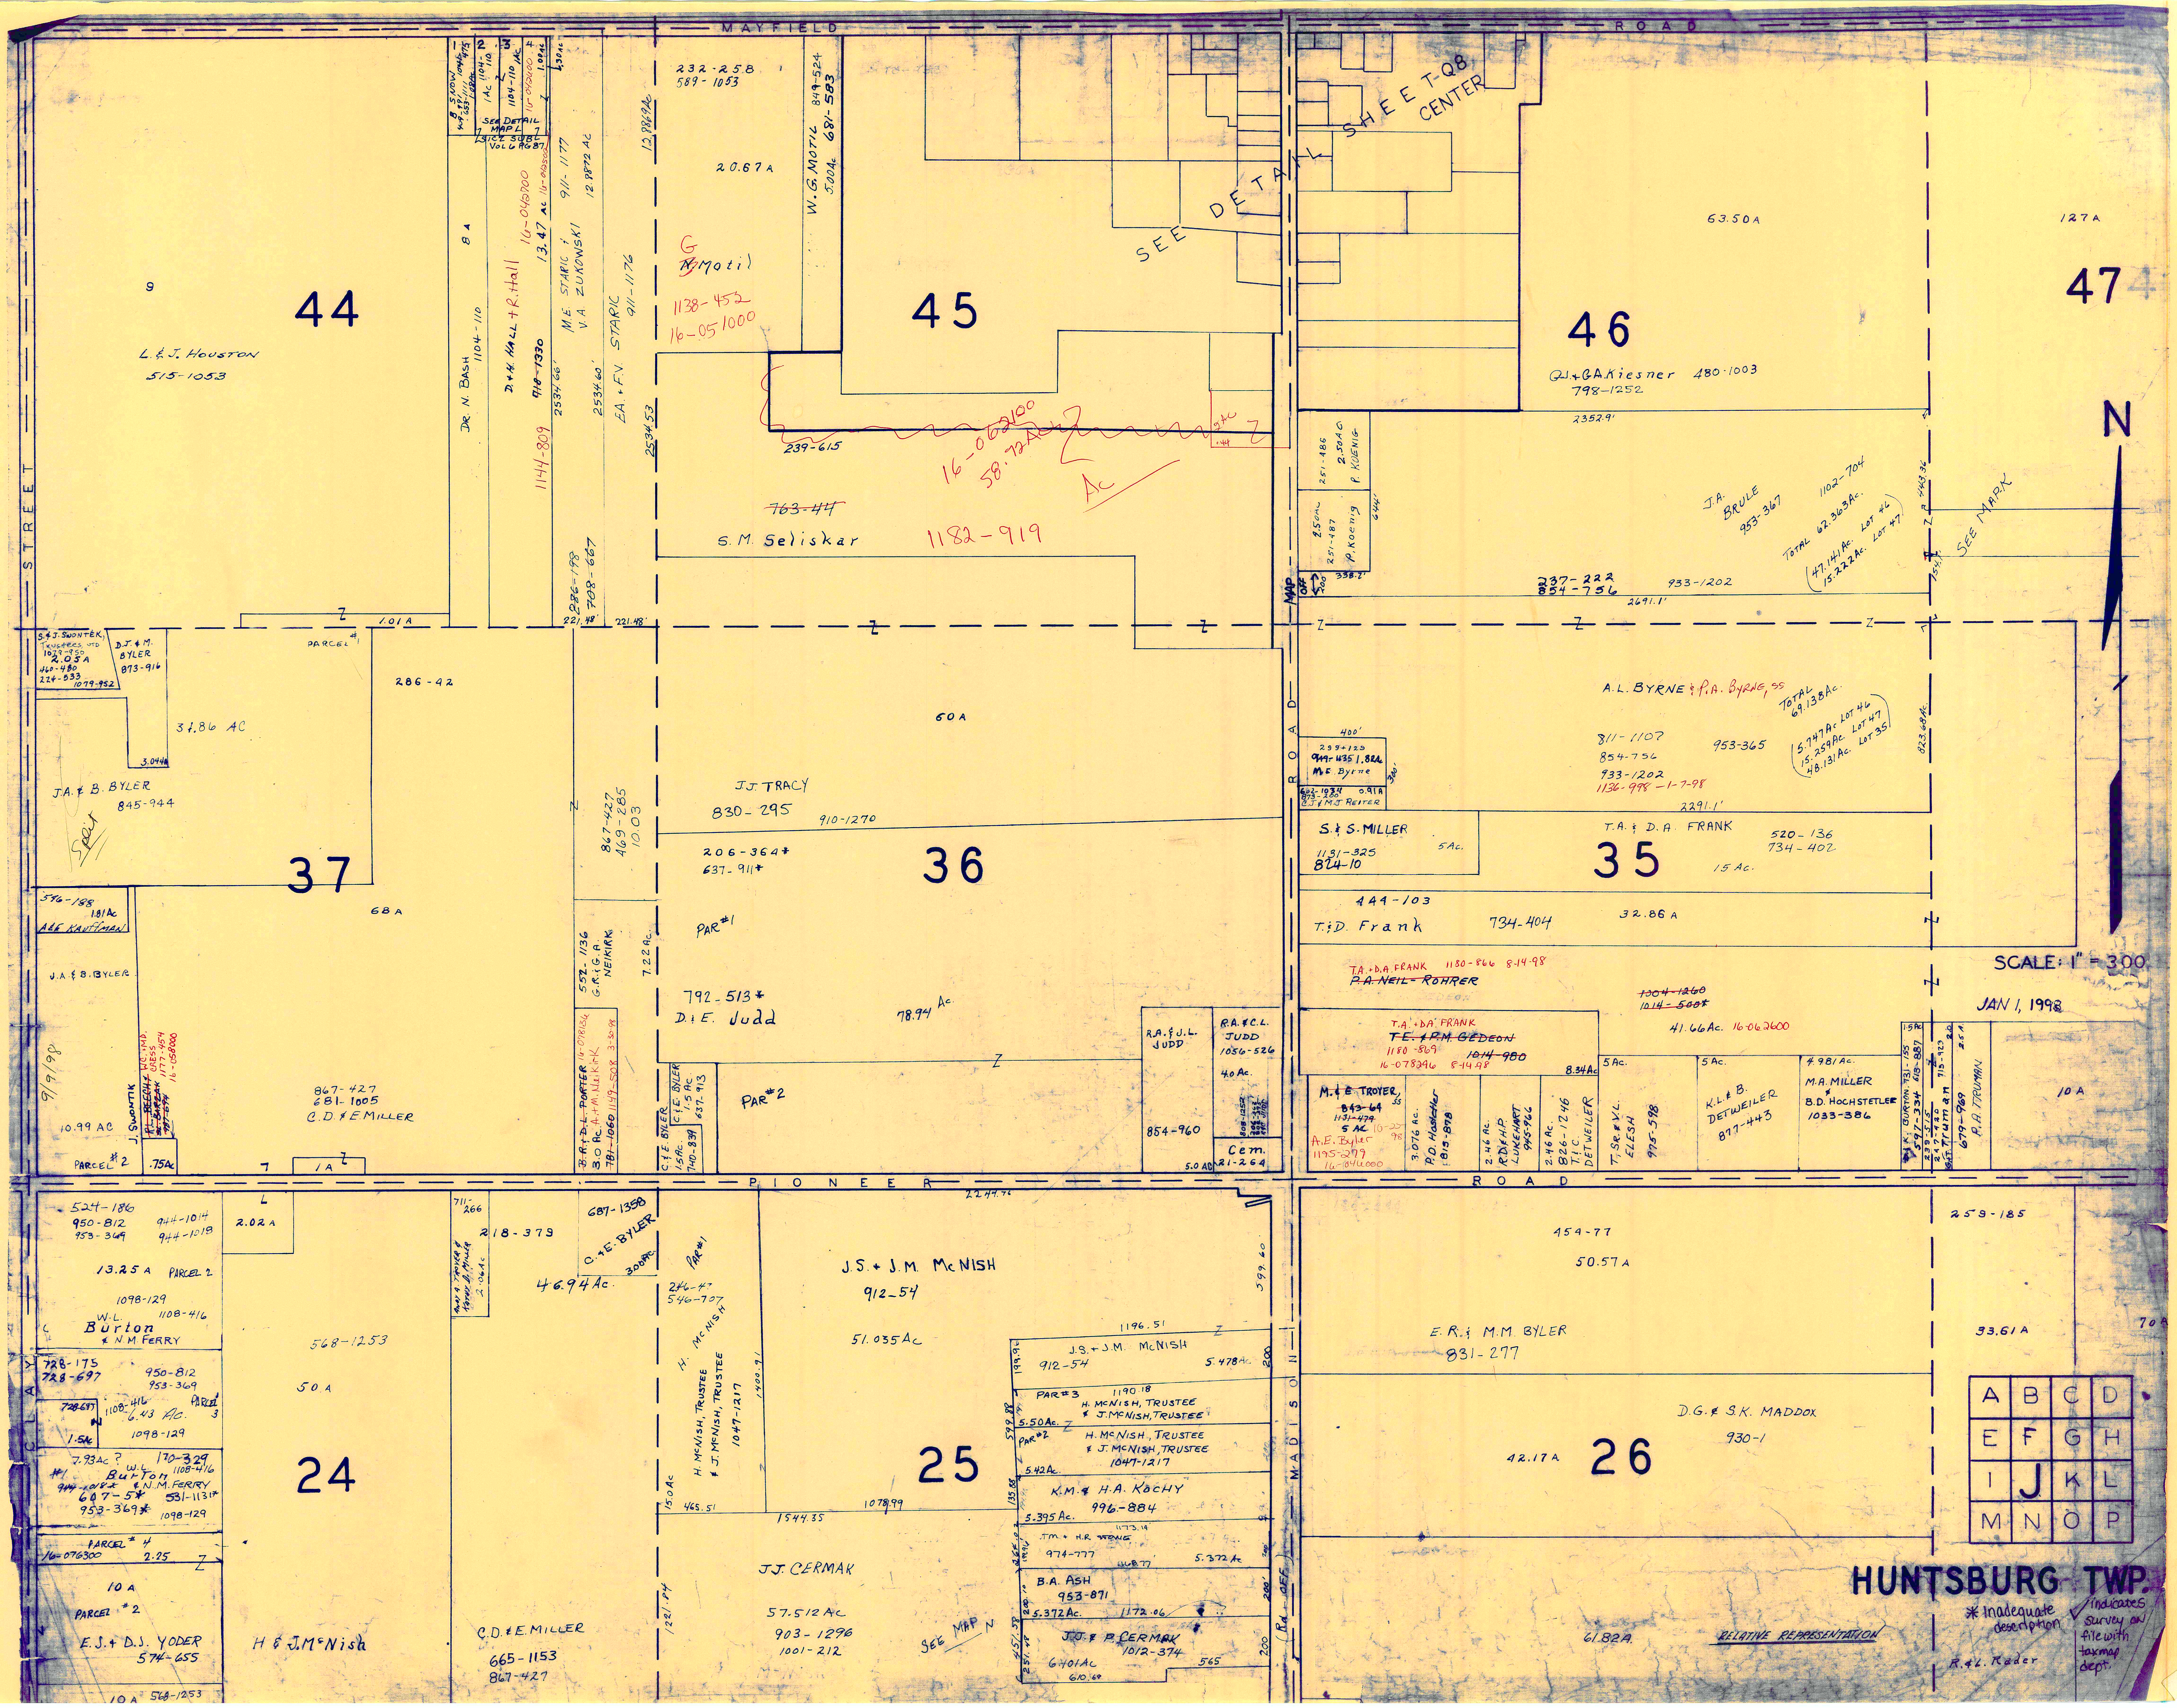

MAYFIELD ROAD
STREET
CLAY
PIONEER ROAD
MADISON
ROAD
44
45
46
47
37
36
35
24
25
26
N
9
L.& J. HOUSTON
515-1053
DR. N. BASH 1104-110
8 A
D.+H. HALL + R. Hall
~~718-1330~~
1144-809
16-045700
13.47 Ac 16-045500
M.E. STARIC & V.A. ZUKOWSKI
911-1177
12.8872 Ac
2534.66'
2534.60'
EA.+F.V. STARIC 911-1176
2534.53
12.8869Ac
286-198
708-667
221.48'
221.48'
1.01 A
1 2 3 4
B. SNOW
1104-110
1 Ac
1104-110 1Ac
16-043400
1.00Ac
.30Ac
SEE DETAIL MAP L
SICZ SUBL VOL 6 PG 87
232-258
589-1053
20.67 A
W.G. MOTIL 849-524 681-583 5.00Ac
G. ~~N.~~ Motil
1138-452
16-051000
239-615
16-062100
58.72 Ac
Ac
.44
~~763-44~~
S.M. Seliskar
1182-919
SEE DETAIL SHEET-Q8 CENTER
63.50 A
127 A
QJ.+G.A.Kiesner 480-1003
798-1252
2352.9'
251-486 2.50AC P. KOENIG
2.50Ac 251-487 P. Koenig
644'
338.2'
MAP OFF 200
237-222
854-756
933-1202
2691.1'
J.A. BRULE 953-367
1102-704
TOTAL 62.363Ac.
47.141Ac. LOT 46
15.222Ac. LOT 47
443.36
154.1
SEE MAP K
Z
S.&J. SWONTEK, Trustees, UTD 1079-950
2.05 A
460-480
224-533
1079-952
D.J.& M. BYLER 873-916
PARCEL #1
286-42
31.86 AC
3.044A
J.A.& B. BYLER
845-944
Split
68 A
546-188
1.81Ac
A.& E. KAUFFMAN
J.A.& B. BYLER
9/9/98
10.99 AC
J. SWONTIK
~~R.L. BEECH~~ ~~S. BARZAK~~ ~~787-674~~
W.C.+M.D. CRESS 1177-454 16-058000
.75Ac
PARCEL #2
1 A
867-427
681-1005
C.D.& E.MILLER
867-427
469-285
10.03
552-1136
G.R.& G.A. NEIKIRK
7.22 Ac.
~~B.R.& D.L. PORTER~~ 16-078134
3.0 Ac. A.+M. NeiKirK
~~781-1060~~ 1149-508 3-30-98
C.& E. BYLER
1.5Ac.
740-839
C.& E. BYLER 1.5 Ac 637-913
60 A
J.J. TRACY
830-295
910-1270
206-364*
637-911*
PAR #1
792-513*
D.& E. Judd
78.94 Ac.
PAR #2
R.A.& J.L. JUDD
854-960
R.A.& C.L. JUDD
1056-526
4.0 Ac.
808-1252
Cem. 21-264
5.0 AC
A.L. BYRNE & P.A. Byrne, ss
TOTAL 69.138Ac.
5.747Ac. LOT 46
15.259Ac. LOT 47
48.131Ac. LOT 35
811-1107
854-756
933-1202
1136-998-1-7-98
953-365
823.68Ac.
400'
299-129
~~949-1135~~ 1.82A
M.E. Byrne
300'
602-1034
873-200
0.91A
C.J.& M.J. REITER
2291.1'
S.& S. MILLER
1131-325
824-10
5Ac.
T.A.& D.A. FRANK
520-136
734-402
15 Ac.
444-103
T.& D. Frank
734-404
32.86 A
T.A.+D.A. FRANK 1180-866 8-14-98
~~P.A. NEIL-ROHRER~~
~~1304-1260~~
~~1014-500*~~
41.66Ac. 16-062600
T.A.+D.A. FRANK
~~T.E.& P.M. GEDEON~~
1180-869
~~1014-980~~
16-078296 8-14-98
8.34Ac
M.& E. TROYER, SS
~~843-64~~
~~1131-479~~
5 AC 10-25-98
A.E. Byler
1195-279
16-046000
3.076 Ac.
P.D. Hostetler
815-878
2.46 Ac.
R.D.& H.P. LUKEHART
945-966
2.46 Ac.
826-1246
T.& C. DETWEILER
5 Ac.
T. SR.& V.L. ELESH
975-598
5 Ac.
K.L.& B. DETWEILER
877-443
4.981 Ac.
M.A. MILLER & B.D. HOCHSTETLER
1033-386
1.5Ac
K. BURTON 731-155
597-334 613-887
2.0
239-515
247-420
G.T. Truman 715-923
679-969
2.5 A
P.A. TRUMAN
10 A
524-186
950-812
953-369
944-1014
944-1018
2.02 A
13.25 A
PARCEL 2
1098-129
1108-416
W.L. Burton
& N.M. FERRY
728-175
728-697
950-812
953-369
728-697
1108-416
6.43 Ac.
PARCEL 3
1098-129
1.5Ac
7.93Ac ?
#1
170-329
1108-416
W.L. Burton & N.M. FERRY
944-1018*
607-5*
953-369*
531-1131*
1098-129
PARCEL # 4
16-076300
2.25
10 A
PARCEL # 2
E.S.+ D.J. YODER
574-655
10 A 568-1253
568-1253
50 A
H & J.McNish
711-266
Andy A. Troyer & Kathy D. Miller 2.06Ac
218-379
687-1358
C.+E. BYLER
3.00Ac.
46.94 Ac.
C.D.& E.MILLER
665-1153
867-427
PAR #1
246-47
546-707
H. McNISH
H. McNISH, TRUSTEE & J. McNISH, TRUSTEE
1047-1217
1400.91
15.0Ac
465.51
1544.35
1078.99
1221.94
2244.76
J.S.+ J.M. McNISH
912-54
51.035Ac
599.60
J.J. CERMAK
57.512 Ac
903-1296
1001-212
SEE MAP N
1196.51
J.S.+J.M. McNISH
912-54
5.478Ac
199.96
200
PAR #3
1190.18
H. McNISH, TRUSTEE & J. McNISH, TRUSTEE
5.50Ac.
599.88
PAR #2
H. McNISH, TRUSTEE & J. McNISH, TRUSTEE
1047-1217
5.42Ac.
K.M.& H.A. KOCHY
996-884
135.88
5.395 Ac.
1173.14
T.M.+ H.R. ~~STONE~~
974-777
264.02
1168.77
5.372 Ac
B.A. ASH
953-871
200.10
5.372Ac.
1172.06
451.58
J.J.& P. CERMAK
1012-374
251.48
6.401Ac
610.69
565
200'
(Rd. OFF.)
454-77
50.57 A
E.R.& M.M BYLER
831-277
D.G.& S.K. MADDOX
930-1
42.17 A
61.82A
259-185
33.61 A
70 A
A B C D
E F G H
I J K L
M N O P

HUNTSBURG TWP.

SCALE: 1" = 300'

JAN 1, 1998

* Inadequate description

✓ indicates survey on file with taxmap dept.

RELATIVE REPRESENTATION

R.& L. Rader

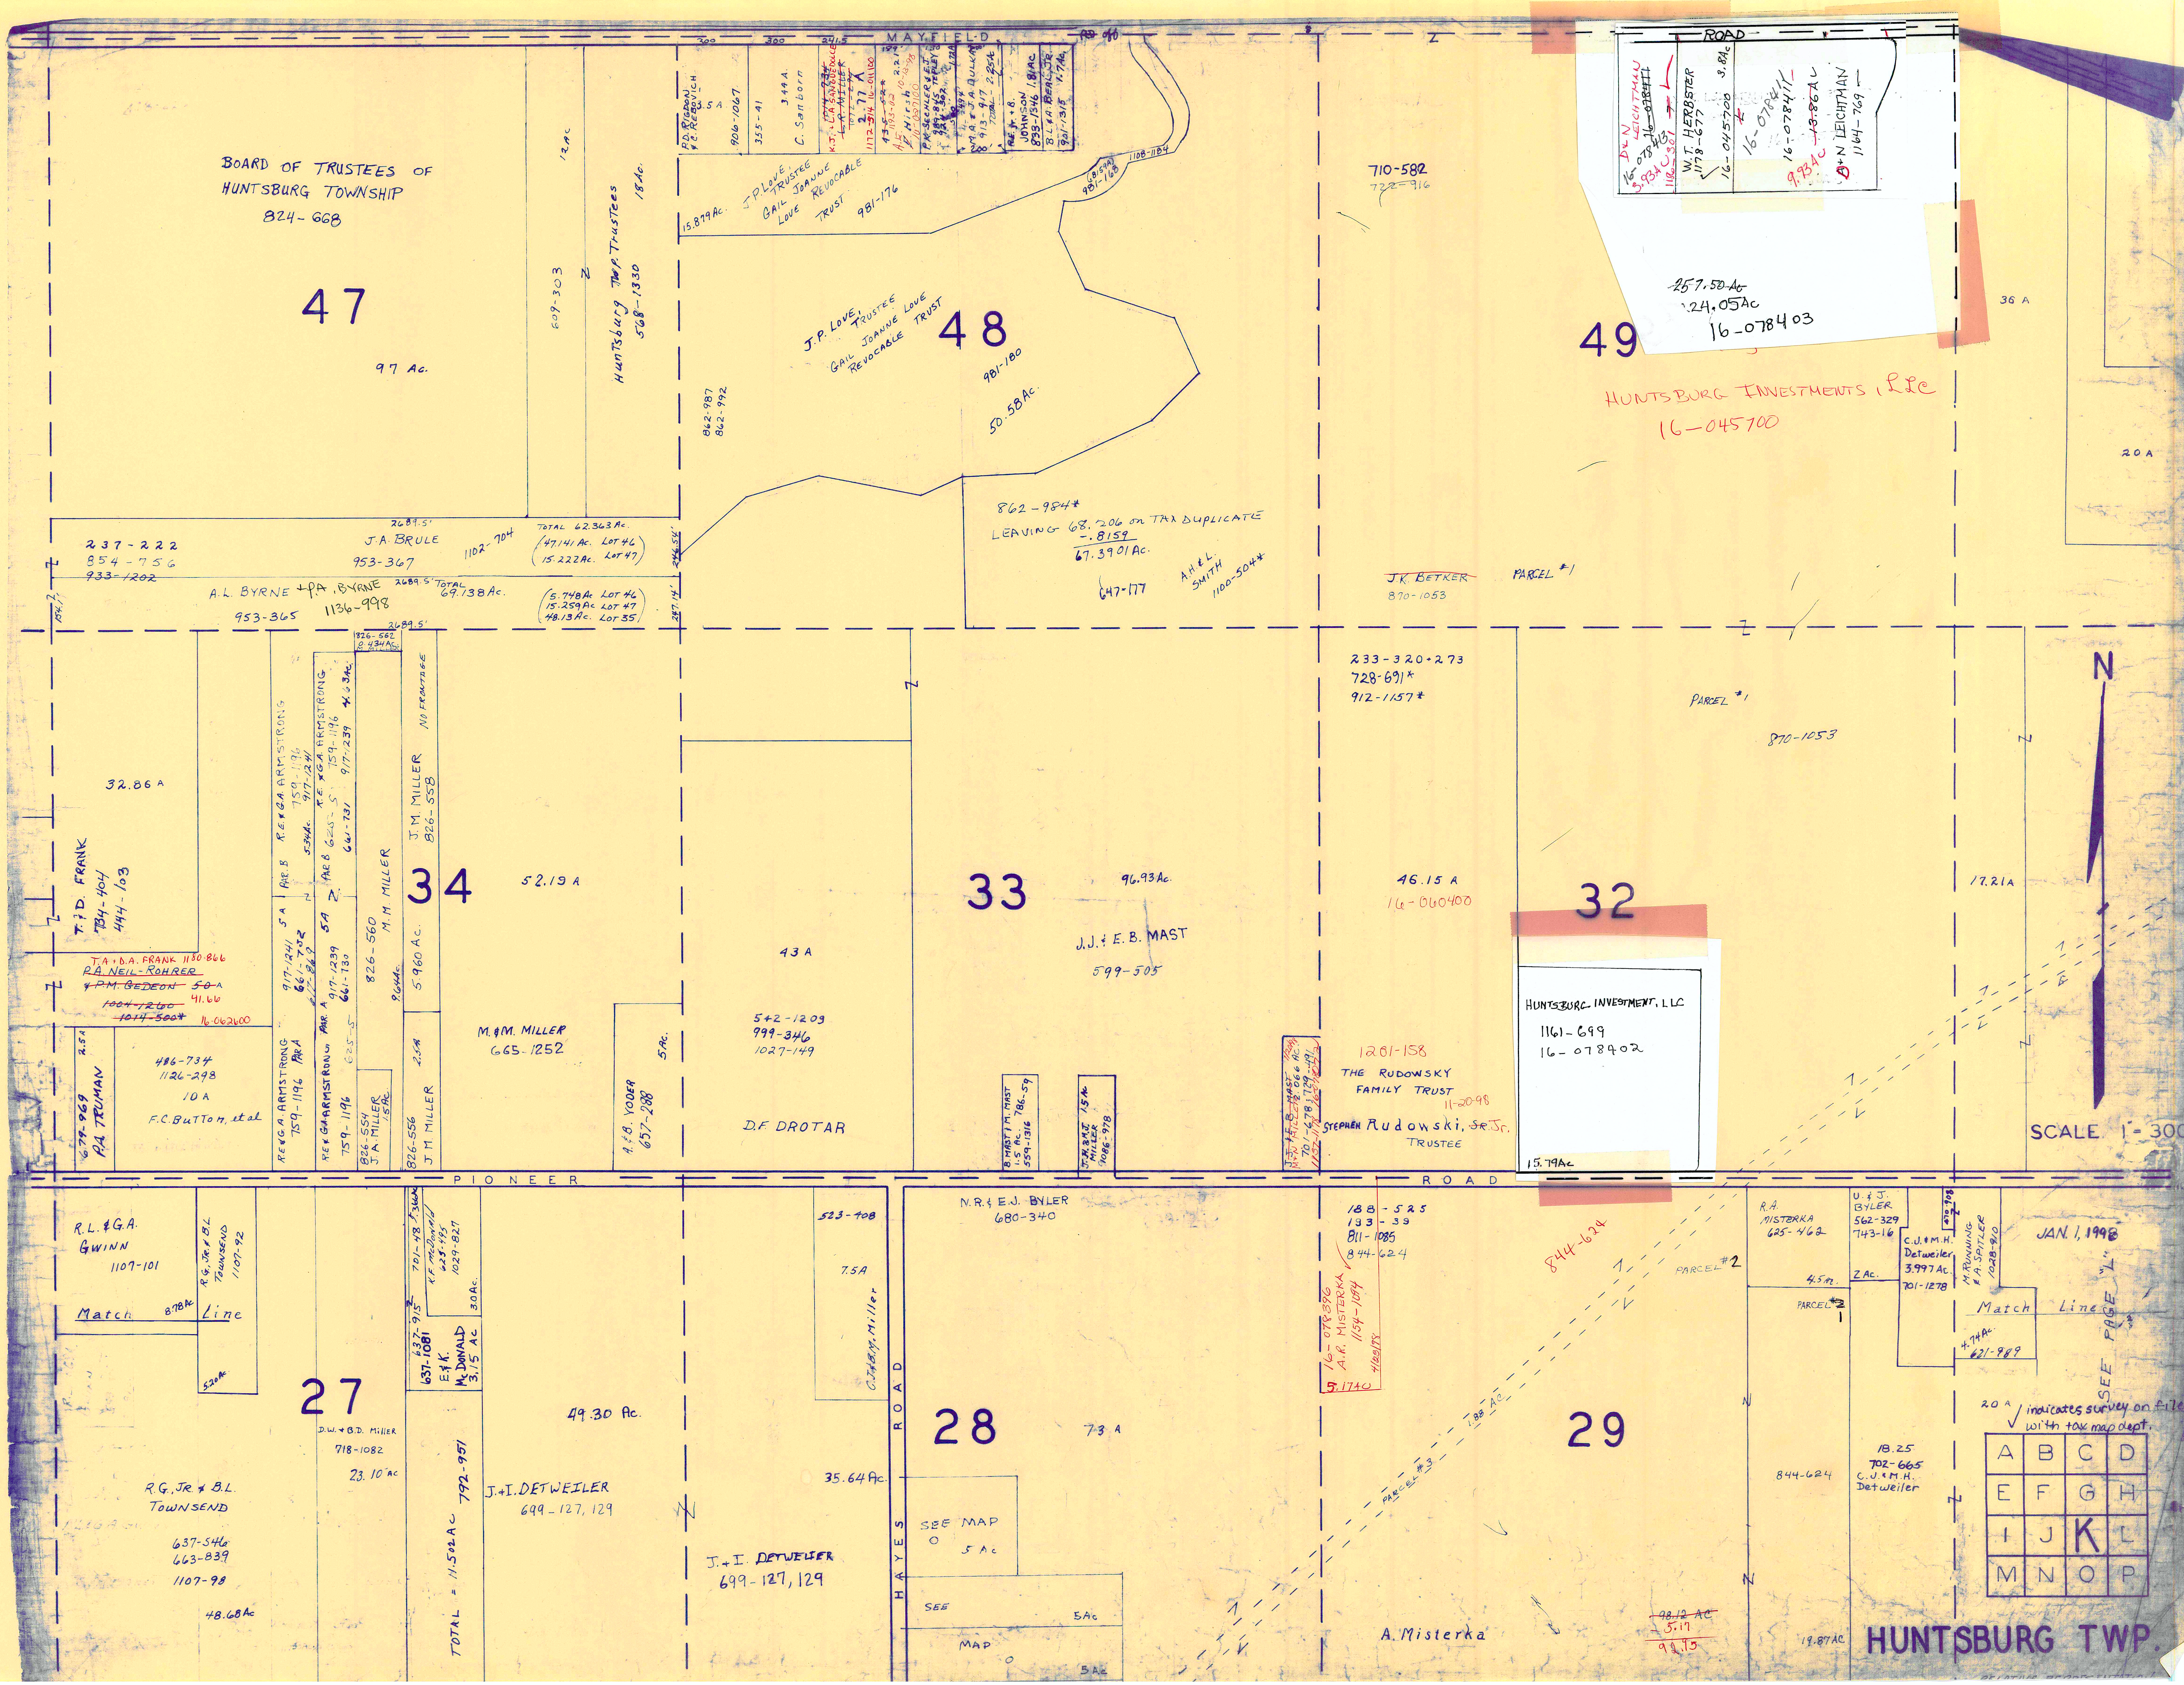
MAYFIELD ROAD
BOARD OF TRUSTEES OF HUNTSBURG TOWNSHIP
824-668
47
97 Ac.
12 Ac
609-303
Huntsburg Twp. Trustees
568-1330
18 Ac.
P.D. RIGDON & C. REBOVICH
3.5 A
906-1067
355-41
3.44 A.
C. Sanborn
K.J. & L.A. SANGUEDOLCE
L.R. MILLER
2.77 A
1172-514 16-011100
A.E. Hirsh
1193-82
2.21
10-13-98
P.K. SECHLER & E.J. TEPLEY
989-845
M.A. & J.A. DULKA
913-917
TOTAL 2.25 A
R.E. J. & B. JOHNSON
1.81 AC
833-1346
B.L. & A. BEAL, JR.
1.7 Ac.
901-1315
1108-1184
(.8159 A)
981-168
15.879 Ac.
J.P. LOVE, TRUSTEE GAIL JOANNE LOVE REVOCABLE TRUST
981-176
48
J.P. LOVE, TRUSTEE GAIL JOANNE LOVE REVOCABLE TRUST
981-180
50.58 Ac.
862-987
862-992
862-984*
LEAVING 68.206 on TAX DUPLICATE
-.8159
67.3901 Ac.
647-177
A.H. & L. SMITH
1100-504*
237-222
854-756
~~933-1202~~
J.A. BRULE
953-367
1102-704
2689.5'
TOTAL 62.363 Ac.
(47.141 Ac. LOT 46
15.222 Ac. LOT 47)
A.L. BYRNE + P.A. BYRNE
953-365
1136-998
TOTAL 69.138 Ac.
(5.748 Ac LOT 46
15.259 Ac LOT 47
48.13 Ac. LOT 35)
246.54'
247.14'
154.2'
710-582
~~722-916~~
ROAD
D & N LEICHTMAN
~~16-078411~~
16-078413
3.93 AC
1186-301
W.T. HERBSTER
1178-677
3.8 Ac
16-045700
16-078411
16-078411
~~13.86 AC~~
9.93 AC
D + N LEICHTMAN
1164-769
~~257.50 Ac~~
124.05 Ac
16-078403
49
HUNTSBURG INVESTMENTS, LLC
16-045700
36 A
20 A
~~J.K. BETKER~~
870-1053
PARCEL #1
826-562
0.434 Ac.
M. MILLER
R.E. & G.A. ARMSTRONG
759-1196
917-1241
5.34 Ac.
PAR. B
625-5
661-731
4.63 Ac.
NO FRONTAGE
J.M. MILLER
826-558
M.M. MILLER
826-560
5.960 Ac.
9.64 Ac.
34
52.19 A
32.86 A
T. & D. FRANK
734-404
444-103
T.A. & D.A. FRANK 1180-866
~~P.A. NEIL-ROHRER~~
~~& P.M. GEDEON~~
~~50~~ A
41.66
~~1004-1260~~
~~1014-500*~~
16-062600
5 A
917-1241
661-732
617-869
917-1239
661-730
PAR. A
2.5 A
679-969
P.A. TRUMAN
486-734
1126-298
10 A
F.C. BUTTON, et al
R.E. & G.A. ARMSTRONG
759-1196
PAR. A
826-554
J.A. MILLER
1.5 Ac.
826-556
J.M. MILLER
M. & M. MILLER
665-1252
A. & B. YODER
657-288
5 Ac.
43 A
542-1209
999-346
1027-149
D.F. DROTAR
33
96.93 Ac.
J.J. & E.B. MAST
599-505
B. MAST & M. MAST
1.5 Ac.
786-59
559-1316
J.H. & M.J. MILLER
1.5 A
1086-978
~~J.J. & E.B. MAST~~
M + N MILLER
2.066 AC.
701-678; 729-491
1137-1178
16-078072
11-20-98
233-320+273
728-691*
912-1157*
PARCEL #1
870-1053
46.15 A
16-060400
32
17.21 A
1261-158
THE RUDOWSKY FAMILY TRUST
11-20-98
STEPHEN Rudowski, ~~Sr.~~ Jr.
TRUSTEE
HUNTSBURG INVESTMENT, LLC
1161-699
16-078402
15.79 Ac
N
SCALE 1" = 300
PIONEER ROAD
R.L. & G.A. GWINN
1107-101
R.G. JR. & B.L. TOWNSEND
1107-92
Match 8.78 Ac Line
5.20 Ac
27
D.W. & B.D. Miller
718-1082
23.10 Ac
R.G., JR. & B.L. TOWNSEND
637-546
663-839
1107-98
48.68 Ac
701-48
1.36 Ac
K.F. McDonald
625-495
1029-827
3.0 Ac.
637-915
637-1081
E. & K. McDONALD
3.15 Ac
TOTAL = 11.502 Ac
792-951
49.30 Ac.
J. + I. DETWEILER
699-127, 129
523-408
7.5 A
C.J. & B.M. Miller
35.64 Ac.
J. + I. DETWEILER
699-127, 129
HAYES ROAD
N.R. & E.J. BYLER
680-340
28
73 A
SEE MAP O
5 Ac
SEE MAP O
5 Ac
5 Ac
188-525
193-39
811-1085
844-624
16-078396
A.R. MISTERKA
1154-1094
4/23/98
5.174 Ac
844-624
PARCEL #2
1.88 AC
PARCEL #3
29
A. Misterka
~~98.12 AC~~
-5.17
92.95
R.A. MISTERKA
625-462
4.5 A.
PARCEL #2
U. & J. BYLER
562-329
743-16
2 Ac.
470-908
C.J. & M.H. Detweiler
3.997 Ac.
701-1278
M. RUNNING & A. SPITLER
1028-910
JAN. 1, 1998
Match Line
4.74 Ac.
621-989
SEE PAGE "L"
20 A
✓ indicates survey on file with tax map dept.
844-624
18.25
702-665
C.J. & M.H. Detweiler
19.87 AC
A B C D
E F G H
I J K L
M N O P
HUNTSBURG TWP.

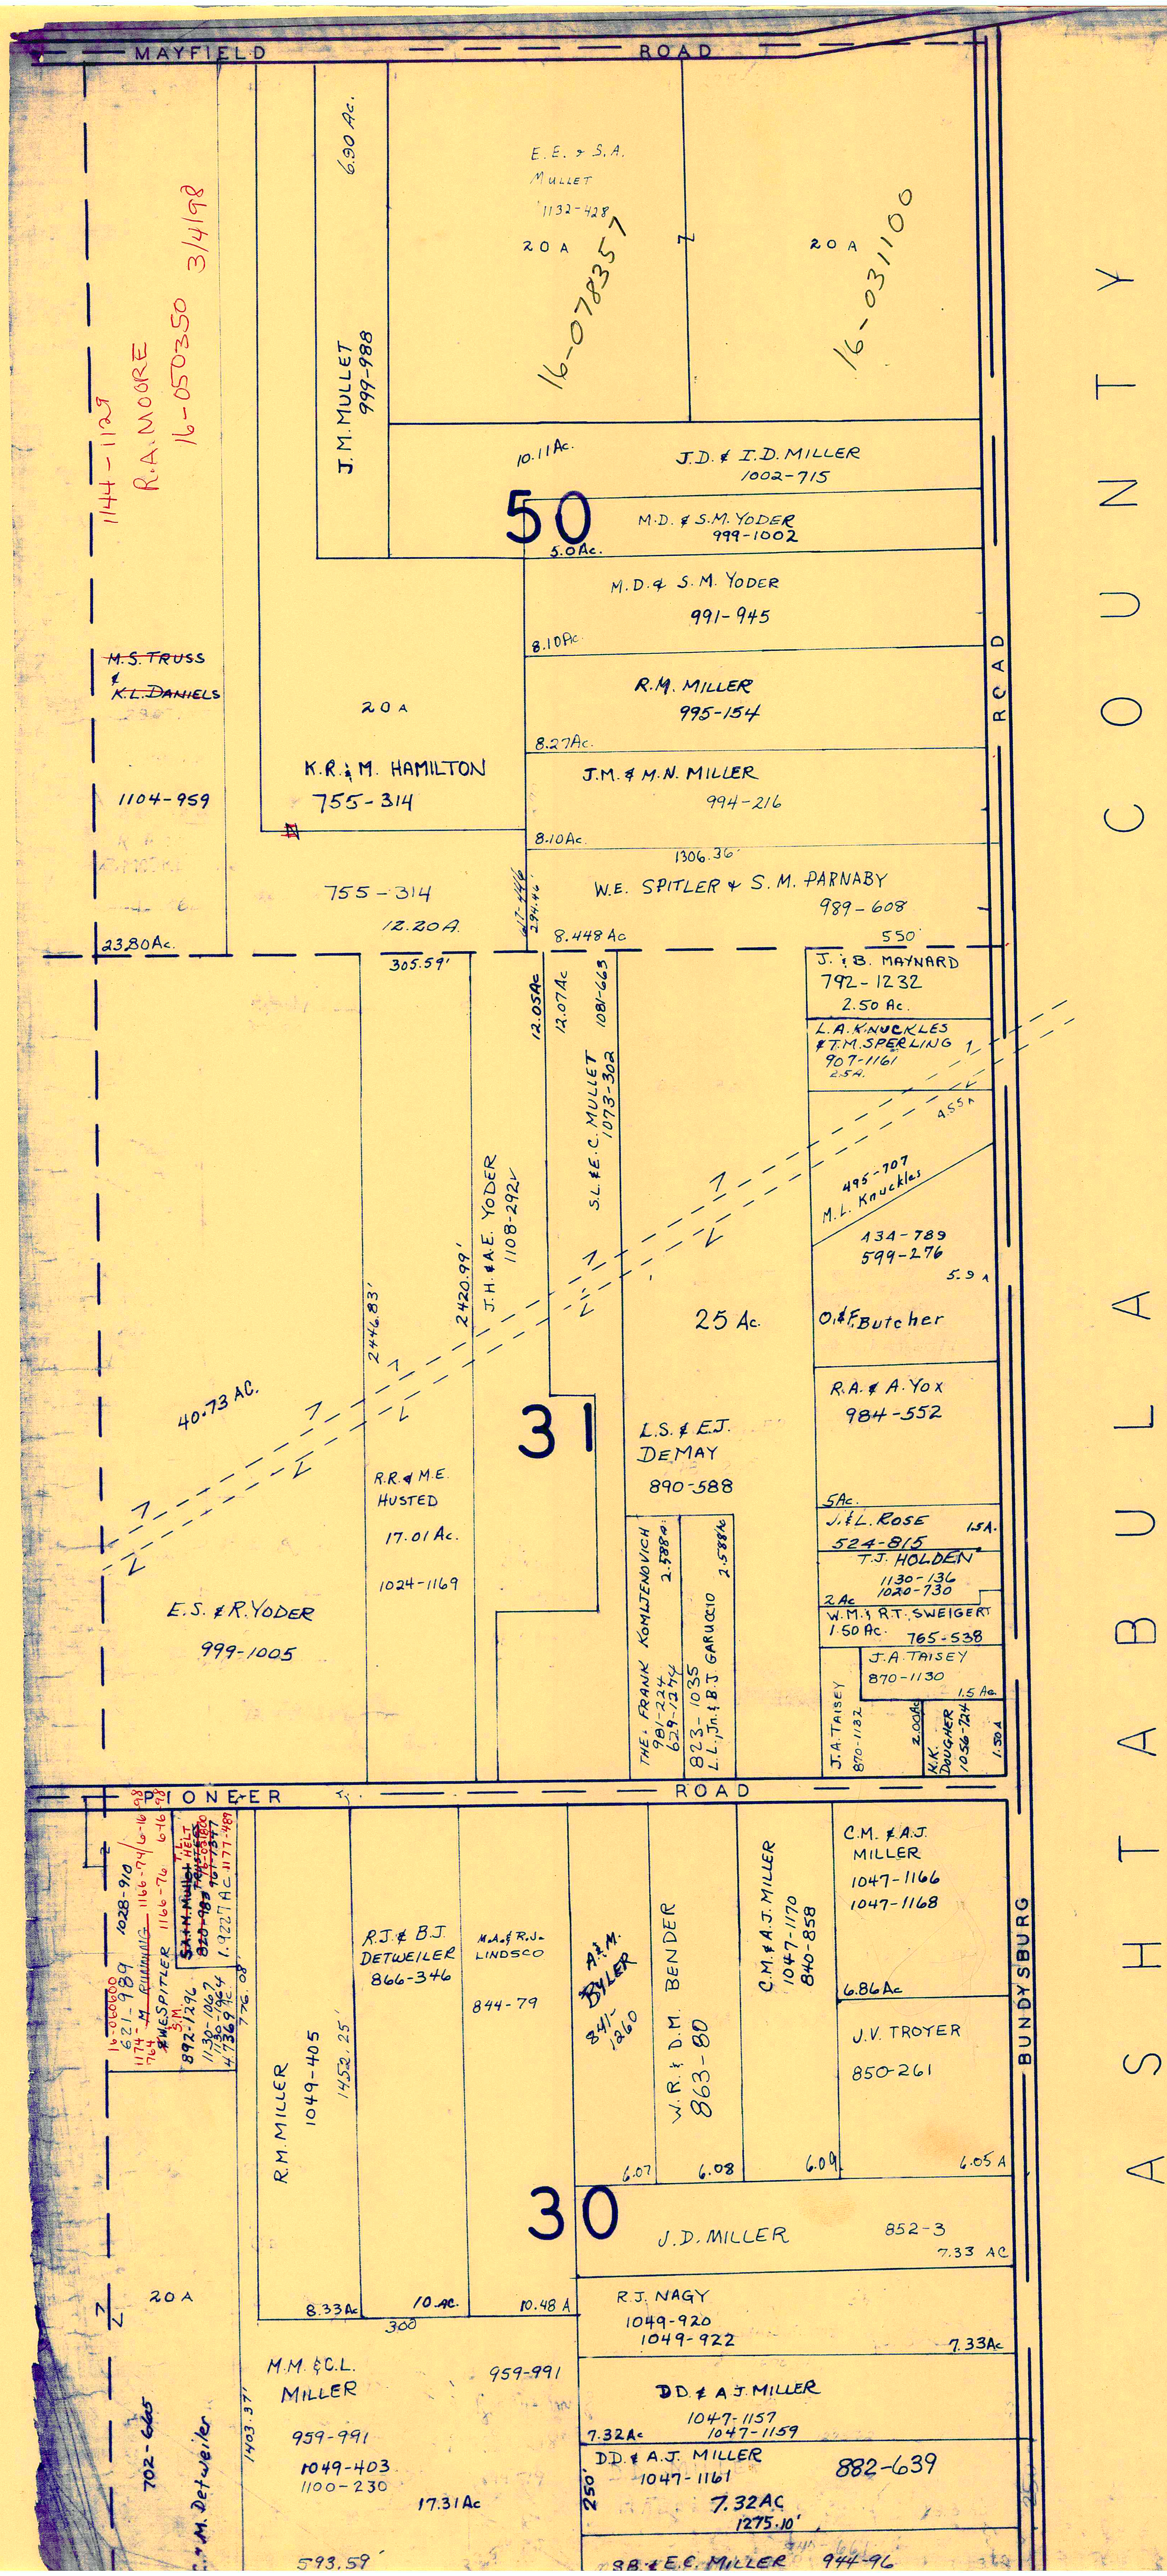
MAYFIELD ROAD
ASHTABULA COUNTY
ROAD
BUNDYSBURG
PIONEER ROAD
50
31
30
1144-1129
R.A. MOORE
16-050350
3/4/98
~~M.S. TRUSS~~
~~& K.L. DANIELS~~
1104-959
23.80Ac.
6.90 Ac.
J.M. MULLET
999-988
E.E. & S.A. MULLET
1132-428
20 A
16-078357
20 A
16-031100
10.11Ac.
J.D. & I.D. MILLER
1002-715
M.D. & S.M. YODER
999-1002
5.0Ac.
M.D. & S.M. YODER
991-945
8.10Ac
R.M. MILLER
995-154
8.27Ac.
J.M. & M.N. MILLER
994-216
8.10Ac.
20 A
K.R. & M. HAMILTON
755-314
755-314
12.20A
1306.36'
W.E. SPITLER & S.M. PARNABY
989-608
294.46'
8.448 Ac
550'
305.59'
J. & B. MAYNARD
792-1232
2.50 Ac.
L.A. KNUCKLES
& T.M. SPERLING
907-1161
2.5A.
4.55A
495-707
M.L. Knuckles
434-789
599-276
5.9 A
O. & F. Butcher
12.05Ac
12.07Ac
1081-663
S.L. & E.C. MULLET
1073-302
J.H. & A.E. YODER
1108-292
2420.99'
2446.83'
25 Ac.
40.73 AC.
R.R. & M.E. HUSTED
17.01 Ac.
1024-1169
E.S. & R. YODER
999-1005
L.S. & E.J. DEMAY
890-588
R.A. & A. YOX
984-552
5Ac.
J. & L. ROSE
524-815
1.5A.
T.J. HOLDEN
1130-136
1020-730
2 Ac
W.M. & R.T. SWEIGERT
1.50 Ac.
765-538
J.A. TAISEY
870-1130
1.5 Ac.
THE. FRANK KOMLJENOVICH
981-224
629-1274
2.588A
823-1035
L.L. Jr. & B.J. GARUCCIO
2.588Ac
J.A. TAISEY
870-1132
2.00Ac
K.K. DOUGHER
1056-724
1.50A
1028-910
16-060600
621-989
1174-764 M RUNNING
& W.E. SPITLER
S.M.
892-1296
1166-74 6-16-98
1166-76 6-16-98
1130-1067
1130-1964
4.7369Ac.
~~S.A. & N. Mullet~~
~~820-983~~
T.L. HELT TRUSTEE
16-031800
761-1347
1.9227AC 1177-489
776.08'
R.M. MILLER
1049-405
1452.25'
R.J. & B.J. DETWEILER
866-346
M.A. & R.J. LINDSCO
844-79
A. & M. BYLER
841-1260
W.R. & D.M. BENDER
863-80
C.M. & A.J. MILLER
1047-1170
840-858
C.M. & A.J. MILLER
1047-1166
1047-1168
6.86Ac
J.V. TROYER
850-261
6.07
6.08
6.09
6.05 A
J.D. MILLER
852-3
7.33 AC
8.33Ac
10 Ac.
10.48 A
300
R.J. NAGY
1049-920
1049-922
7.33Ac
20 A
M.M. & C.L. MILLER
959-991
959-991
1049-403
1100-230
17.31Ac
1403.37'
702-665
C.M. Detweiler
DD & A J MILLER
1047-1157
1047-1159
7.32Ac
DD & A.J. MILLER
1047-1161
882-639
7.32AC
1275.10'
250'
593.59'
SB & E.C. MILLER
944-96

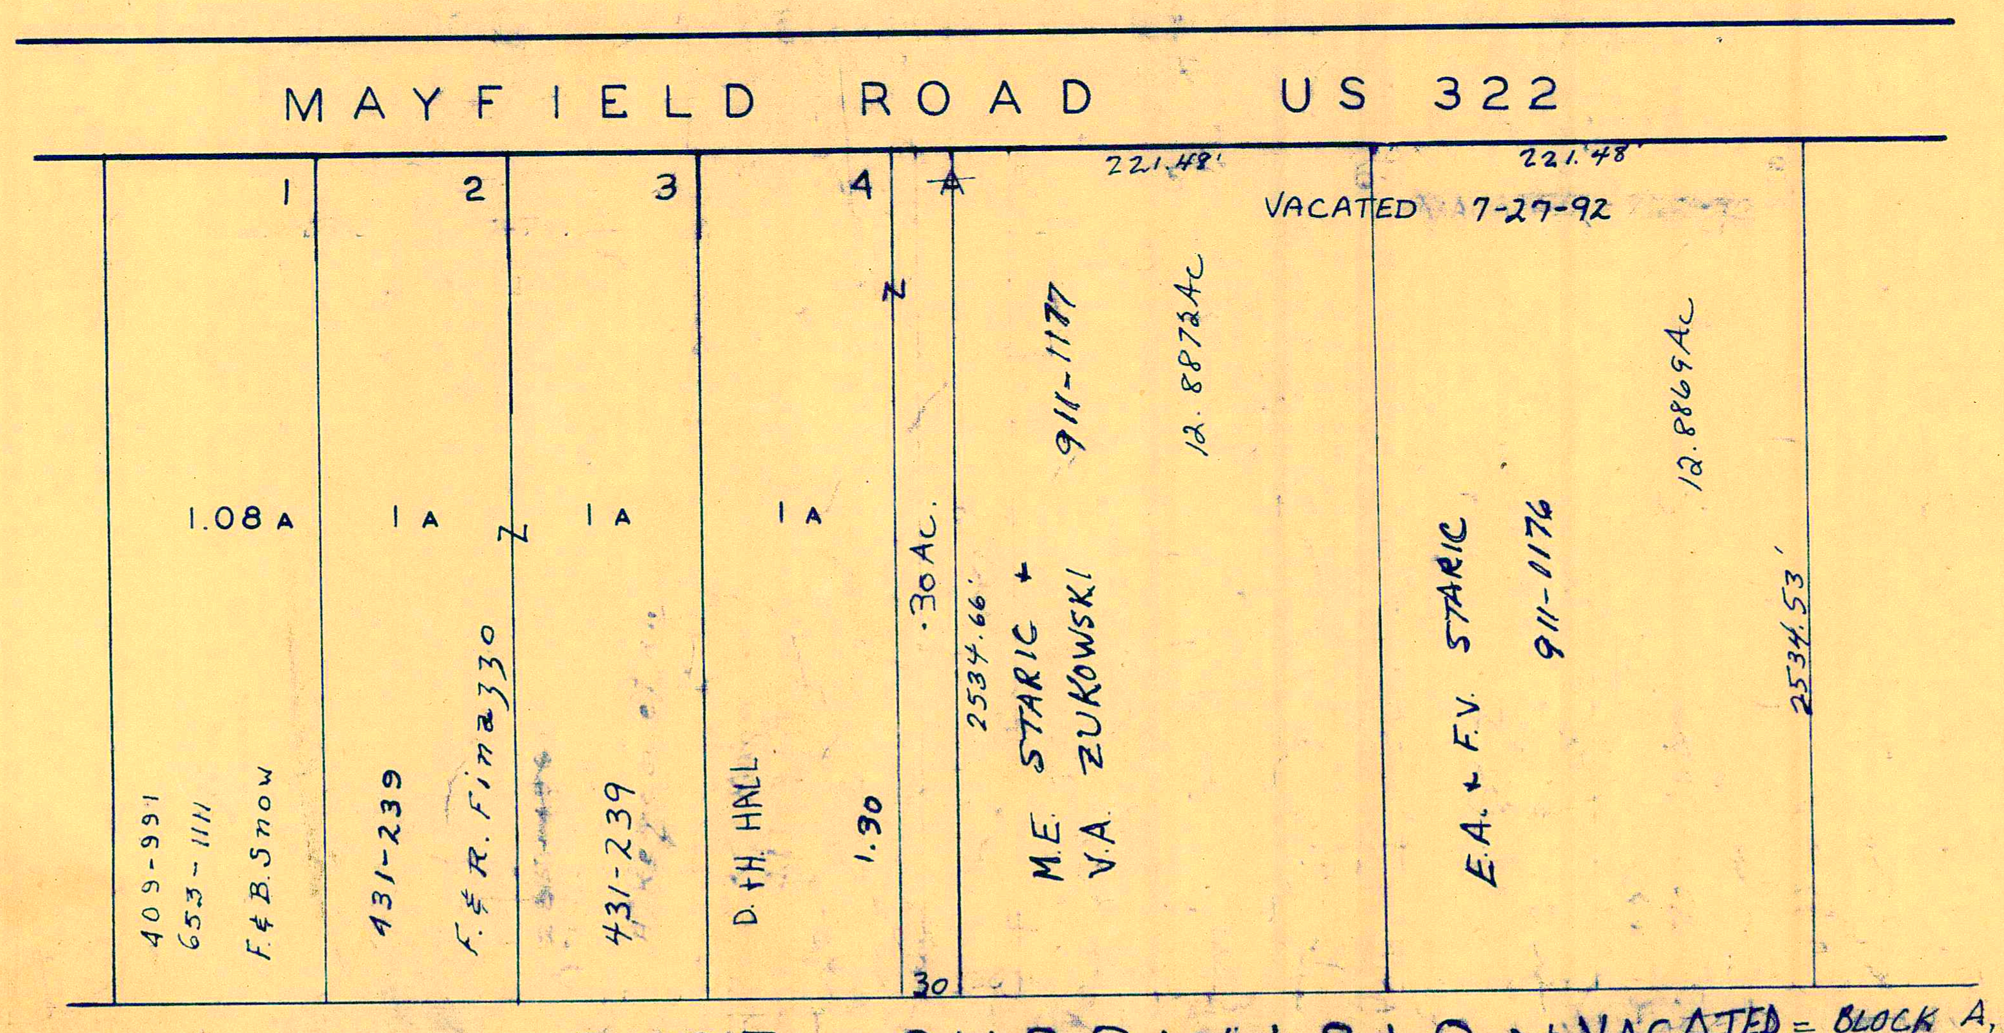
MAYFIELD ROAD US 322
1
2
3
4
A
221.48'
221.48'
VACATED 7-27-92
1.08 A
1 A
1 A
1 A
409-991
653-1111
F. & B. Snow
431-239
F. & R. Fina 330
431-239
D. & H. HALL
1.90
.30 Ac.
30
2534.66'
M.E. STARIC &
V.A. ZUKOWSKI
911-1177
12.8872Ac
E.A. & F.V. STARIC
911-1176
12.8869Ac
2534.53'

SICZ SUBDIVISION
VOL-6 - PG. 87
LOT 44
SCALE 1" 100'

VACATED = BLOCK A, S/L 5-6-7-8
7-27-92

√ indicates survey on file with tax map dept.

SCALE 1" 300'

JAN 1, 1998

* Inadequate description

RELATIVE REPRESENTATION

A	B	C	D
E	F	G	H
I	J	K	L
M	N	O	P

HUNTSBURG TWP.

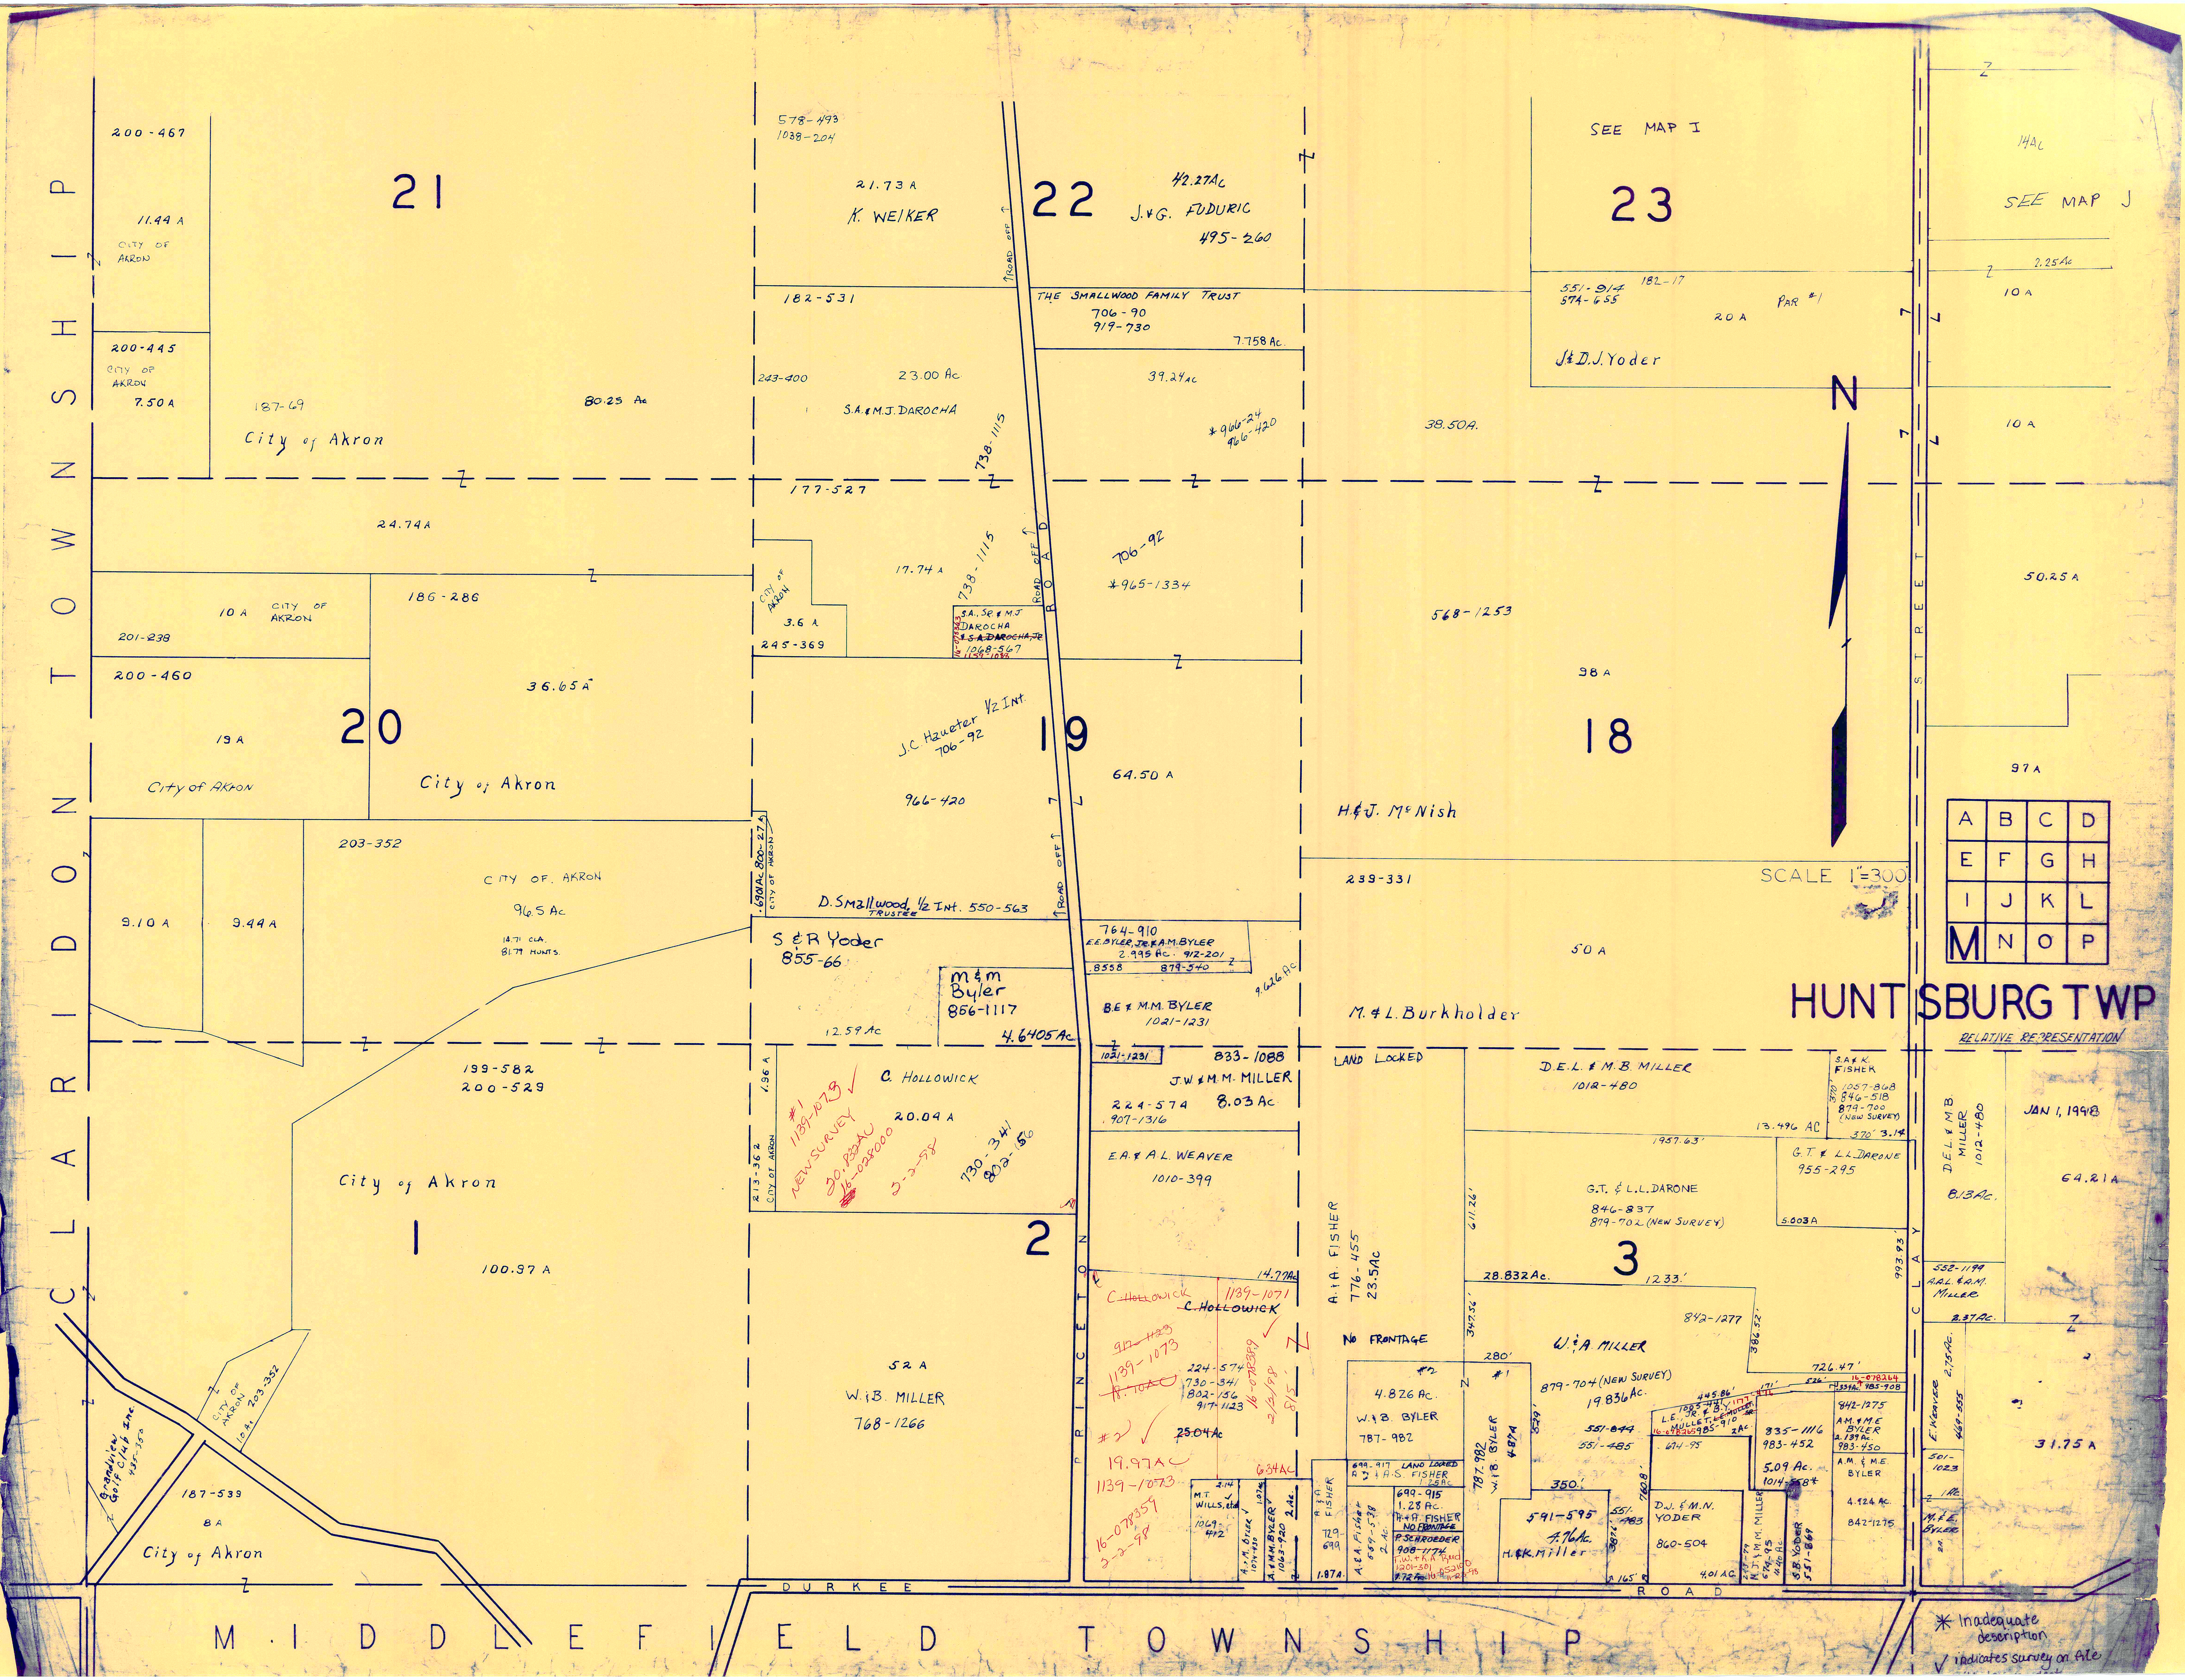
CLARIDON TOWNSHIP
MIDDLEFIELD TOWNSHIP
HUNTSBURG TWP
RELATIVE REPRESENTATION
JAN 1, 1998
SCALE 1"=300'
N
SEE MAP I
SEE MAP J
21
22
23
20
19
18
1
2
3
200-467
11.44 A
CITY OF AKRON
200-445
CITY OF AKRON
7.50 A
187-69
City of Akron
80.25 Ac
578-493
1038-204
21.73 A
K. WEIKER
182-531
243-400
23.00 Ac
S.A.&M.J. DAROCHA
738-1115
42.27 Ac
J.&G. FUDURIC
495-260
THE SMALLWOOD FAMILY TRUST
706-90
919-730
7.758 Ac
39.24 Ac
966-24
966-420
551-914
574-655
182-17
20 A
PAR #1
J.& D.J. Yoder
38.50 A.
14 Ac
2.25 Ac
10 A
10 A
24.74 A
177-527
10 A
CITY OF AKRON
186-286
201-238
200-460
36.65 A
19 A
City of Akron
City of Akron
CITY OF AKRON
3.6 A
245-369
17.74 A
S.A. & M.J. DAROCHA
1068-567
706-92
965-1334
ROAD
568-1253
98 A
50.25 A
97 A
J.C. Hauter 1/2 Int.
706-92
966-420
64.50 A
H.& J. McNish
203-352
CITY OF AKRON
96.5 Ac
14.71 CLA.
81.79 HUNTS.
9.10 A
9.44 A
D. Smallwood 1/2 Int. 550-563
TRUSTEE
S.&R. Yoder
855-66
764-910
E.E. BYLER JR. & A.M. BYLER
2.995 Ac.
912-201
8.558
879-540
M.&M. Byler
856-1117
4.6405 Ac
BE & M.M. BYLER
1021-1231
9.626 Ac
239-331
50 A
M.& L. Burkholder
12.59 Ac
199-582
200-529
City of Akron
100.97 A
1.96 A
213-362
CITY OF AKRON
C. HOLLOWICK
20.04 A
#1 1139-1073
NEW SURVEY
20.132 AC
16-028000
3-3-98
730-341
802-150
52 A
W.& B. MILLER
768-1266
833-1088
J.W.& M.M. MILLER
8.03 Ac
1021-1231
224-574
907-1316
E.A.& A.L. WEAVER
1010-399
LAND LOCKED
D.E.L. & M.B. MILLER
1012-480
S.A.& K. FISHER
1057-868
846-518
879-700
(NEW SURVEY)
13.496 AC
370' 3.14
1957.63'
G.T. & L.L. DARONE
846-837
879-702 (NEW SURVEY)
G.T. & L.L. DARONE
955-295
5.003 A
DEL & M.B. MILLER
1012-480
8.13 Ac.
64.21 A
A.& A. FISHER
776-455
23.5 Ac
28.832 Ac.
1233'
842-1277
558-1199
A.R.L. & A.M. MILLER
2.37 Ac.
C. HOLLOWICK
1139-1071
14.77 Ac
917-1123
1139-1073
16-078389
2/3/98
224-574
730-341
802-150
917-1123
25.04 Ac
#2
19.97 Ac
1139-1073
16-078357
3-2-98
6.34 Ac
NO FRONTAGE
4.826 Ac
W.& B. BYLER
787-982
W.& A. MILLER
879-704 (NEW SURVEY)
19.836 Ac.
726.47'
842-1275
A.M. & M.E. BYLER
983-450
835-1116
983-452
5.09 Ac.
1014-584
4.124 Ac
842-1275
E. Weaver
31.75 A
M.T. WILLS, etc.
1069-442
A.M. BYLER
A.M.& M. BYLER
1062-920
A.& A. FISHER
729-699
1.87 A
A.& A. FISHER
699-915
1.28 Ac.
A.& A. FISHER
NO FRONTAGE
P. SCHROEDER
908-1174
787-982
W.& B. BYLER
4.87 A
591-595
4.76 Ac.
H.& K. Miller
D.J. & M.N. YODER
860-504
4.01 AC
551-485
551-483
S.B. YODER
551-869
187-539
8 A
City of Akron
CITY OF AKRON
10 Ac 203-352
Grandview Golf Club Inc.
PRINCETON
DURKEE ROAD
CLAY STREET
ROAD OFF
A B C D
E F G H
I J K L
M N O P
* Inadequate description
✓ indicates survey on file

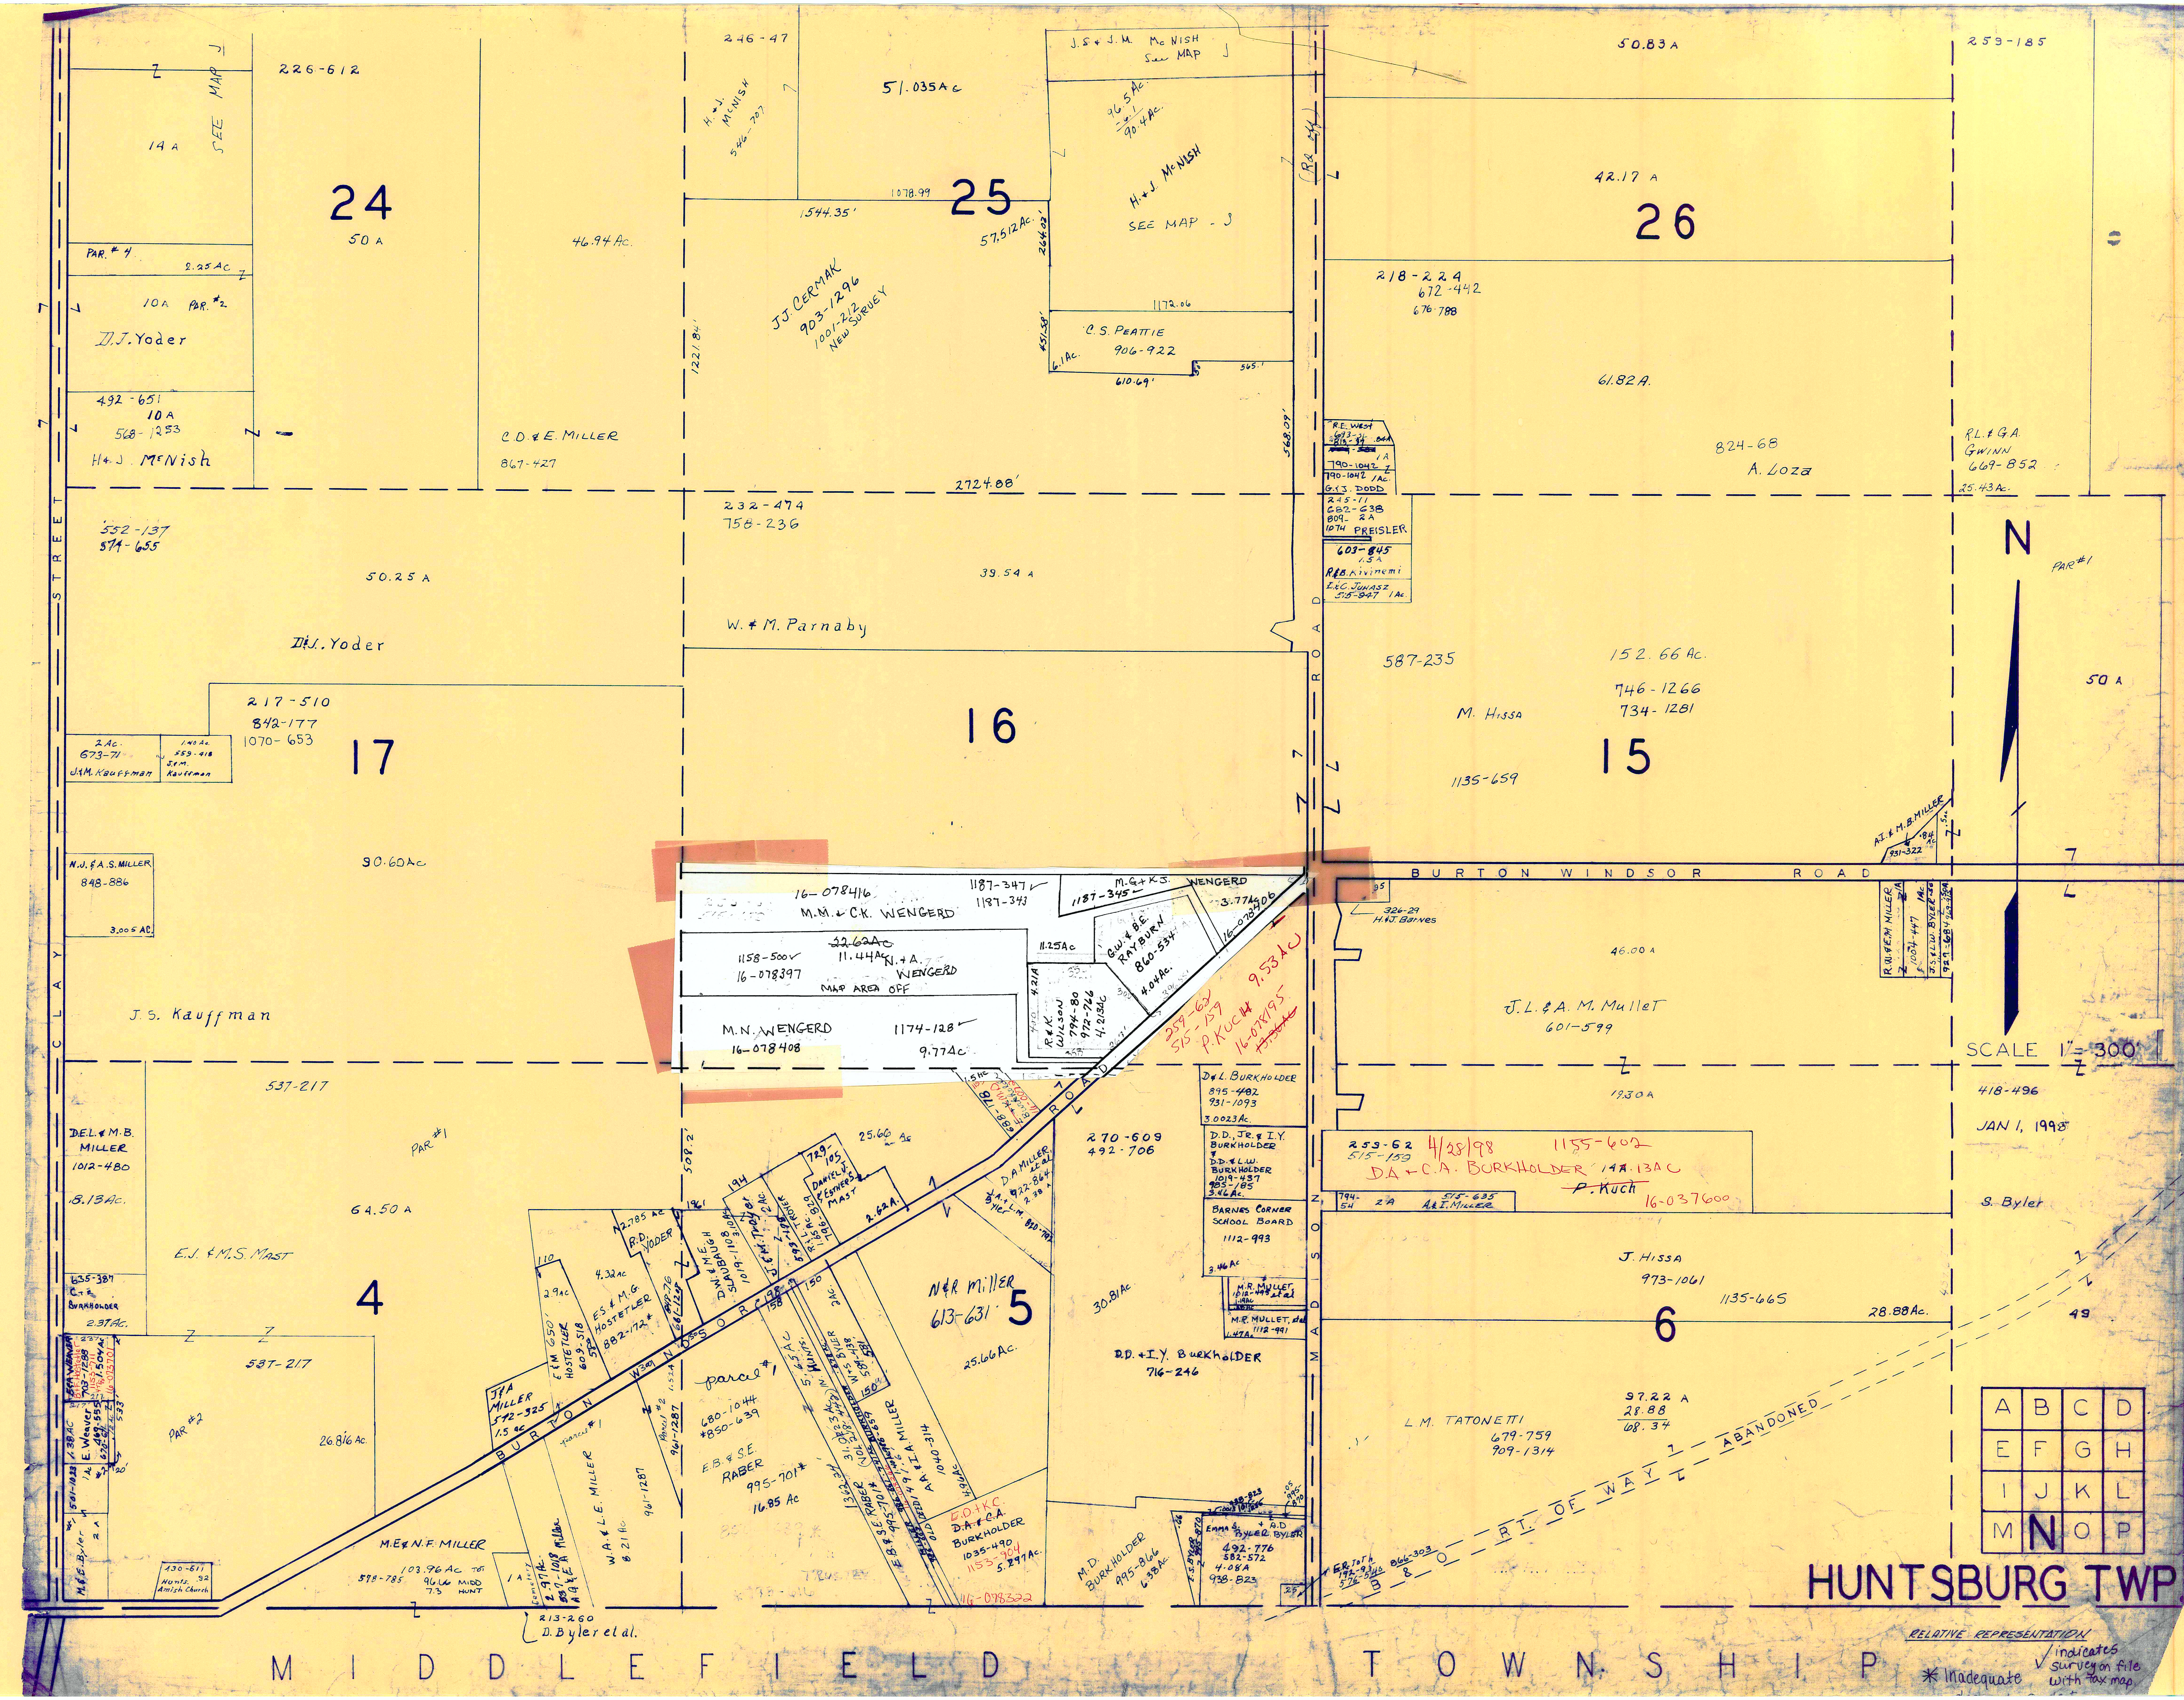
HUNTSBURG TWP
SCALE 1" = 300'
JAN 1, 1998
N
CLAY STREET
BURTON WINDSOR ROAD
MADISON ROAD
MIDDLEFIELD TOWNSHIP
ABANDONED B & O RT. OF WAY
24
25
26
17
16
15
4
5
6
226-612
14 A
SEE MAP J
50 A
46.94 Ac.
PAR. #4
2.25 AC
10 A
PAR. #2
D.J. Yoder
492-651
10 A
568-1253
H.+J. McNish
C.D. & E. Miller
867-427
246-47
H.+J. McNISH
546-707
51.035 Ac
1544.35'
1078.99
57.512 Ac.
1221.84'
J.J. CERMAK
903-1296
1001-212
New SURVEY
J.S.+J.M. McNISH
See MAP J
96.5 Ac.
90.4 Ac.
H.+J. McNISH
SEE MAP J
1172.06
C.S. PEATTIE
906-922
6.1 Ac.
610.69'
565.'
568.09'
50.83 A
42.17 A
218-224
672-442
676-788
61.82 A.
824-68
A. Loza
R.L. & G.A. GWINN
669-852
25.43 Ac.
259-185
2724.88'
232-474
758-236
39.54 A
W. & M. Parnaby
552-137
574-655
50.25 A
D&J. Yoder
217-510
842-177
1070-653
2 Ac.
673-71
J&M. Kauffman
1.40 Ac.
559-416
S&M. Kauffman
N.J. & A.S. MILLER
848-886
3.005 AC.
90.60 Ac
J.S. Kauffman
R.E. West
G.&S. DODD
245-11
662-638
809-2 A
1074 PREISLER
603-845
R&B. Kivinemi
E.&C. Juhasz
515-847
587-235
152.66 Ac.
746-1266
734-1281
M. Hissa
1135-659
PAR #1
50 A
A.I. & M.B. MILLER
931-322
16-078416
M.M. & C.K. WENGERD
1187-347
1187-343
M.G. & K.J. WENGERD
1187-345
3.77 Ac
16-078406
~~22.62 Ac~~
11.44 Ac
N. & A. WENGERD
1158-500
16-078397
MAP AREA OFF
M.N. WENGERD
16-078408
1174-128
9.77 Ac
11.25 Ac
G.W. & B.E. RAYBURN
860-534
4.04 Ac.
R. & K. WILSON
794-80
972-746
4.21 Ac
259-63
515-159
P. KUCH
9.53 AC
16-078195
~~11.5 Ac~~
324-29
H.&J. Barnes
46.00 A
J.L. & A.M. Mullet
601-599
R.W. & E.M. MILLER
J.S. & A. BYLER
1004-447
684-364
929
19.30 A
418-496
S. Byler
537-217
DEL & M.B. MILLER
1012-480
8.13 Ac.
PAR #1
64.50 A
E.J. & M.S. MAST
635-387
C.&A. BURKHOLDER
2.37 Ac.
537-217
PAR #2
26.816 Ac
25.66 Ac
D. & E. MAST
729-105
2.62 A
R.D. YODER
2.785 AC
D.W. & M.E. SLAUBAUGH
E.S. & M.G. HOSTETLER
882-172
E.&M. HOSTETLER
609-518
J.&A. MILLER
572-325
1.5 ac
parcel #1
680-1044
850-639
E.B. & S.E. RABER
995-701
16.85 Ac
W.A. & L.E. MILLER
8.21 Ac.
961-1287
M.E. & N.F. MILLER
598-785
103.96 Ac
96.66 MIDD
7.3 HUNT
213-260
D. Byler et al.
430-611
Hunts. 52
Amish Church
N&R Miller
613-631
25.66 Ac.
D.A. MILLER
E.D. & K.C.
D.A. & C.A. BURKHOLDER
1035-490
1153-904
5.897 Ac.
16-078322
270-609
492-706
30.81 Ac
D.D. + I.Y. Burkholder
716-246
M.D. BURKHOLDER
995-866
D.& L. BURKHOLDER
895-482
931-1093
3.0023 Ac.
D.D., Jr. & I.Y. BURKHOLDER
D.D. & L.W. BURKHOLDER
1019-437
BARNES CORNER SCHOOL BOARD
1112-993
M.R. MULLET
M.R. MULLET, etal
1112-991
Emma & A.D. BYLER
492-776
582-572
938-823
253-62
515-159
4/28/98
1155-602
D.A. + C.A. BURKHOLDER
~~14A~~ 13AC
~~P. Kuch~~
16-037600
515-685
A.& I. MILLER
794-54
2 A
J. Hissa
973-1061
1135-665
28.88 Ac.
49
L.M. TATONETTI
679-759
909-1314
97.22 A
28.88
68.34
A B C D
E F G H
I J K L
M N O P
RELATIVE REPRESENTATION
* inadequate
✓ indicates survey on file with tax map

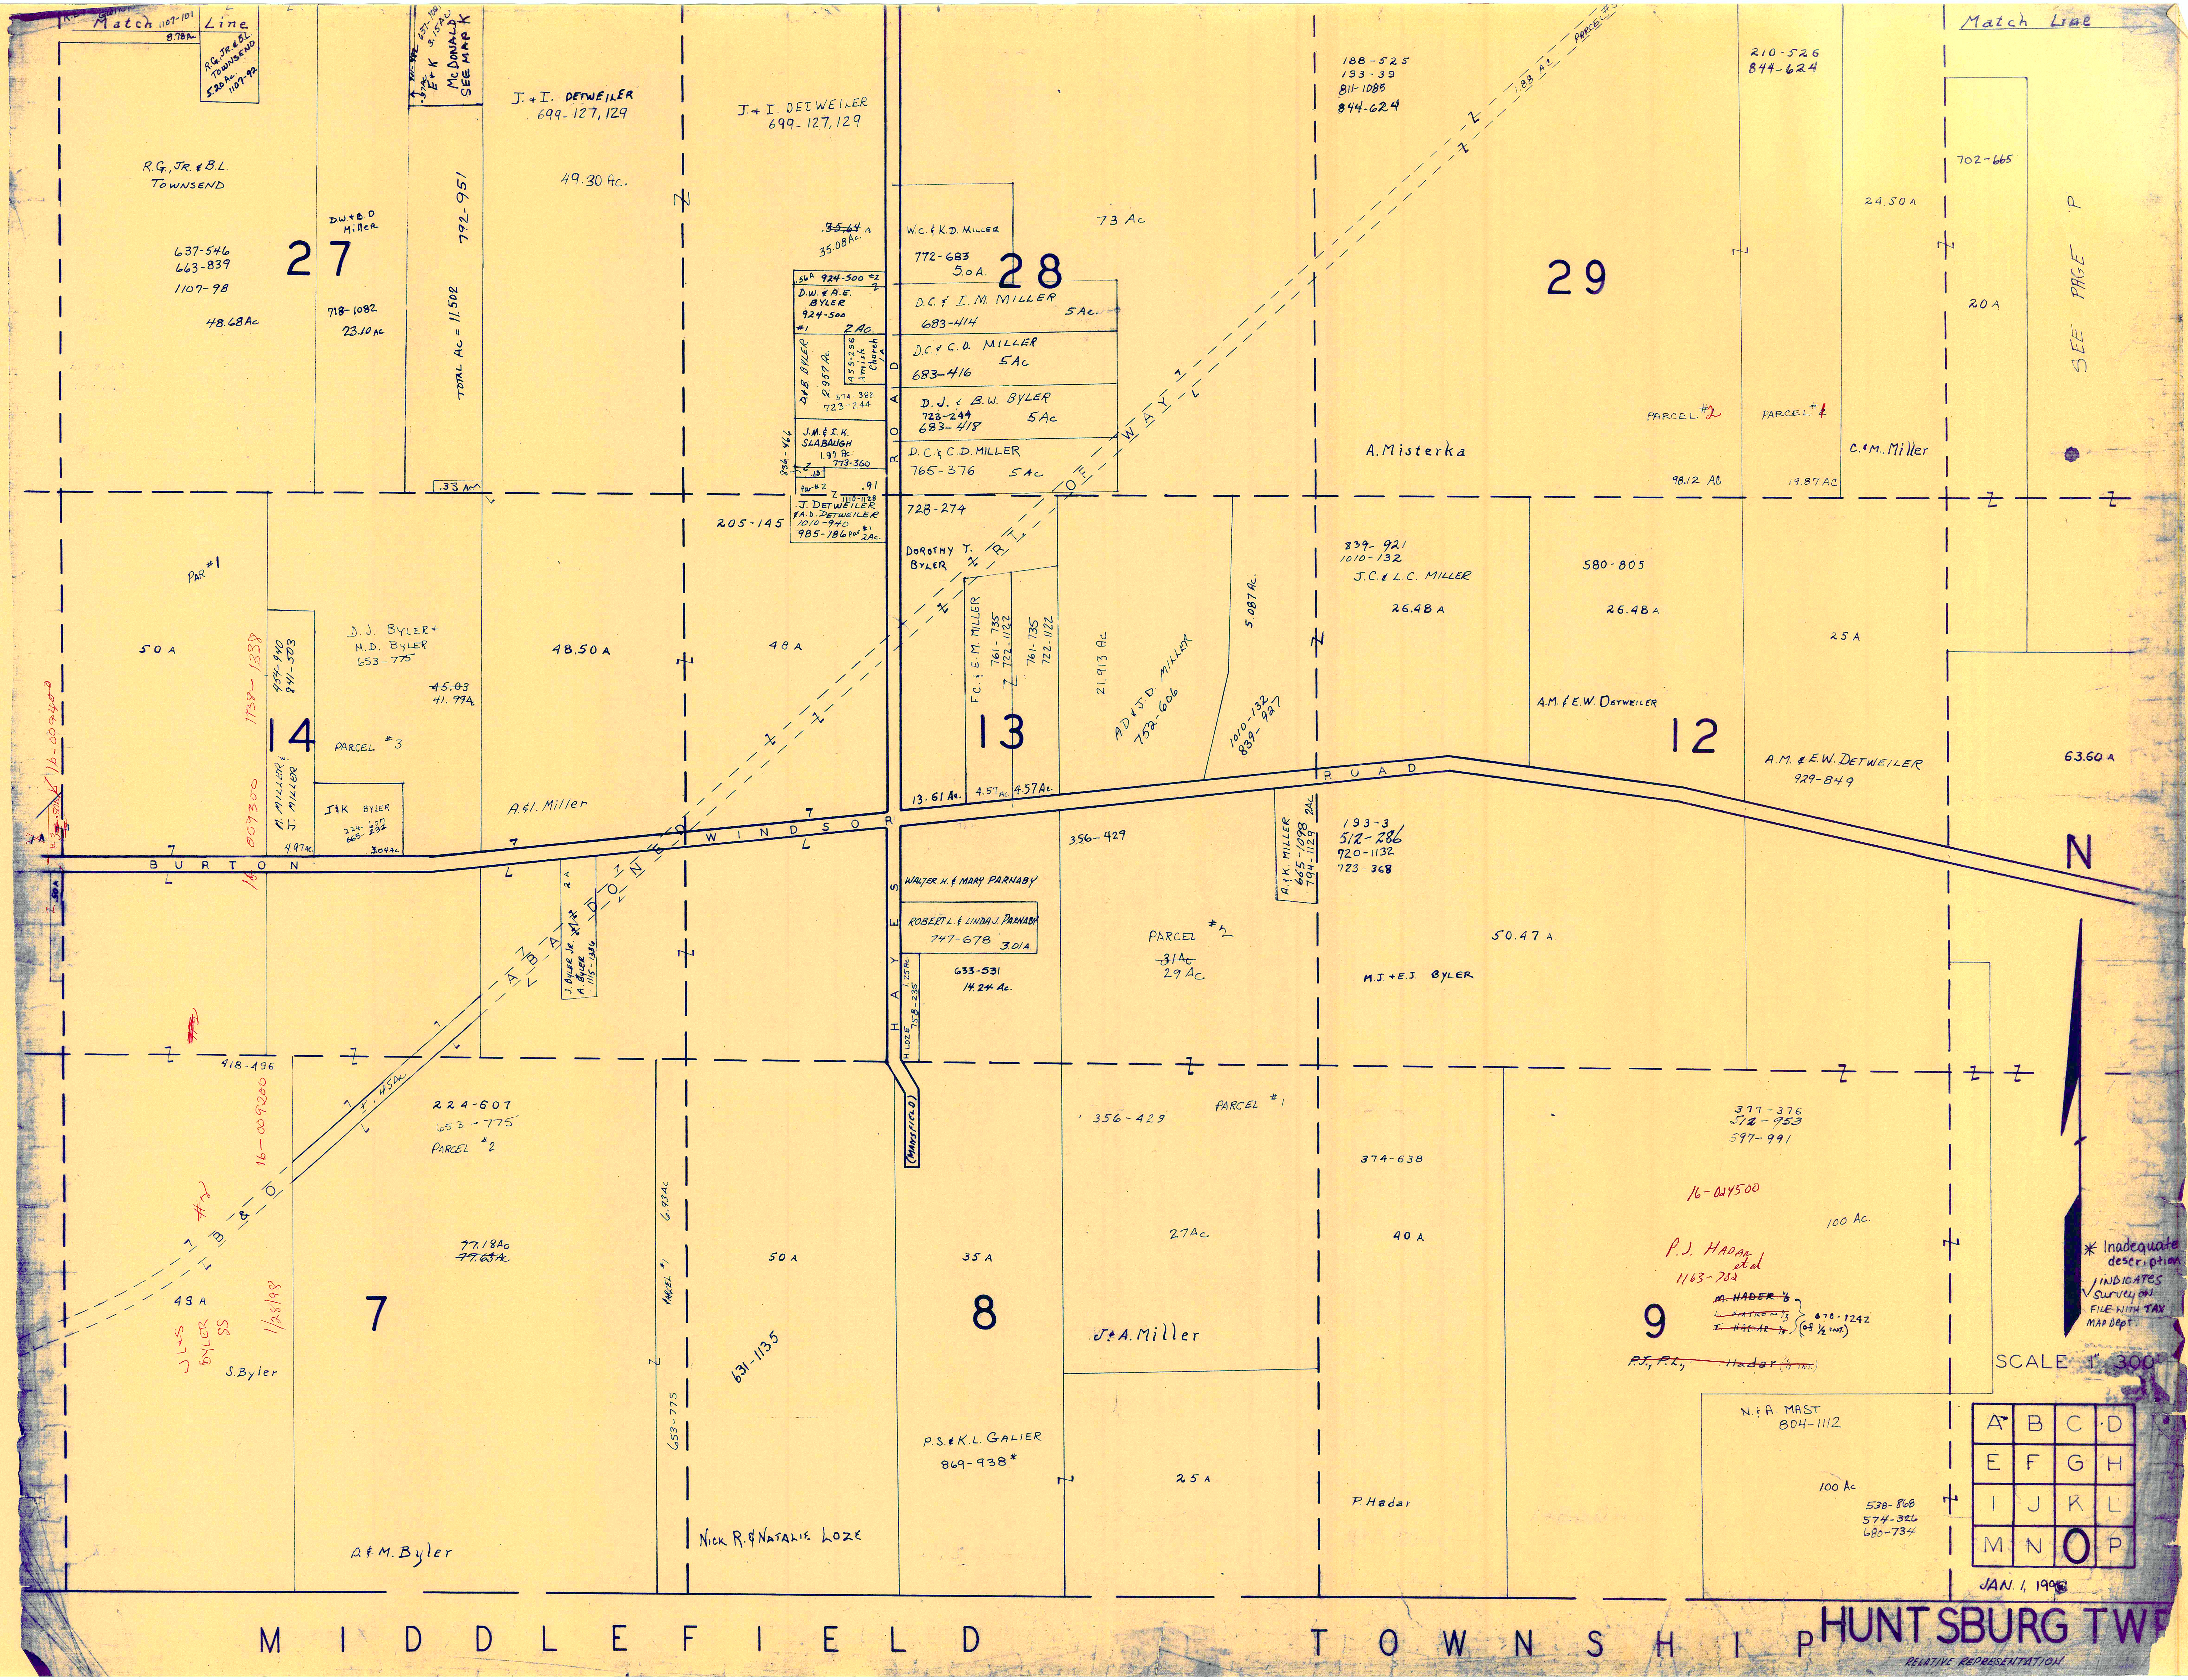
Match Line
1107-101
8.78Ac
R.G., JR. & B.L. TOWNSEND 5.20Ac. 1107-92
R.G., JR. & B.L. TOWNSEND
637-546
663-839
1107-98
48.68Ac
27
D.W. & B.O Miller
718-1082
23.10Ac
792-951
TOTAL Ac = 11.502
.37Ac 637-1081 E & K 3.15AC McDONALD SEE MAP K
.33 Ac
J. & I. DETWEILER
699-127, 129
49.30 Ac.
J. & I. DETWEILER
699-127, 129
~~35.64~~ A
35.08Ac.
.56A 924-500 #2
D.W. & A.E. BYLER 924-500
#1 2Ac.
D & B BYLER 2.957 Ac.
574-388
723-244
459-296 Amish Church 1A
J.M. & I.K. SLABAUGH 1.87 Ac. 773-360
836-466
.13
Par #2 .91
1110-1128
J. DETWEILER & A.D. DETWEILER
1010-940
985-186 Par #1 2Ac.
W.C. & K.D. MILLER
772-683
5.0A.
28
73 Ac
D.C. & I.M. MILLER
683-414
5Ac.
D.C. & C.D. MILLER
5Ac
683-416
D.J. & B.W. BYLER
723-244
683-418
5Ac
D.C. & C.D. MILLER
765-376
5Ac
ROAD
ABANDONED RT. OF WAY
PARCEL #3
1.83 A±
188-525
193-39
811-1085
844-624
29
A. Misterka
210-526
844-624
24.50 A
702-665
20 A
SEE PAGE P
PARCEL #2
PARCEL #1
C. & M. Miller
98.12 AC
19.87 AC
Match Line
PAR #1
50 A
1138-1338
454-940
841-503
D.J. BYLER & H.D. BYLER
653-775
~~45.03~~
41.99A
14
PARCEL #3
A. MILLER & J. MILLER
4.97Ac.
J & K BYLER 224-297 665-332 3.04Ac
16-009400
16-009300
H.A. Byler
48.50 A
A & I. Miller
205-145
48 A
728-274
DOROTHY Y. BYLER
F.C. & E.M. MILLER 761-735 722-1122
761-735 722-1122
13
13.61 Ac.
4.57Ac
4.57Ac
21.913 Ac
A.D. & J.D. MILLER 752-606
5.087 Ac.
1010-132
839-927
839-921
1010-132
J.C. & L.C. MILLER
26.48 A
580-805
26.48 A
25 A
A.M. & E.W. DETWEILER
12
A.M. & E.W. DETWEILER
929-849
63.60 A
BURTON WINDSOR ROAD
2A
J. Byler Jr. & A Byler 1115-1384
HAYES ROAD
WALTER H. & MARY PARNABY
ROBERT L. & LINDA J. PARNABY
747-678 3.01A
633-531
14.24 Ac.
356-429
PARCEL #2
~~31Ac~~
29 Ac
A. & K. MILLER 665-1098 794-1129 2Ac
193-3
512-286
720-1132
723-368
50.47 A
M.J. & E.J. BYLER
N
418-496
16-009200
224-607
653-775
PARCEL #2
~~77.63Ac~~
77.18Ac
7
43 A
JL & S BYLER #2
1/25/98
S. Byler
A & M. Byler
PARCEL #1
6.97Ac
653-775
50 A
631-1135
Nick R. & Natalie Loze
H. LOZE 758-235 1.25Ac
(MANSFIELD)
356-429
35 A
8
P.S. & K.L. GALIER
869-938*
PARCEL #1
27Ac
J. & A. Miller
25 A
374-638
40 A
P. Hadar
377-376
512-953
597-991
16-024500
P.J. HADAR etal
1163-782
~~A. HADER ½~~
~~1/3~~
~~1/3~~
678-1242 (of ½ INT.)
9
~~P.J., P.L., Hadar~~ (½ INT.)
100 Ac.
N. & A. MAST
804-1112
100 Ac.
538-868
574-326
680-734
* Inadequate description
√ INDICATES survey on FILE WITH TAX MAP Dept.
SCALE 1" 300'
A B C D
E F G H
I J K L
M N O P
JAN. 1, 199
MIDDLEFIELD TOWNSHIP
HUNTSBURG TW
RELATIVE REPRESENTATION

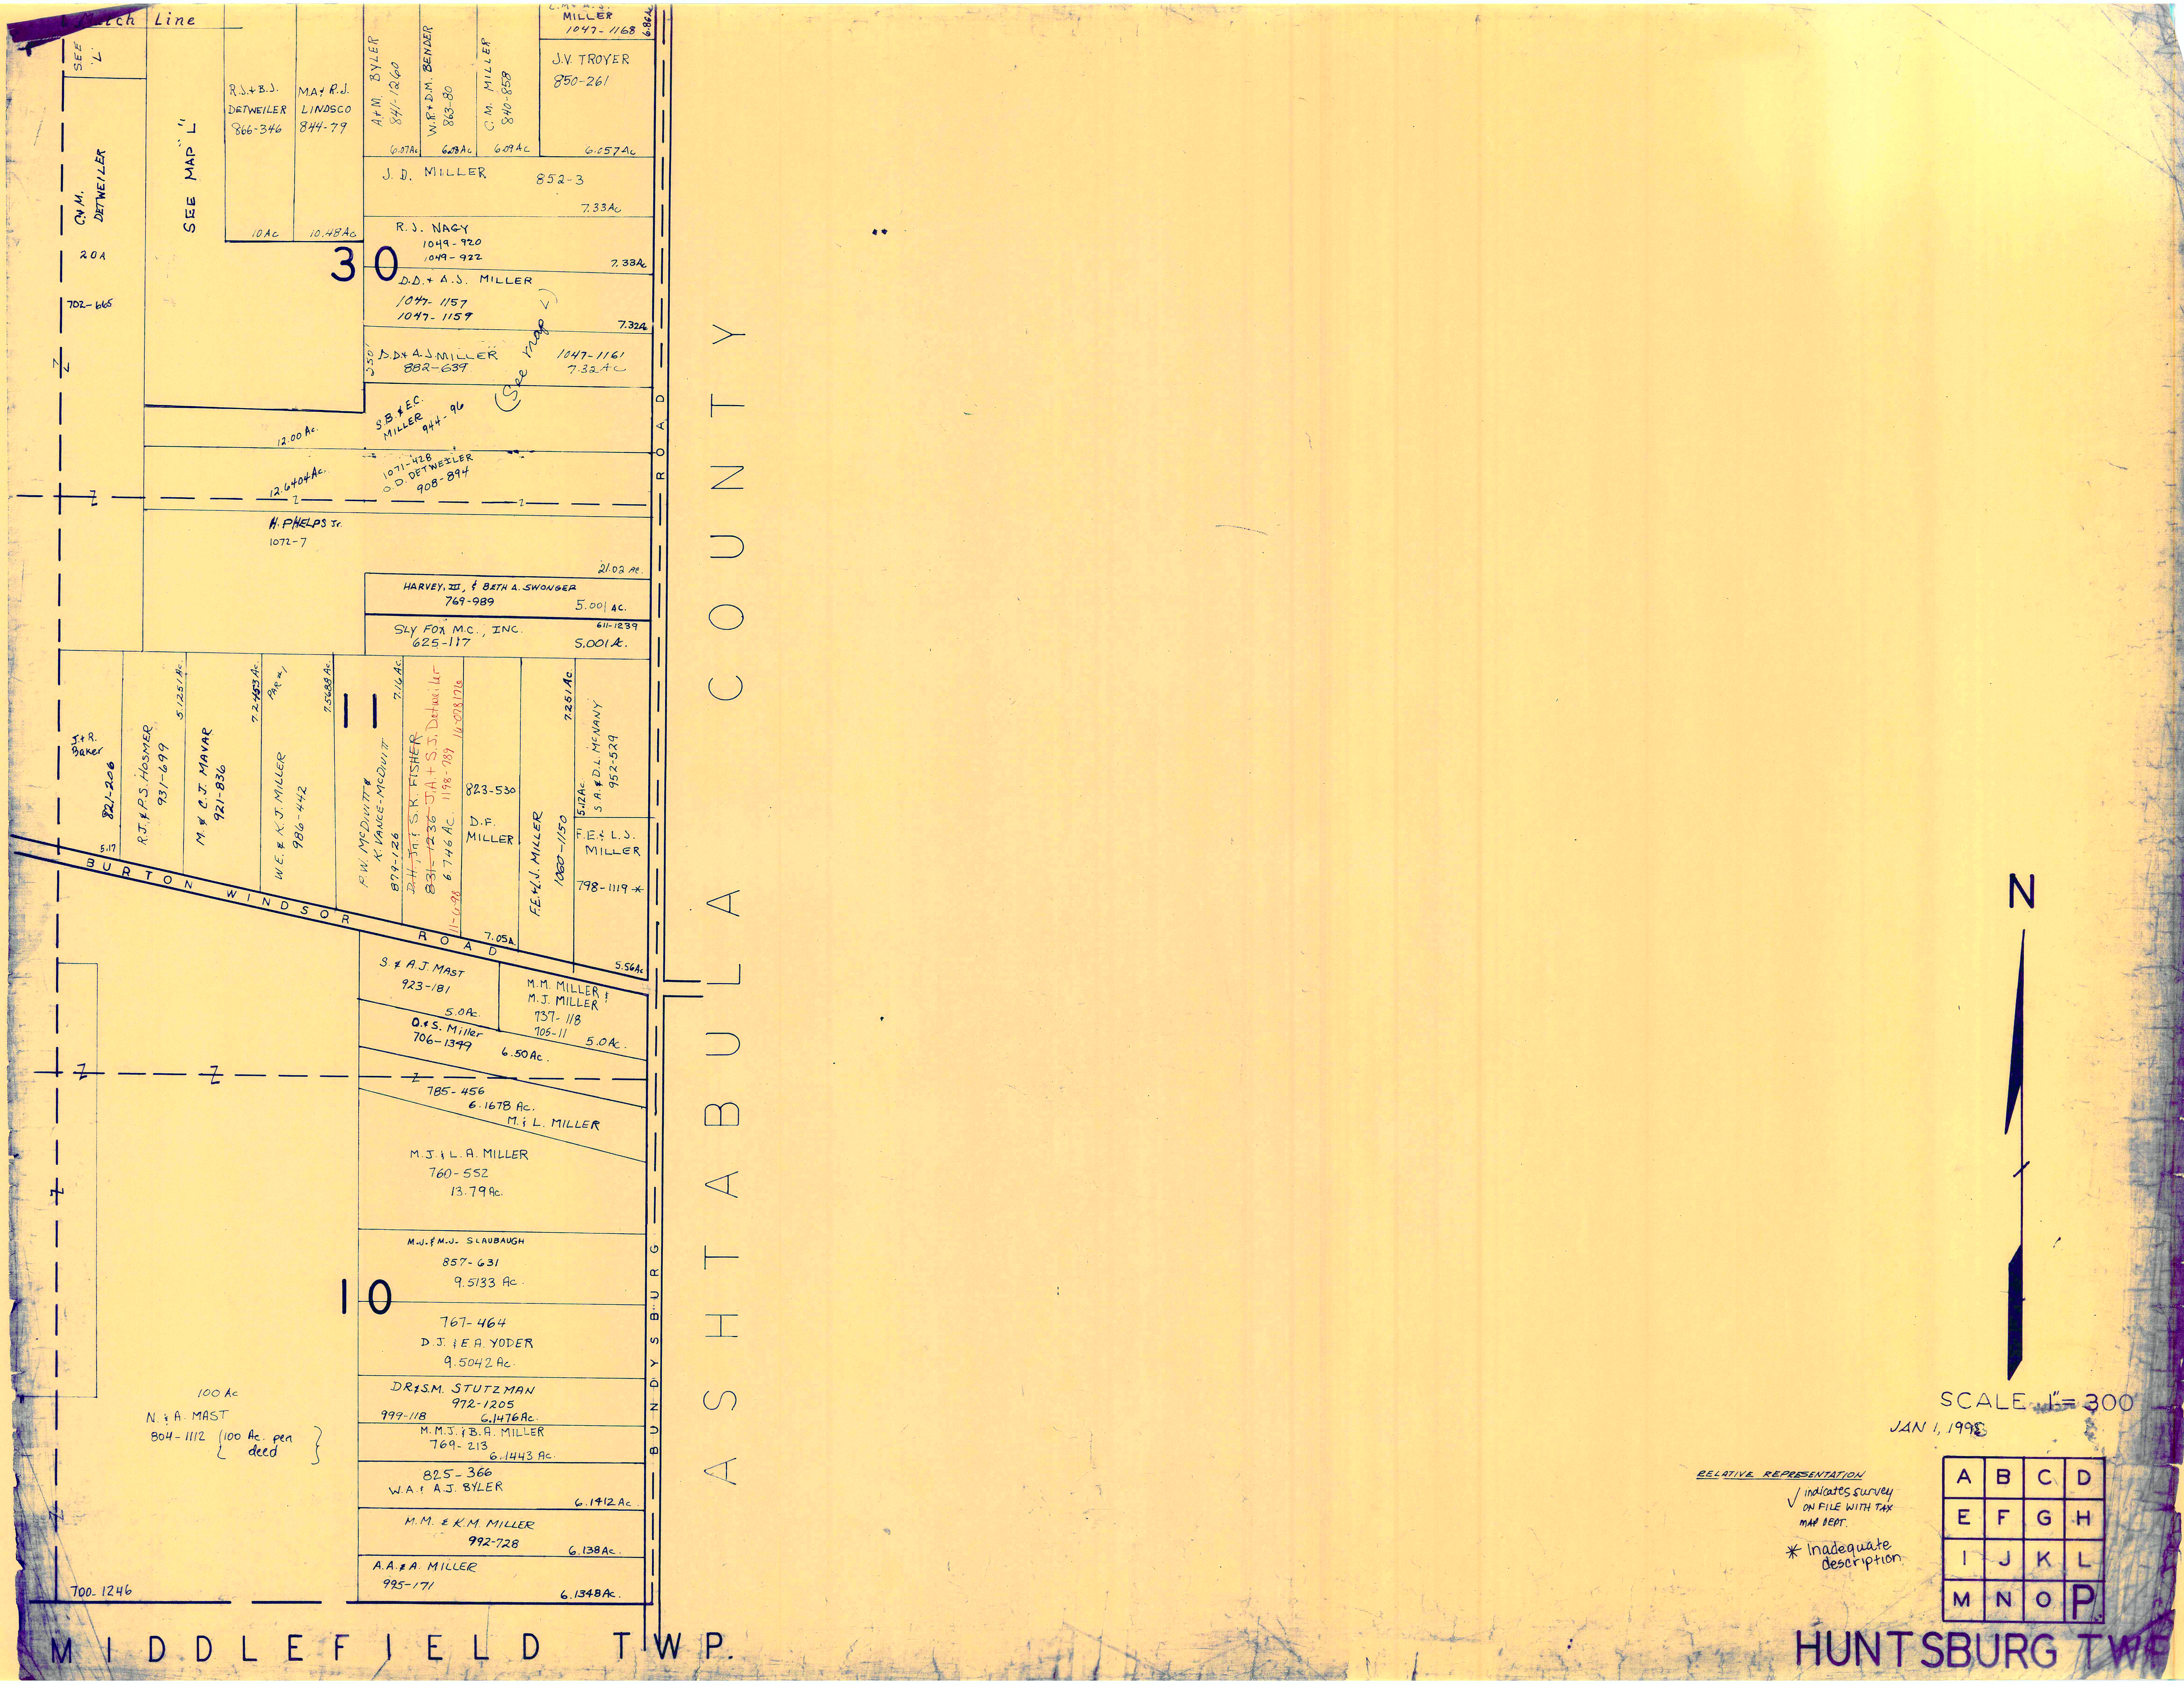
Match Line
SEE 'L'
SEE MAP "L"
C.& M. DETWEILER
20A
702-665
R.J.+B.J. DETWEILER
866-346
10Ac
M.A.& R.J. LINDSCO
844-79
10.48Ac
A.+M. BYLER
841-1260
6.07Ac
W.R.+D.M. BENDER
863-80
6.08Ac
C.M. MILLER
840-858
6.09Ac
MILLER
1047-1168
6.86Ac
J.V. TROYER
850-261
6.057Ac
J. D. MILLER
852-3
7.33Ac
R.J. NAGY
1049-920
1049-922
7.33Ac
30
D.D.+A.J. MILLER
1047-1157
1047-1159
7.32Ac
350'
D.D.+A.J. MILLER
882-639
1047-1161
7.32Ac
(See map L)
S.B.& E.C. MILLER
944-96
12.00 Ac.
1071-428
O.D. DETWEILER
908-894
12.6404Ac.
H. PHELPS Jr.
1072-7
21.02 Ac.
HARVEY, III, & BETH A. SWONGER
769-989
5.001 AC.
SLY FOX M.C., INC.
625-117
611-1239
5.001A.
J.+R. Baker
821-206
5.17
R.J.& P.S. HOSMER
931-699
5.1251Ac.
M.& C.J. MAVAR
921-836
7.2453Ac.
PAR #1
W.E.& K.J. MILLER
986-442
7.5688Ac.
11
P.W. McDIVITT & K. VANCE-McDIVITT
879-126
7.16Ac.
~~D.H., Jr. & S.K. FISHER~~
~~831-1236~~
J.A.+S.J. Detweiler
1198-789
16-078176
11-6-98
6.746Ac.
823-530
D.F. MILLER
7.05A.
F.E.&L.J. MILLER
1060-1150
7.251Ac.
S.A.& D.L. McNANY
952-529
5.12Ac.
F.E.& L.J. MILLER
798-1119 *
5.56Ac.
BURTON WINDSOR ROAD
S.& A.J. MAST
923-181
5.0Ac.
M.M. MILLER & M.J. MILLER
737-118
705-11
5.0Ac.
O.& S. Miller
706-1349
6.50Ac.
785-456
6.1678 Ac.
M.& L. MILLER
M.J.& L.A. MILLER
760-552
13.79Ac.
M.J.& M.J. SLAUBAUGH
857-631
9.5133 Ac.
10
767-464
D.J. & E.A. YODER
9.5042Ac.
DR & S.M. STUTZMAN
972-1205
999-118
6.1476Ac.
M.M.J. & B.A. MILLER
769-213
6.1443 Ac.
825-366
W.A.& A.J. BYLER
6.1412Ac.
M.M. & K.M. MILLER
992-728
6.138Ac.
A.A.& A. MILLER
995-171
6.1348Ac.
100 Ac
N.& A. MAST
804-1112
{100 Ac. per deed}
700-1246
Z
ROAD
BUNDYSBURG
ASHTABULA COUNTY
MIDDLEFIELD TWP.
N
SCALE 1"=300'
JAN 1, 1998
RELATIVE REPRESENTATION
√ indicates survey ON FILE WITH TAX MAP DEPT.
* Inadequate description
A B C D
E F G H
I J K L
M N O P
HUNTSBURG TWP.

HUNTSBURG TP.
CENTER

INDEX TO PROPERTIES HAVING #NO.'S

- #1 719-18 J.L.+K.M. WHITE .61 A.
- #2 1004-839 1008-1292 T.P.& S.M. Thurling SS/1060-746 .63 A. – 16-070200
- #3 971-1198 J.P. BRUENING .60 A.
- #4 491-321 Township of Huntsburg .35 A.
- #5 122-499, 130-169 Township of Huntsburg .10 AC
- #6 880-627;629 T.P.&S. THURLING 1060-744 .13 Ac. – 16-069700
- #7 943-920 D. HUTCHINSON .25 A.
- #8 776-840 K. MILLER .50 A.
- #9 890-1113 E.C.& D.S. PLICKERT .50 A.
- #10 747-676 KAREN EDITH PHILLIPS .50 A.
- #11 878-802* J.A. BRUNER .07 A.
- #12 T.A. FRANK 1133-1252 .27 A.
- #13 878-802* J.A. BRUNER .49 A.
- #14 T.T.J. TRUST 758-550 .05 A.
- #15 1004-560 L.R. CHURA & T.L. SHAFFER .1726
- #16 599-27 S.E RHODES .87 A.
- #17 723-803 J.&R.&G. Sykora & S. Cook .26 A. 1/4 int
- #18 585-671 F. HALL .33 A.
- #19 T.A. Loze & D. Perko .50 A. 865-259
- #20 469-239 K. Motil .55 AC

	INDEX TO PROPERTIES HAVING #NO.'S		
#1	J.L. & K.M. WHITE	719-18	.61ac
#2	T.P. & S.M. THURLING S.S.	1060-746	.63ac
		1008-1292	
		1004-839	
#3	J.P. BRUENING	971-1198	.60ac
#4	TOWNSHIP OF HUNTSBURG	491-321	.35ac
#5	TOWNSHIP OF HUNTSBURG	130-169	.10ac
		122-499	
#6	T.P. & S.M. THURLING	1060-744	.13ac
		880-627	
#7	D. HUTCHINSON	943-920	.25ac
#8	K. MILLER	776-840	.50ac
#9	E.C. & D.S. PLICKERT	890-1113	.50ac
#10	K.E. PHILLIPS	747-676	.50ac
#11	*J.A. BRUNER	878-802	.07ac
#12	T.A. FRANK	1133-1252	.27ac
#13	*J.A. BRUNER	787-802	.49ac
#14	T.T.J. TRUST NO.2	758-550	.05ac
#15	L.R. CHURA & T.L. SHAFFER	1004-560	.17ac
#16A	T.T.J. TRUST NO.2	1086-1176	.37ac
		1086-1174	
#16B	T.P. THURLING	1086-1174	.50ac
#17	J. & R. & G. SYKORA & S. COOK	723-803	.26ac
#18	F. HALL	585-671	.33ac
#19	T.A. LOZE & D. PERKO	865-259	.50ac
#20	K. MOTIL	469-239	.55ac

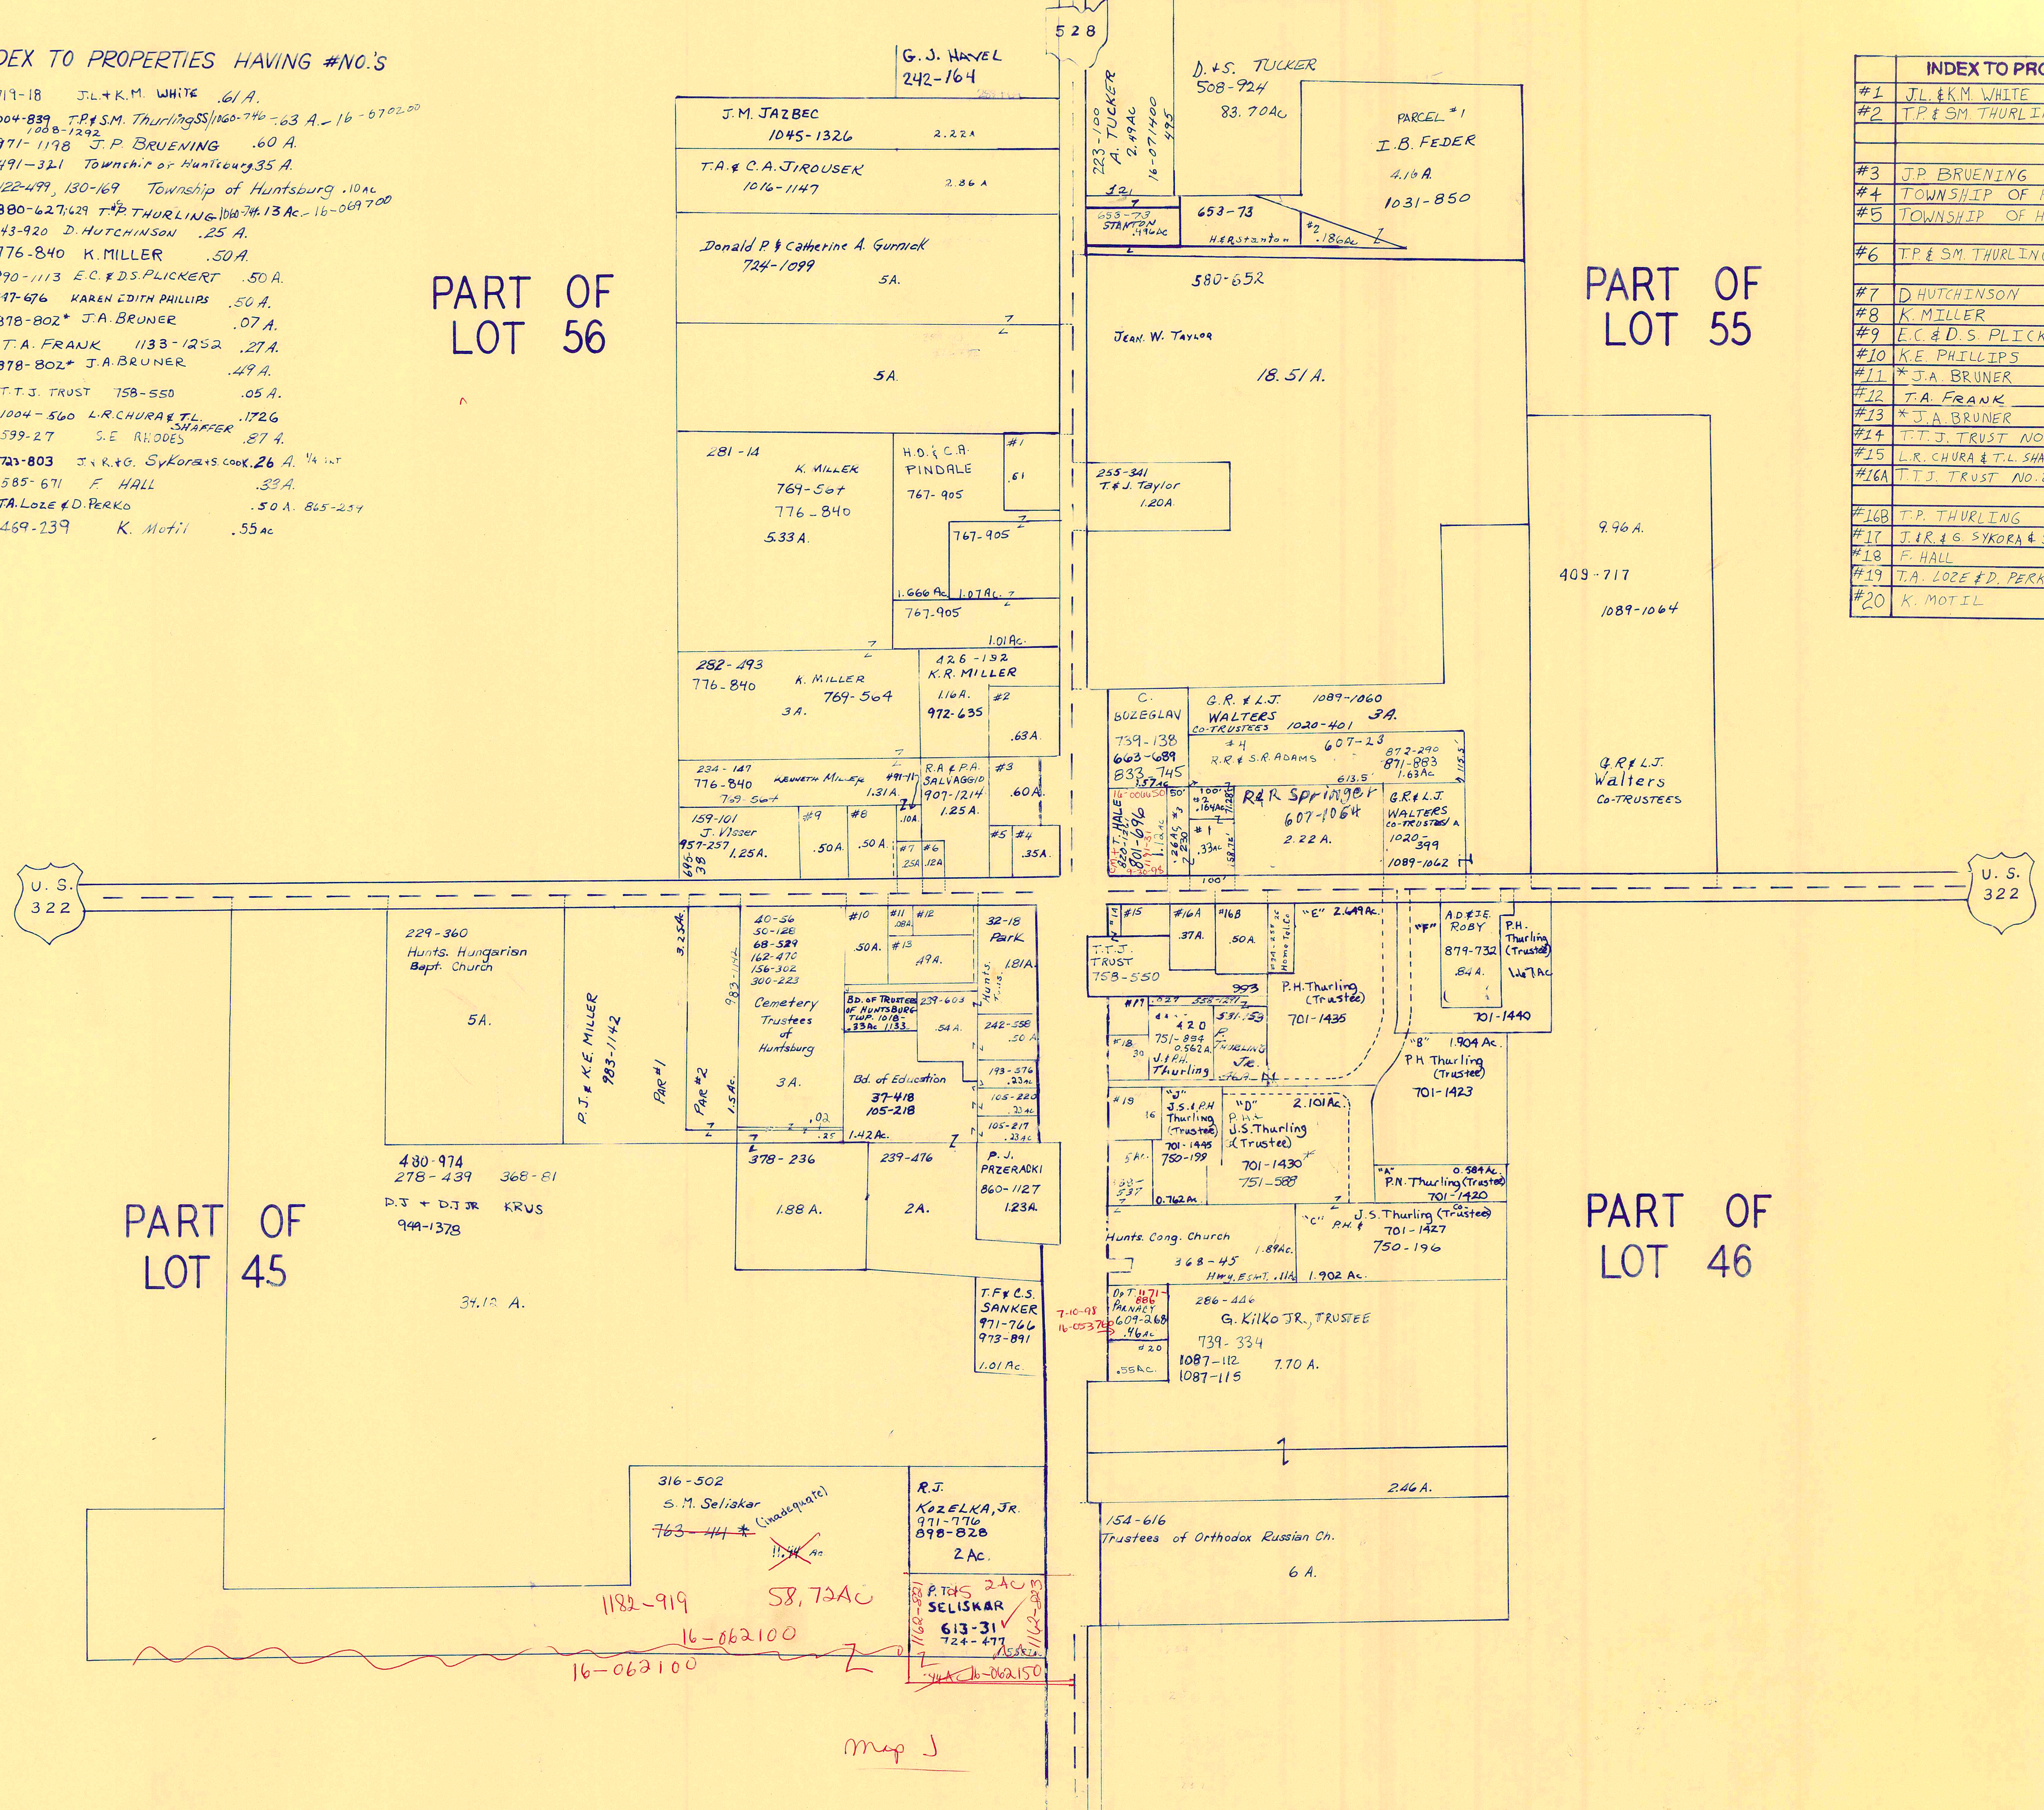
528
G.J. HAVEL 242-164
J.M. JAZBEC 1045-1326 2.22A
T.A. & C.A. JIROUSEK 1016-1147 2.36A
Donald P. & Catherine A. Gurnick 724-1099 5A.
5A.
PART OF LOT 56
281-14
K. MILLER 769-507 776-840 5.33A.
H.D. & C.A. PINDALE 767-905
767-905
282-493 776-840
K. MILLER 769-564 3A.
426-192 K.R. MILLER 1.16A. 972-635
234-147 776-840
R.A. & P.A. SALVAGGIO 907-1214 1.25A.
159-101 J. Visser 957-257 1.25A.
A. TUCKER 223-100 2.49AC 16-071400
D. & S. TUCKER 508-924 83.70AC
PARCEL #1 I.B. FEDER 4.16A. 1031-850
STANTON
653-73
H. KERSTANTON
580-652
Jean W. Taylor 18.51 A.
PART OF LOT 55
255-341 T. & J. Taylor 1.20A
9.96A.
409-717
1089-1064
C. BOZEGLAV 739-138 663-689 833-745
G.R. & L.J. WALTERS CO-TRUSTEES 1089-1060 1020-401 3A.
607-23
R.R. & S.R. ADAMS
872-290 871-883
R & R Springer 607-1064 2.22A.
G.R. & L.J. WALTERS CO-TRUSTEES 1020-399 1089-1062
G.R. & L.J. Walters Co-TRUSTEES
U.S. 322
U.S. 322
229-360 Hunts. Hungarian Bapt. Church 5A.
P.J. & K.E. MILLER 983-1142
PAR #1
PAR #2
40-56 50-126 68-529 162-470 156-362 300-223
Cemetery Trustees of Huntsburg 3A.
BD. OF TRUSTEES OF HUNTSBURG TWP. 1018-1133
Bd. of Education 37-418 105-218
32-18 Park
242-558
193-576
105-220
105-217
P.J. PAZERACKI 860-1127 1.23A.
378-236 1.88A.
239-476 2A.
480-974 278-439 368-61
P.J. + D.J. JR KRUS 944-1378
PART OF LOT 45
34.12 A.
T.T.J. TRUST 758-550
P.H. Thurling (Trustee) 701-1435
A.D. & J.E. ROBY 879-732
P.H. Thurling (Trustee)
701-1440
J.F.H. Thurling
P.H. Thurling (Trustee) 701-1423
J.S. & P.H. Thurling (Trustee) 701-1445 750-199
J.S. Thurling (Trustee) 701-1430 751-588
P.N. Thurling (Trustee) 701-1420
J.S. Thurling (Trustee) 701-1427 750-196
Hunts. Cong. Church 368-45
PART OF LOT 46
T.F. & C.S. SANKER 971-766 973-891 1.01Ac.
G. Kilko JR., TRUSTEE 286-444 739-334 1087-112 1087-115 7.70 A.
2.46A.
154-616 Trustees of Orthodox Russian Ch. 6A.
316-502 S.M. Seliskar ~~763-414~~ (inadequate)
R.J. KOZELKA, JR. 971-776 898-828 2Ac.
P. T. & S. SELISKAR 613-31 724-477
1182-919
58.72Ac
16-062100
16-062100
16-062150
Map J

N

JAN. 1, 1998

SCALE: 1 IN. = 200'

RELATIVE REPRESENTATION

√ indicates survey on FILE WITH TAX MAP Dept.

* Inadequate description

Q8 CENTER

Huntsburg 1998